
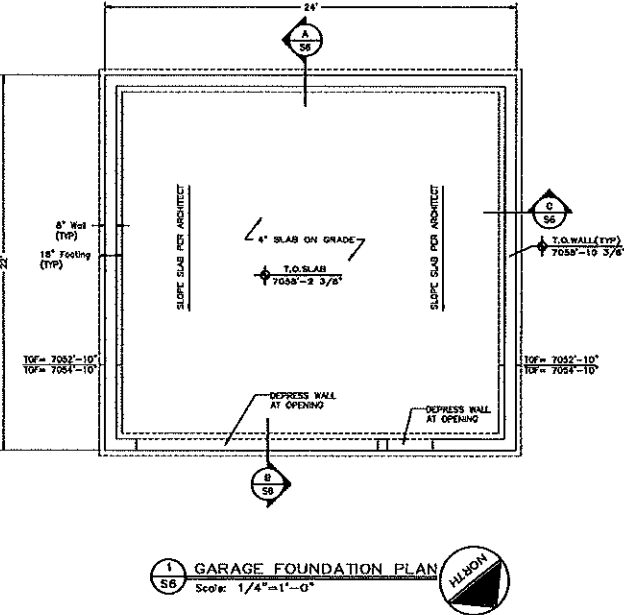
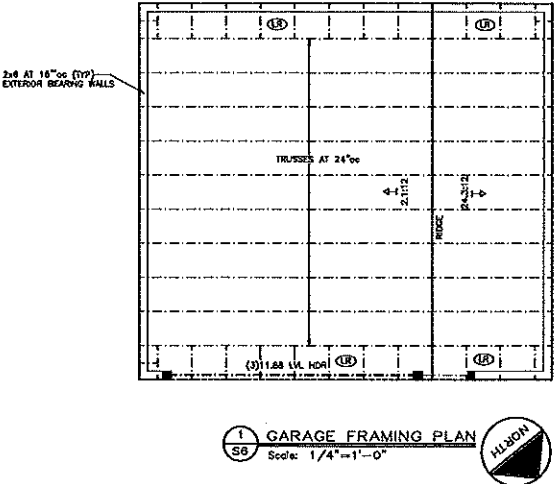
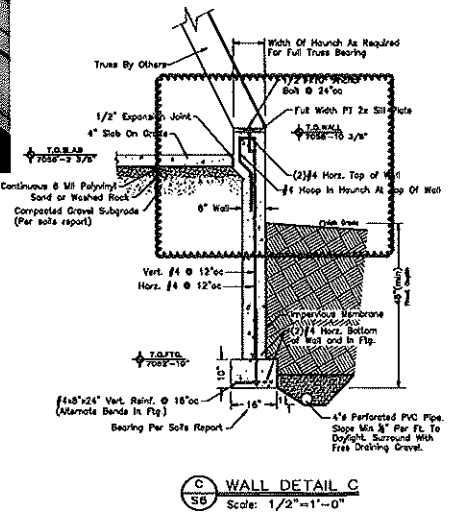
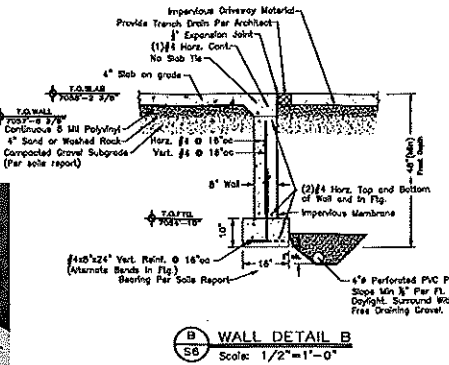
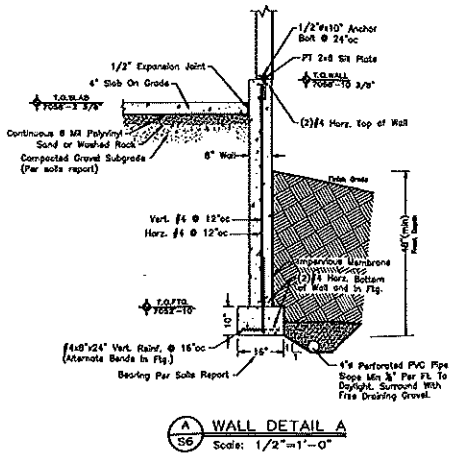


O.K. as Installed in Field 4-25-22

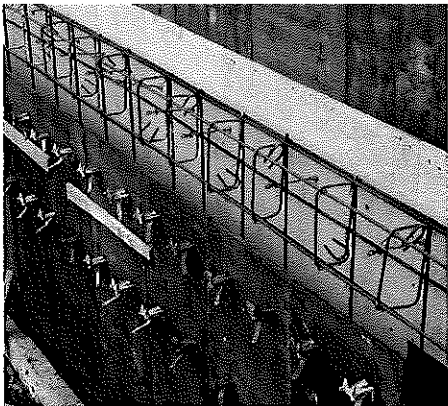

ENGINEERING DESIGNWORKS, INC.
1859 RIVER QUEEN LANE
STEAMBOAT SPRINGS, CO 80487
P.O. Box 77272
Steamboat Springs, CO 80477
PHONE: (970) 729-2499
FAX: (970) 729-2498
www.edesignworks.com

DATE: 11-30-2021
JOB #: 2021153
DRAWN: EDW
ENG: CW
REVIEWED: ---
REVISED: ---

ISSUE REV3
GARAGE STRUCTURE for the proposed:
STEAMBOAT SPRINGS ALPINE HOUSE
1859 RIVER QUEEN LANE
STEAMBOAT SPRINGS, COLORADO