

[illegible]

GENERAL MECHANICAL CONTRACT REQUIREMENTS:

GENERAL:

1. UNLESS OTHERWISE NOTED, THE WORK DESCRIBED ON THE PLANS AND SPECIFICATIONS SHALL INCLUDE THE FURNISHING AND INSTALLATION OF ALL LABOR AND MATERIALS NECESSARY FOR COMPLETE AND OPERATIONAL HVAC, FIRE PROTECTION AND PLUMBING SYSTEMS. CONTRACTOR SHALL FURNISH THESE EVEN IF ITEMS REQUIRED TO ACHIEVE THIS (I.E. OFFSETS, ISOLATION AND BALANCING DEVICES, MAINTENANCE CLEARANCES, ETC.) ARE NOT SPECIFICALLY SHOWN.
2. DATA GIVEN ON THE DRAWINGS IS AS EXACT AS COULD BE SECURED. ABSOLUTE ACCURACY IS NOT GUARANTEED AND THE CONTRACTOR SHALL OBTAIN AND VERIFY EXACT LOCATIONS, MEASUREMENTS, LEVELS, SPACE REQUIREMENTS, POTENTIAL CONFLICTS WITH OTHER TRADES, ETC. AT THE SITE AND SHALL SATISFACTORILY ADAPT HIS WORK TO THE ACTUAL CONDITIONS OF THE JOB.
3. THE DRAWINGS ARE DIAGRAMMATICAL IN NATURE AND SHALL NOT BE SCALED. THEY SHOW CERTAIN PHYSICAL RELATIONSHIPS WHICH MUST BE ESTABLISHED WITHIN THE DIVISION 21,22 AND 23 WORK AND ITS INTERFACE WITH OTHER WORK. ESTABLISHING THIS RELATIONSHIP IN THE FIELD IS THE EXCLUSIVE RESPONSIBILITY OF THE CONTRACTOR. THIS DIVISION SHALL COORDINATE ITS WORK WITH ALL DIVISIONS OF THE WORK AND ADJUST ITS WORK AS REQUIRED BY THE ACTUAL CONDITIONS OF THE PROJECT.

A. THE CONTRACTOR SHALL VISIT THE SITE BEFORE SUBMITTING A BID TO BECOME THOROUGHLY FAMILIAR WITH THE ACTUAL CONDITIONS OF THE PROJECT. NO EXTRAS WILL BE ALLOWED DUE TO LACK OF KNOWLEDGE OF EXISTING CONDITIONS.

B. CERTAIN SYSTEMS REQUIRE ENGINEERING OF INSTALLATION DETAILS BY CONTRACTOR. UNLESS FULLY DETAILED IN THE CONTRACT DOCUMENTS, SUCH ENGINEERING IS THE EXCLUSIVE RESPONSIBILITY OF THE CONTRACTOR.

C. IT IS THE CONTRACTOR'S RESPONSIBILITY TO DETERMINE WHERE CLEARANCES ARE LIMITED, AND WHERE INSTALLATION DRAWINGS OR SCHEMATICS, "CONSTRUCTION DRAWINGS", OR COORDINATION DRAWINGS MAY BE REQUIRED IN ACCORDANCE WITH, OR IN EXCESS OF, THOSE REQUIRED BY THE SPECIFICATIONS. THE CONTRACTOR SHALL PREPARE ALL SUCH COORDINATION DRAWINGS AS PART OF THE BASE CONTRACT. SUCH DRAWINGS MAY BE SUBMITTED TO THE ARCHITECT/ENGINEER FOR RECORD AND COMMENT. ANY WORK INSTALLED WITHOUT APPROVED COORDINATION DRAWINGS IS DONE AT THE CONTRACTOR'S RISK.

4. THESE NOTES ONLY SUPPLEMENT, AND DO NOT REPLACE, THE SPECIFICATIONS.

5. DEFINITIONS AND TERMINOLOGY

A. THE DEFINITIONS OF DIVISION 1 AND THE GENERAL CONDITIONS OF THIS SPECIFICATION ALSO APPLY TO THE DIVISION 21,22 AND 23 CONTRACT DOCUMENTS.

B. "CONTRACT DOCUMENTS" CONSTITUTE THE DRAWINGS, SPECIFICATIONS, GENERAL CONDITIONS, PROJECT MANUALS, ETC., PREPARED BY ENGINEER (OR OTHER DESIGN PROFESSIONAL IN ASSOCIATION WITH ENGINEER) FOR CONTRACTOR'S BID OR CONTRACTOR'S NEGOTIATIONS WITH THE OWNER. THE DIVISION 21,22 AND 23 DRAWINGS AND SPECIFICATIONS PREPARED BY THE ENGINEER ARE NOT CONSTRUCTION DOCUMENTS.

C. "CONSTRUCTION DOCUMENTS", "CONSTRUCTION DRAWINGS", AND SIMILAR TERMS FOR DIVISION 21,22 AND 23 WORK REFER TO INSTALLATION DIAGRAMS, SHOP DRAWINGS AND COORDINATION DRAWINGS PREPARED BY THE CONTRACTOR USING THE DESIGN INTENT INDICATED ON THE ENGINEER'S CONTRACT DOCUMENTS. THESE SPECIFICATIONS DETAIL THE CONTRACTOR'S RESPONSIBILITY FOR "ENGINEERING BY CONTRACTOR" AND FOR PREPARATION OF CONSTRUCTION DOCUMENTS.

D. "IN" INDICATES "NEW" EQUIPMENT TO BE PROVIDED UNDER THIS CONTRACT.

E. "E" INDICATES "EXISTING" EQUIPMENT ON SITE WHICH MAY OR MAY NOT NEED TO BE RELOCATED AS A PART OF THIS WORK.

F. "R" INDICATES EXISTING EQUIPMENT TO BE RELOCATED AS PART OF THIS WORK.

G. "FURNISH" MEANS TO "SUPPLY" AND USUALLY REFERS TO AN ITEM OF EQUIPMENT.

H. "INSTALL" MEANS TO "SET IN PLACE, CONNECT AND PLACE IN FULL OPERATIONAL ORDER".

I. "PROVIDE" MEANS TO "FURNISH AND INSTALL".

J. "EQUIVALENT" MEANS "MEETS THE SPECIFICATIONS OF THE REFERENCE PRODUCT OR ITEM IN ALL SIGNIFICANT ASPECTS." SIGNIFICANT ASPECTS SHALL BE AS DETERMINED BY THE ARCHITECT/ENGINEER.

K. "WORK BY OTHER(S) DIVISIONS", "RE-XX DIVISION", AND SIMILAR EXPRESSIONS MEANS WORK TO BE PERFORMED UNDER THE CONTRACT DOCUMENTS, BUT NOT NECESSARILY UNDER THE DIVISION OR SECTION OF THE WORK ON WHICH THE NOTE APPEARS. IT IS THE CONTRACTOR'S SOLE RESPONSIBILITY TO COORDINATE THE WORK OF THE CONTRACT BETWEEN HIS/HER SUPPLIERS, SUBCONTRACTORS AND EMPLOYEES. IF CLARIFICATION IS REQUIRED, CONSULT ARCHITECT/ENGINEER BEFORE SUBMITTING BID.

L. BY INFERENCE, ANY REFERENCE TO A "CONTRACTOR" OR "SUB-CONTRACTOR" MEANS THE ENTITY WHICH HAS CONTRACTED WITH THE OWNER FOR THE WORK OF THE CONTRACT DOCUMENTS.

M. "ENGINEER" MEANS THE DESIGN PROFESSIONAL FIRM WHICH HAS PREPARED THESE CONTRACT DOCUMENTS. ALL QUESTIONS, SUBMITTALS, ETC. OF THIS DIVISION SHALL BE ROUTED THROUGH THE ARCHITECT TO THE ENGINEER (THROUGH PROPER CONTRACTUAL CHANNELS).

EXISTING BUILDING:

1. THE CONTRACTOR'S ATTENTION IS CALLED TO THE FACT THAT THE EXISTING BUILDING WILL BE OCCUPIED BY THE OWNER DURING CONSTRUCTION. CONTINUED OPERATION OF THE FACILITY SHALL NOT BE HINDERED BY THIS WORK. THE CONTRACTOR SHALL ACCOUNT FOR ALL ADDITIONAL COSTS WHICH MAY BE INCURRED BY HIM DUE TO THE DIFFICULTY OF WORKING OVER AND AROUND EMPLOYEES, DESKS, EQUIPMENT, ETC., AND DUE TO THE HOURS OF THE DAY IN WHICH AN AREA MAY BE AVAILABLE WHEN SUBMITTING HIS BID.
2. MAINTAIN A MARK-UP SET OF DRAWINGS WHICH INDICATE VARIATIONS IN THE ACTUAL INSTALLATION FROM THE ORIGINAL DESIGN. SURRENDER DRAWINGS TO OWNER UPON COMPLETION.
3. ALL CAPACITIES ARE SCHEDULED AT JOBSITE ALTITUDE OF 6700 FT. ABOVE SEA LEVEL.
4. COORDINATE ALL PENETRATIONS OF THE FLOOR SLAB AND CONCRETE WALL PRIOR TO COMMENCING WORK. UTILIZE X-RAY AND VISUAL INVESTIGATION OF EXISTING CONDITIONS AS REQUIRED PRIOR TO DRILLING OR CUTTING. COORDINATE ALL NEW PENETRATIONS WITH OTHER DIVISIONS OF THE WORK. ALL CONTRACTORS ARE INDIVIDUALLY RESPONSIBLE FOR ALL PENETRATIONS REQUIRED BY THEIR DIVISIONS.

ELECTRICAL COORDINATION:

1. VERIFY THE ELECTRICAL SERVICE PROVIDED BY THE ELECTRICAL CONTRACTOR BEFORE ORDERING ANY MECHANICAL EQUIPMENT REQUIRING ELECTRICAL CONNECTIONS.
2. PROVIDE PREMIUM EFFICIENCY MOTORS WITH 1.15 SERVICE FACTOR ON ALL EQUIPMENT. MOTORS SHALL BE CAPABLE OF OPERATING CONTINUOUSLY AT 105°F UNDER JOBSITE CONDITIONS AND ALTITUDE.
3. THE ELECTRICAL POWER FOR CERTAIN EQUIPMENT PROVIDED UNDER DIVISION 21,22 AND 23 HAS NOT BEEN SPECIFICALLY INDICATED ON THE ELECTRICAL DRAWINGS AND MUST BE PROVIDED BY AND FIELD COORDINATED BY THE DIVISION 21,22 AND 23 TRADE REQUIRING SUCH POWER.

SUFFICIENT POWER FOR THIS PURPOSE SHALL BE FURNISHED AS "SPARE", DEDICATED CIRCUIT CAPACITY IN DIVISION 26'S PANELBOARDS. ALL WIRING, CONDUIT AND ELECTRICAL DEVICES DOWNSTREAM OF THE PANELBOARDS IS THE RESPONSIBILITY OF THE DIVISION 21,22 AND 23 TRADE REQUIRING THE POWER UNLESS OTHERWISE SHOWN ON THE ELECTRICAL DRAWINGS.

SUCH EQUIPMENT IS HEREBY DEFINED AS:

A. ELECTRICAL HEAT TRACE. REQUIRED HEAT TRACE LOCATIONS, CAPACITIES AND SPECIFICATION ARE SHOWN OR INDICATED ON THE DRAWINGS. REFER TO SPECIFICATIONS FOR ADDITIONAL INFORMATION.

B. FIRE PROTECTION AIR COMPRESSORS, DRY-PIPE CONTROL PANELS AND VALVES. REQUIRED CONNECTIONS ARE INCLUDED IN THE DIVISION 21 WORK, AND WILL BE SHOWN BY THAT CONTRACTOR'S ENGINEERED SYSTEM DESIGN DRAWINGS.

(1) PRE-ACTION SYSTEM INITIATION SIGNALS (SUCH AS SMOKE DETECTORS, OR GENERAL ALARM CONDITIONS IN A PRE-ACTION ZONE) SHALL BE PROVIDED UNDER DIVISION 28 FIRE-ALARM WORK.

(2) DIVISION 21 SHALL PROVIDE PRE-ACTION CONTROL PANEL AND INTERCONNECTION BETWEEN NEAREST SUITABLE FIRE ALARM PANEL AND LOCATION OF PRE-ACTION VALVE(S).

(3) DIVISION 28 SHALL PROVIDE INTERCONNECTION BETWEEN FIRE COMMAND CENTER ALARM PANEL (PROVIDED UNDER DIVISION 28) AND REMOTE COMMUNICATION FIRE ALARM PANEL (PROVIDED UNDER DIVISION 28).

C. TEMPERATURE CONTROL PANELS, CONTROL AIR COMPRESSORS AND LINE VOLTAGE POWER FOR 24V CONTROL TRANSFORMERS. REQUIRED CONNECTION ARE INCLUDED IN DIVISION 23/30/00 AND WILL BE SHOWN BY THAT CONTRACTOR'S CONTROL SUBMITTAL DRAWINGS.

D. IT IS NOT PERMISSIBLE TO UTILIZE "SPARE" POWER FROM ADJACENT POWER CIRCUITS TO SERVE ANY OF THE ABOVE LOADS. ALL POWER MUST COME FROM DEDICATED CIRCUITS.

5. SMOKE DETECTORS:

FOR AIR HANDLING UNITS AND AIR SYSTEMS WITH A CAPACITY EXCEEDING 2000 CFM, PROVIDE UL LISTED SMOKE DETECTORS IN RETURN AIR SYSTEMS IN ACCORDANCE WITH THE INTERNATIONAL MECHANICAL CODE AND ELSEWHERE AS SHOWN ON THE DRAWINGS.

SMOKE DETECTORS WILL BE FURNISHED AND SET IN PLACE UNDER THIS DIVISION. DETECTORS WILL BE WIRED UNDER DIVISION 28. SMOKE DETECTORS MUST BE OF THE SAME MANUFACTURER, AND COMPATIBLE WITH THE FIRE ALARM SYSTEM PROVIDED UNDER DIVISION 28 (IF APPLICABLE).

CONNECT RELAY(S) TO FAN CONTROL CIRCUIT TO STOP FAN WHEN SMOKE IS DETECTED.

INSTALLATION:

1. SUSPEND EACH TRADE'S WORK SEPARATELY FROM THE STRUCTURE. DUCTWORK SHALL BE HELD TIGHT TO STRUCTURE EXCEPT WHERE OTHERWISE SHOWN.
2. INSTALL ALL EQUIPMENT AND MATERIALS IN ACCORDANCE WITH MANUFACTURER'S RECOMMENDATIONS UNLESS SPECIFICALLY INDICATED OTHERWISE OR WHERE LOCAL CODES OR REGULATIONS TAKE PRECEDENCE.
3. PROVIDE MANUFACTURER'S RECOMMENDED SERVICE CLEARANCE AROUND ALL EQUIPMENT REQUIRING SAME.
4. PROVIDE FOR SAFE CONDUCT OF THE WORK, CAREFUL REMOVAL AND DISPOSITION OF MATERIALS AND PROTECTION OF PROPERTY WHICH IS TO REMAIN UNDISTURBED.
5. PROVIDE ACCESS DOORS FOR ALL EQUIPMENT, VALVES, CLEANOUTS, ACTUATORS AND CONTROLS WHICH REQUIRE ACCESS FOR ADJUSTMENT OR SERVICING AND WHICH ARE LOCATED IN OTHERWISE INACCESSIBLE LOCATIONS.

A. FOR EQUIPMENT LOCATED IN "ACCESSIBLE LOCATIONS" SUCH AS LAY-IN CEILINGS, LOCATE EQUIPMENT TO PROVIDE ADEQUATE SERVICE CLEARANCE FOR NORMAL MAINTENANCE WITHOUT REMOVING ARCHITECTURAL, ELECTRICAL OR STRUCTURAL ELEMENTS SUCH AS THE CEILING SUPPORT SYSTEM, ELECTRICAL FIXTURES, ETC. "NORMAL MAINTENANCE" INCLUDES, BUT IS NOT LIMITED TO, FILTER CHANGING, GREASING OF BEARINGS, USING PIT PORTS FOR PRESSURE OR TEMPERATURE MEASUREMENTS, SERVICING CONTROL VALVES AND SERVICING CONTROL PANELS.

6. ISOLATE ALL PRESSURIZED PIPE (WATER, ETC.) AT EACH RISER, BRANCH, PIECE OF EQUIPMENT, AND AREA SERVED.
7. PROVIDE TRAP GUARDS OR PRIMERS FOR ALL FLOOR DRAINS AND FLOOR SINKS SHOWN ON DRAWINGS. PRIMERS MAY BE CONNECTED TO FLUSH FIXTURES OR BE STAND ALONE. SEE SPECIFICATIONS.
8. NO DOMESTIC WATER, CHILLED WATER, OR HEATING WATER LINES SHALL BE LOCATED EXPOSED IN FINISHED SPACES OR BELOW THE BUILDING SLAB UNLESS SHOWN OTHERWISE ON THE DRAWINGS.

9. ALL CURBS, ROOF JACKS, ROOF THIMBLES, SANITARY VENTS, ROOF DRAINS, ETC. SHALL BE COMPATIBLE WITH ROOFING SYSTEM TO BE PROVIDED. REFERENCE ARCHITECTURAL DIVISION FOR REQUIRED FLASHING DETAILS.
10. MECHANICAL CONTRACTOR IS RESPONSIBLE FOR PROVIDING ALL CONCRETE EQUIPMENT PAD DIMENSIONS, BASED ON THE FINAL EQUIPMENT SELECTION, TO THE STRUCTURAL AND GENERAL CONTRACTOR FOR INCLUSION IN THOSE CONTRACTOR'S WORK AS DESCRIBED BY THE GENERAL CONTRACTOR.

DUCTWORK INSTALLATION:

1. SEAL ALL SEAMS (LONGITUDINAL AND TRANSVERSE) AIR TIGHT WITH SEALANT PER SPECIFICATIONS.
2. DUCT DIMENSIONS ARE INSIDE CLEAR.
3. DIFFUSER NECK SIZE IS SAME AS FLEXIBLE DUCT SIZE.
4. UNLESS OTHERWISE NOTED, ALL CHANGES IN DIRECTION SHALL BE MADE WITH RADIUS ELBOWS WITH RADIUS TO CENTERLINE EQUAL TO 1.5 DUCT WIDTH.
5. WHERE REQUIRED FOR SPACE CONSTRAINTS, PROVIDE MITERED ELBOWS WITH TURNING VANES AS FOLLOWS:

A. FOR DUCT WIDTHS OF 36" OR LESS, PROVIDE MANUFACTURED SINGLE WIDTH TURNING VANES, WITH NO TRAILING EDGES AND SPACING IN ACCORDANCE WITH SMACNA DUCT CONSTRUCTION STANDARDS FOR "STANDARD SPACING".

B. USE DOUBLE THICKNESS (AIRFOIL) BLADES WITHOUT TRAILING EDGES FOR DUCT WIDTHS GREATER THAN 36".

6. ALL FLEXIBLE DUCTS SHALL NOT BE LESS THAN 4", OR MORE THAN 10' IN LENGTH. INSTALL FLEXIBLE DUCTWORK SUCH THAT:

A. MINIMUM OVERALL LENGTH OF 3D, STRAIGHT INTO NECK OF DIFFUSER.

B. MAXIMUM OF 135° OF TOTAL TURNING IN ENTIRE LENGTH OF FLEXIBLE DUCT.

C. MINIMUM TURNING RADIUS OF R = 1.5D.

D. WHERE:

* D = FLEXIBLE DUCT DIAMETER

* R = RADIUS OF TURN AS MEASURED TO CENTERLINE OF DUCT.

7. BRANCH LINES:

- A. MAKE ALL TAPS TO ROUND DUCTWORK WITH CONICAL TEES.
- B. MAKE ALL TAPS TO RECTANGLE DUCTWORK WITH 45° ENTRY OR CONICAL SPIN IN TO ROUND.
- C. INCLUDE DAMPERS AT ALL BRANCH LINES.
8. INCLUDE DAMPERS AT ALL BRANCH LINES, WHERE SHOWN ON THE DRAWINGS, AND WHERE OTHERWISE REQUIRED FOR BALANCING.

PIPE INSTALLATION:

1. ALL PIPING SHALL BE ADEQUATELY SUPPORTED FROM THE BUILDING STRUCTURE TO PREVENT SAGGING, POCKETING, SWAYING OR DISPLACEMENT BY MEANS OF HANGERS AND SUPPORTS. PIPING IS NOT TO BE SUPPORTED BY EQUIPMENT.
2. PROVIDE DIELECTRIC UNIONS BETWEEN DISSIMILAR MATERIALS.
3. PROVIDE MANUAL AIR VENTS AND CAPPED HOSE-END DRAINS WITH ISOLATION VALVES AT PIPING HIGH AND LOW POINTS.
4. WELD PIPE IN ACCORDANCE WITH APPLICABLE CODES AND STANDARDS. WELDERS SHALL BE CERTIFIED FOR TYPE OF WORK BEING PERFORMED.
5. FLUSH OUT PIPING AND REMOVE CONTROL DEVICES BEFORE PERFORMING PRESSURE TEST. DO NOT USE PIPING SYSTEM VALVES TO ISOLATE SECTIONS WHERE TEST PRESSURE EXCEEDS VALVE PRESSURE RATING. PRESSURIZE PIPING AT 100 PSIG. IF LEAKAGE IS OBSERVED OR IF TEMPERATURE COMPENSATED PRESSURE DROP EXCEEDS 1% OF TEST PRESSURE, REPAIR LEAKS AND RETEST. DO NOT USE AIR PRESSURE TO TEST PLASTIC PIPE.
6. PROVIDE SUPPORT UNDER ELBOWS ON PUMP SUCTION AND DISCHARGE LINES.
7. ALL STRAINERS SHALL BE FURNISHED WITH A "ROUGHING" SCREEN AND TWO (2) SCREENS FOR NORMAL OPERATION. INSTALL STRAINER WITH ROUGHING SCREEN AND OPERATE SYSTEM FOR 24 HOURS MINIMUM (RUN DOMESTIC WATER SYSTEMS AT MAX FLOW FOR A MINIMUM OF ONE HALF (1/2) HOUR. REMOVE ROUGHING SCREEN AND INSTALL NORMAL SCREEN AFTER TWO WEEKS OF NORMAL OPERATION INSTALL NEW NORMAL SCREEN.
8. INSTALL ALL PIPING TO ALLOW FOR EXPANSION AND CONTRACTION WITHIN THE PIPING SYSTEM. ENSURE ALL REQUIRED PIPE EXPANSION WILL OCCUR IN THE PROPER DIRECTION AND SEGMENT OF PIPE. PROPERLY ANCHOR (RE SPECIFICATIONS) ALL PIPING REQUIRING EXPANSION/CONTRACTION ISOLATION. COORDINATE PIPE EXPANSION/CONTRACTION TO PREVENT DAMAGE TO ANY AND ALL BUILDING COMPONENTS.
9. PROVIDE ISOLATION VALVES AT EVERY HYDRONIC BRANCH LINE.

CONDENSATE DRAINAGE:

1. PROVIDE CONDENSATE DRAINAGE FOR ALL COOLING COILS AND OVERFLOW PANS.
2. ROUTE CONDENSATE PIPING, FULL SIZE OF DRIP PAN CONNECTION, TO NEAREST CODE APPROVED RECEPTACLE. INSULATE WHERE LOCATED ABOVE FINISHED CEILINGS.
- LOUVERS:
1. ALL LOUVERS LOCATED ON EXTERIOR WALLS SHALL BE PROVIDED BY DIVISION 23. REQUIRED LOUVER FREE AREAS ARE INDICATED ON DIVISION 23 DRAWINGS. IT IS THE RESPONSIBILITY OF THIS CONTRACTOR TO CONFIRM THAT THE REQUIRED FREE AREA HAS BEEN PROVIDED. PRIOR TO CONNECTION TO THAT LOUVER, DIVISION 23 SHALL PROVIDE ALL LOUVER PLENUMS.

LOUVERS:

1. ALL LOUVERS LOCATED ON EXTERIOR WALLS SHALL BE PROVIDED BY DIVISION 23. REQUIRED LOUVER FREE AREAS ARE INDICATED ON DIVISION 23 DRAWINGS. IT IS THE RESPONSIBILITY OF THIS CONTRACTOR TO CONFIRM THAT THE REQUIRED FREE AREA HAS BEEN PROVIDED. PRIOR TO CONNECTION TO THAT LOUVER, DIVISION 23 SHALL PROVIDE ALL LOUVER PLENUMS.

CUTTING, PATCHING AND DEMOLITION:

1. KEEP DEMOLITION & CUTTING TO MINIMUM. REQUIRED FOR PROPER EXECUTION OF WORK.
2. BE RESPONSIBLE FOR ALL CUTTING AND PATCHING NECESSARY FOR THE COMPLETION OF THE WORK.
3. NO CUTTING (NOT SHOWN ON THE CONTRACT DOCUMENTS) SHALL BE DONE WITHOUT THE APPROVAL OF THE ARCHITECT AS TO LOCATIONS, METHOD AND EXTENT OF THE CUTTING.
4. REPAIR ALL ACCIDENTAL OR INTENTIONAL DAMAGE TO MATCH EXISTING CONSTRUCTION WITH NO NOTICEABLE DIFFERENCE IN CONTINUITY, APPEARANCE OR FUNCTION.
5. ALL "CAPPED" SANITARY AND VENT LINES SHALL BE RECONNECTED OR RE-ROUTED AS NECESSARY TO PREVENT "DEAD-ENDS" IN THE PIPING. ALL PIPING SHALL DRAIN TO ACTIVE SANITARY WASTE LINES AND ALL BRANCHES WITH TRAPS SHALL BE ADEQUATELY VENTED.

GENERAL PLUMBING CONTRACT REQUIREMENTS:

1. THE GENERAL MECHANICAL REQUIREMENTS PERTAIN TO THE WORK OF THIS DIVISION.
2. PREPARE SHOP DRAWINGS OF ALL NEW WORK (INCLUDING SLEEVE LOCATIONS) TO VERIFY LOCATIONS AND COORDINATION OF WORK BETWEEN TRADES PRIOR TO INSTALLATION.
3. ALL REQUIRED OPENINGS IN CONCRETE BEAMS AND STRUCTURAL WALLS ARE TO BE ACCOMPLISHED USING SLEEVES PROPERLY SIZED FOR THE PIPE THEY SERVE. CORE DRILLING IN BEAMS IS NOT ALLOWED. CORE DRILLING IN PANS IS ALLOWED UPON PRIOR APPROVAL OF ARCHITECT AND STRUCTURAL ENGINEER.
4. ANY ELECTRICAL SPACE NOT CONSTRUCTED WITH A SUB-ROOF WHICH MAY HAVE PLUMBING PIPING AT THE CEILING OF THESE SPACES SHALL HAVE A DRIP PAN INSTALLED BELOW THE PIPING. DRIP PANS SHALL BE 1.5 TIMES THE WIDTH OF THE PIPING SERVED WITH A MINIMUM OF 2" HIGH SIDES. DRIP PANS SHALL BE SUSPENDED FROM THE PIPING SERVED AND SHALL SLOPE AT A MINIMUM 1/8"/FT. DRIP PANS SHALL DISCHARGE WITH MIN. 1-1/2" DR TO FLOOR DRAINS.
- A. DO NOT LOCATE PIPING DIRECTLY ABOVE ANY ELECTRICAL EQUIPMENT IN ELECTRICAL ROOMS.

STRUCTURE:

1. DO NOT PENETRATE STRUCTURAL MEMBERS. ALL EQUIPMENT SUPPORTS SHALL BE ATTACHED TO THE LOAD BEARING MEMBERS OF STRUCTURAL ELEMENTS. DO NOT OVER-STRESS ANY STRUCTURAL MEMBERS. CONTACT STRUCTURAL ENGINEER FOR ALLOWABLE LOADS FOR SPECIFIC MEMBERS.
2. DO NOT UTILIZE POWER DRIVEN ANCHORS FOR ANY LOCATIONS WHICH REQUIRE THE LOAD TO BE HELD IN TENSION. SEE STRUCTURAL DIVISION FOR ADDITIONAL RESTRICTIONS.
3. SEE ALSO STRUCTURAL DIVISION FOR ACCEPTABLE ANCHORING AND SUPPORT MEANS, METHODS, AND LOCATIONS.
4. PROVIDE FLEXIBLE CONNECTORS, EXPANSION LOOPS, EXPANSION JOINTS, ADDITIONAL FITTINGS OR EQUIVALENT TO ACCOMMODATE THE THERMAL EXPANSION OF THE BUILDING THROUGH STRUCTURAL EXPANSION JOINTS. PROVIDE SUCH FITTING AT EVERY PIPE, DUCT, CONDUIT, ETC. CROSSING OF A STRUCTURAL EXPANSION JOINT.

FIRE PROTECTION NOTES:

1. FIRE PROTECTION NOTES

A. SUBMIT SHOP DRAWINGS SHOWING PROPOSED LAYOUT OF FIRE PROTECTION SYSTEM. DRAWINGS SHALL SHOW ACTUAL EQUIPMENT TO BE USED, DIMENSIONS AND HYDRAULIC CALCULATIONS. SHOP DRAWINGS SHALL BE APPROVED BY THE LOCAL AUTHORITY HAVING JURISDICTION PRIOR TO SUBMITTAL TO ENGINEER OR ARCHITECT.

B. SHOW THE CONNECTING MAIN AND BRANCH PIPE SIZES FOR ALL RELOCATED EXISTING SPRINKLER HEADS.

C. CONFORM TO HAZARD OCCUPANCY REQUIREMENTS OF NFPA 13.

2. THE ENTIRE BUILDING SHALL BE SERVED BY EXISTING GONDOLA SQUARE GLYCOL FIRE SPRINKLER SYSTEM. COORDINATE ELECTRICAL, FIRE PROTECTION AND MECHANICAL SPACE REQUIREMENTS CAREFULLY BEFORE PROCEEDING WITH INSTALLATION.

3. EXTEND THE EXISTING SPRINKLER SYSTEM, RELOCATE EXISTING AND ADD NEW SPRINKLER HEADS IN ACCORDANCE WITH NFPA 13, ALL APPLICABLE CODES AND ORDINANCES AND PROJECT REQUIREMENTS TO COMPLETELY PROTECT THE NEW WORK.

4. SYSTEM SHALL BE INSTALLED COMPLETE AND OPERATIONAL, INCLUDING WATER FLOW INDICATOR, CONNECTIONS TO EXISTING ALARM, DRAIN PIPING, IDENTIFICATION SIGNS, ETC.

5. WORK SHALL BE PERFORMED BY A QUALIFIED FIRE SPRINKLER INSTALLER WITH A MINIMUM OF (5) FIVE YEARS EXPERIENCE IN SIMILAR INSTALLATIONS.

6. COORDINATE ALL WORK WITH ALL OTHER TRADES.

FIRE STOPPING:

1. FIRE STOPPING REQUIREMENT: PENETRATIONS THROUGH RATED WALLS AND FLOORS SHALL BE SEALED WITH A MATERIAL, CAPABLE OF PREVENTING THE PASSAGE OF FLAMES AND HOT GASSES WHEN SUBJECTED TO THE REQUIREMENTS OF THE TEST STANDARD SPECIFIC FOR FIRE STOPS ASTM-E-814. ACCEPTANCE MATERIALS INCLUDE: DOW CORNING RTV FIRE STOP FOAM FOR BARE PIPE, METAL CONDUIT, AND ELECTRICAL CABLE; 3M FIRE DAM 21,22 AND 230 CALULK FOR BARE PIPE, METAL CONDUIT, AND BUILDING CONSTRUCTION; GAPS 3M FS-195 INTUMESCENT STRIPS FOR INSULATED PIPES, PLASTIC PIPE OR CONDUIT, AND ELECTRICAL CABLE.

CONSTRUCTION VENTILATION:

1. WHERE EXISTING OR NEW MECHANICAL SYSTEMS ARE USED FOR TEMPORARY VENTILATION OR CLIMATE CONTROL, MECHANICAL EQUIPMENT INSTALLER SHALL PROVIDE CONSTRUCTION FILTERS, MAINTAIN EQUIPMENT, AND CLEAN, ADJUST AND PUT IN NEW CONDITION BEFORE BUILDING OCCUPANCY. PARTS AND LABOR WARRANTY SHALL NOT BE CONSIDERED TO START UNTIL ACCEPTANCE OF SYSTEM BY OWNER.
2. PROVIDE CONSTRUCTION FILTERS INSTALLED AT ALL AIR MOVING DEVICES THROUGHOUT THE CONSTRUCTION. REMOVE FILTERS ONLY FOR BALANCING AND FINAL TUNOVER. INSPECT ALL NON-CONSTRUCTION FILTERS AND REPLACE ALL THOSE DEEMED NECESSARY BY THE ENGINEER PRIOR TO ACCEPTANCE OF THE SYSTEM BY THE OWNER.

Seal / Signature



Project Name

Steamboat Base Village
Redevelopment

Project Number

003.7835.000

Description


MECHANICAL GENERAL NOTES

Scale

1/8" = 1'-0"

BUILDING A RETAIL LOCAL AREA CONTROLLER:


- A. THE BUILDING A RETAIL SPACE SHALL BE PROVIDED WITH A LOCAL AREA CONTROLLER WITH TOUCHSCREEN INTERFACE. THE LOCAL AREA CONTROLLER SHALL CONTROL THE VENTILATION SUPPLY FAN, THE EXHAUST FAN, THE VENTILATION DUCT HEATER, AND ALL FAN COIL UNITS SERVED BY THE ASSOCIATED VENTILATION SUPPLY FAN.
- B. THE INTENT OF THE LOCAL AREA CONTROLLER IS TO OPERATE ALL EQUIPMENT SERVING THE AREA SIMULTANEOUSLY IN OCCUPIED MODE FOR THE PURPOSE OF AIRFLOW BALANCING. THE LOCAL AREA CONTROLLER SHALL DETERMINE OCCUPIED AND UNOCCUPIED MODE SCHEDULE.
- C. OCCUPIED MODE: WHEN THE LOCAL AREA CONTROLLER IS IN OCCUPIED MODE, THE VENTILATION SUPPLY FAN SHALL START, THE VENTILATION DUCT HEATER SHALL BE ENABLED, THE EXHAUST FAN SHALL START, AND ALL FAN COIL UNITS SERVED BY THE VENTILATION SUPPLY FAN SHALL ENTER OCCUPIED MODE.
- D. UNOCCUPIED MODE: WHEN THE LOCAL AREA CONTROLLER IS IN UNOCCUPIED MODE, THE VENTILATION SUPPLY FAN SHALL STOP, THE VENTILATION DUCT HEATER SHALL BE DISABLED, THE EXHAUST FAN SHALL STOP, AND ALL FAN COIL UNITS SERVED BY THE VENTILATION SUPPLY FAN SHALL ENTER UNOCCUPIED MODE.
- E. NIGHT SETBACK MODE: WHEN THE AREA CONTROLLER IS UNOCCUPIED MODE, THE VENTILATION SUPPLY FAN SHALL REMAIN STOPPED, THE VENTILATION DUCT HEATER SHALL BE DISABLED, THE EXHAUST FAN SHALL REMAIN STOPPED, AND ALL FAN COIL UNITS SERVED BY THE VENTILATION SUPPLY FAN SHALL BE ALLOWED TO CYCLE BASED ON TEMPERATURE IN EACH INDIVIDUAL ZONE.
- F. OCCUPIED AND UNOCCUPIED MODE SCHEDULING AND SETPOINT ADJUSTMENT SHALL BE CAPABLE OF BEING PROGRAMMED AT THE LOCAL AREA CONTROLLER VIA A TOUCHSCREEN INTERFACE LOCATED WITHIN THE STORAGE ROOM. SCHEDULES SHALL BE CAPABLE OF CONFORMING TO AN HOUR BY HOUR OCCUPANCY SCHEDULE INCLUDING UP TO ONE FULL YEAR OF HOUR BY HOUR SCHEDULING.

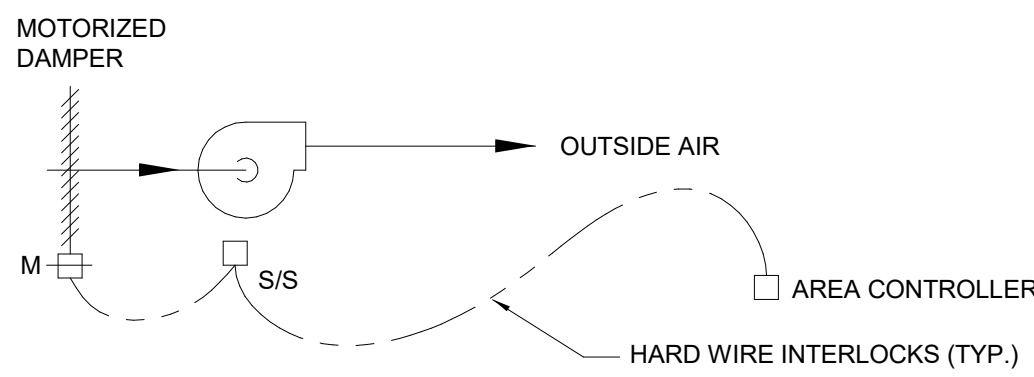

VENTILATION SUPPLY FAN CONTROL

NONE


- A. UPON START SIGNAL FROM ASSOCIATED AREA CONTROLLER, ENERGIZE FAN AND OPEN OUTSIDE AIR MOTORIZED DAMPER. FAN SHALL OPERATE CONTINUOUSLY WHEN IN OCCUPIED MODE. UPON STOP SIGNAL FROM ASSOCIATED AREA CONTROLLER, DE-ENERGIZE FAN AND CLOSE MOTORIZED DAMPER.

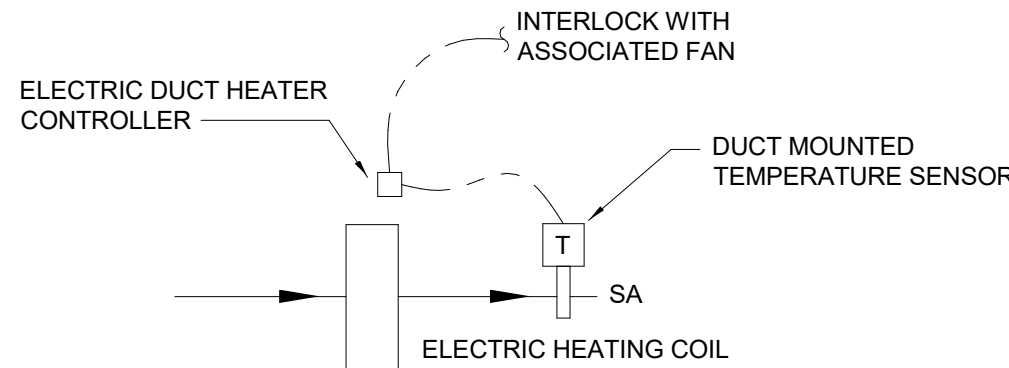

ELECTRIC DUCT HEATER CONTROL

NONE


- A. INTERLOCK ELECTRIC DUCT HEATER WITH VENTILATION SUPPLY FAN SERVING SAME AREA. ENERGIZE DUCT HEATER AND MODULATE TO MAINTAIN VENTILATION SUPPLY AIR TEMPERATURE OF 50F (ADJ.). DUCT HEATER SHALL BE ENABLED ONLY WHEN SUPPLY FAN IS OPERATING.

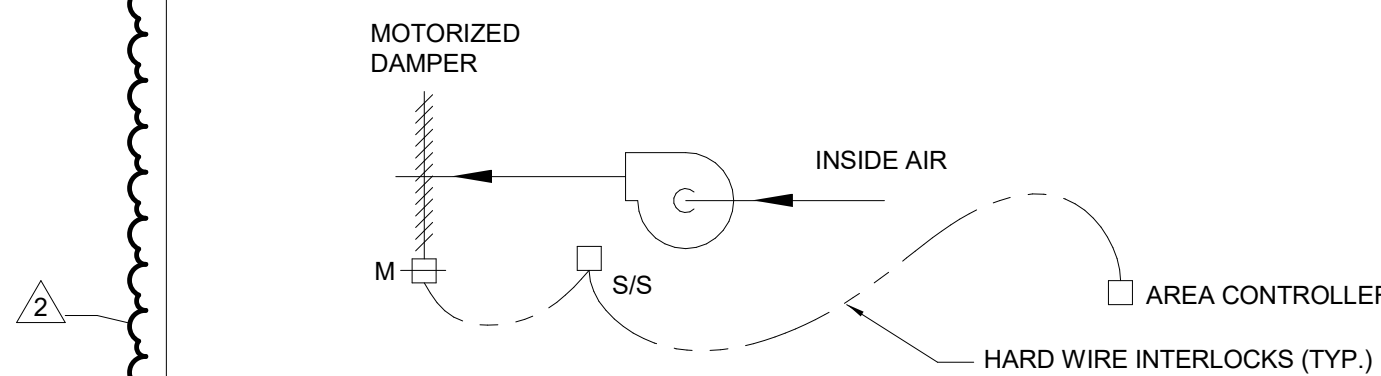

EXHAUST FAN CONTROL

NONE

- A. MOTORIZED DAMPER SHALL OPEN AND FAN SHALL BE ENERGIZED VIA SIGNAL FROM LOCAL AREA CONTROLLER.

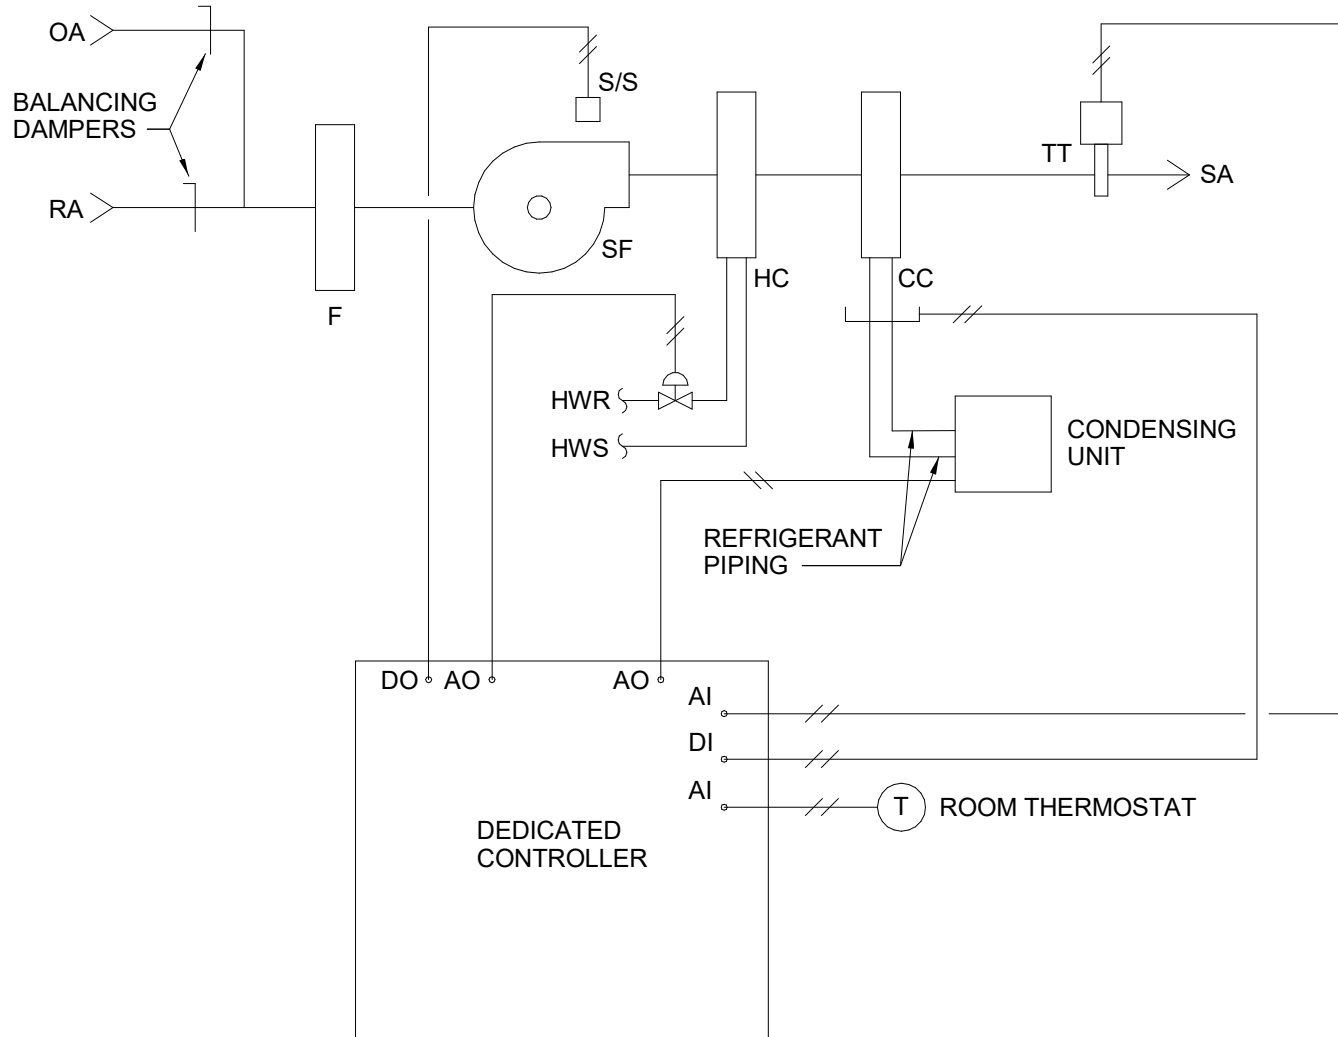


BUILDING A RETAIL FAN COIL UNIT CONTROL

NONE

SEQUENCE OF OPERATION:

- A. GENERAL:
- THE FOLLOWING SEQUENCE OF OPERATION INCLUDES REQUIRED FUNCTIONALITY OF THE FAN COIL UNIT. POINTS REQUIRED TO EXECUTE THIS SEQUENCE SHALL BE COORDINATED BETWEEN THE EQUIPMENT PROVIDER AND TEMPERATURE CONTROLS CONTRACTOR PRIOR TO THE START OF CONSTRUCTION. SUBMIT LIST OF ITEMS TO BE PROVIDED BY THE TEMPERATURE CONTROLS CONTRACTOR IN ORDER TO EXECUTE THIS SEQUENCE.
 - UNIT SHALL BE PROVIDED WITH A LOCAL THERMOSTAT WITH CONNECTION TO THE LOCAL AREA CONTROLLER.
- B. OCCUPIED MODE:
- WHEN THE FCU IS IN THE OCCUPIED MODE, THE SUPPLY FAN SHALL OPERATE CONTINUOUSLY. THE SUPPLY FAN SHALL UTILIZE MULTI-SPEED FAN CONTROL. COOLING AND HEATING SHALL MODULATE IN SEQUENCE TO MAINTAIN SPACE TEMPERATURE SETPOINT.
 - THE FAN COIL UNITS SERVING THE RETAIL SPACE ARE PROVIDED WITH A COMMON OUTSIDE AIR LOUVER AND MOTORIZED DAMPER AND COMMON RELIEF AIR LOUVER AND MOTORIZED DAMPER. EACH FAN COIL UNIT SHALL ENTER OCCUPIED MODE OR UNOCCUPIED MODE UPON SIGNAL FROM THE ASSOCIATED LOCAL AREA CONTROLLER. THE LOCAL AREA CONTROLLER SHALL BE CONFIGURED SO THAT BOTH FCUs FOLLOW THE SAME OCCUPIED/UNOCCUPIED SCHEDULE AT ALL TIMES.
- C. UNOCCUPIED MODE:
- WHEN THE FCU ENTERS UNOCCUPIED MODE THE SUPPLY FAN SHALL BE OFF, COOLING SHALL BE DISABLED, AND HEATING CONTROL VALVE SHALL CLOSE.
 - SPACE TEMPERATURE SHALL BE SETBACK AND MAINTAINED BELOW A 5F (ADJ.) OFFSET TO OCCUPIED MODE COOLING SETPOINT AND ABOVE A 10F (ADJ.) OFFSET TO OCCUPIED MODE HEATING SETPOINT.
 - WHEN COOLING IS REQUIRED IN THE SPACE, THE SUPPLY FAN SHALL CYCLE ON AND COOLING SHALL MODULATE TO MAINTAIN SPACE TEMPERATURE.
 - WHEN HEATING IS REQUIRED IN THE SPACE, THE SUPPLY FAN SHALL CYCLE ON AND HEATING SHALL MODULATE TO FULL.
 - UPON SPACE TEMPERATURE REACHING UNOCCUPIED MODE SETPOINT, UNIT SHALL CYCLE OFF.
- D. FAN SAFETY CONTROLS:
- DE-ENERGIZE THE SUPPLY FAN WHENEVER THE OVERFLOW SENSOR HAS TRIPPED. MANUAL RESET REQUIRED.
- E. HEATING CONTROL:
- BASEBOARD HEATING SHALL ACT AS THE FIRST STAGE OF HEATING CONTROL. REFER TO BASEBOARD CONTROL DIAGRAM.
 - THE FCU HEATING CONTROL VALVE SHALL MODULATE TO MAINTAIN DISCHARGE AIR TEMPERATURE TO NO LOWER THAN 70F WHEN IN HEATING MODE. ONCE BASEBOARD CONTROL VALVES HAVE FULLY OPENED, FCU HEATING CONTROL VALVE SHALL ACT AS SECOND STAGE HEATING AND SHALL MODULATE TO MAINTAIN SPACE TEMPERATURE SETPOINT. HEATING CONTROL VALVE SHALL CLOSE IF THE FANS ARE OFF.
- F. COOLING CONTROL:
- THE COOLING SHALL MODULATE TO MAINTAIN SPACE TEMPERATURE. COOLING SHALL BE DISABLED IF THE FANS ARE OFF.

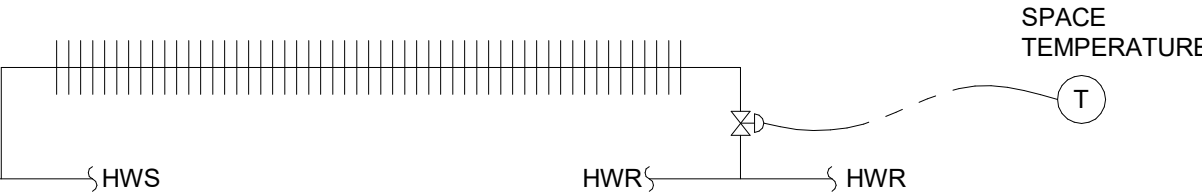

BUILDING A HYDRONIC FIN TUBE CONTROL

NONE

- A. BASEBOARD HEATING SHALL ACT AS FIRST STAGE HEATING. REFER TO FAN COIL UNIT SEQUENCE. 2-WAY MODULATING CONTROL VALVE SHALL OPEN TO MAINTAIN SPACE TEMPERATURE HEATING SETPOINT.

CONTROL LEGEND

ABBR DESCRIPTION	ABBR DESCRIPTION	ABBR DESCRIPTION
AI ANALOG INPUT	FR FREEZESTAT	PHC PREHEAT COIL
AO ANALOG OUTPUT	FRN FURNACE	PT PRESSURE TRANSMITTER
BDD BACKDRAFT DAMPER	FS FLOW SWITCH	PZ PIEZOMETER RING
BTU BTU METER	FSCP FIREFIGHTER SMOKE	RA RETURN AIR
C CONTROLLER	FSPD FAN SPEED	RF RETURN FAN
CC COOLING COIL	FT FLOW TRANSMITTER	S SPACE TEMPERATURE SENSOR
CD CONTROL DAMPER	H HUMIDITY OR HIGH	S/S START/STOP
CPM AIRFLOW MEASURING SENSOR	HC HEATING COIL	SA SUPPLY AIR
CHR CHILLED WATER RETURN	HL HIGH LIMIT HUMIDITY SWITCH	SC SPEED CONTROL
CHS CHILLED WATER SUPPLY	HS HUMIDITY SENSOR	SD SMOKE DETECTOR
CO2 CARBON DIOXIDE	HT HUMIDITY TRANSMITTER	SF SUPPLY FAN
COND CONDENSATE OVERFLOW	HWR HOT WATER RETURN	SPT STATIC PRESSURE TRANSMITTER
COV CHANGE OF VALUE	HWS HOT WATER SUPPLY	SR SWITCHING RELAY
CSEN CURRENT SENSOR	I INTERLOCK RELAY	T THERMOSTAT
DI DIGITAL INPUT	L LEVEL OR LOW	TM THERMAL MASS METER
DO DIGITAL OUTPUT	LAN LOCAL AREA NETWORK	TO TIMED OVERIDE SWITCH
DP DIFFERENTIAL PRESSURE	M MOTORIZED CONTROL	TS TEMPERATURE SENSOR
EA EXHAUST AIR	MIN MINIMUM	TT TEMPERATURE TRANSMITTER
ES END SWITCH	ND NITROGEN DIOXIDE	TTAB TEMPERATURE TRANSMITTER
F FILTER ASSEMBLY OR FAIL	OA OUTSIDE AIR	V VALVE
FACP FIRE ALARM CONTROL PANEL	OS OCCUPANCY SENSOR	VFD VARIABLE FREQUENCY DRIVE
FAS FIRE ALARM SYSTEM	P SPACE STATIC PRESSURE	VP VIRTUAL POINT
FC FAIL CLOSED	P-E PNEUMATIC ELECTRIC SWITCH	VS VELOCITY SENSOR
FCU FAN COIL UNIT		WBT WET BULB TEMPERATURE TRANSMITTER
FM FLOW METER		
FO FAIL OPEN		

CONTROL SYSTEM GENERAL NOTES:

DESIGN INTENT:

- A. THE CONTROL DRAWINGS AND SEQUENCES ARE PROVIDED TO COMMUNICATE A DESIGN INTENT FOR CONTROL OF INDICATED SYSTEMS. ALTERNATIVE CONTROL METHODS MAY BE USED WHERE PRACTICAL OR WHERE NECESSARY TO MEET REQUIRED SYSTEM PERFORMANCE. WHERE ALTERNATIVE CONTROL METHODS ARE USED TO MEET THE DESIGN INTENT, THESE METHODS SHALL BE INDICATED IN SUBMITTAL TO ENGINEER FOR EVALUATION. ENGINEER SHALL DETERMINE IF A SUBMITTED ALTERNATIVE CONTROL METHOD MEETS THE DESIGN INTENT.
- B. ALTHOUGH THE MECHANICAL DRAWINGS MAY INDICATE A PRODUCT AS BASIS OF DESIGN, THE CONTROL DRAWINGS AND SEQUENCES ARE PROVIDED TO INDICATE A DESIGN INTENT FOR THE COMPLETE SYSTEM THAT IS APPLICABLE TO MULTIPLE POTENTIAL PRODUCTS OR MANUFACTURERS. CONTROL METHODS SHALL BE DEVELOPED BY THE TEMPERATURE CONTROLS CONTRACTOR AND/OR EQUIPMENT PROVIDER IN ORDER TO ACHIEVE THE REQUIRED SYSTEM PERFORMANCE.

REQUIRED COORDINATION:

- A. THE DIVISION 23 CONTRACTOR SHALL BE RESPONSIBLE FOR COORDINATION BETWEEN EQUIPMENT PROVIDERS AND TEMPERATURE CONTROLS CONTRACTOR IN ORDER TO FULLY SATISFY THE DESIGN INTENT. INTERFACE BETWEEN CONTROL SYSTEMS, INCLUDING ITEMS PROVIDED BY EACH ENTITY, COMMUNICATION PROTOCOL, SIGNAL TYPE, ETC., SHALL BE COORDINATED PRIOR TO RELEASE OF EQUIPMENT FOR PRODUCTION.
- B. THE TEMPERATURE CONTROLS CONTRACTOR SHALL PROVIDE SUBMITTAL DRAWINGS AND PRODUCT DATA FOR THE ENTIRE CONTROL SYSTEM TO ENGINEER FOR REVIEW. THE TEMPERATURE CONTROLS SUBMITTAL SHALL DISTINGUISH WHERE SPECIFIC SEQUENCE ELEMENTS ARE PROVIDED WITHIN THE BOILER PLANT CONTROL SYSTEM OR WITHIN PACKAGED EQUIPMENT CONTROLLERS. RE: SPECIFICATIONS FOR REQUIREMENTS.
- C. REFER TO SPECIFICATION SECTION 23 05 01 MECHANICAL AND ELECTRICAL COORDINATION.

SEQUENCE OF OPERATION GENERAL NOTES:

GENERAL:

- A. IN THE EVENT OF A POWER OUTAGE OR OTHER MALFUNCTION, THE CURRENTLY ENABLED CONTROLS SEQUENCES SHALL BE MAINTAINED. RE: SPECIFICATIONS.

OCCUPANCY SCHEDULES:

- A. THE FOLLOWING SPECIAL OCCUPANCY SCHEDULE MODES ARE HEREBY DEFINED:
- OCCUPIED MODE
 - UNOCCUPIED MODE

INITIAL SPACE THERMOSTAT SETPOINTS

- A. INITIAL SPACE THERMOSTAT SETPOINTS SHALL BE AS FOLLOWS:
- RETAIL SPACE:
COOLING: 76F
HEATING: 70F

Seal / Signature



Project Name

Steamboat Base Village
Redevelopment

Project Number

003.7835.000

Description

MECHANICAL CONTROLS

Scale

1/8" = 1'-0"

2B-M0.002

REVIEWED
FOR
CODE
COMPLIANCE
09/23/2022

GENERAL NOTES:

1. THE DRAWINGS ARE DIAGRAMMATIC IN NATURE. THE CONTRACTOR IS RESPONSIBLE FOR ALL OFFSETS, TRANSITIONS, ELBOWS, ETC. AS REQUIRED IN DUCTWORK, PIPING, SUPPORTS, ETC. TO COMPLETE THE WORK IN A CLEAN, FUNCTIONAL INSTALLATION THAT IS FULLY COORDINATED WITH ALL OTHER TRADES. ANY PRICING EFFORT SHALL TAKE THESE FACTORS INTO ACCOUNT.
2. MAINTAIN CODE REQUIRED AREA OF SEPARATION FROM OUTSIDE AIR INTAKES TO TERMINATIONS OF EXHAUST, COMBUSTION AIR, PLUMBING VENTS, ETC.
3. PROVIDE MANUAL BALANCE DAMPERS IN ALL SUPPLY DUCT BRANCH TAPS DOWNSTREAM OF DOWNSTREAM OF VENTILATION FAN.
4. PROVIDE MANUAL BALANCE DAMPERS IN ALL SUPPLY DUCT BRANCH TAPS DOWNSTREAM OF FAN UNITS.
5. PROVIDE MANUAL BALANCE DAMPERS IN ALL EXHAUST DUCT BRANCH TAPS.
6. COORDINATE SPACE TEMPERATURE SENSORS AND THERMOSTAT LOCATIONS TO ALIGN VERTICALLY WITH LIGHT SWITCHES.
7. PROVIDE THROUGH FACE BALANCING FOR ALL DIFFUSERS, REGISTERS, AND GRILLES ABOVE INACCESSIBLE AREAS.
8. INSTALL EXPOSED DUCTWORK AS HIGH AS POSSIBLE.
9. TEMPERATURE CONTROLS CONTRACTOR SHALL SUBMIT PLANS INDICATING ALL SPACE TEMPERATURE SENSORS, T-STATS, ETC. AS PART OF SUBMITTAL PROCESS FOR A/E REVIEW PRIOR TO ROUGH-IN.
10. ALL DUCT/PIPE PENETRATIONS THROUGH FIRE RATED/SMOKE RATED PARTITIONS SHALL BE CAULKED AND SEALED TO MEET THE RATING REQUIRED. REFER TO LIFE SAFETY DRAWINGS FOR FIRE/SMOKE RATING REQUIREMENTS.
11. PROVIDE TURNING VANES IN ALL 90 DEGREE DUCT ELBOWS.
12. PROVIDE ISOLATION VALVES AT EACH BRANCH LINE OFF OF MAINS.
13. PROVIDE 3/4" BRANCH PIPING TO ALL TERMINAL UNITS, UNLESS NOTED OTHERWISE.
14. PROVIDE CONDENSATE DRAIN FROM ALL DX EVAPORATOR COILS TO NEAREST MOP SINK, FLOOR DRAIN, OR APPROVED INDIRECT CONNECTION POINT. PROVIDE CONDENSATE PUMP FOR ALL COOLING UNITS THAT CANNOT BE DRAINED BY GRAVITY TO TERMINATION LOCATION.

KEYNOTES

M2	REMOVE (E) BASEBOARD AND MODIFY (E) PIPING AS REQUIRED TO SERVE (N) BASEBOARD.
M3	REMOVE (E) FAN COIL AND ASSOCIATED SHEET METAL, DIFFUSERS, AND BRANCH PIPING.
M6	DISCONNECT AND DECOMMISSION EXISTING GAS FIREPLACE. REMOVE GAS PIPING BACK TO NEAREST MAIN AND CAP. REMOVE FIREPLACE BURNER AND PREPARE FIREPLACE FOR INFILL.

Date	Description
1 05/20/2022	ISSUE FOR CONSTRUCTION
2 06/27/2022	BULLETIN 1

Seal / Signature



Project Name

Steamboat Base Village
Redevelopment

Project Number

003.7835.000


Description

MECHANICAL PLAN - LEVEL 02


Scale

1/8" = 1'-0"


2B-M1.201

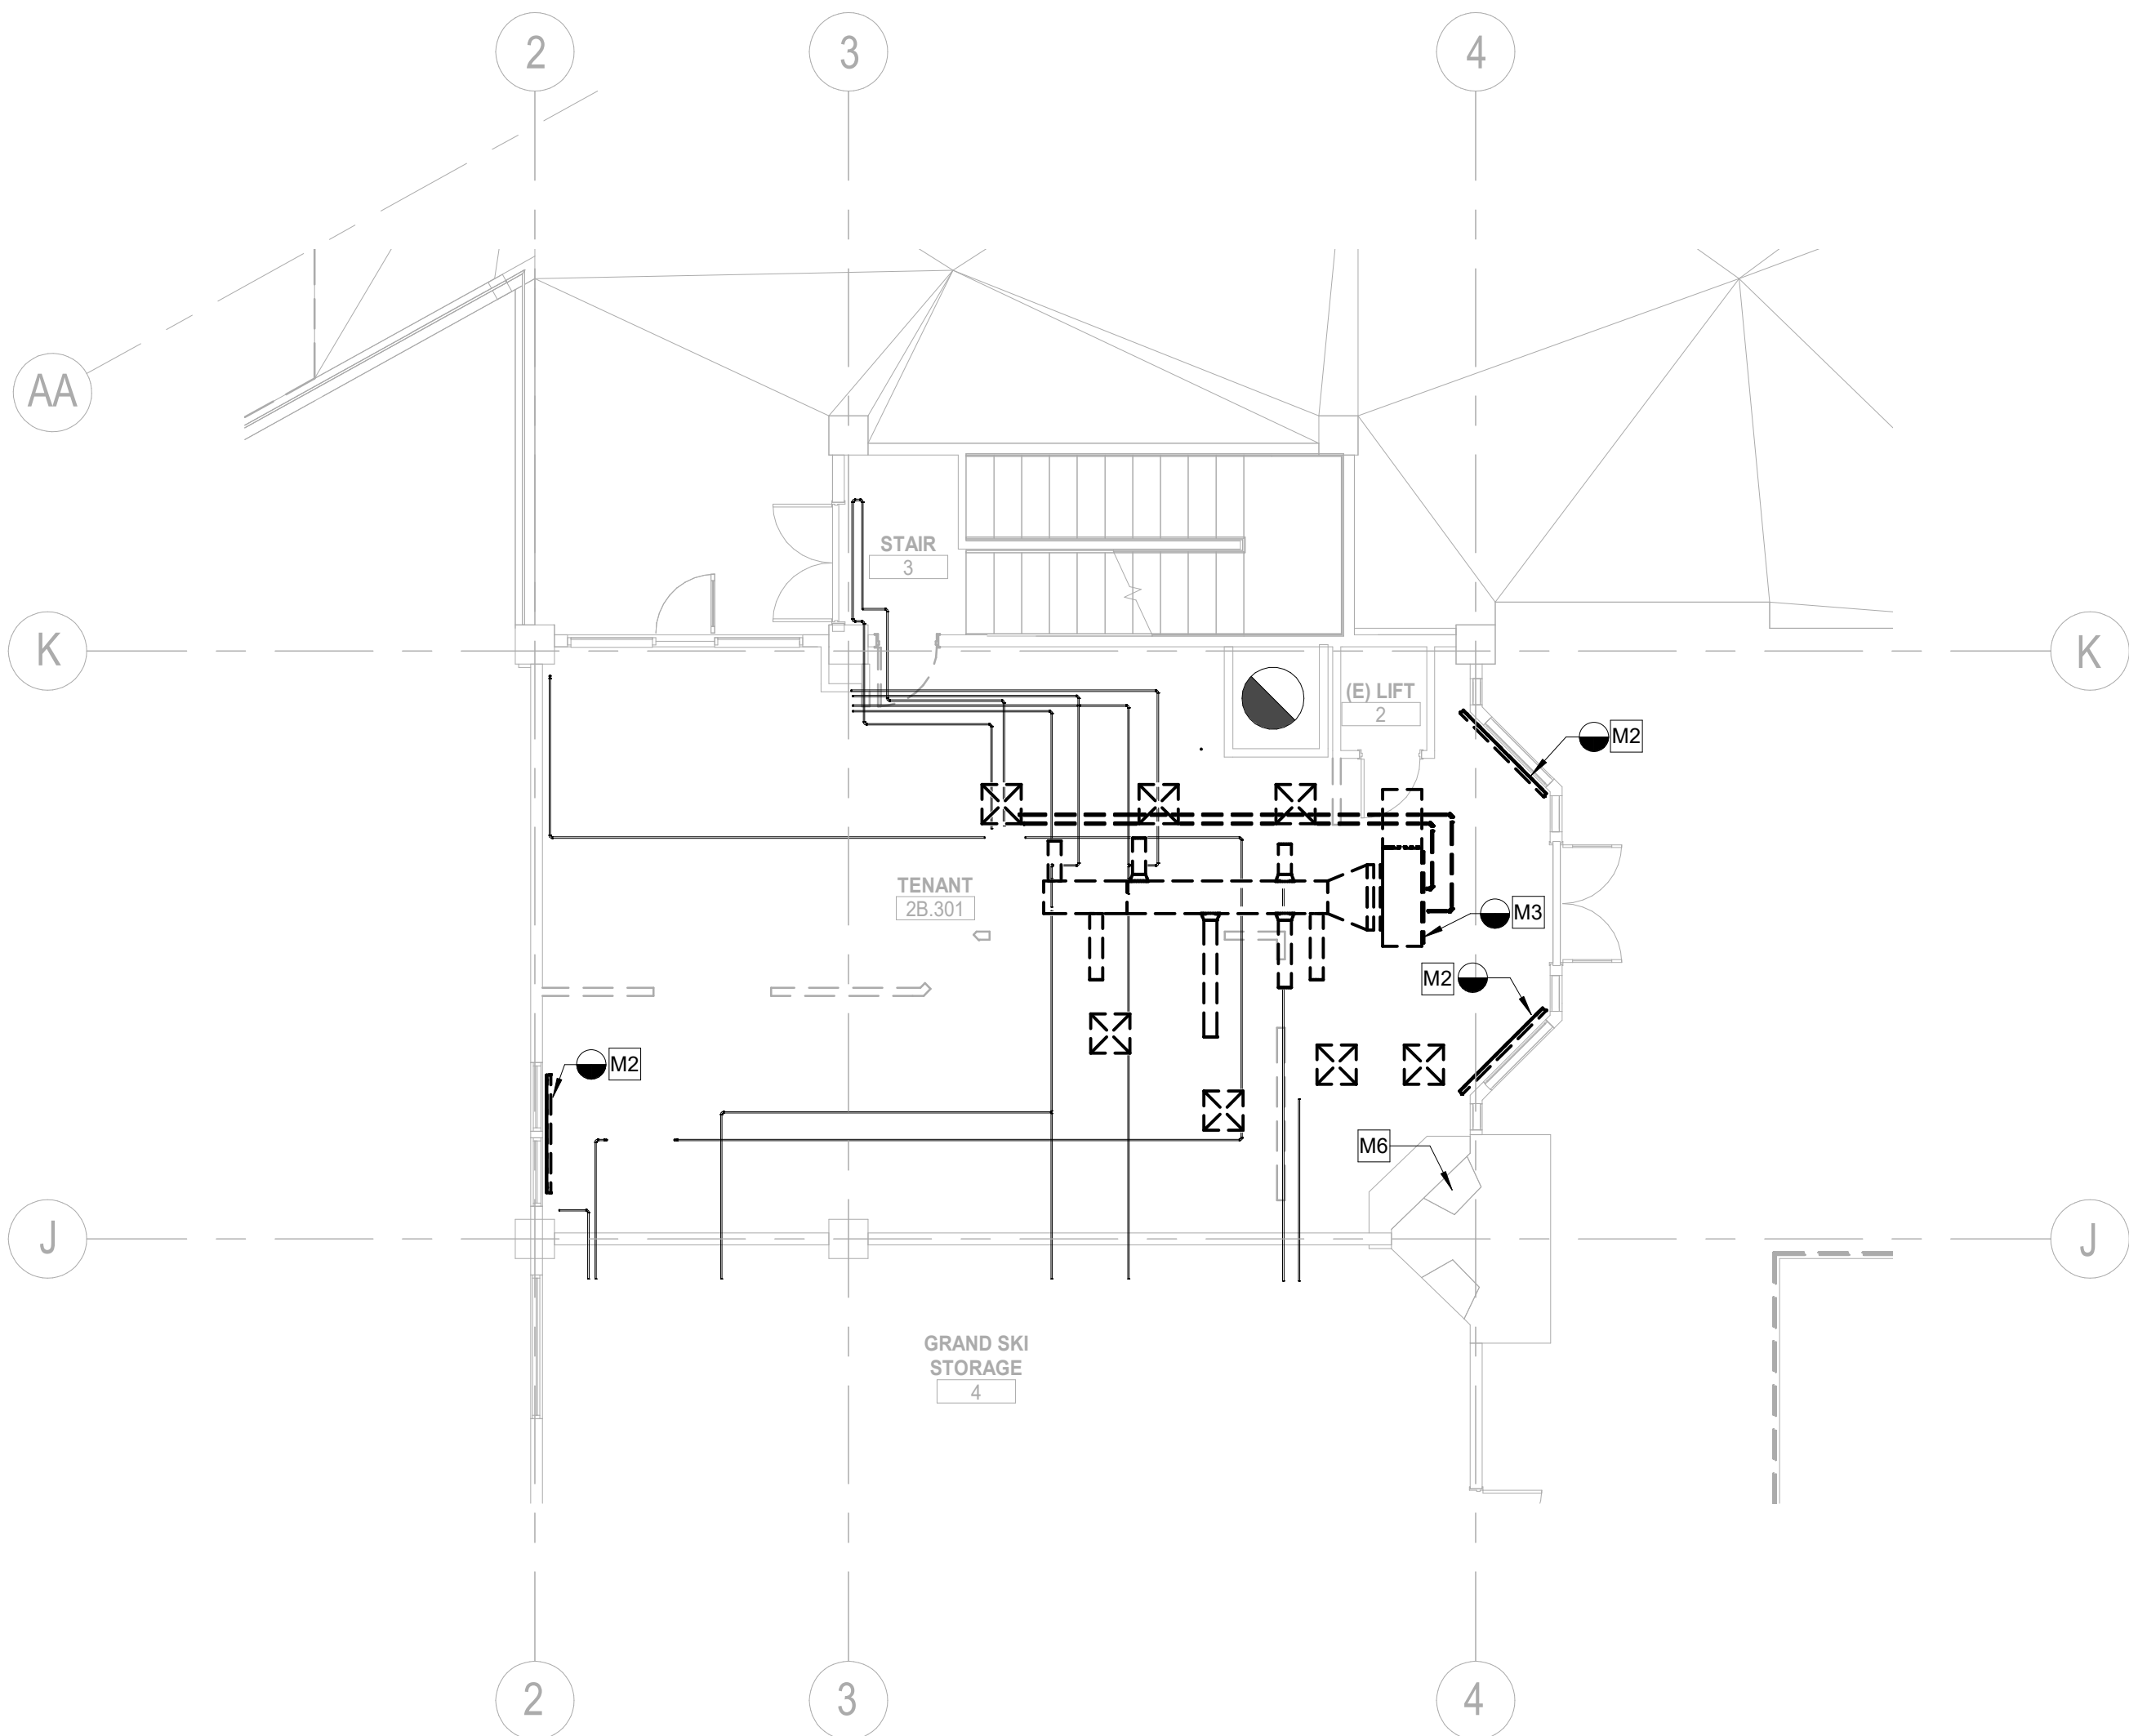

1 MECHANICAL DEMOLITION PLAN - LEVEL 02
SCALE: 1/8" = 1'-0"

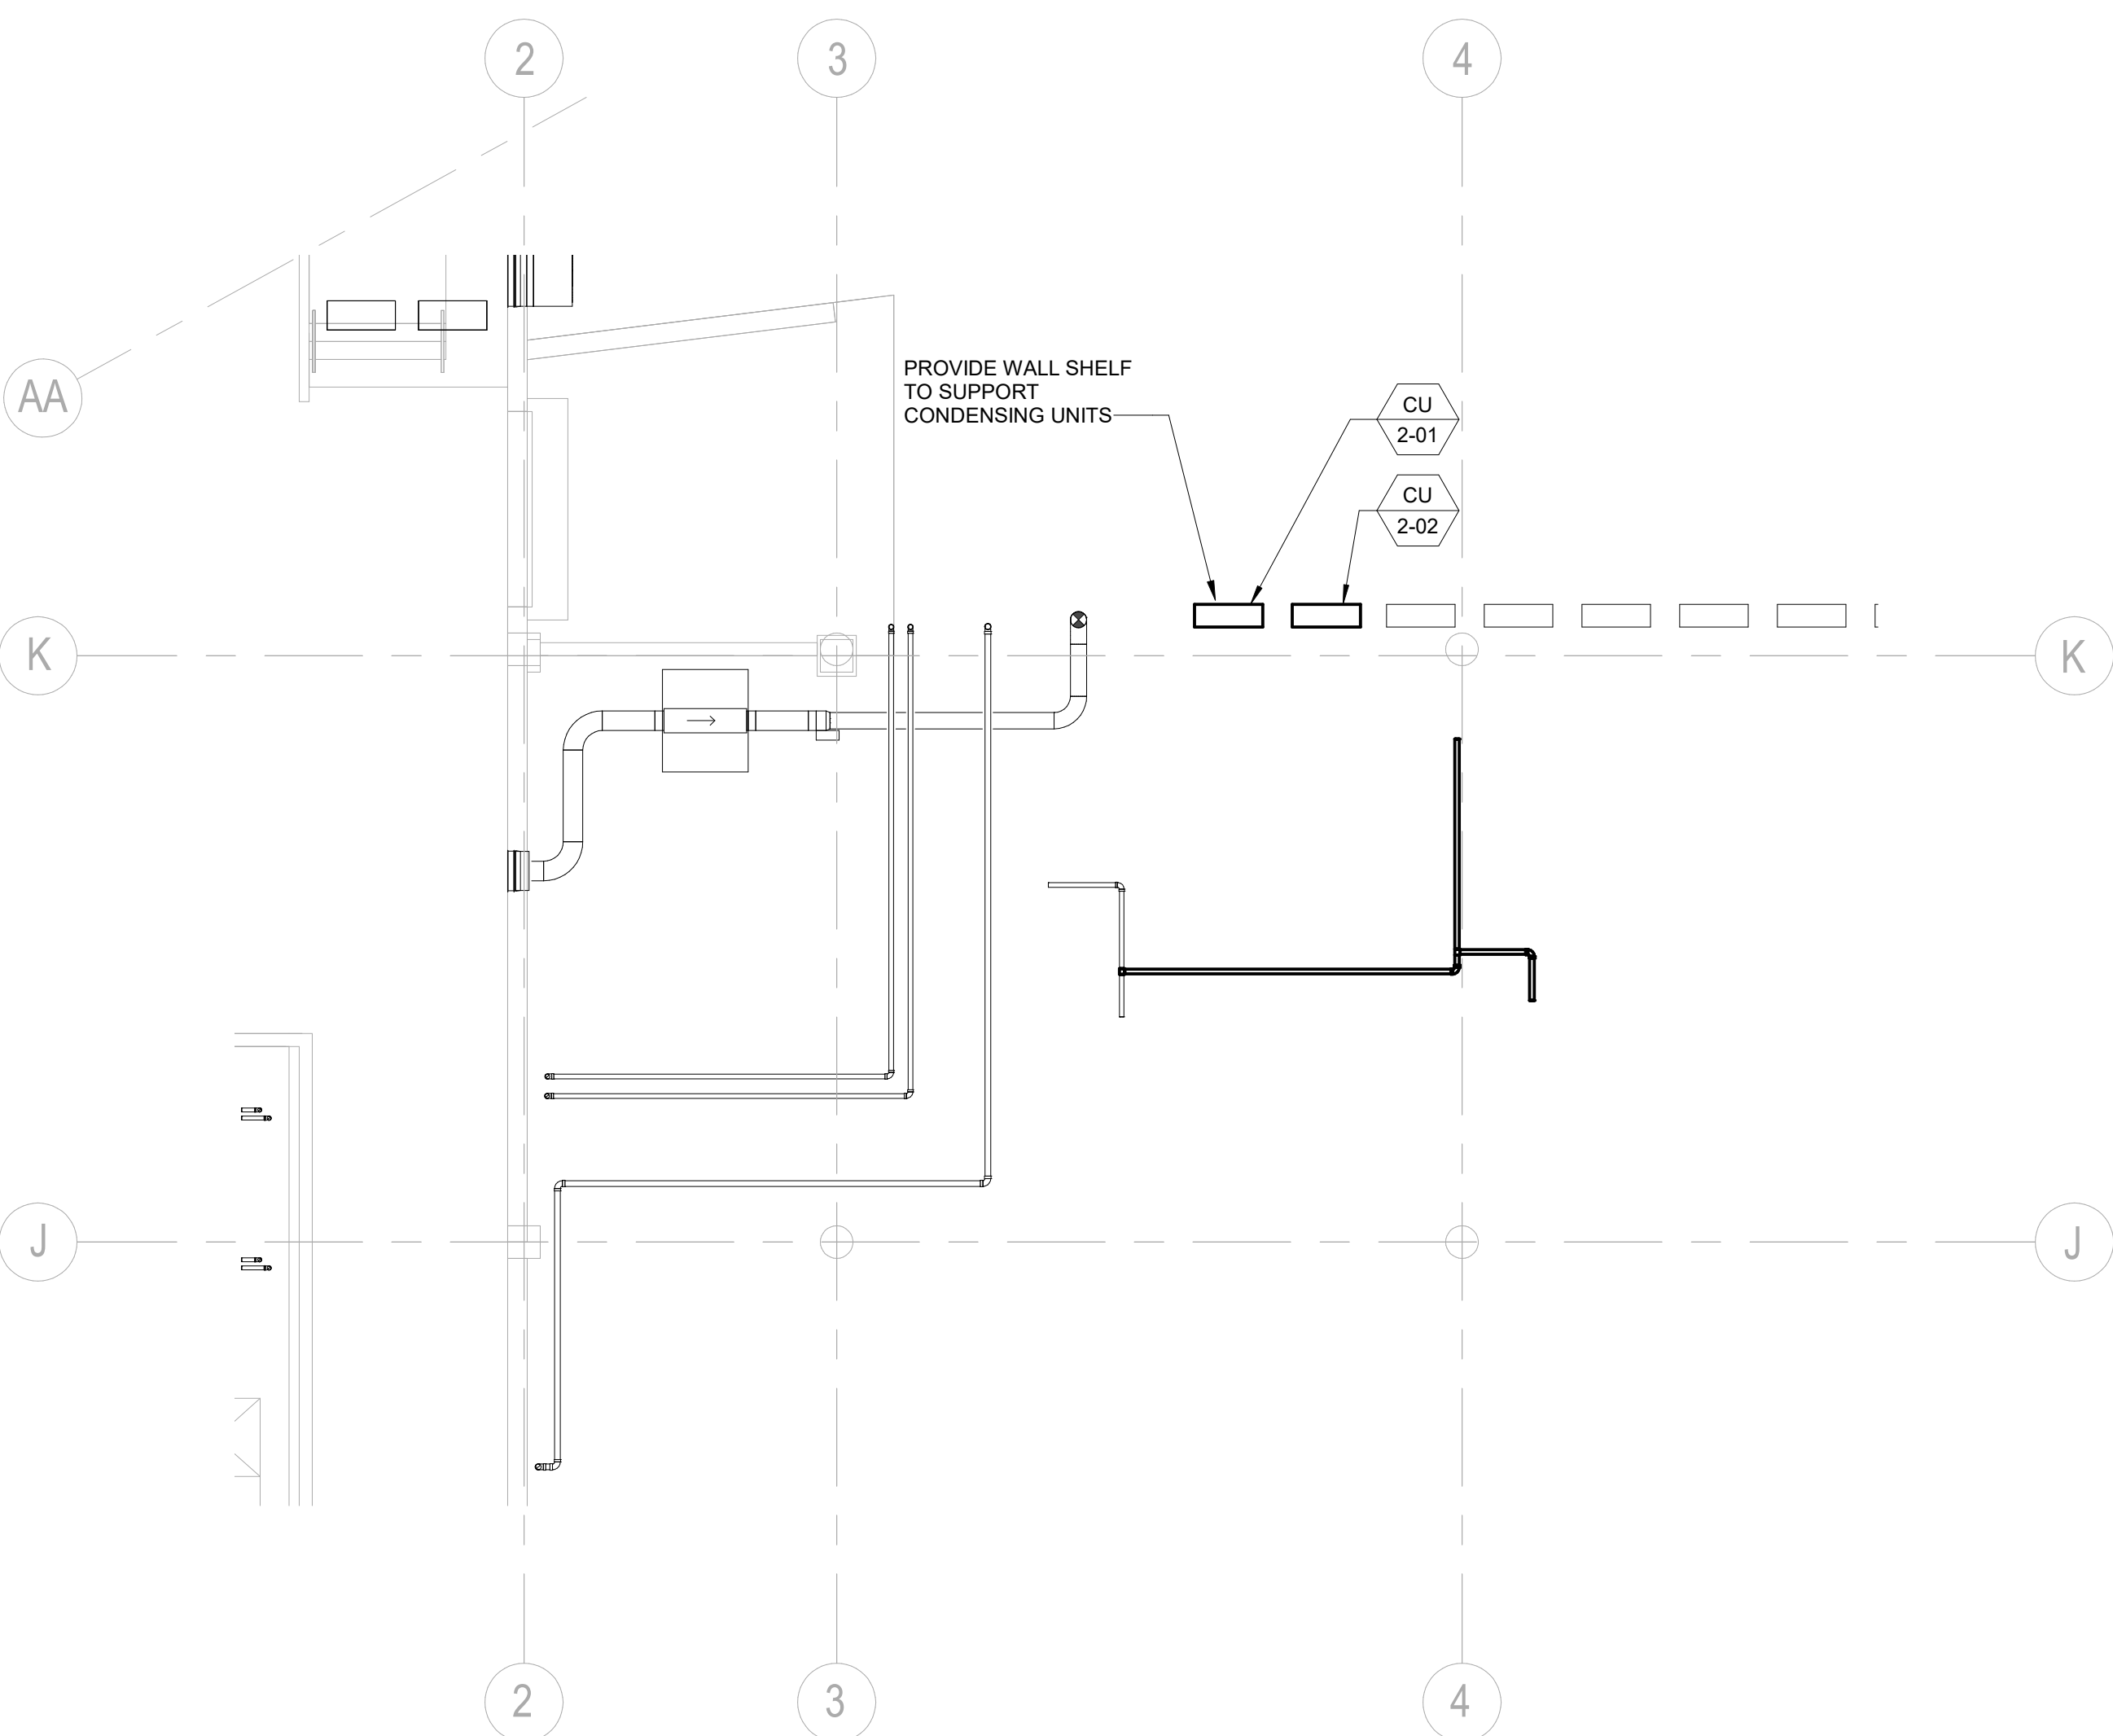


3 MECHANICAL PLAN - PARKING GARAGE
SCALE: 1/8" = 1'-0"

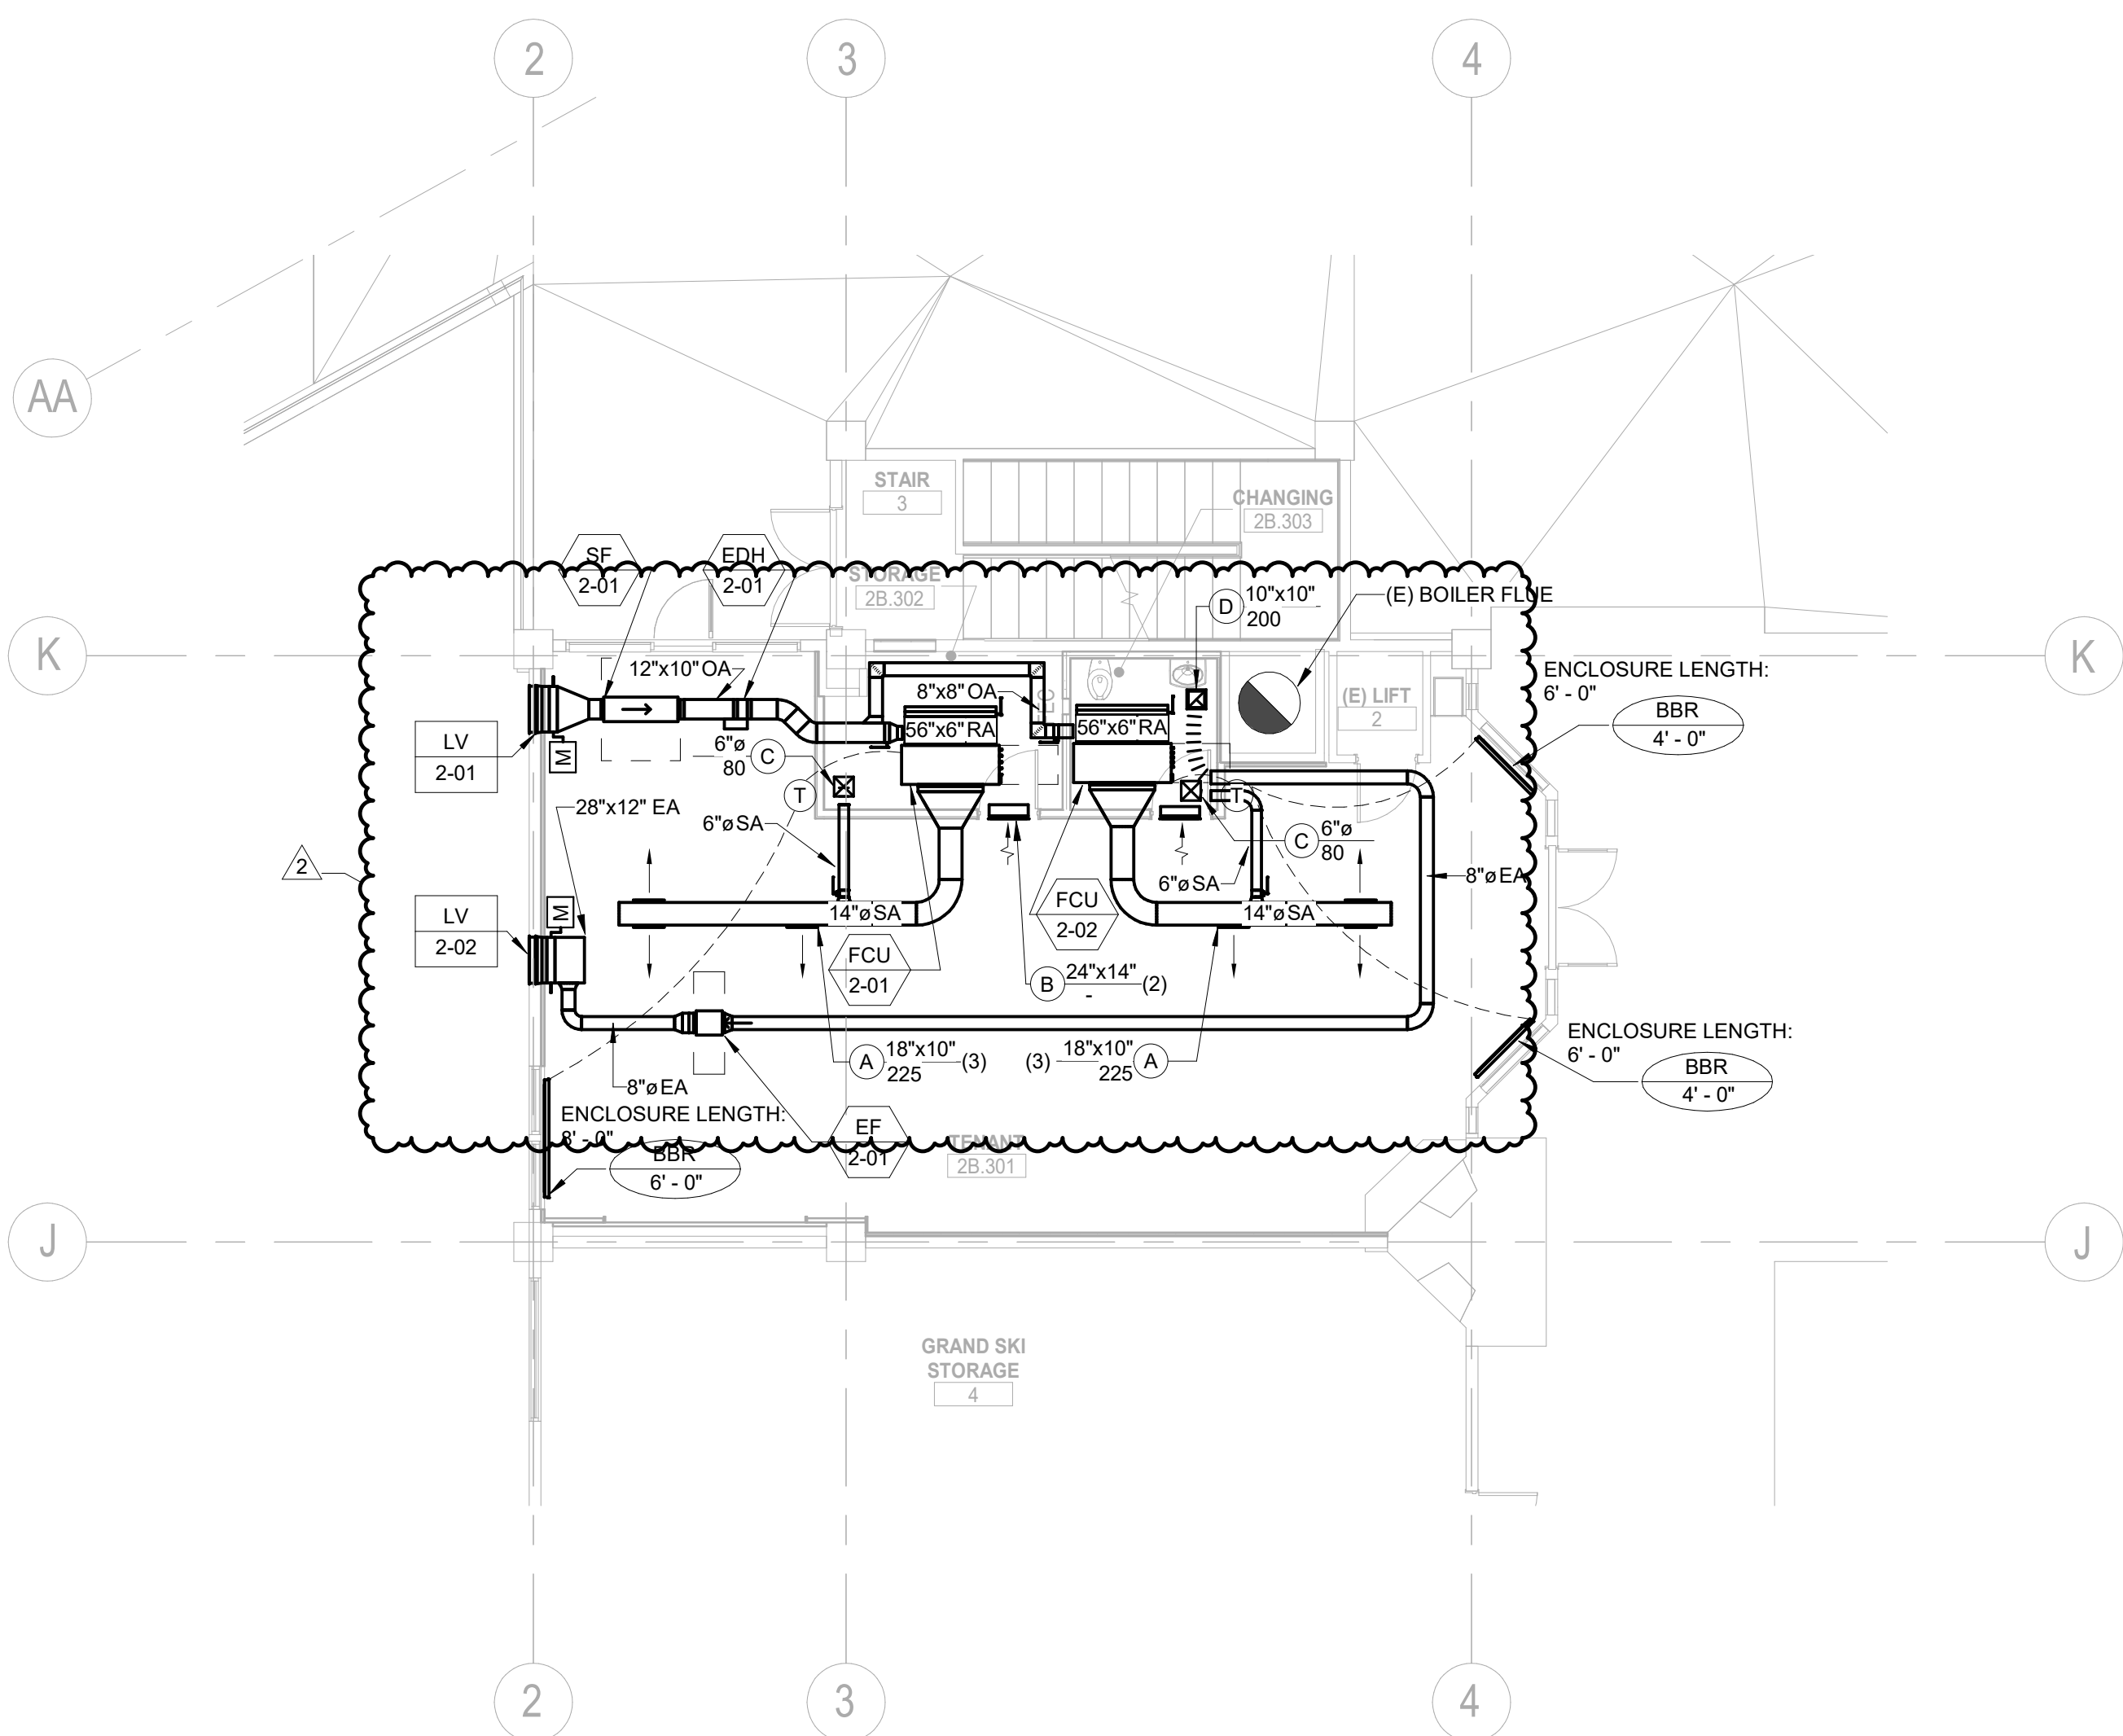

2 MECHANICAL PLAN - LEVEL 02
SCALE: 1/8" = 1'-0"

KEY PLAN

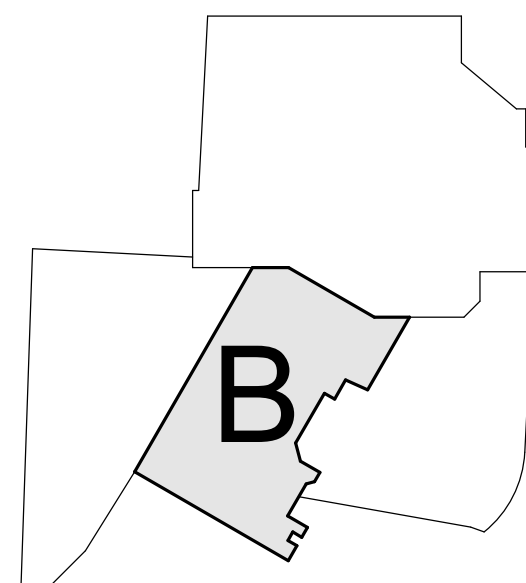

REVIEWED
FOR
CODE
COMPLIANCE
09/23/2022


GENERAL NOTES:

1. THE DRAWINGS ARE DIAGRAMMATIC IN NATURE. THE CONTRACTOR IS RESPONSIBLE FOR ALL OFFSETS, TRANSITIONS, ELBOWS, ETC. AS REQUIRED IN DUCTWORK, PIPING, SUPPORTS, ETC. TO COMPLETE THE WORK IN A CLEAN, FUNCTIONAL INSTALLATION THAT IS FULLY COORDINATED WITH ALL OTHER TRADES. ANY PRICING EFFORT SHALL TAKE THESE FACTORS INTO ACCOUNT.
2. MAINTAIN CODE REQUIRED AREA OF SEPARATION FROM OUTSIDE AIR INTAKES TO TERMINATIONS OF EXHAUST, COMBUSTION AIR, PLUMBING VENTS, ETC.
3. PROVIDE MANUAL BALANCE DAMPERS IN ALL SUPPLY DUCT BRANCH TAPS DOWNSTREAM OF DOWNSTREAM OF VENTILATION FAN.
4. PROVIDE MANUAL BALANCE DAMPERS IN ALL SUPPLY DUCT BRANCH TAPS DOWNSTREAM OF FAN UNITS.
5. PROVIDE MANUAL BALANCE DAMPERS IN ALL EXHAUST DUCT BRANCH TAPS.
6. COORDINATE SPACE TEMPERATURE SENSORS AND THERMOSTAT LOCATIONS TO ALIGN VERTICALLY WITH LIGHT SWITCHES.
7. PROVIDE THROUGH FACE BALANCING FOR ALL DIFFUSERS, REGISTERS, AND GRILLES ABOVE INACCESSIBLE AREAS.
8. INSTALL EXPOSED DUCTWORK AS HIGH AS POSSIBLE.
9. TEMPERATURE CONTROLS CONTRACTOR SHALL SUBMIT PLANS INDICATING ALL SPACE TEMPERATURE SENSORS, T-STATS, ETC. AS PART OF SUBMITTAL PROCESS FOR A/E REVIEW PRIOR TO ROUGH-IN.
10. ALL DUCT/PIPE PENETRATIONS THROUGH FIRE RATED/SMOKE RATED PARTITIONS SHALL BE CAULKED AND SEALED TO MEET THE RATING REQUIRED. REFER TO LIFE SAFETY DRAWINGS FOR FIRE/SMOKE RATING REQUIREMENTS.
11. PROVIDE TURNING VANES IN ALL 90 DEGREE DUCT ELBOWS.
12. PROVIDE ISOLATION VALVES AT EACH BRANCH LINE OFF OF MAINS.
13. PROVIDE 3/4" BRANCH PIPING TO ALL TERMINAL UNITS, UNLESS NOTED OTHERWISE.
14. PROVIDE CONDENSATE DRAIN FROM ALL DX EVAPORATOR COILS TO NEAREST MOP SINK, FLOOR DRAIN, OR APPROVED INDIRECT CONNECTION POINT. PROVIDE CONDENSATE PUMP FOR ALL COOLING UNITS THAT CANNOT BE DRAINED BY GRAVITY TO TERMINATION LOCATION.


KEYNOTES

M2	REMOVE (E) BASEBOARD AND MODIFY (E) PIPING AS REQUIRED TO SERVE (N) BASEBOARD.
M3	REMOVE (E) FAN COIL AND ASSOCIATED SHEET METAL, DIFFUSERS, AND BRANCH PIPING.
M4	(N) 3/4" HEATING HOT WATER PIPING TO BE CONNECTED TO (E) HEATING HOT WATER PIPING IN CEILING SPACE BELOW.
M5	CONNECT (N) FAN COIL HEATING HOT WATER PIPING TO (E) 1-1/2" AND (E) 1-1/4" MAINS.


△	Date	Description
1	05/20/2022	ISSUE FOR CONSTRUCTION

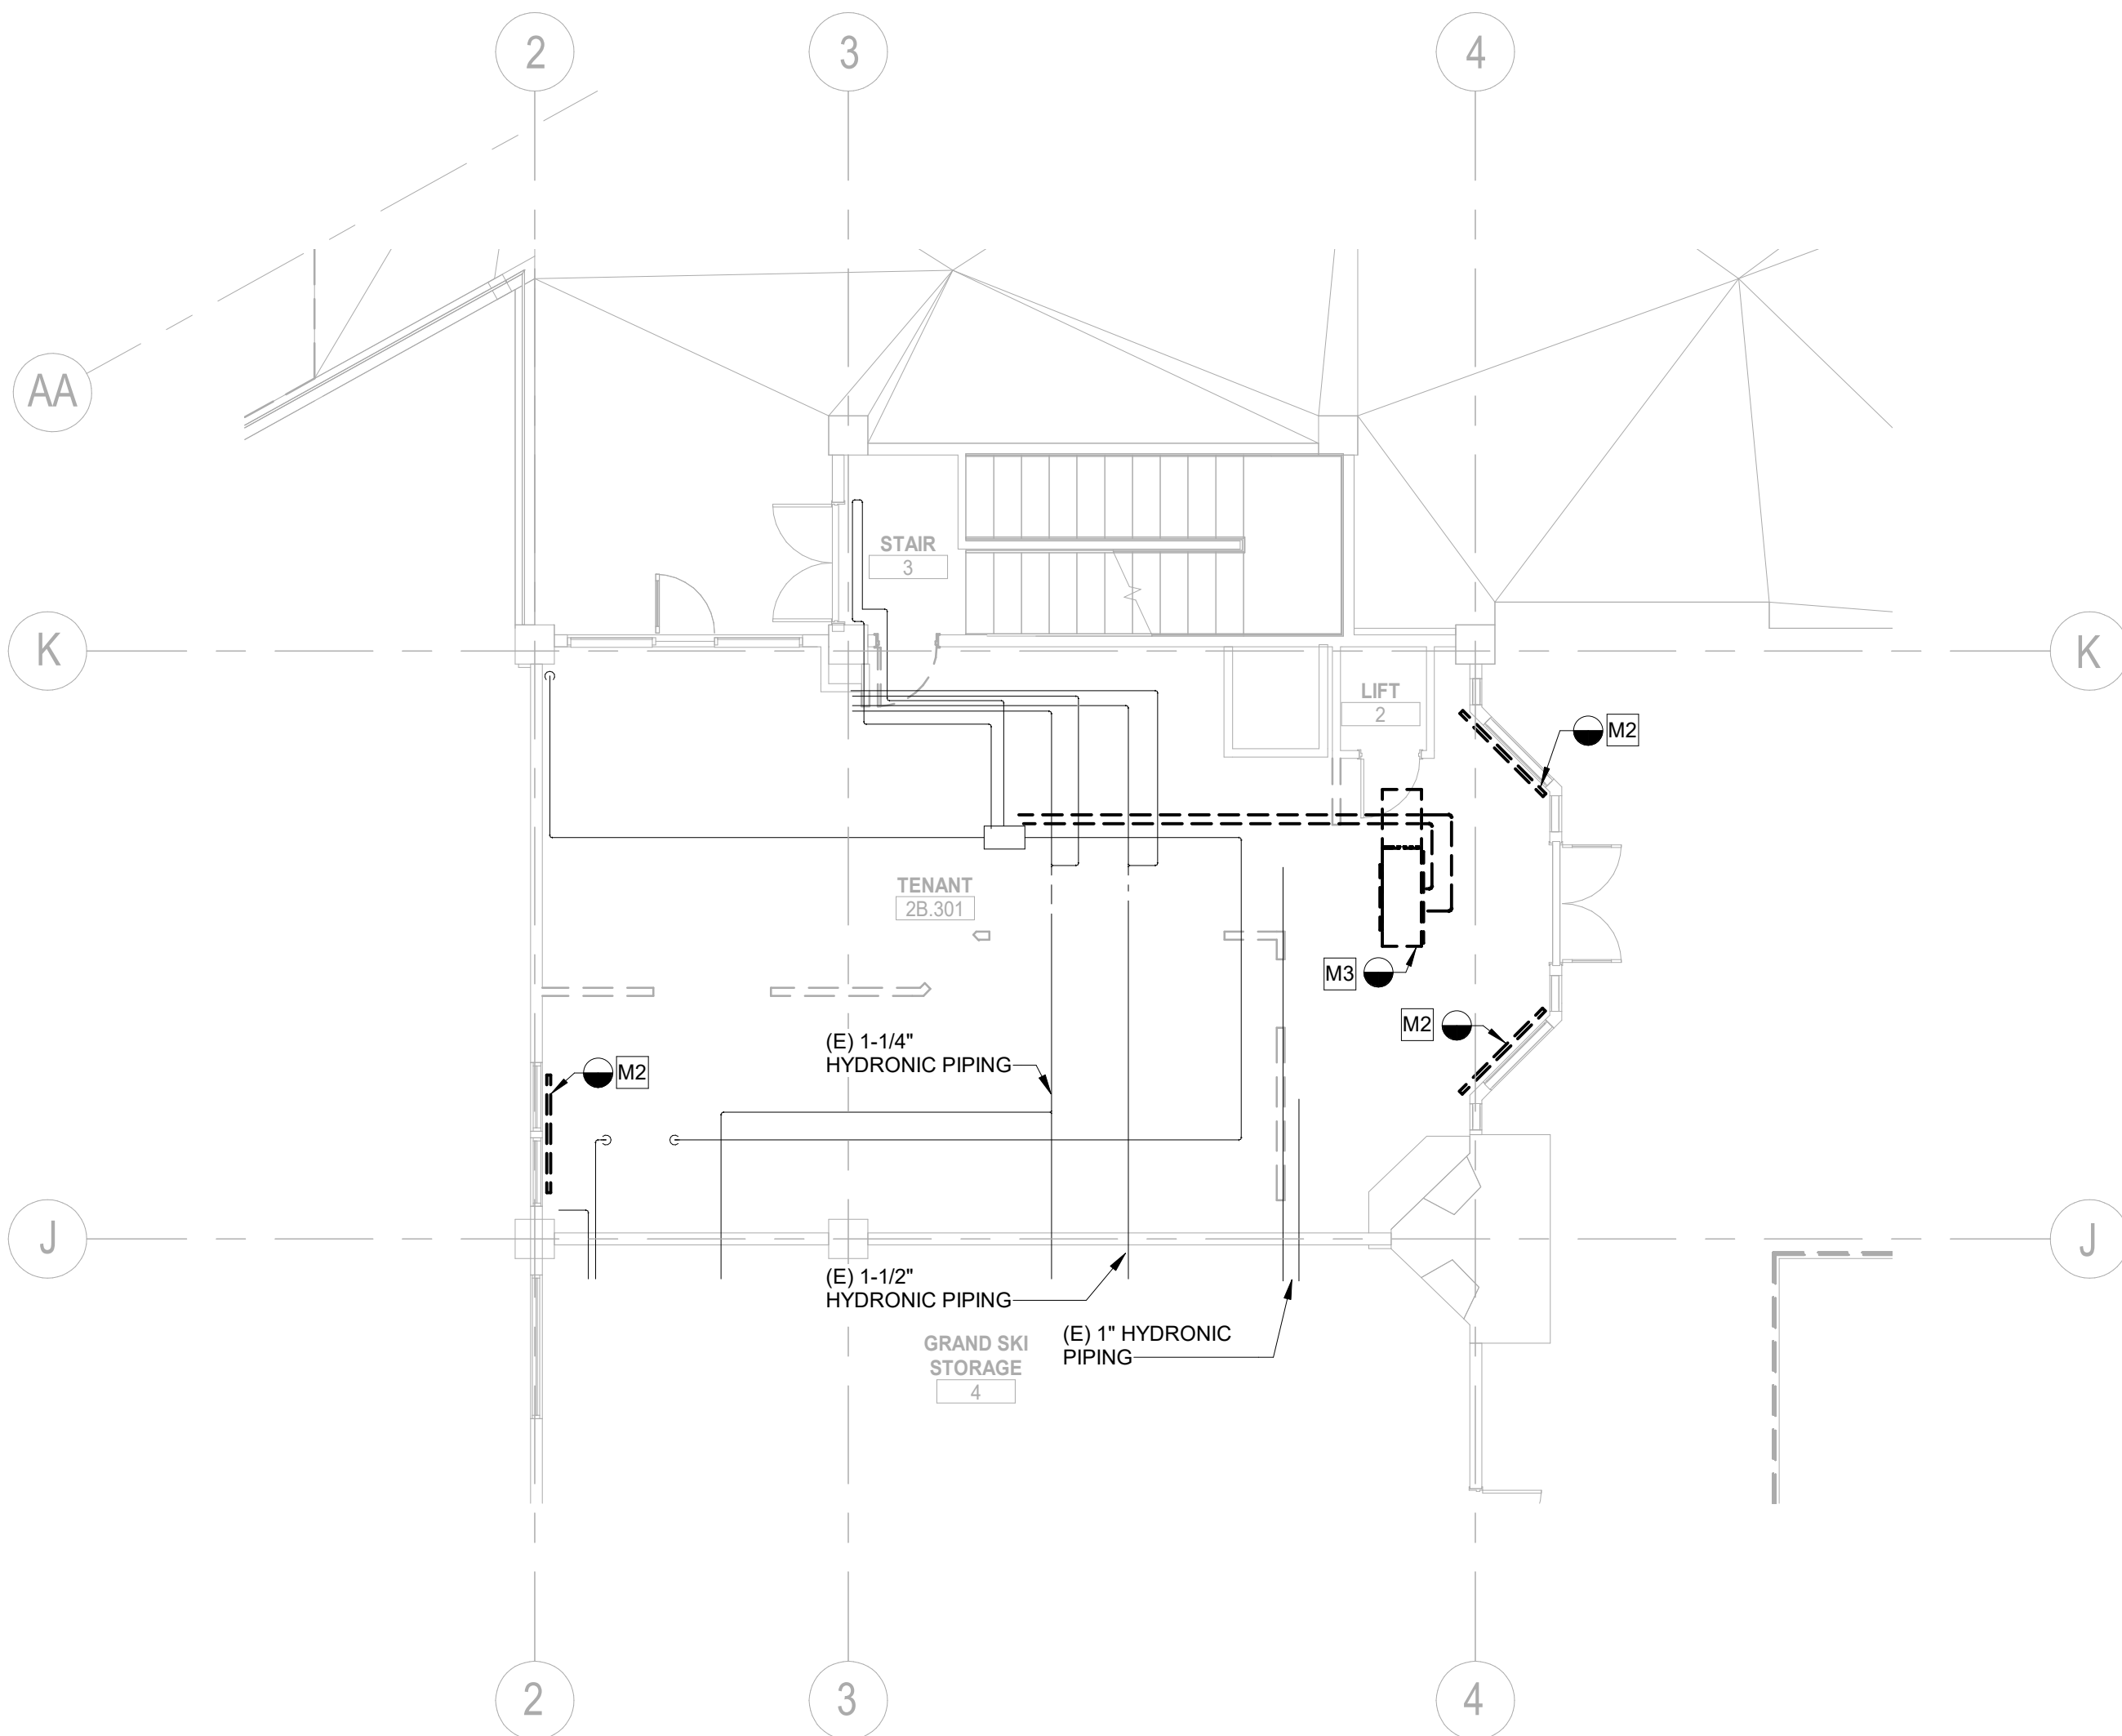

1 MECHANICAL PIPING DEMOLITION PLAN - LEVEL 02
SCALE: 1/8" = 1'-0"

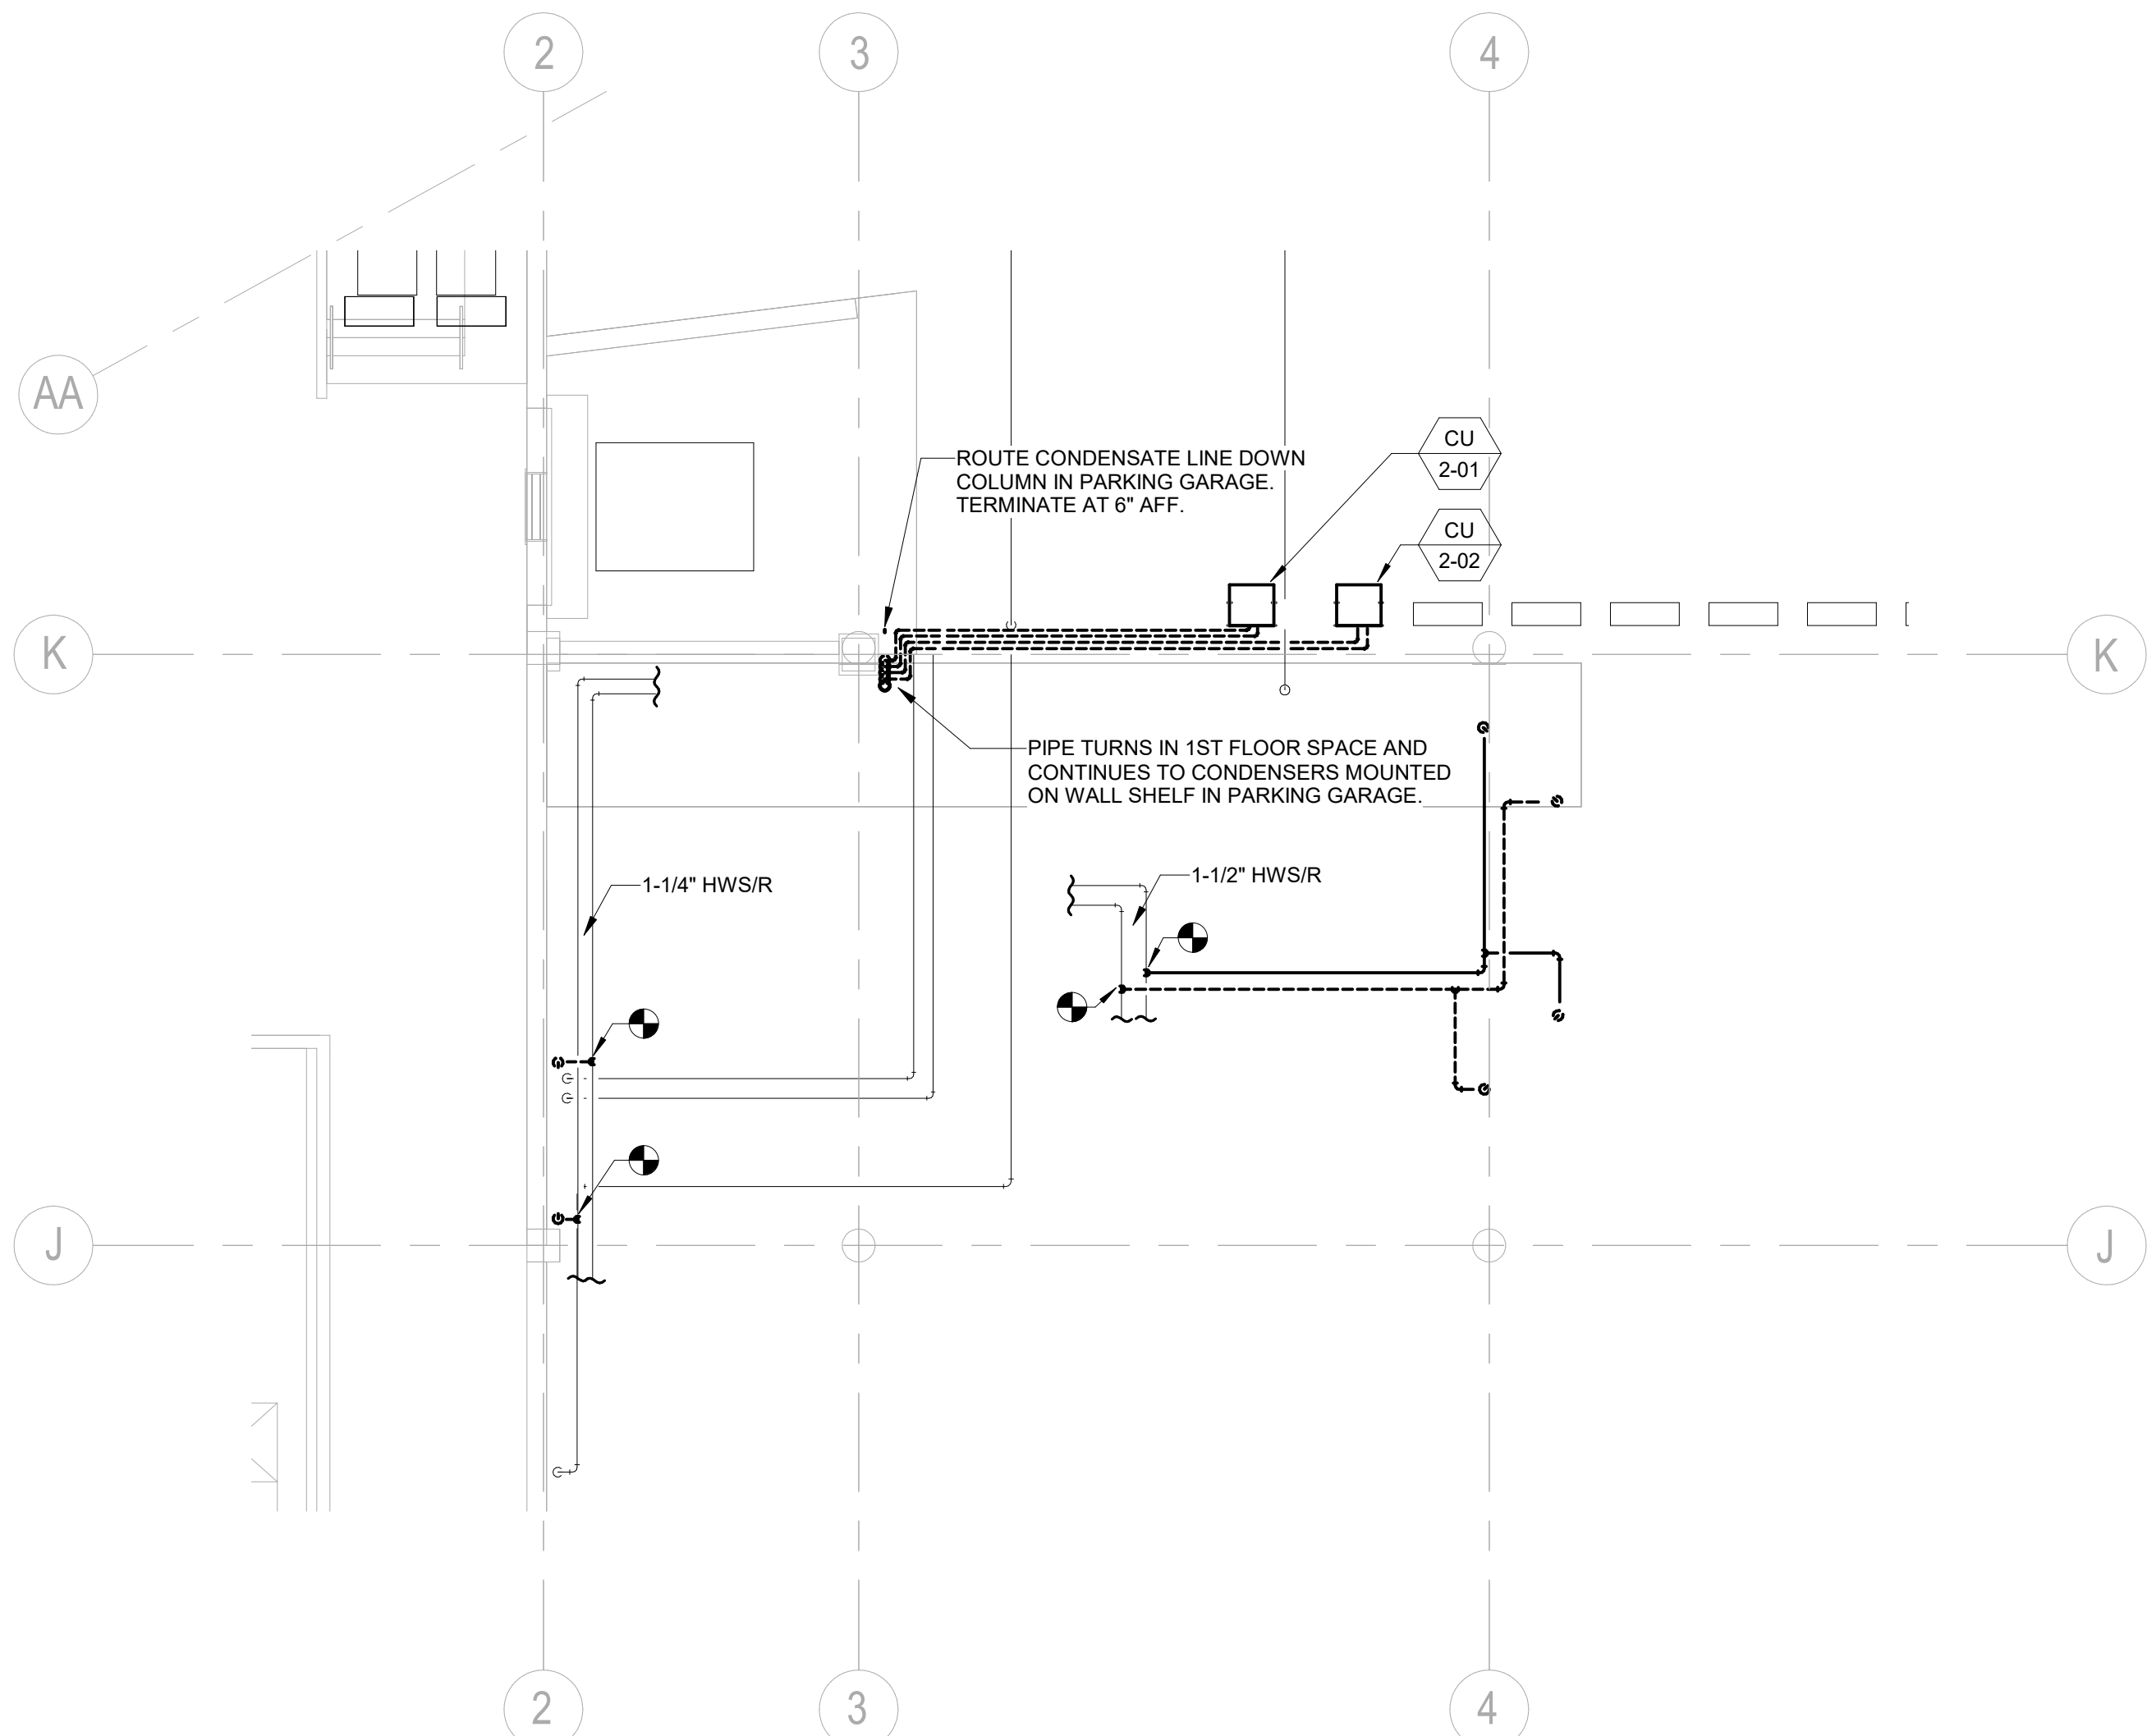


3 MECHANICAL PLAN - PARKING GARAGE MECH PIPING
SCALE: 1/8" = 1'-0"

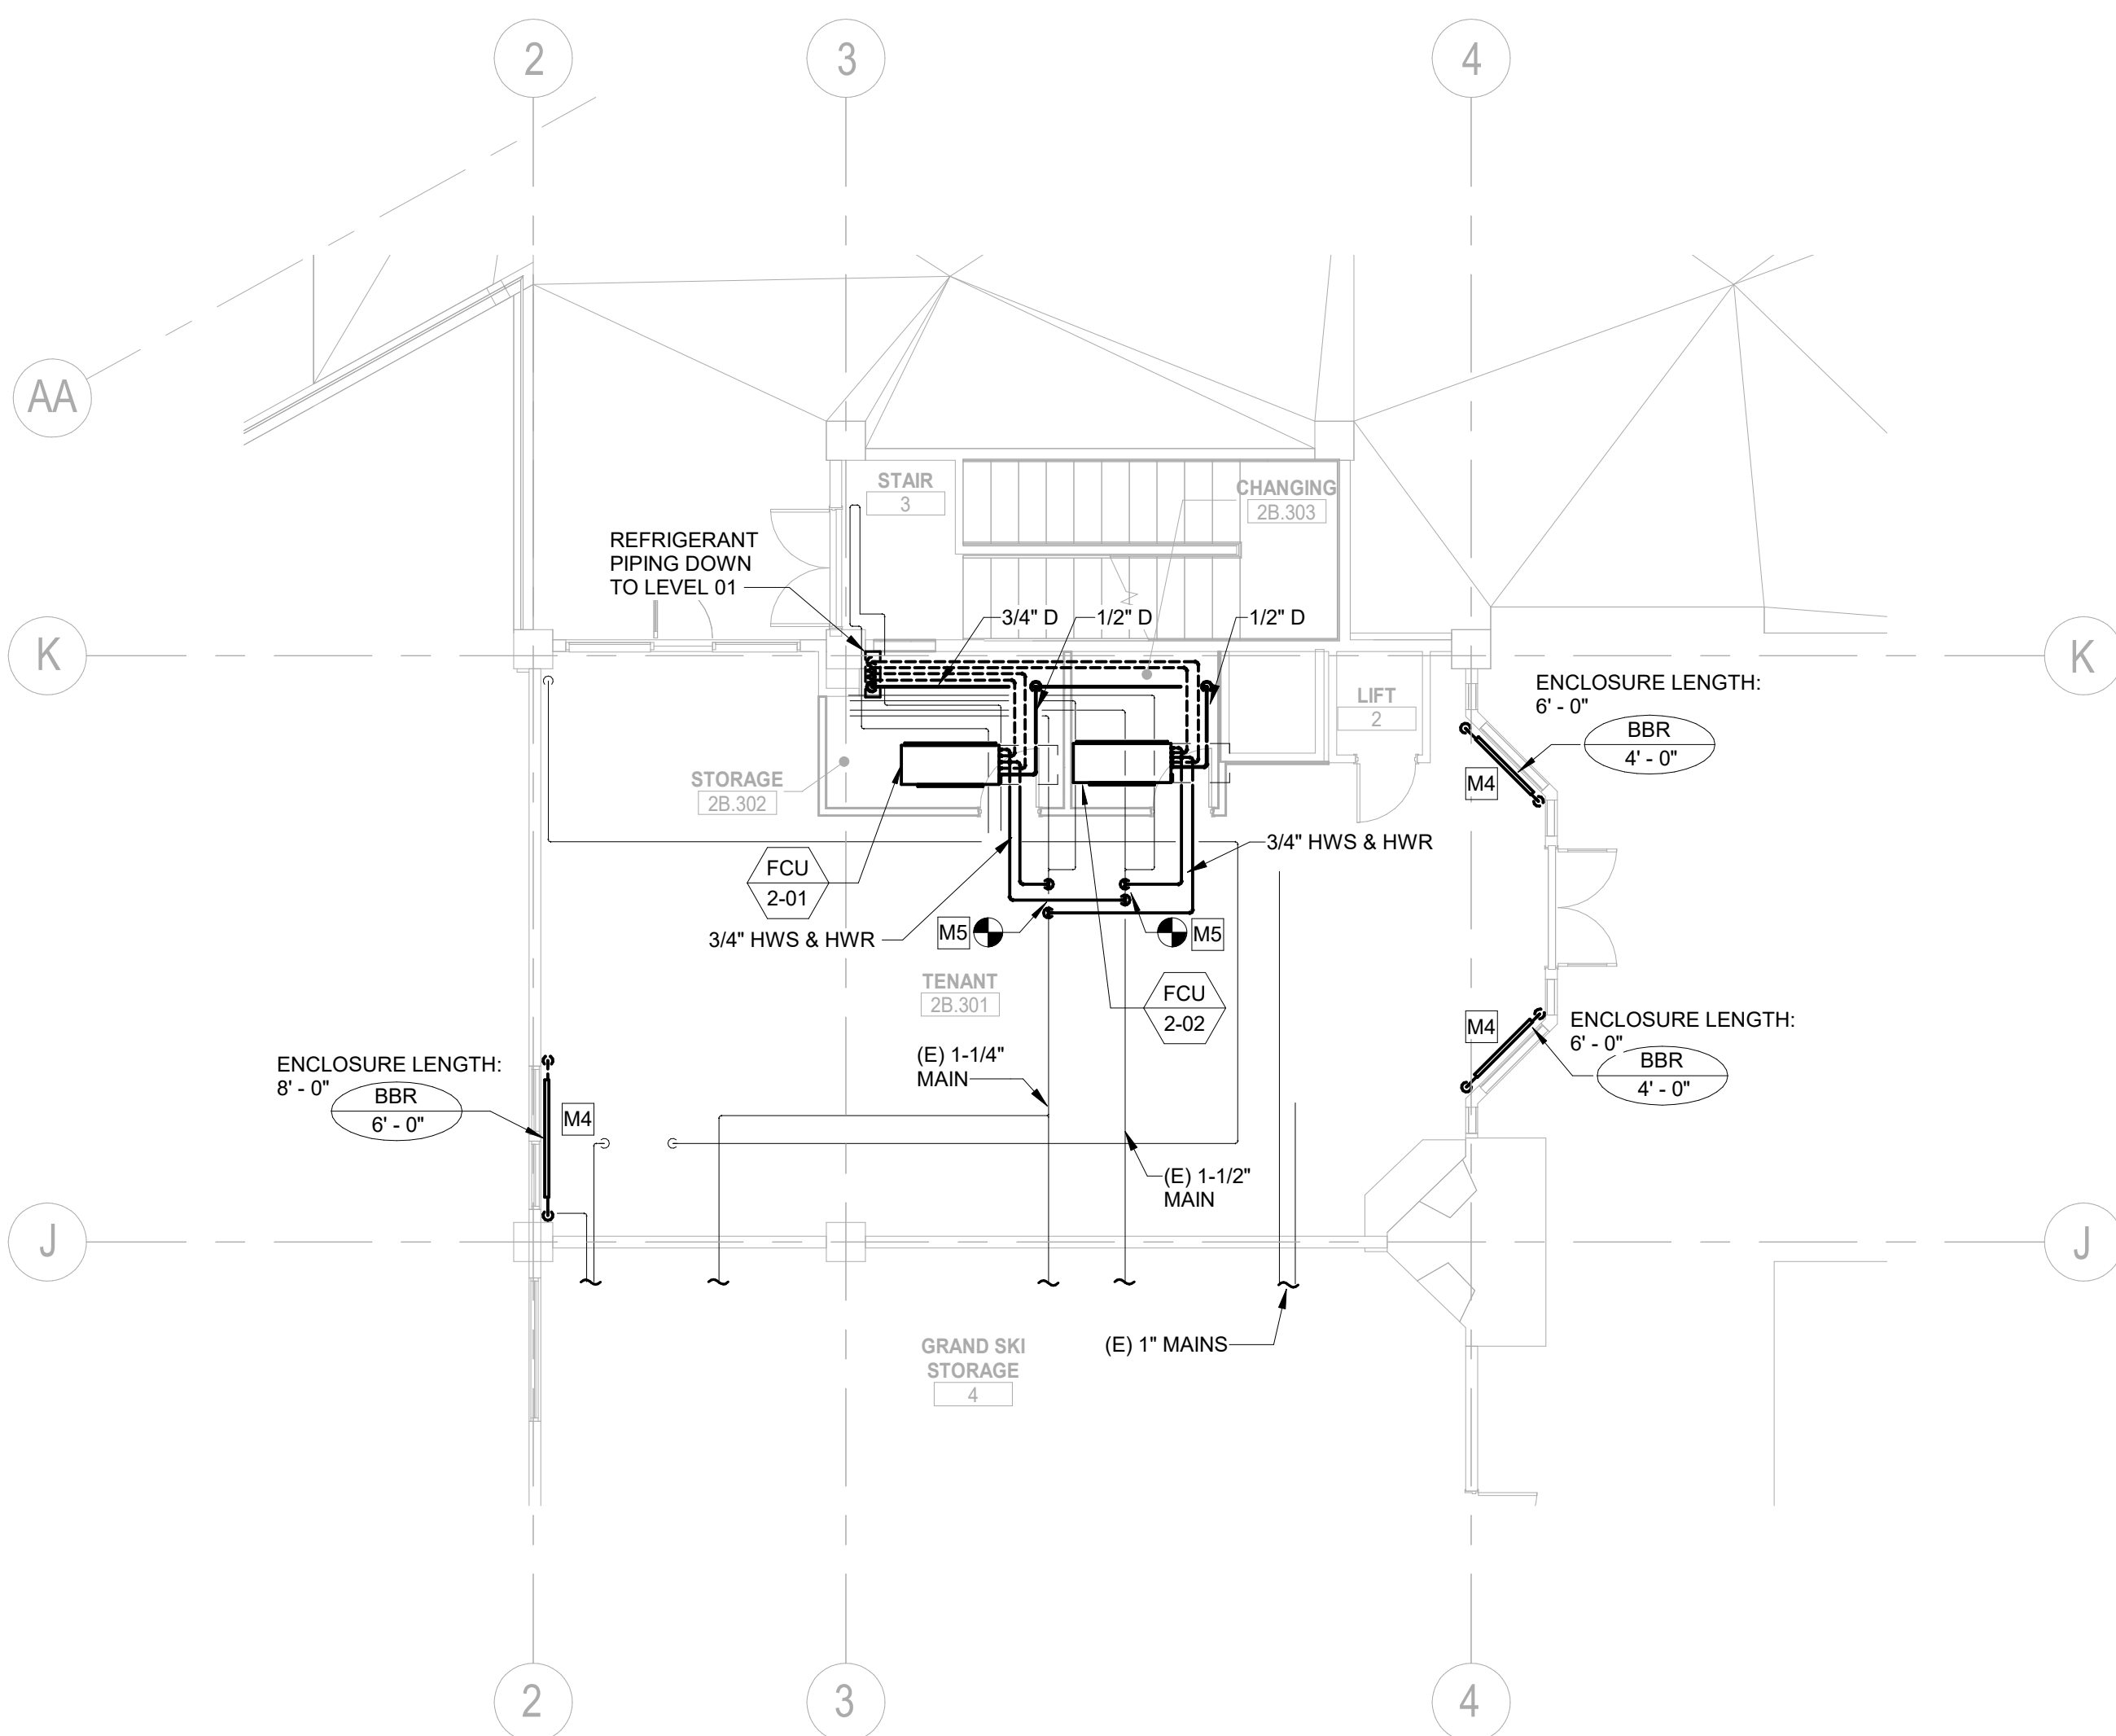

2 MECHANICAL PIPING PLAN - LEVEL 02
SCALE: 1/8" = 1'-0"

KEY PLAN

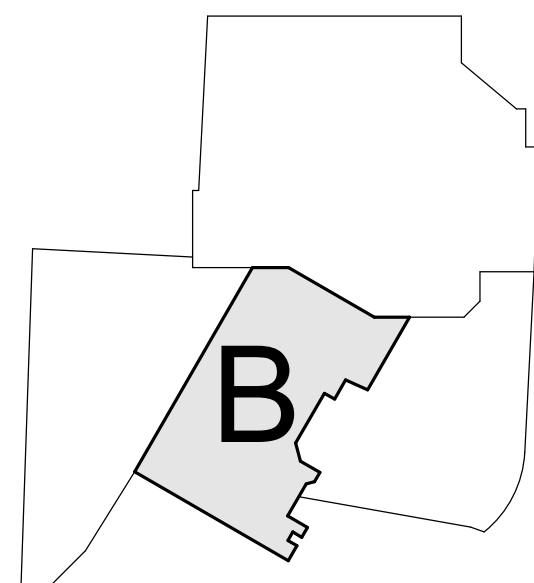


Seal / Signature



Project Name
Steamboat Base Village
Redevelopment
Project Number
003.7835.000
Description
MECHANICAL PIPING PLAN - LEVEL
02


Scale
1/8" = 1'-0"

2B-M1.301

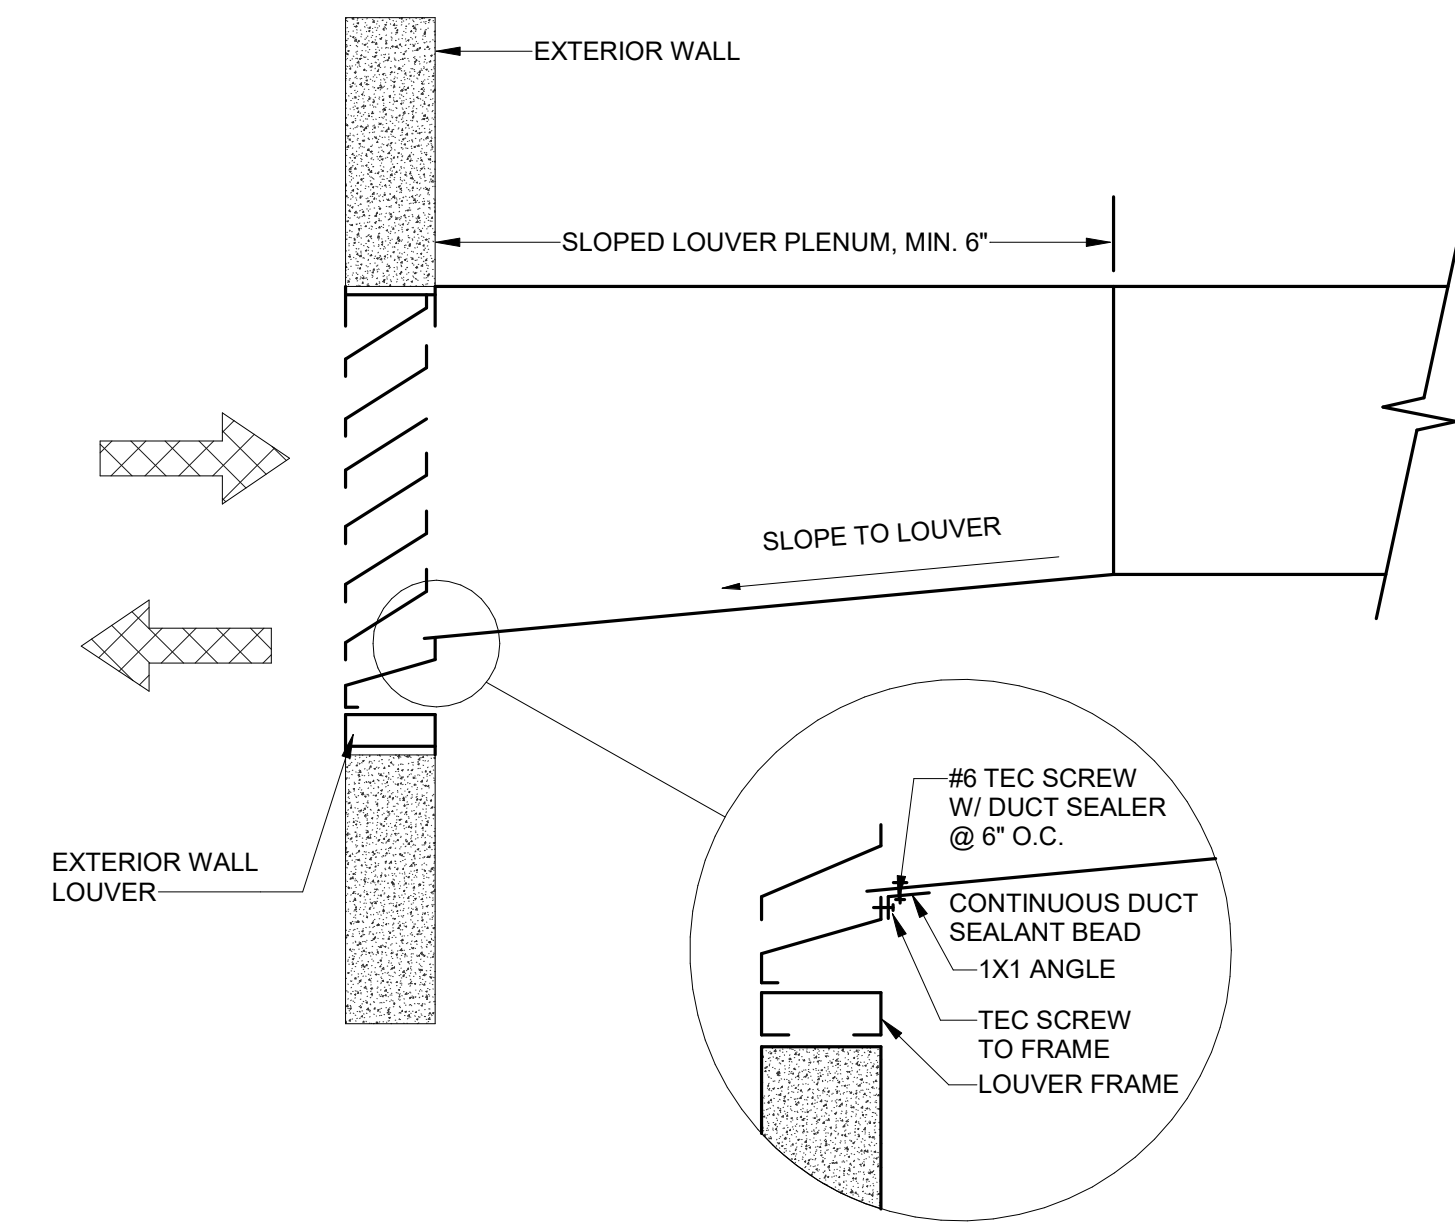


NOTE:
1. ORIENT DUCT JOINTS ALONG SIDES OF DUCTWORK FOR SLOPED DUCT SECTION.

5 OUTSIDE WALL LOUVER DUCT CONNECTION
NO SCALE

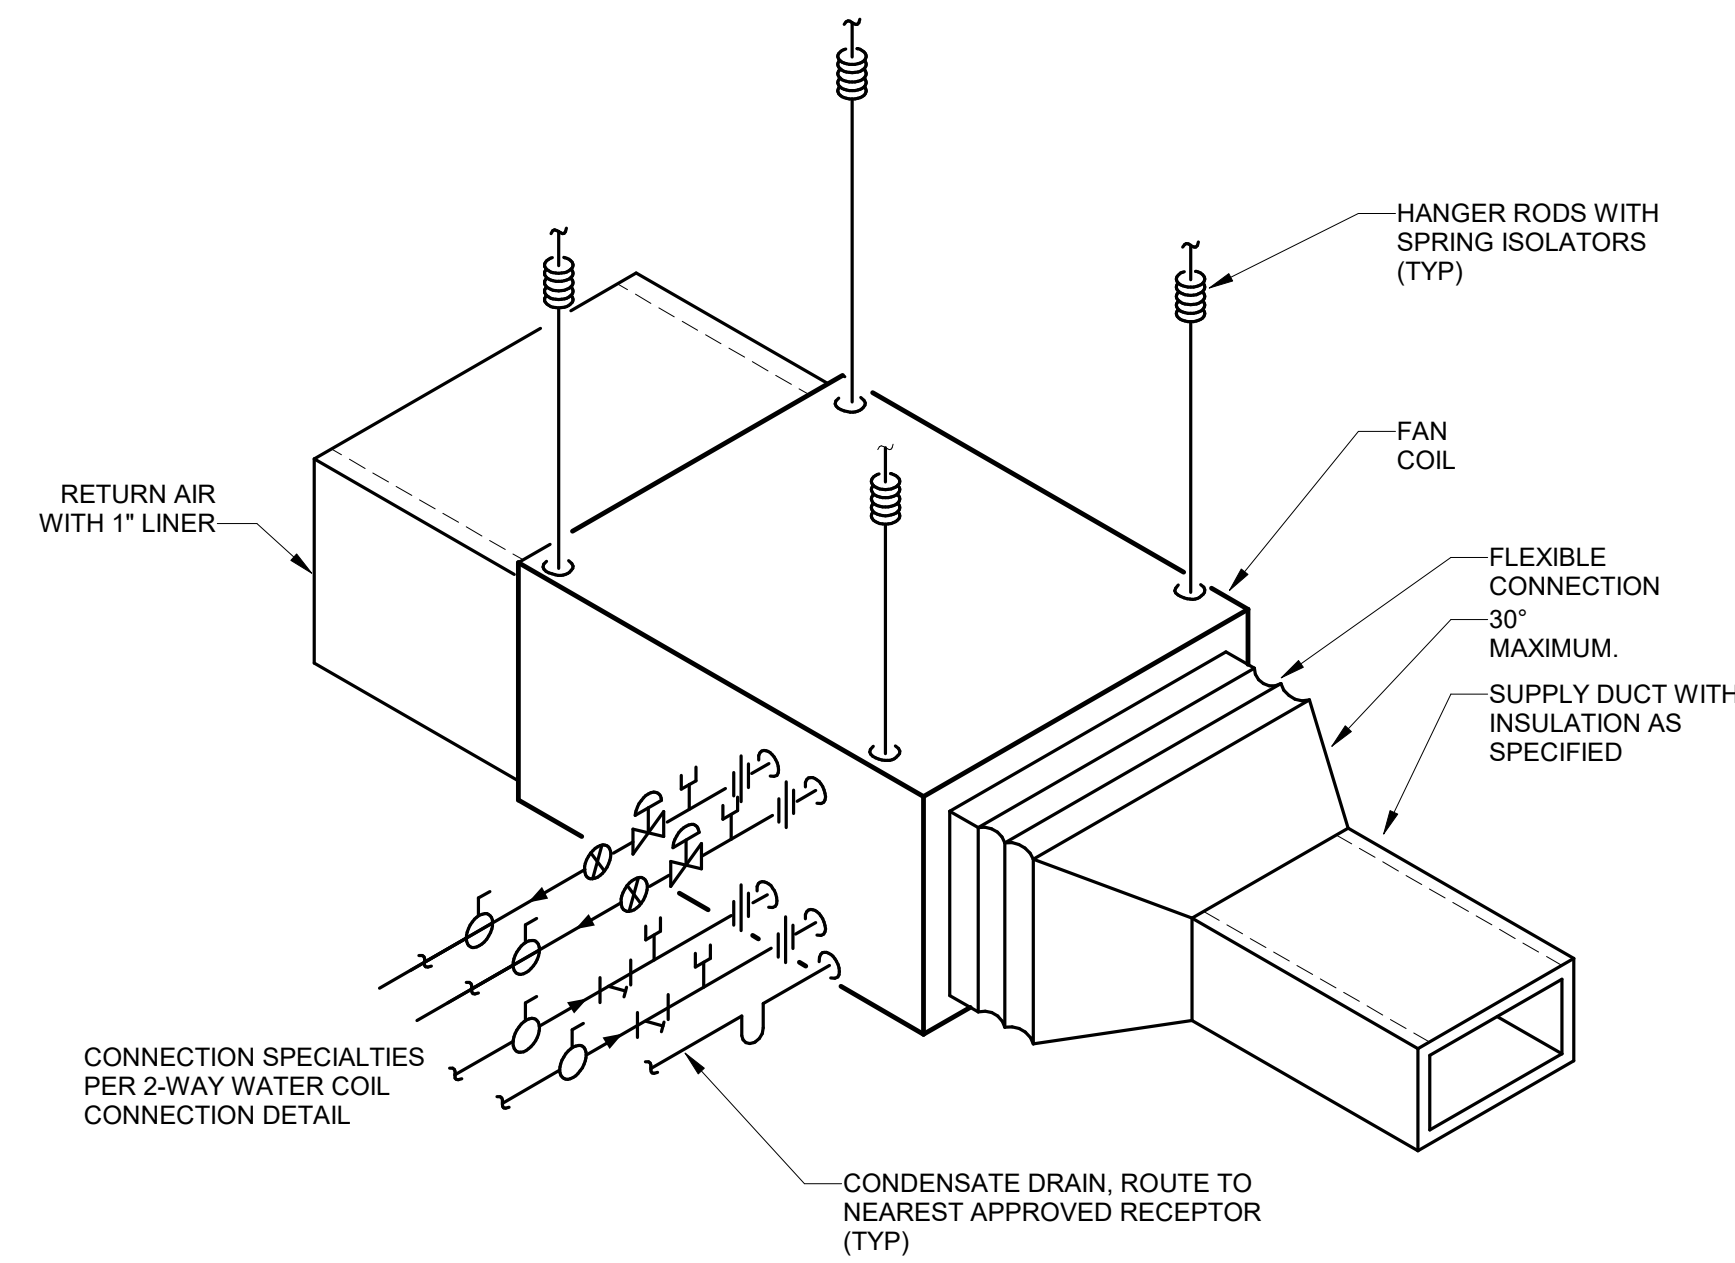


1 FAN COIL DETAIL-GSQ
NO SCALE

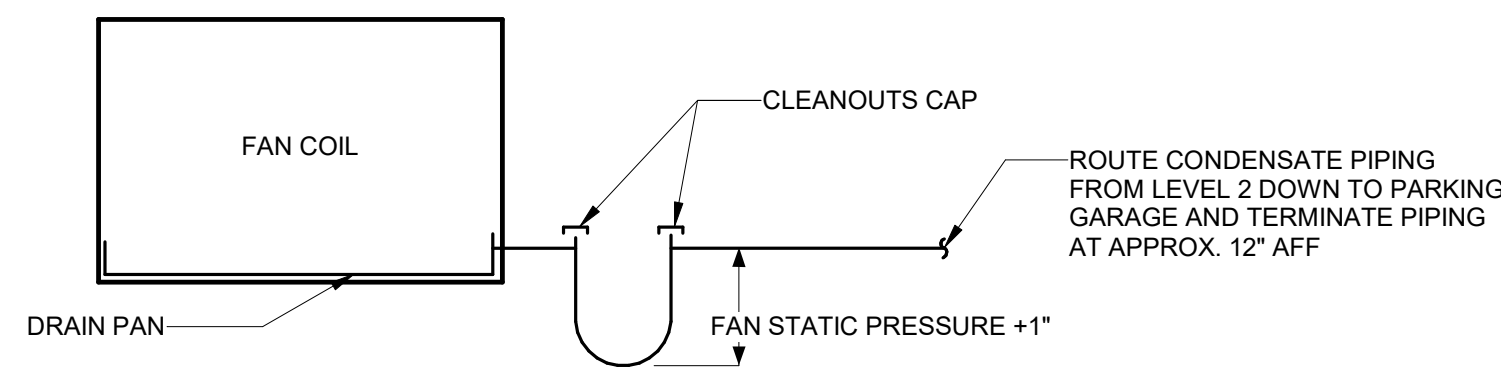


NOTE:
1. INSULATE CONDENSATE DRAIN WHEN ABOVE CEILINGS.

2 FAN COIL UNIT CONDENSATE DRAIN DETAIL-GSQ
NO SCALE

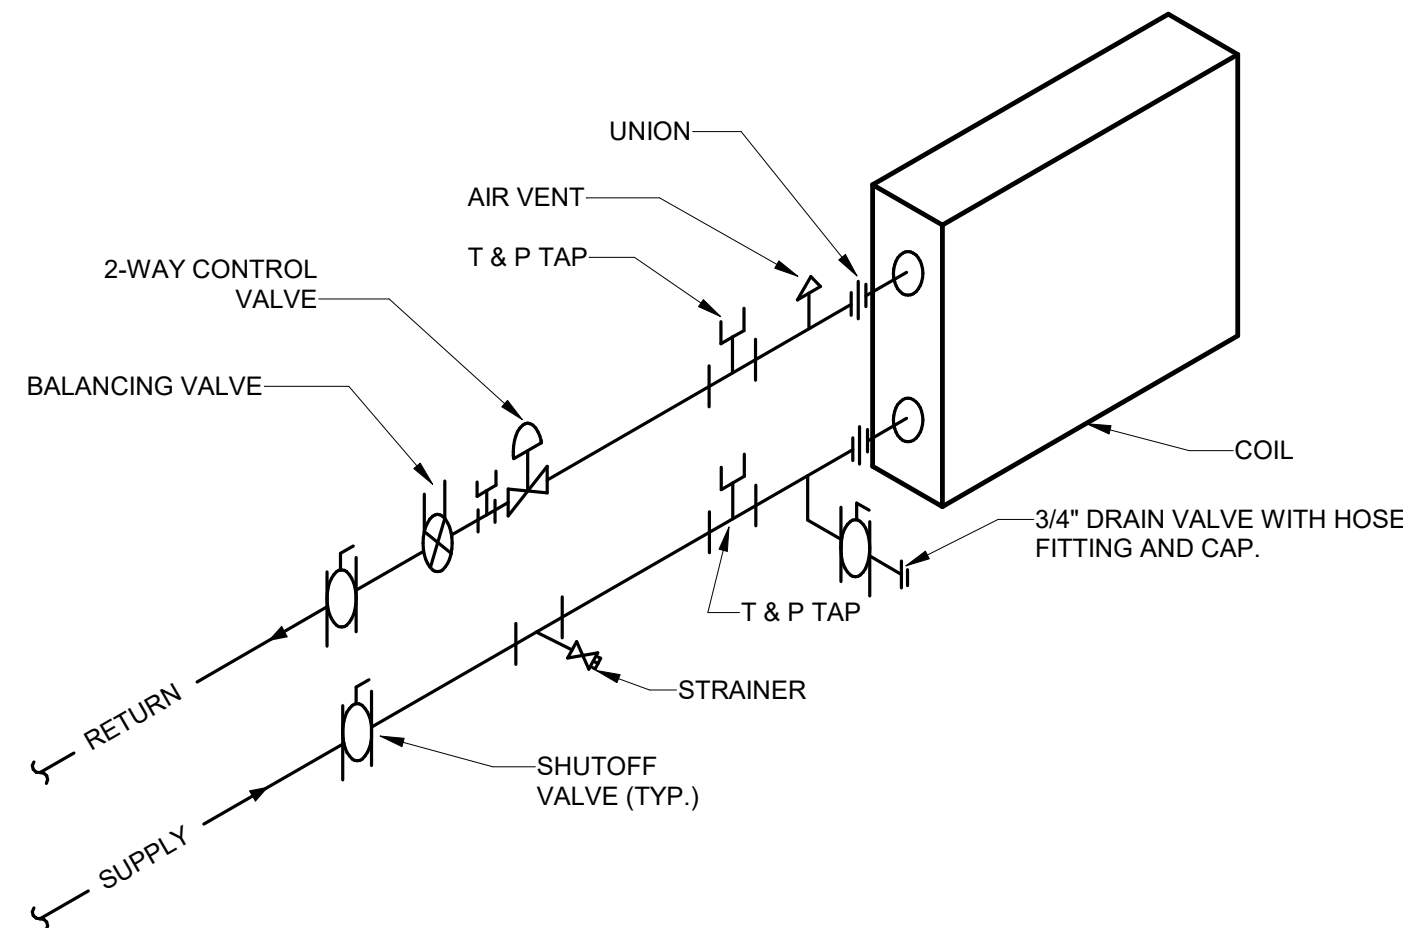

3 TYPICAL WATER COIL CONNECTION DETAIL (2 WAY CONTROL)-GSQ
NO SCALE

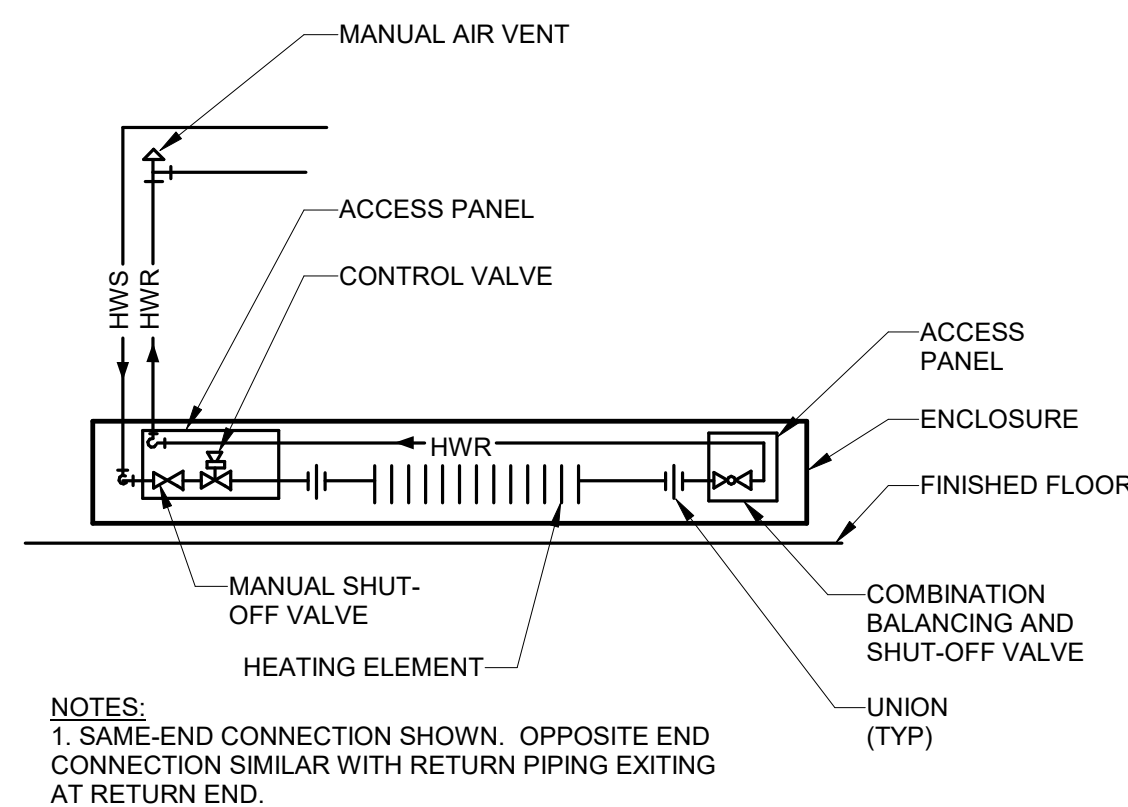

NOTES:
1. SAME END CONNECTION SHOWN. OPPOSITE END CONNECTION SIMILAR WITH RETURN PIPING EXITING AT RETURN END.

4 HOT WATER BASEBOARD DETAIL-GSQ
NO SCALE

REVIEWED
FOR
CODE
COMPLIANCE
09/23/2022

△	Date	Description
1	05/20/2022	ISSUE FOR CONSTRUCTION

Seal / Signature



Project Name

Steamboat Base Village
Redevelopment

Project Number

003.7835.000

Description

MECHANICAL DETAILS

Scale

NO SCALE

2B-M8.000

FAN COIL SCHEDULE (HYDRONIC/DX)																																		
CODE (FCU)	MANUFACTURER/ MODEL NO.	AREA SERVED	CFM	FAN		DX COOLING COIL					HYDRONIC HEATING COIL					ELECTRICAL					REMARKS	CONDENSING UNIT CODE	MANUFACTURER / MODEL NO.	CAPACITY (MBH)	ELECTRICAL - CONDENSING UNIT							REMARKS		
				OA CFM	ESP (IN.)	EAT (°F) DB	LAT WB	TOTAL (°F) MBH	SENS MBH	EAT (°F)	LAT (°F)	MBH	GPM	WPD (FT)	HP	VOLT	PH	MCA	FUSE	DISCON.					FEEDER	VOLT	PH	MCA	FUSE	DISCON.	FEEDER		E-POWER	
2-01	TRANE FCCB080	BUILDING A RETAIL - ZA	757	200	0.25	80.0	61.0	56.3	19.66	19.52	51.6	75.1	20.47	1.6	0.94	0.220	208/120	1	2.25	15A	30A/3P	(3#12,#12G) 3/4"C	A	CU 0-01	TRANE 4TRR4025L1000B	25.00	208	1	14	20A FRS-R	30A/3P	(3#12, #12G) 3/4"C	N	
2-02	TRANE FCCB080	BUILDING A RETAIL - ZB	757	175	0.25	80.0	61.0	56.3	19.66	19.52	51.6	75.1	20.47	1.6	0.94	0.220	208/120	1	2.25	15A	30A/3P	(3#12,#12G) 3/4"C	A	CU 0-02	TRANE 4TRR4025L1000B	25.00	208	1	14	20A FRS-R	30A/3P	(3#12, #12G) 3/4"C	N	
GENERAL NOTES: 1. HEATING WATER: EWT = 150°F, LWT = 130°F, 30% PROPYLENE GLYCOL. 2. PROVIDE 1" MERV 8 FILTERS. 3. SCHEDULED FAN VALUES (CFM, SP AND HP) ARE ACTUAL AT ALTITUDE. MOTOR HP HAS BEEN ADJUSTED FROM SEA LEVEL CONDITIONS FOR OPERATION AT JOBSITE ELEVATION. JOB SITE ELEVATION = 6700 FT. 4. PROVIDE PREMIUM EFFICIENCY MOTORS FOR MOTORS 1 HP AND OVER PER MENA STANDARD MG1-2003, TABLES 12-12 AND 12-13. 5. OUTSIDE AIR CONDITIONS: SUMMER: 86F DB / 56.2F WB WINTER: -10F																						GENERAL NOTES: 1. AMBIENT AIR TEMPERATURE = 95°F. 2. PROVIDE MANUFACTURER'S REQUIRED MINIMUM CLEARANCE AROUND UNIT. 3. MOUNT CONDENSING UNITS ON WALL SHELF IN PARKING GARAGE SPACE. PROVIDE NEOPRENE PAD ISOLATORS BELOW EACH CONDENSING UNIT. 4. MAINTAIN MANUFACTURER'S MINIMUM CLEARANCE REQUIREMENTS.												
REMARKS: A. PROVIDE ENCLOSURE WITH REAR RETURN AND FRONT DISCHARGE.																																		

BASEBOARD RADIATION SCHEDULE (HYDRONIC)				
CODE	MANUFACTURER/ MODEL NO.	CAPACITY (BTU/H·F)	GPM/FT	ROWS
BBR	SIGMA / SWE-06T	350	0.1	1
GENERAL NOTES: 1. EWT= 150 °F, LWT= 130 °F, 30% PROPYLENE GLYCOL. 2. REFER TO PLANS FOR ACTIVE FINNED LENGTH. MINIMUM FLOW FOR CIRCUIT IS 1 GPM. 3. PROVIDE WALL TO WALL ENCLOSURE UNLESS OTHERWISE NOTED. 4. ENCLOSURE COLOR SELECTED BY ARCHITECT. 5. TUBE MATERIAL IS COPPER, FIN MATERIAL ALUMINUM UNLESS OTHERWISE NOTED. 6. PROVIDE EACH NEW SECTION OF BASEBOARD WITH A NEW 2-WAY CONTROL VALVE. MULTIPLE SECTIONS ON THE SAME EXPOSURE MAY USE A COMMON CONTROL VALVE. RE: CONTROL DIAGRAMS.				

ELECTRIC DUCT HEATER																	
CODE (EDH)	AREA SERVED	MANUFACTURER/ MODEL NO.	OSA CFM	HEATING COIL										INLET SIZE	OUTLET SIZE	REMARKS	
				EAT	LAT	KW	CONTROL	V	PH	FLA	ELECTRICAL		FEEDER				
2-01	BLDG A RETAIL	INDEECO QUZ	400	-10.0	50.0	5.9	SCR	208	3	16	30A/3P	20A FRN-R	(3#10, #10G) 3/4"		12 X 10	12 X 10	A,B
<u>GENERAL NOTES</u> 1. MOUNT PER MANUFACTURER'S INSTALLATION INSTRUCTIONS INCLUDING ALL UL LISTING REQUIREMENTS. 2. HEATING COIL DISCHARGE TEMPERATURES SHALL NOT EXCEED 100F. 3. JOBSITE ELEVATION = 6700 FT.																	
<u>REMARK NOTES</u> A. PROVIDE LINE VOLTAGE DUCT MOUNTED THERMOSTAT DOWNSTREAM OF HEATER. CONTROL TO 50F LEAVING AIR TEMP. B. INTERLOCK HEATER WITH VENTILATION FAN SERVING SAME AREA.																	

ENVIRONMENTAL FAN SCHEDULE																		
CODE	MANUFACTURER/ MODEL NO.	AREA SERVED	LOCATION	TYPE	CFM	ESP "W.C. (ALT.)	ELECTRICAL							MTG	CTRL	WEIGHT (LBS)	REMARKS	
							DRIVE	HP/W	VOLT	PH	FLA	DISC.	FUSE					FEEDER
SF-2-01	GREENHECK/SO-90-VG	BLDG A RETAIL	CEILING	INLINE - OA	400	0.25	EC(D)	1/10	120	1	3.1		T.O.\$	(2#12, 1#12G) 3/4"C	1	1	100	A,B,C
EF-2-02	GREENHECK/SO-90-VG	BLDG A RETAIL	CEILING	INLINE - EA	200	0.25	EC(D)	1/10	120	1	1.5		T.O.\$	(2#12, 1#12G) 3/4"C	1	1	70	C
<div>GENERAL NOTES:</div> <div>1. DRIVE TYPE: EC(D) = DIRECT DRIVE WITH ELECTRONICALLY COMMUTATED FAN MOTOR AND LOCAL SPEED ADJUSTMENT.</div> <div>2. SCHEDULED FAN VALUES (CFM, SP AND HP) ARE ACTUAL AT ALTITUDE. MOTOR HP HAS BEEN ADJUSTED FROM SEA LEVEL CONDITIONS FOR OPERATION AT JOB SITE ELEVATION. JOB SITE ELEVATION = 6,700 FT.</div> <div>MOUNTING (MTG):</div> <div>1. INSTALL FAN WITH FLEXIBLE CONNECTIONS AT DUCT INLET AND OUTLET. PROVIDE RUBBER GROMMET VIBRATION ISOLATION HANGERS.</div> <div>CONTROL (CTRL):</div> <div>1. FAN SHALL BE INTERLOCKED WITH FAN COILS SERVING SAME AREA. FAN SHALL OPERATE IN OCCUPIED MODE ONLY. INTERLOCK FAN WITH MOTORIZED DAMPER AT PERIMETER LOUVER.</div> <div>REMARK NOTES:</div> <div>A. PROVIDE MOTORIZED DAMPER AT PERIMETER LOUVER.</div> <div>B. PROVIDE INTEGRAL ANGLED FILTER HOUSING WITH 2" MERV 8 FILTERS.</div> <div>C. PROVIDE INSULATED FAN HOUSING.</div>																		

MECHANICAL LOUVER SCHEDULE							
CODE (LV)	MANUFACTURE/MODEL NUMBER	SERVICE	AIRFLOW	VELOCITY	GROSS DIMENSIONS H x W	MINIMUM FREE AREA (SF)	REMARKS
2-01	RUSKIN ELF6375DX	OA INTAKE	400	500	12" x 28"	0.8	A,B
2-02	RUSKIN ELF6375DX	OA RELIEF	400	500	12" x 28"	0.8	A,B
GENERAL NOTES 1. LOUVERS SCHEDULED HERE ARE CONNECTED TO MECHANICAL SYSTEMS. REMARK NOTES A. PROVIDE INSULATED PLENUM. SLOPE BASE OF PLENUM TO DRAIN WATER OUT THROUGH LOUVER FACE. RE: MECHANICAL DETAILS. B. PROVIDE BIRD SCREEN.							

GRILLE REGISTER DIFFUSER SCHEDULE						
CODE	MANUFACTURER/ MODEL NO.	SERVICE	TYPE	ACCESSORIES	FACE SIZE	REMARKS
A	PRICE / SDGE	SUPPLY	SPIRAL MOUNT	AIR SCOOP	SEE PLANS	
B	PRICE / 530	RETURN	LOUVERED		SEE PLANS	
C	PRICE / 510Z	SUPPLY	LOUVERED		SEE PLANS	
D	PRICE / 510Z	EXHAUST	LOUVERED		SEE PLANS	
GENERAL NOTES: 1. SEE PLANS FOR CFM AND NECK SIZE. 2. MAXIMUM NOISE CRITERIA (NC) SHALL BE 30 UNLESS OTHERWISE NOTED. 3. COLOR TO BE COORDINATED WITH ARCHITECT. 4. MATERIAL IS STEEL UNLESS OTHERWISE NOTED.						

Steamboat

ALTRERRA

MOUNTAIN COMPANY

east west partners

2305 Mount Werner Circle

Steamboat Springs, CO 80487

Gensler

1225 17th Street

Suite 150

Denver, CO 80202

United States

Tel 303.595.8585

Fax 303.825.6823

me

engineers

14143 Denver West Pkwy

Suite 300

Golden, CO

United States

Tel 303.421.6555

REVIEWED
FOR
CODE
COMPLIANCE
09/23/2022

Date	Description
05/20/2022	ISSUE FOR CONSTRUCTION
06/27/2022	BULLETIN 1

Seal / Signature

COLORADO LICENSE

ANDREW E. EDWARDS

56806

PROFESSIONAL ENGINEER

Project Name

Steamboat Base Village
Redevelopment

Project Number

003.7835.000

Description

MECHANICAL SCHEDULES

Scale

2B-MEP0.000

© 2018 Gensler