



RCRBD
RECORD SET

cont. we corrugated
steel

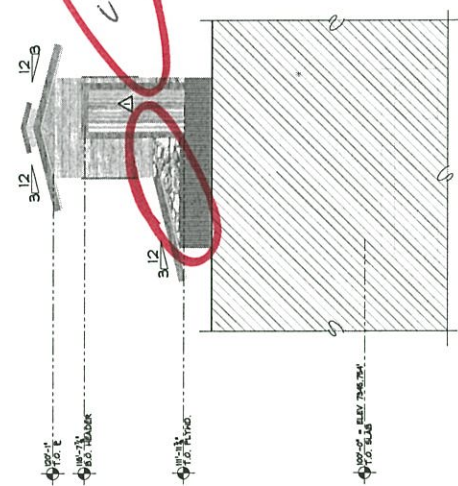


4 EAST ELEVATION

SCALE 1/4" = 1'-0"

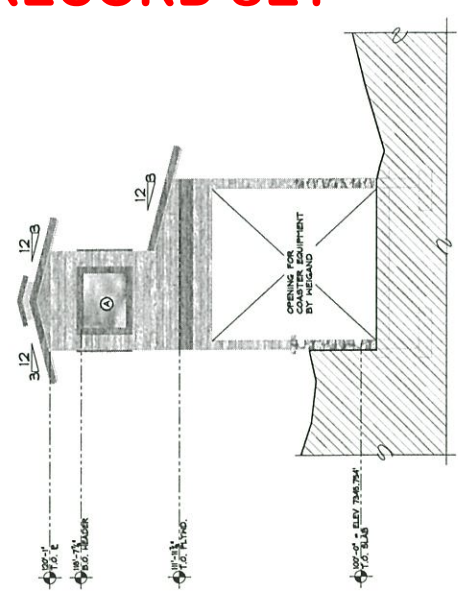


2 WEST ELEVATION

SCALE 1/4" = 1'-0"

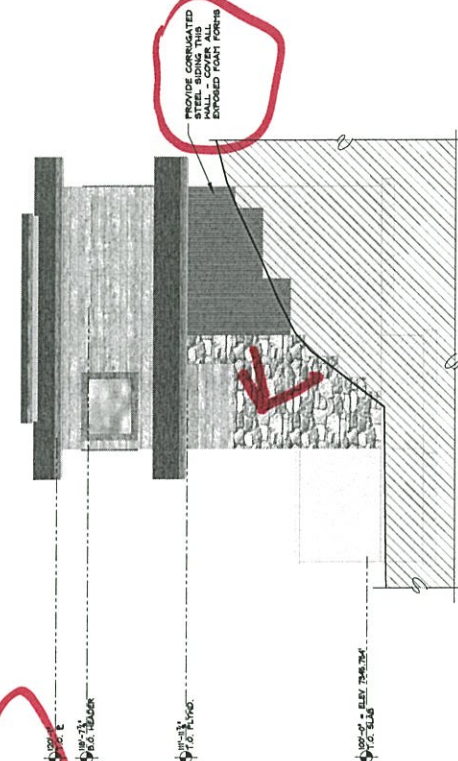

3 SOUTH ELEVATION

SCALE 1/4" = 1'-0"

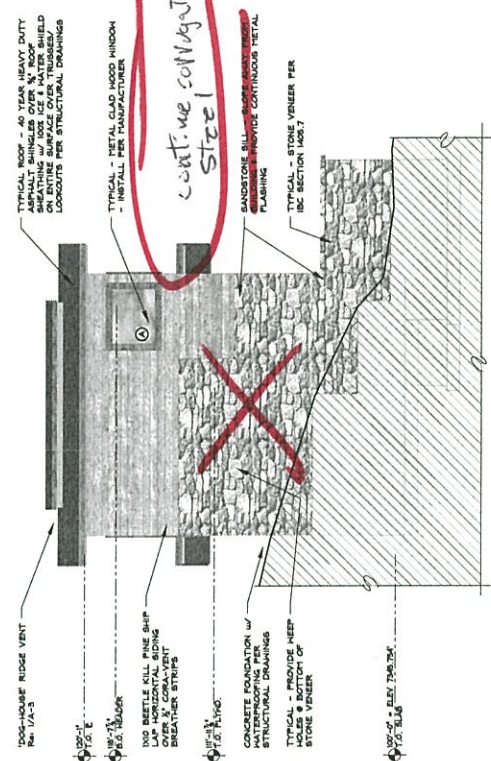

1 NORTH ELEVATION

SCALE 1/4" = 1'-0"

STEAMBOAT ENGINEERING & ARCHITECTURAL DESIGN, INC.
2740 Avera Lane Suite E, Steamboat Springs, CO 80487
Phone: 970.871.9101 Fax: 970.871.9089
Email: Steve@seadn.com

ALPINE COASTER UPPER BUILDING
2205 N. T. WERNER, COLORADO
STEAMBOAT SPRINGS, COLORADO
A NEW BUILDING FOR
66RC - STEAMBOAT SKI & RESORT CORP.

ISSUE DATES
REVISION
07 - 04 - 16

DRAWN BY
PROJECT # 16020
BUILDING
ELEVATIONS

A-2
SHEET 3 of 6