


R C R B D
RECORD SET

1/1
REVISED 10-7-16

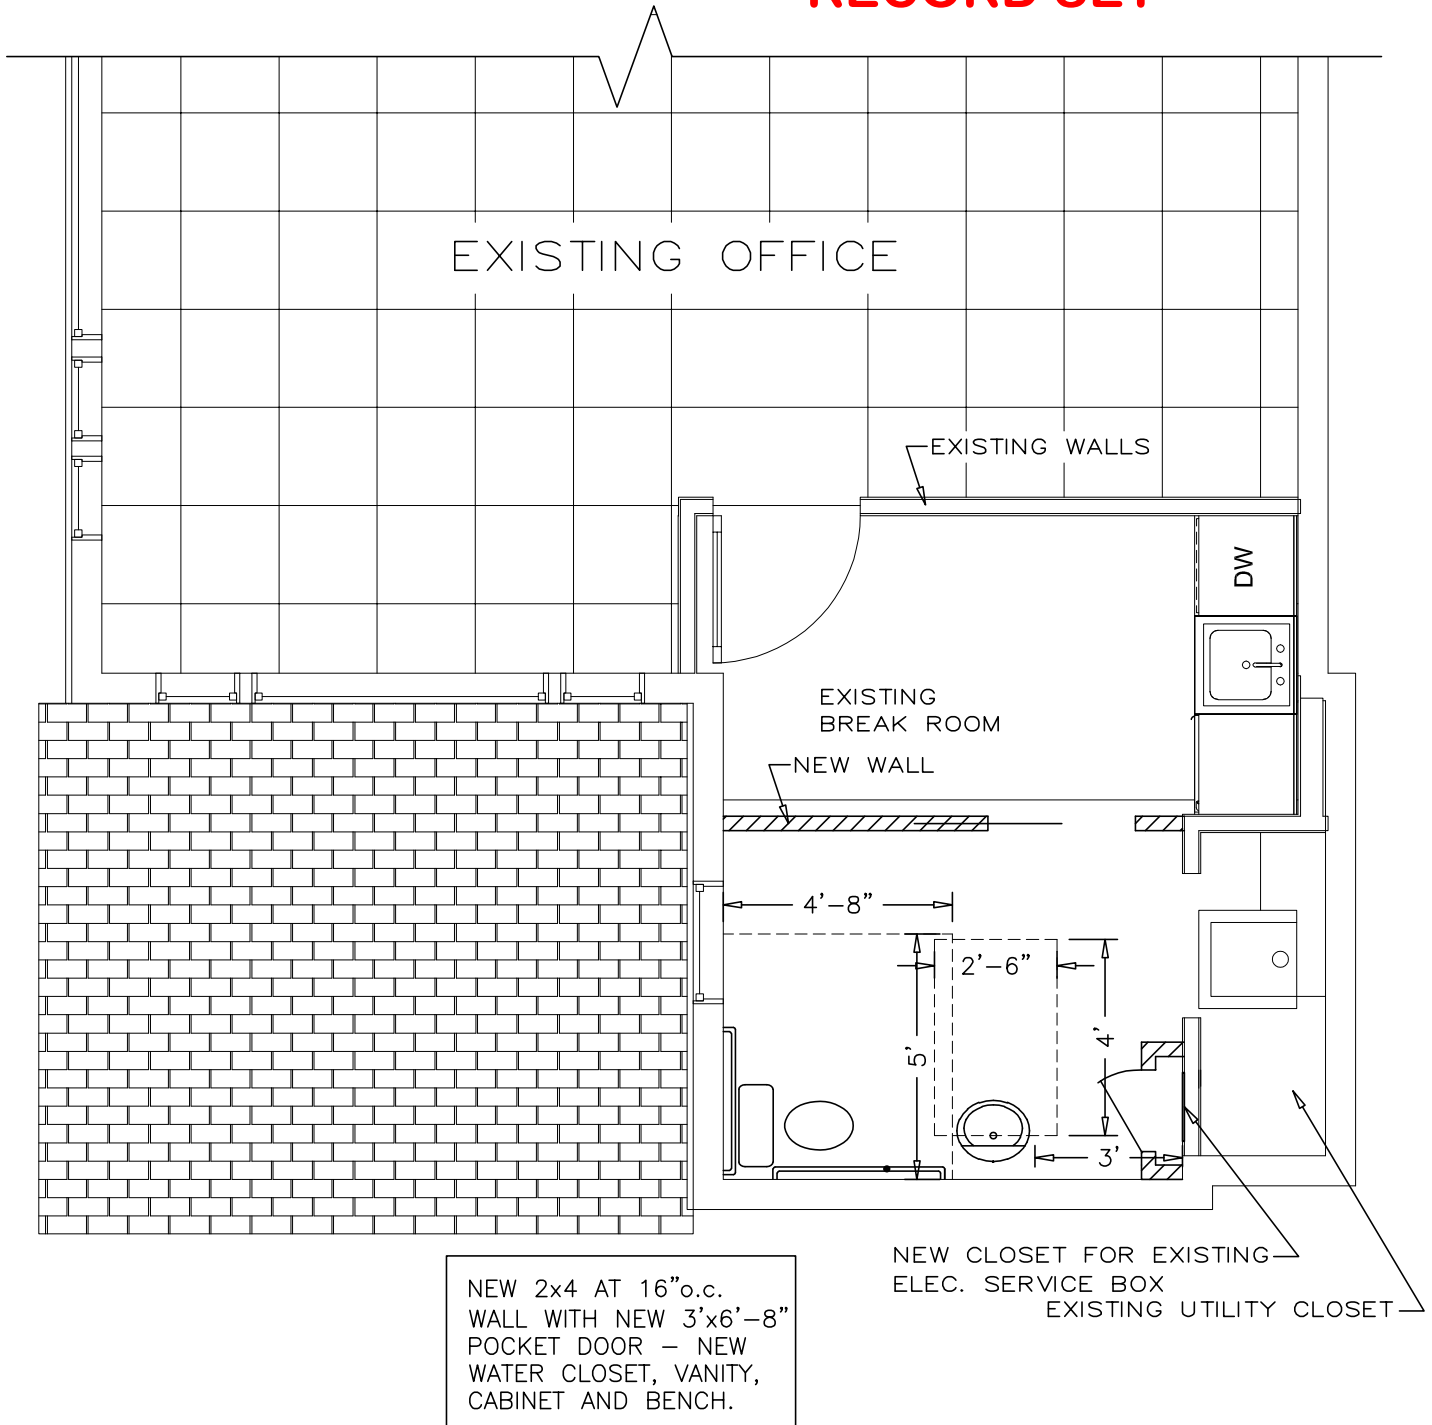

DEER PARK OFFICE ALTERATION

1855 SKI TIME SQUARE
STEAMBOAT SPRINGS, COLORADO

ENGINEERING DESIGNWORKS, INC.
EDW #16128 (970) 879-4890

