

GENERAL NOTES:



1. ALL DOORS TO BE 3'-0" x 7'-0", V.I.F.
2. ALL WALLS & CEILINGS TO RECEIVE NEW 5/8" GYP. BOARD

R C R B D

1/1

9-7-16

RECORD SET

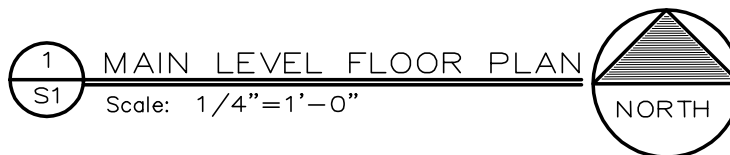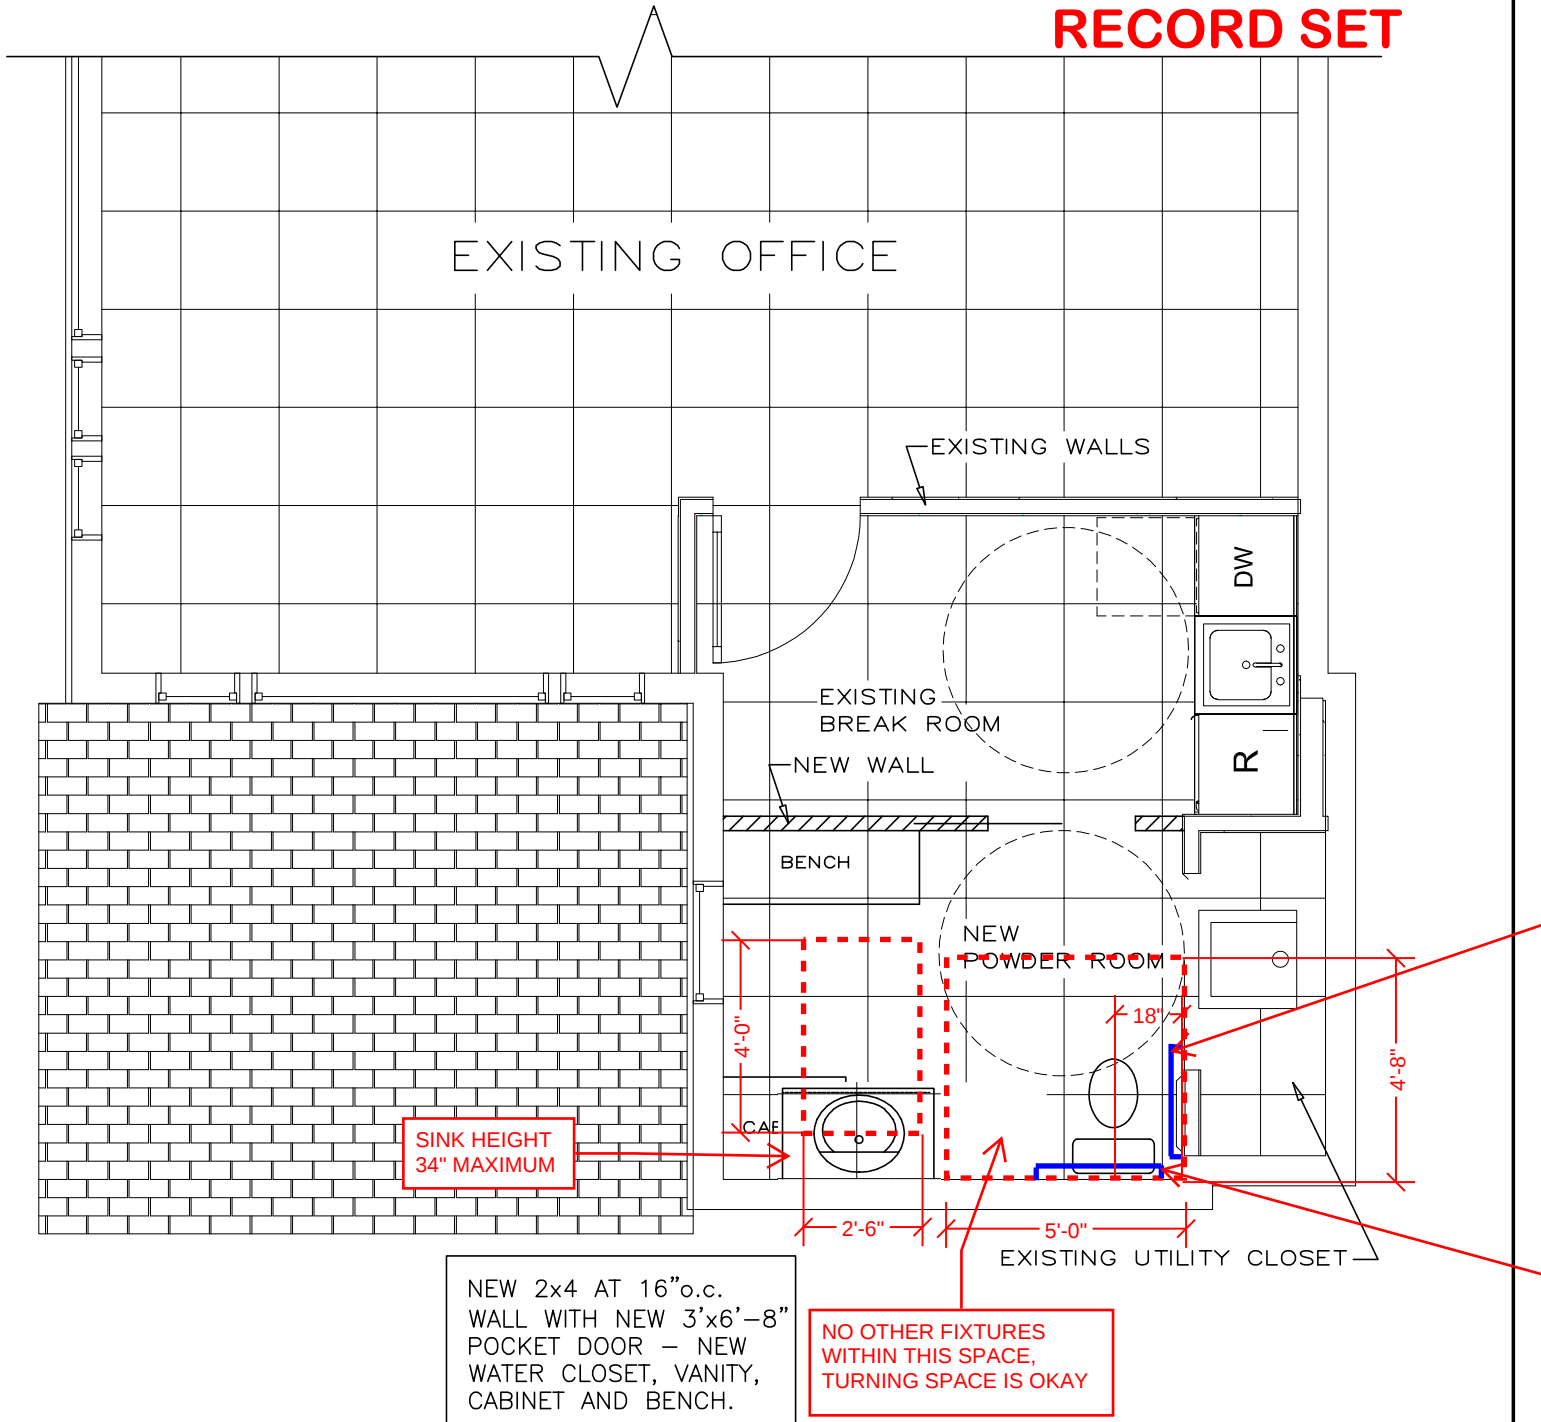

DEER PARK OFFICE ALTERATION

1855 SKI TIME SQUARE
STEAMBOAT SPRINGS, COLORADO




ENGINEERING DESIGNWORKS, INC.

EDW #16128


(970) 879-4890

TOE AND KNEE CLEARANCE REQUIRED FOR THE SNK


R C R B D RECORD SET

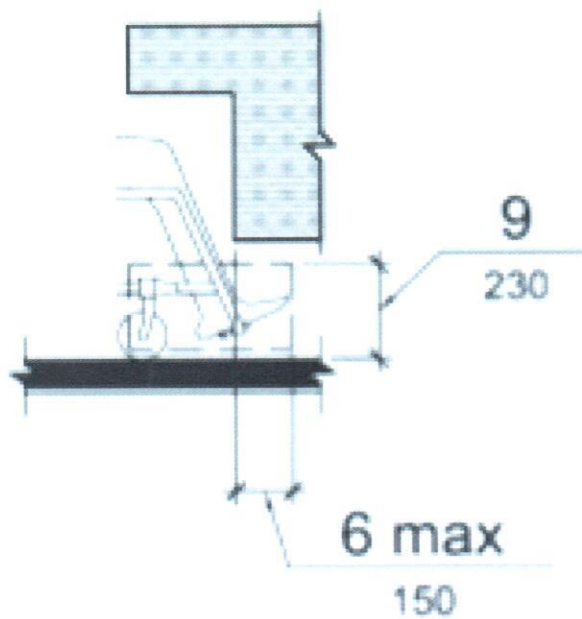


(a)
elevation

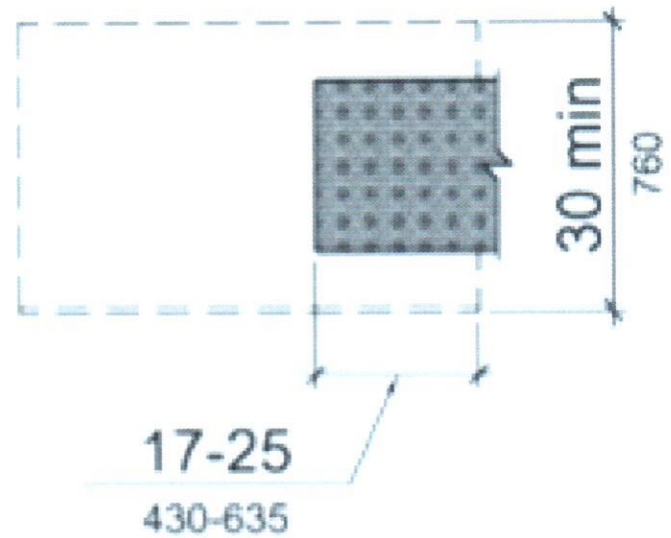

(b)
plan

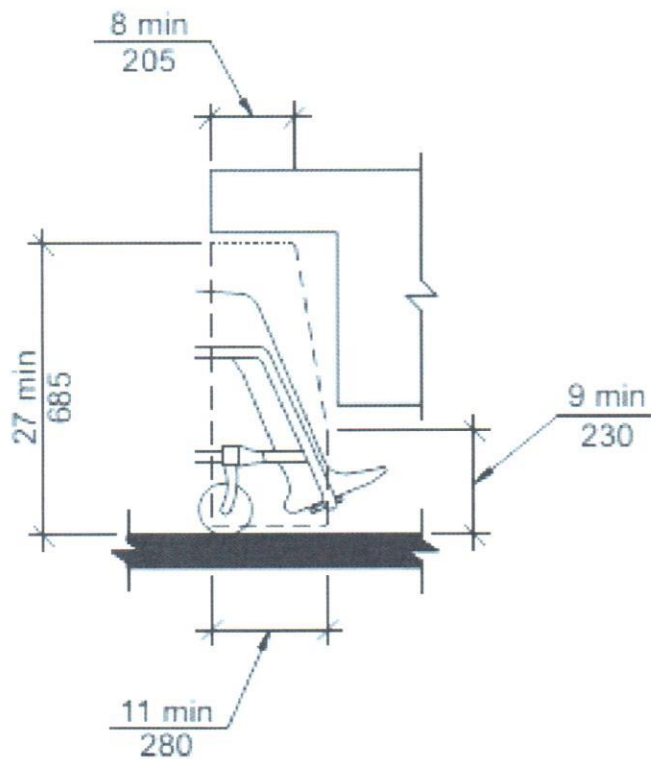

(a)
Elevation

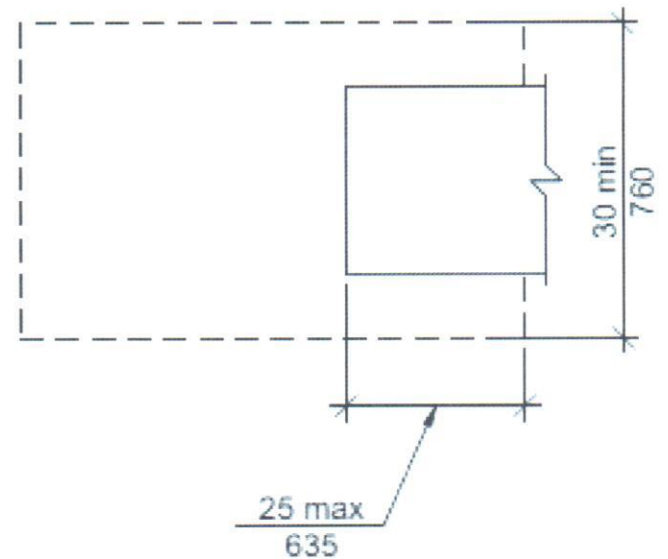

(b)
Plan

RECORD SET




GENERAL NOTES:

1. ALL DOORS TO BE 3'-0" x 7'-0", V.I.F.
2. ALL WALLS & CEILINGS TO RECEIVE NEW 5/8" GYP. BOARD

PJ2117-1
Fire Prevention
In: 9/16/2016
Out: 09/24/2016


1/1
9-7-16

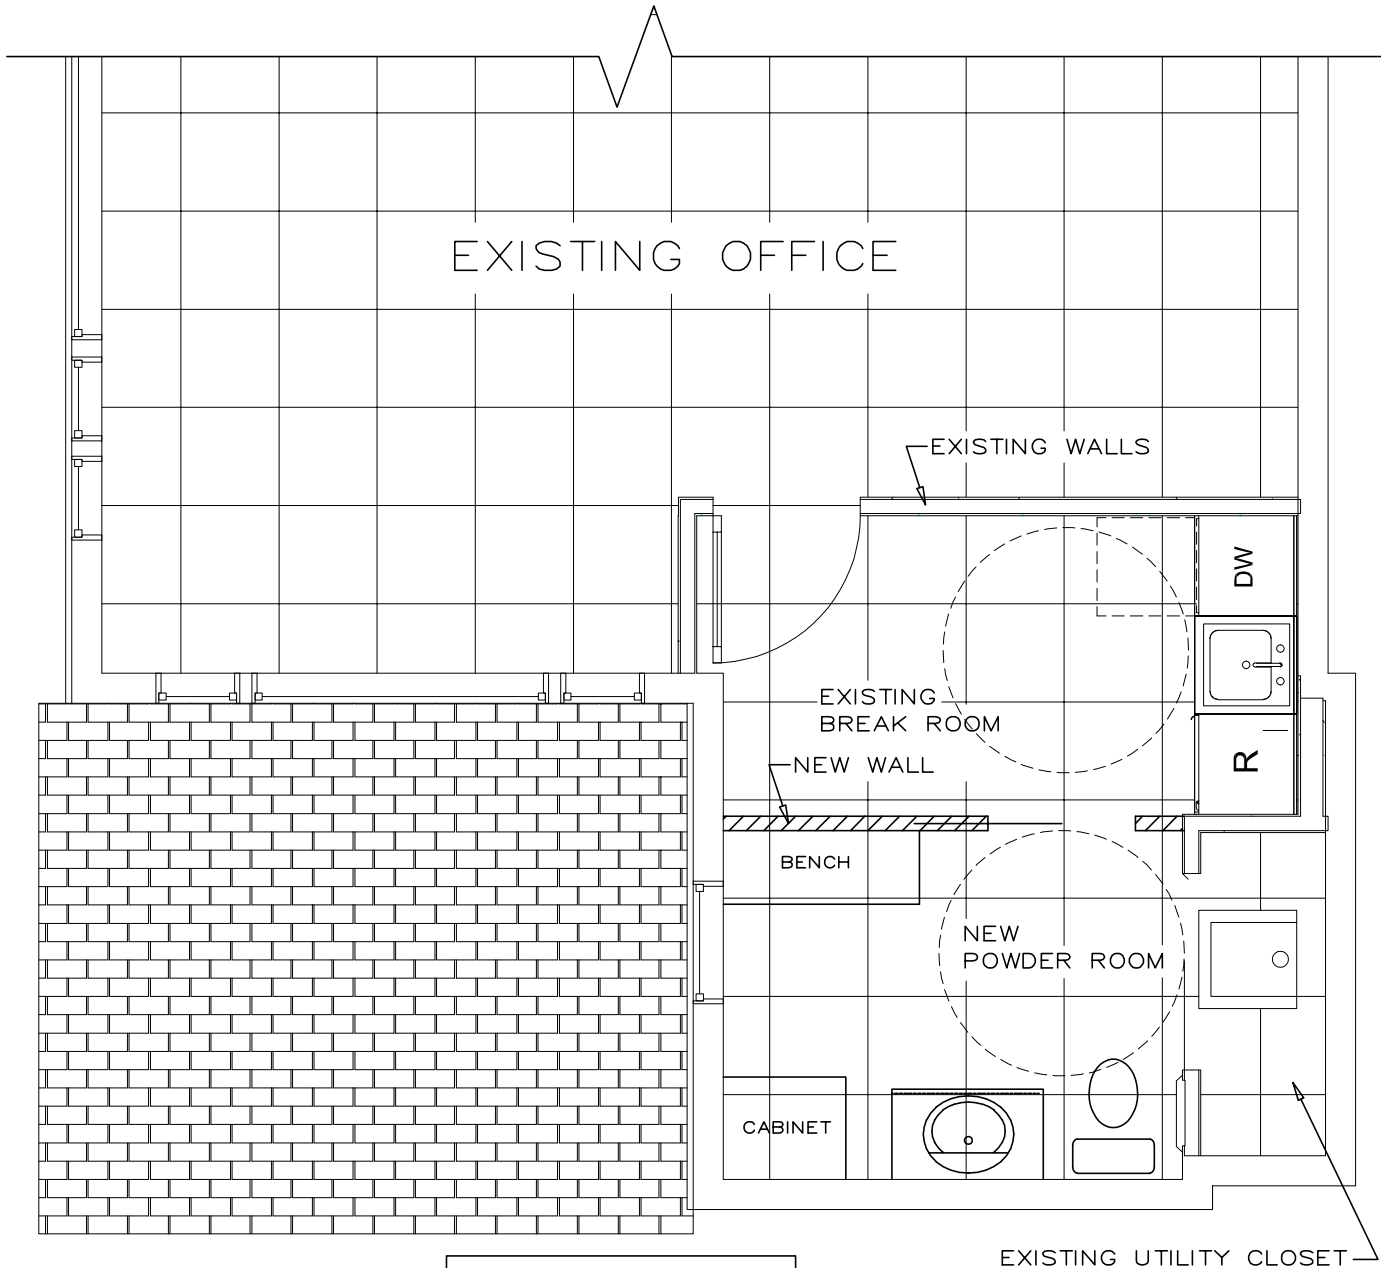

NEW 2x4 AT 16"o.c.
WALL WITH NEW 3'x6'-8"
POCKET DOOR - NEW
WATER CLOSET, VANITY,
CABINET AND BENCH.

Revised

09/23/2016 11:54:06 AM

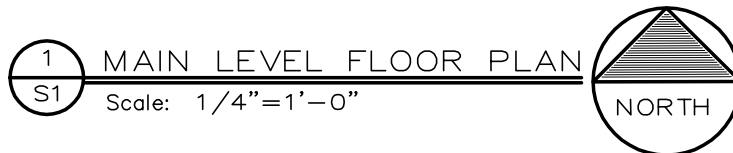

DEER PARK OFFICE ALTERATION

1855 SKI TIME SQUARE
STEAMBOAT SPRINGS, COLORADO



ENGINEERING DESIGNWORKS, INC.

EDW #16128

(970) 879-4890