


THE RICHARDSON DESIGN PARTNERSHIP, L.L.C.
 510 South 600 East
 Salt Lake City, Utah 84102
 P: 801.355.6886
 F: 801.355.6880

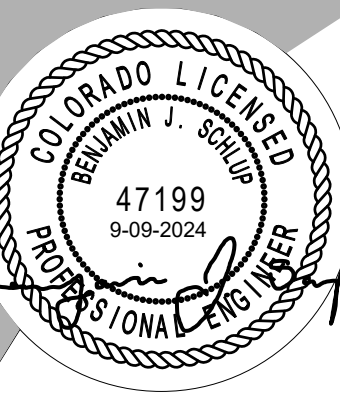

SPECTRUM ENGINEERS
 324 S. State St., Suite 400
 Salt Lake City, UT 84111
 800-678-7077
 801-328-5151
 fax: 801-328-5155
 www.spectrum-engineers.com

Reviewed for Code Compliance
 10/07/2024
 CONSULTANT


SERAC CAPITAL PARTNERS, LLC
 5051 WESTHEIMER RD. SUITE 1750
 HOUSTON, TX 77056
 OWNER:

CENTRAL PARK RESTAURANT T.I.
 1760 Central Park Dr.
 Steamboat Springs, CO
 PROJECT:

ISSUE DATE	DESCRIPTION
09/17/2024	
09/10/24	Owner Revisions

REV. DATE	DESCRIPTION
09/10/24	Owner Revisions


PERMIT SET
MECHANICAL DETAILS
RME501
 PROJECT #: 2020
 DRAWN BY: GBT
 CHECKED BY: SSJ
 SHEET #

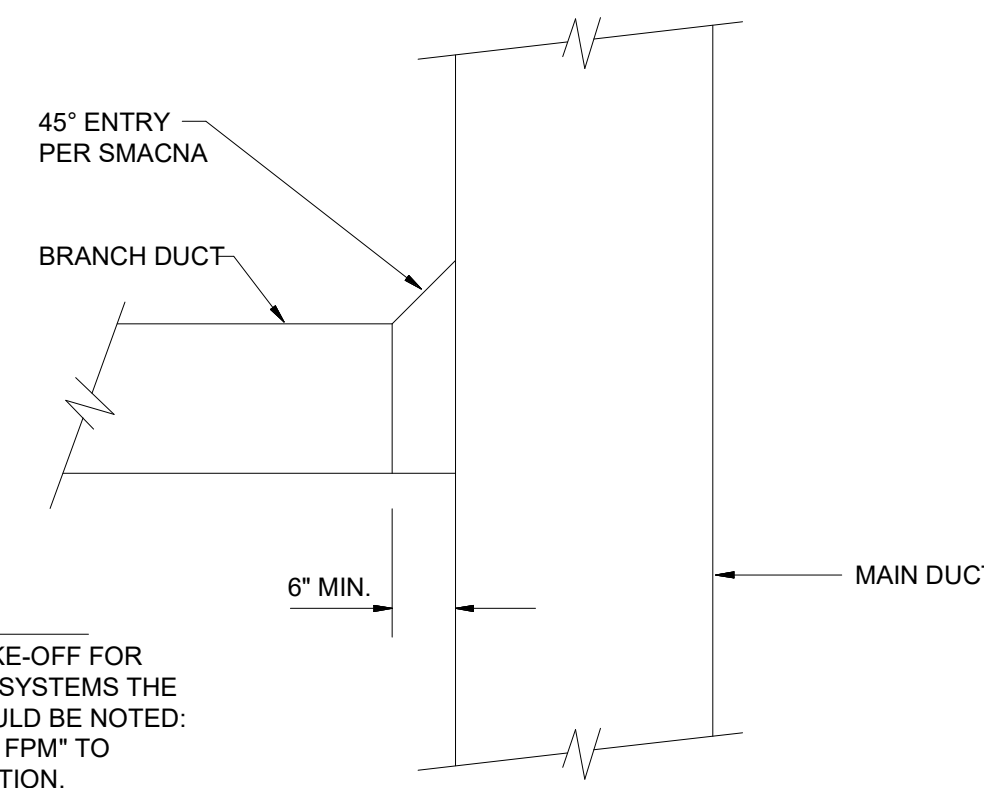

NOTE:
 WHEN USING THIS TAKE-OFF FOR HIGH VELOCITY DUCT SYSTEMS THE ENTRY OPENING SHOULD BE NOTED: "NOT TO EXCEED 1500 FPM" TO AVOID NOISE GENERATION.


8 TYPICAL DUCT TAKEOFF DETAIL

SCALE: NTS

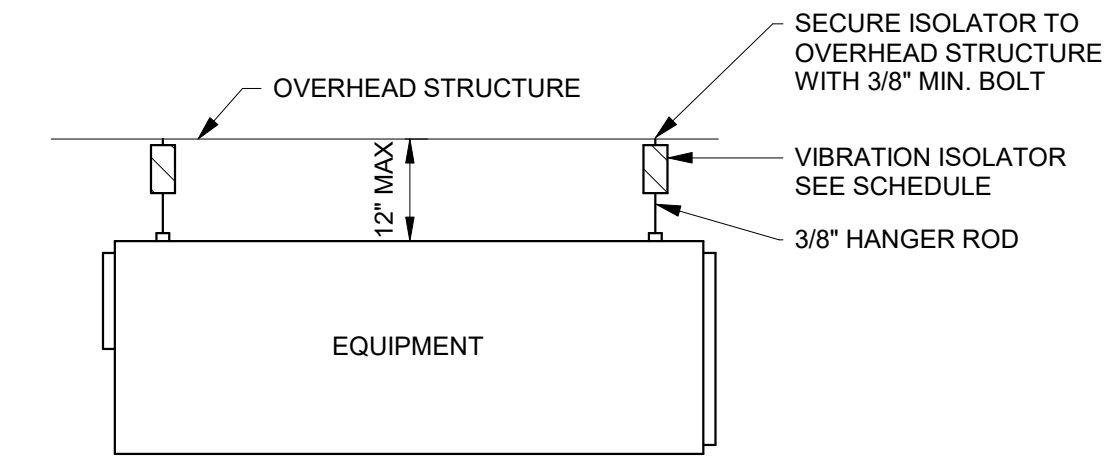

4 VIBRATION ISOLATOR - SUSPENDED


SCALE: NTS

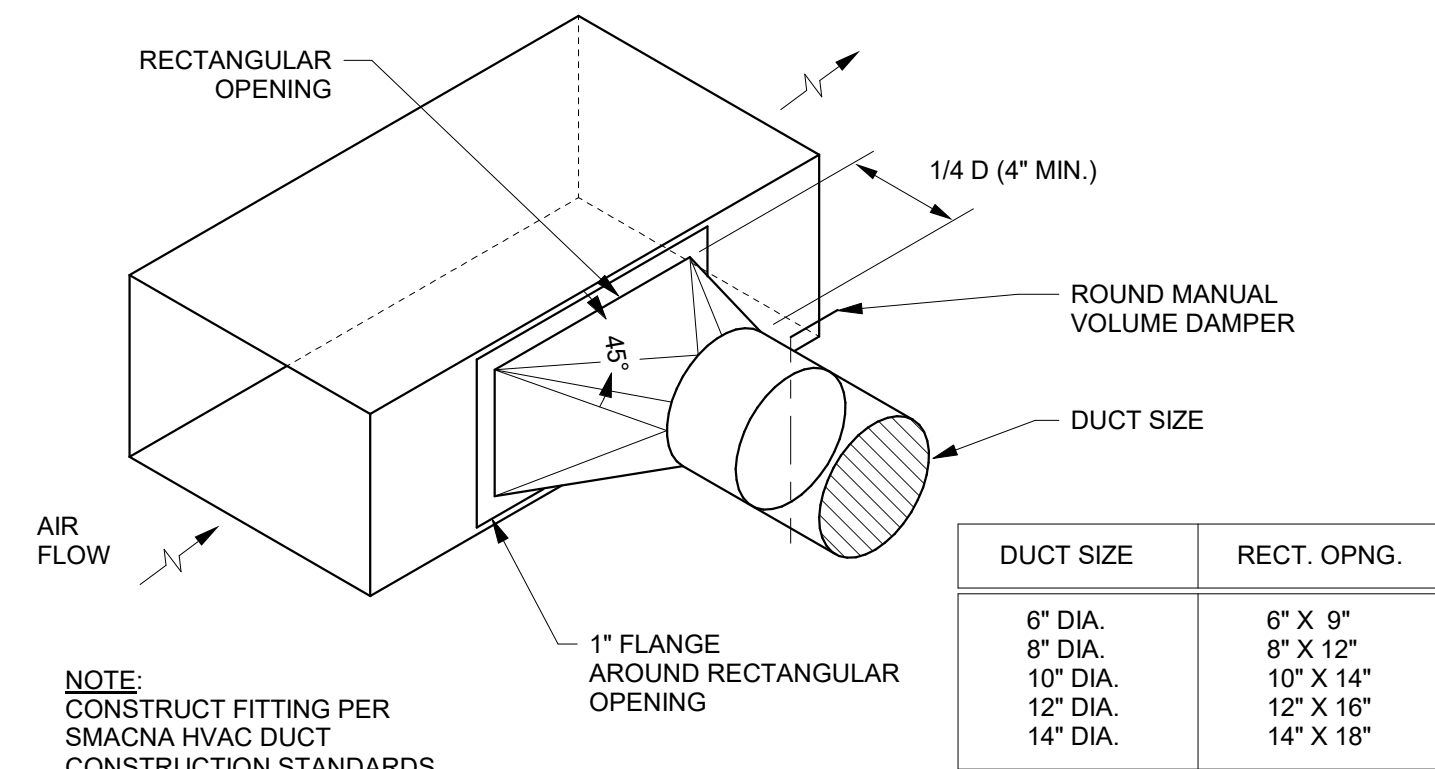

NOTE:
 CONSTRUCT FITTING PER SMACNA HVAC DUCT CONSTRUCTION STANDARDS METAL AND FLEXIBLE FIGURE 2-6.

7 DUCT HIGH EFFICIENCY TAKE-OFF


SCALE: NTS

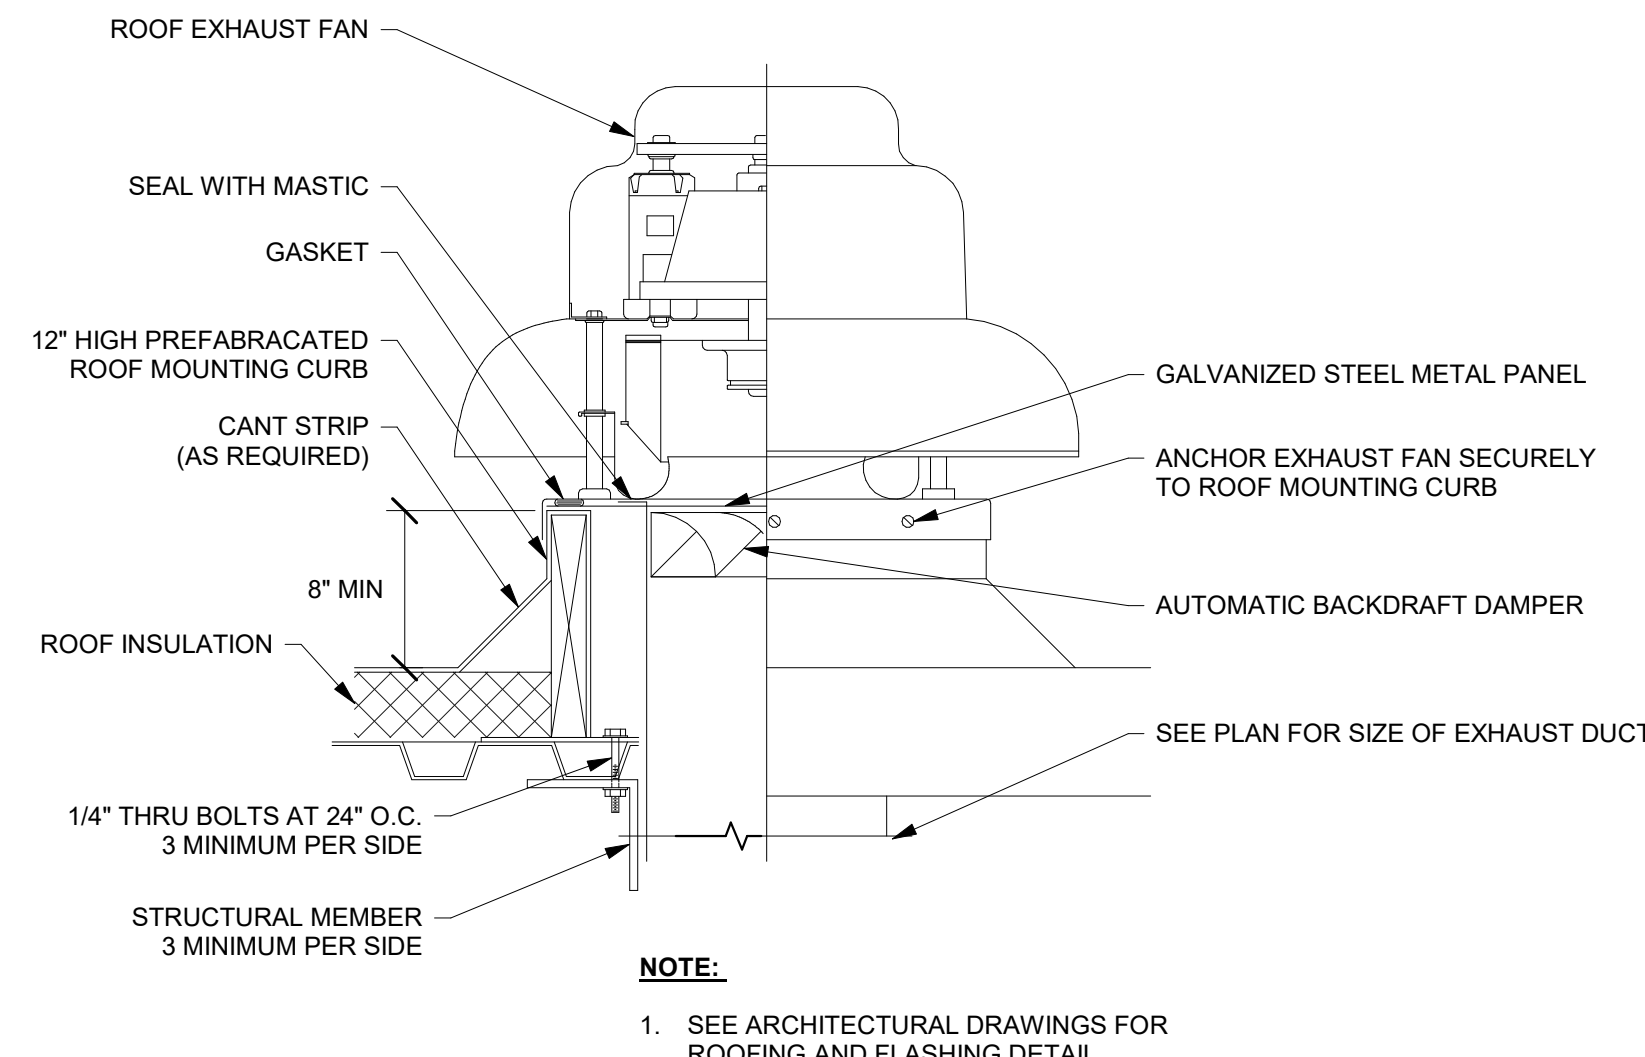

NOTE:
 1. SEE ARCHITECTURAL DRAWINGS FOR ROOFING AND FLASHING DETAIL.

3 ROOF EXHAUST FAN


SCALE: NTS

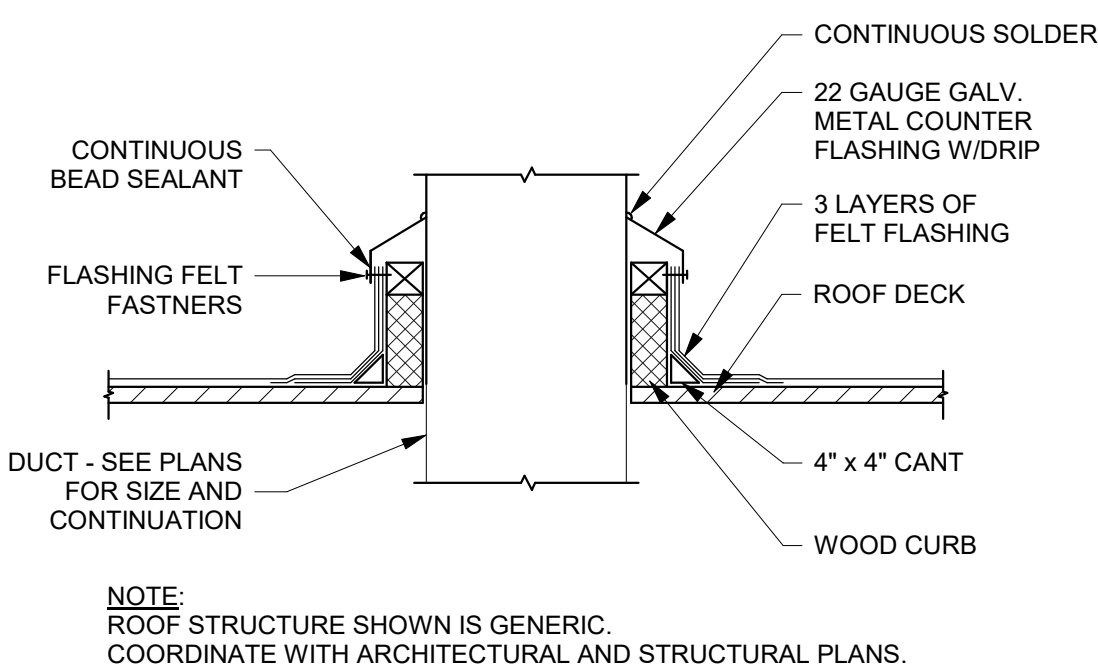

NOTE:
 ROOF STRUCTURE SHOWN IS GENERIC. COORDINATE WITH ARCHITECTURAL AND STRUCTURAL PLANS.

10 DUCT FLASHING DETAIL


SCALE: NTS

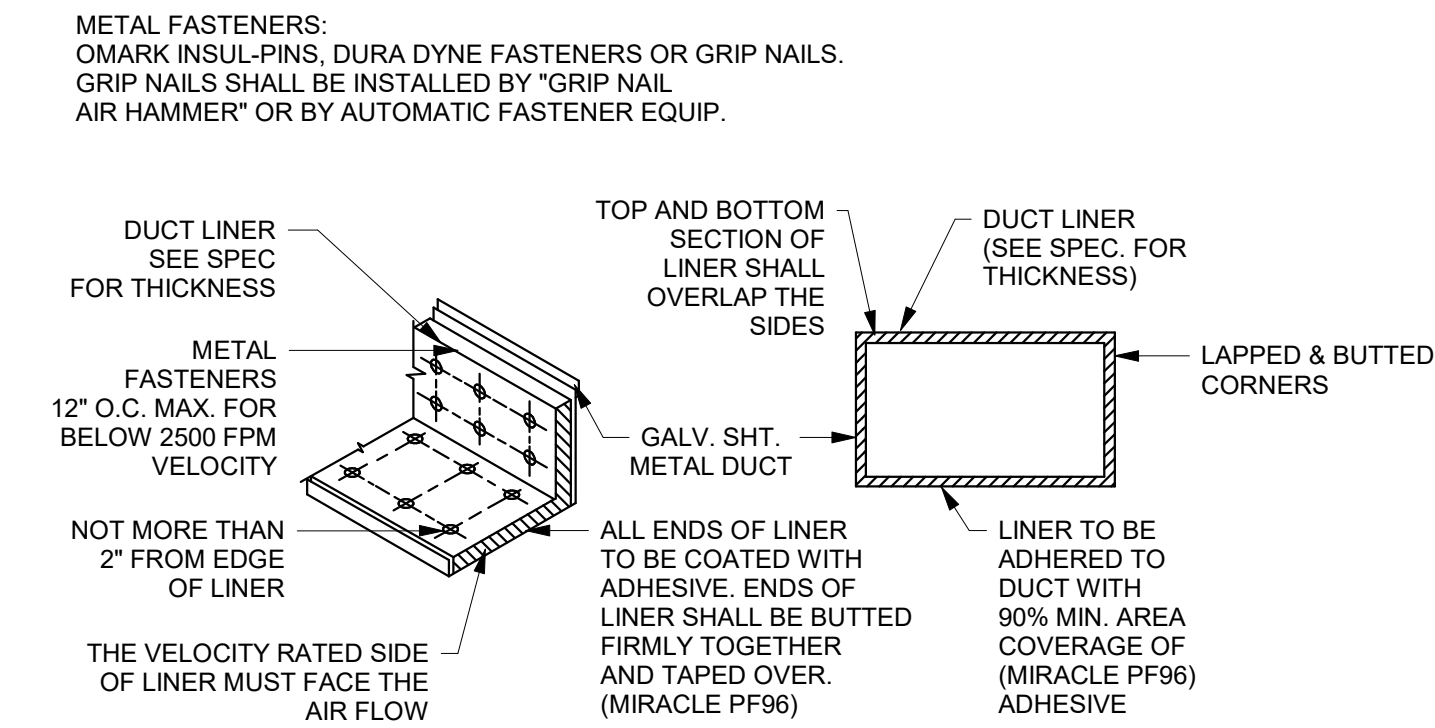

NOTE:
 THE VELOCITY RATED SIDE OF LINER MUST FACE THE AIR FLOW.

6 DUCT LINER

SCALE: NTS

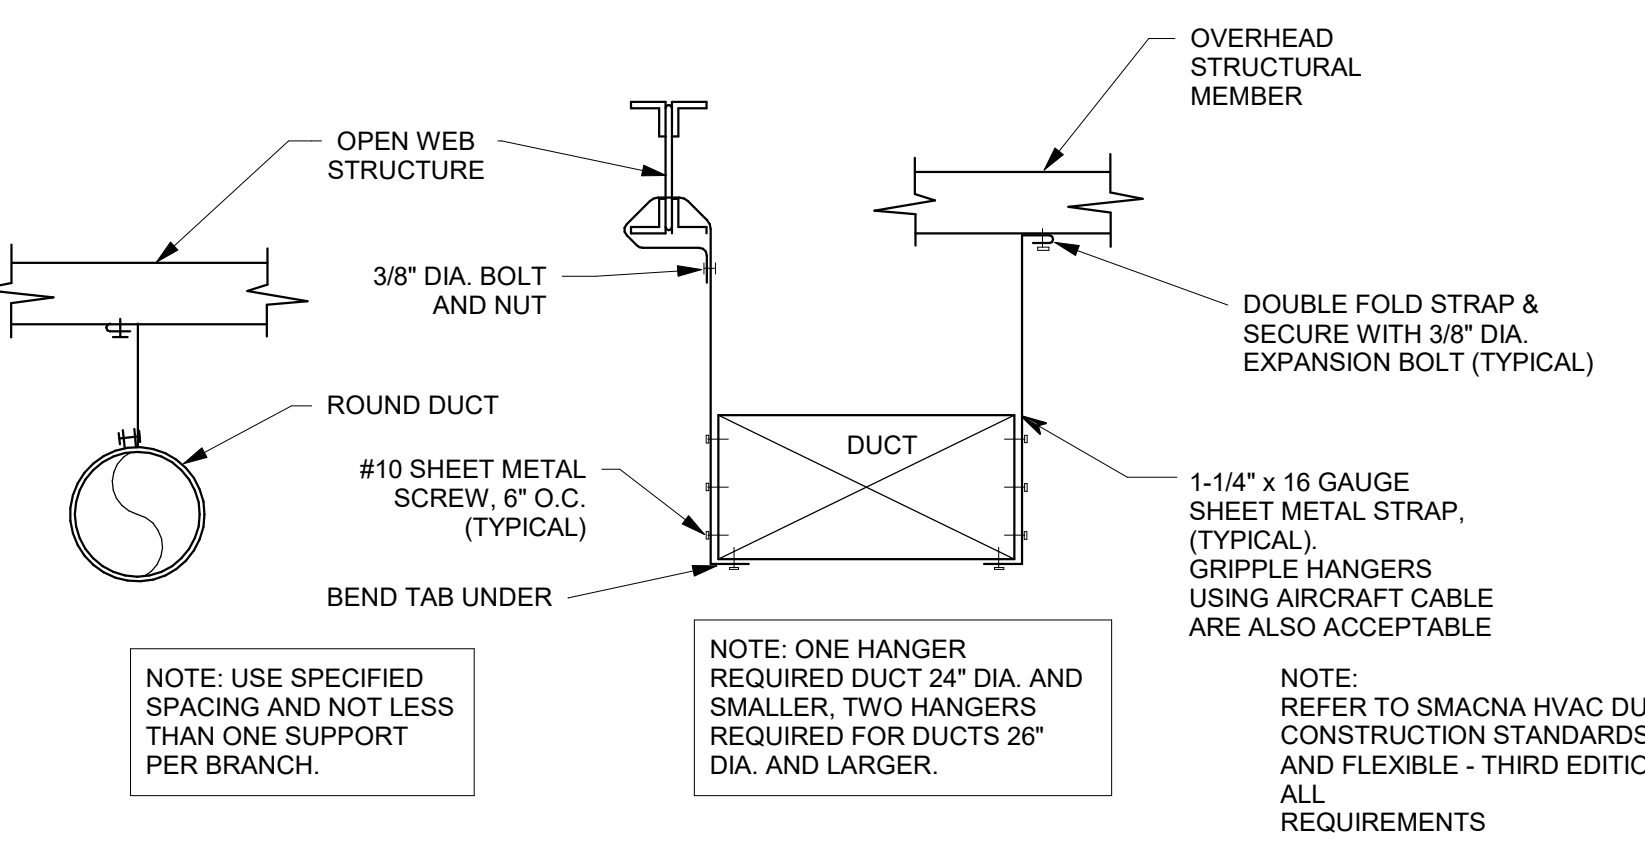


NOTE: USE SPECIFIED SPACING AND NOT LESS THAN ONE SUPPORT PER BRANCH.

NOTE: ONE HANGER REQUIRED DUCT 24\"/>

NOTE: REFER TO SMACNA HVAC DUCT CONSTRUCTION STANDARDS METAL AND FLEXIBLE - THIRD EDITION FOR ALL REQUIREMENTS.

2 DUCT HANGER

SCALE: NTS

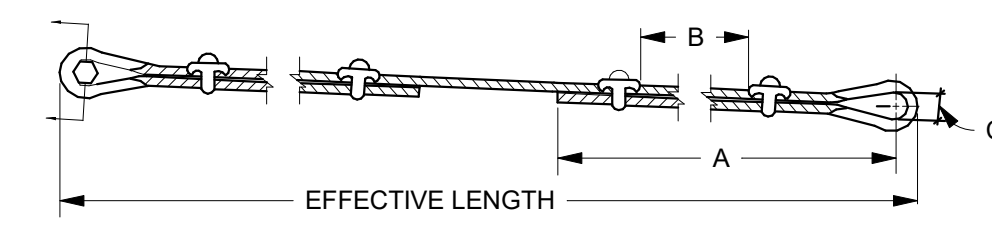


- NOTES:**
- CABLES, THIMBLES, CABLE CLIPS, GROMMETS, FLAT WASHERS AND NEOPRENE WASHERS ARE TO BE FURNISHED BY RESTRAINT MANUFACTURER. ALL OTHER HARDWARE TO BE PROVIDED BY CONTRACTOR.
 - CABLE CLIPS MUST BE ORIENTED AS SHOWN WITH SHORT END OF CABLE ON THE CURVED PART OF THE CLIP.
 - CABLE CLIPS (SAME SIZE AS CABLE) MUST BE ORIENTED AS SHOWN WITH SHORT END OF CABLE ON THE CURVED PART OF THE CLIP.
 - ENTIRE RESTRAINT SYSTEM SHALL BE AMBER BOOTH OR EQUAL.

CABLE DIA.	CABLE DESIGN	CABLE SCHEDULE			BOLT SIZE	ALLOWABLE LOAD (lb)	BREAKING STRENGTH (lb)
		A	B	C			
1/8"	7X19 GALV.	5-1/4"	1-5/8"	5/8"	3/8"	660	2000
3/16"	7X19 GALV.	5-3/4"	1-7/8"	5/8"	3/8"	1400	4200
1/4"	7X19 GALV.	6-3/4"	2-3/8"	11/16"	3/8"	2330	7000
5/16"	7X19 GALV.	7-3/8"	2-5/8"	13/16"	5/8"	3260	9800
3/8"	7X19 GALV.	8-7/8"	3-1/4"	1"	5/8"	4800	14400
7/16"	6X19 IWRC	17"	3-5/8"	1"	5/8"	5920	17800
1/2"	6X19 IWRC	18"	3-7/8"	1-1/8"	3/4"	7660	23000

9 CABLE CONSTRUCTION


SCALE: NTS

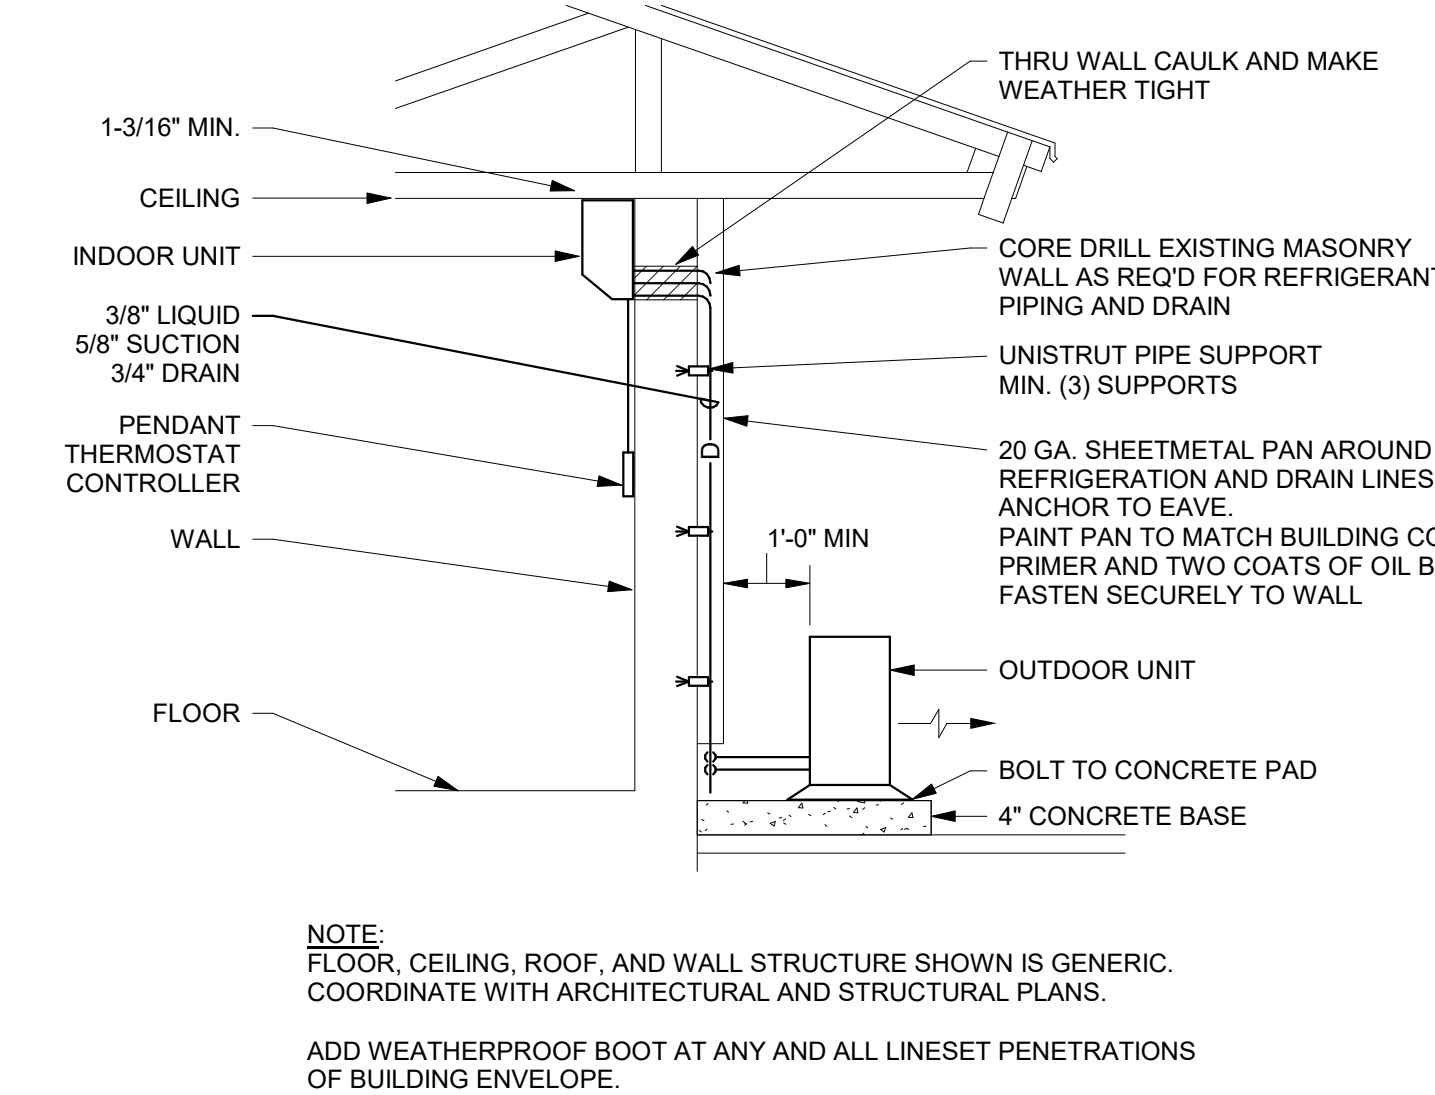

NOTE:
 FLOOR, CEILING, ROOF, AND WALL STRUCTURE SHOWN IS GENERIC. COORDINATE WITH ARCHITECTURAL AND STRUCTURAL PLANS.
 ADD WEATHERPROOF BOOT AT ANY AND ALL LINES/ET PENETRATIONS OF BUILDING ENVELOPE.

5 AIR CONDITIONING UNIT DETAIL


SCALE: NTS

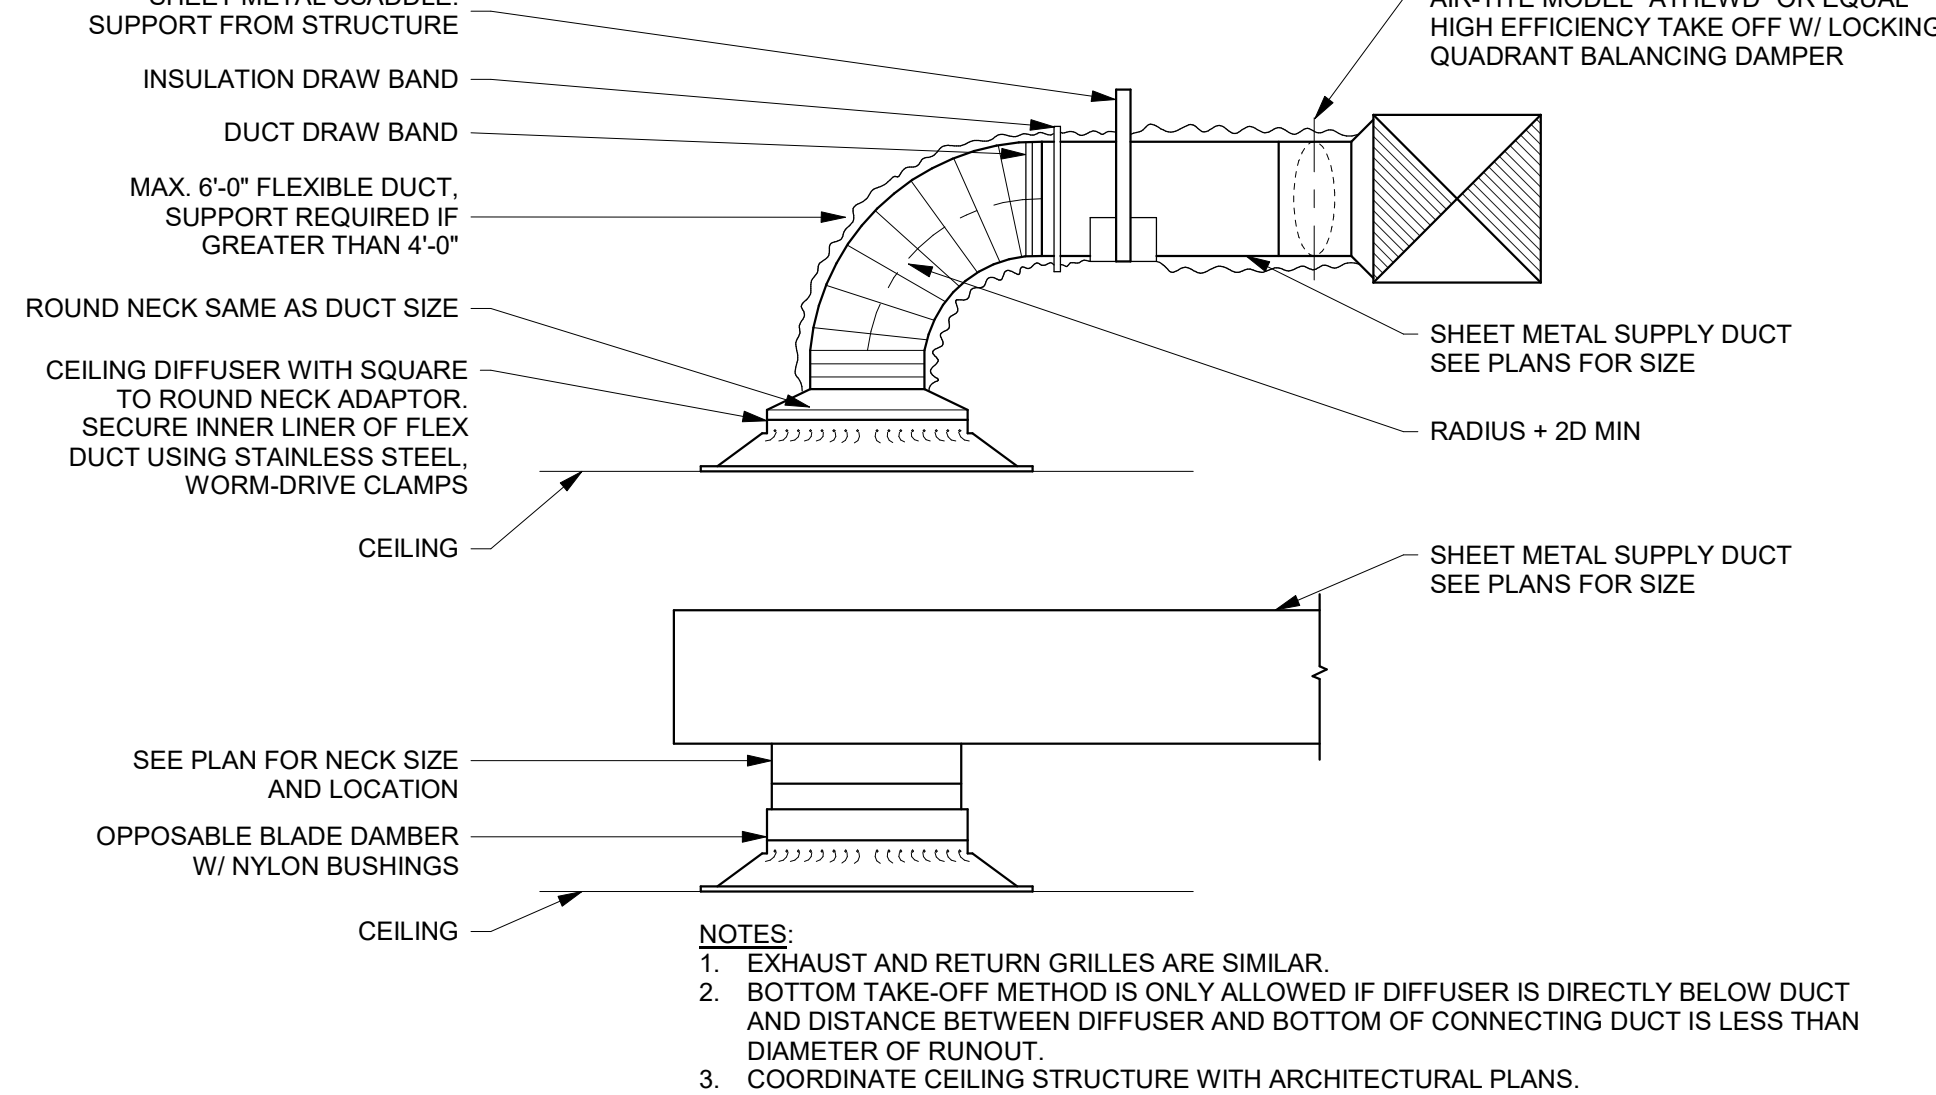


NOTES:
 1. EXHAUST AND RETURN GRILLES ARE SIMILAR.
 2. BOTTOM TAKE-OFF METHOD IS ONLY ALLOWED IF DIFFUSER IS DIRECTLY BELOW DUCT AND DISTANCE BETWEEN DIFFUSER AND BOTTOM OF CONNECTING DUCT IS LESS THAN DIAMETER OF RUNOUT.
 3. COORDINATE CEILING STRUCTURE WITH ARCHITECTURAL PLANS.

1 CEILING DIFFUSER DETAIL WITH DUCTING

SCALE: NTS

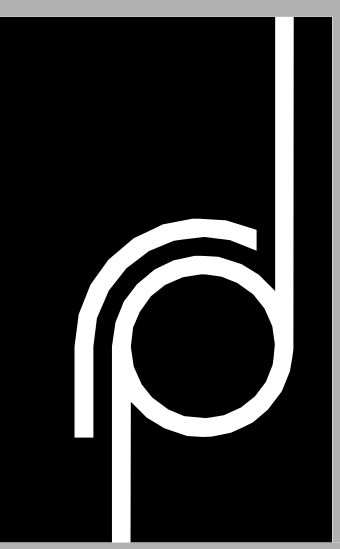

THE RICHARDSON DESIGN PARTNERSHIP, L.L.C.
 510 South 600 East
 Salt Lake City, Utah 84102
 P: 801.355.6886
 F: 801.355.6880

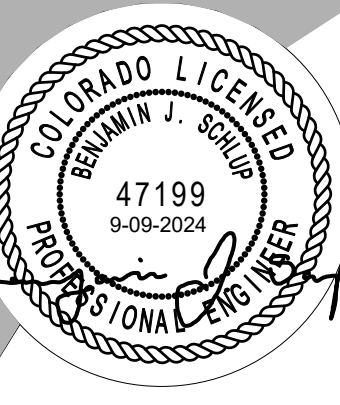

ALL DRAWINGS, SPECIFICATIONS AND CONTRACT DOCUMENTS SHALL BE READ IN CONJUNCTION WITH THE PROJECT MANUAL AND THE SUPPLEMENTAL SPECIFICATIONS TO THE PROJECT MANUAL. THE CONTRACTOR SHALL BE RESPONSIBLE FOR OBTAINING ALL NECESSARY PERMITS AND APPROVALS FROM THE APPLICABLE AGENCIES. THE CONTRACTOR SHALL BE RESPONSIBLE FOR OBTAINING ALL NECESSARY PERMITS AND APPROVALS FROM THE APPLICABLE AGENCIES. THE CONTRACTOR SHALL BE RESPONSIBLE FOR OBTAINING ALL NECESSARY PERMITS AND APPROVALS FROM THE APPLICABLE AGENCIES.

SPECTRUM ENGINEERS
 324 S. State St., Suite 400
 Salt Lake City, UT 84111
 800-878-7077
 801-328-5151
 fax: 801-328-5155
 www.spectrum-engineers.com


Reviewed for Code Compliance
 10/07/2024
 CONSULTANT

SERAC CAPITAL PARTNERS, LLC
 5051 WESTHEIMER RD. SUITE 1750
 HOUSTON, TX 77056
 OWNER:


CENTRAL PARK RESTAURANT T.I.
 1760 Central Park Dr.
 Steamboat Springs, CO
 PROJECT:

ISSUE DATE	DESCRIPTION
06/17/2024	
REV. DATE	DESCRIPTION
09/10/24	Owner Revisions


PERMIT SET
MECHANICAL DETAILS
RME502
 PROJECT # 2020
 DRAWN BY: GBT
 SHEET #
 CHECKED BY: SSJ

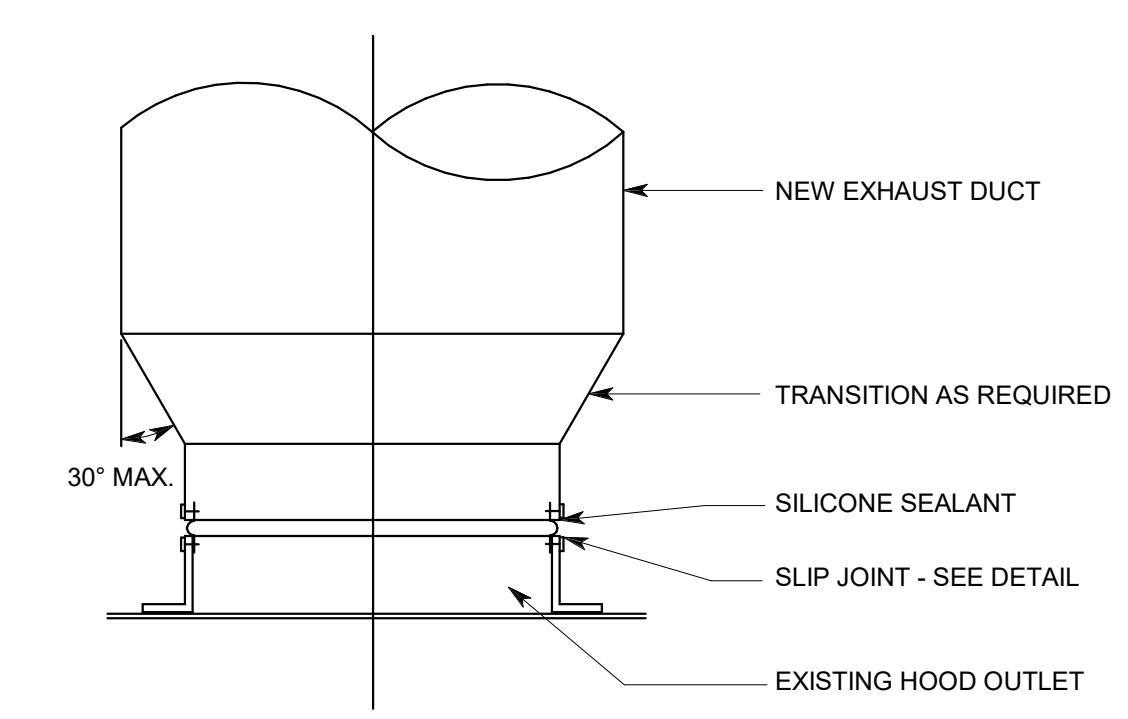


3 HOOD CONNECTION DETAIL
 SCALE: NTS

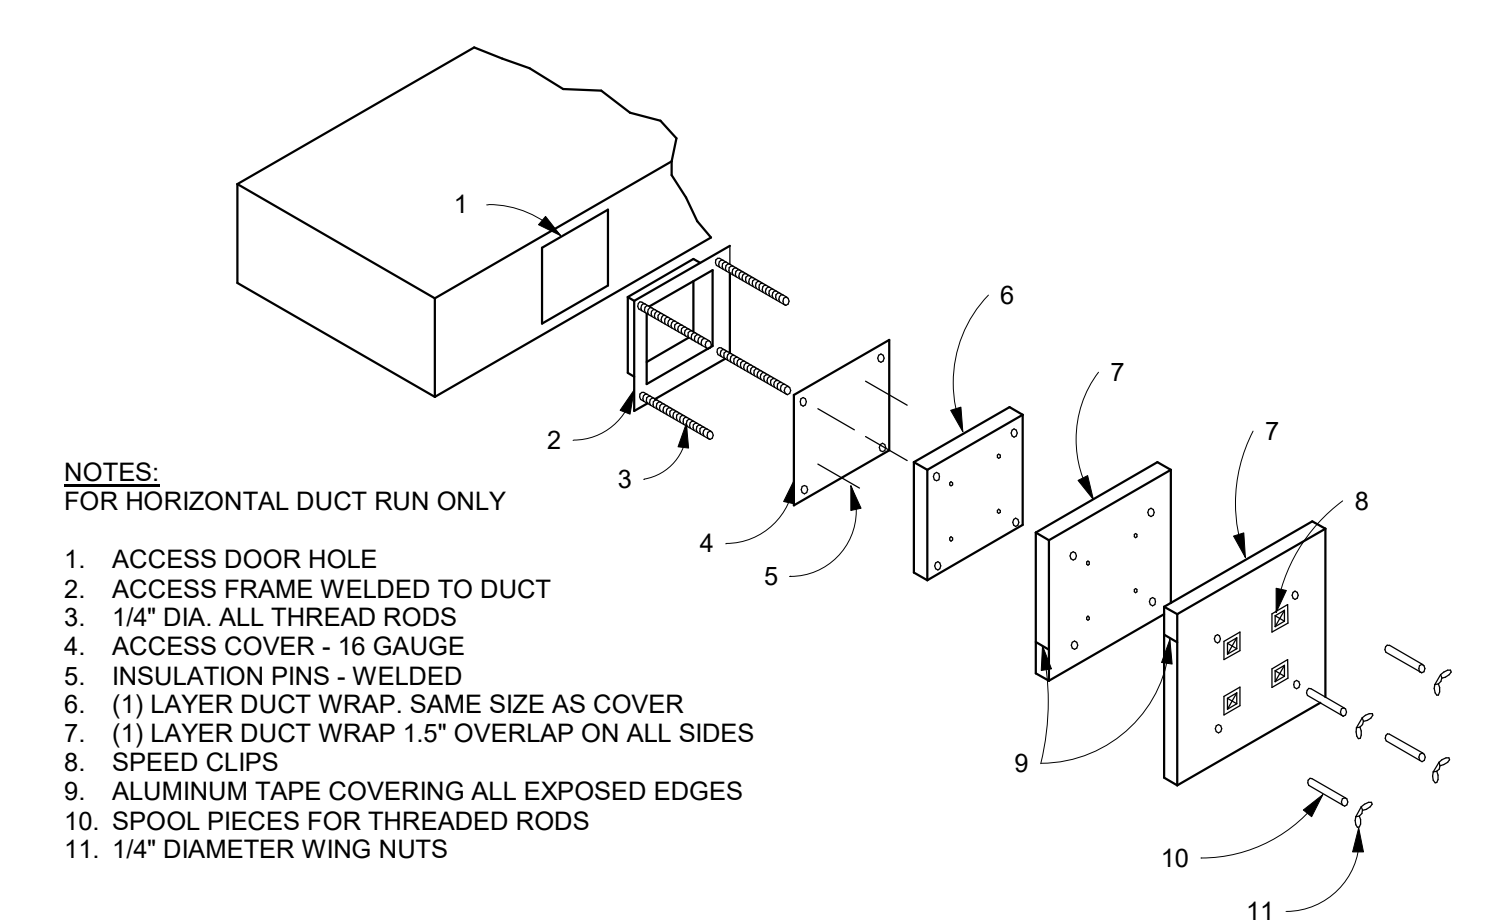

2 GREASE DUCT ACCESS DOOR DETAIL
 SCALE: NTS

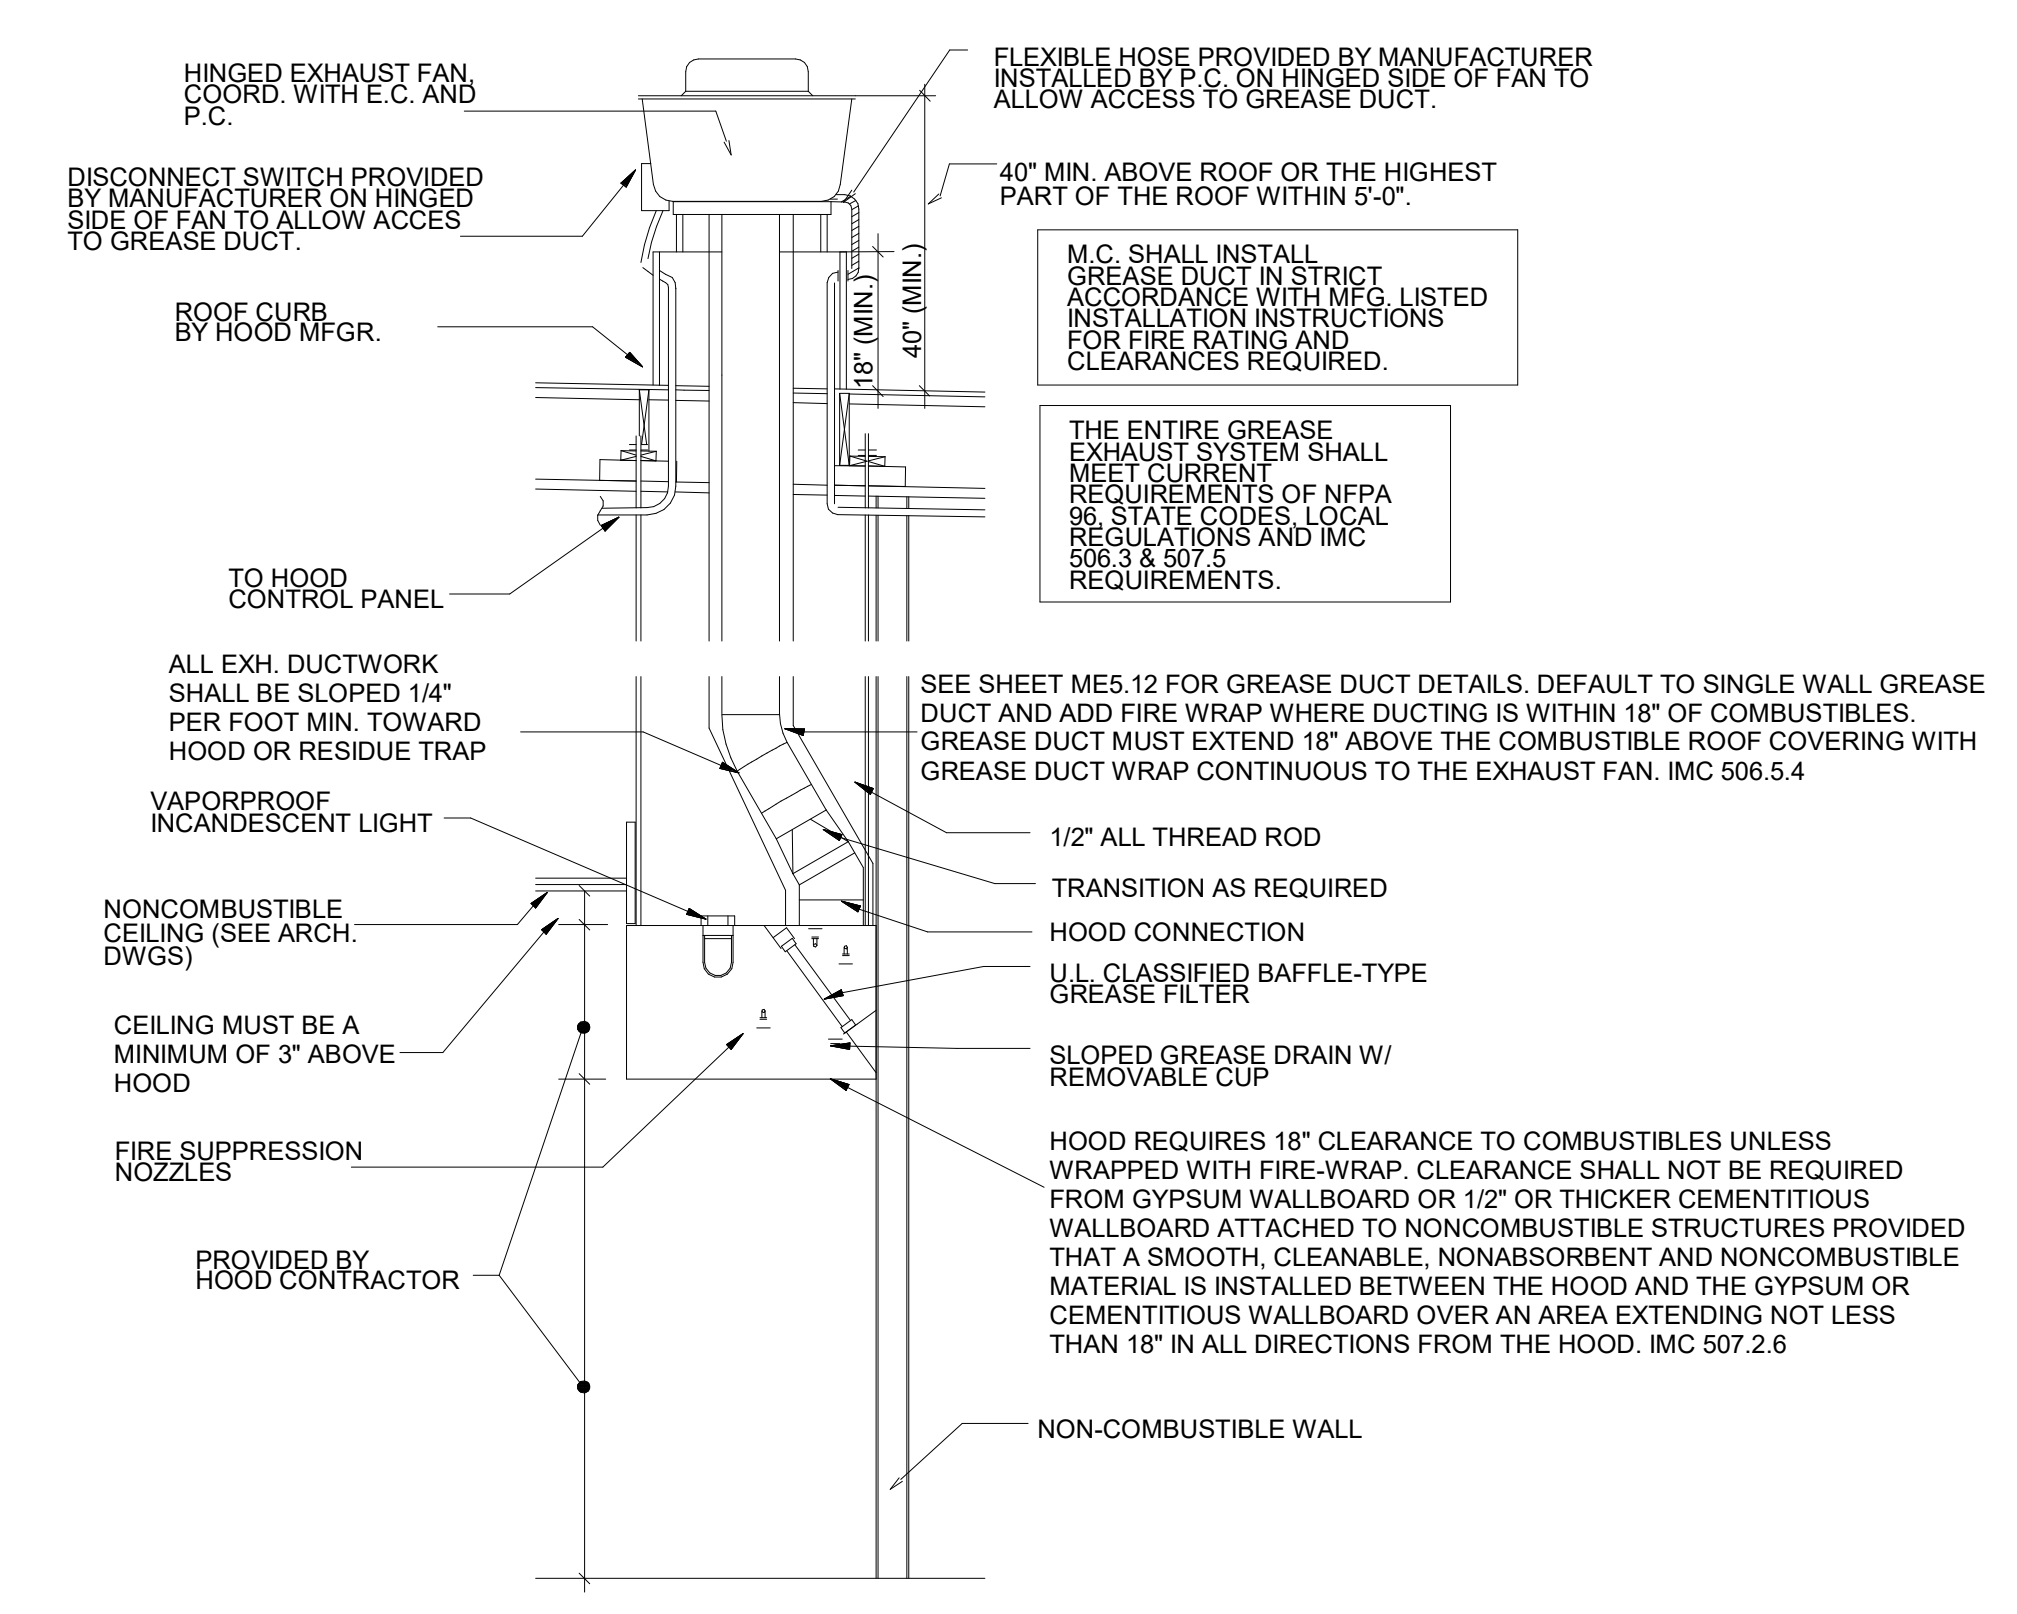


1 TYP. TYPE 1 GREASE HOOD AND DUCT DETAIL
 SCALE: NTS

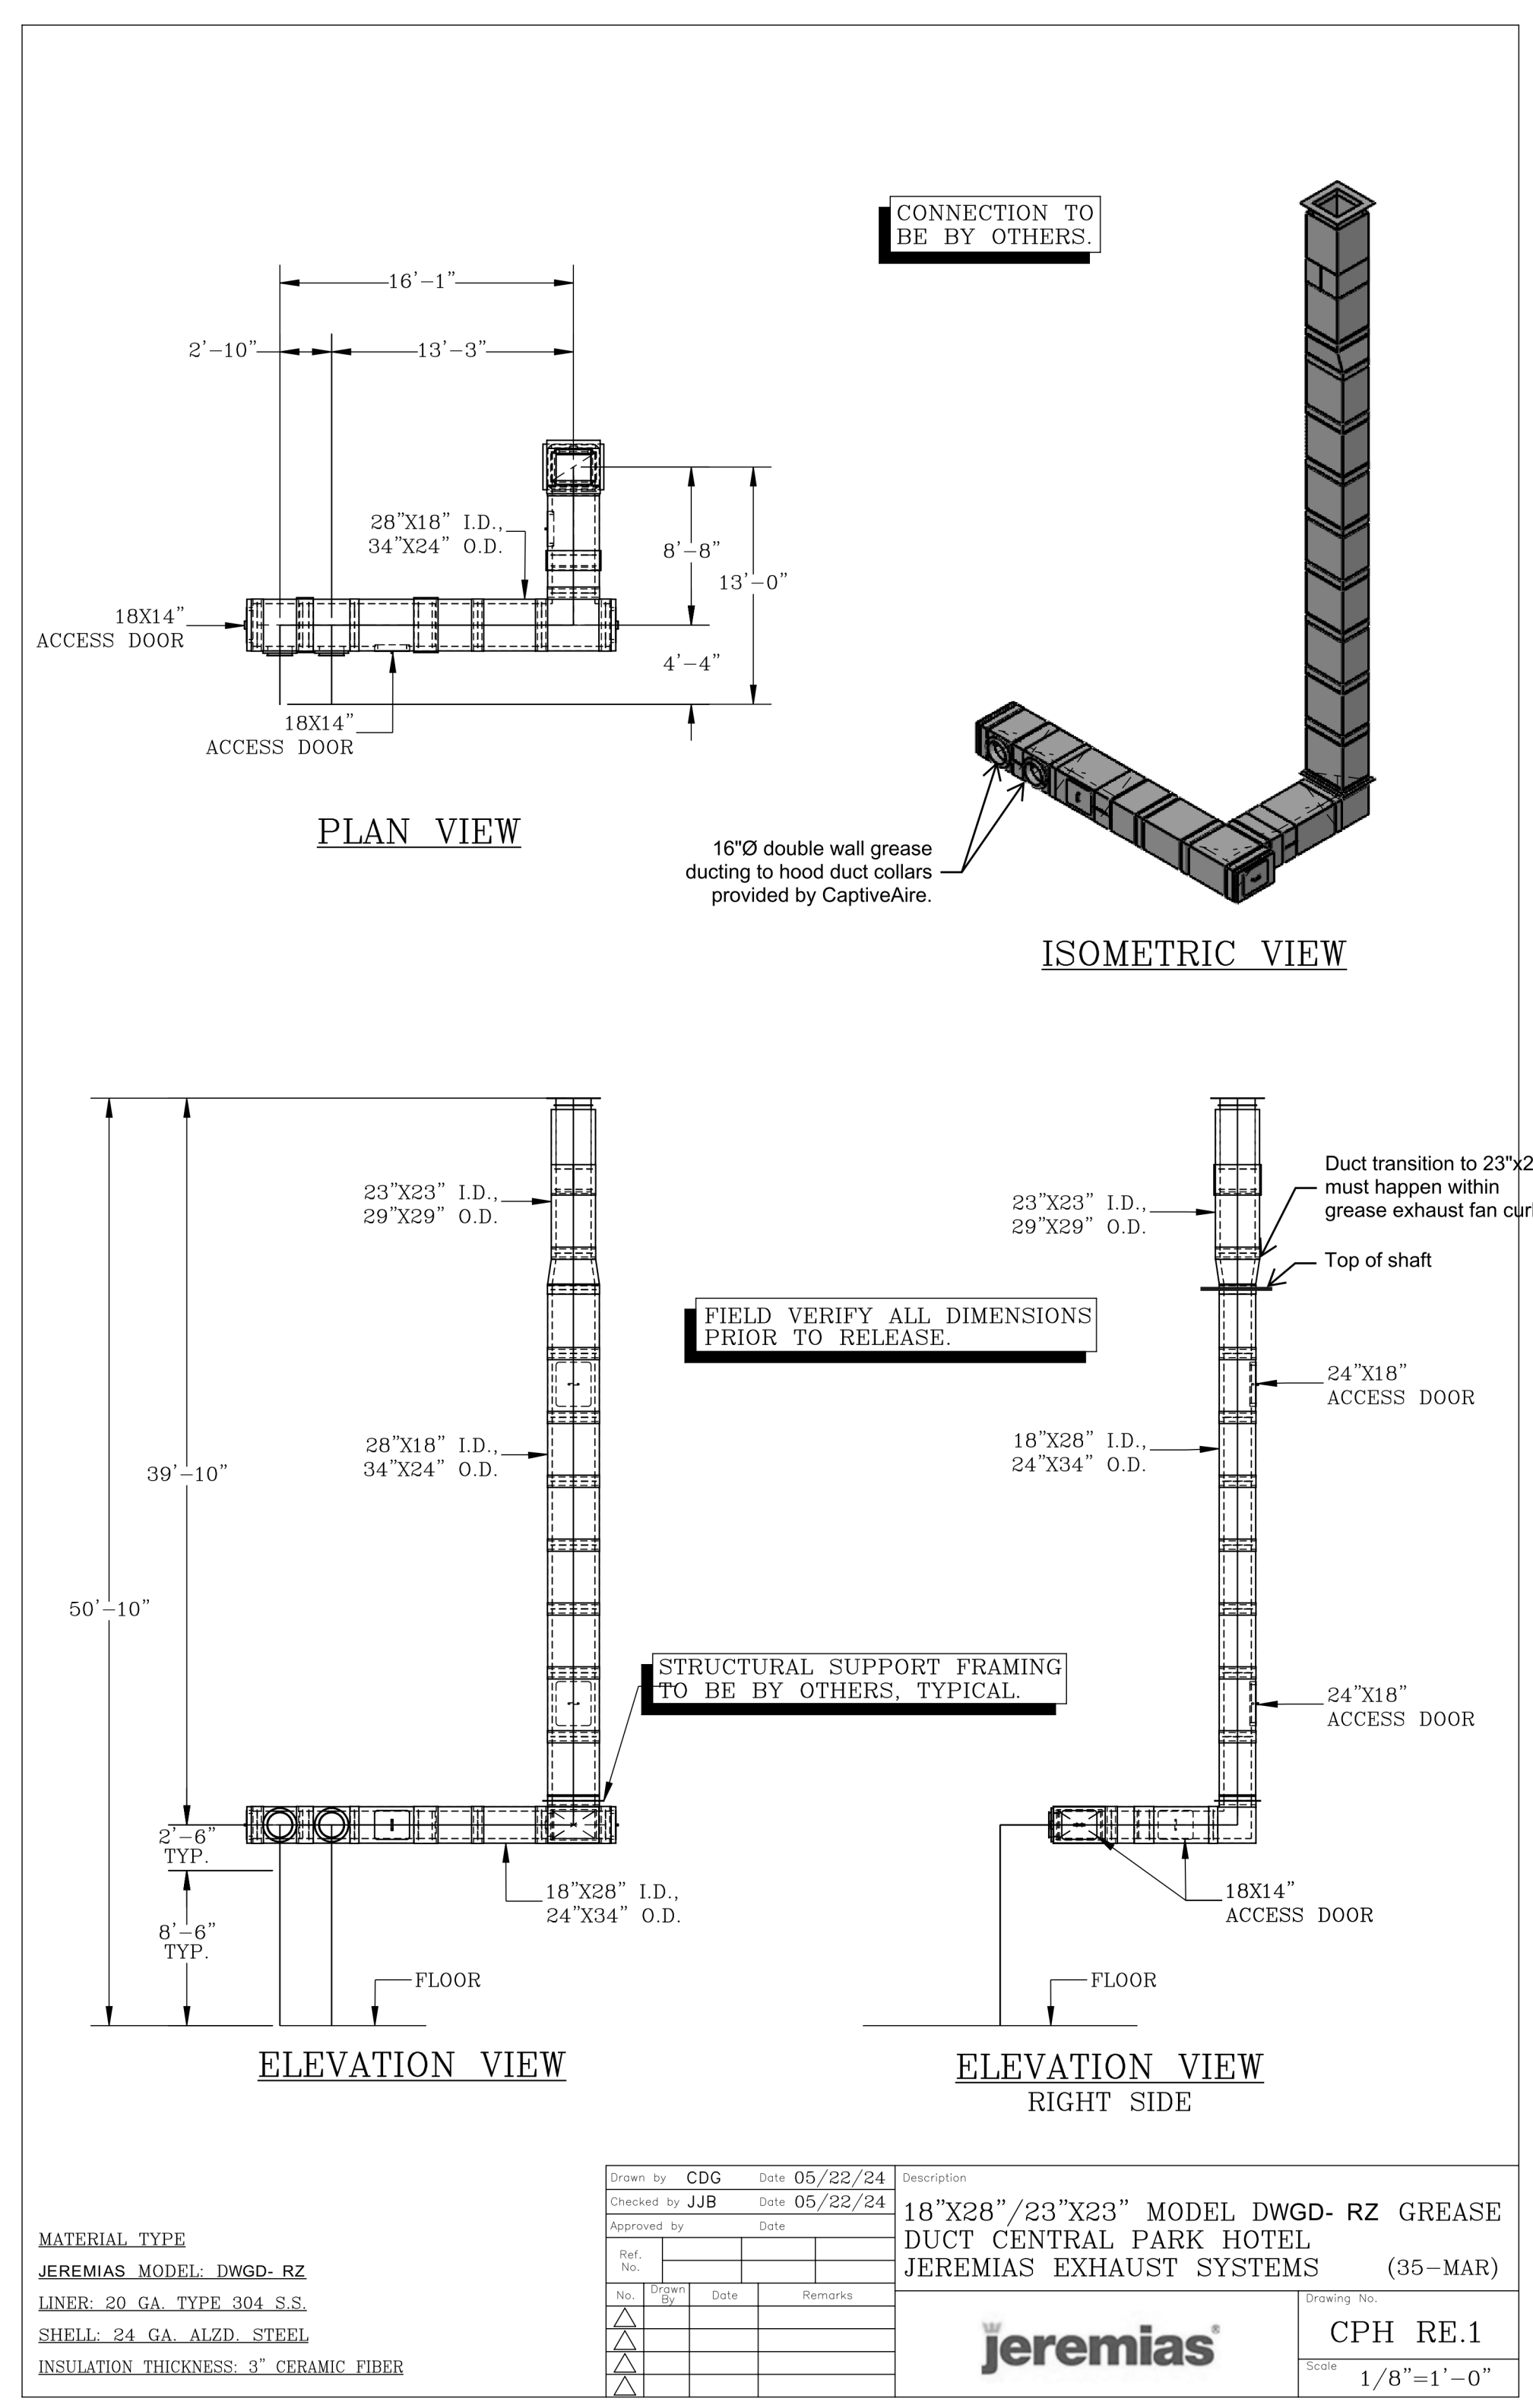


GREASE DUCT LAYOUT BY JEREMIAS
 (also reference shaft section view on sheet MH101)

Drawn by: CDG	Date: 05/22/24	Description:
Checked by: JJB	Date: 05/22/24	18\"/>
Approved by:	Date:	JEREMIAS EXHAUST SYSTEMS (35-MAR)
Scale:		CPH RE.1
Notes:		1/8\"/>

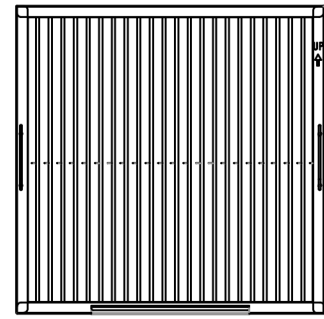

Captrate Grease-Stop Solo Filter

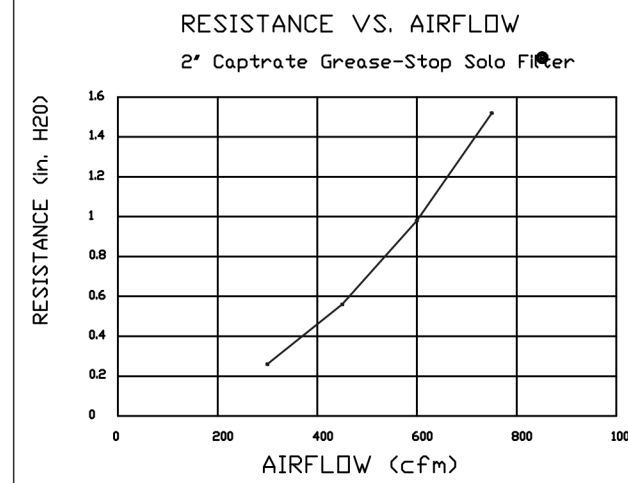

Filter Detail CAPRATE

EXHAUST CFM=LENGTH OF HOOD X CFM/LIN.FT. (LOAD)
SUPPLY CFM=EXHAUST CFM X PERCENTAGE REQUIRED
TOTAL DUCT AREA=144 X CFM FPM(2)
DUCT LENGTH= TOTAL DUCT AREA DUCT DEPTH


CALCULATIONS UTILIZED

CAPTIVE-AIRE HOODS ARE BUILT IN COMPLIANCE WITH

- NFPA #89
ETL SANITATION
ETL LISTED 3054804-001
ETL IS LISTED TO IEC STANDARDS
NSF




BUILDING CODES

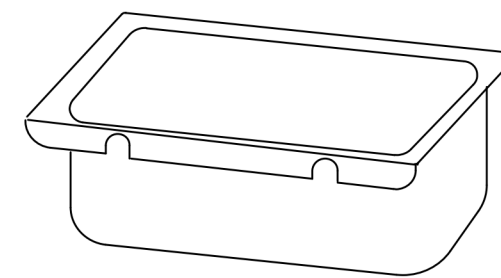

Grease Cup will be supported by 2 studs on the inside wall of the hood. The grease will drain through a concealed grease trough and into this removable cup.

1/2 Pint Grease Cup Detail

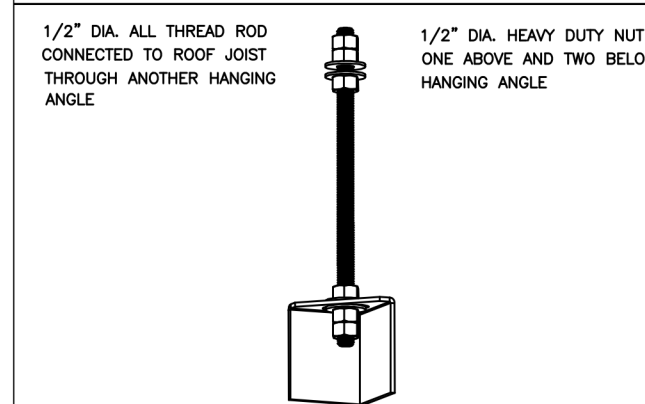

* ROD AND NUTS TO BE SUPPLIED BY INSTALLING CONTRACTOR. HANGING ANGLE IS PRE-FURNISHED AT FACTORY.

ND-2 HANGING ANGLE DETAIL

Table with columns: HOOD STYLE, DIM FROM REAR, DIM FROM FRONT (24" High Hood), DIM FROM FRONT (30" High Hood). Rows include Wall Exhaust Only, Wall Exhaust Only with MUA, Back Shelf Exhaust Only, Back Shelf Exhaust Only with MUA, and Condensate.

HANGING ANGLE LOCATIONS

FOR QUESTIONS, CALL THE Utah Office REGION 87 PHONE: (801) 878 - 3677 EMAIL: reg87@captiveaire.com

PATENT NUMBERS EXHAUST HOODS ND-2/BD-2/SND-2 (CANADA) - CA PATENT 2520435 C.

HOOD INFORMATION - JOB#6744566

Table with columns: HOOD NO, TAG, MODEL, MANUFACTURER, LENGTH, MAX COOKING TEMP, TYPE, APPLIANCE DUTY, DESIGN CFM/FT, TOTAL EXH CFM, EXHAUST PLENUM (WIDTH, LENG, HEIGHT, DIA, CFM, VEL, SP), HOOD CONSTRUCTION, HOOD CONFIG (END TO END, ROW).

HOOD INFORMATION

Table with columns: HOOD NO, TAG, TYPE, FILTER(S) (QTY, HEIGHT, LENGTH, EFFICIENCY @ 7 MICRONS), LIGHT(S) (QTY, TYPE, WIRE GUARD, LOCATION, SIZE), UTILITY CABINET(S) (FIRE SYSTEM, SIZE, MODEL #), ELECTRICAL, SWITCHES (QUANTITY), FIRE SYSTEM (PIPING, WEIGHT).

HOOD OPTIONS

Table with columns: HOOD NO, TAG, OPTION. Lists options for hood ends, riser sensors, and structural panels.

SYSTEM DESIGN VERIFICATION (SDV)

IF ORDERED, GAS SERVICE WILL PERFORM A SYSTEM DESIGN VERIFICATION (SDV) ONCE ALL EQUIPMENT HAS HAD A COMPLETE START UP PER THE OPERATION AND INSTALLATION MANUAL. TYPICALLY, THE SDV WILL BE PERFORMED AFTER ALL INSPECTIONS ARE COMPLETE.

ANY FIELD RELATED DISCREPANCIES THAT ARE DISCOVERED DURING THE SDV WILL BE BROUGHT TO THE ATTENTION OF THE GENERAL CONTRACTOR AND CORRESPONDING TRADES ON SITE. THESE ISSUES WILL BE DOCUMENTED AND FORWARDED TO THE APPROPRIATE SALES OFFICE. IF GAS SERVICE HAS TO RESOLVE A DISCREPANCY THAT IS A FIELD ISSUE, THE GENERAL CONTRACTOR WILL BE NOTIFIED AND BILLED FOR THE WORK. SHOULD A RETURN TRIP BE REQUIRED DUE TO ANY FIELD RELATED DISCREPANCY THAT CANNOT BE RESOLVED DURING THE SDV, THERE WILL BE ADDITIONAL TRIP CHARGES.

DURING THE SDV, GAS SERVICE WILL ADDRESS ANY DISCREPANCY THAT IS THE FAULT OF THE MANUFACTURER. SHOULD A RETURN TRIP BE REQUIRED, THE GENERAL CONTRACTOR AND APPROPRIATE SALES OFFICE WILL BE NOTIFIED. THERE WILL BE NO ADDITIONAL CHARGES FOR MANUFACTURER DISCREPANCIES.

REVISIONS table, CAPTIVE logo, Utah Office address and contact info, project name: Steamboat Springs Restaurant TI, location: Steamboat Springs, CO, 80477.

THE RICHARDSON DESIGN PARTNERSHIP, L.L.C. logo and contact information.

SPECTRUM ENGINEERS logo and contact information.


Reviewed for Code Compliance 10/07/2024 stamp.

SERAC CAPITAL PARTNERS, LLC logo and address: 5051 WESTHEIMER RD. SUITE 1750 HOUSTON, TX 77056.

CENTRAL PARK RESTAURANT T.I. logo and address: 1760 Central Park Dr. Steamboat Springs, CO.


Table with columns: ISSUE DATE, DESCRIPTION, REV. DATE, DESCRIPTION. Shows revision history.

PERMIT SET MECHANICAL KITCHEN EQUIPMENT RME503 logo and project details.

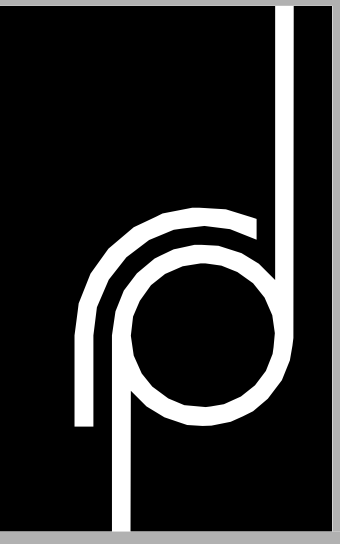

THE
RICHARDSON
DESIGN
PARTNERSHIP,
L.L.C.

510 South 600 East
Salt Lake City, Utah 84102
P: 801.355.6886
F: 801.355.6880

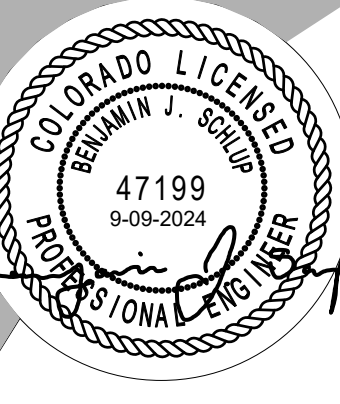

THE ENGINEER HEREBY CERTIFIES THAT HE HAS PREPARED THIS DOCUMENT IN ACCORDANCE WITH THE REQUIREMENTS OF THE PROFESSIONAL ENGINEERING ACT AND THE REGULATIONS OF THE BOARD OF PROFESSIONAL ENGINEERS AND ARCHITECTS OF THE STATE OF COLORADO. THE ENGINEER'S DESIGN PARTNERSHIP, L.L.C. IS AN EQUAL OPPORTUNITY FIRM.

SPECTRUM
ENGINEERS
324 S. State St., Suite 400
Salt Lake City, UT 84111
800-878-7077
801-328-5151
fax: 801-328-5155
www.spectrum-engineers.com

Reviewed for
Code
Compliance
10/07/2024
CONSULTANT

SERAC CAPITAL PARTNERS, LLC
5051 WESTHEIMER RD. SUITE 1750
HOUSTON, TX 77056
OWNER:

**CENTRAL PARK
RESTAURANT T.I.**
1760 Central Park Dr.
Steamboat Springs, CO
PROJECT:


ISSUE DATE	DESCRIPTION
06/17/2024	
09/10/24	Owner Revisions

REV. DATE	DESCRIPTION
09/10/24	Owner Revisions

PERMIT SET
**MECHANICAL
KITCHEN EQUIPMENT**
PROJECT # 2408
DRAWN BY: EHT
CHECKED BY: SSJ
RME505

REVISIONS

NO.	DESCRIPTION	DATE


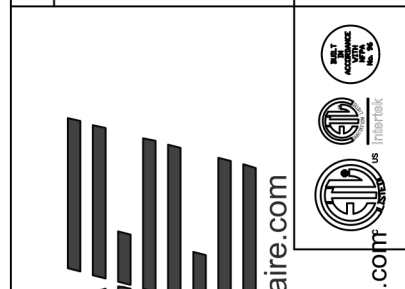



www.captiveus.com
Utah Office
2686 S. Redwood Rd., Suite S, West Valley, UT 84119
PHONE: (801) 878-3677 FAX: 9192279563 EMAIL: reg@captivewest.com

CAPTIVE

Steamboat Springs Restaurant TI
Steamboat Springs, CO, 80477

DATE: 6/12/2024
DWG.#: 6744566
DRAWN BY: EH
SCALE: 3/4" = 1'-0"
MASTER DRAWING

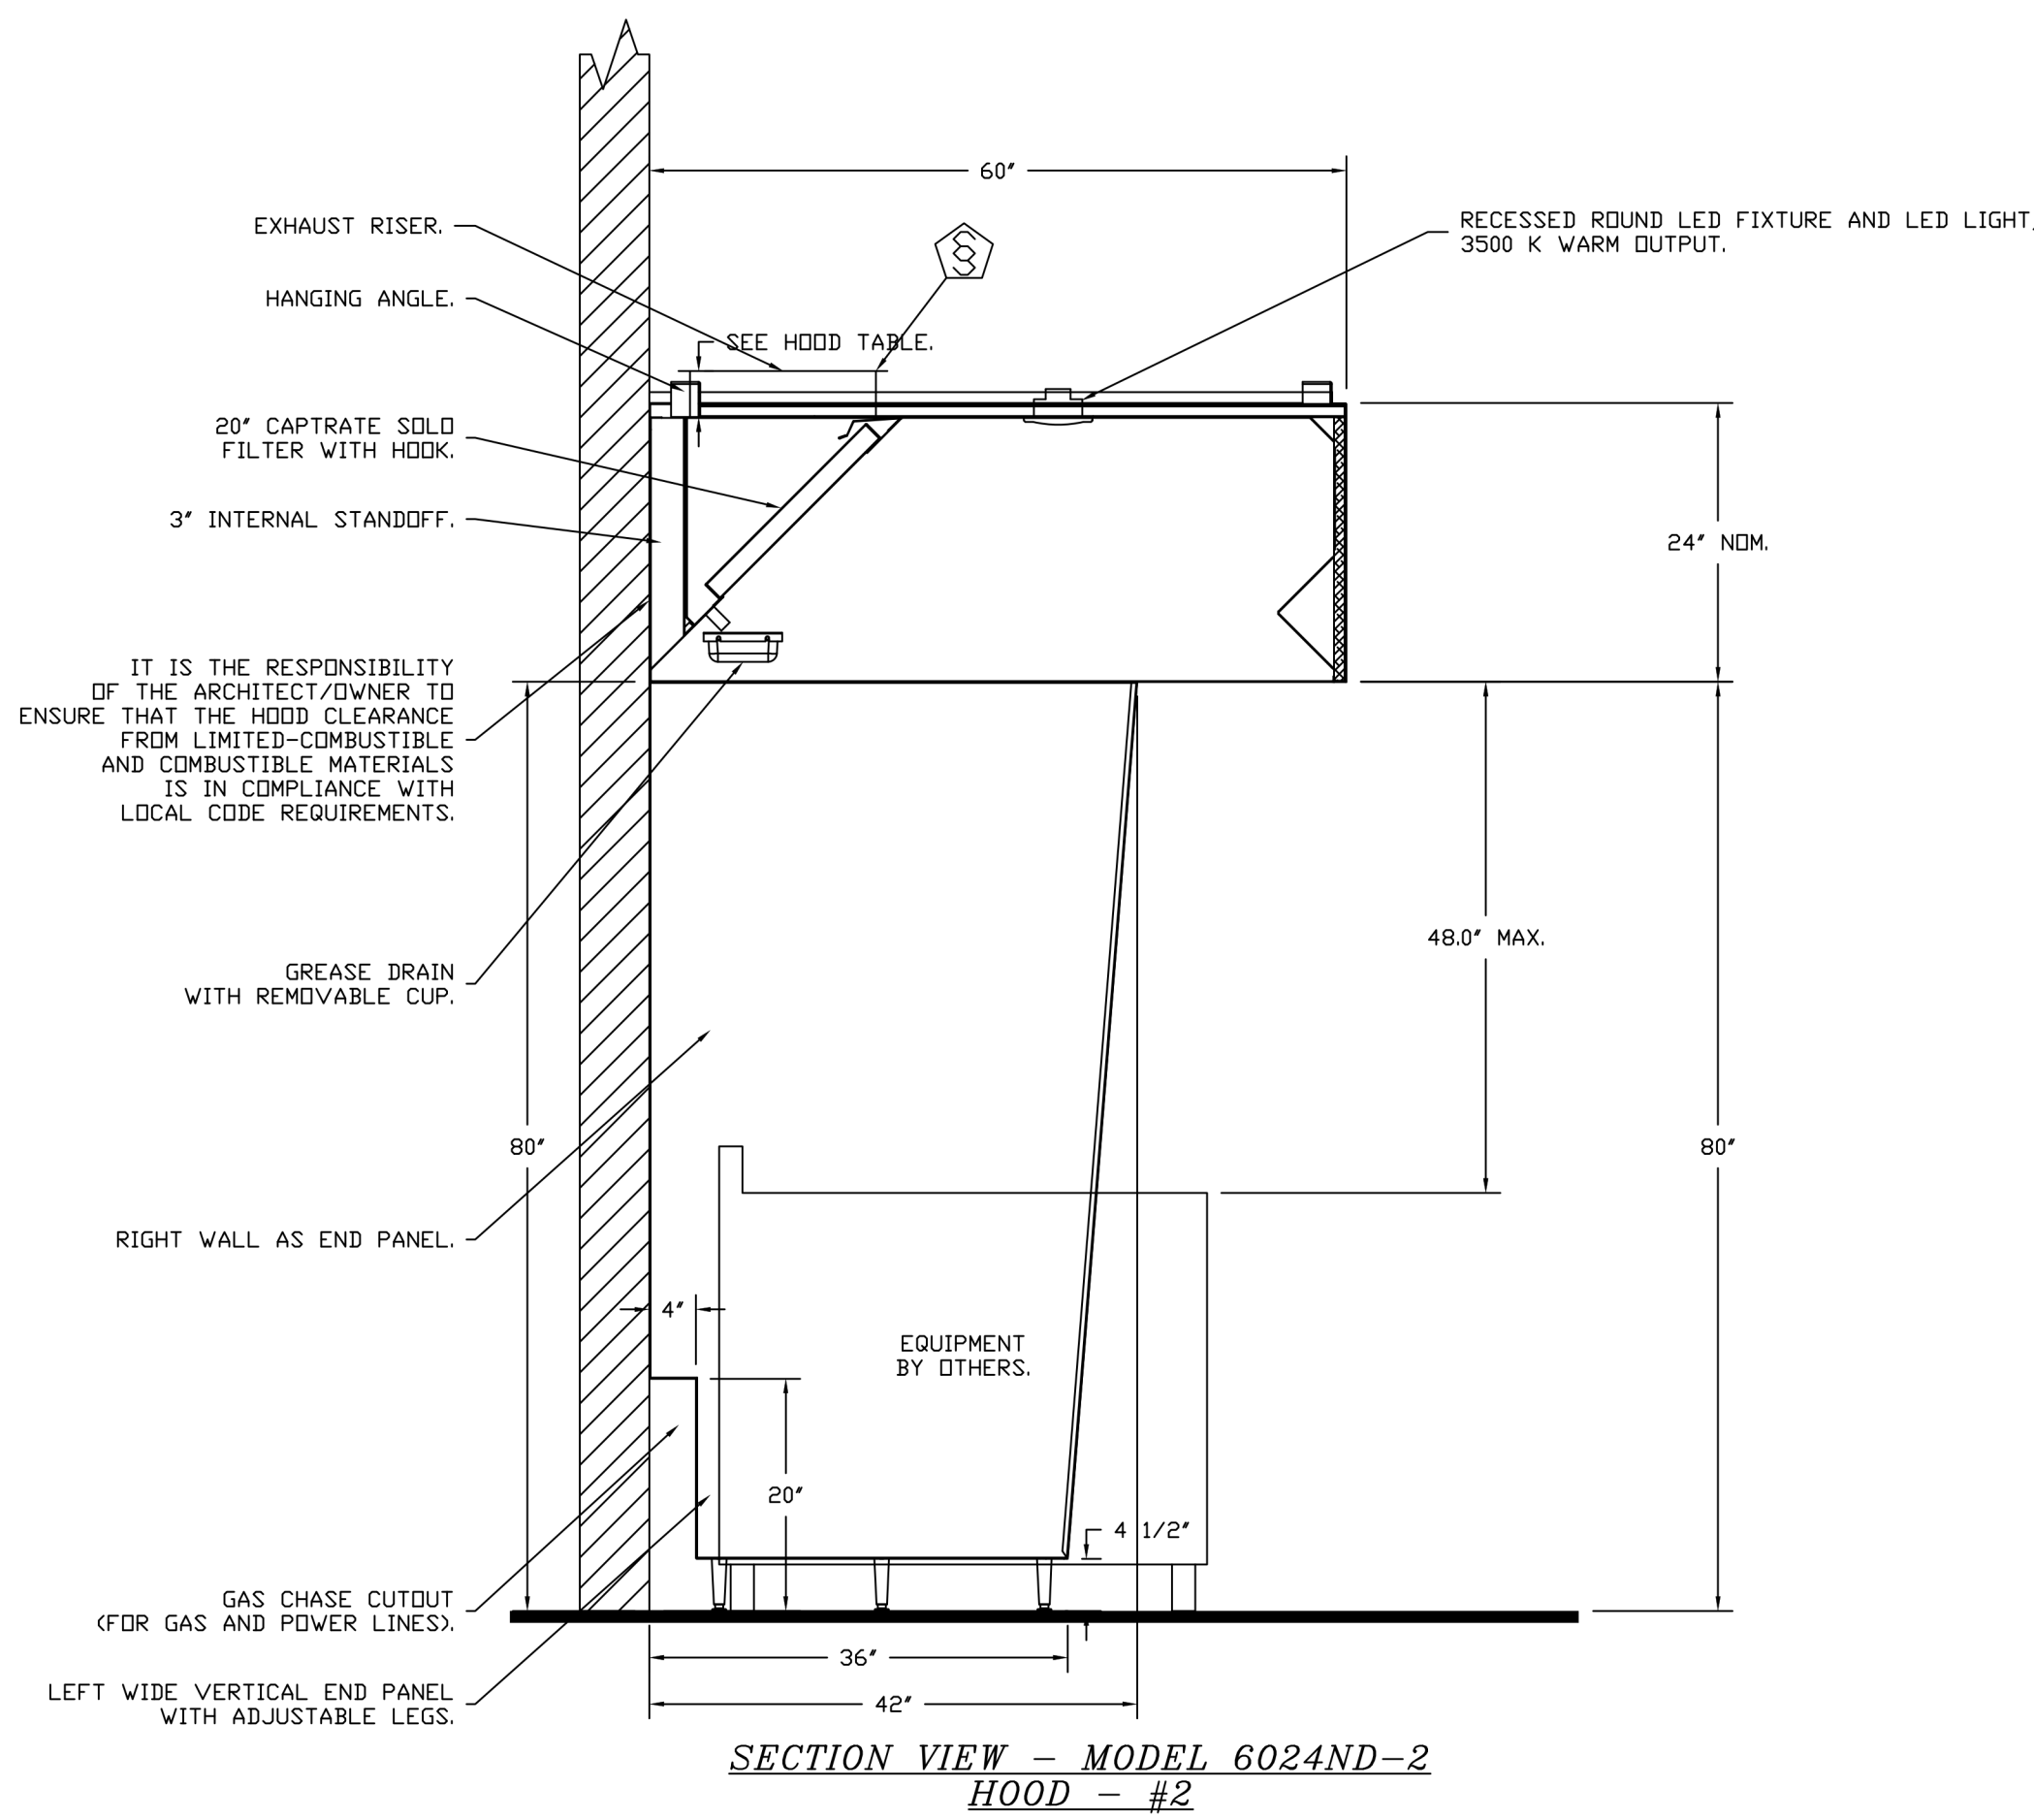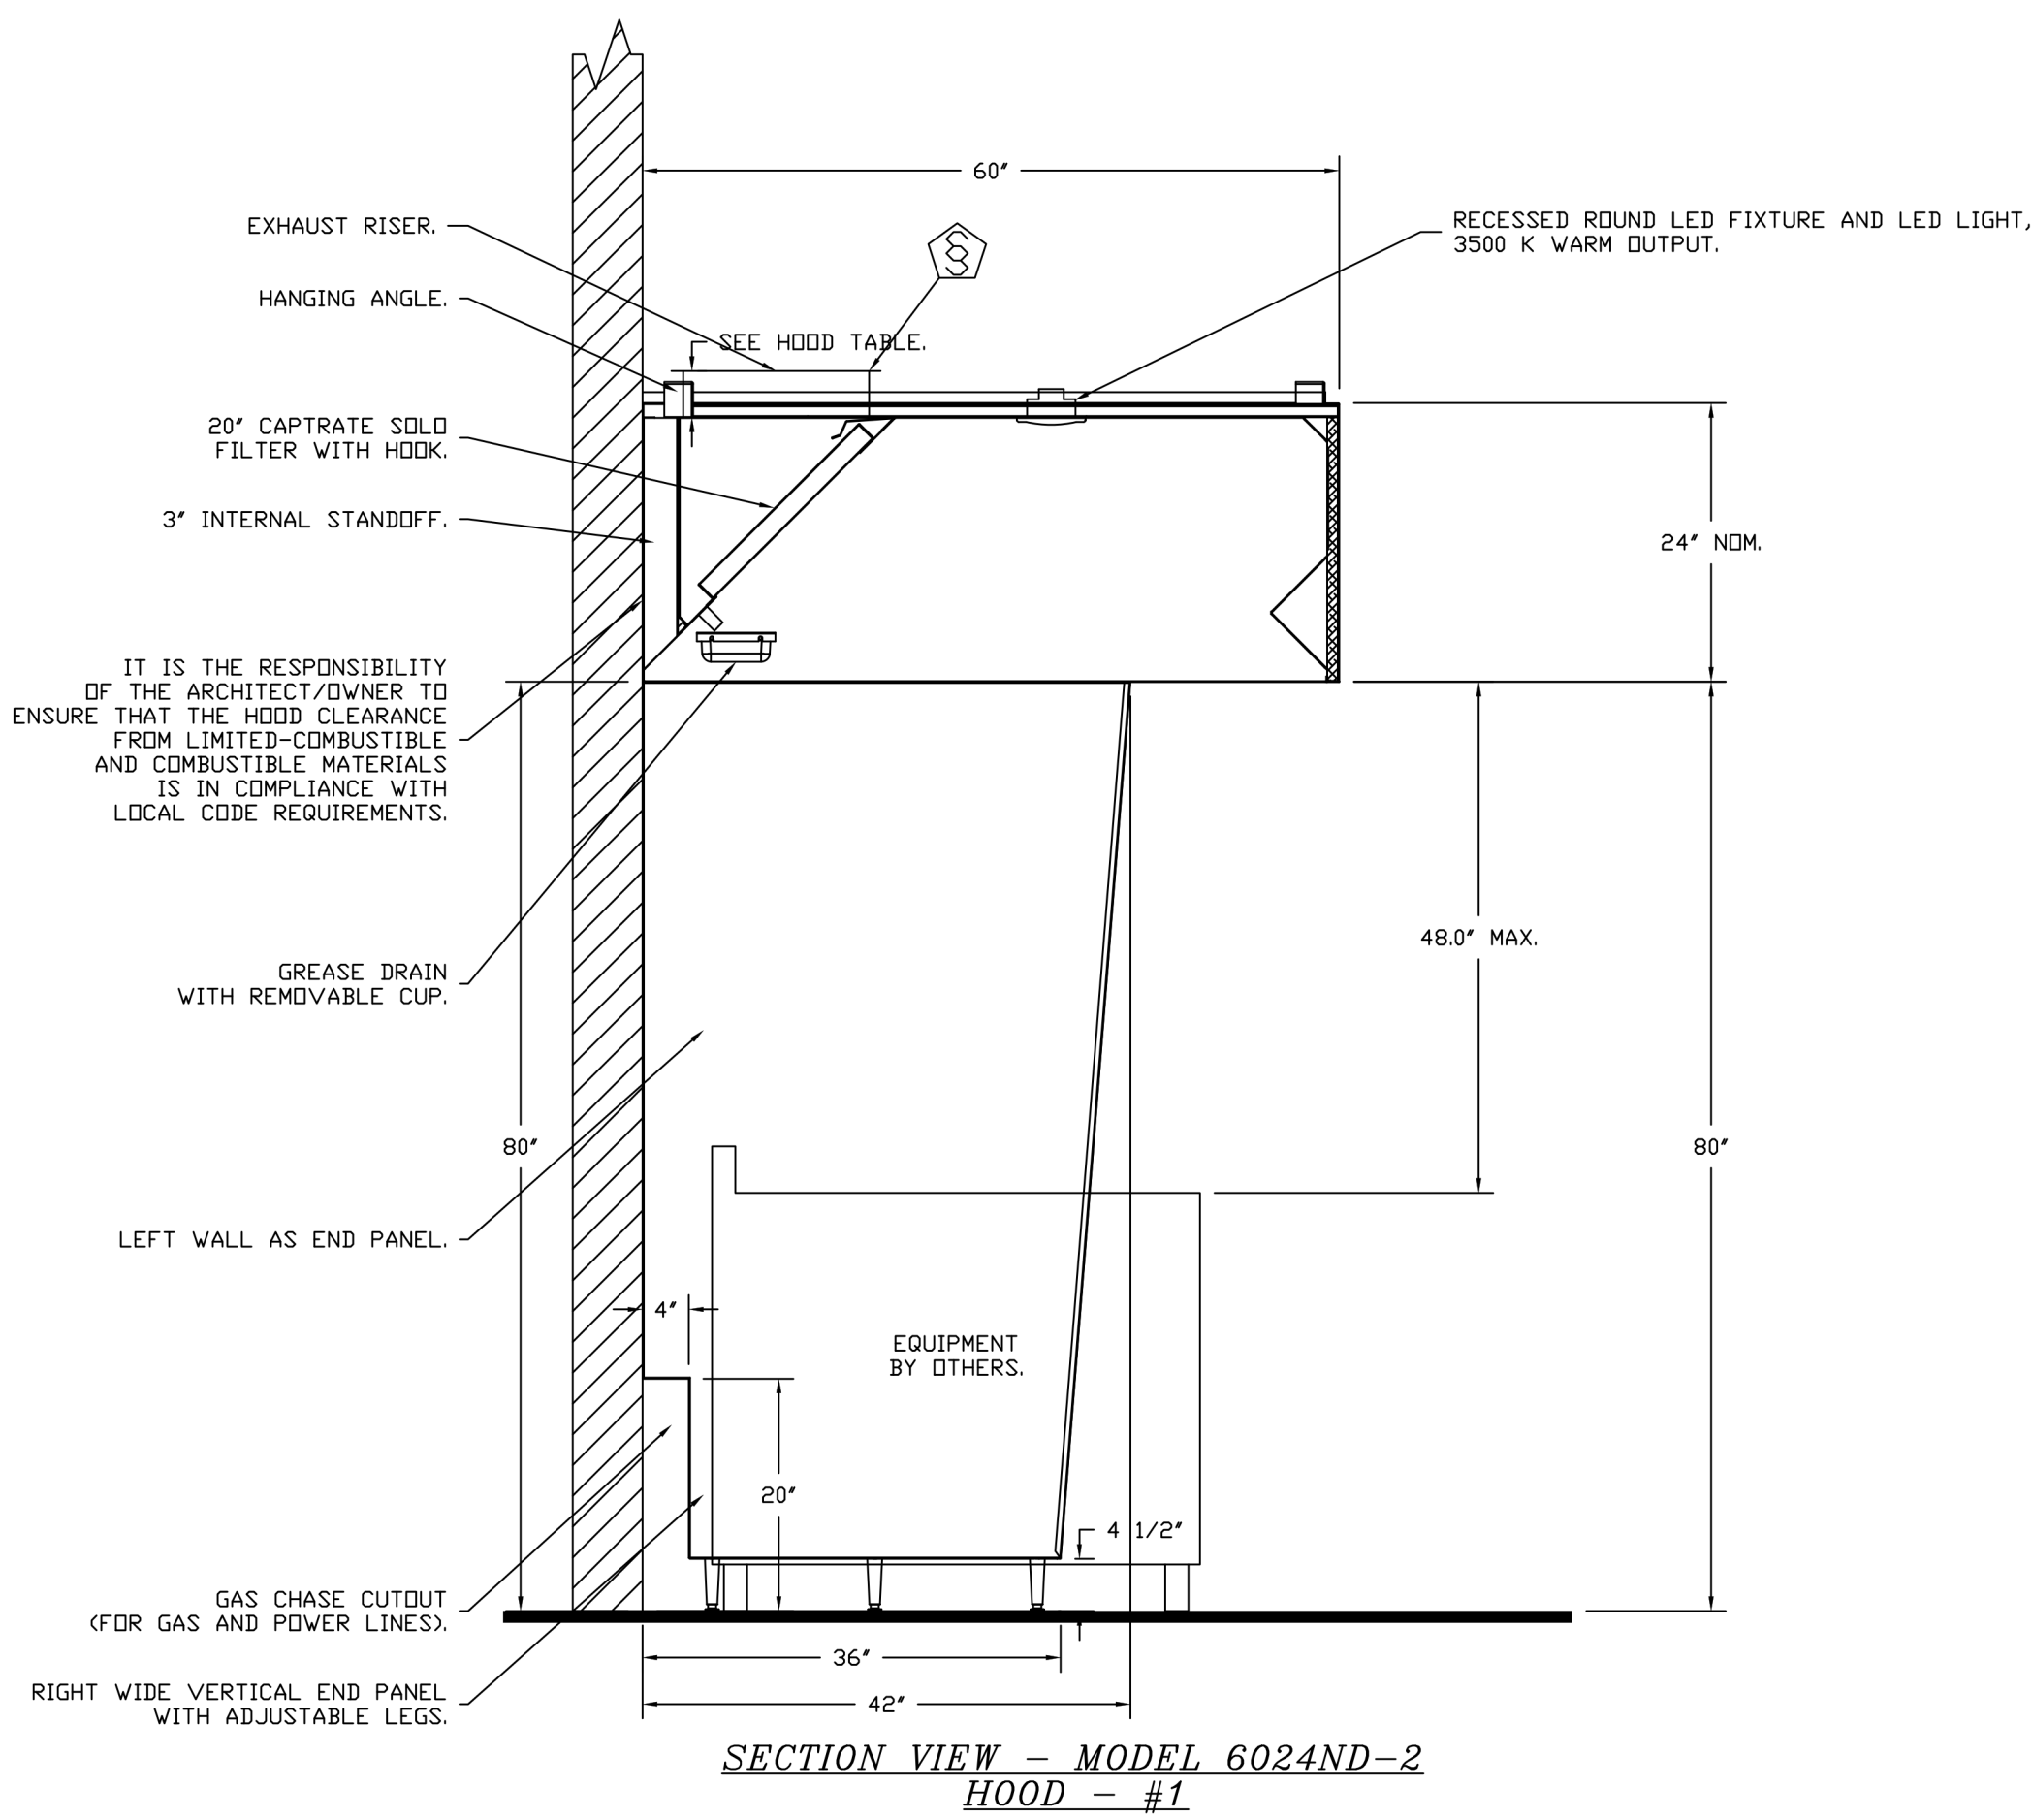

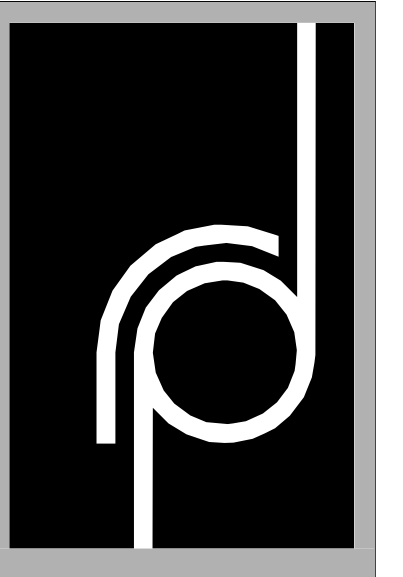

THE RICHARDSON DESIGN PARTNERSHIP, L.L.C.
 510 South 600 East
 Salt Lake City, Utah 84102
 P: 801.355.6886
 F: 801.355.6880



SPECTRUM ENGINEERS
 324 S. State St., Suite 400
 Salt Lake City, UT 84111
 800-678-7077
 801-328-5151
 fax: 801-328-5155
 www.spectrum-engineers.com

Reviewed for Code Compliance
 10/07/2024
 CONSULTANT

SERAC CAPITAL PARTNERS, LLC
 5051 WESTHEIMER RD. SUITE 1750
 HOUSTON, TX 77056
 OWNER:

CENTRAL PARK RESTAURANT T.I.
 1760 Central Park Dr.
 Steamboat Springs, CO
 PROJECT:

ISSUE DATE	DESCRIPTION
06/17/2024	
09/10/24	Owner Revisions





PERMIT SET
 MECHANICAL KITCHEN EQUIPMENT
 PROJECT #: 2023
 DRAWN BY: EHT
 CHECKED BY: SSJ
 RME506

REVISIONS	DESCRIPTION	DATE

CAPTIVE
 www.captivefire.com
 Utah Office
 2686 S. Redwood Rd., Suite S, West Valley, UT 84119 PHONE: (801) 878-3677 FAX: 9192279963 EMAIL: reg@captiveware.com

Steamboat Springs Restaurant TI
 Steamboat Springs, CO, 80477

DATE: 6/12/2024
 DWG.#: 6744566
 DRAWN BY: EH
 SCALE: 1/2" = 1'-0"
 MASTER DRAWING

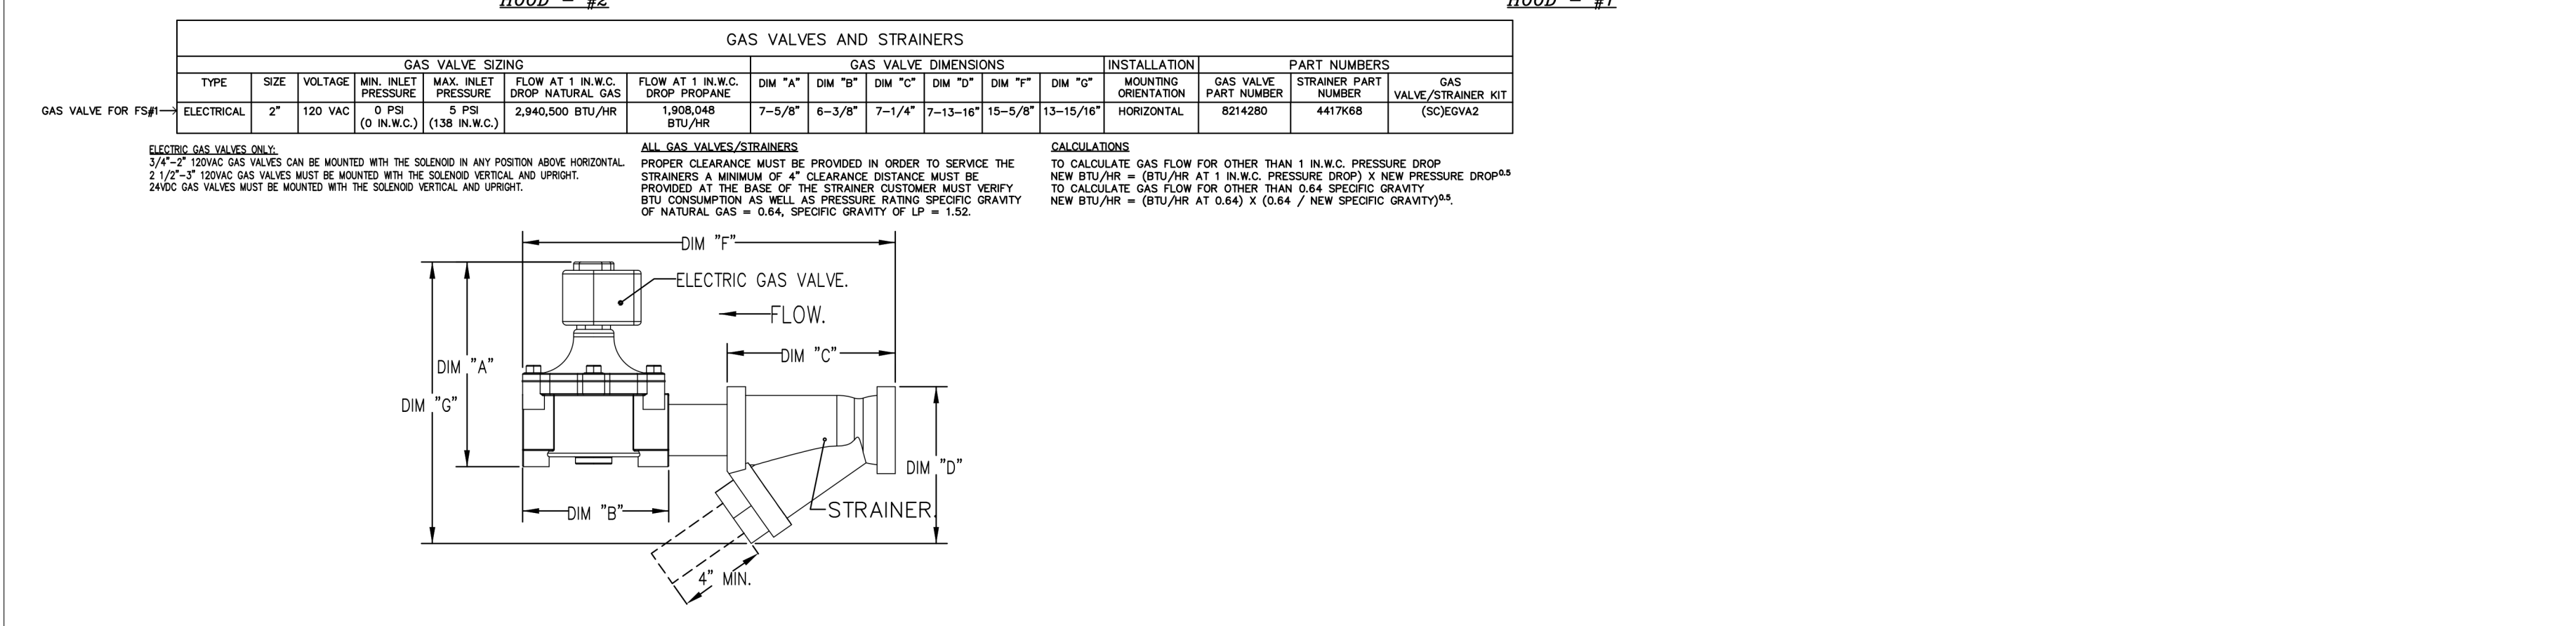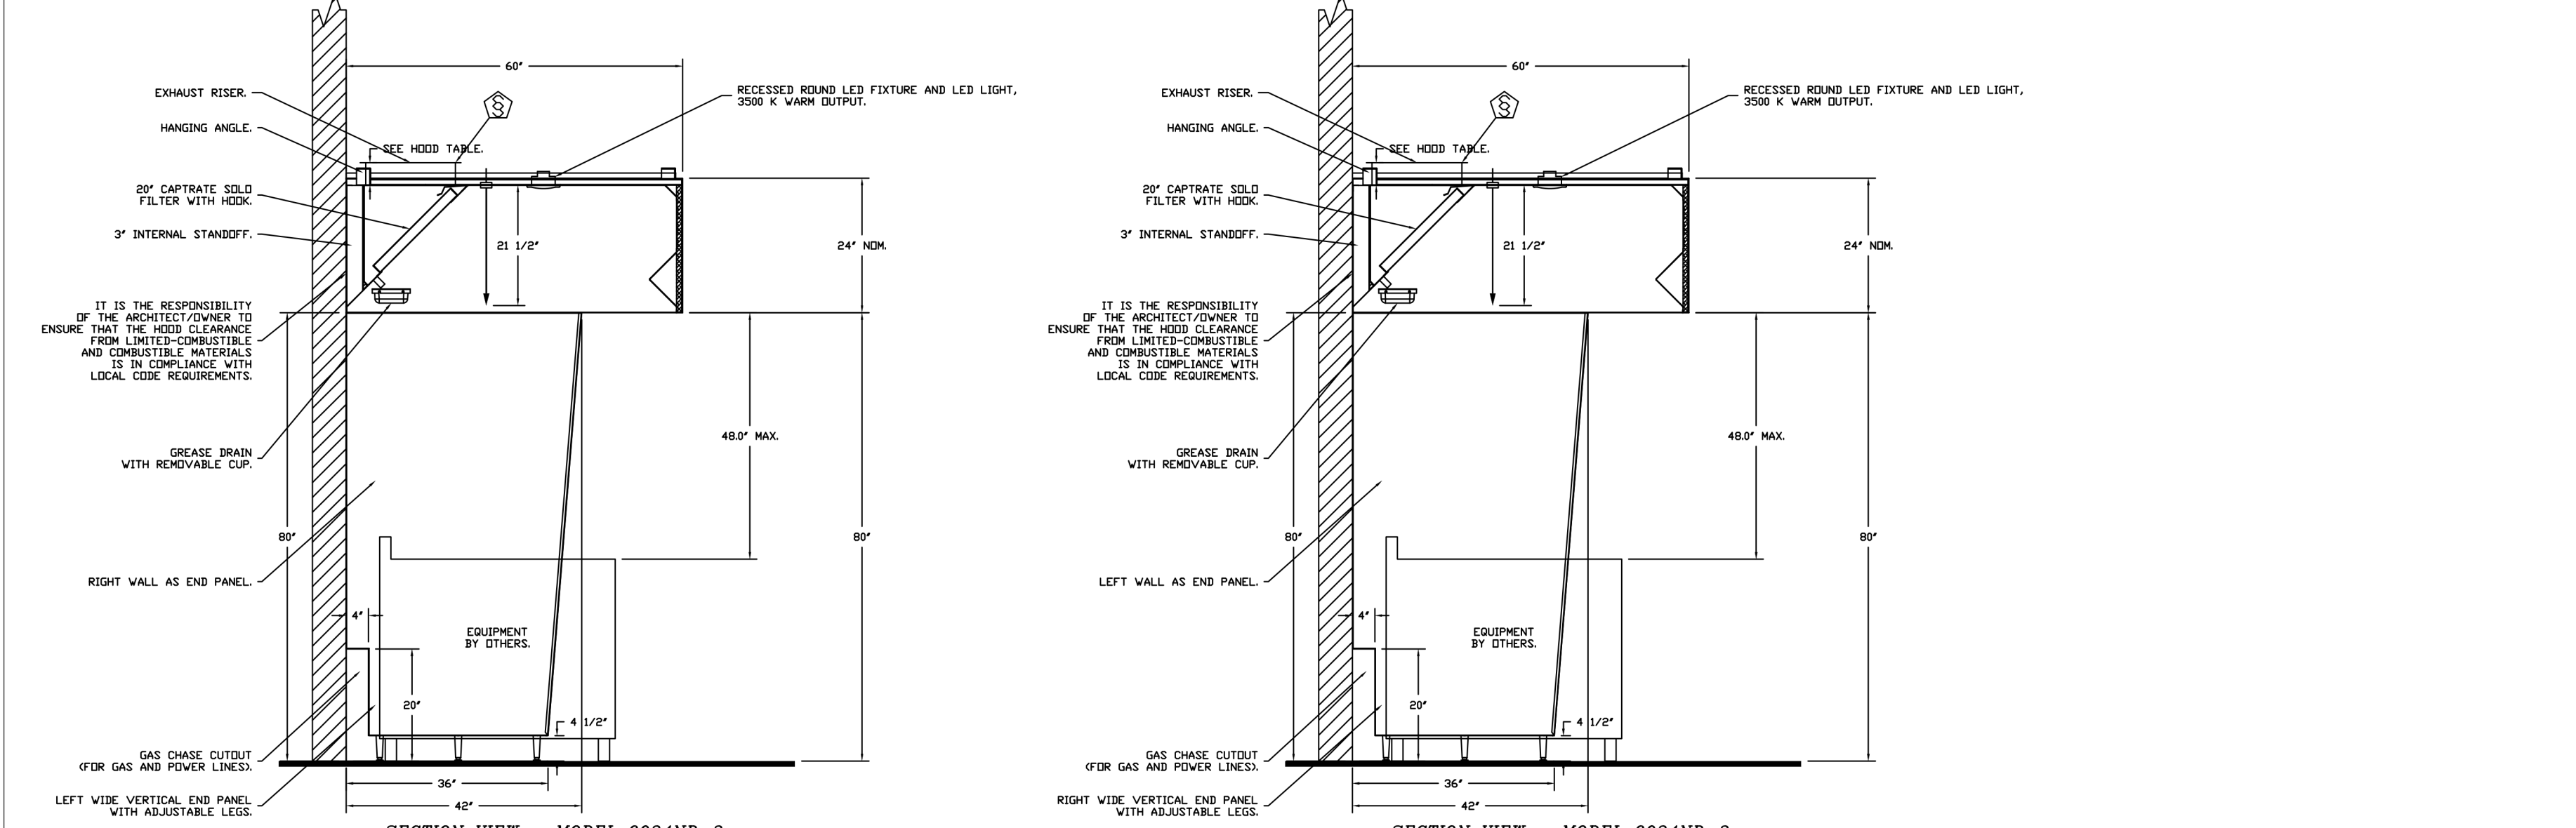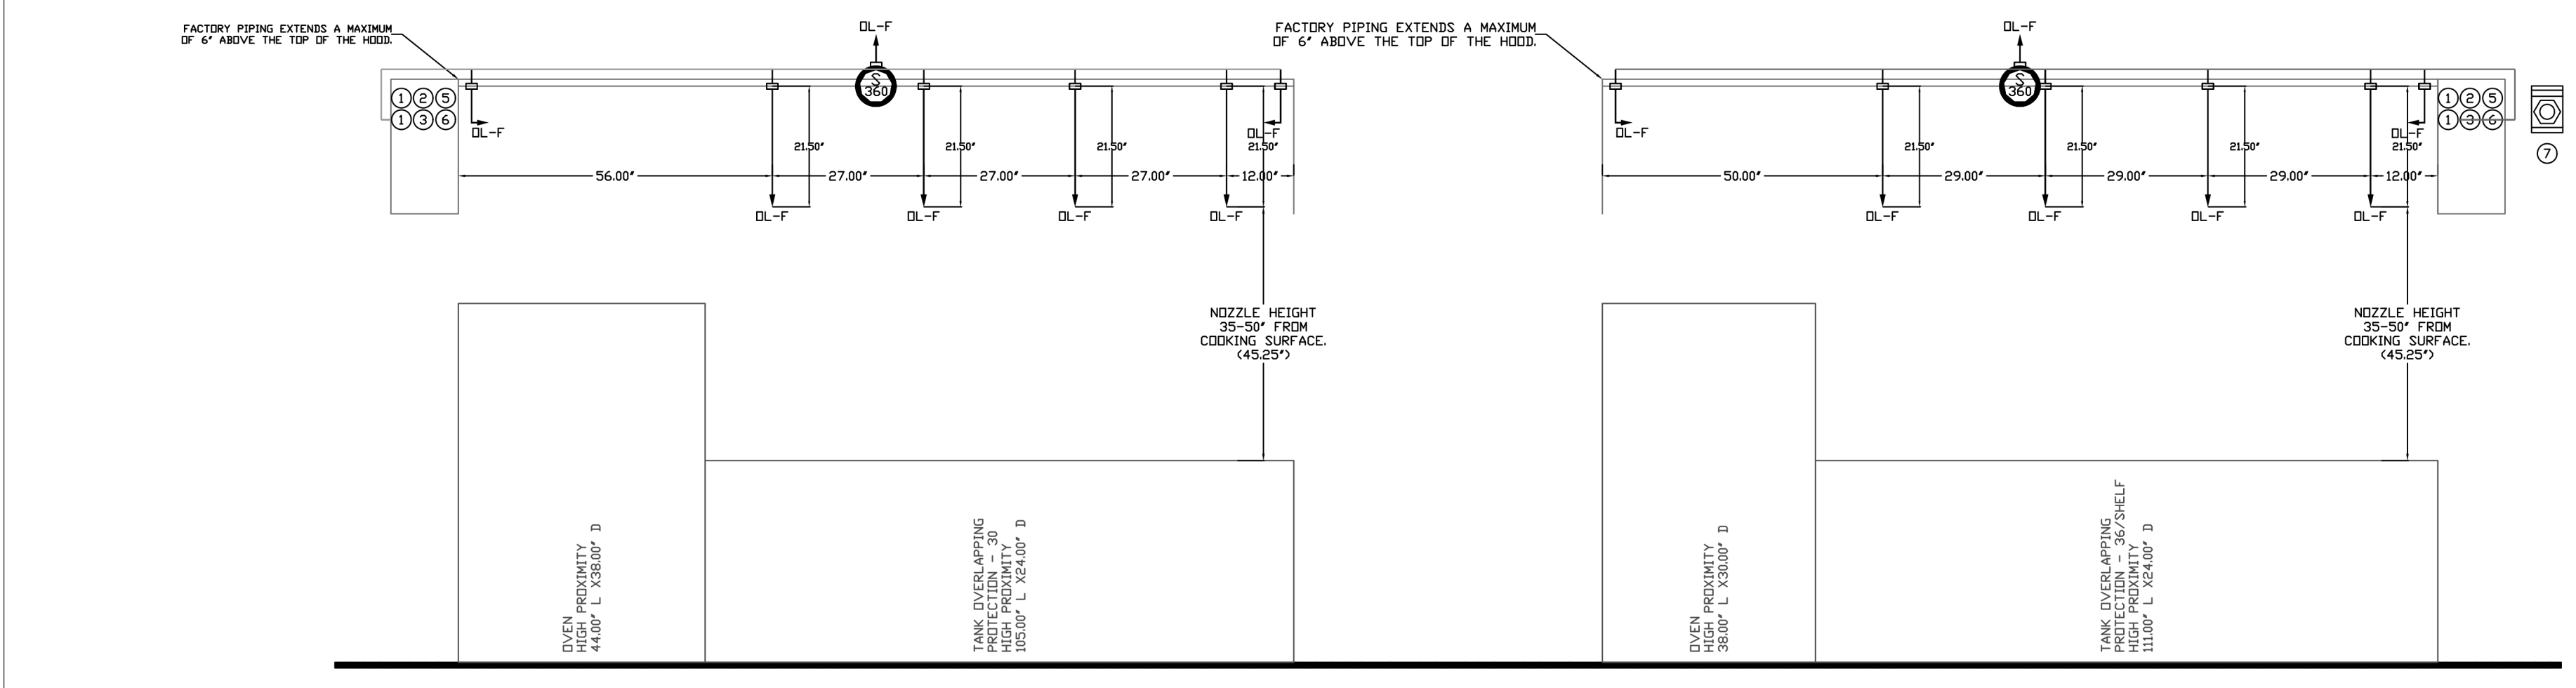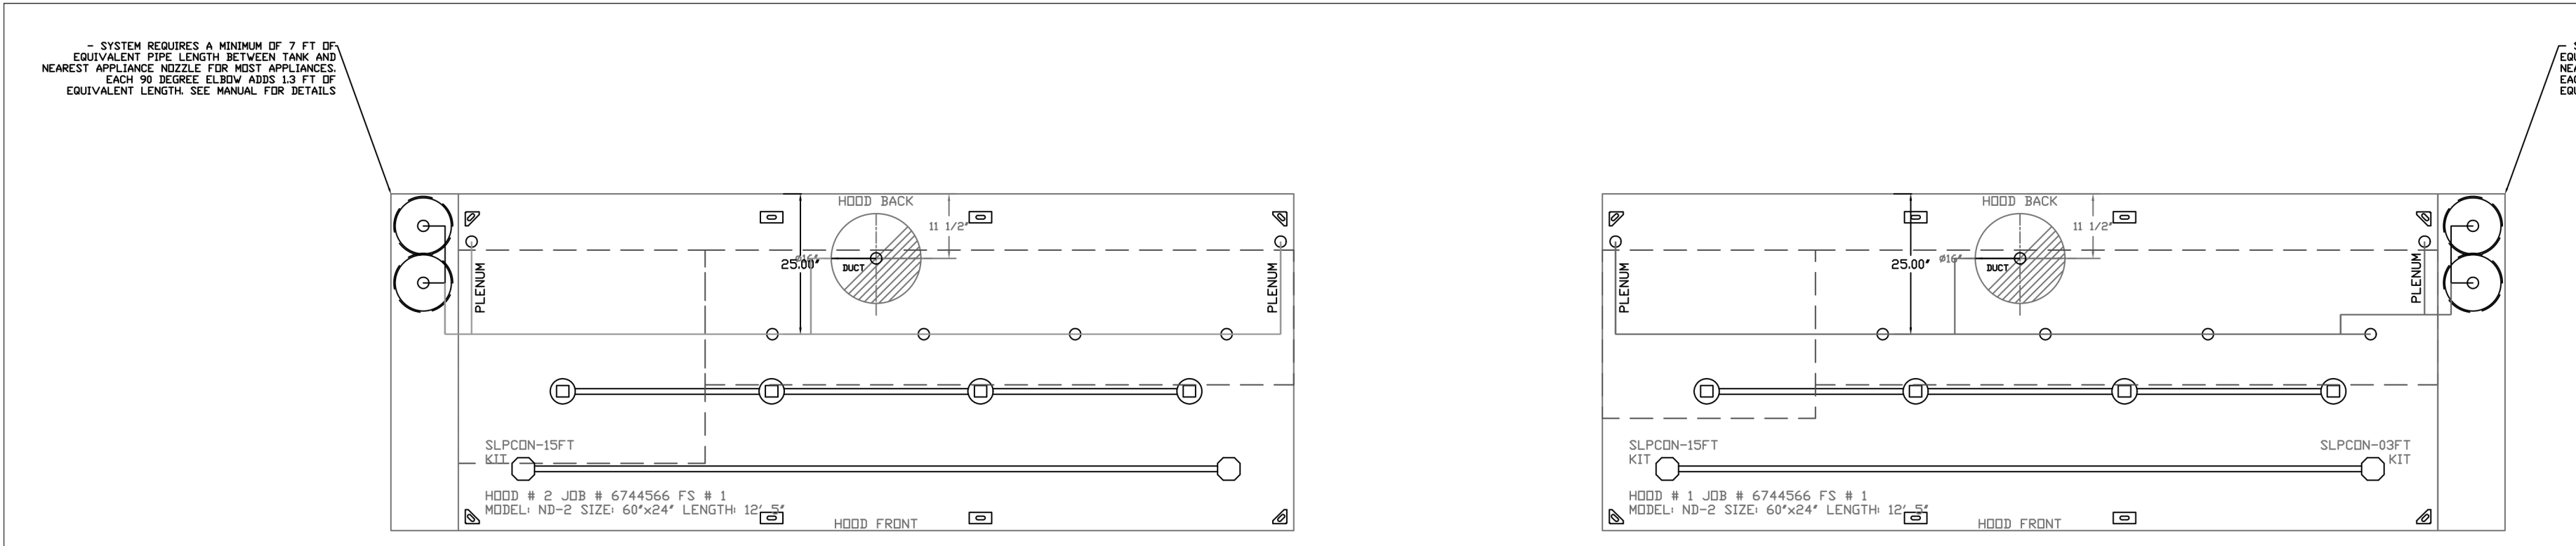

FIRE SYSTEM INFORMATION - JOB#6744566

FIRE SYSTEM TAG	TYPE	SIZE	MAX FP	DESIGN FP	INSTALLATION
1	TANK FS	4 1/2" DIA	40	64	FIRE CABINET RIGHT, RIGHT, HOOD 1
1	TANK FS	4 1/2" DIA	40	64	FIRE CABINET LEFT, LEFT, HOOD 2


GAS VALVES

FIRE SYSTEM TAG	TYPE	SIZE	SUPPLIED BY
1	SC ELECTRICAL	2.000	CAPTIVWARE SYSTEMS

FIRE SYSTEM PARTS LIST KEY


FIRE SYSTEM TAG	KEY NUMBER - PART DESCRIPTION	QTY BY FACTORY	QTY BY BIST
0 - 0	TANK FIRE SUPPRESSION MAINTENANCE GUIDE UTILITY CABINET LABEL SHEET.	1	0
0 - 0	TANK FIRE SUPPRESSION POST-DISCHARGE PROCEDURE UTILITY CABINET LABEL SHEET.	1	0
0 - 0	12-FEET-304-1/4-1/2-300 DUCT FIRE THERMOSTAT WITH 12 FOOT WIRE LEADS, NO. (CLOSD ON TEMP RISE AT 360°F. (400/3430).	2	0
0 - 0	38-00008 OIL SEAL - 1/2" O.D.S.	2	0
0 - 0	4489453 1/2" MALE NPT TO 1/2" FEMALE NPT ELBOW, BRASS.	4	0
0 - 0	4489482 1/2" X 1/4" BRASS REDUCING BUSHING.	2	0
0 - 0	79583 1/2" 90 DEG. PRE-PRESS. ELBOW WITH 1/2" NPT FEMALE CONNECTION, VIEGA.	2	0
0 - 0	79580 1/2" X 1/2" PRE-PRESS. TEE X 1/2" NPT FEMALE CONNECTION, VIEGA.	4	0
0 - 0	87-10042-001 SECONDARY ACTUATOR VALVE (CSVA) - SINGLE ACTUATOR, REQUIRES PRIMARY RELEASE, ACTUATOR, TANK FIRE SUPPRESSION.	2	0
0 - 0	87-10045-001 HOSE, SECONDARY ACTUATOR HOSE, 7.5' BRAIDED STAINLESS STEEL, TANK FIRE SUPPRESSION.	2	0
0 - 0	87-30001-001 TANK - PRESSURIZED TANK USED FOR TANK FIRE SUPPRESSION.	4	0
0 - 0	87-30003-001 PRIMARY ACTUATOR KIT (PAC) - ACTUATOR AND RELEASE SOLENOID ASSEMBLY, ONE NEEDED PER FIRE SYSTEM, SUPERVISED, TANK FIRE SUPPRESSION.	2	0
0 - 0	87-30052-001 HARDWARE, SVA BOLTS, TANK FIRE SUPPRESSION.	16	0
0 - 0	90524500C PRO PRESS 1/2" PRESS X PRESS 90 ELBOW L.B.	12	0
0 - 0	9097200PC PRO PRESS PG611 1/2" PRESS TEE L.B.	12	0
0 - 0	98694112 HARDWARE, DATANLOCK LOCKING BRACKET SQUARE NUTS 5/16" ZINC, TANK FIRE SUPPRESSION.	8	0
0 - 0	8034330 JUNCTION BOX FOR MANUAL PULL STATION, 1.5" DEEP BACK BOX, RED COLOR.	2	0
0 - 0	401464 1/4" NPT SOLENOID VALVE AND CAP, JB INDUSTRIES, 1/4" FLARE X 1/4" NPT HALF UNION, USED IN TANK SERVICE PORT.	2	0
0 - 0	80145 3/8" BLACK IRON 90 ELL.	6	0
0 - 0	07A00000X DISCHARGE ADAPTER TANK LOCKING PLATE FOR FIRE SYSTEM TANK INSTALLATION IN UTILITY CABINETS, TANK FIRE SUPPRESSION.	4	0
0 - 0	SLIPON-OFF SUPERVISED LOOP CONNECTION KIT, CONTAINS THE PARTS NEEDED TO CONNECT THE SUPERVISED LOOP BETWEEN END TO END HOODS WITH LESS THAN A 14" GAP OR BACK TO BACK HOODS WITH LESS THAN 18" GAP, 17 FEET OF TANK HO WIRE, 15 FEET OF FLEXIBLE CONDUIT, AND TWO 7/8" CONNECTORS.	1	0
0 - 0	SLIPON-OFF SUPERVISED LOOP CONNECTION KIT, CONTAINS THE PARTS NEEDED TO CONNECT THE SUPERVISED LOOP BETWEEN END TO END HOODS WITH LESS THAN A 14" GAP OR BACK TO BACK HOODS WITH LESS THAN 18" GAP, 17 FEET OF TANK HO WIRE, 15 FEET OF FLEXIBLE CONDUIT, AND TWO 7/8" CONNECTORS.	2	0
0 - 0	TANK STRAP TANK STRAP - USED FOR TANK FIRE SUPPRESSION.	12	0
0 - 0	87-30003-001 PRIMARY ACTUATOR KIT (PAC) - ACTUATOR AND RELEASE SOLENOID ASSEMBLY, ONE NEEDED PER FIRE SYSTEM, SUPERVISED, TANK FIRE SUPPRESSION.	4	0
0 - 0	87-30052-001 HARDWARE, SVA BOLTS, TANK FIRE SUPPRESSION.	14	0
0 - 0	16 - 16 - DL-F NOZZLE - TANK PROTECTION APPLIANCE COVERAGE NOZZLE (INCLUDES METAL BLOW OFF CAP, LANYARD, USED WITH CHROME-PLATED PIPING).	14	0
0 - 0	16 - 16 - DL-F NOZZLE - TANK PROTECTION APPLIANCE COVERAGE NOZZLE (INCLUDES METAL BLOW OFF CAP, LANYARD, USED WITH CHROME-PLATED PIPING).	14	0
0 - 0	24 - 24 - A0034301 3/4" DRIVE SINGLE ACTION MANUAL ACTUATION DEVICE (PUSH/PULL STATION) WITH PROTECTIVE COVER, ONE (1) NORMALLY OPEN CONTACT, RED COLOR.	2	0

06/20/24 10:16:45 AM
 Autodesk Docs (22) 701 9415 - Steamboat Springs CO2023057 - Steamboat Springs Restaurant.ti

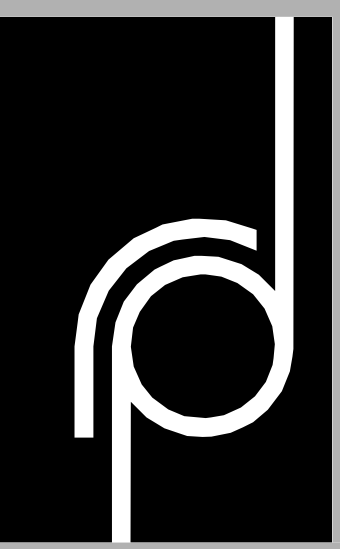

THE
RICHARDSON
DESIGN
PARTNERSHIP,
L.L.C.

510 South 600 East
Salt Lake City, Utah 84102
P: 801.355.6886
F: 801.355.6880

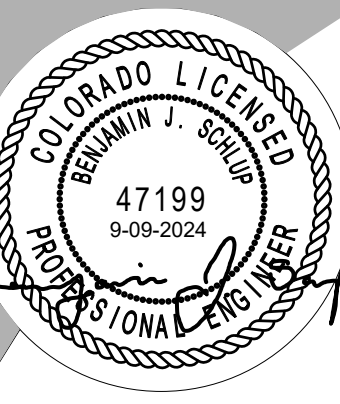

THE ABOVE DESIGN, SPECIFICATION OR OTHER DOCUMENT IS THE PROPERTY OF SPECTRUM ENGINEERS, L.L.C. AND IS TO BE USED ONLY FOR THE PROJECT AND LOCATION SPECIFICALLY IDENTIFIED HEREIN. ANY REUSE OR MODIFICATION OF THIS DOCUMENT WITHOUT THE WRITTEN CONSENT OF SPECTRUM ENGINEERS, L.L.C. IS STRICTLY PROHIBITED.

**SPECTRUM
ENGINEERS**
324 S. State St., Suite 400
Salt Lake City, UT 84111
800-878-7077
801-328-5151
fax: 801-328-5155
www.spectrum-engineers.com

Reviewed for
Code
Compliance
10/07/2024
CONSULTANT

SERAC CAPITAL PARTNERS, LLC

5051 WESTHEIMER RD. SUITE 1750
HOUSTON, TX 77056

OWNER:

CENTRAL PARK
RESTAURANT T.I.

1760 Central Park Dr.
Steamboat Springs, CO

PROJECT:

ISSUE DATE DESCRIPTION
06/17/2024

REV. DATE DESCRIPTION
09/10/24 Owner Revisions

DRAWN BY: EH

SCALE:
1/2" = 1'-0"

MASTER DRAWING

PROJECT #: 2023
DRAWN BY: EBT
CHECKED BY: SSJ

PERMIT SET

MECHANICAL
KITCHEN EQUIPMENT

RME508



REVISIONS

NO.	DESCRIPTION	DATE

CAPTIVE
Utah Office
2686 S. Redwood Rd., Suite S, West Valley, UT 84119 PHONE: (801) 878-3677 FAX: 9192279563 EMAIL: reg@captivemechanical.com
www.captivemechanical.com






Steamboat Springs Restaurant TI
Steamboat Springs, CO, 80477

DATE: 6/12/2024
DWG.#: 6744566
DRAWN BY: EH
SCALE: 1/2" = 1'-0"
MASTER DRAWING

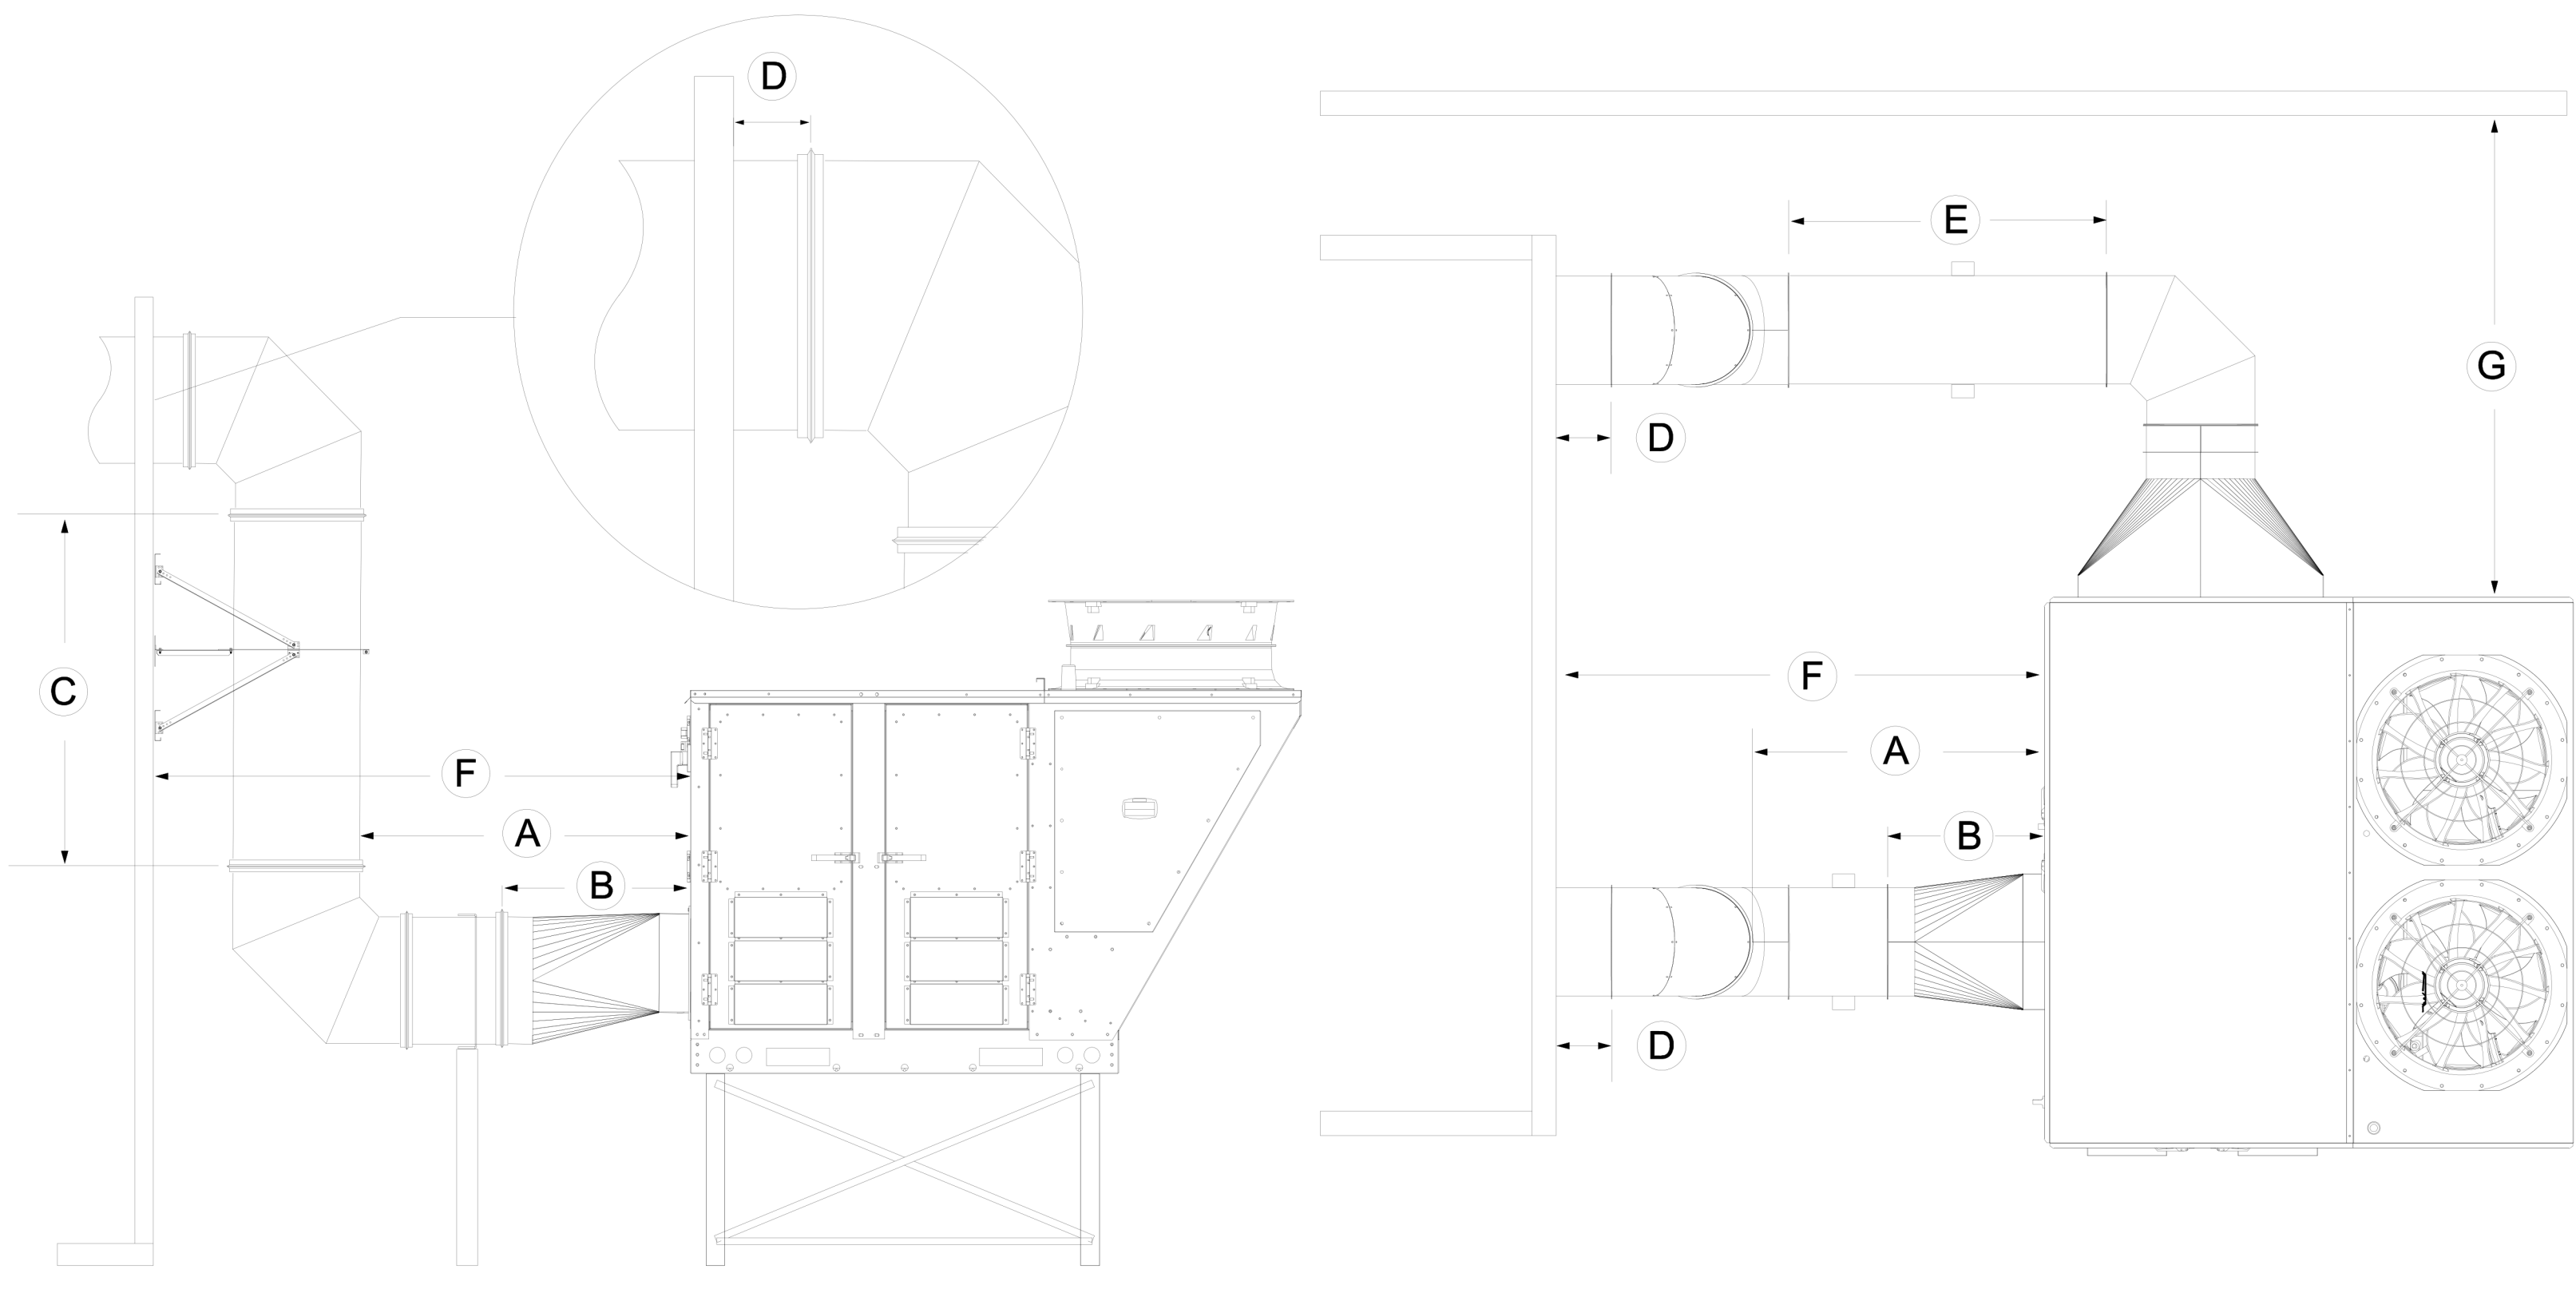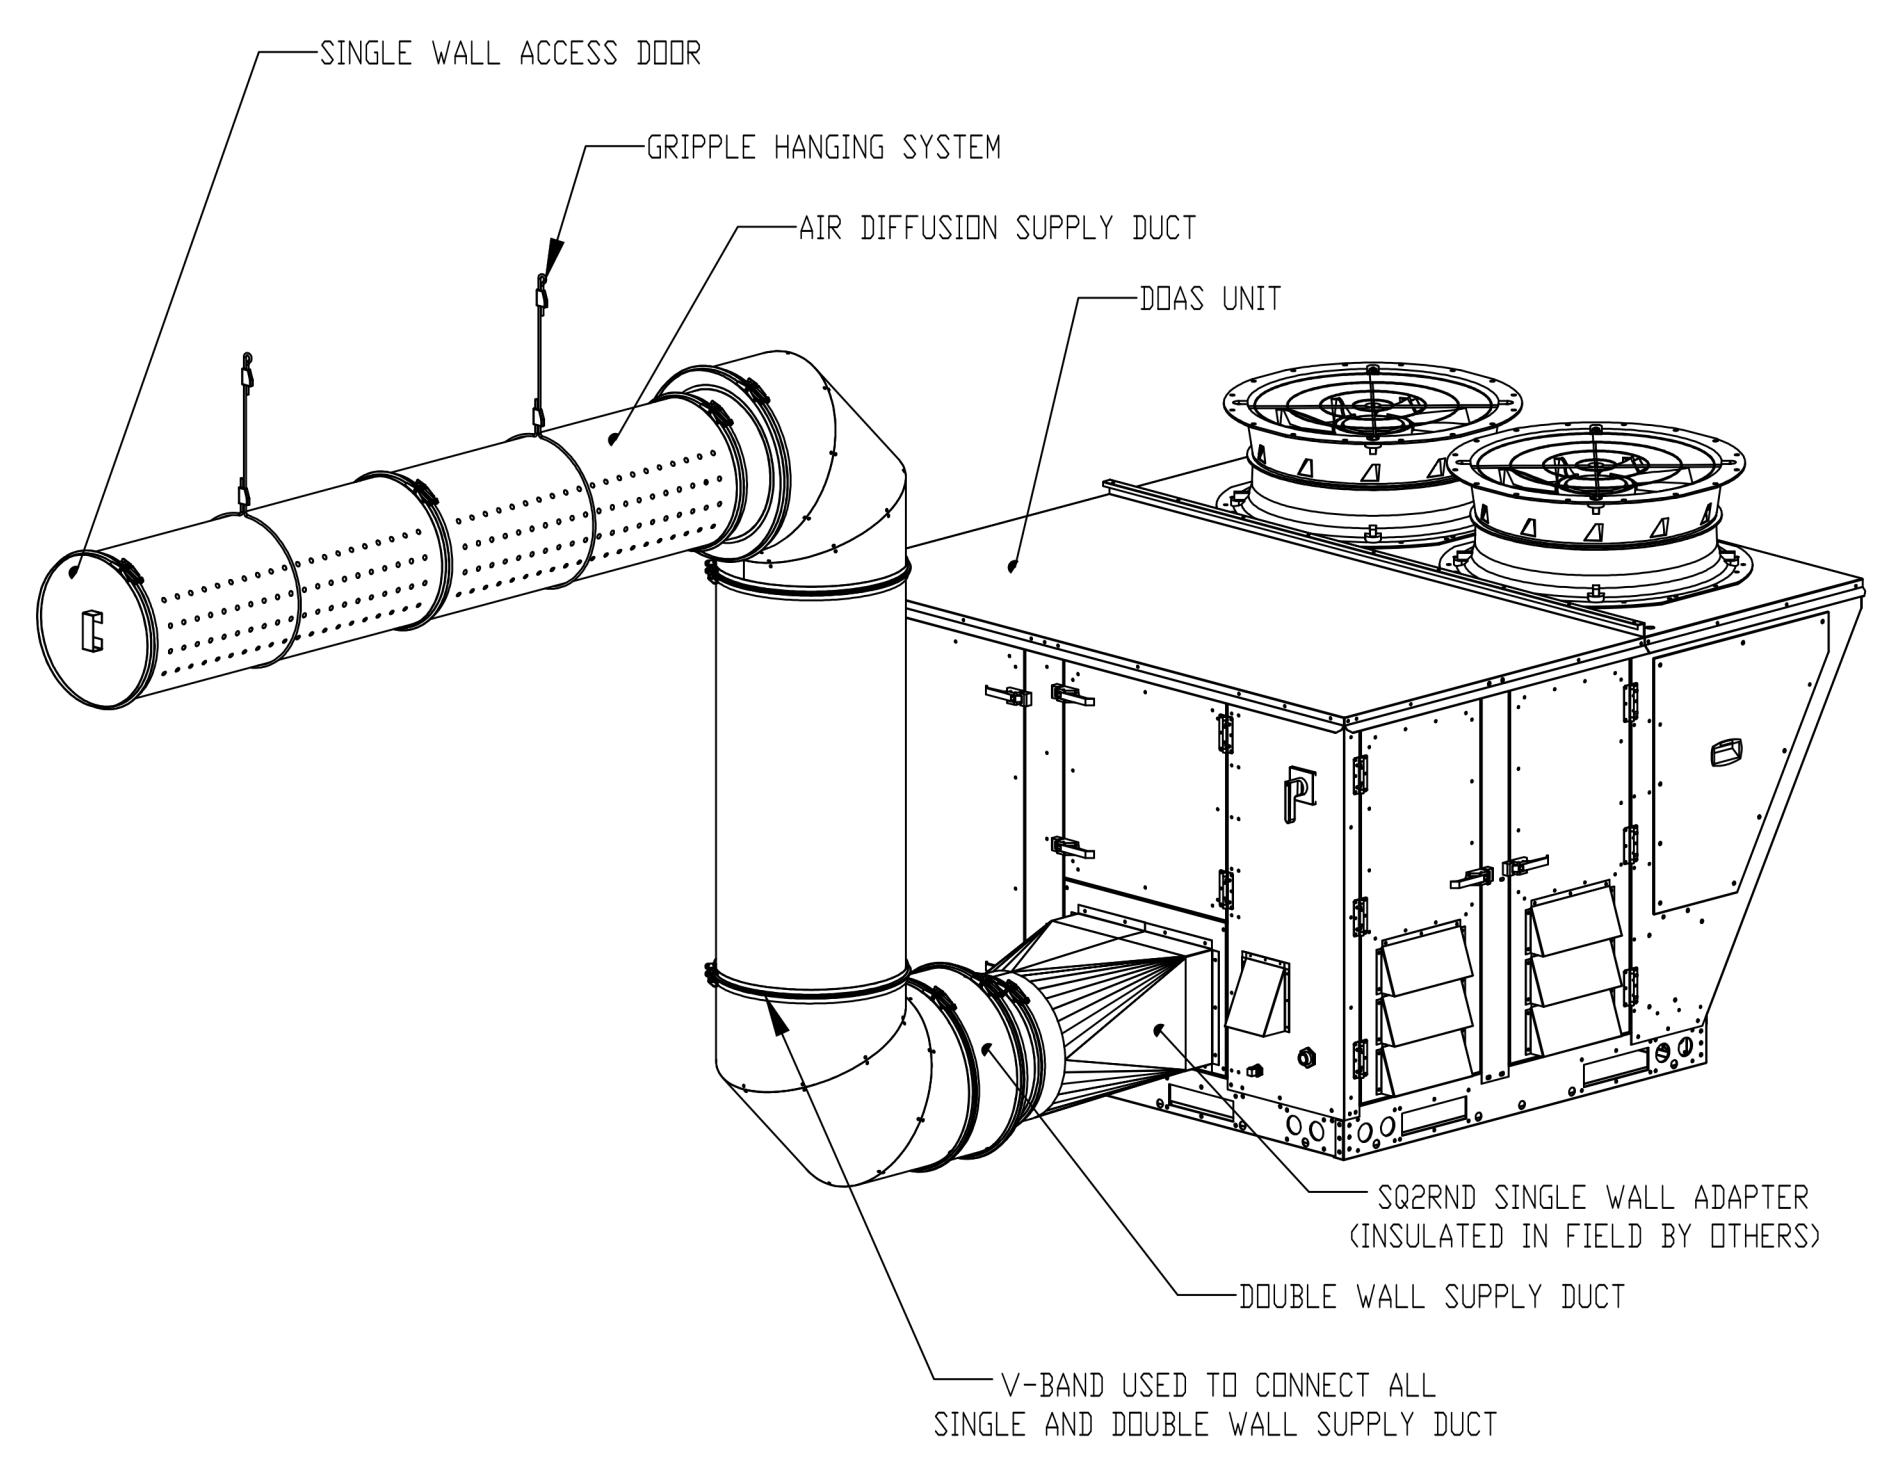

Side Discharge Requirements

Unit Size	Dim. A	Dim. B	Dim. C	Dim. D	Dim. E	Dim. F	Dim. G
Size 3	2'-1 1/2"	2'-0"	10'-0"	0'-4"	15' SW / 8' DW	5'-10"	5'-10"


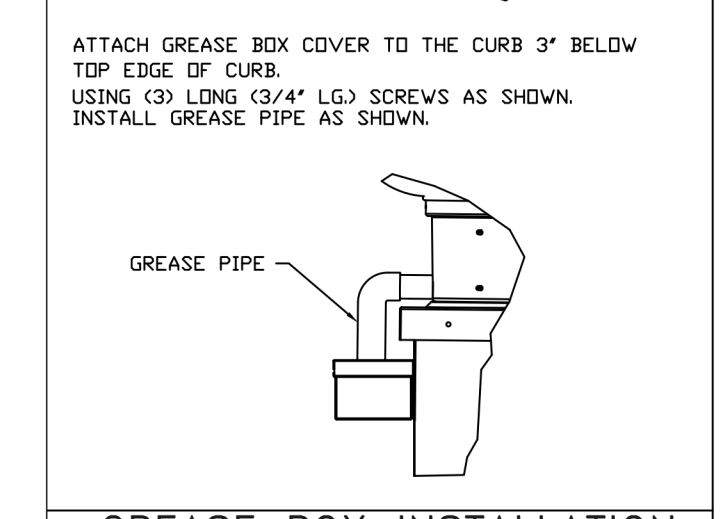
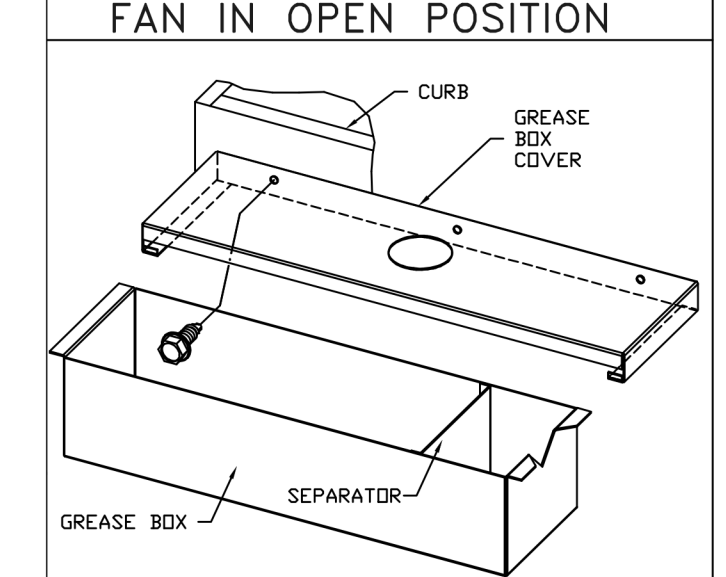
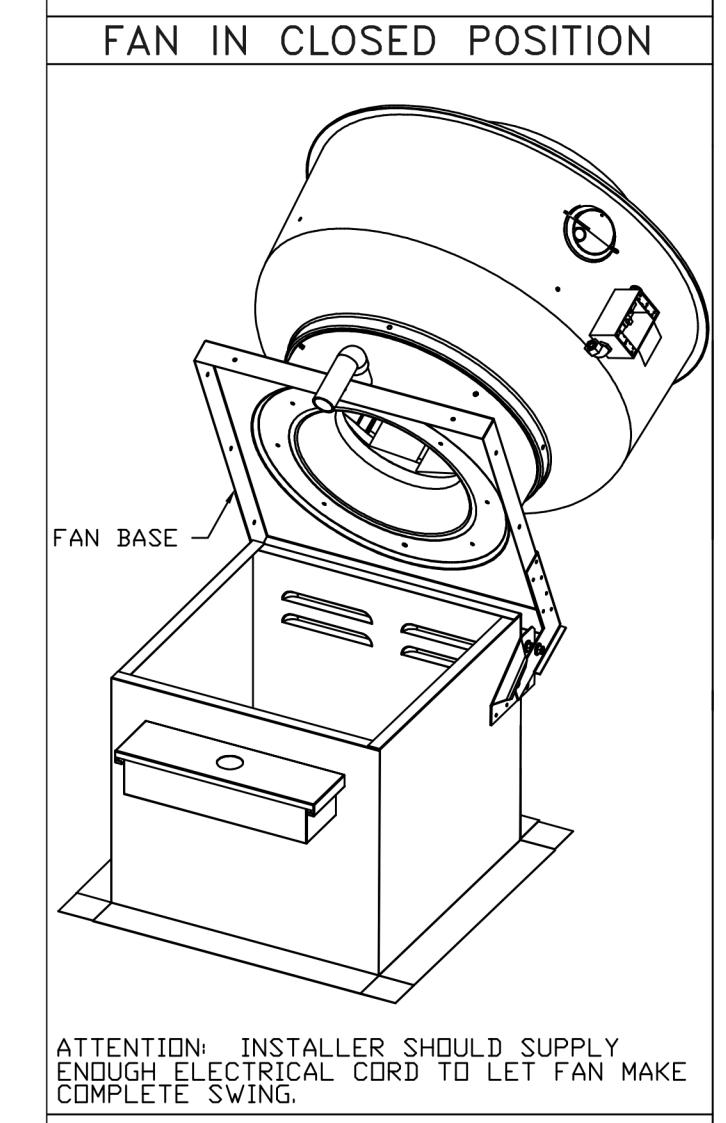
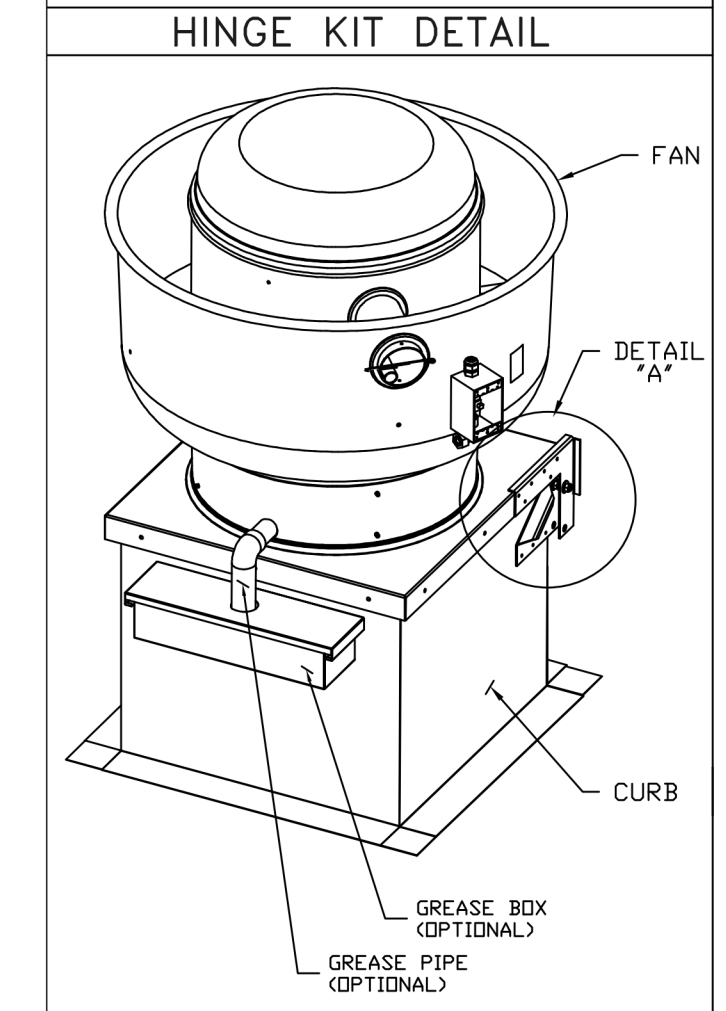
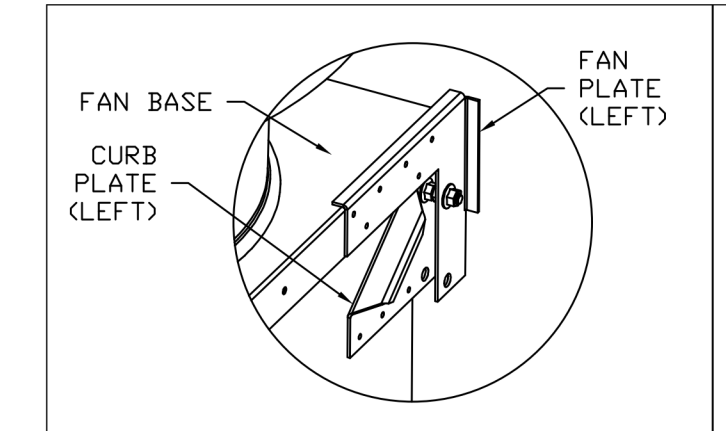


- ELECTRICAL PACKAGE NOTES**
- A PRE-WIRED ELECTRICAL CONTROL PACKAGE SHALL BE PROVIDED TO OPERATE THE HOOD LIGHTS AND FANS.
 - PACKAGE SHALL CONSIST OF SWITCH PANEL WITH LIGHT SWITCHES AND RED-LEADED FAN SWITCHES, STARTER/ OVERLOAD ASSEMBLY FOR EACH FAN/PROPPELLER, NUMBERED INPUT/OUTPUT TERMINAL STRIPS, AND A TERMINAL FOR DOUBLE-SIGNAL FIRE SYSTEM MICROSWITCH CONNECTION.
 - ONE RELAY IS WIRED TO MICROSWITCH (IN FIRE SYSTEM) FOR SURETY FAN SHUTDOWN AND OTHER RELAY FOR ADDITIONAL FIRE SYSTEM ACTIVATED DRY CONTACTS.
 - ELECTRICAL CONDUIT DRIPS FROM THE PANELS SHALL BE CONNECTED TO THE NUMBERED TERMINAL STRIP. CONDUIT BETWEEN THE PRE-WIRED PACKAGE AND PANELS SHALL BE SUPPLIED BY THE ELECTRICAL CONTRACTOR.

FAN #2 CAS-HVAC3-I.500-24MF-12.5T - HEATER



- NOTES:
- DO NOT OBSTRUCT OUTSIDE AIR INLET, OUTSIDE AIR COIL OR OUTSIDE AIR FAN.
 - DENOTES CORNER WEIGHT.
 - ROOF OPENING MUST BE 2" SMALLER THAN CURB DIMENSIONS IN BOTH DIRECTIONS.
 - CONNECTION FROM BREAKER TO UNITS SAFETY DISCONNECT SWITCH TO BE COPPER WIRE ONLY.

*NOTE: SUPPLY DUCT MUST BE INSTALLED TO MEET SMACNA STANDARDS. A MINIMUM STRAIGHT DUCT LENGTH MUST BE MAINTAINED DOWNSTREAM OF UNIT DISCHARGE AS OUTLINED IN AMCA PUBLICATION 201. WHEN USING RECTANGULAR DUCTWORK, ELBOWS MUST BE RADIUS THROAT, RADIUS BACK WITH TURNING VANES. FLEXIBLE DUCTWORK AND SQUARE THROAT/SQUARE BACK ELBOWS SHOULD NOT BE USED. ANY TRANSITION AND/OR TURNS IN THE DUCTWORK WILL CAUSE SYSTEM EFFECT. SYSTEM EFFECT WILL DRASTICALLY INCREASE STATIC PRESSURE AND REDUCE AIRFLOW. DO NOT RELY ON UNIT TO SUPPORT DUCT IN ANY WAY. FAILURE TO PROPERLY SIZE DUCTWORK MAY CAUSE SYSTEM EFFECTS AND REDUCE PERFORMANCE OF THE EQUIPMENT. SUGGESTED STRAIGHT DUCT SIZE IS 25" x 14".

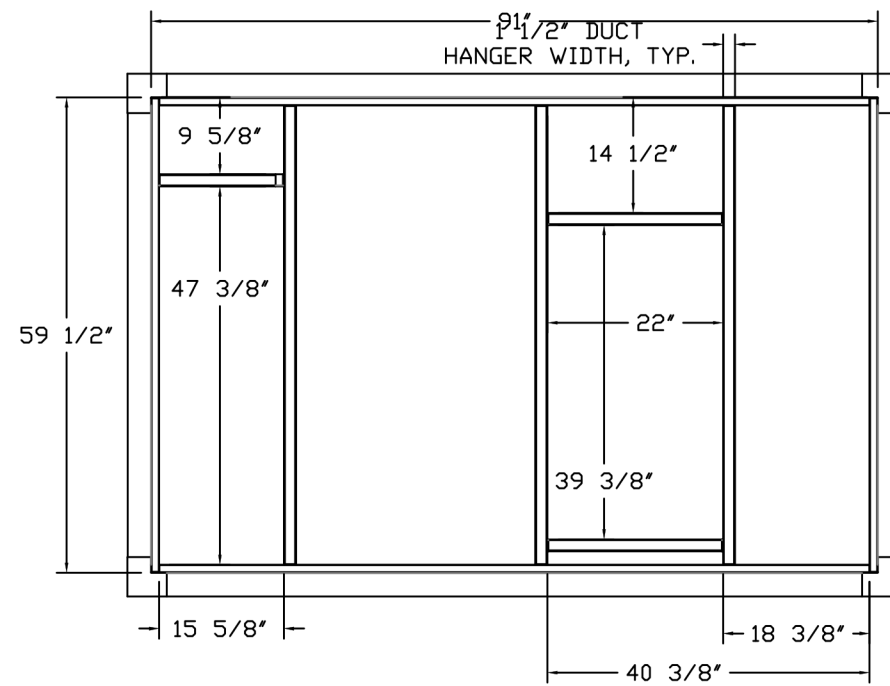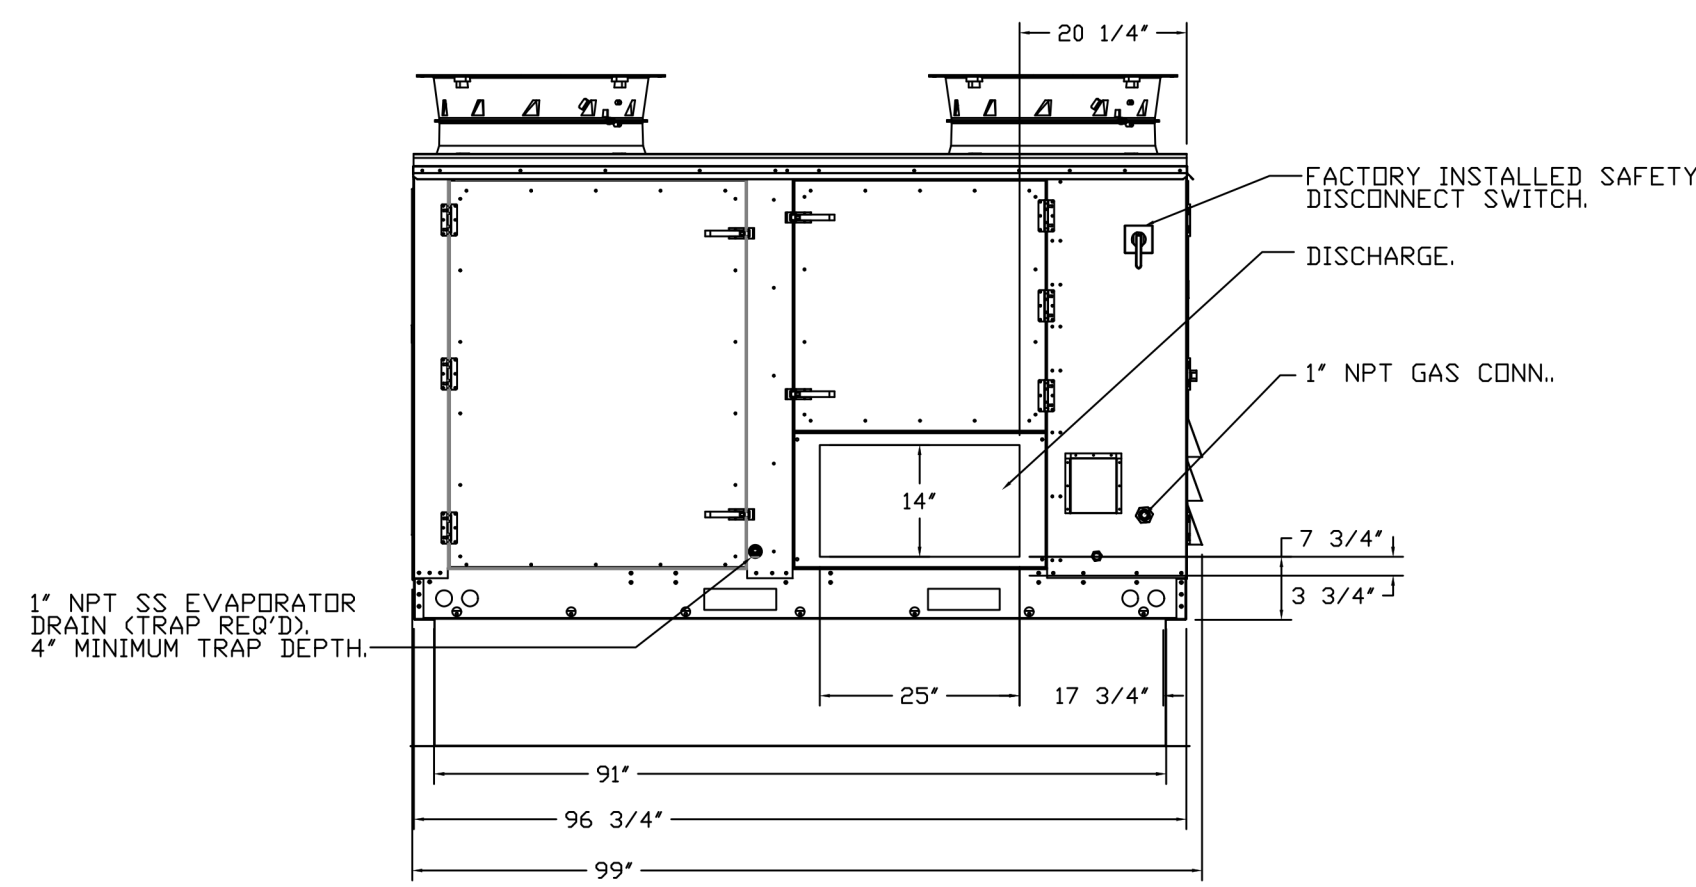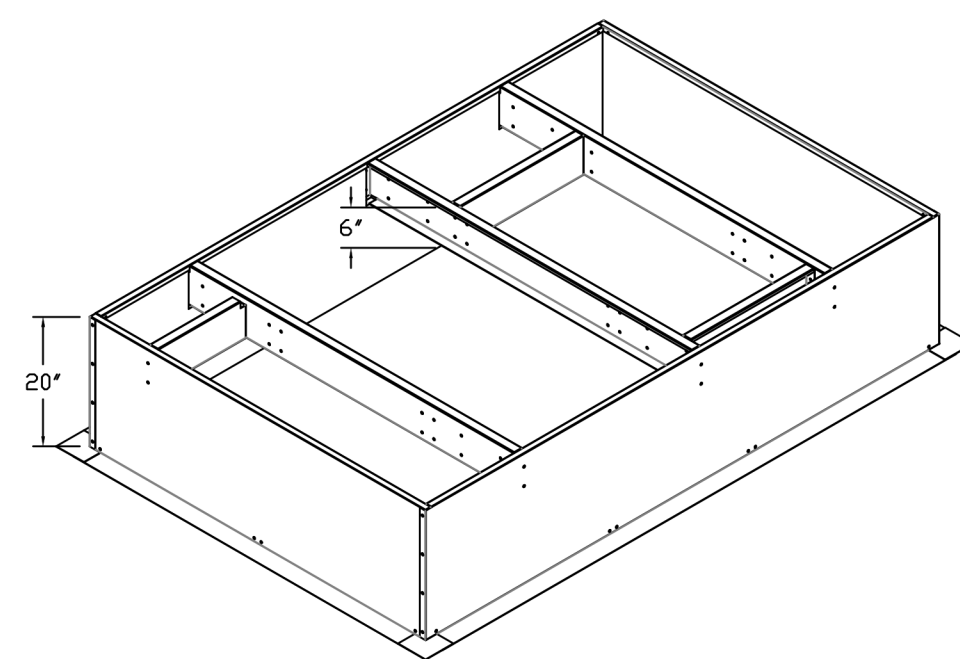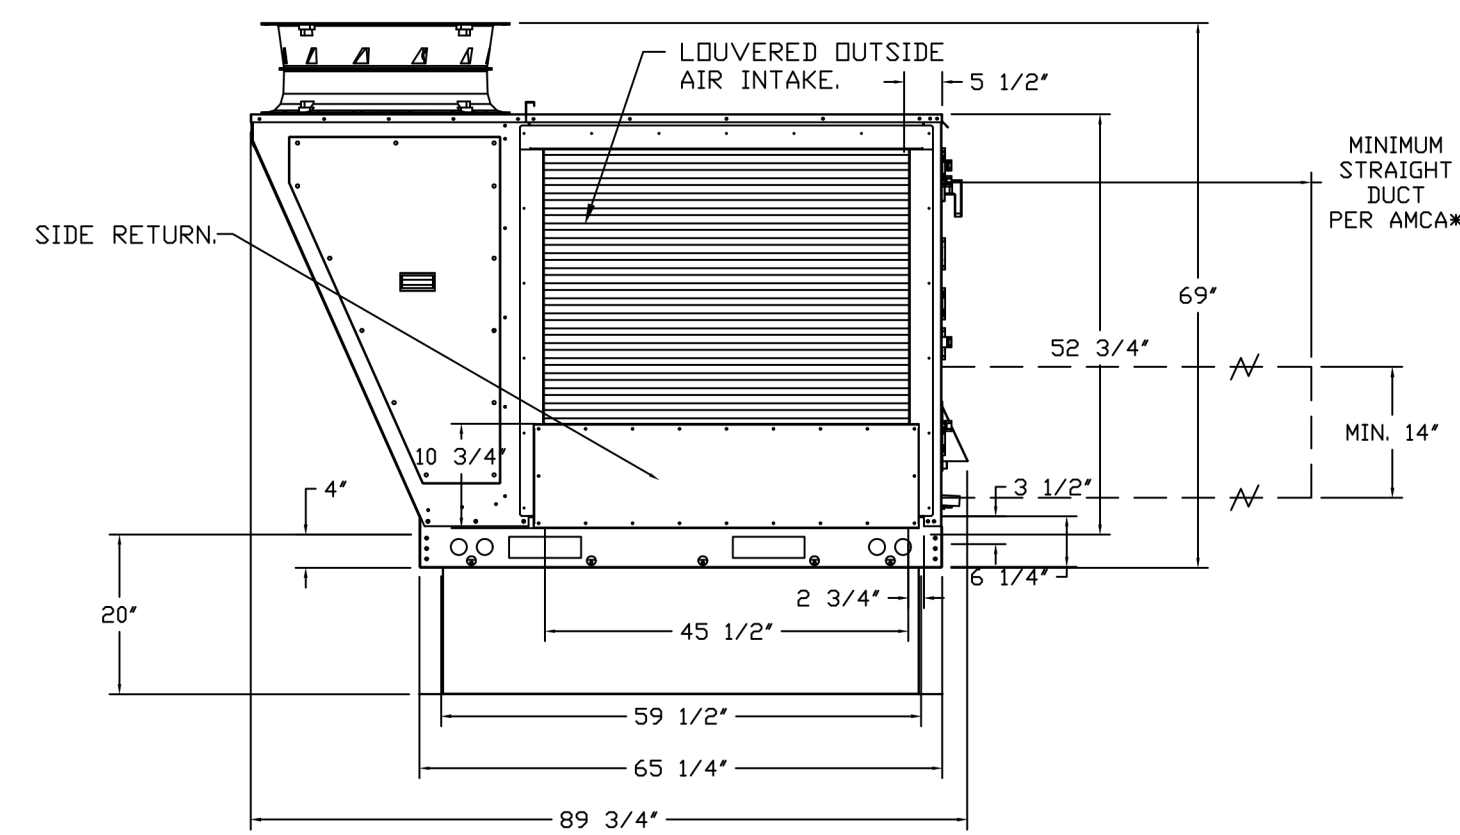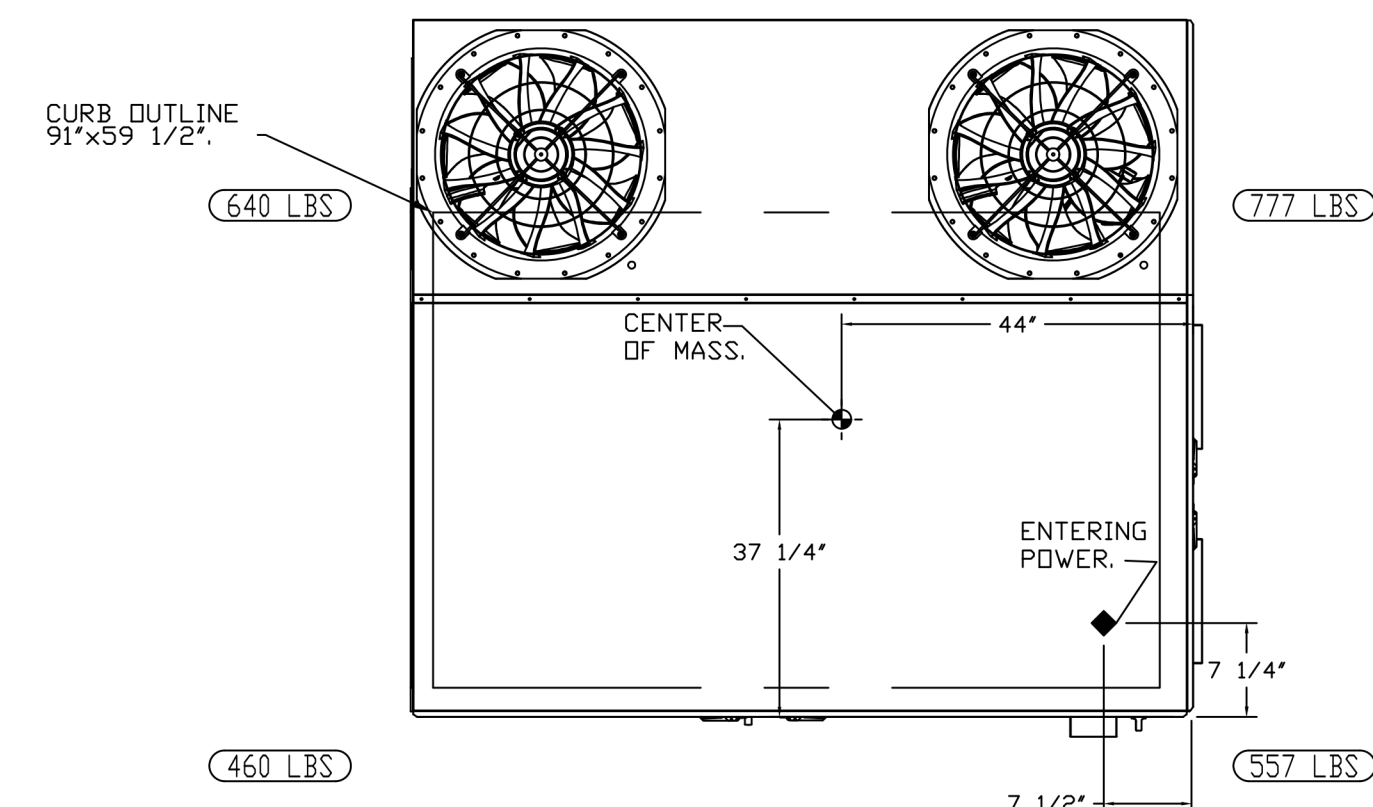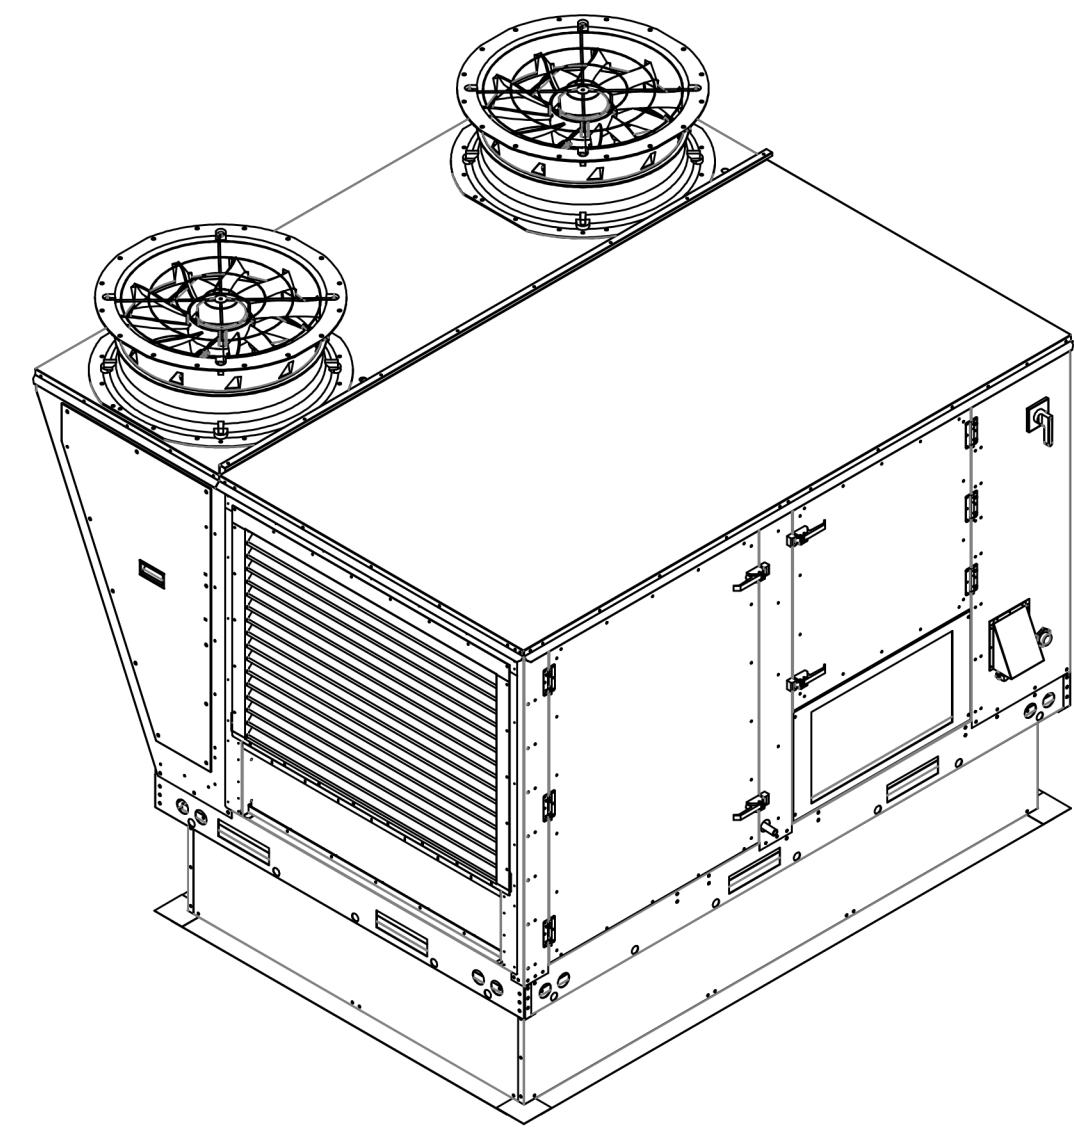

TYPICAL DOAS/RTU ROOF MOUNTING INSTALLATION INSTRUCTIONS

- SECURE THE CURB TO THE ROOF FRAMING MEMBERS BY DRILLING 1/4" PILOT HOLES IN THE CURB FLANGES AT LOCATIONS SHOWN IN THE DIAGRAM BELOW. USING 3/8" X 2" ZINC PLATED STEEL LAG BOLTS AND ZINC PLATED WASHERS, SCREW THROUGH THE CURB FLANGES AND INTO THE ROOF FRAMING MEMBERS. A MINIMUM OF (5) LAG BOLTS ON EACH SHORT SIDE, AND (7) LAG BOLTS ON EACH LONG SIDE IS REQUIRED.
- SECURE THE UNIT BASE TO THE SIDE WALLS OF THE CURB USING (24) 1/4"-14 X 2" SELF-DRILLING, STEEL ZINC PLATED SCREWS. PRE-PUNCHED HOLES HAVE BEEN PROVIDED FOR EACH SCREW LOCATION.

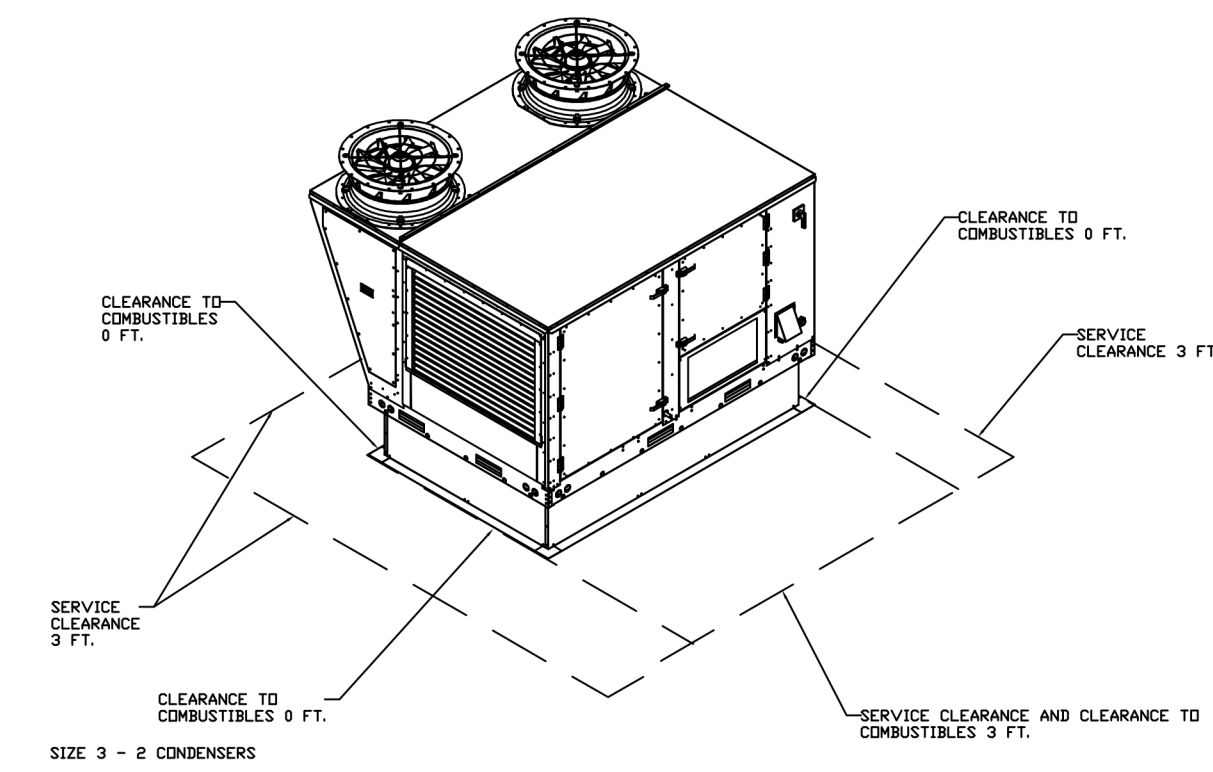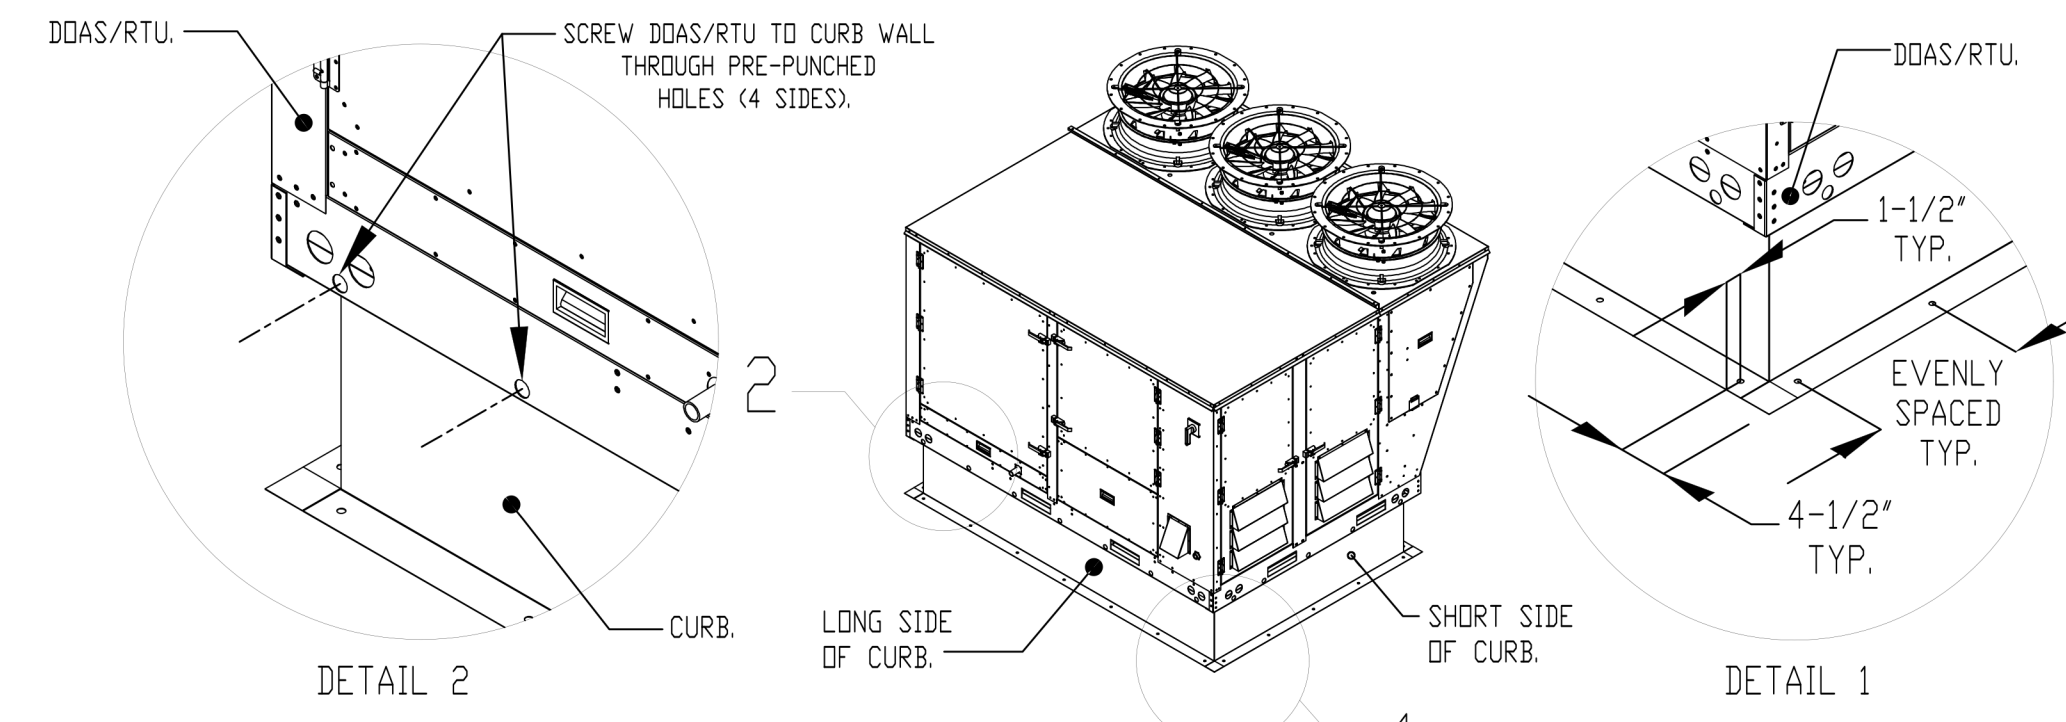


REVISIONS	
NO.	DESCRIPTION

CAPTIVE


Utah Office
2686 S. Redwood Rd., Suite S, West Valley, UT 84119 PHONE: (801) 878-3677 FAX: 9192275963 EMAIL: reg@captiveware.com www.captiveware.com

Steamboat Springs Restaurant TI
Steamboat Springs, CO, 80477

DATE:	6/12/2024
DWG.#:	6744566
DRAWN BY:	EH
SCALE:	1/2" = 1'-0"
MASTER DRAWING	

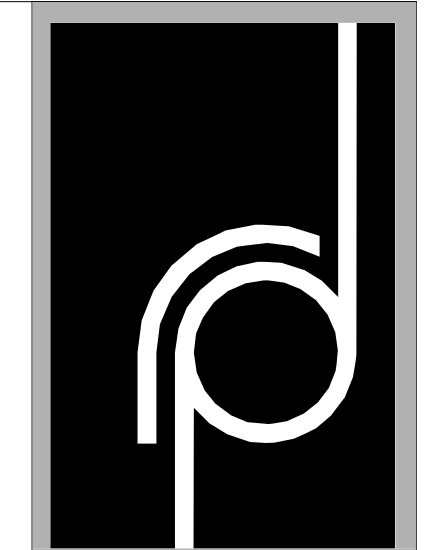

THE RICHARDSON DESIGN PARTNERSHIP, L.L.C.
610 South 600 East
Salt Lake City, Utah 84102
P: 801.355.6886
F: 801.355.6880

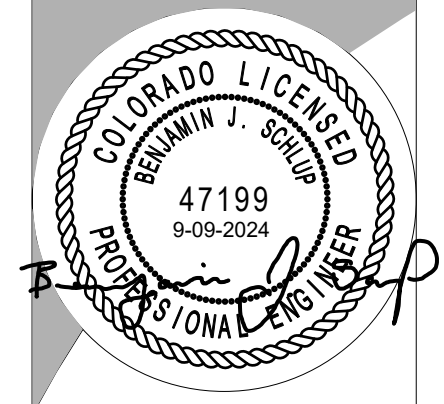

SPECTRUM ENGINEERS
324 S. State St., Suite 400
Salt Lake City, UT 84111
800-678-7077
801-339-5151
fax: 801-328-5155
www.spectrum-engineers.com

Reviewed for Code Compliance
10/07/2024
CONSULTANT

SERAC CAPITAL PARTNERS, LLC
5051 WESTHEIMER RD. SUITE 1750
HOUSTON, TX 77056
OWNER:


CENTRAL PARK RESTAURANT T.I.
1760 Central Park Dr.
Steamboat Springs, CO
PROJECT:

ISSUE DATE	DESCRIPTION
06/17/2024	
09/10/24	Owner Revisions

PERMIT SET
MECHANICAL KITCHEN EQUIPMENT
RME509
PROJECT #: 2023
DRAWN BY: EHT
CHECKED BY: SSJ

ELECTRICAL PACKAGE - JOB#6744566





NO	TAG	PACKAGE #	LOCATION	SWITCHES		OPTION	FANS CONTROLLED				
				LOCATION	QUANTITY		TYPE	HP	VOLT	FLA	
1		DCV-1111	UTILITY CABINET RIGHT	UTILITY CABINET RIGHT	1 LIGHT	SMART CONTROLS DCV	EXHAUST	3	5.000	208	15.2
				HOOD # 1	1 FAN		SUPPLY	3	5.000	208	15.8

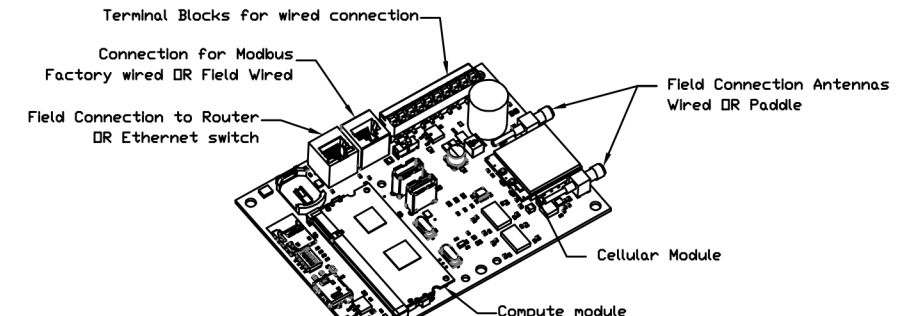

CASlink Monitor and Control
 - Hood control panel to support communications to cloud-based Building Management System.
 - Hood Control Panel to allow cloud-based Building Management System to monitor real time parameters outlined as MONITOR in the points list.
 - Hood Control Panel to allow cloud-based Building Management System to control parameters outlined as CONTROL in the points list.
 - Hood Control Panel to allow cloud-based Building Management System to implement SYSTEM SCHEMATIC control strategies for fully integrated Building Management.

MONITORING AND CONTROL POINTS LIST

DCV Package	Function	DC Package	Function
Room Temperature	MONITOR	Room Temperature(s)	MONITOR
Duct Temperature(s)	MONITOR	Duct Temperature(s)	MONITOR
MRA Discharge Temperature	MONITOR	MRA Discharge Temperature	MONITOR
Return MRA Discharge Temperature	MONITOR	Return MRA Discharge Temperature	MONITOR
Fan Speed	MONITOR	Control Panel	MONITOR
Fan Amperage	MONITOR	Fan Faults	MONITOR
Fan Status	MONITOR	Fan Status	MONITOR
VFD Faults	MONITOR	VFD Faults	MONITOR
Control Panel	MONITOR	PCV Filter Clip Percentage	MONITOR
Fan Faults	MONITOR	Fan Status	MONITOR
PCV Faults	MONITOR	Building Pressure	MONITOR
PCV Filter Clip Percentage	MONITOR	PCV Filter Clip Percentage	MONITOR
Fire Condition	MONITOR & CONTROL	Light Button(s)	MONITOR & CONTROL
CO2 Fire System	MONITOR	Push Button	MONITOR & CONTROL
Building Pressure	MONITOR	Push Button	MONITOR & CONTROL
Prep Fire Button	MONITOR & CONTROL		
Fan Button	MONITOR & CONTROL		
Light Button	MONITOR & CONTROL		
Push Button	MONITOR & CONTROL		

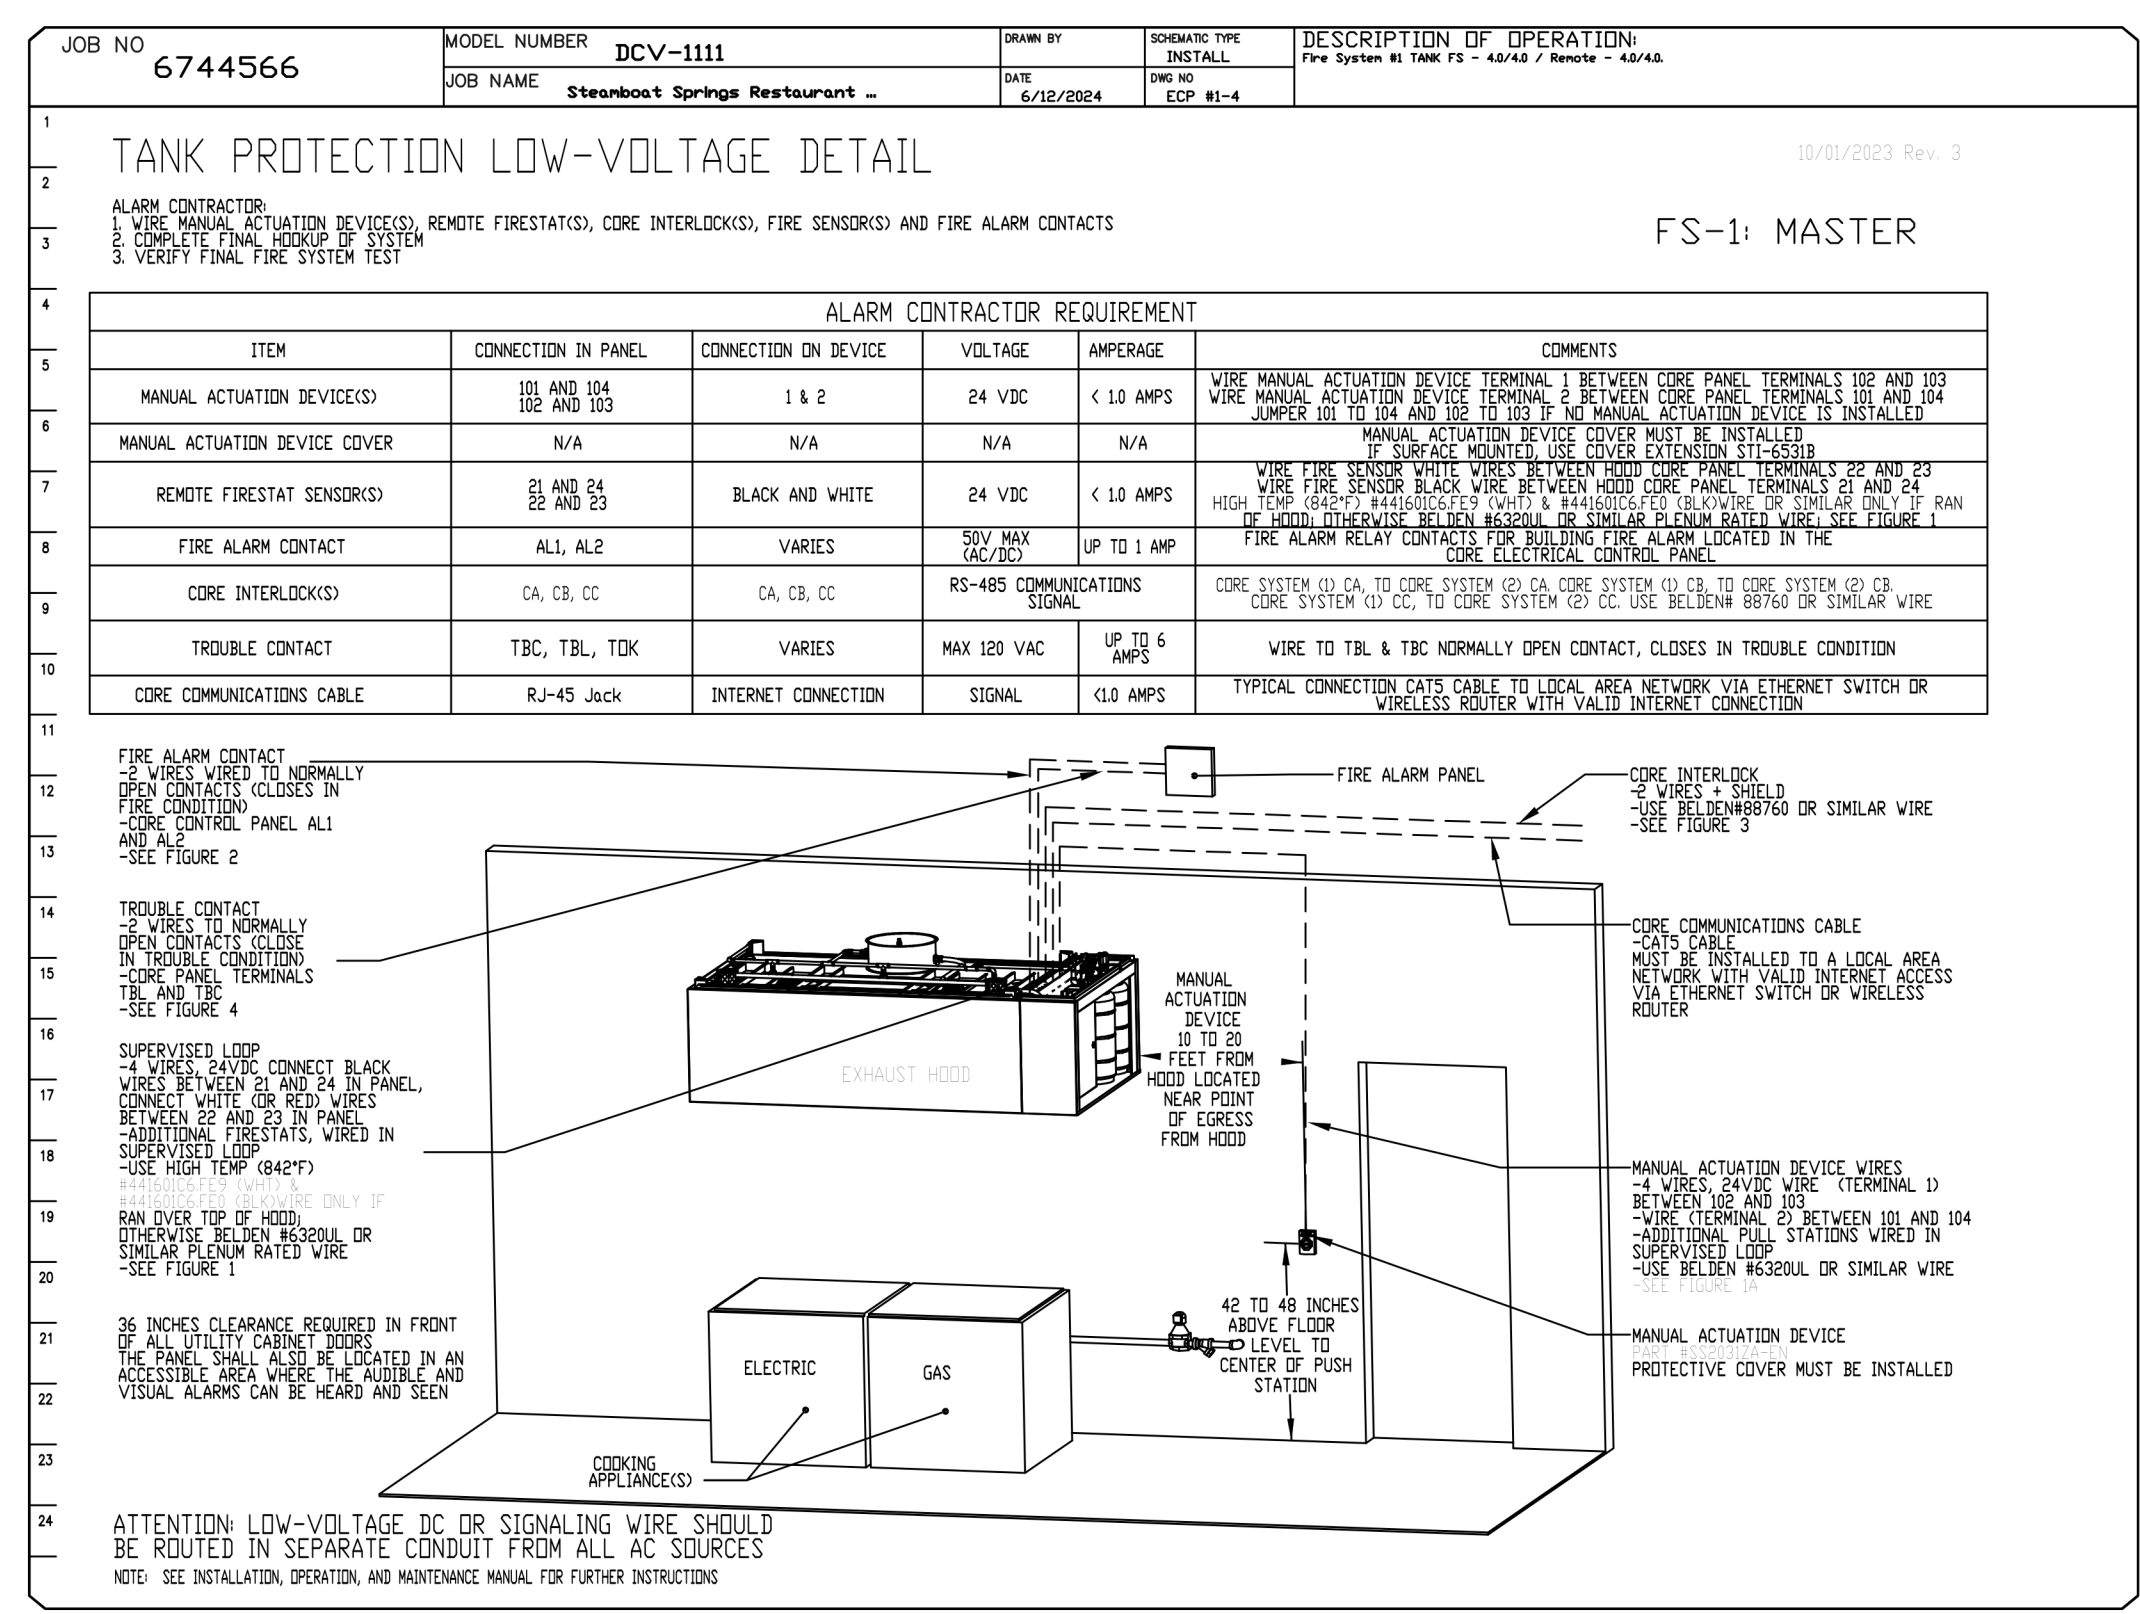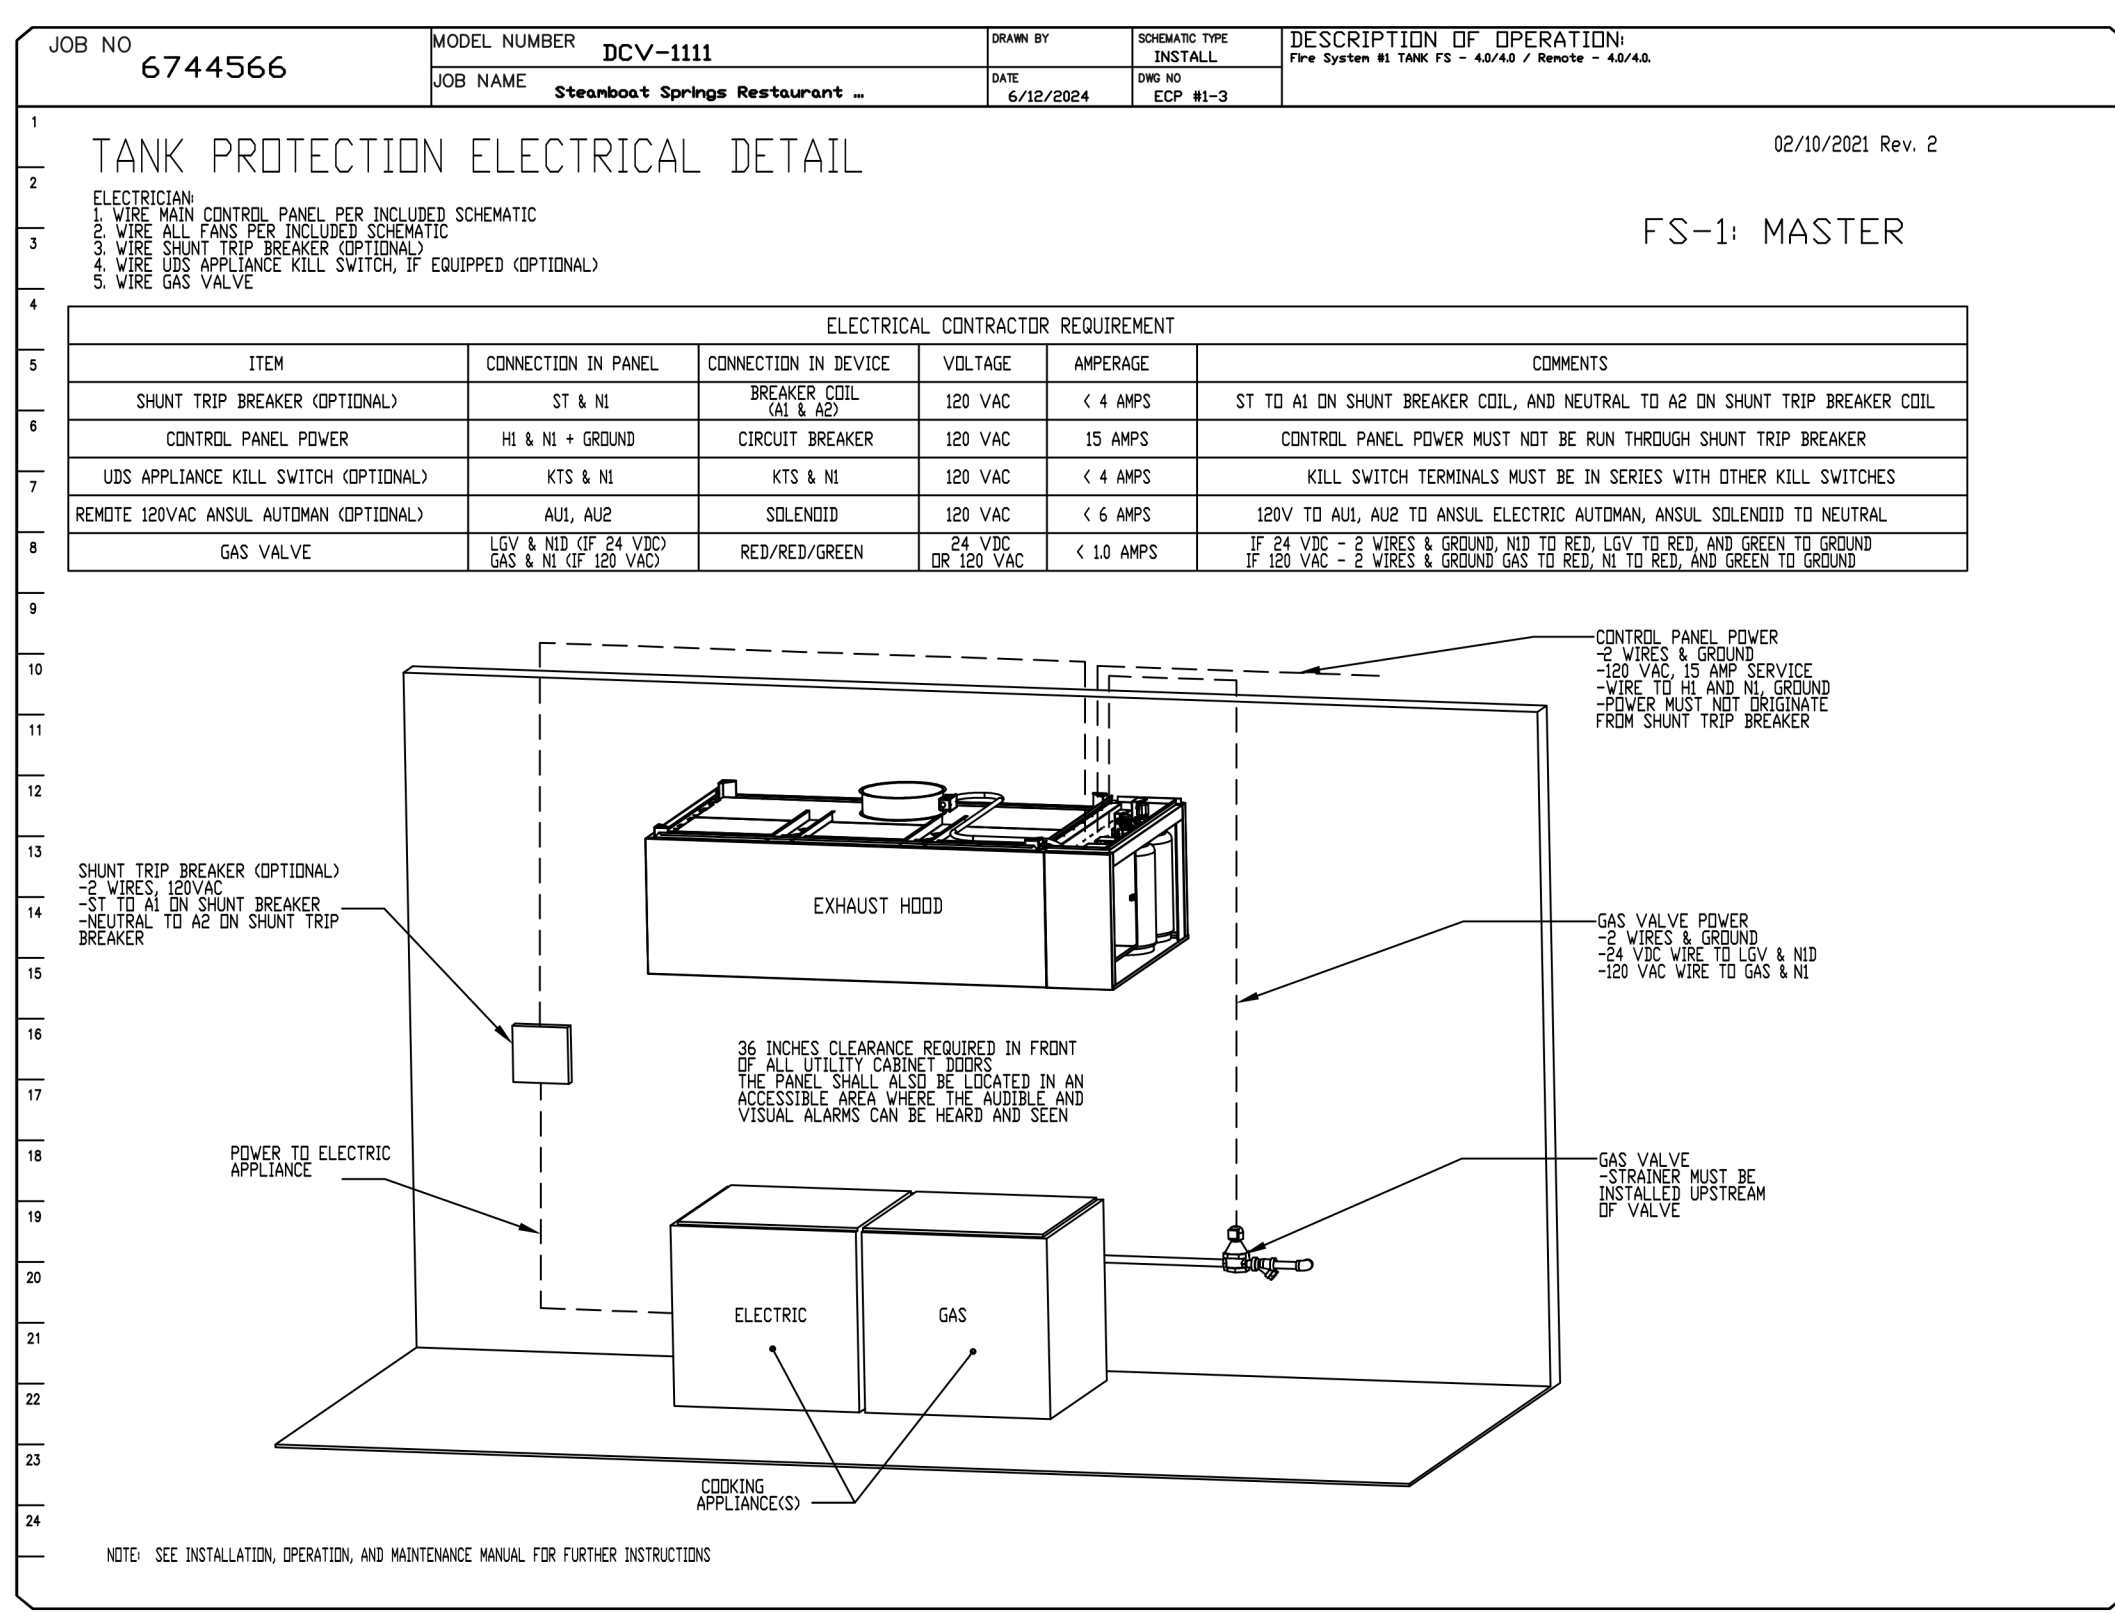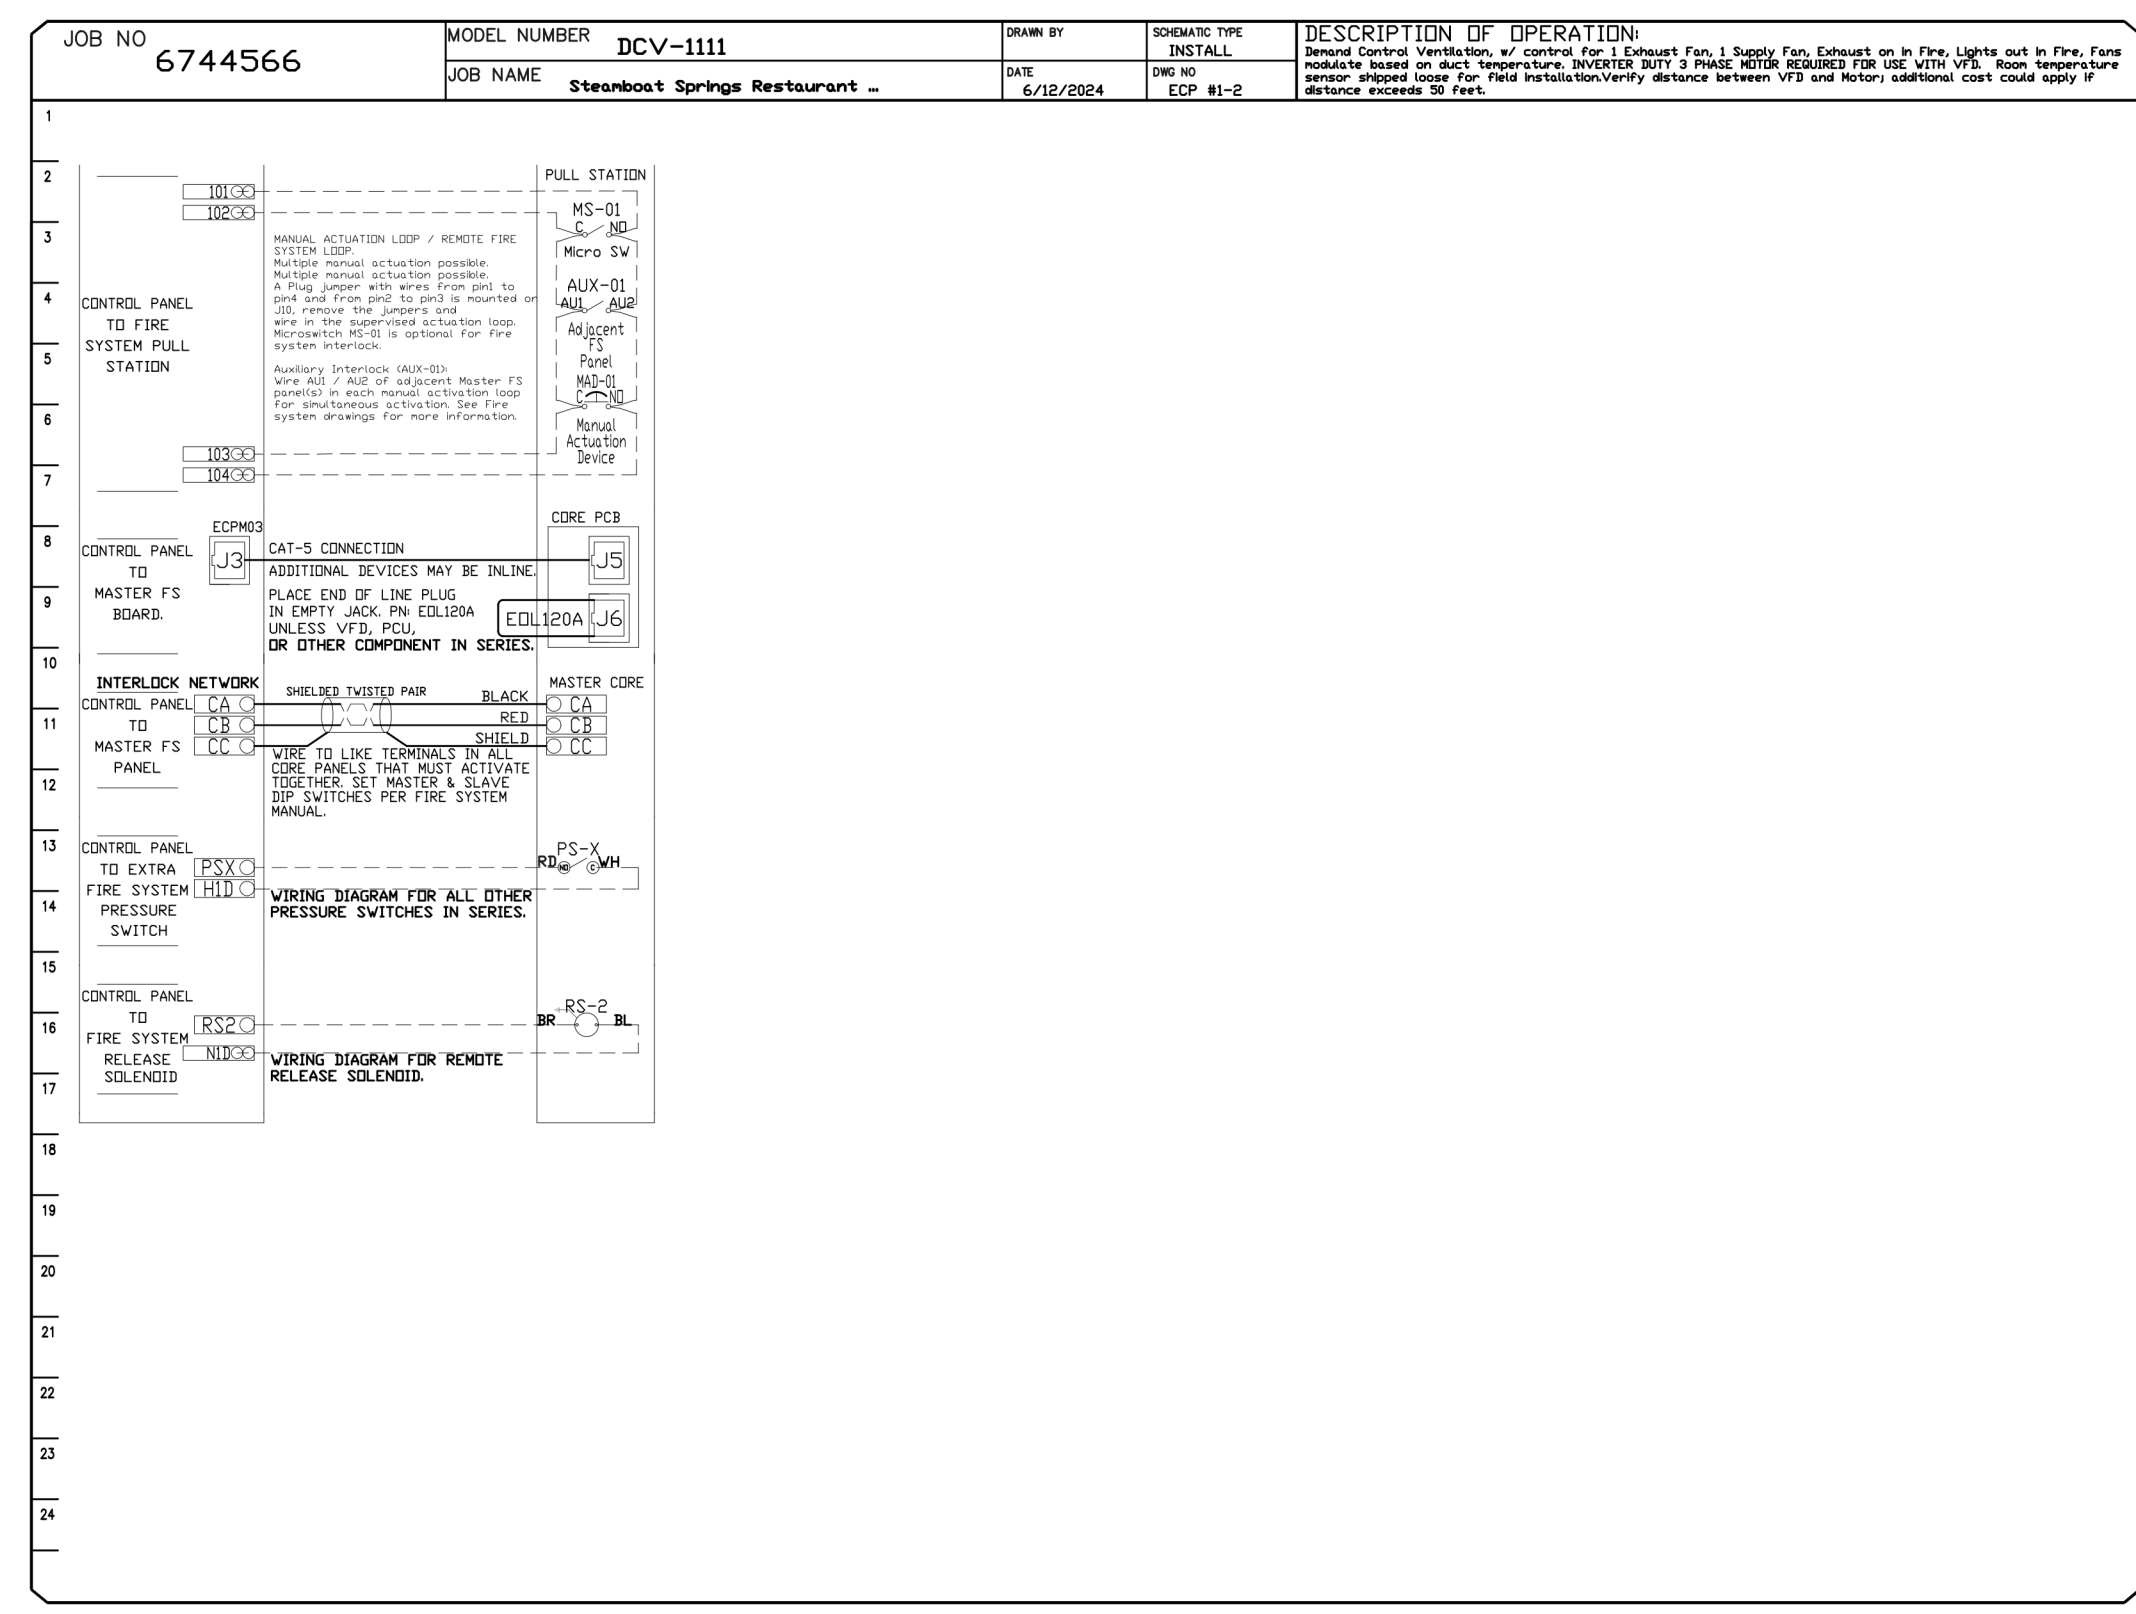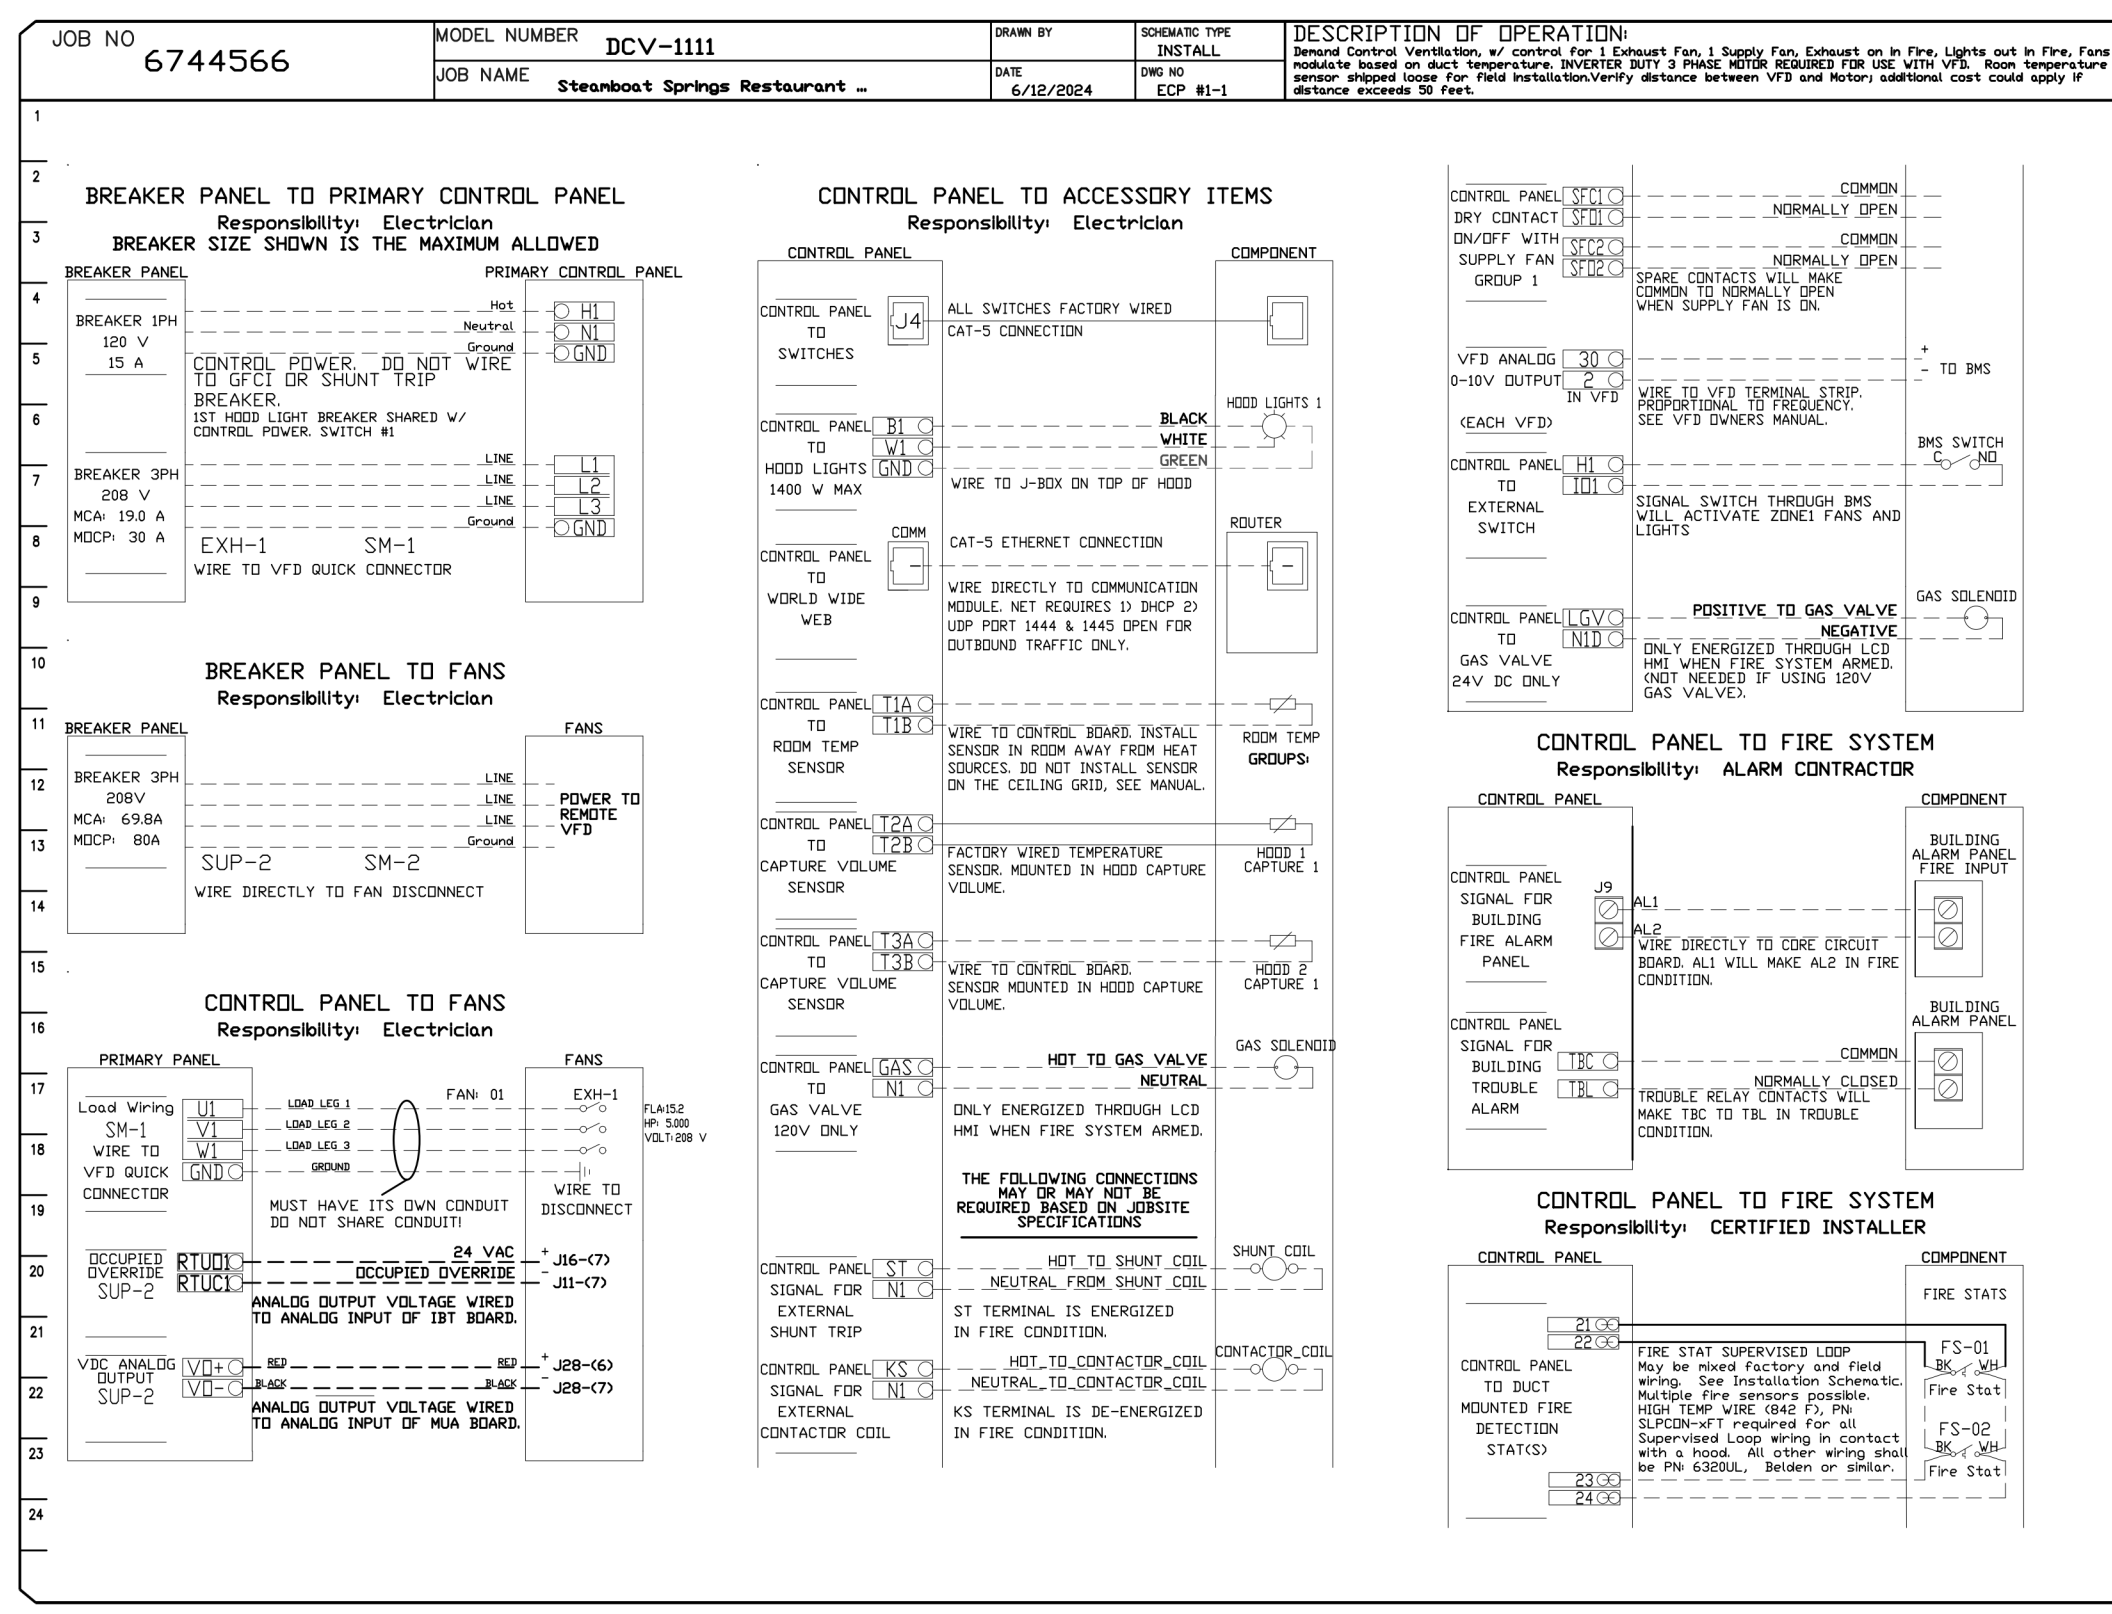


REVISIONS

NO	DESCRIPTION	DATE
1		
2		
3		
4		

CAPTIVE
 Utah Office
 2686 S. Redwood Rd., Suite S, West Valley, UT, 84119 PHONE: (801) 978-3677 FAX: 9192279963 EMAIL: reg@captivewire.com
 www.captivewire.com

Steamboat Springs Restaurant II
 Steamboat Springs, CO, 80477

DATE: 6/12/2024
 DWG.#: 6744566
 DRAWN BY: EH
 SCALE: 3/4" = 1'-0"
 MASTER DRAWING

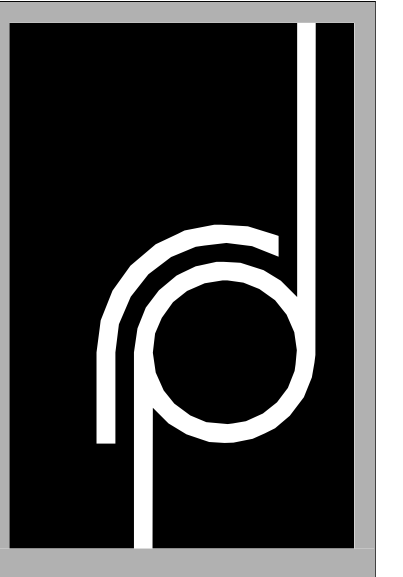

THE RICHARDSON DESIGN PARTNERSHIP, L.L.C.
 510 South 600 East
 Salt Lake City, Utah 84102
 P: 801.355.6886
 F: 801.355.6880



SPECTRUM ENGINEERS
 324 S. State St., Suite 400
 Salt Lake City, UT 84111
 800-678-7077
 801-328-5151
 fax: 801-328-5155
 www.spectrum-engineers.com

Reviewed for Code Compliance
 10/07/2024
 CONSULTANT

SERAC CAPITAL PARTNERS, LLC
 5051 WESTHEIMER RD. SUITE 1750
 HOUSTON, TX 77056
 OWNER:

CENTRAL PARK RESTAURANT T.I.
 1760 Central Park Dr.
 Steamboat Springs, CO
 PROJECT:

ISSUE	DATE	DESCRIPTION
1	06/17/2024	Owner Revisions
2	09/10/24	Owner Revisions

PERMIT SET
 MECHANICAL KITCHEN EQUIPMENT
 RME511
 PROJECT #: 2019
 DRAWN BY: EHT
 CHECKED BY: SSJ

EXISTING HEAT PUMP UNIT SCHEDULE (BY SHELL - PROVIDED FOR REFERENCE)																	
LABEL	INDOOR UNIT SERVED	AREA SERVED	HEAT PUMP CAPACITY (BTUH)	REFRIGERANT TYPE	ELECTRICAL										REMARKS		
					VOLTS	PHASE	Hz	MCA (EACH)	MOC (EACH)	BASE PAN HEATER (Y / N)	EMERG POWER	DISCONNECT PROVIDED BY (MECH/ ELEC)	SOUND RATING	WEIGHT (LBS)		MANUFACTURER	MODEL
(E)HP-12	F-12	RESTAURANT	60,000	R-410A	208	1	60	35	40	YES	NO	ELEC	62	225	Lennox	VPC060H4M-3P	ALL
(E)HP-13	F-13	RESTAURANT	60,000	R-410A	208	1	60	35	40	YES	NO	ELEC	62	225	Lennox	VPC060H4M-3P	ALL

1. EXISTING - PROVIDED AND INSTALLED AS PART OF SHELL DESIGN/CONSTRUCTION.

EXISTING FAN COIL UNIT SCHEDULE (BY SHELL - SHOWN FOR REFERENCE)																				
LABEL	TYPE	SERVES	COOLING TOTAL CAPACITY (BTUH)	AIRFLOW (CFM)	ESP (IN-WC)	SUPPLY FAN ELECTRICAL										REMARKS				
						VOLTS	PHASE	Hz	MCA	MOC	KW	VOLTAGE	PHASE	AMPS	EMERG POWER		DISCONNECT PROVIDED BY (MECH/ ELEC)	WEIGHT (LBS)	MANUFACTURER	MODEL
(E)FC-12	HORIZONTAL	RESTAURANT	54,000	2,000	0.6	208	1	60	7	15	7.5	208	1	36	NO	ELEC	170	LENNOX	VVC060H4-3P	ALL
(E)FC-13	HORIZONTAL	RESTAURANT	54,000	2,000	0.6	208	1	60	7	15	7.5	208	1	36	NO	ELEC	170	LENNOX	VVC060H4-3P	ALL

1. EXISTING - PROVIDED AND INSTALLED AS PART OF SHELL DESIGN/CONSTRUCTION.

NEW HEAT PUMP UNIT SCHEDULE																					
LABEL	INDOOR UNIT SERVED	AREA SERVED	EER (SEER)	HSPF	COOLING CAPACITY (BTUH)	HEATING CAPACITY (BTUH)	COP AT 5°F	REFRIGERANT TYPE	ELECTRICAL										REMARKS		
									VOLTS	PHASE	Hz	MCA (EACH)	MOC (EACH)	BASE PAN HEATER (Y / N)	EMERG POWER	DISCONNECT PROVIDED BY (MECH/ ELEC)	SOUND RATING	WEIGHT (LBS)		MANUFACTURER	MODEL
HP-1R	FC-1R	RESTAURANT	11.7 (17.7)	9.2	36,000	40,000	1.8	R-410A	208	1	60	25	30	YES	NO	ELEC	62	225	Lennox	VPC060H4M-3P	ALL

ACCEPTABLE MANUFACTURERS:
CARRIER
TRANE/MITSUBISHI
LENNOX
DAIKIN
LG

REMARKS:
(1) PROVIDE WITH HAIL GUARDS.
(2) PROVIDE WITH NEOPRENE PADS AT ALL MOUNTING CONNECTION POINTS.
(3) PROVIDE REFRIGERANT PIPING SIZED AS PER MANUFACTURER'S RECOMMENDATIONS. "ACR" COPPER ONLY.
(4) COORDINATE REFRIGERANT CHARGE AND PIPING SIZES WITH EQUIVALENT LINE LENGTH TO MINIMIZE PRESSURE DROP AND CAPACITY LOSS.
(5) PROVIDE AIREX TITAN BOOT OR EQUAL AT ANY REFRIGERANT LINE PENETRATIONS INTO BUILDING ENVELOPE.
(6) PROVIDE CRANKCASE HEATER, LOW AMBIENT CONTROLS, AND TAMPER PROOF PORT CAPS.
(7) BUILT IN BASE PAN HEATER
(8) PROVIDE FACTORY AUTHORIZED STARTUP OF EQUIPMENT INCLUDING STARTUP OF ANY FACTORY CONTROLS TO ENSURE PROPER SEQUENCING.

SCHEDULE KEY
PLUMB = DIVISION 22
MECH = DIVISION 23
ELEC = DIVISION 26
MNFR = MANUFACTURER

TYPE II HOOD SCHEDULE					
LABEL	MODEL	MANUFACTURER	LENGTH	DESIGN CFM/FT	TOTAL EXH CFM
H-3	CHP336	HALIFAX	3' - 0"	200	600

NEW FAN COIL UNIT SCHEDULE																			
LABEL	TYPE	SERVES	COOLING CAPACITY (BTUH)	HEATING CAPACITY (BTUH)	AIRFLOW (CFM)	ESP (IN-WC)	BLOWER MOTOR FLA	SUPPLEMENTAL ELECTRIC HEAT		VOLTAGE	PHASE	MCA	MOC	EMERGENCY POWER	DISCONNECT PROVIDED BY (MECH/ ELEC)	WEIGHT (LBS)	MANUFACTURER	MODEL	REMARKS
								KW	BTUH										
FC-1R	HORIZONTAL	RESTAURANT	36,000	40,000	1,200	0.6	4.2	7.5	19,200	208	1	39.3	40	NO	ELEC	175	LENNOX	VVC060H4-3P	ALL

ACCEPTABLE MANUFACTURERS:
TRANE/MITSUBISHI
CARRIER
LENNOX
DAIKIN
LG

REMARKS:
(1) ELECTRICAL MCA AND MOC INCLUDE BOTH BLOWER MOTOR AND SUPPLEMENTAL ELECTRIC HEAT. SINGLE POINT POWER.
(2) PROVIDE WITH FILTER RACK, NEUTRALIZATION KIT, AND CONDENSATE PUMP.
(3) PROVIDE WITH INDOOR COIL TO MATCH AIRFLOW.
(4) PROVIDE WITH LENNOX MODEL V8TATS1 OR EQUAL, POWERED BY FAN COIL UNIT. MECHANICAL CONTRACTOR SHALL PROVIDE AND INSTALL NECESSARY WIRING BETWEEN FAN COIL UNIT & THERMOSTAT.
(5) PROVIDE FACTORY AUTHORIZED STARTUP OF EQUIPMENT INCLUDING STARTUP OF ANY FACTORY CONTROLS TO ENSURE PROPER SEQUENCING.
(6) PROVIDE SECONDARY DRAIN PAN. PROVIDE WATER LEVEL ALARM (DIVERSITECH WS-1 WET SWITCH OR EQUAL) IN DRAIN PAN TO SHUT OFF UNIT WHEN HIGH WATER LEVEL IS DETECTED.

SCHEDULE KEY:
PLUMB = DIVISION 22
MECH = DIVISION 23
ELEC = DIVISION 26
MNFR = MANUFACTURER

HEATER SCHEDULE (ELECTRIC)																
LABEL	TYPE	HEATING CAPACITY (WATTS)	STAGES	ELECTRICAL			DISCONNECT PROVIDED BY (MECH/ ELEC)	WEIGHT (LBS)	MANUFACTURER	MODEL	REMARKS					
				VOLTS	PHASE	Hz						MCA	MOC			
CUH	RECESSED, WALL MOUNTED	4000	2	208	3	60	11.1	ELEC	25	Marley Engineered Products (QMARK)	AWH44083F 1-3					

ACCEPTABLE MANUFACTURERS:
HODINE
REZTOR
QMARK
MARLEY

REMARKS:
(1) PROVIDE WITH FINGER PROOF FAN GUARD.
(2) RECESSED WALL MOUNTED.
(3) PROVIDE WITH INTEGRAL THERMOSTAT.

SCHEDULE KEY:
PLUMB = DIVISION 22
MECH = DIVISION 23
ELEC = DIVISION 26
MNFR = MANUFACTURER

- *FOR TYPE I HOOD (H-1 & H-2) SCHEDULES, OPTIONS AND ACCESSORIES, SEE CAPTIVEAIRE PLANS ON SHEETS ME503, ME504 ME505, & ME506.
- *FOR GREASE EXHAUST FAN (EF-1R) SCHEDULES, OPTIONS AND ACCESSORIES, SEE CAPTIVEAIRE PLANS ON SHEET ME507.
- *FOR CONDENSATE EXHAUST FAN (EF-2R) SCHEDULES, OPTIONS AND ACCESSORIES, SEE CAPTIVEAIRE PLANS ON SHEET ME507.
- *FOR MAKEUP AIR UNIT (KMAU-1) SCHEDULES, OPTIONS AND ACCESSORIES, SEE CAPTIVEAIRE PLANS ON SHEETS ME507, ME508 & ME509.

REGISTER - GRILLE- DIFFUSER SCHEDULE																
LABEL	TYPE	MAX AIRFLOW (CFM)	FACE SIZE	NECK SIZE	BLOW PATTERN	PD (IN-WC)	THROW(S) (FT)	MAX NC	MANUFACTURER	MODEL	REMARKS					
												10"-12" WATTS	PRICE			
R-1	RETURN GRILLE - SIDEWALL	2000	24" X 24"	18" X 18"	N/A	0.100	N/A	30	PRICE INDUSTRIES	535	1-3					
R-2	RETURN GRILLE - CEILING - LAY-IN	1750	24" X 24"	SEE PLANS	N/A	0.100	N/A	30	PRICE INDUSTRIES	535	1-3					
R-3	RETURN GRILLE - DUCT MOUNTED	1946	36" X 12"	36" X 12"	N/A	0.031	N/A	30	PRICE INDUSTRIES	SDGR	1-3					
S-1	SUPPLY DIFFUSER - CEILING - LAY-IN	545	24" X 24"	10" Ø	4-WAY	0.122	5-5-12	30	PRICE INDUSTRIES	SCD	1-3					
S-2	SUPPLY DIFFUSER - SIDEWALL	850	14" X 12"	14" X 12"	ADJUSTABLE	0.100	23-28-40	30	METALABRE	H4004S-AF-1	1-3					
S-3	SUPPLY DIFFUSER - DUCT MOUNTED	500	16" X 6"	16" X 6"	ADJUSTABLE	0.050	10-14-19	30	PRICE INDUSTRIES	SDG	1-4					
S-4	SUPPLY DIFFUSER - CEILING - LAY-IN	785	24" X 24"	12" Ø	4-WAY	0.142	7-10-15	30	PRICE INDUSTRIES	SCD	1-3					
S-5	SUPPLY DIFFUSER - CEILING - LAY-IN	415	24" X 24"	8" Ø	4-WAY	0.146	5-7-11	30	PRICE INDUSTRIES	SCD	1-3					
S-6	SUPPLY DIFFUSER - CEILING - LAY-IN	850	24" X 24"	14" Ø	DOWN	0.050	N/A	30	PRICE INDUSTRIES	PDOR	1-3					
S-7	SQUARE CONE DIFFUSER	140	12" X 12"	4" Ø	4-WAY	0.215	5-6-9	30	PRICE INDUSTRIES	SCD	1-3					

ACCEPTABLE MANUFACTURERS:
KRUEGER
TUTTLE & BAILEY
TITUS
PRICE

REMARKS:
(1) REGISTERS AND GRILLES SHALL BE TESTED IN ACCORDANCE WITH ANSI/ASHRAE STD 70. NC VALUES ARE BASED ON OCTAVE BAND SOUND POWER LEVELS MINUS A ROOM ABSORPTION OF 10 DB, RE 10"-12" WATTS.
(2) PROVIDE WITH MOUNTING FRAME BASED ON CEILING TYPE. REFERENCE ARCHITECTURAL REFLECT CEILING PLAN FOR CEILING TYPES.
(3) COORDINATE EXACT COLOR SELECTION WITH OWNER AND ARCHITECT. ALL MAIN LEVEL RGD'S IN AMENITY SPACES REQUIRE COLOR APPROVAL BY ARCHITECT PRIOR TO ORDERING.
(4) PROVIDE WITH AIR-SCOOP FOR BALANCING

KMAU-1 SEQUENCE OF OPERATIONS
OVERVIEW: THIS UNIT IS MEANT TO PROVIDE GENERAL AIR CONDITIONING (HEATING AND COOLING) FOR THE KITCHEN AREA, AS WELL AS VENTILATION FOR THE WHOLE RESTAURANT SPACE (KITCHEN AND DINING AREAS).
FAN SEQUENCE: DURING BUSINESS HOURS (OR IF HOOD HEAT SENSORS ARE TRIGGERED ON OUTSIDE OF BUSINESS HOURS), THIS MAU SHALL TURN ON TO FULL DESIGN AIRFLOW WITH 5,046 CFM OF OUTSIDE AIR AND 511 CFM OF RETURN AIR. OUTSIDE OF BUSINESS HOURS (AND WHEN HOOD HEAT SENSORS ARE TRIGGERED OFF) KMAU-1 FAN SHALL ADJUST TO 2,250 CFM TOTAL AIRFLOW WITH 20% OUTSIDE AIRFLOW (450 CFM) AND 80% RETURN AIRFLOW (1,800 CFM). DX COOLING AND GAS HEATING SYSTEMS TO MODULATE TO MAINTAIN SET TEMPERATURE IN SPACE (WALL THERMOSTAT AND TEMPERATURE SENSOR IN SPACE). IN HEATING MODE KMAU-1 MUST MAINTAIN A MINIMUM DISCHARGE AIR TEMPERATURE OF 85°F AND A MAXIMUM DISCHARGE AIR TEMPERATURE OF 95°F. IN COOLING MODE, KMAU-1 MUST MAINTAIN A MINIMUM DISCHARGE AIR TEMPERATURE OF 50°F AND A MAXIMUM DISCHARGE AIR TEMPERATURE OF 60°F.
THE UNIT SHALL SHUT DOWN AND GENERATE AN ALARM UPON RECEIVING A SMOKE DETECTOR STATUS.
EF-1R SEQUENCE OF OPERATIONS
EF-1R SHALL BE INTERLOCKED WITH KMAU-1 AND RUN CONTINUOUSLY DURING BUSINESS HOURS, OR IF HEAT SENSORS IN HOOD ARE TRIGGERED ON.
DH-1 SEQUENCE OF OPERATIONS
DUCT HEATER SHALL BE SINGLE STAGE OPERATION AND SHALL TURN ON WHEN ALL OF THE FOLLOWING CONDITIONS ARE MET:
1. OUTDOOR AMBIENT AIR TEMPERATURE IS BELOW 30°F.
2. KMAU-1 AIRFLOW IS ON AT DESIGN AIRFLOW OF -5,000 CFM.
3. KMAU-1 IS IN HEATING MODE.

DUCT HEATER SCHEDULE (GAS FIRED)																			
LABEL	TYPE	DIMENSIONS	HEATING CAPACITY		HEATING CAPACITY			AIR TEMP RISE (°F)	VENTING TYPE	ELECTRICAL					REMARKS				
			AIRFLOW (CFM)	AIR PRESSURE DROP (IN. W.C.)	INPUT (BTUH)	OUTPUT (BTUH)	STAGES			VOLTS	PHASE	Hz	FLA	EMERG POWER		DISCONNECT PROVIDED BY (MECH/ ELEC)	WEIGHT (LBS)	MANUFACTURER	MODEL
DH-1	GAS-FIRED DUCT HEATER	26" X 41-1/4" X 35-1/4"	5,657	0.35	250,000	200,000	1	33	GRAVITY	120	1	60	0.2	NO	ELEC	276	REZTOR	X-250	ALL

ACCEPTABLE MANUFACTURERS:
MODINE
REZTOR
DETROIT RADIANT
STERLING

REMARKS:
(1) PROVIDE WITH STAINLESS STEEL HEAT EXCHANGER, STAINLESS STEEL BURNERS, AND DRAIN FLANGE.
(2) PROVIDE WITH HIGH ALTITUDE KIT.
(3) DUCT HEATER TO TURN ON WHEN ALL OF THE FOLLOWING ARE TRUE: (1) AMBIENT TEMPERATURE DROPS BELOW 30°F, (2) KMAU-1 AIRFLOW IS ON AT DESIGN -5,000 CFM, (3) KMAU-1 IS IN HEATING MODE.
(4) CONTRACTOR MUST REMOVE FINGER BAFFLE FOR HIGH AIRFLOW SCENARIO.

SCHEDULE KEY:
PLUMB = DIVISION 22
MECH = DIVISION 23
ELEC = DIVISION 26
MNFR = MANUFACTURER

MINIMUM OUTSIDE AIR CALCS PER IMC									
ROOM	SQ FT	TOTAL PEOPLE	OA CFM/PERSON	OA / SQ FT	OA FOR SQ FT	SUM OF PEOPLE AND SQ FT OA	EZ FACTOR	TOTAL	O.A. PROVIDED
RESTAURANT DINING	1,497	136	7.5	1,020	0.18	270		1,290	1,700
KITCHEN	1,392	15	7.5	113	0.12	167	0.80	350	3,350
TOTAL OA REQUIRED									1,963


MINIMUM EXHAUST AIR CALCS PER IMC						
ROOM	SQ FT	EXHAUST CFM / SQ FT	EXHAUST / UNIT	UNITS	TOTAL REQUIRED EXHAUST CFM	EXHAUST PROVIDED
RESTROOMS	120	-	50	2	100	170
KITCHEN	1,392	0.7	-	-	975	1,600
TOTAL EXHAUST REQUIRED					1,075	1,770

AIR BALANCE CALCS - KITCHEN AREA				
EQUIPMENT	SUPPLY CFM	OA CFM	EXHAUST AIR CFM	
KMAU-1	3,350	3,350		
EF-1R			4,350	
EF-2R			600	
TOTALS	3,350	3,350	4,950	NEGATIVE 1,600 CFM


AIR BALANCE CALCS - DINING AND BAR AREAS				
EQUIPMENT	SUPPLY CFM	OA CFM	EXHAUST AIR CFM	
FC-1R	1,200			
KMAU-1	1,700	1,700		
(E) EF-2 (Restroom 1)			50	
(E) EF-2 (Restroom 2)			50	
(E) FC-12	2,000			
(E) FC-13	2,000			
TOTALS	6,900	1,700	100	POSITIVE 1,600 CFM

BUILDING TOTAL: BALANCED (0)

MINIMUM PIPE INSULATION THICKNESS FOR WATER AND REFRIGERANT									
FIELD OPERATING TEMP RANGE (F)	INSULATION CONDUCTIVITY		INSULATION THICKNESS (INCHES) BASED ON NOMINAL PIPE SIZE						
	CONDUCTIVITY BTU/IN/HT*2°F	MEAN RATING TEMPERATURE, F	LESS THAN 1" DIA.	1"-1 1/2" DIA.	1 1/2"-4" DIA	4"-8" DIA.	8" DIA. AND ABOVE		
>350	0.32-0.34	250	4.5	5.0	5.0	5.0	5.0		
251-350	0.29-0.32	200	3.0	4.0	4.5	4.5	4.5		
201-250	0.27-0.30	150	2.5	2.5	2.5	3.0	3.0		
141-200	0.25-0.29	125	1.5	1.5	2.0	2.0	2.0		
105-140	0.22-0.28	100	1.0	1.0	1.5	1.5	1.5		
40-60	0.27-0.30	75	0.5	0.5	1.0	1.0	1.0		
<40	0.20-0.26	50	0.5	1.0	1.0	1.0	1.5		

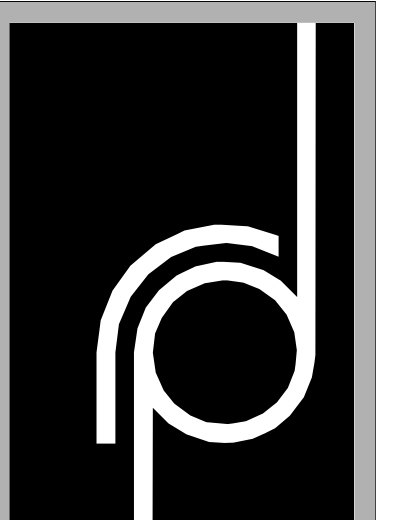

THE RICHARDSON DESIGN PARTNERSHIP, L.L.C.
510 South 600 East
Salt Lake City, Utah 84102
P: 801.355.6886
F: 801.355.6880

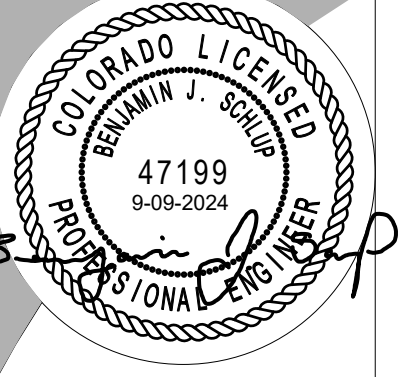

SPECTRUM ENGINEERS
324 S. State St., Suite 400
Salt Lake City, UT 84111
800-678-7077
801-328-5151
fax: 801-328-5155
www.spectrum-engineers.com


Reviewed for Code Compliance
10/07/2024
CONSULTANT

SERAC CAPITAL PARTNERS, LLC
5051 WESTHEIMER RD. SUITE 1750
HOUSTON, TX 77056
OWNER:


CENTRAL PARK RESTAURANT T.I.
1760 Central Park Dr.
Steamboat Springs, CO
PROJECT:

ISSUE DATE	DESCRIPTION
09/17/2024	
REV. DATE	DESCRIPTION
09/10/24	Owner Revisions

PERMIT SET
MECHANICAL SCHEDULES
PROJECT #: 2024
DRAWN BY: GBT
CHECKED BY: SSJ
RME601
SHEET #

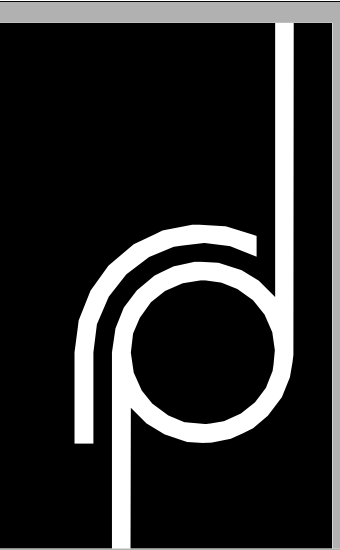

THE RICHARDSON DESIGN PARTNERSHIP, L.L.C.
 510 South 600 East
 Salt Lake City, Utah 84102
 P: 801.352.6868
 F: 801.355.6880

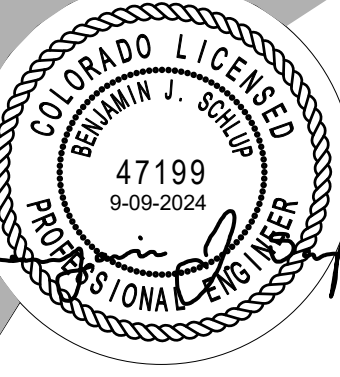

ALL MECHANICAL, ELECTRICAL AND PLUMBING WORK SHALL BE IN ACCORDANCE WITH THE 2024 INTERNATIONAL MECHANICAL, ELECTRICAL AND PLUMBING CODES (IMC, NEC AND UPC) AS AMENDED BY THE STATE OF TEXAS. THE CONTRACTOR SHALL BE RESPONSIBLE FOR OBTAINING ALL NECESSARY PERMITS AND APPROVALS FROM THE APPLICABLE AGENCIES. THE CONTRACTOR SHALL MAINTAIN ACCESS TO ALL MECHANICAL, ELECTRICAL AND PLUMBING SYSTEMS AT ALL TIMES.

SPECTRUM
 324 S. State St., Suite 400
 Salt Lake City, UT 84111
 800-678-7077
 801-328-9151
 fax: 801-328-5155
 www.spectrum-engineers.com

Reviewed for Code Compliance
 10/07/2024
 CONSULTANT

SERAC CAPITAL PARTNERS, LLC
 5051 WESTHEIMER RD. SUITE 1750
 HOUSTON, TX 77056
 OWNER:



CENTRAL PARK RESTAURANT T.I.
 1760 Central Park Dr.
 Steamboat Springs, CO
 PROJECT:

ISSUE DATE	DESCRIPTION
06/17/2024	
REV. DATE	DESCRIPTION
09/10/24	Owner Revisions

PROJECT #	DATE
RMH101	10/07/2024
DRAWN BY	OST
CHECKED BY	SS

PERMIT SET
LEVEL 1 MECHANICAL PLAN
 PROJECT # 2024
 DRAWN BY OST
 SHEET 101
 CHECKED BY SS


GENERAL SHEET NOTES	GENERAL SHEET NOTES	GENERAL SHEET NOTES
<ol style="list-style-type: none"> THIS CONTRACTOR SHALL CLOSELY COORDINATE MECHANICAL AND PLUMBING WITH ELECTRICAL, ARCHITECTURAL, AND BUILDING STRUCTURE. ALL LOW PRESSURE RECTANGULAR DUCTWORK TO BE LINED WITH INSULATION WITH AN R-VALUE OF R-6. ALL LOW PRESSURE ROUND DUCTWORK TO BE WRAPPED WITH INSULATION WITH AN R-VALUE OF R-6. CONTRACTOR SHALL USE SMACNA DUCT CONSTRUCTION STANDARDS FOR SHEET METAL DUCTS. ALL DUCTWORK (UNLESS OTHERWISE NOTED ON FLOOR PLANS) SHALL BE CONSTRUCTED OF 1.5" W.C. SEAL CLASS "A". ALL EXPOSED DUCTWORK TO BE SPIRAL ROUND OR FLAT OVAL WITH CLEAR SILICON DUCT SEALANT. DUCT TO BE FREE OF ANY COATINGS OR FILMS TO ALLOW FOR PAINTING. ALL DUCT DIMENSIONS ARE INSIDE CLEAR DIMENSIONS. FLEXIBLE DUCT MAY BE USED AT FINAL TERMINATION OF DUCT TO DIFFUSER OR GRILLE. MAXIMUM FLEXIBLE DUCT LENGTH IS 5'-0". PROVIDE DUCT SUPPORTS EVERY 3 FEET. FLEX DUCT SHALL NOT BE COMPRESSED OR KINKED BY ANY OBJECTS SUCH AS STRUCTURE, PIPING, ETC. PROVIDE FLEX DUCT ELBOW FLEX FLOW ELBOW BY THERMAFLEX, FLEX RIGHT ELBOW BY FLEXMASTER, SMART FLOW ELBOW BY HART AND COOLEY, OR EQUAL AT ALL CEILING MOUNTED DIFFUSER CONNECTIONS. NOT FOR USE WHERE ABOVE CEILING SPACE IS USED AS RETURN PLENUM. GRILLES AND DUCTWORK ARE SIZED INDEPENDENTLY. THE NECK SIZE OF GRILLES MAY NOT MATCH THE ASSOCIATED DUCT SIZE. PROVIDE TRANSITION TO GRILLES AS NECESSARY. PROVIDE BALANCING DAMPER WITH LOCKING QUADRANT IN EACH DUCT BRANCH OF SUPPLY AND EXHAUST DUCTWORK. PROVIDE REMOTE CABLE OPERATED DAMPER SYSTEM FOR ALL DUCTWORK ABOVE HARD LID CEILINGS OR WHERE DAMPER IS INACCESSIBLE OR PROVIDE OPPOSED BLADE DAMPER WITH NYLON BUSHINGS AT GRILLE. 	<ol style="list-style-type: none"> PROVIDE ACCESS DOORS FOR ALL SERVICEABLE EQUIPMENT OR VALVES ABOVE HARD LID CEILINGS OR IN WALLS. ALL ACCESS PANELS ARE TO BE PAINTED TO MATCH ADJACENT SURFACES. GREASE DUCT SERVING TYPE I HOODS SHALL BE 16 GAGE STEEL DUCT (OR LISTED AND LABELED FACTORY-BUILT COMMERCIAL KITCHEN GREASE DUCT) WITH TWO LAYERS OF FIRE WRAP TO PROVIDE ZERO INCH CLEARANCE TO COMBUSTIBLE. DIMENSIONS SHOWN ARE INSIDE CLEAR DIMENSIONS. GREASE DUCT REQUIRES AN ADDITIONAL 6" FROM DIMENSION SHOWN. FIELD VERIFY CLEARANCES PRIOR TO ORDERING. PROVIDE DUCT CLEANOUTS NO MORE THAN 20 FT APART AND NO MORE THAN 10 FT FROM ANY CHANGE IN DIRECTION GREATER THAN 45°. A FIRE RATED CHASE OR FACTORY BUILT UL 1978 APPROVED GREASE DUCT ARE APPROVED SUBSTITUTES TO GREASE DUCT. GREASE DUCT TO SLOPE 1/4" PER FOOT. PRIOR TO CONCEALMENT OF ANY PORTION OF THE GREASE DUCT PERFORM A LEAKAGE TEST AND A LIGHT TEST PER IMC 506.3.2.5. PRIOR TO CONCEALMENT AN INSPECTION OF THE GREASE DUCT WRAP IS REQUIRED WITH A BUILDING DEPARTMENT WITNESS PRESENT. GC TO HIRE NEBB OR AABC CERTIFIED THIRD PARTY TEST AND BALANCE (TAB) CONTRACTOR. TAB CONTRACTOR SHALL ADJUST SHEAVES, BELTS, DAMPERS, ETC AS NECESSARY TO BALANCE SYSTEM TO AIRFLOWS REQUIRED AT LOWEST POSSIBLE SPEEDS. TAB CONTRACTOR SHALL VERIFY THE OUTSIDE AIR AT EACH RTU IS AS SCHEDULED. FOLLOW PROCEDURES AS LAID FORTH IN THE CURRENT VERSION OF "PROCEDURAL STANDARDS FOR TESTING ADJUSTING AND BALANCING OF ENVIRONMENTAL SYSTEMS" BY NEBB. PROVIDE REPORT ON NEBB FORMS TO ENGINEER FOR REVIEW. 	<ol style="list-style-type: none"> THIS CONTRACTOR SHALL ENGAGE A FIRE PROTECTION DESIGN BUILD CONTRACTOR TO MODIFY THE EXISTING FIRE SPRINKLER SYSTEM. DESIGNER SHALL BE NICET LEVEL III TECHNICIAN. WORKING PLANS AND CALCULATIONS SHALL BE PREPARED ACCORDING TO NFPA 13, AND BE APPROVED BY AUTHORITIES HAVING JURISDICTION, INCLUDING HYDRAULIC CALCULATIONS IF APPLICABLE. PROVIDE NEW QUICK RESPONSE FIRE SPRINKLER HEADS IN ALL AREAS OF WORK. SPRINKLER HEADS TO BE ON FLEXIBLE BRAIDED STAINLESS DROPS. SPRINKLER HEAD TO BE CENTER IN HALF OF TILE. COORDINATE EXACT THERMOSTAT LOCATIONS WITH FURNITURE AND OWNER. FAILURE TO DO SO MAY REQUIRE MOVING THERMOSTATS AT CONTRACTORS COST. CONTRACTOR SHALL FIELD VERIFY EXISTING FIELD CONDITIONS PRIOR TO ORDERING OR FABRICATING. ADDITIONAL COST WILL NOT BE ALLOWED FOR CONTRACTORS FAILURE TO BECOME FAMILIAR WITH EXISTING SITE CONDITIONS. PROVIDE FACTORY AUTHORIZED STARTUP OF ALL EQUIPMENT INCLUDING STARTUP OF ANY FACTORY CONTROLS TO ENSURE PROPER SEQUENCING. GENERAL CONTRACTOR SHALL HIRE A 3RD PARTY COMMISSIONING AGENT TO COMMISSION NEW HVAC EQUIPMENT. COMMISSIONING AGENT SHALL BE LICENSED MECHANICAL ENGINEER. COMMISSIONING AGENT TO PROVIDE COMMISSIONING PLAN LISTING EQUIPMENT AND TEST TO BE PERFORMED TO ENGINEER FOR REVIEW. COMMISSIONING AGENT SHALL PROVIDE REPORT STATING ANY SYSTEM DEFICIENCIES AND LISTING ANY DEFERRED TESTS. PROVIDE OPERATION AND MAINTENANCE MANUALS (O&M) WITHIN 30 DAYS OF CERTIFICATE OF OCCUPANCY FOR ALL EQUIPMENT IN DIGITAL FORMAT TO ENGINEER FOR REVIEW. O&M'S SHALL INCLUDE DOCUMENTATION OF ALL WARRANTIES, REPORTS AND TESTS. RECORD DRAWINGS, CONTROLS SEQUENCE OF OPERATIONS WITH DIAGRAMS, & EQUIPMENT INFORMATION. EQUIPMENT INFORMATION INCLUDES MAKE & MODEL, WIRING, PIPING, STARTUP, SHUTDOWN, TROUBLE SHOOTING SYSTEM BALANCING REPORT, FINAL COMMISSIONING REPORT AND MAINTENANCE PROCEDURES. PIPING AND DUCTWORK SHALL NOT BE SUPPORTED FROM THE ROOF DECK, JOIST BRIDGING OR OTHER PIPES. HANG PIPES FROM BEAMS, JOIST OR SUPPLEMENTARY STRUCTURAL MEMBERS, WHERE POSSIBLE INSTALL ALL PIPING AND DUCTWORK WITHIN 12" FROM SUPPORTING STRUCTURE. WHERE JURISDICTION REQUIRES, CONTRACTOR IS RESPONSIBLE FOR PROVIDING SEISMIC RESTRAINT AND SUPPORT ENGINEERED BY A LICENSED STRUCTURAL ENGINEER. PROVIDE DESIGN DRAWINGS TO AUTHORITY HAVING JURISDICTION AND MECHANICAL ENGINEER FOR REVIEW. PROVIDE PROTECTIVE SHIELD PLATES AT THE TOP PLATES AND BOTTOM PLATES, EXTENDING AT LEAST 2" BELOW THE TOP PLATE AND 2" ABOVE THE BOTTOM PLATE FOR ANY DUCT WORK OR PIPING WITHIN 1-1/4" FROM THE FACE OF THE STUD. HVAC DUCTS WITH A DISTRIBUTED WEIGHT GREATER THAN 20LBS/FT, OR THAT HAVE CROSS SECTIONAL AREA 6 SQ FT OR GREATER REQUIRE SEISMIC RESTRAINT. IN ADDITION, DUCT CONVEYING HAZARDOUS MATERIAL, PIPES (OTHER THAN NATURAL GAS, MEDICAL GAS, STEAM OR HIGH PRESSURE HOT WATER PIPING) THAT ARE 3" DIAMETER TRADE SIZE OR GREATER THAT ARE SUSPENDED MORE THAN 12" FROM SUPPORTING STRUCTURE REQUIRE SEISMIC RESTRAINTS. PIPES WITH A DIAMETER OF 3" TRADE SIZE OR GREATER SUSPENDED MORE THAN 12" FROM SUPPORTING STRUCTURE REQUIRE SEISMIC RESTRAINT (ALL OTHER DUCTWORK AND PIPING IS EXEMPT FROM SEISMIC BRACING). CONTRACTOR SHALL BE RESPONSIBLE FOR SEISMICALLY RESTRAINING SUCH DUCTS & PIPES. IN ACCORDANCE WITH THE CONTRACT DOCUMENTS, CONTRACTOR SHALL PROVIDE SHOP DRAWINGS AND PRODUCT DATA BASED ON THE NONSTRUCTURAL SEISMIC BRACING NOTES, DRAWINGS AND DETAILS PROVIDED IN THE CONTRACT DOCUMENTS FOR REVIEW BY SEISMIC BRACING ENGINEER.

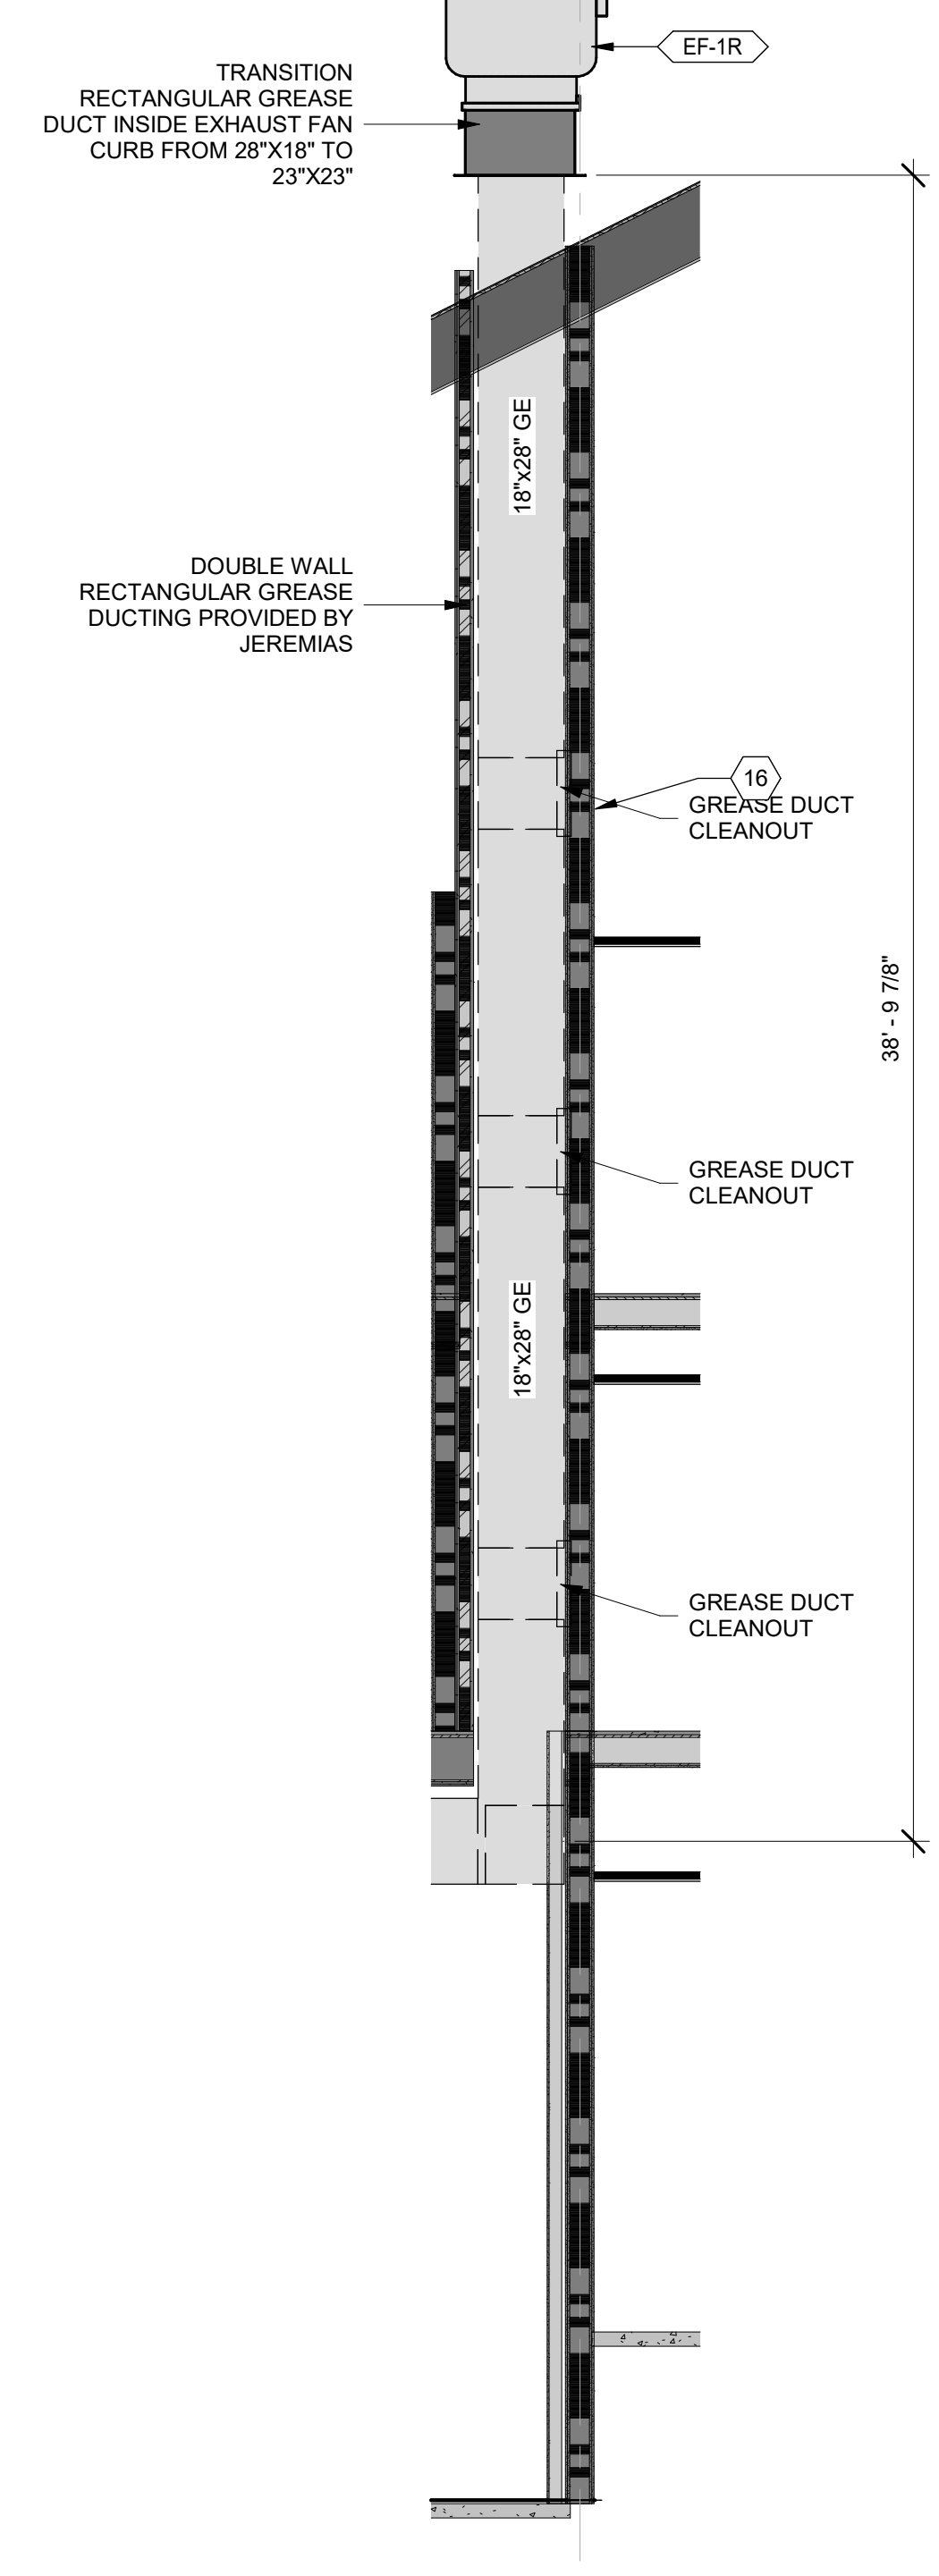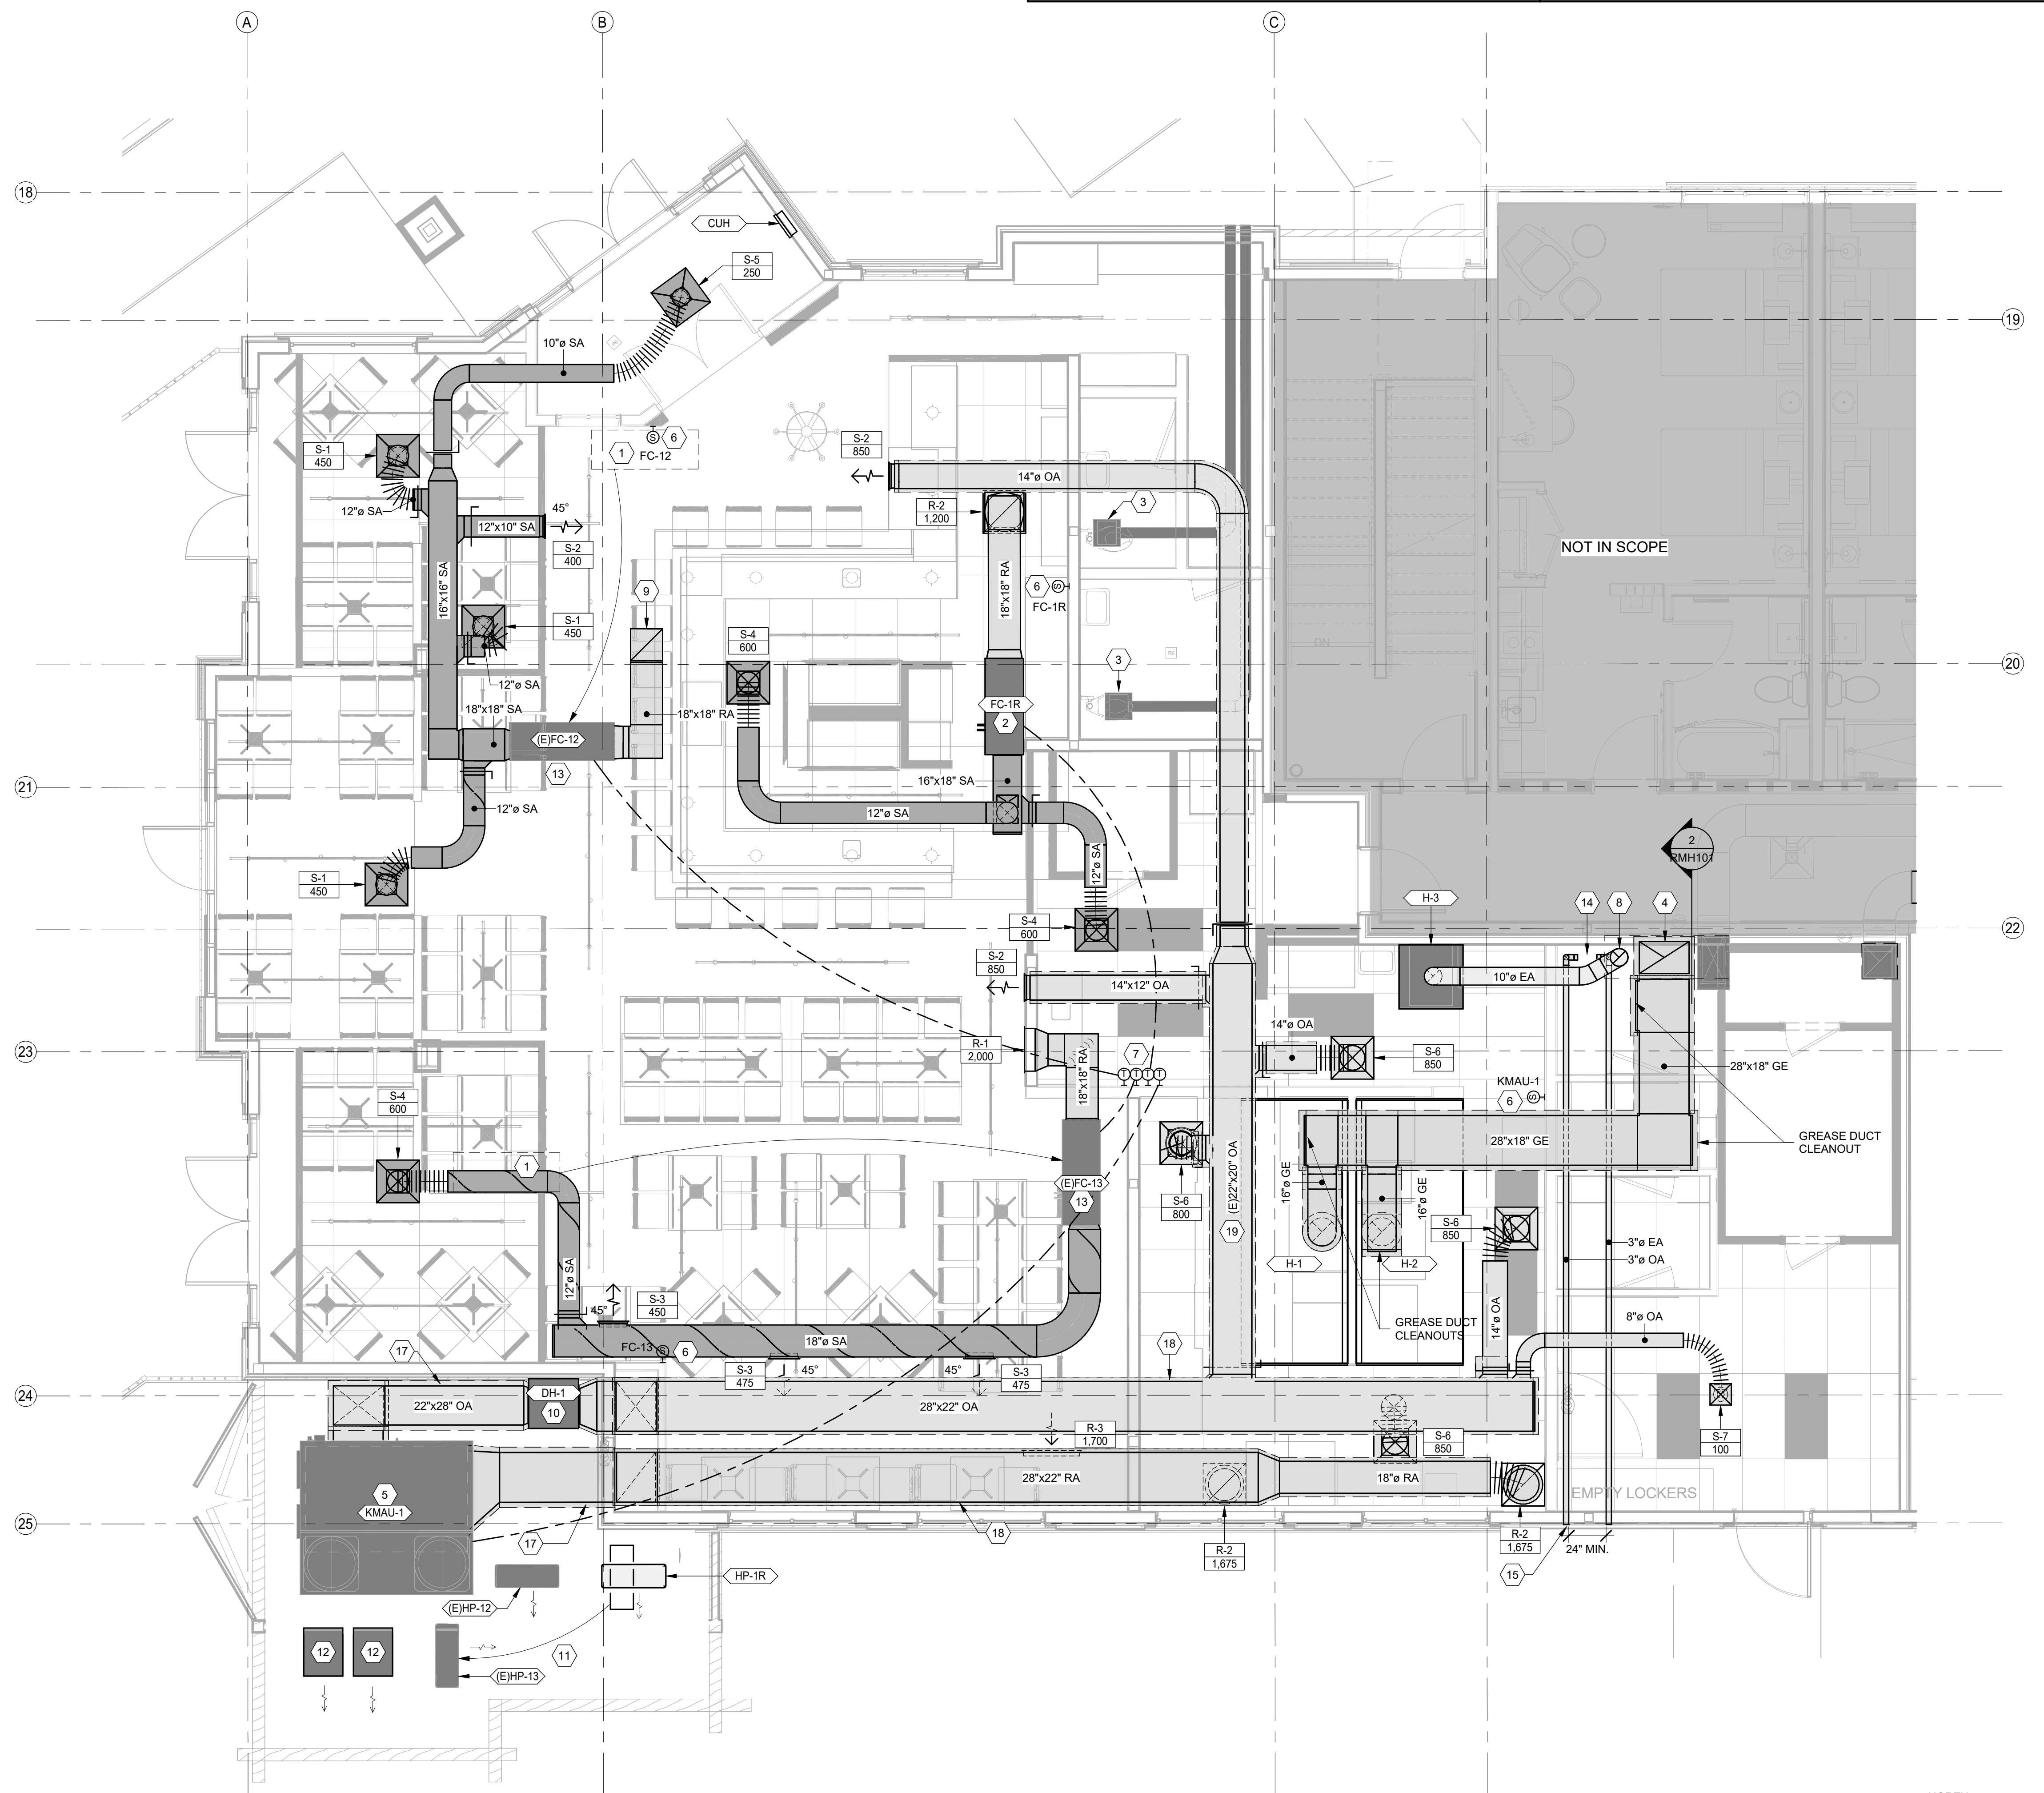

2 GREASE DUCT SHAFT
 SCALE: 1/4" = 1'-0"


1 LEVEL 1 MECHANICAL PLAN
 SCALE: 1/4" = 1'-0"

09/20/24 9:15:45 AM
 Autodesk Docs (2/7) 9145 - Steamboat Springs CO20240327 - Steamboat Springs Restaurant

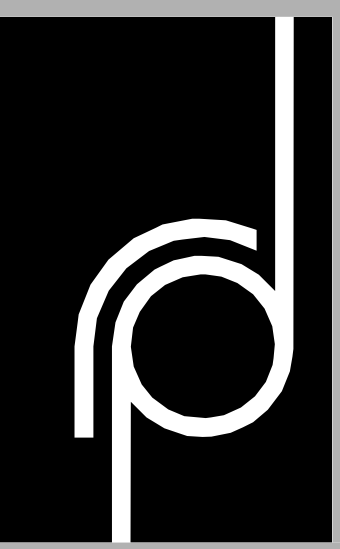

THE RICHARDSON DESIGN PARTNERSHIP, L.L.C.

510 South 600 East
Salt Lake City, Utah 84102
P: 801.355.6886
F: 801.355.6880

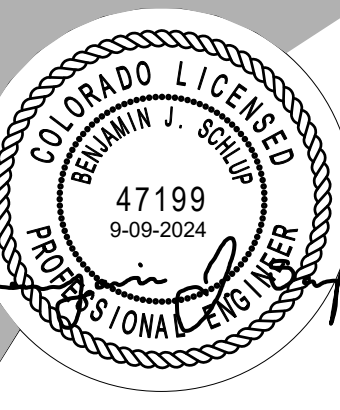

THE MECHANICAL ENGINEER HAS REVIEWED THE MECHANICAL DESIGN AND SPECIFICATIONS FOR THE MECHANICAL SYSTEMS AND HAS DETERMINED THAT THE MECHANICAL SYSTEMS WILL BE INSTALLED AND OPERATED IN ACCORDANCE WITH THE REQUIREMENTS OF THE MECHANICAL CODES AND STANDARDS APPLICABLE TO THE PROJECT.



324 S. State St., Suite 400
Salt Lake City, UT 84111
800-678-7077
801-328-5151
fax: 801-328-5155
www.spectrum-engineers.com

Reviewed for Code Compliance
10/07/2024
CONSULTANT

SERAC CAPITAL PARTNERS, LLC
5051 WESTHEIMER RD. SUITE 1750
HOUSTON, TX 77056

OWNER:

CENTRAL PARK RESTAURANT T.I.
1760 Central Park Dr.
Steamboat Springs, CO

PROJECT:

ISSUE DATE	DESCRIPTION
06/17/2024	
09/10/24	Owner Revisions

REV. DATE DESCRIPTION

09/10/24 Owner Revisions

09/10/24

09/10/24


09/10/24

09/10/24


GENERAL SHEET NOTES

1. MAINTAIN ALL EXHAUSTS AND VENTS A MINIMUM OF 10' FROM ANY FRESH AIR INTAKE.
2. ROOF TOP EQUIPMENT CONDENSATE PIPING SHALL BE ROUTED TO ROOF DRAINS AND TERMINATED WITH AN AIR GAP. SUPPORT PIPING PER SPECS.
3. MECHANICAL CONTRACTOR TO COORDINATE ALL CURBING AND ROOF PENETRATIONS WITH GENERAL CONTRACTOR.
4. THIS CONTRACTOR SHALL CLOSELY COORDINATE MECHANICAL AND PLUMBING WITH ELECTRICAL, ARCHITECTURAL, AND BUILDING STRUCTURE.
5. ALL LOW PRESSURE RECTANGULAR DUCTWORK TO BE LINED WITH INSULATION WITH AN R-VALUE OF R-4. ALL LOW PRESSURE ROUND DUCTWORK TO BE WRAPPED WITH INSULATION WITH AN R-VALUE OF R-6.
6. CONTRACTOR SHALL USE SMACNA DUCT CONSTRUCTION STANDARDS FOR SHEET METAL DUCTS. ALL DUCTWORK UNLESS OTHERWISE NOTED ON FLOOR PLANS SHALL BE CONSTRUCTED OF 15' W.C. SEAL GLASS "X".
7. ALL EXPOSED DUCTWORK TO BE SPIRAL ROUND OR FLAT OVAL WITH CLEAR SILICON DUCT SEALANT. DUCT TO BE FREE OF ANY COATINGS OR FILMS TO ALLOW FOR PAINTING.
8. ALL DUCT DIMENSIONS ARE INSIDE CLEAR DIMENSIONS.
9. FLEXIBLE DUCT MAY BE USED AT FINAL TERMINATION OF DUCT TO DIFFUSER OR GRILLE. MAXIMUM FLEXIBLE DUCT LENGTH IS 5'-0". PROVIDE DUCT SUPPORTS EVERY 3 FEET. FLEX DUCT SHALL NOT BE COMPRESSED OR KINKED BY ANY OBJECTS SUCH AS STRUCTURE, PIPING, ETC.
10. PROVIDE FLEX DUCT ELBOW (FLEX FLOW ELBOW BY THERMAFLEX, FLEX RIGHT ELBOW BY FLEXMASTER, SMART FLOW ELBOW BY HART AND COOLEY, OR EQUAL) AT ALL CEILING MOUNTED DIFFUSER CONNECTIONS. NOT FOR USE WHERE ABOVE CEILING SPACE IS USED AS RETURN PLENUM.
11. GRILLES AND DUCTWORK ARE SIZED INDEPENDENTLY. THE NECK SIZE OF GRILLES MAY NOT MATCH THE ASSOCIATED DUCT SIZE. PROVIDE TRANSITION TO GRILLES AS NECESSARY.
12. PROVIDE BALANCING DAMPER WITH LOCKING QUADRANT IN EACH DUCT BRANCH OF SUPPLY AND EXHAUST DUCTWORK.
13. PROVIDE REMOTE CABLE OPERATED DAMPER SYSTEM FOR ALL DUCTWORK ABOVE HARD LID CEILINGS OR WHERE DAMPER IS INACCESSIBLE OR PROVIDE OPPOSED BLADE DAMPER WITH NYLON BUSHINGS AT GRILLE.
14. PROVIDE ACCESS DOORS FOR ALL SERVICEABLE EQUIPMENT OR VALVES ABOVE HARD LID CEILINGS OR IN WALLS. ALL ACCESS PANELS ARE TO BE PAINTED TO MATCH ADJACENT SURFACES.
15. GREASE DUCT SERVING TYPE I HOODS SHALL BE 16 GAGE STEEL DUCT (OR LISTED AND LABELED FACTORY-BUILT COMMERCIAL KITCHEN GREASE DUCT) WITH TWO LAYERS OF FIRE WRAP TO PROVIDE ZERO INCH CLEARANCE TO COMBUSTIBLE. DIMENSIONS SHOWN ARE INSIDE CLEAR DIMENSIONS. GREASE DUCT REQUIRES AN ADDITIONAL 6" FROM DIMENSION SHOWN. FIELD VERIFY CLEARANCES PRIOR TO ORDERING. PROVIDE DUCT CLEANOUTS NO MORE THAN 20 FT APART AND NO MORE THAN 10 FT FROM ANY CHANGE IN DIRECTION GREATER THAN 45°. A FIRE RATED CHASE OR FACTORY BUILT UL 1878 APPROVED GREASE DUCT ARE APPROVED. SUBSTITUTES TO GREASE DUCT, GREASE DUCT TO SLOPE 1/4" PER FOOT. PRIOR TO CONCEALMENT OF ANY PORTION OF THE GREASE DUCT PERFORM A LEAKAGE TEST AND A LIGHT TEST PER IMC 508.3.2.5 PRIOR TO CONCEALMENT AN INSPECTION OF THE GREASE DUCT WRAP IS REQUIRED WITH A BUILDING DEPARTMENT WITNESS PRESENT.
16. GO TO HIRE NEBB OR ABC CERTIFIED THIRD PARTY TEST AND BALANCE (TAB) CONTRACTOR. TAB CONTRACTOR SHALL ADJUST SHEAVES, BELTS, DAMPERS, ETC AS NECESSARY TO BALANCE SYSTEM TO AIR FLOWS REQUIRED AT LOWEST POSSIBLE SPEEDS. TAB CONTRACTOR SHALL VERIFY THE OUTSIDE AIR AT EACH RTU IS AS SCHEDULED. FOLLOW PROCEDURES AS Laid FORTH IN THE CURRENT VERSION OF "PROCEDURAL STANDARDS FOR TESTING ADJUSTING AND BALANCING OF ENVIRONMENTAL SYSTEMS" BY NEBB. PROVIDE REPORT ON NEBB FORMS TO ENGINEER FOR REVIEW.
17. THIS CONTRACTOR SHALL ENGAGE A FIRE PROTECTION DESIGN BUILD CONTRACTOR TO MODIFY THE EXISTING FIRE SPRINKLER SYSTEM. DESIGNER SHALL BE NICET LEVEL III TECHNICIAN. WORKING PLANS AND CALCULATIONS SHALL BE PREPARED ACCORDING TO NFPA 13, AND BE APPROVED BY AUTHORITIES HAVING JURISDICTION, INCLUDING HYDRAULIC CALCULATIONS IF APPLICABLE.
18. PROVIDE NEW QUICK RESPONSE FIRE SPRINKLER HEADS IN ALL AREAS OF WORK. SPRINKLER HEADS TO BE ON FLEXIBLE BRAIDED STAINLESS DROPS. SPRINKLER HEAD TO BE CENTER IN HALF OF TILE.
19. COORDINATE EXACT THERMOSTAT LOCATIONS WITH FURNITURE AND OWNER. FAILURE TO DO SO MAY REQUIRE MOVING THERMOSTATS AT CONTRACTORS COST.
20. CONTRACTOR SHALL FIELD VERIFY EXISTING FIELD CONDITIONS PRIOR TO ORDERING OR FABRICATING. ADDITIONAL COST WILL NOT BE ALLOWED FOR CONTRACTOR'S FAILURE TO BECOME FAMILIAR WITH EXISTING SITE CONDITIONS.
21. PROVIDE FACTORY AUTHORIZED STARTUP OF ALL EQUIPMENT INCLUDING STARTUP OF ANY FACTORY CONTROLS TO ENSURE PROPER SEQUENCING.
22. GENERAL CONTRACTOR SHALL HIRE A 3RD PARTY COMMISSIONING AGENT TO COMMISSION NEW HVAC EQUIPMENT. COMMISSIONING AGENT SHALL BE LICENSED MECHANICAL ENGINEER, COMMISSIONING AGENT TO PROVIDE COMMISSIONING PLAN LISTING EQUIPMENT AND TEST TO BE PERFORMED TO ENGINEER FOR REVIEW. COMMISSIONING AGENT SHALL PROVIDE REPORT STATING ANY SYSTEM DEFICIENCIES AND LISTING ANY DEFERRED TESTS.
23. PROVIDE OPERATION AND MAINTENANCE MANUALS (OMM) WITHIN 30 DAYS OF CERTIFICATE OF OCCUPANCY FOR ALL EQUIPMENT IN DIGITAL FORMAT TO ENGINEER FOR REVIEW. OMM'S SHALL INCLUDE DOCUMENTATION OF ALL WARRANTIES, REPORTS AND TESTS. RECORD DRAWINGS, CONTROLS SEQUENCE OF OPERATIONS WITH DIAGRAMS, & EQUIPMENT INFORMATION. EQUIPMENT INFORMATION INCLUDES MAKE & MODEL, WIRING, PIPING, STARTUP, SHUTDOWN, TROUBLE SHOOTING SYSTEM BALANCING REPORT, FINAL COMMISSIONING REPORT AND MAINTENANCE PROCEDURES.
24. PIPING AND DUCTWORK SHALL NOT BE SUPPORTED FROM THE ROOF DECK, JOIST BRIDGING OR OTHER PIPES. HANG PIPES FROM BEAMS, JOIST OR SUPPLEMENTARY STRUCTURAL MEMBERS. WHERE POSSIBLE INSTALL ALL PIPING AND DUCTWORK WITHIN 12" FROM SUPPORTING STRUCTURE.
25. WHERE JURISDICTION REQUIRES, CONTRACTOR IS RESPONSIBLE FOR PROVIDING SEISMIC RESTRAINT AND SUPPORT ENGINEERED BY A LICENSED STRUCTURAL ENGINEER. PROVIDE DESIGN DRAWINGS TO AUTHORITY HAVING JURISDICTION AND MECHANICAL ENGINEER FOR REVIEW.
26. PROVIDE PROTECTIVE SHIELD PLATES AT THE TOP PLATES AND BOTTOM PLATES, EXTENDING AT LEAST 2" BELOW THE TOP PLATE AND 2" ABOVE THE BOTTOM PLATE FOR ANY DUCT WORK OR PIPING WITHIN 1-1/4" FROM THE FACE OF THE STUD.

SHEET KEYNOTES

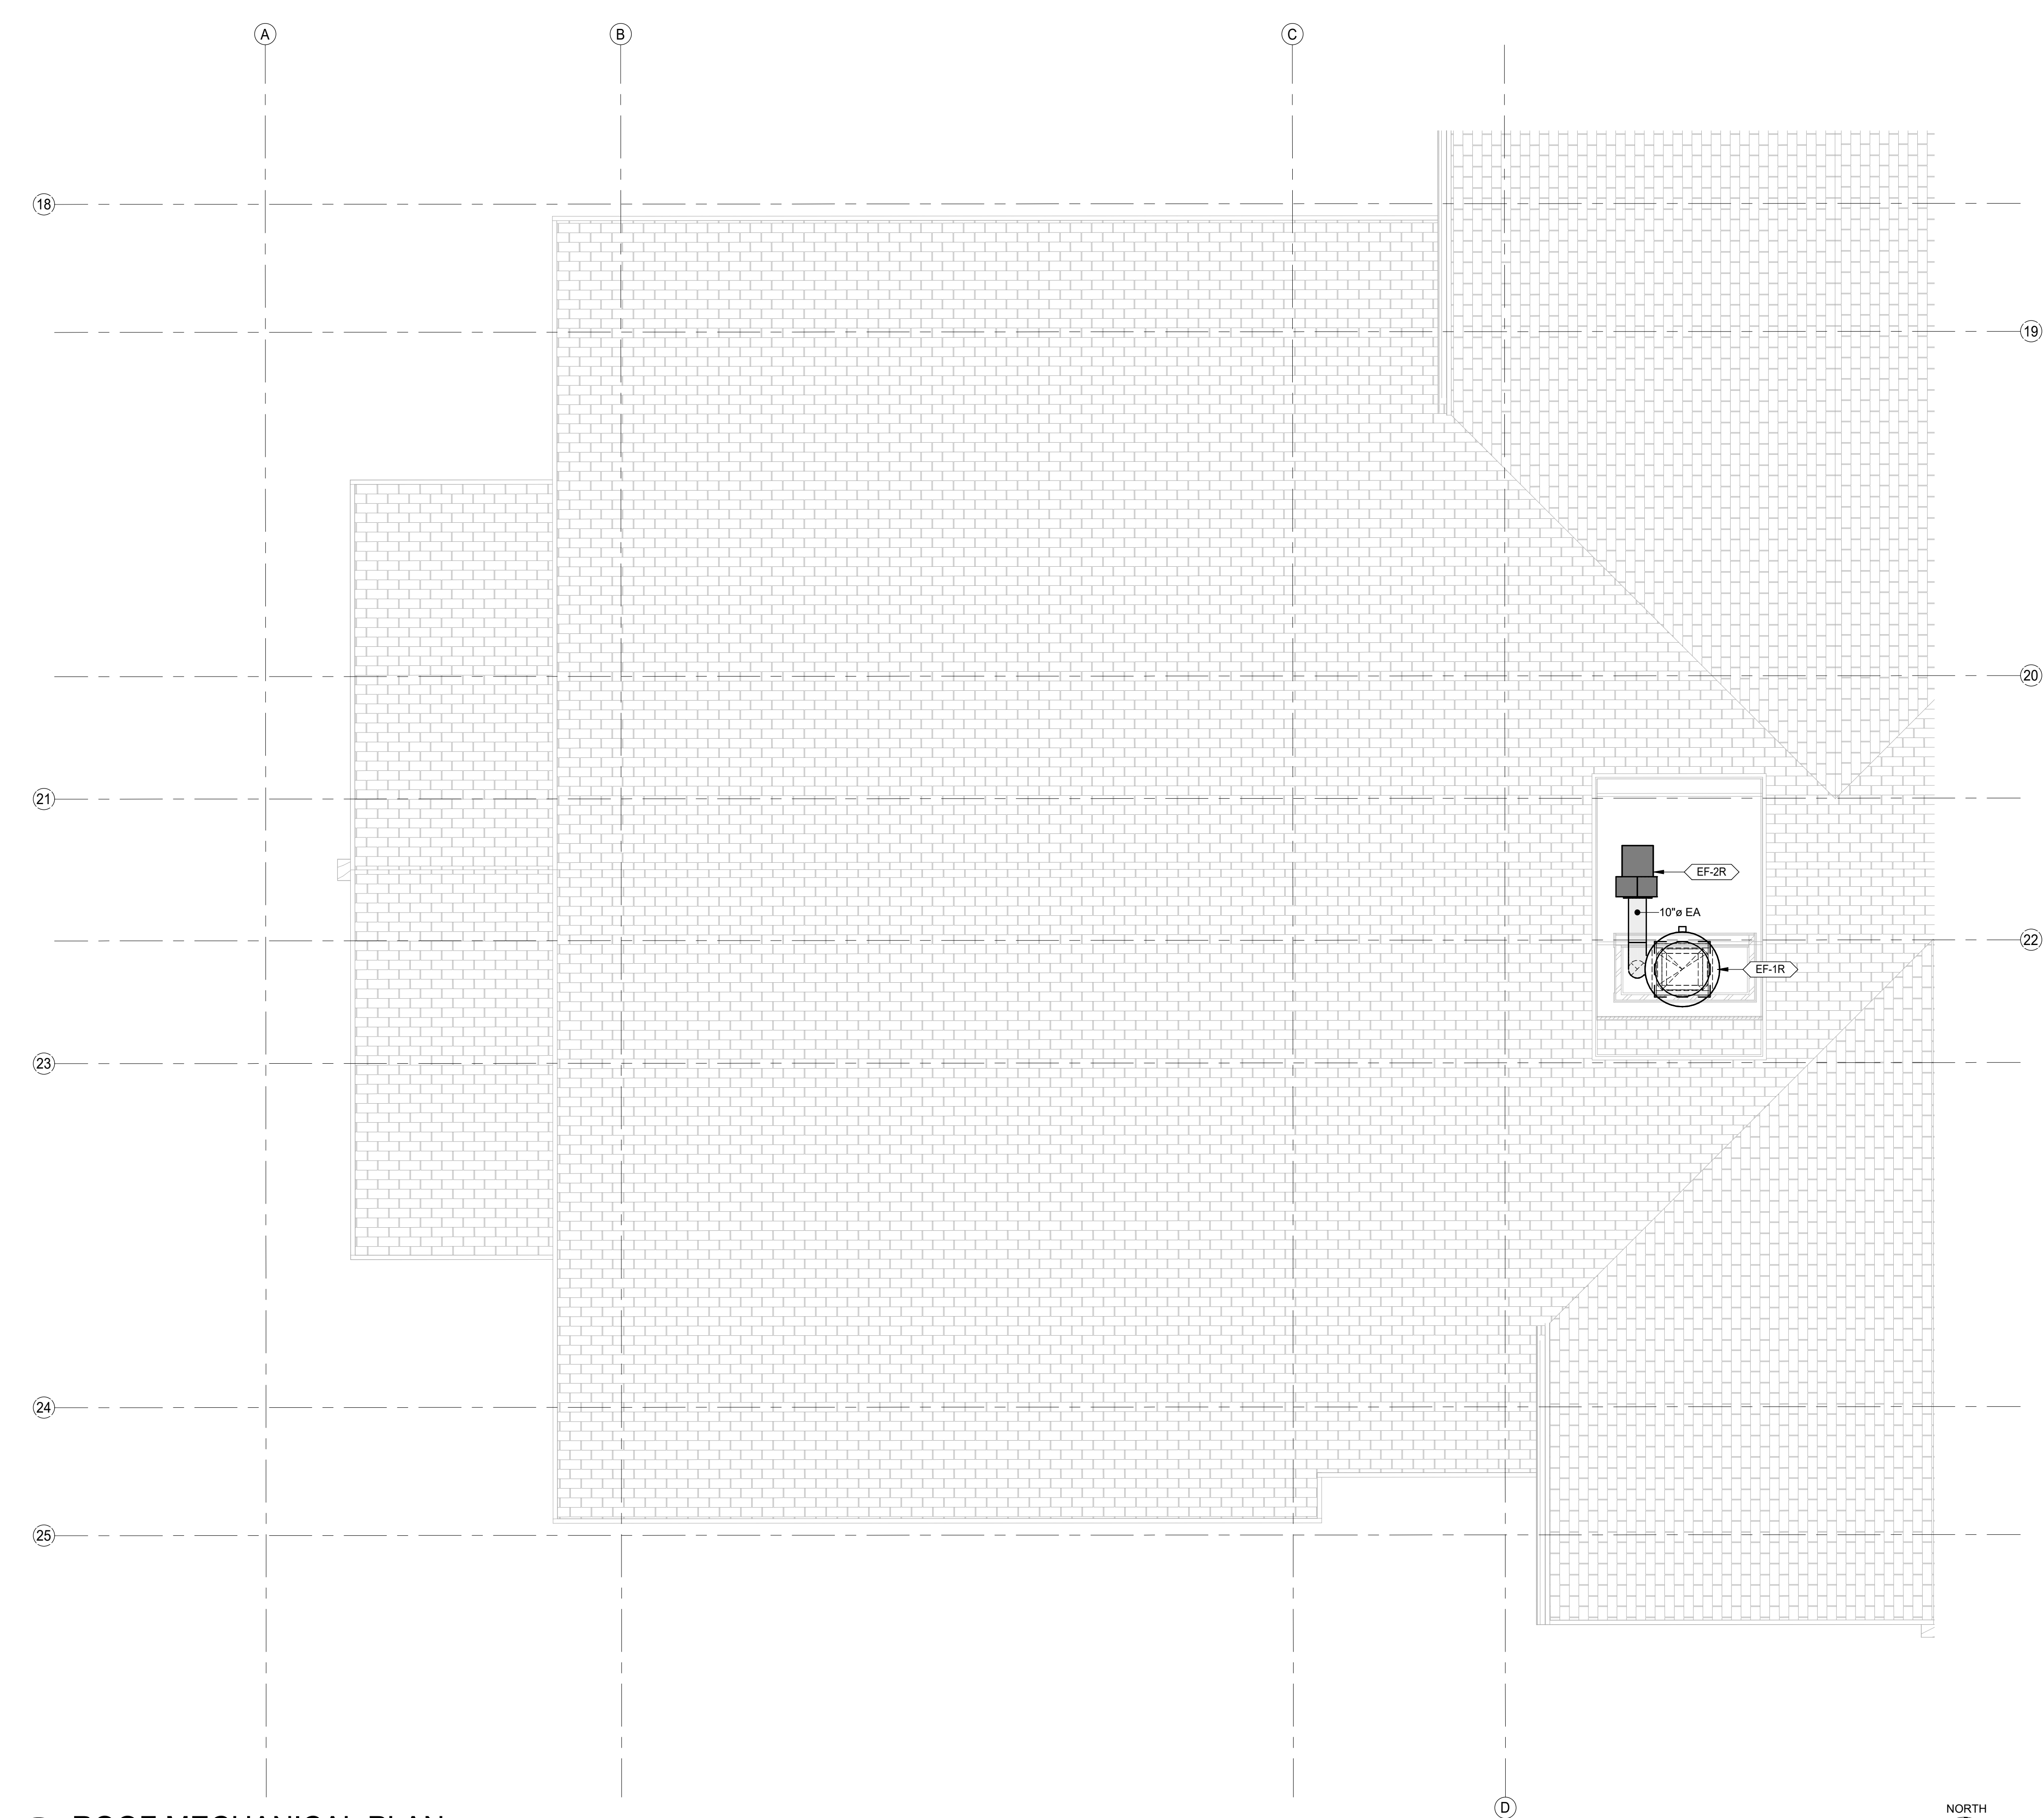

1 ROOF MECHANICAL PLAN
SCALE: 1/4" = 1'-0"

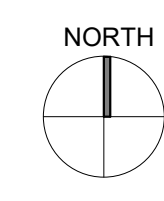

PERMIT SET
ROOF MECHANICAL PLAN
PROJECT #: 2408
DRAWN BY: GBT
CHECKED BY: SSJ
RMH102

SYMBOL LEGEND - MISC	
REFERENCE LINES AND SYMBOLS	
SYMBOL	DESCRIPTION
	VIEW OR DETAIL INDICATOR: # INDICATES DETAIL NUMBER, SHEET INDICATES DRAWING SHEET WHERE VIEW OR DETAIL IS SHOWN.
	ELEVATION OR SECTION INDICATOR: # INDICATES VIEW NUMBER, SHEET INDICATES DRAWING SHEET WHERE VIEW IS SHOWN.
	ROOM / SPACE INDICATOR
	KEYNOTE INDICATOR
	REVISION INDICATOR
	PLUMBING FIXTURE INDICATOR
	EQUIPMENT INDICATOR
	REGISTER, GRILLE, OR DIFFUSER INDICATOR
	BREAKLINE
	MATCHLINE SEE XXXXX
	CONTRACT LIMIT LINE: DASHDOT, WIDE LINE
	NEW CONNECTION TO EXISTING
	POINT OF DEMOLITION

SYMBOL LEGEND - PIPING	
NOTE: ALL ABBREVIATIONS MAY NOT BE USED.	
SYMBOL	DESCRIPTION
	HOSE BIBB / WALL HYDRANT
	CLEANOUT TO GRADE
	FLOOR CLEANOUT
	WALL CLEANOUT
	FLOOR DRAIN
	FLOOR SINK

DEFINITIONS	
NOTE: ALL DEFINITIONS MAY NOT BE USED.	
INDICATED: THE TERM "INDICATED" REFERS TO GRAPHIC REPRESENTATIONS, NOTES, OR SCHEDULES ON THE DRAWINGS, OTHER PARAGRAPHS OR SCHEDULES IN THE SPECIFICATIONS, AND SIMILAR REQUIREMENTS IN THE CONTRACT DOCUMENTS. WHERE TERMS SUCH AS "SHOWN," "NOTED," "SCHEDULED," AND "SPECIFIED" ARE USED, IT IS TO HELP THE READER LOCATE THE REFERENCE. NO LIMITATION ON LOCATION IS INTENDED.	
DIRECTED: TERMS SUCH AS "DIRECTED", "REQUESTED", "AUTHORIZED", "SELECTED", "APPROVED", "REQUIRED", AND "PERMITTED" MEAN "DIRECTED BY THE ENGINEER," "REQUESTED BY THE ENGINEER," AND SIMILAR PHRASES.	
APPROVED: THE TERM "APPROVED", WHERE USED IN CONJUNCTION WITH THE ENGINEER'S ACTION ON THE CONTRACTOR'S SUBMITTALS, APPLICATIONS, AND REQUESTS, IS LIMITED TO THE ENGINEER'S DUTIES AND RESPONSIBILITIES AS STATED IN GENERAL AND SUPPLEMENTARY CONDITIONS.	
FURNISH: THE TERM "FURNISH" IS USED TO MEAN "SUPPLY AND DELIVER TO THE PROJECT SITE, READY FOR UNLOADING, UNPACKING, ASSEMBLY, INSTALLATION, AND SIMILAR OPERATIONS."	
INSTALL: THE TERM "INSTALL" IS USED TO DESCRIBE OPERATIONS AT PROJECT SITE INCLUDING THE ACTUAL "UNLOADING, UNPACKING, ASSEMBLY, ERECTION, PLACING, ANCHORING, APPLYING, WORKING TO DIMENSION, FINISHING, CURING, PROTECTING, CLEANING, AND SIMILAR OPERATIONS."	
PROVIDE: THE TERM "PROVIDE" MEANS "TO FURNISH AND INSTALL, COMPLETE AND READY FOR THE INTENDED USE."	
INSTALLER: AN "INSTALLER" IS THE CONTRACTOR OR AN ENTITY ENGAGED BY THE CONTRACTOR, EITHER AS AN EMPLOYEE, SUBCONTRACTOR, OR SUB-SUBCONTRACTOR, FOR PERFORMANCE OF A PARTICULAR CONSTRUCTION ACTIVITY, INCLUDING INSTALLATION, ERECTION, APPLICATION, AND SIMILAR OPERATIONS. INSTALLERS ARE REQUIRED TO BE EXPERIENCED IN THE OPERATIONS THEY ARE ENGAGED TO PERFORM.	


PIPING LEGEND	
NOTE: ALL ABBREVIATIONS MAY NOT BE USED.	
ABBREVIATION	DESCRIPTION
—160—	160°F HOT WATER
-----160R-----	160°F HOT WATER RETURN / CIRCULATION
---CWV---	COMBINATION WASTE AND VENT
---CD---	CONDENSATE DRAIN
---DCW---	DOMESTIC COLD WATER
---DHWR---	DOMESTIC HOT WATER RECIRCULATION
---DI---	DEIONIZED WATER
---DSW---	DOMESTIC SOFT WATER
---FP---	FIRE PROTECTION
---FW---	FILTERED WATER
---GW---	GREASE WASTE
---IF---	INHIBITOR FILTERED WATER
---IW---	IRRIGATION WATER
---LPG---	LIQUID PROPANE GAS
---NG---	NATURAL GAS
---RW---	RAINWATER / STORM DRAIN
---SCW---	DOMESTIC SOFT COLD WATER
---SHW---	DOMESTIC SOFT HOT WATER
---SRW---	SECONDARY RAINWATER / STORM DRAIN
---SS---	SANITARY SEWER
---V---	VENT

SYMBOL LEGEND - PIPING	
NOTE: ALL ABBREVIATIONS MAY NOT BE USED.	
SYMBOL	DESCRIPTION
	SHUT OFF VALVE
	GATE VALVE
	CHECK VALVE
	AUTOMATIC 2-WAY VALVE
	AUTOMATIC 3-WAY VALVE
	GLOBE VALVE
	BALL VALVE
	RELIEF VALVE
	PRESSURE REDUCING VALVE
	SOLENOID VALVE
	BALANCING OR PLUG COCK
	FLOW SETTER
	EXPANSION VALVE
	GAS COCK
	MANUAL AIR VENT
	STRAINER
	GAUGE COCK
	PRESSURE GAUGE
	THERMOMETER
	90 DEGREE ELBOW UP
	90 DEGREE ELBOW DOWN
	90 DEGREE TEE UP
	90 DEGREE TEE DOWN
	PIPE UNION
	PIPE CAP
	PIPE ANCHOR

ABBREVIATIONS	
NOTE: ALL ABBREVIATIONS MAY NOT BE USED.	
(E)	EXISTING
(F)	FUTURE
AC	AIR CONDITION-(ING,-ED)
APD	AIR PRESSURE DROP
BD	BALANCING DAMPER
BHP	BRAKE HORSE POWER
BTU	BRITISH THERMAL UNIT
BTUH	BTU/HOUR
CFH	CUBIC FEET PER HOUR
CFM	CUBIC FEET PER MINUTE
CV	CONTROL VALVE
DB	DRY BULB TEMPERATURE
DCW	DOMESTIC COLD WATER
DHW	DOMESTIC HOT WATER
DHWR	DOMESTIC HOT WATER RECIRC
DP	DEPTH, DEEP, OR DROP IN PRESSURE
EA	EXHAUST AIR
EER	ENERGY EFFICIENCY RATIO
EFF	EFFICIENCY
ELEC	ELECTRIC
ELEV	ELEVATION
ENT	ENTERING
EVAP	EVAPORATE-(E,-ING,-ED,-OR)
EXT	ENTERING WATER TEMPERATURE
EXT	EXTERNAL
FD	FIRE DAMPER
FLA	FULL LOAD AMPS
FFI	FINS PER INCH
FFM	FEET PER MINUTE
FPS	FEET PER SECOND
FSD	FIRE SMOKE DAMPER
GE	GREASE EXHAUST
GPH	GALLONS PER HOUR
GPM	GALLONS PER MINUTE
HD	HEAD
HG	MERCURY
HP	HORSEPOWER
HR	HOUR
HTG	HEATING
HZ	HERTZ (FREQUENCY)
IN	INCH
IN	KILOWATT
KW	LEAVING AIR TEMPERATURE
LAT	POUNDS
LBS	POUNDS
LH	LATENT HEAT
LRA	LOCKED ROTOR AMPS
LVG	LEAVING
LWT	LEAVING WATER TEMPERATURE
MBH	THOUSAND BTU PER HOUR
MCA	MINIMUM CIRCUIT AMPS
MFR	MANUFACTURER-(ER,-ED)
NC	NORMALLY CLOSED OR NOISE CRITERIA
NIC	NOT IN CONTRACT
NO	NORMALLY OPEN
NPSH	NET POSITIVE SUCTION HEAD
NTS	NOT TO SCALE
OA	OUTSIDE AIR
OD	OUTSIDE DIAMETER
OZ	OUNCE
PD	PRESSURE DROP OR DIFFERENCE
PG	PROPYLENE GLYCOL
PH	PHASE
PPM	PARTS PER MILLION
PSF	POUNDS PER SQUARE FOOT
PSI	POUNDS PER SQUARE INCH
PSIA	PSI ABSOLUTE
PSIG	PSI GAUGE
RA	RETURN AIR
RECIRC	RECIRCULATE -(ER,-ED,-ING)
REFR	REFRIGERATION
REQD	REQUIRED
RLA	RATED LOAD AMPS
RPM	REVOLUTIONS PER MINUTE
SA	SUPPLY AIR
SCFM	STANDARD CUBIC FEET PER MINUTE
SCW	SOFT COLD WATER
SH	SENSIBLE HEAT
SP	STATIC PRESSURE
SPEC(S)	SPECIFICATION(S)
SQ	SQUARE
SS	SANITARY SEWER, SOIL, WASTE
STD	STANDARD
TA	TRANSFER AIR
TD	TEMP. DROP OR DIFF.
TEMP	TEMPERATURE
TOT	TOTAL
TSTAT	THERMOSTAT
TYP	TYPICAL
V	VOLT, VOLTAGE OR VENT
VAC	VACUUM
VAV	VARIABLE AIR VOLUME
VEL	VELOCITY
VENT	VENT, VENTILATION
VERT	VERTICAL
VFD	VARIABLE FREQUENCY DRIVE
VOL	VOLUME
VTR	VENT THROUGH ROOF
WB	WET BULB TEMP
WC	WATER COLUMN
WG	WATER GAUGE
WPD	WATER PRESSURE DROP
WTR	WATER

- ### PLUMBING GENERAL NOTES
- THE PLUMBING DRAWINGS SHOW THE GENERAL DESIGN, ARRANGEMENT AND EXTENT OF THE PLUMBING SYSTEM. BECAUSE OF THE SMALL SCALE OF THE DRAWINGS, THESE DRAWINGS DO NOT SHOW OFFSETS, BENDS OR ELBOWS NECESSARY FOR THE COMPLETE INSTALLATION IN THE SPACE PROVIDED. CONTRACTOR SHALL MAKE SUCH SLIGHT ALTERATIONS AS MAY BE NECESSARY TO MAKE THE SYSTEM COMPLETE AND OPERATIONAL IN ACCORDANCE WITH THE DESIGN INTENT. MAJOR DEVIATIONS SUCH AS CHANGES IN COMPONENT SIZES, WEIGHTS, QUANTITIES OR MATERIAL REQUIRE PRIOR APPROVAL BY THE DESIGN ENGINEER.
 - THE DRAWINGS AND SPECIFICATIONS HAVE BEEN PREPARED TO SUPPLEMENT EACH OTHER AND SHALL BE INTERPRETED AS AN INTEGRAL UNIT WITH THE ITEMS SHOWN ON ONE AND NOT THE OTHER BEING FURNISHED AND INSTALLED AS THOUGH SHOWN AND CALLED OUT IN BOTH.
 - THE ENTIRE PLUMBING INSTALLATION SHALL CONFORM TO THE REQUIREMENTS OF THE MOST RECENTLY ADOPTED BUILDING CODES, MECHANICAL CODE, PLUMBING CODE, ELECTRICAL CODE, AND ALL OTHER APPLICABLE CITY, COUNTY, STATE, AND FEDERAL CODES AND REGULATIONS IN EFFECT.
 - THE ENTIRE PLUMBING INSTALLATION SHALL CONFORM TO ANY CODES, RULES, REGULATIONS AND REQUIREMENTS OF THE BUILDING OWNER.
 - PRIOR TO FABRICATING AND INSTALLATION OF ANY PLUMBING COMPONENT THE CONTRACTOR SHALL COORDINATE THE INSTALLATION OF ALL PLUMBING WORK WITH ALL OTHER BUILDING TRADES, INCLUDING BUILDING TRADES HIRED DIRECTLY BY THE OWNER. WHERE CONFLICTS MAY OCCUR, THEY SHALL BE RESOLVED PRIOR TO INSTALLATION.
 - ALL PLUMBING INFORMATION IS NOT SHOWN ON THE PLUMBING DRAWINGS. THE CONTRACTOR SHALL BE RESPONSIBLE FOR COORDINATING ALL INFORMATION ON ALL OTHER CONSTRUCTION DOCUMENTS.
 - THE CONTRACTOR SHALL BE RESPONSIBLE TO REVIEW AND USE, WHERE APPROPRIATE, ALL THE PLUMBING DETAILS SHOWN ON THE DRAWINGS. DETAILS MAY OR MAY NOT BE CALLED OUT ON THE DRAWINGS WITH SYMBOLS OR KEYED NOTES. ANY CHANGES RESULTING FROM FAILURE TO INSTALL THE PLUMBING SYSTEM WITHOUT USING THE INCLUDED DETAILS SHALL BE THE RESPONSIBILITY OF THE CONTRACTOR.
 - ANY PART OF THE PLUMBING INSTALLATION THAT FAILS, IS UNFIT, OR BECOMES DAMAGED DURING CONSTRUCTION SHALL BE REPAIRED OR REPLACED BY THE CONTRACTOR AT NO ADDITIONAL COST TO THE OWNER.
 - PROVIDE PROPER PROVISIONS FOR EXPANSION, CONTRACTION, OR MOVEMENT OF ALL PIPING.
 - PROVIDE LARGE ENOUGH PIPE SLEEVES THROUGH WALL OR FLOOR TO ALLOW FOR ANTICIPATED DIFFERENTIAL MOVEMENT.
 - ALL PIPING SHALL BE SUPPORT WITH CLEVIS HANGERS (MSS TYPE 1) PERFORATED METAL STRAPS OR PLASTIC STRAPPING (PLUMBER TAPE) SHALL NOT BE USED TO SUPPORT OR BRACE ANY PIPE.
 - PROVIDE PIPE HANGERS WITHIN 16 INCHES OF ALL CHANGES OF DIRECTION.
 - PROVIDE SWAY BRACING FOR ALL PIPING 4" AND LARGER AT ALL CHANGES IN DIRECTION GREATER THAN 45 DEGREES.
 - ALL STEEL CLEVIS HANGERS USED TO SUPPORT COPPER PIPING SHALL BE COPPER OR PLASTIC COATED.
 - COPPER PIPING SHALL NOT COME IN CONTACT WITH FIRE TREATED LUMBER. PROVIDE 1/2" THICK SLIP-ON CLOSED CELL INSULATION WHERE COPPER PIPING IS ADJACENT TO FIRE TREATED LUMBER. CLOSED CELL INSULATION SHALL EXTEND A MINIMUM OF 1-1/2" PAST LUMBER.
 - ALL EXPOSED PIPING SHALL BE INSTALLED IN A NEATLY ARRANGED MANNER PARALLEL TO THE BUILDING STRUCTURE.
 - ALL EXPOSED DOMESTIC WATER PIPE IN OCCUPIED SPACES SHALL BE POLISHED CHROME PLATED OR COPPER.
 - ALL EXPOSED DRAINAGE PIPING IN OCCUPIED SPACES INCLUDING TRAPS UNDER SINKS SHALL BE POLISHED CHROME PLATED.
 - DRAWINGS SHOW GENERAL ARRANGEMENT OF THE DRAIN WASTE AND VENT SYSTEM WITH THE REQUIRED CLEANOUTS. CONTRACTOR SHALL PROVIDE ALL ADDITIONAL CLEANOUTS AS REQUIRED BY THE PLUMBING CODE.
 - ALL SANITARY DRAINAGE SYSTEM PIPING 3" AND LARGER SHALL BE SLOPED IN DIRECTION OF FLOW AT A MINIMUM OF 1/8" PER FOOT.
 - ALL SANITARY DRAINAGE SYSTEM PIPING SMALLER THAN 3" SHALL BE SLOPED IN DIRECTION OF FLOW AT A MINIMUM OF 1/4" PER FOOT.
 - SLOPE VENT SYSTEM TOWARDS DRAINAGE SYSTEM.
 - SIMILAR EQUIPMENT SHALL BE OF THE SAME MANUFACTURER.
 - ALL EQUIPMENT SHALL PROVIDE THE SCHEDULED PERFORMANCE AT THE JOB SITE ELEVATION.
 - FIXTURE AND EQUIPMENT MODEL NUMBERS SHOWN IN PLUMBING FIXTURE SCHEDULE AND PLUMBING EQUIPMENT SCHEDULE ARE SHOWN TO ESTABLISH THE TYPE OF PRODUCT THAT SHALL BE USED. THE SELECTED PRODUCT SHALL MEET THE SCHEDULED PERFORMANCE DATA SHOWN ON THE SCHEDULE EVEN IF A DIFFERENT MODEL IS SUPPLIED THAT IS DIFFERENT THAN THAT SCHEDULED.
 - ALL EQUIPMENT SHALL BE INSTALLED IN STRICT ACCORDANCE WITH THE EQUIPMENT MANUFACTURER'S INSTALLATION INSTRUCTIONS. PROVIDE ALL NECESSARY FITTINGS, TRANSITIONS, VALVES AND OTHER DEVICES AND ACCESSORIES REQUIRED FOR A COMPLETE, WORKABLE INSTALLATION.
 - SEE "PLUMBING FIXTURE SCHEDULE" FOR INDIVIDUAL TRAPS, WASTE, VENT, AND DOMESTIC WATER PIPING FOR INDIVIDUAL FIXTURES.
 - ALL PLUMBING EQUIPMENT SHALL BE LISTED AND LABELED BY AN APPROVED TESTING AGENCY.
 - FIXTURES, EQUIPMENT AND PIPING INSTALLATION SHALL MEET NSF STANDARDS.

PLUMBING SHEET INDEX	
RPE001	PLUMBING COVER SHEET
RPE001	PLUMBING DETAILS
RPE002	PLUMBING DETAILS
RPE003	GREASE INTERCEPTOR DETAILS
RPE001	PLUMBING SCHEDULES
RPL101	LEVEL 1 PLUMBING PLAN - DWV
RPL102	LEVEL 1 PLUMBING PLAN - WATER
RPL103	LEVEL 1 PLUMBING PLAN - GAS
RPL104	ROOF PLUMBING PLAN

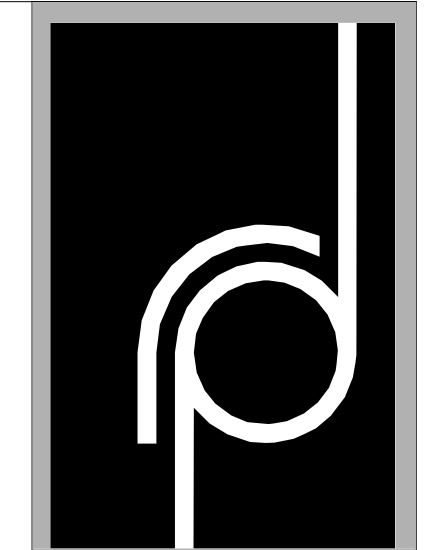

THE RICHARDSON DESIGN PARTNERSHIP, L.L.C.
 510 South 600 East
 Salt Lake City, Utah 84112
 P: 801.355.6886
 F: 801.355.6880

PROFESSIONAL ENGINEER
 4719
 9-09-2024

SPECTRUM ENGINEERS
 324 S. State St., Suite 400
 Salt Lake City, UT 84111
 800-678-7077
 801-328-5151
 fax: 801-328-5155
 www.spectrum-engineers.com

Reviewed for Code Compliance
 10/07/2024
 CONSULTANT

SERAC CAPITAL PARTNERS, LLC
 5051 WESTHEIMER RD. SUITE 1750
 HOUSTON, TX 77056

OWNER:

CENTRAL PARK RESTAURANT T.I.
 1760 Central Park Dr.
 Steamboat Springs, CO

PROJECT:


ISSUE DATE	DESCRIPTION
06/17/2024	
REV. DATE	DESCRIPTION
09/10/24	Owner Revisions

PERMIT SET


PLUMBING COVER SHEET

PROJECT #: 2408
 DRAWN BY: GBT
 SHEET #
 CHECKED BY: SSJ

RPE001

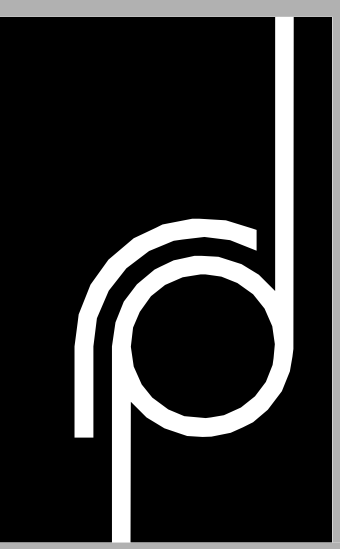

THE RICHARDSON DESIGN PARTNERSHIP, L.L.C.
 510 South 600 East
 Salt Lake City, Utah 84102
 P: 801.355.6886
 F: 801.355.6880

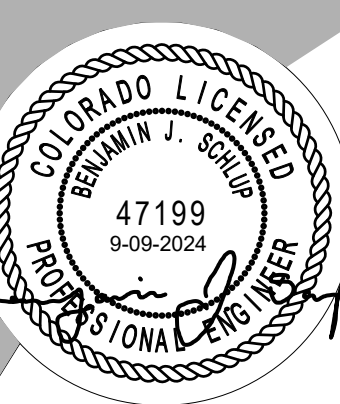

SPECTRUM ENGINEERS
 324 S. State St., Suite 400
 Salt Lake City, UT 84111
 800-878-7077
 801-328-5151
 fax: 801-328-5155
 www.spectrum-engineers.com


Reviewed for Code Compliance
 10/07/2024

SERAC CAPITAL PARTNERS, LLC
 5051 WESTHEIMER RD., SUITE 1750
 HOUSTON, TX 77056


CENTRAL PARK RESTAURANT T.I.
 1760 Central Park Dr.
 Steamboat Springs, CO

ISSUE DATE	DESCRIPTION
09/17/2024	
09/10/24	Owner Revisions


PERMIT SET
PLUMBING DETAILS
 PROJECT #: 2024
 DRAWN BY: GRT
 SHEET #
RPE501
 CHECKED BY: SSJ

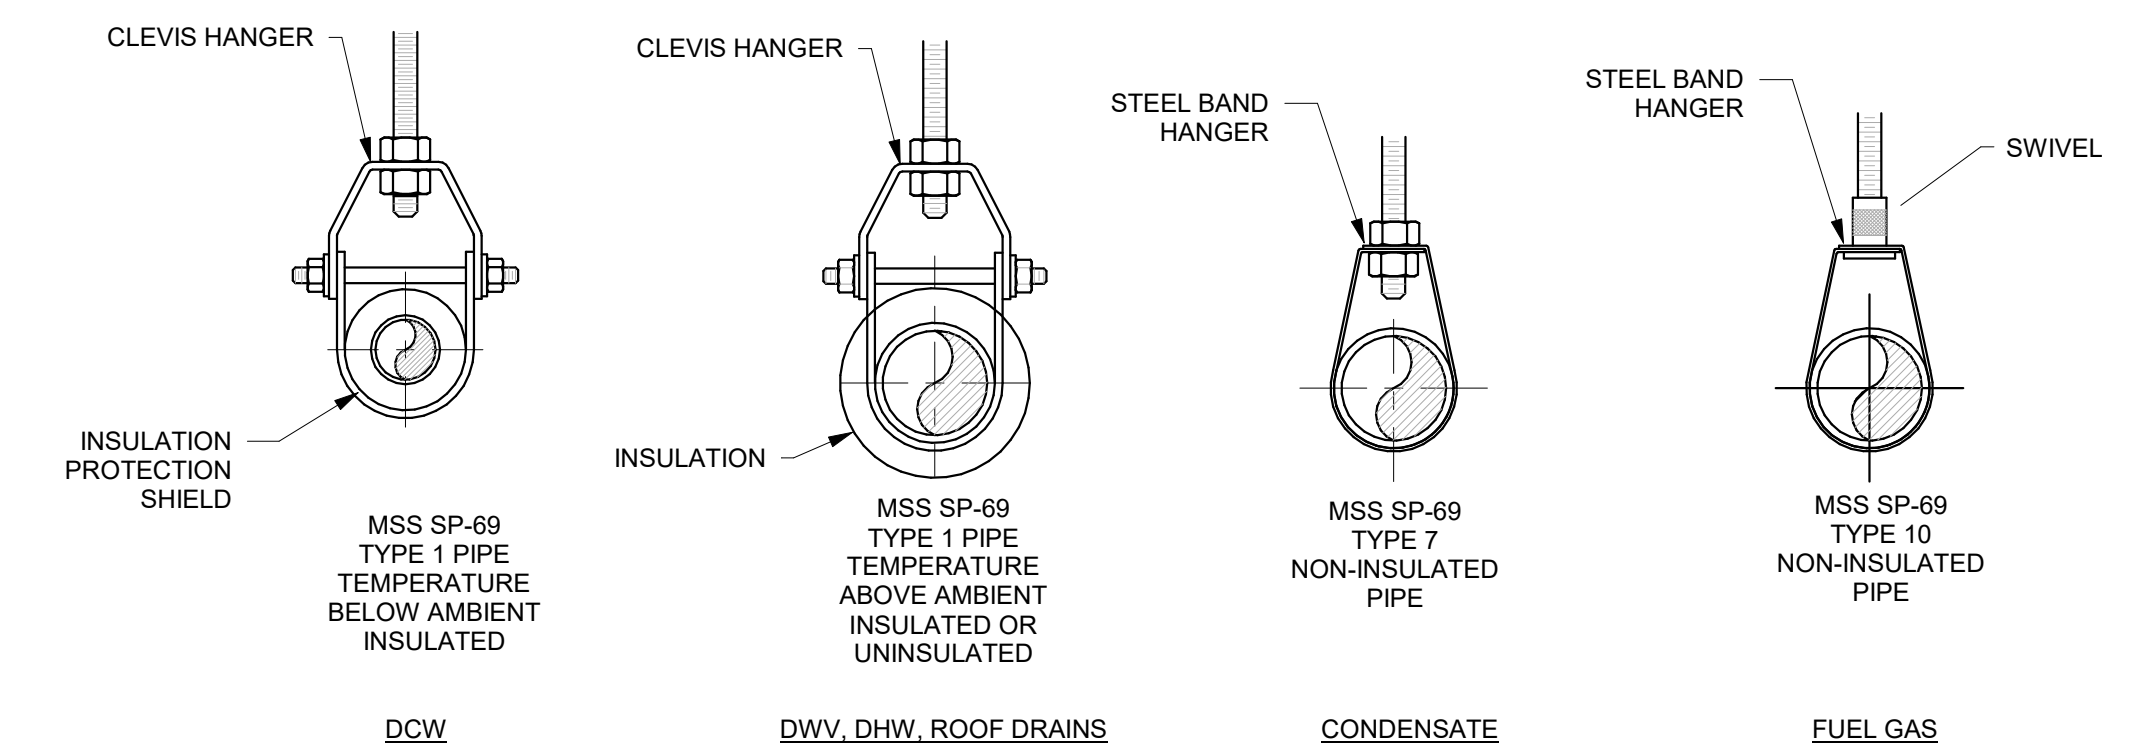


4 PIPE HANGERS
 SCALE: NTS

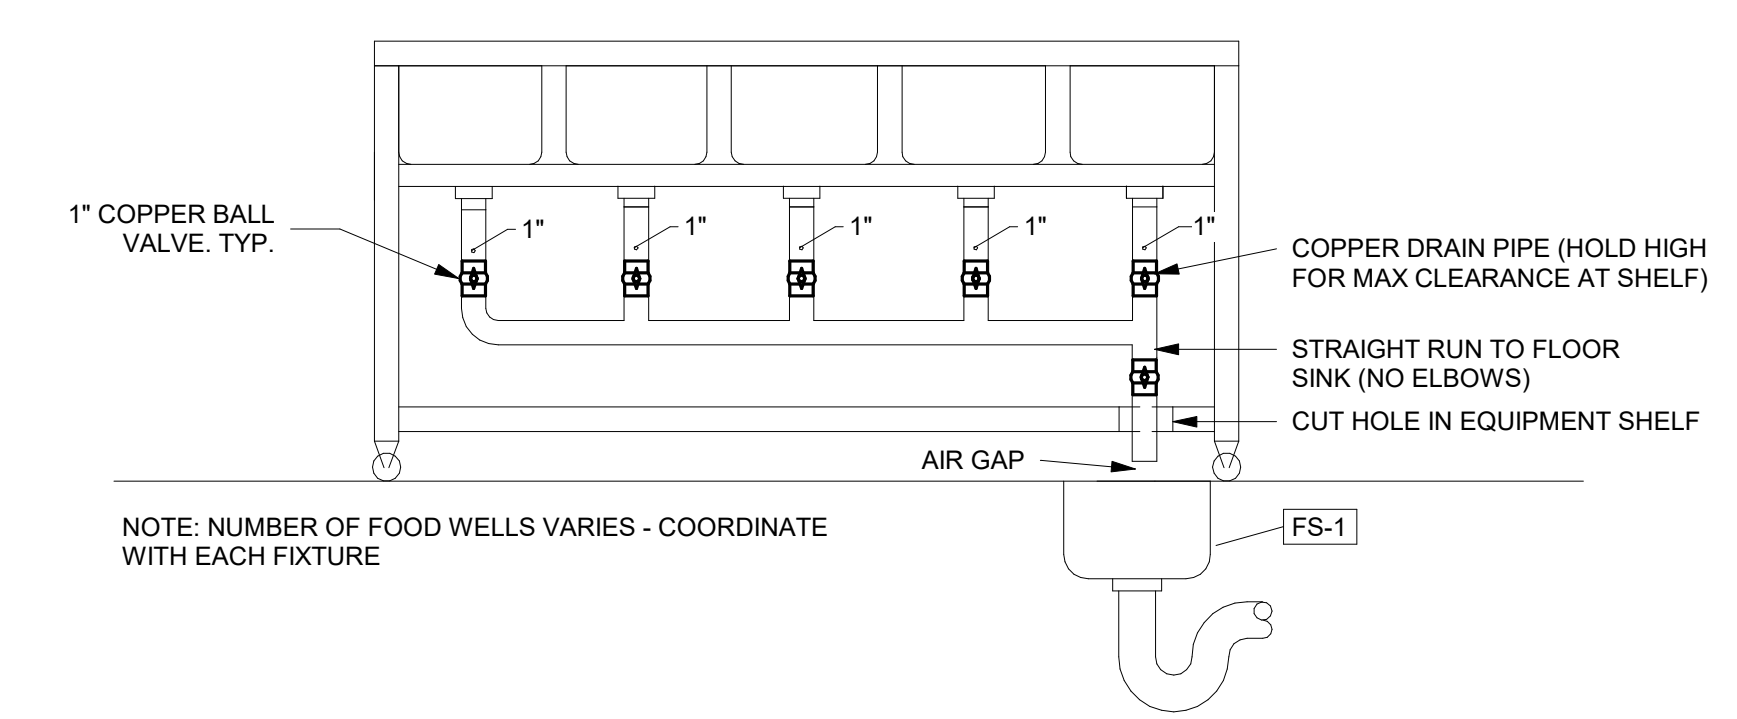


3 HOT FOOD WELL WASTE PIPING DETAIL
 SCALE: NTS

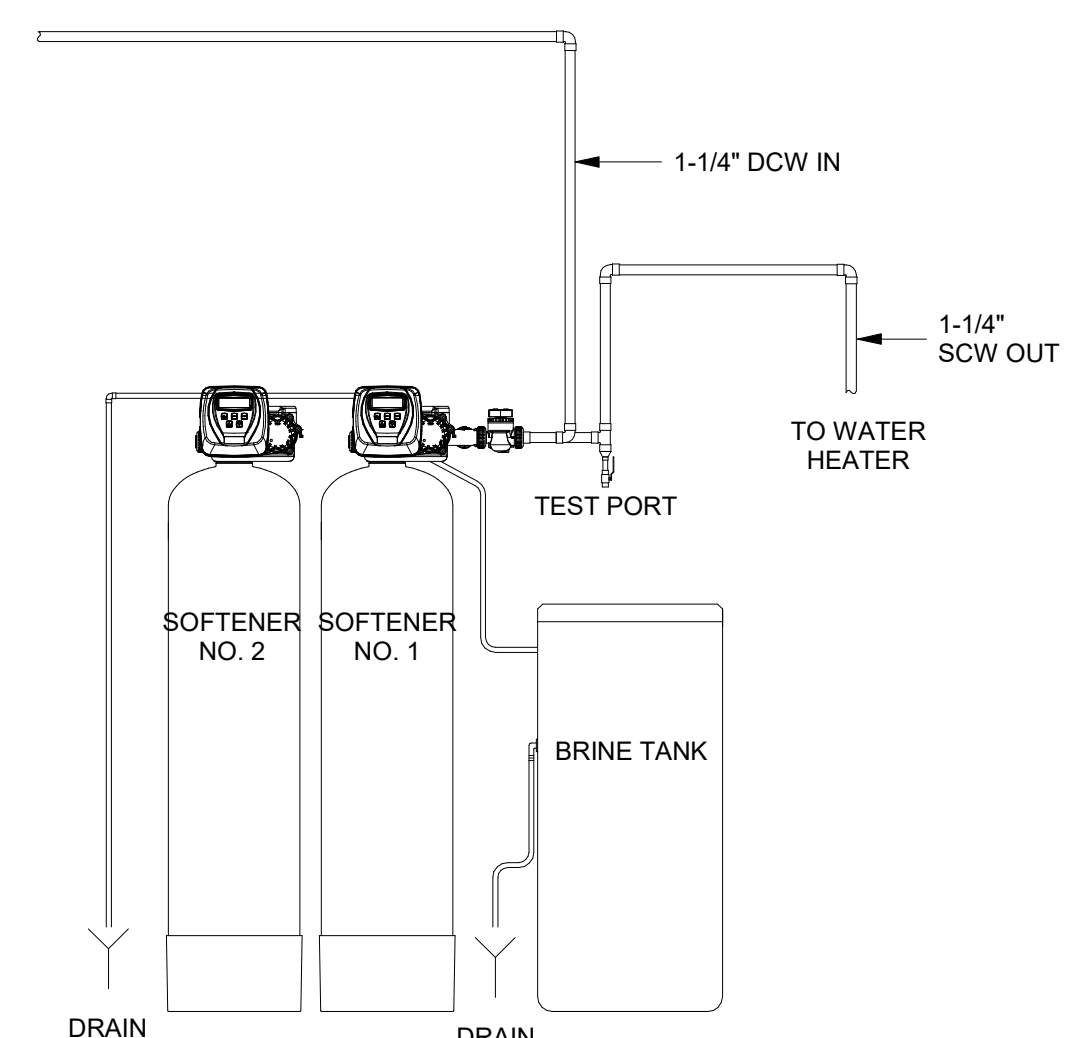


2 WATER SOFTENER PIPING DETAIL
 SCALE: NTS

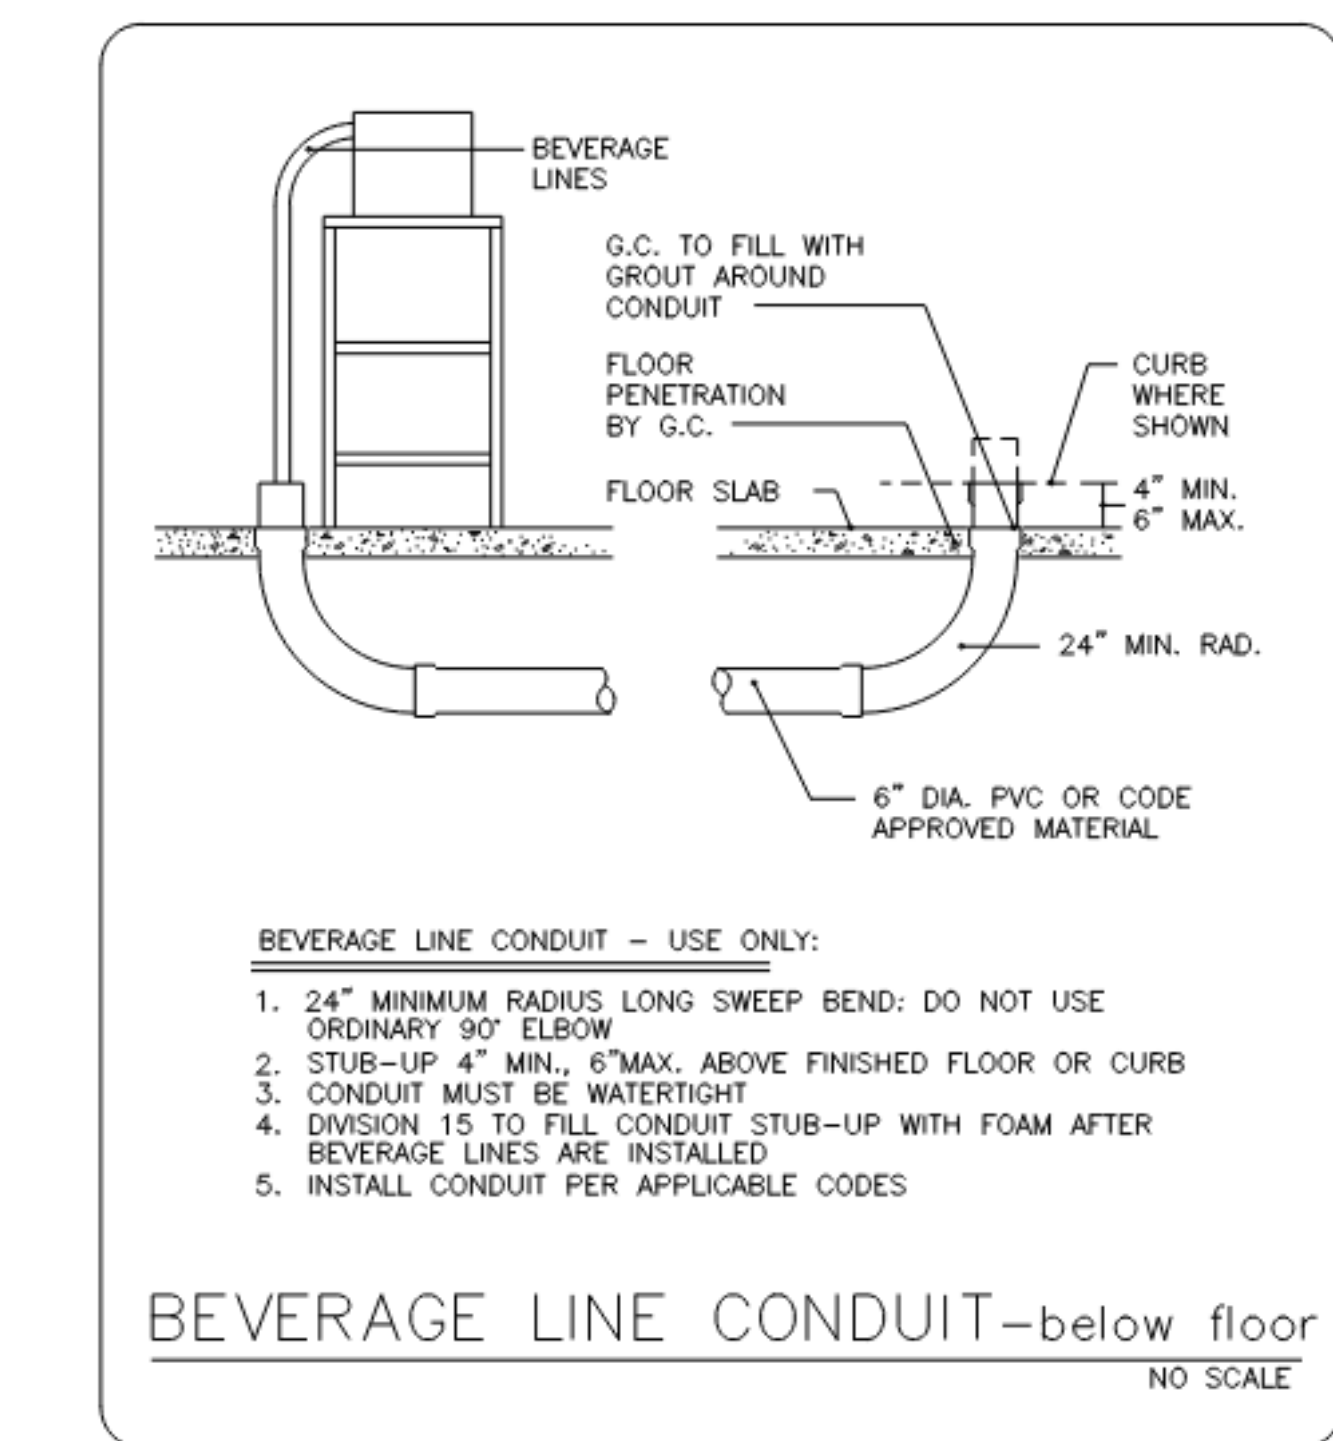


1 BEVERAGE LINE CONDUIT DETAIL
 SCALE: NTS

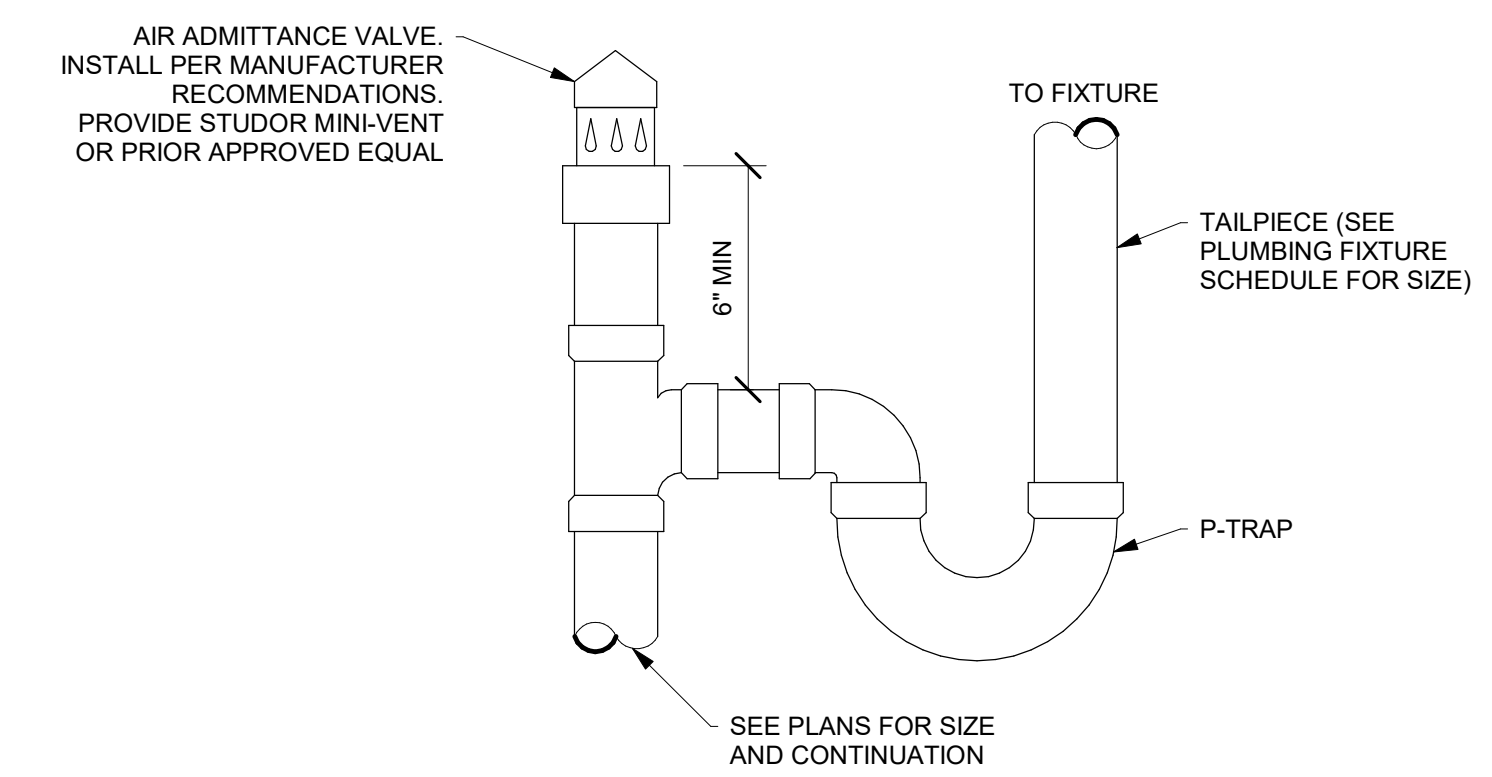


9 AIR ADMITTANCE VALVE DETAIL
 SCALE: NTS

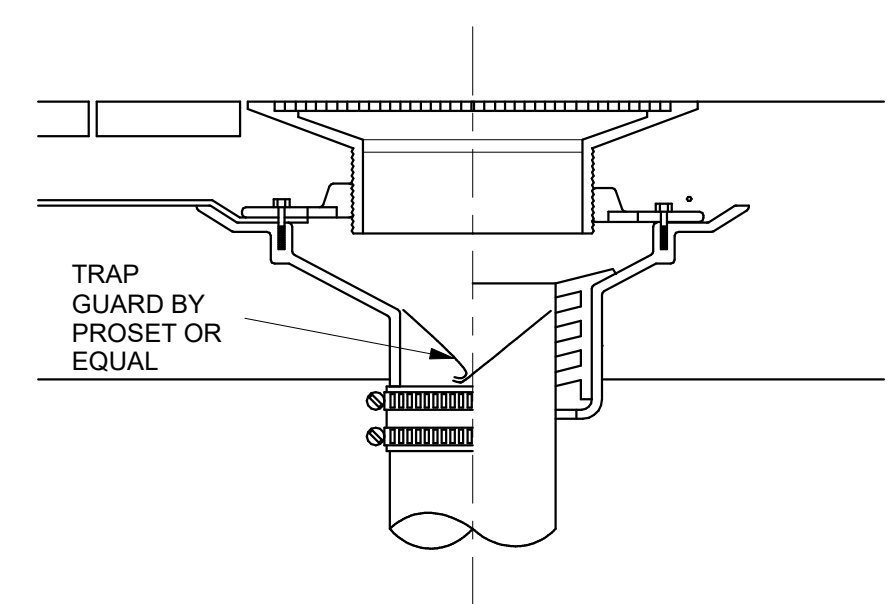

8 FLOOR DRAIN
 SCALE: NTS

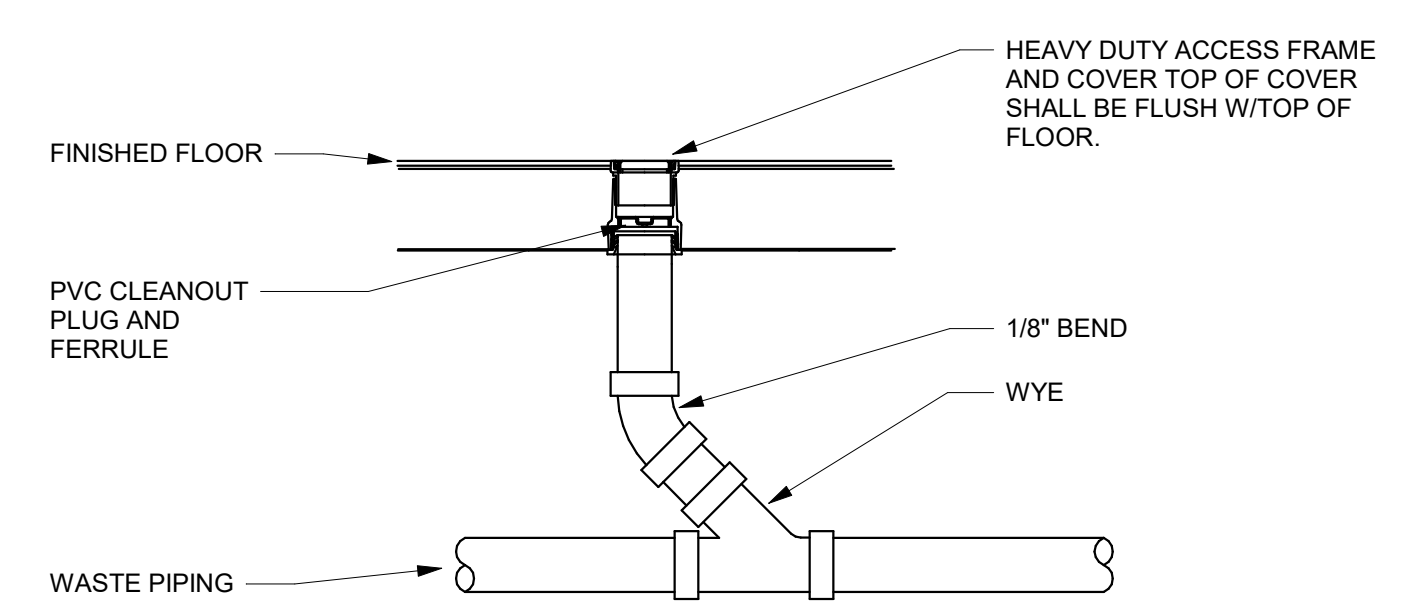


7 FLOOR CLEANOUT
 SCALE: NTS

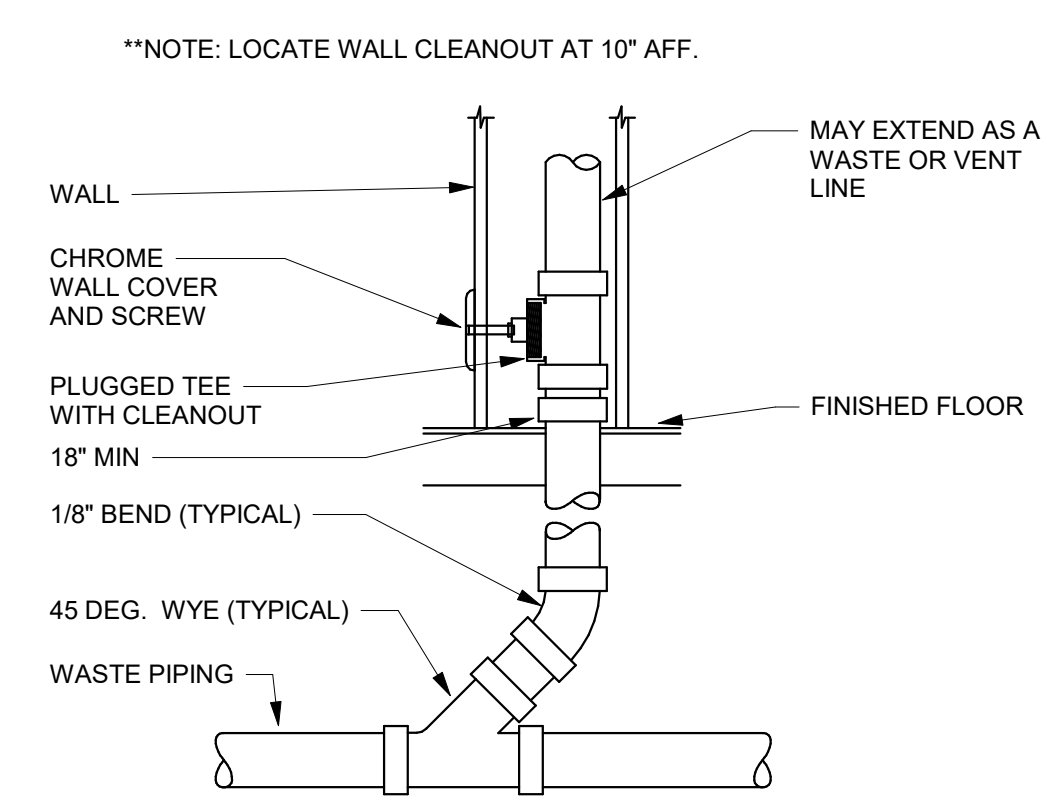


6 WALL CLEANOUT
 SCALE: NTS

FUEL LINE SIZE (NOMINAL INCHES)	VENT LINE SIZE (NOMINAL INCHES)
UP TO 1 1/2"	3/4"
2"	1"
2 1/2"	1 1/4"
3"	1 1/2"

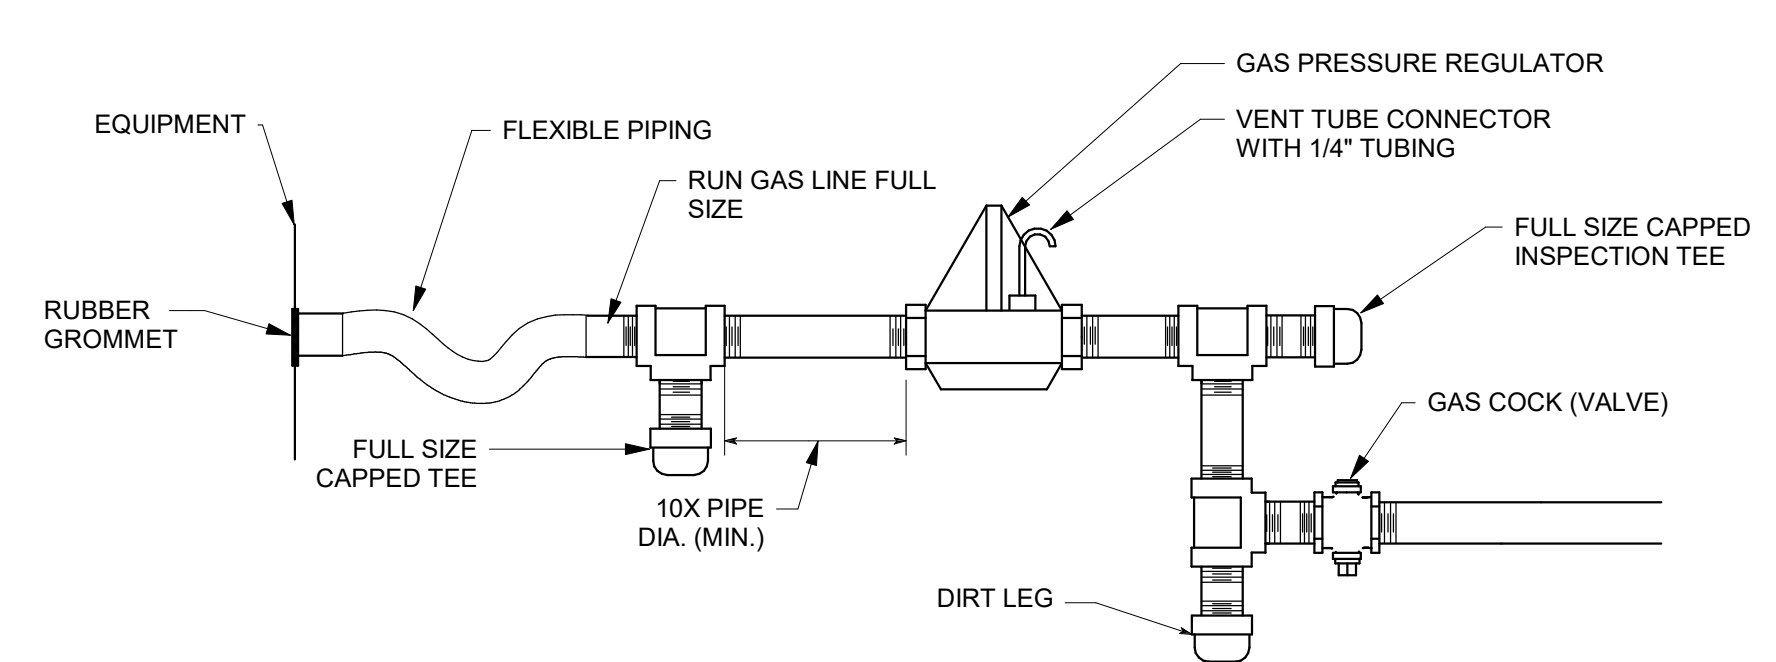

10 EQUIPMENT GAS PIPING WITH REGULATOR
 SCALE: NTS

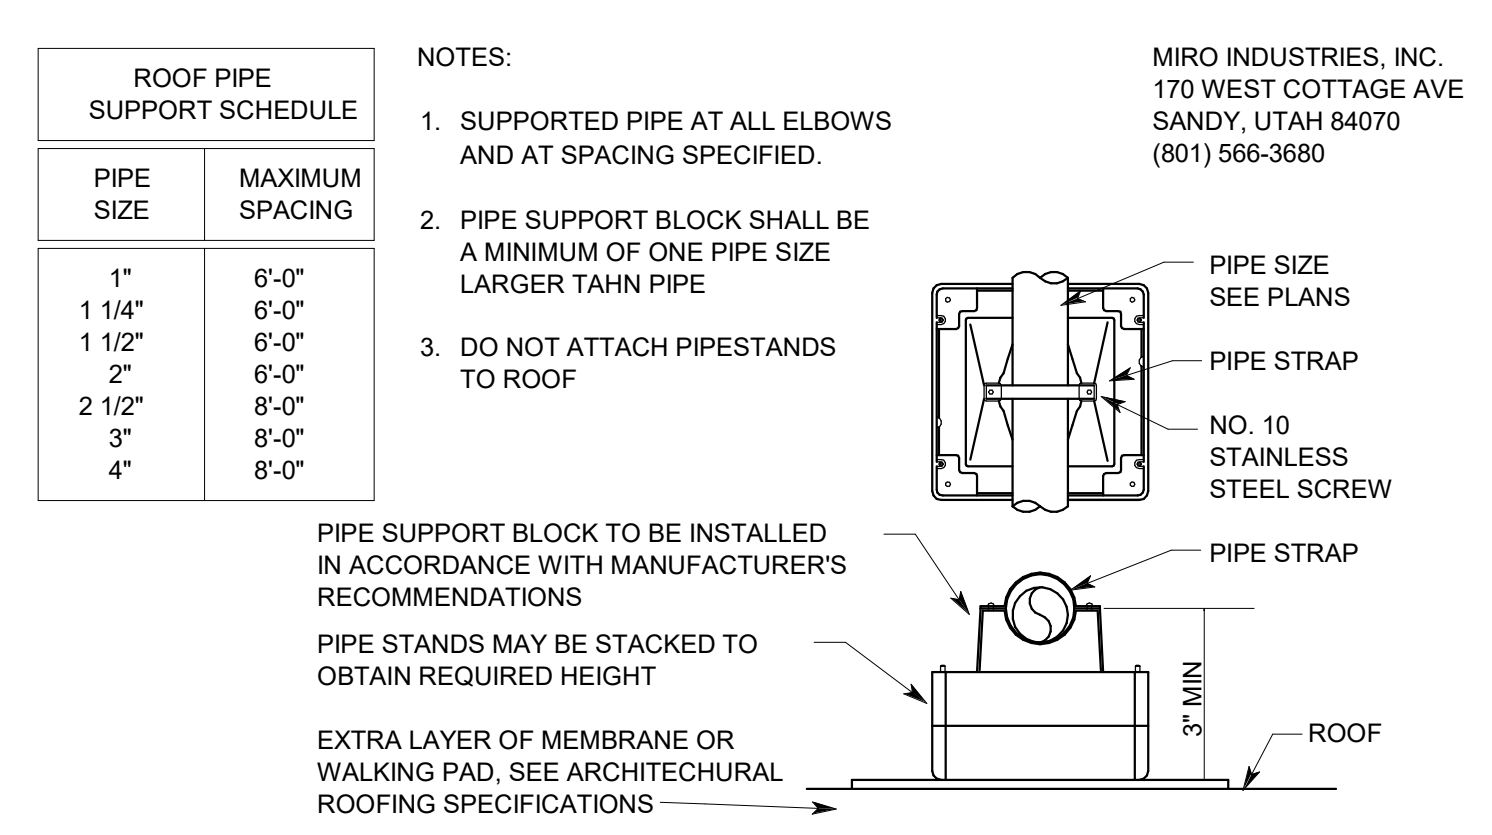

5 ROOF PIPING SUPPORT
 SCALE: NTS


NOTES:

- SUPPORTED PIPE AT ALL ELBOWS AND AT SPACING SPECIFIED.
- PIPE SUPPORT BLOCK SHALL BE A MINIMUM OF ONE PIPE SIZE LARGER THAN PIPE.
- DO NOT ATTACH PIPESTANDS TO ROOF.


PIPE SUPPORT BLOCK TO BE INSTALLED IN ACCORDANCE WITH MANUFACTURER'S RECOMMENDATIONS. PIPE STANDS MAY BE STACKED TO OBTAIN REQUIRED HEIGHT. EXTRA LAYER OF MEMBRANE OR WALKING PAD, SEE ARCHITECTURAL ROOFING SPECIFICATIONS.

MIRO INDUSTRIES, INC.
 170 WEST COTTAGE AVE
 SANDY, UTAH 84070
 (801) 566-3680

PIPE SIZE	MAXIMUM SPACING
1"	6'-0"
1 1/4"	6'-0"
1 1/2"	6'-0"
2"	6'-0"
2 1/2"	8'-0"
3"	8'-0"
4"	8'-0"

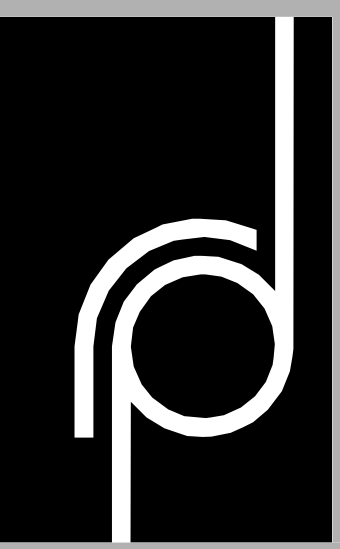

THE RICHARDSON DESIGN PARTNERSHIP, L.L.C.
 510 South 600 East
 Salt Lake City, Utah 84102
 P: 801.355.6886
 F: 801.355.6880

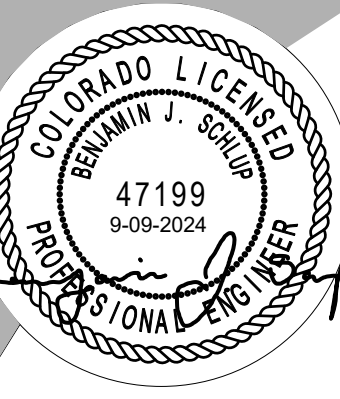

ALL DRAWINGS, SPECIFICATIONS AND CONTRACT DOCUMENTS SHALL BE SUBJECT TO THE TERMS AND CONDITIONS OF THE RICHARDSON DESIGN PARTNERSHIP, L.L.C. STANDARD TERMS AND CONDITIONS OF SERVICE. THE RICHARDSON DESIGN PARTNERSHIP, L.L.C. SHALL BE RESPONSIBLE FOR THE DESIGN AND CONSTRUCTION OF THE PROJECT. THE RICHARDSON DESIGN PARTNERSHIP, L.L.C. SHALL NOT BE RESPONSIBLE FOR THE DESIGN AND CONSTRUCTION OF THE PROJECT IF THE RICHARDSON DESIGN PARTNERSHIP, L.L.C. IS NOT THE DESIGNER OF RECORD FOR THE PROJECT.

SPECTRUM ENGINEERS
 324 S. State St., Suite 400
 Salt Lake City, UT 84111
 800-878-7077
 801-328-5151
 fax: 801-328-5155
 www.spectrum-engineers.com

Reviewed for Code Compliance
 10/07/2024
 CONSULTANT


SERAC CAPITAL PARTNERS, LLC
 5051 WESTHEIMER RD. SUITE 1750
 HOUSTON, TX 77056
 OWNER:

CENTRAL PARK RESTAURANT T.I.
 1760 Central Park Dr.
 Steamboat Springs, CO
 PROJECT:


ISSUE DATE	DESCRIPTION
09/17/2024	
09/10/24	Owner Revisions

REV. DATE	DESCRIPTION
09/10/24	Owner Revisions


PERMIT SET
PLUMBING DETAILS
 PROJECT #: 2023
 DRAWN BY: DRT
 SHEET #: RPE502
 CHECKED BY: SSI

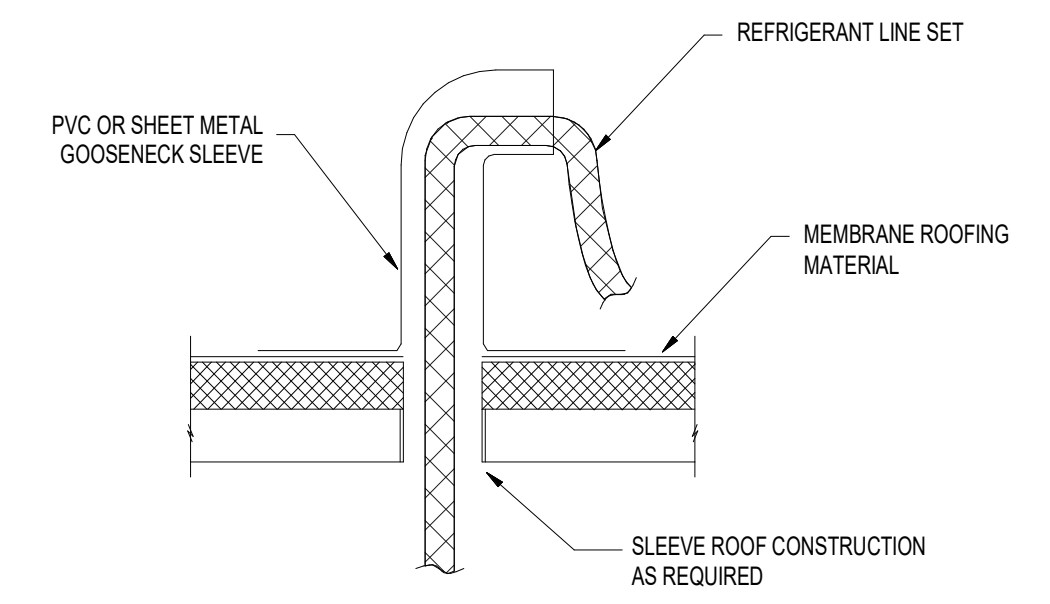


4 LINE-SET PENETRATION DETAIL
 SCALE: NTS

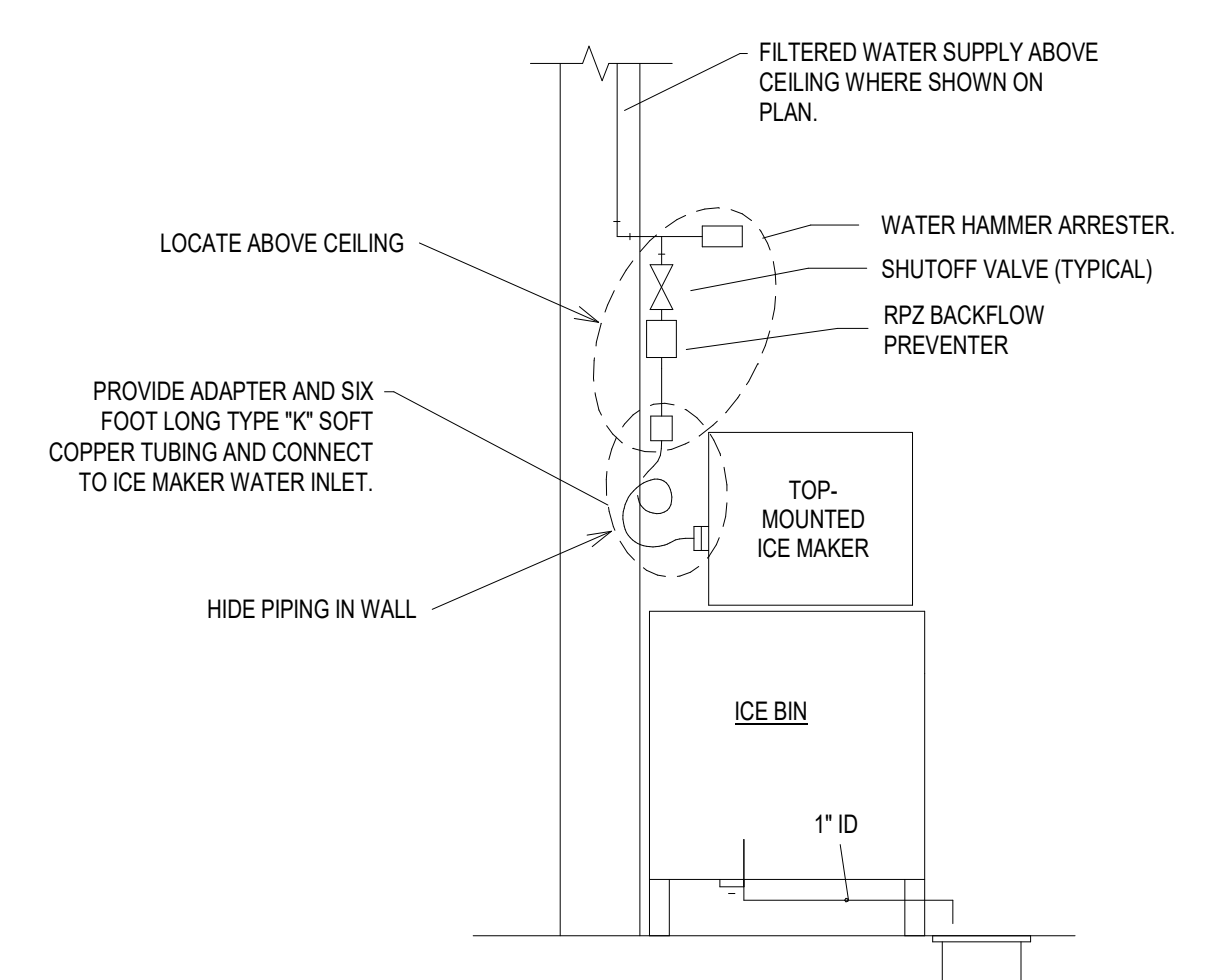


3 ICE MACHINE DETAIL
 SCALE: NTS
 PIPING ARRANGEMENT SHOWN IS SCHEMATIC. ADJUST TO SUIT FIELD CONDITIONS PROVIDE CONNECTIONS AS RECOMMENDED BY EQUIPMENT MANUFACTURER.

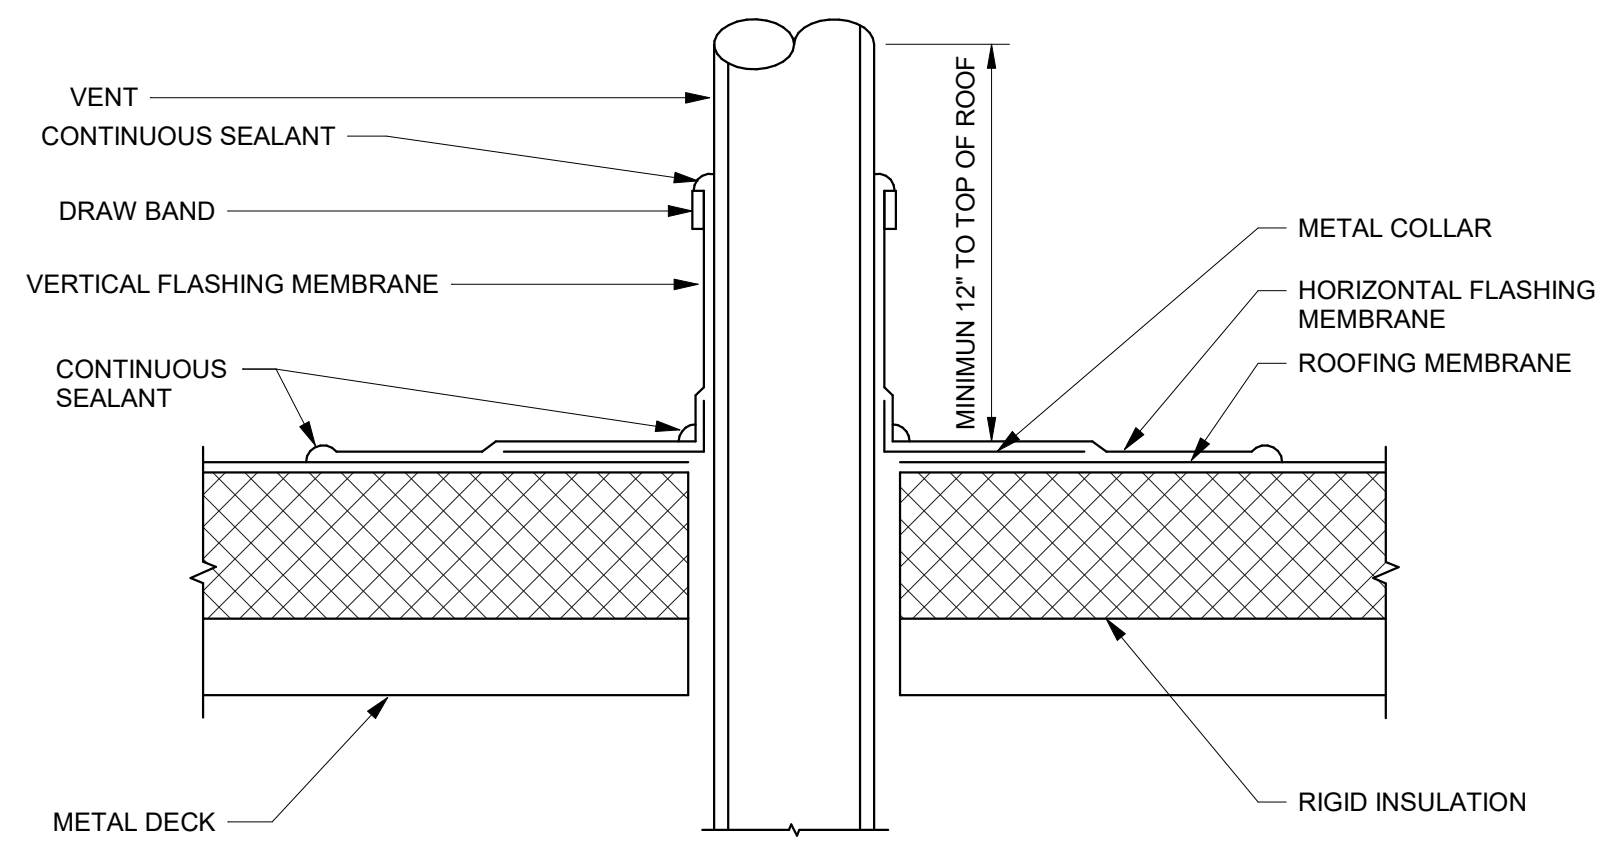


2 VENT THRU ROOF DETAIL
 SCALE: NTS

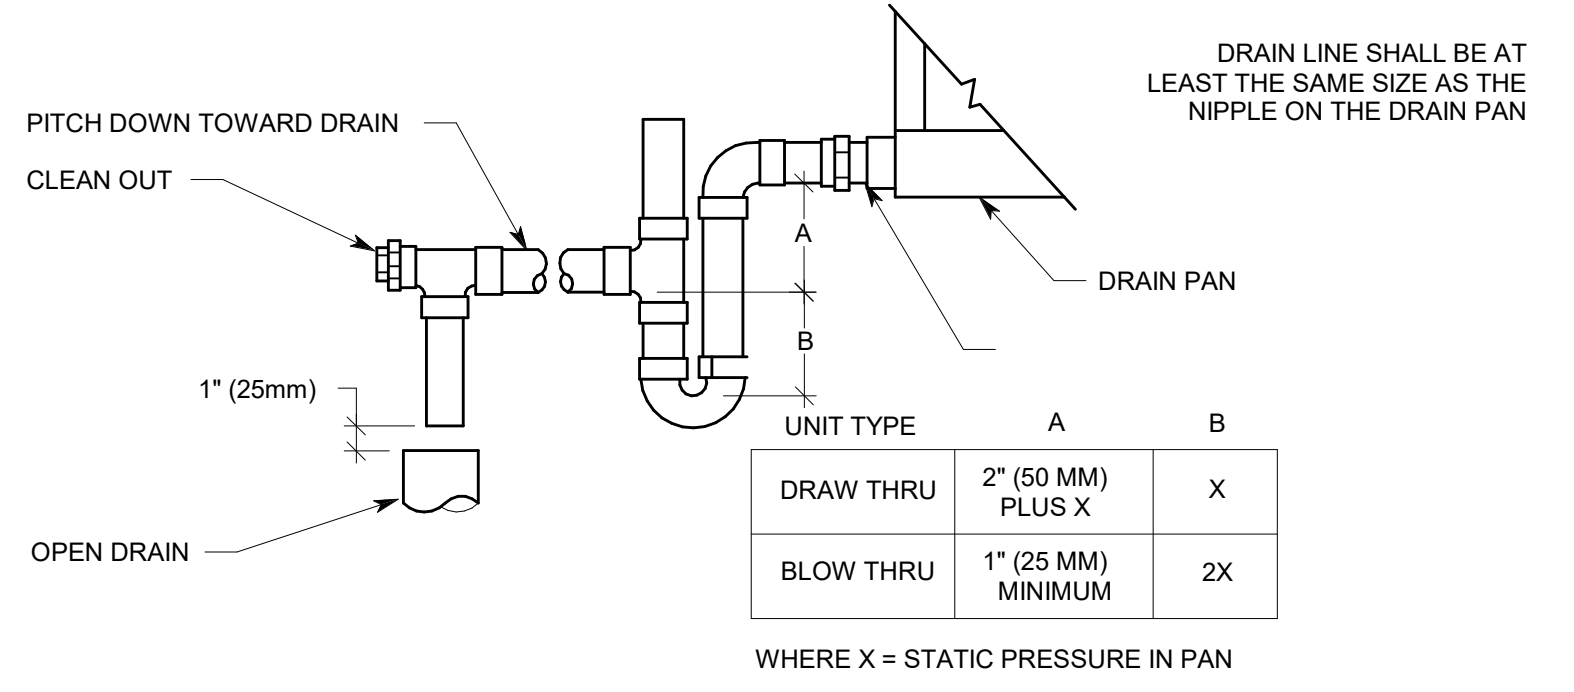

1 RTU CONDENSATE TRAP DETAIL
 SCALE: NTS

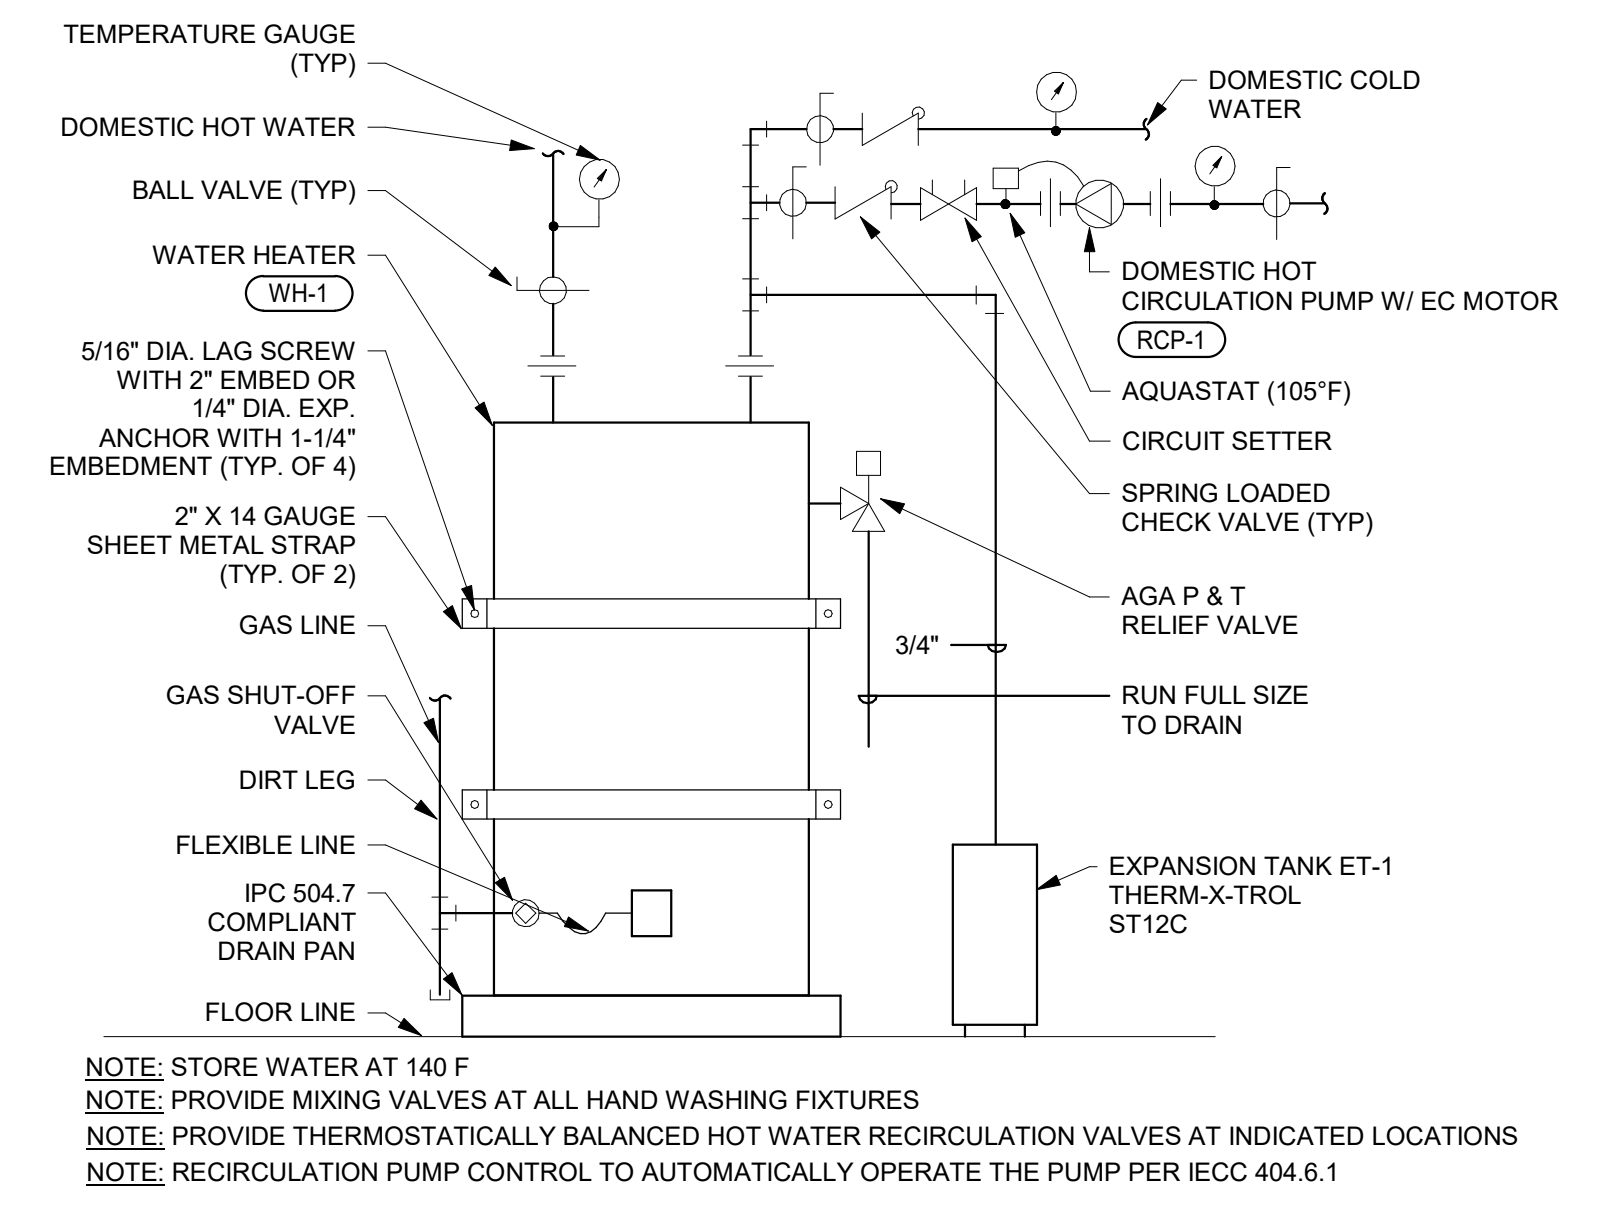


6 WATER HEATER WITH RECIRC
 SCALE: NTS
 NOTE: STORE WATER AT 140 F
 NOTE: PROVIDE MIXING VALVES AT ALL HAND WASHING FIXTURES
 NOTE: PROVIDE THERMOSTATICALLY BALANCED HOT WATER RECIRCULATION VALVES AT INDICATED LOCATIONS
 NOTE: RECIRCULATION PUMP CONTROL TO AUTOMATICALLY OPERATE THE PUMP PER IECC 404.6.1

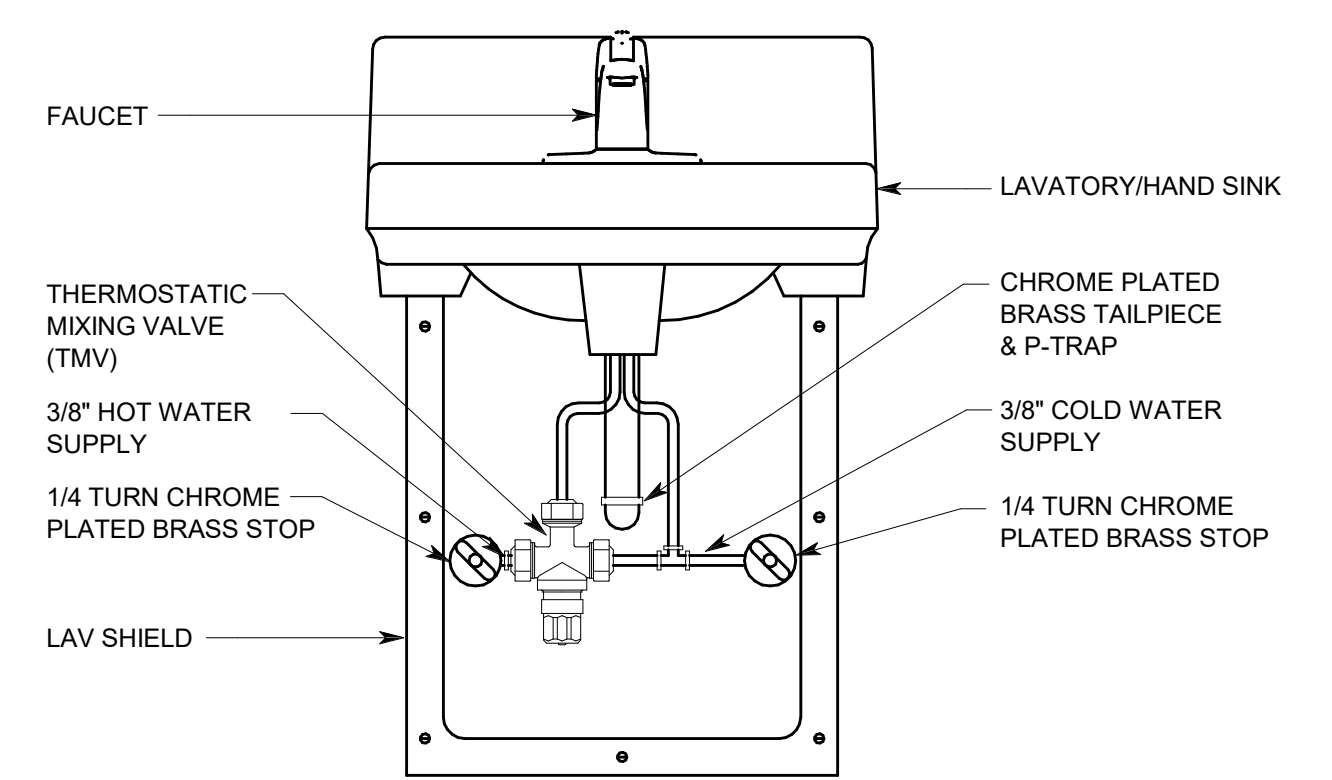

5 HAND SINK W/MIXING VALVE
 SCALE: NTS


Secure Cover Adapters

Cover adapters must be secured to base units in above grade installations with increased head pressure conditions. Use cover adapter tie-down kit model ATDI.

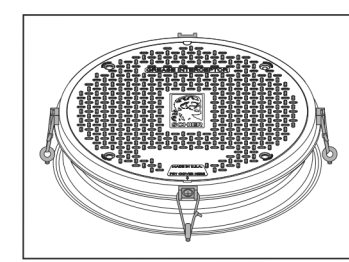


High Water Table Installations

Interceptors and risers are not designed to withstand water table height in excess of the top of the unit when buried (see figure). If it is possible for this to occur, install the interceptor and risers in a water-tight concrete vault or backfill with concrete or flowable backfill (wet concrete and flowable backfill should be poured in stages to avoid crushing the interceptors). At risk areas include but are not limited to tidal surge areas, floodplains and areas that receive storm water. Great Basin™ models that are direct buried in high water table scenarios must be installed with an anchor kit. Model GB-250 uses model AK1 anchor kit.

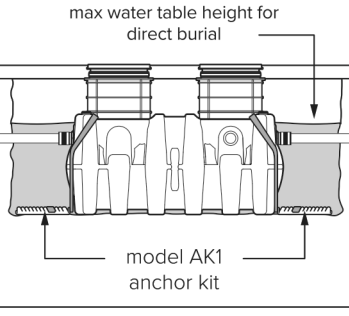


Hydrostatic/Pressure Slabs

When installed under a hydrostatic slab (slab designed to withstand upward fill, usually caused by hydrostatic pressure) interceptors must be enclosed in a watertight concrete vault.

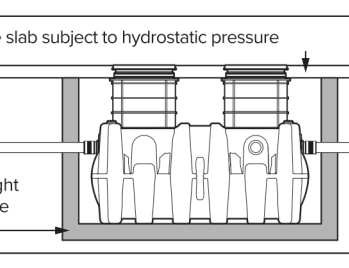


DO NOT COMPACT BACKFILL MECHANICALLY

Compact by hand only.


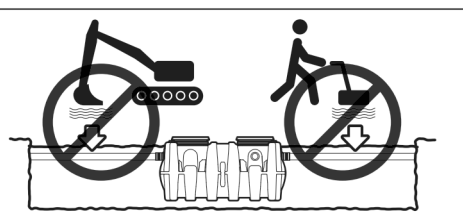


Below Grade Installation Slab Requirements

A concrete slab to finished grade with rebar is required when installing interceptors below grade.

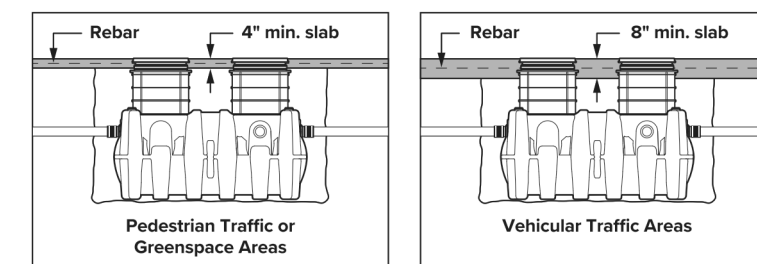


Installations with Risers

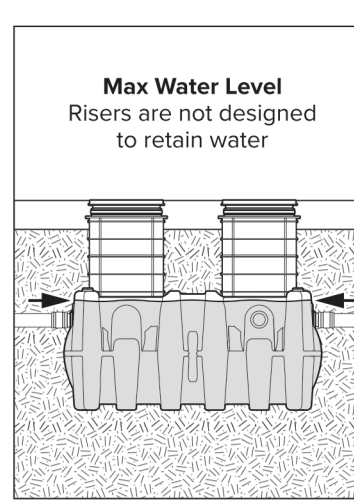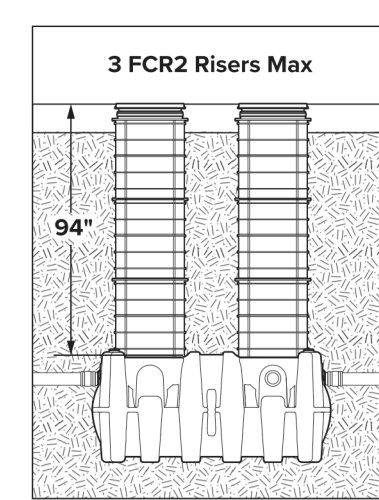


Corrugated Riser Pipe Requirements

Riser adapter model CA2 must be used when installing interceptors using 24" diameter corrugated pipe as a riser. This will adequately embed the cover adapter in the concrete slab, preventing cover/cover adapter failure under traffic rated loads.

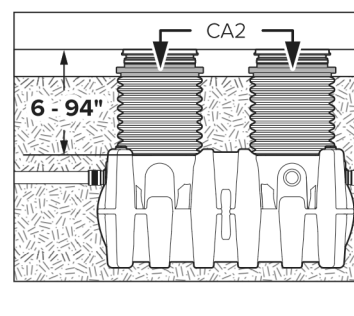

Excavate Burial Pit ONLY

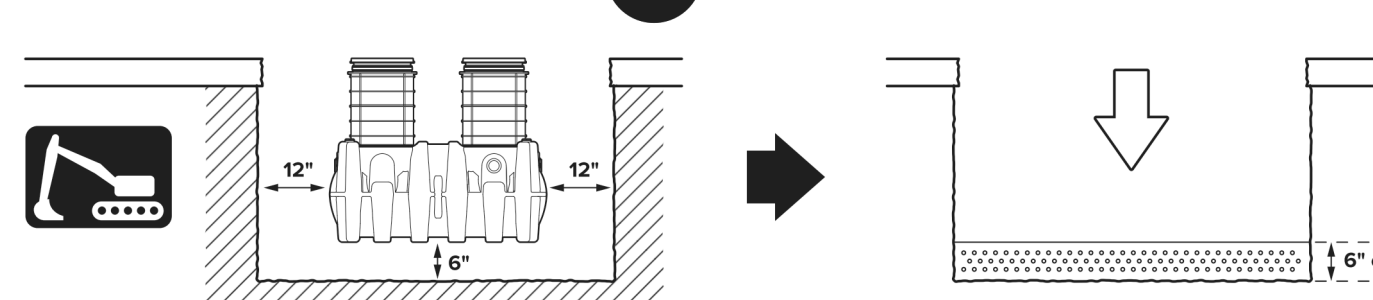


Excavate hole at least 12" larger than interceptor on all sides and 6" deeper than tank bottom. Lay a level bed of well-packed, crushed aggregate (approximately 3/4" size rock or sand, with no fines) in the base of hole.

The GB-250 is ready for burial depth of 44" from finished grade to bottom of tank (or 13-1/2" to centerline of riser). Deeper burials will require extending the cover adapters and possibly adding risers.

Measure dimension X to determine riser height needed.

Riser Height Needed	Risers Required
0" - 4"	None (use adapter)
>4" - 34"	FCR2 (x2)
>34" - 64"	FCR2 (x4)
>64" - 94"	FCR2 (x6)

Install risers if required

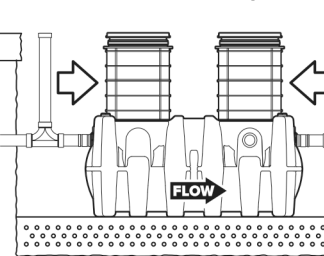

See instructions included with FCR2.

SPECIFICATIONS

Notes:

- 4" FPT inlet/outlet with 4" plain end adapters, single inlet and triple outlet.
- Unit weight - w/ cast iron covers: 376 lbs. (For wet weight add 2,310 lbs.)
- Maximum operating temperature: 150° F continuous
- Capacities - Liquid: 277 gal.; Grease: 1,895 lbs. (260 gal.) @100GPM Grease: 1,196 lbs. (164 gal.) @200GPM Solids: 69 gal.
- This unit does not require flow control for 100 GPM applications. Built-in flow control is provided for 200 GPM applications. For series installations, only install flow control on the first unit in the series if necessary.
- For gravity drainage applications only.
- Do not use for pressure applications.
- Cover placement allows full access to tank for proper maintenance.
- Vent not required unless per local code.
- Engineered inlet and outlet diffusers with inspection ports are removable to inspect / clean piping.
- Integral air relief / Anti-siphon / Sampling access.
- Adjustable cover adapters provide up to 4" of additional height.
- Designed for below-grade, above-grade, indoor or outdoor installations.
- Safety Star® access restrictor built into each cover adapter, prevents accidental entry to tanks (450 lb rating).

ENGINEER SPECIFICATION GUIDE

Schier Great Basin™ grease interceptor model # GB-250 shall be lifetime guaranteed and made in USA of seamless, rotationally-molded polyethylene with minimum 3/8" uniform wall thickness. Interceptor shall be furnished for above or below-grade installation with adjustable cover adapters, Safety Star® access restrictor built into each cover adapter, built-in flow control (for 200 GPM only) and three outlet options. Interceptor shall be certified to ASME A112.14.3 (Type D for 100 GPM, type C for 200 GPM) and CSA B481.1. Interceptor flow rate shall be 100 GPM or 200 GPM. Interceptor grease capacity shall be 1,895 lbs. @ 100 GPM or 1,196 lbs. @ 200 GPM. Cover shall provide water/gas-tight seal and have minimum 16,000 lbs. load capacity.

CERTIFIED PERFORMANCE

Great Basin™ hydromechanical grease interceptors are third party performance-tested and listed by IAPMO to ASME #A112.14.3 and CSA B481.1 grease interceptor standards and greatly exceed requirements for grease separation and storage. They are compliant to the Uniform Plumbing Code and the International Plumbing Code.

Type D certification does not require a flow control

SPECIFICATION SHEET

MODEL NUMBER: **GB-250**



PART NUMBER: 4055-007-02

DESCRIPTION: GB-250 GREASE INTERCEPTOR 100 GPM / 200 GPM, 4" INLET/OUTLET, H-20 RATED CAST IRON COVERS

PROPRIETARY AND CONFIDENTIAL




THE INFORMATION CONTAINED IN THIS DRAWING IS THE SOLE PROPERTY OF SCHIER PRODUCTS. ANY REPRODUCTION IN PART OR AS A WHOLE WITHOUT THE WRITTEN PERMISSION OF SCHIER PRODUCTS IS PROHIBITED.

DWG BY: C.SINCLAIR DATE: 5/4/2022 REV: - ECO: -

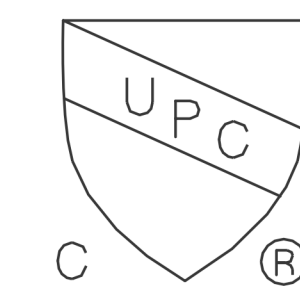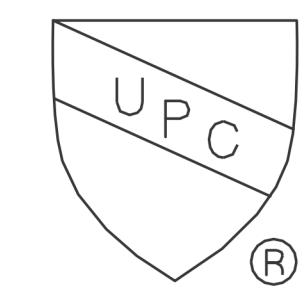

SCHIER

6455 Woodland Dr
Shawnee, KS 66218
Tel: 913-951-3300
Fax: 913-951-3399
schierproducts.com

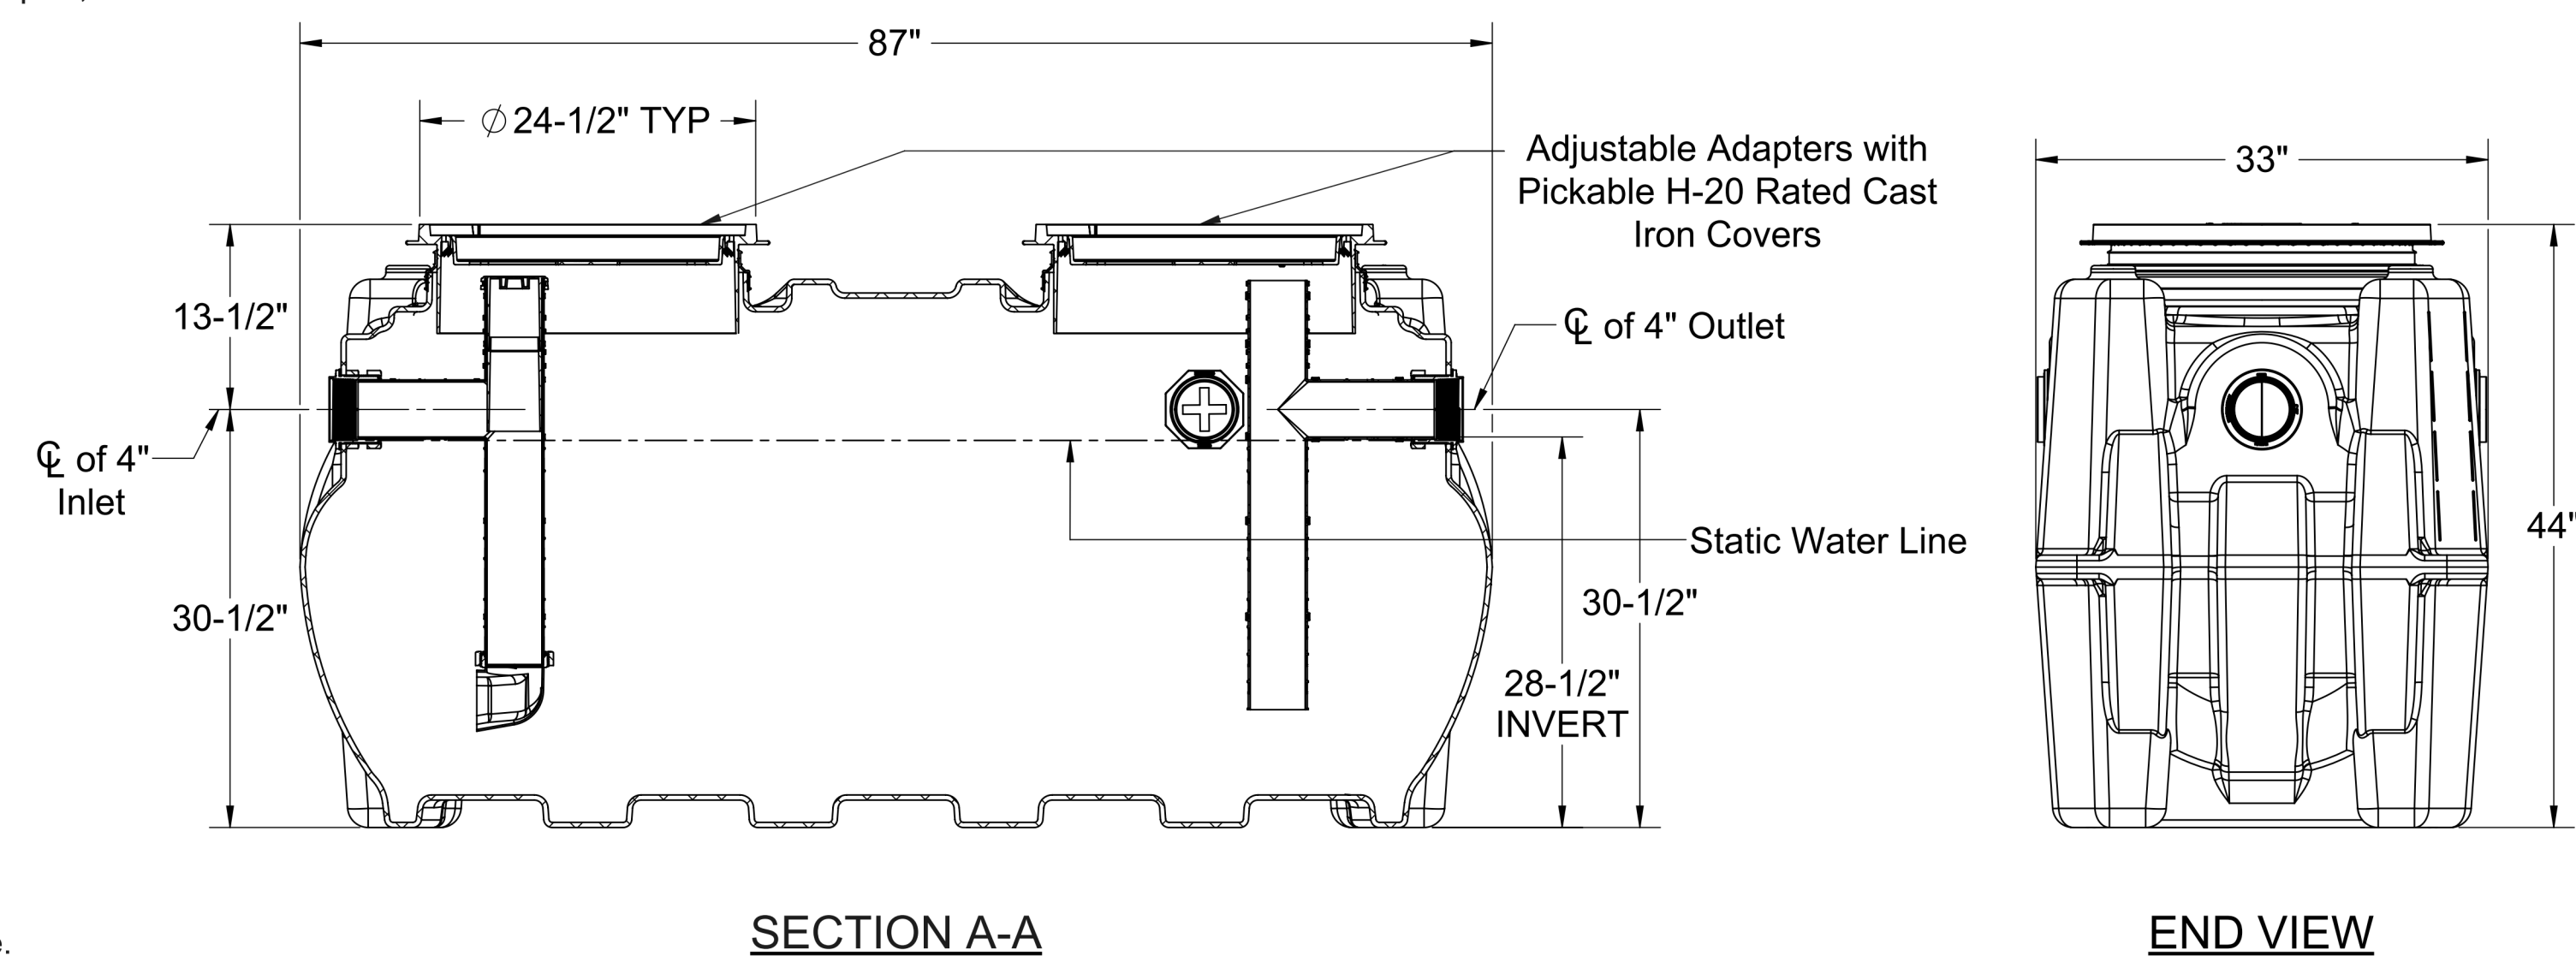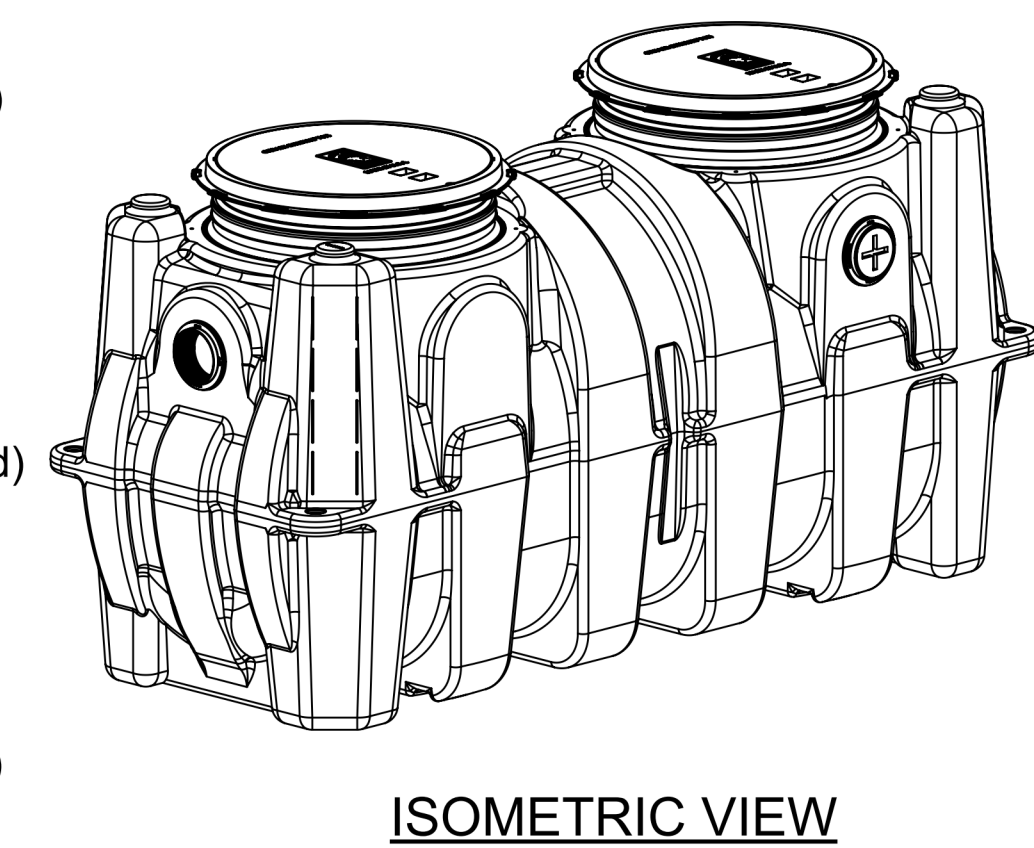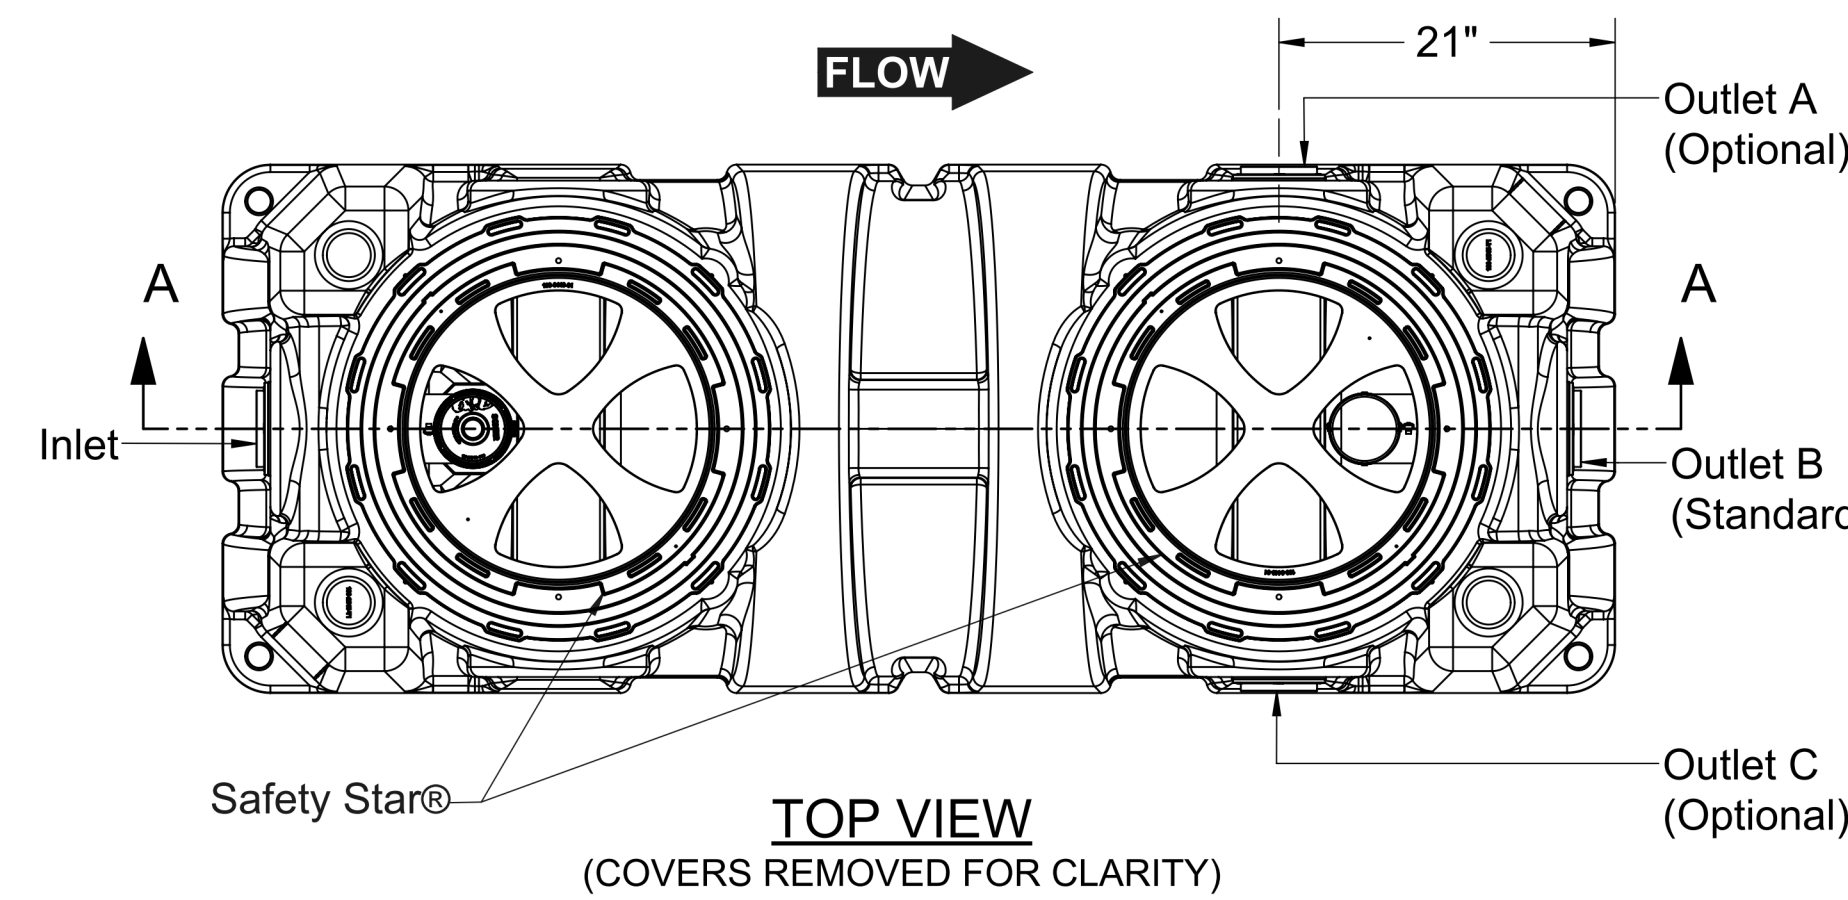

NOTES


- 4" plain end inlet/outlet
- Field modifiable to 6" plain end inlet/outlet
- Unit weight - 9 lbs.
- Maximum operating temperature: 150° F continuous
- Offset connections
- 2 rolls of 33" x 2" butyl mastic tape provided for sealing build-your-own riser joints

ENGINEER SPECIFICATION GUIDE

Schier Sewer Viewer™ sampling port model # SV10 shall be lifetime guaranteed and made in USA of seamless, rotationally-molded polyethylene. Sampling port shall be furnished for above or below grade installation. Cover shall provide water/gas-tight seal and have minimum 16,000 lbs. load capacity.

ACCESSORIES:

- Field Cut Risers for extending cover to grade

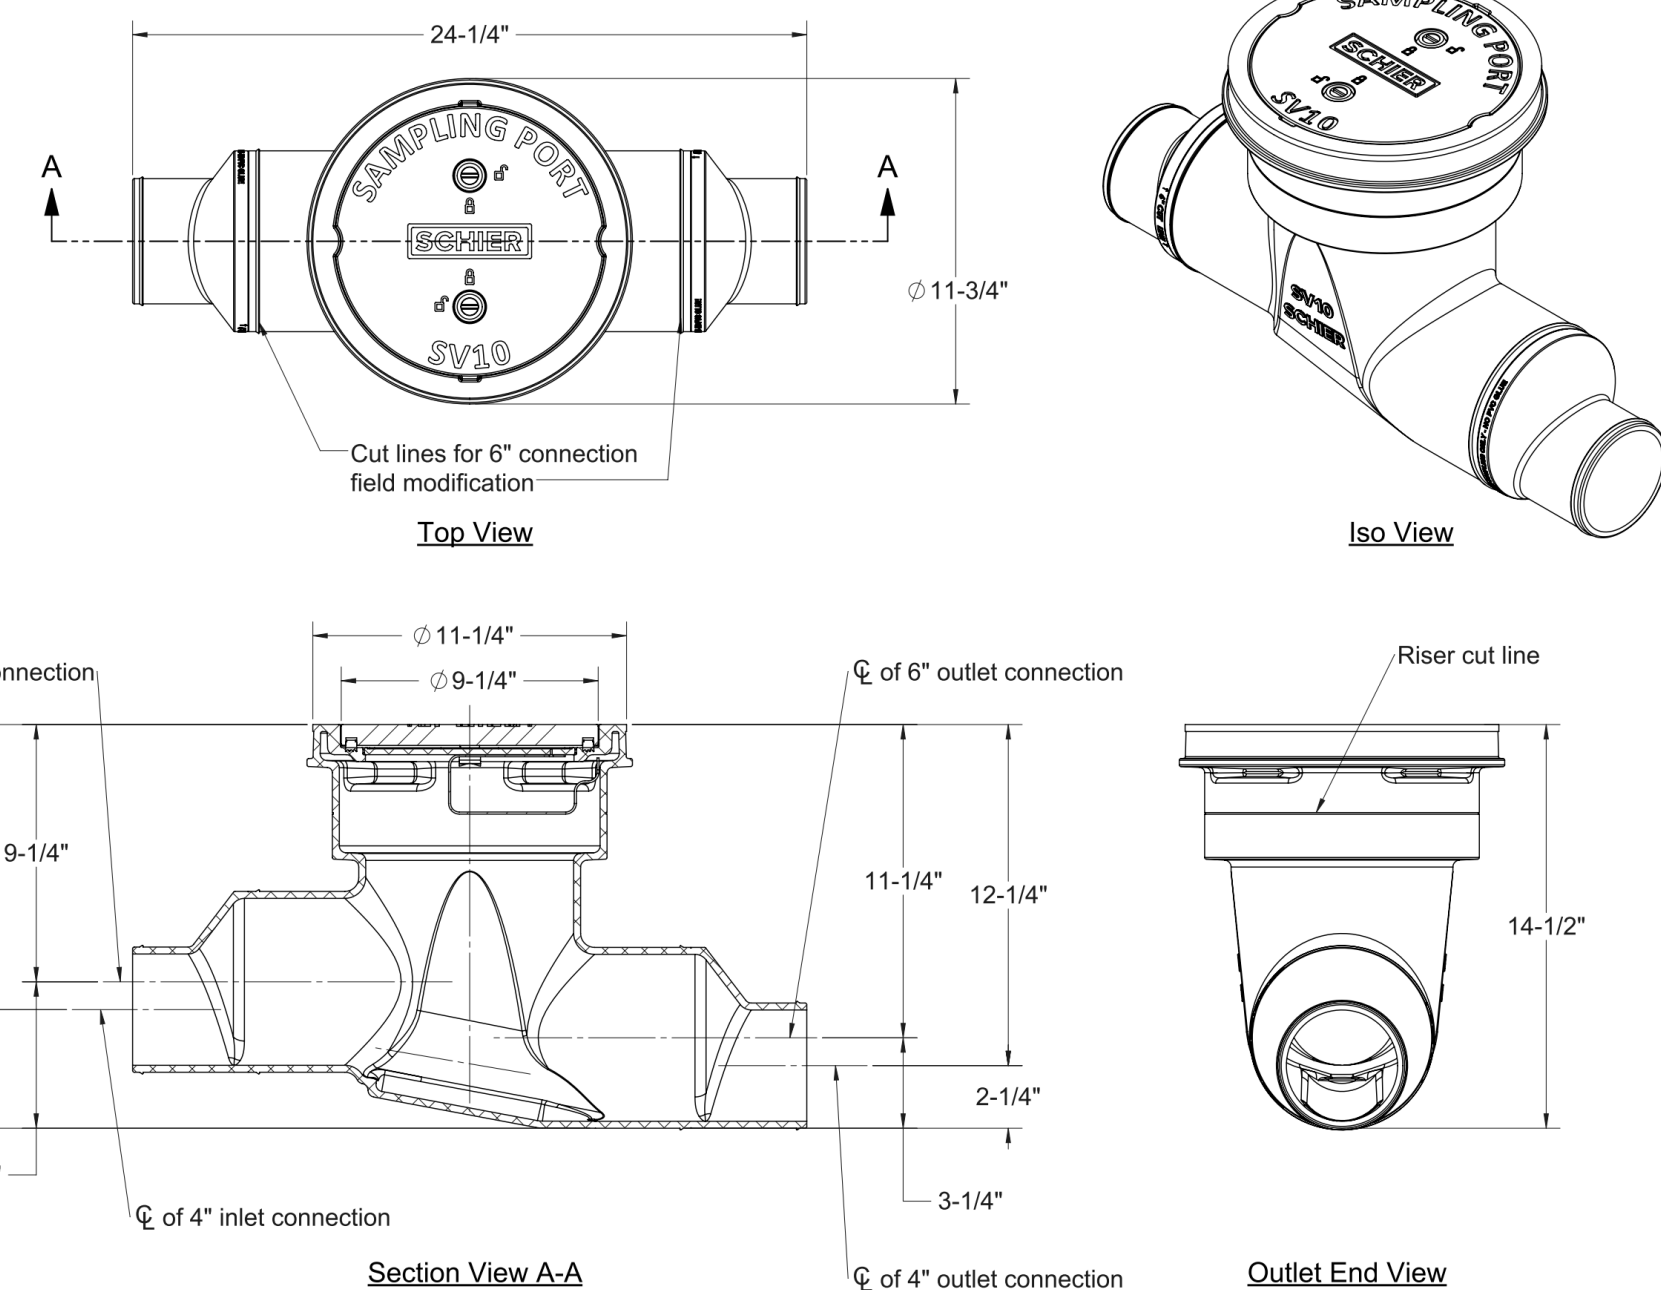

SPECIFICATION SHEET

MODEL NUMBER: **SV10**

PART NUMBER: 8065-001-01

DESCRIPTION: SV10 SEWER VIEWER SAMPLING PORT, 4" CONNECTIONS (FIELD MODIFIABLE TO 6"), POLYETHYLENE COVER

PROPRIETARY AND CONFIDENTIAL

THE INFORMATION CONTAINED IN THIS DRAWING IS THE SOLE PROPERTY OF SCHIER PRODUCTS. ANY REPRODUCTION IN PART OR AS A WHOLE WITHOUT THE WRITTEN PERMISSION OF SCHIER PRODUCTS IS PROHIBITED.


DWG BY: B.BROWN DATE: 6/6/2022 REV: - ECO: -



6455 Woodland Dr
Shawnee, KS 66218
Tel: 913-951-3300
Fax: 913-951-3399
schierproducts.com

**FOR THE FULL INSTALLATION DETAILS, REFER TO THE MANUFACTURER INSTALLATION DOCUMENTS.

NOTE: GREASE INTERCEPTOR LOCATION IS SHOWN ON SHELL CIVIL PLANS. GREASE INTERCEPTOR SIZING REQUIREMENTS ARE SHOWN ON THESE PLANS.

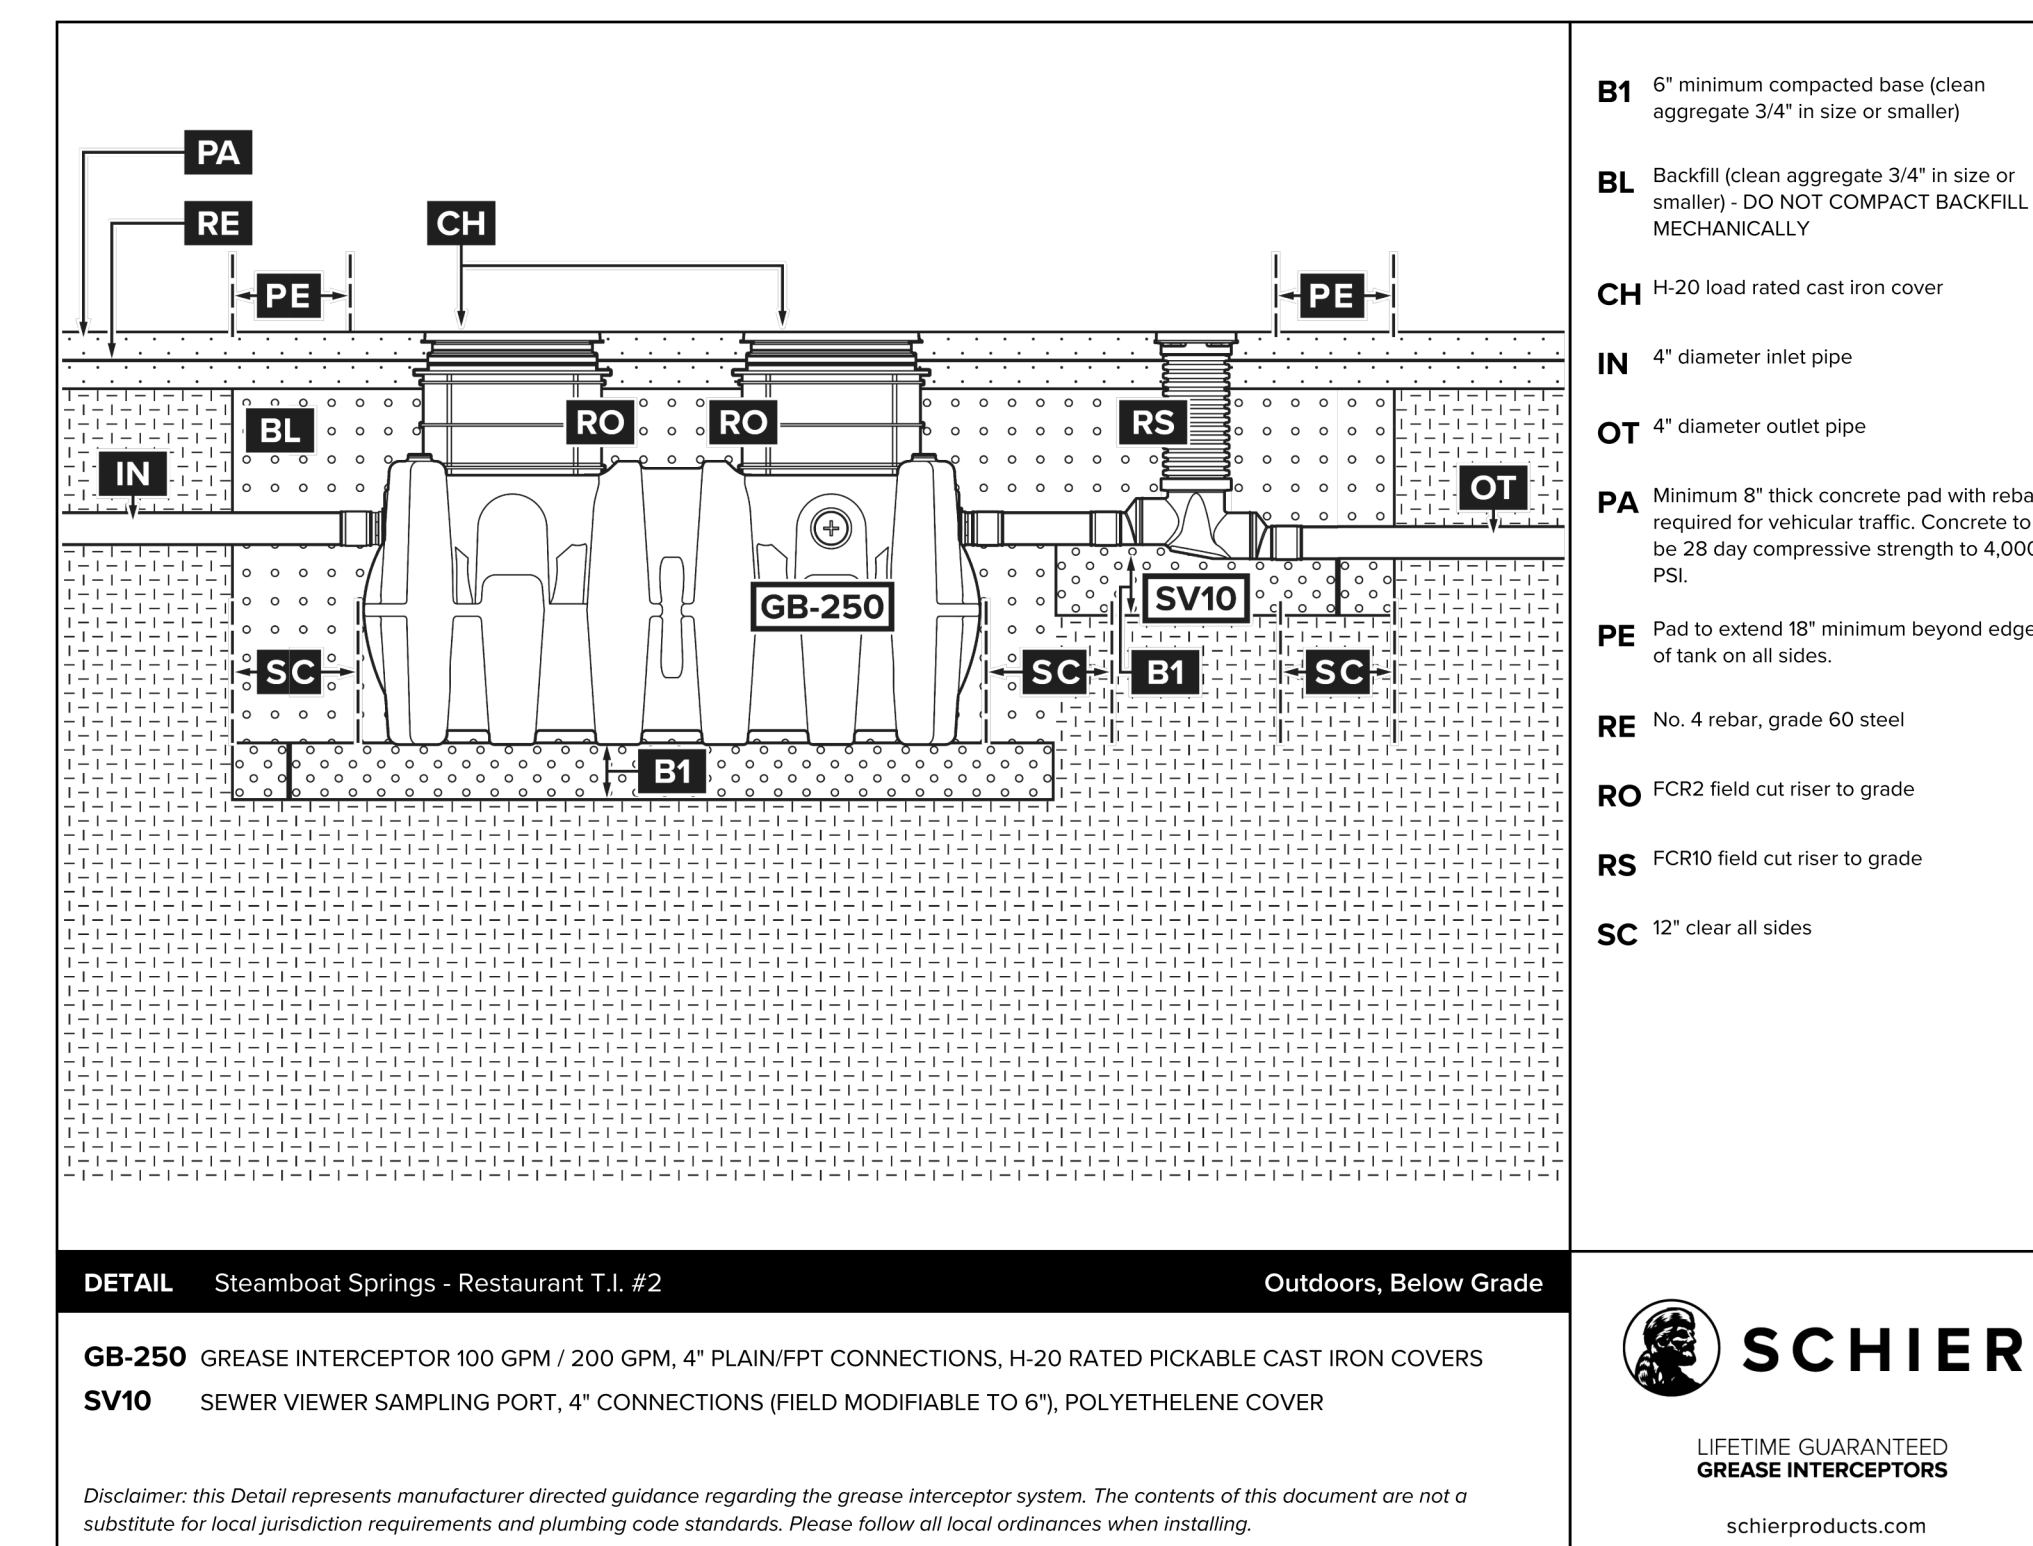


- B1** 6" minimum compacted base (clean aggregate 3/4" in size or smaller)
- BL** Backfill (clean aggregate 3/4" in size or smaller) - DO NOT COMPACT BACKFILL MECHANICALLY
- CH** H-20 load rated cast iron cover
- IN** 4" diameter inlet pipe
- OT** 4" diameter outlet pipe
- PA** Minimum 8" thick concrete pad with rebar required for vehicular traffic. Concrete to be 28 day compressive strength to 4,000 PSI.
- PE** Pad to extend 18" minimum beyond edge of tank on all sides.
- RE** No. 4 rebar, grade 60 steel
- RS** FCR2 field cut riser to grade
- RO** FCR10 field cut riser to grade
- SC** 12" clear all sides

DETAIL Steamboat Springs - Restaurant T.I. #2 Outdoors, Below Grade


GB-250 GREASE INTERCEPTOR 100 GPM / 200 GPM, 4" PLAIN/FPT CONNECTIONS, H-20 RATED PICKABLE CAST IRON COVERS
SV10 SEWER VIEWER SAMPLING PORT, 4" CONNECTIONS (FIELD MODIFIABLE TO 6"), POLYETHYLENE COVER



LIFETIME GUARANTEED
GREASE INTERCEPTORS
schierproducts.com

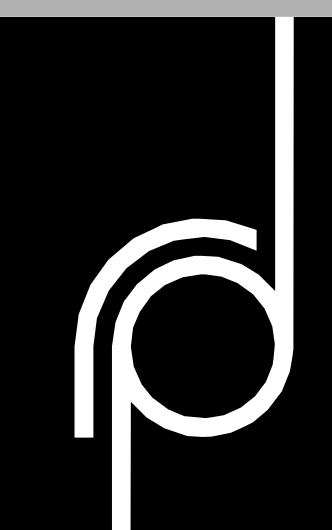

THE RICHARDSON DESIGN PARTNERSHIP, L.L.C.
510 South 600 East
Salt Lake City, Utah 84102
P: 801.355.6886
F: 801.355.6880

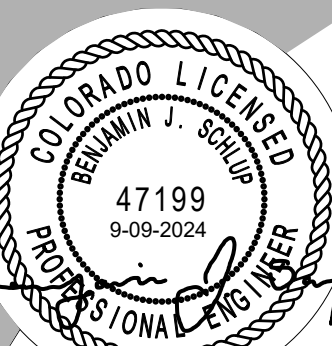

THE ABOVE DESIGN, SPECIFICATION OR CALCULATION WAS PREPARED BY BENJAMIN J. LIPPERT (P.E.) IN FULL COMPLIANCE WITH THE REQUIREMENTS OF THE PROFESSIONAL ENGINEERING ACT AND THE REGULATIONS OF THE BOARD OF PROFESSIONAL ENGINEERS AND ARCHITECTS OF THE STATE OF UTAH. THIS DESIGN IS THE PROPERTY OF THE RICHARDSON DESIGN PARTNERSHIP, L.L.C. ALL RIGHTS ARE RESERVED.

SPECTRUM ENGINEERS
324 S. State St., Suite 400
Salt Lake City, UT 84111
800-878-7077
801-328-5151
fax: 801-328-5155
www.spectrum-engineers.com

Reviewed for Code Compliance
10/07/2024
CONSULTANT

SERAC CAPITAL PARTNERS, LLC
5051 WESTHEIMER RD., SUITE 1750
HOUSTON, TX 77056
OWNER:

CENTRAL PARK RESTAURANT T.I.
1760 Central Park Dr.
Steamboat Springs, CO
PROJECT:

ISSUE DATE	DESCRIPTION
06/17/2024	
09/10/24	Owner Revisions

REV. DATE	DESCRIPTION
09/10/24	Owner Revisions

PERMIT SET
GREASE INTERCEPTOR DETAILS
RPE503
PROJECT #: 2023
DRAWN BY: BBT
CHECKED BY: JSB
SHEET #

MINIMUM PIPE INSULATION THICKNESS FOR WATER AND REFRIGERANT

FIELD OPERATING TEMP RANGE (F)	INSULATION CONDUCTIVITY		INSULATION THICKNESS (INCHES) BASED ON NOMINAL PIPE SIZE				
	CONDUCTIVITY BTU-IN/(HT ² F)	MEAN RATING TEMPERATURE, F	LESS THAN 1" DIA.	1"-1 1/2" DIA.	1 1/2"-4" DIA.	4"-8" DIA.	8" DIA. AND ABOVE
>350	0.32-0.34	250	4.5	5.0	5.0	5.0	5.0
251-350	0.29-0.32	200	3.0	4.0	4.5	4.5	4.5
201-250	0.27-0.30	150	2.5	2.5	2.5	3.0	3.0
141-200	0.25-0.29	125	1.5	1.5	2.0	2.0	2.0
105-140	0.22-0.28	100	1.0	1.0	1.5	1.5	1.5
40-60	0.27-0.30	75	0.5	0.5	1.0	1.0	1.0
<40	0.20-0.26	50	0.5	1.0	1.0	1.0	1.5

VALVE SCHEDULE

SERVICE	VALVE TYPE	PIPE SIZE	DESCRIPTION
DOMESTIC WATER SERVICE	BALL VALVE	2" & SMALLER	COPPER ALLOY, 2-PIECE, STANDARD PORT, CHROME PLATED BALL, TFE SEAT, LEVER HANDLE, 400 PSIG WOG, MSS SP-110, SOLDERED OR THREADED END
	CHECK VALVE	2" & SMALLER	BRONZE BODY, SPRING TYPE, TFE SEAT, BRONZE DISC, SOLDERED OR THREADED ENDS, MSS SP-80
	UNION	2" & SMALLER	ASTM B16.39, CLASS 150, MALLEABLE IRON, HEXAGONAL STOCK BODY, BRONZE-TO-BRONZE SEAT
NATURAL GAS	BALL VALVE	2" & SMALLER	COPPER ALLOY, 2-PIECE, STANDARD PORT, CHROME PLATED BALL, TFE SEAT, LEVER HANDLE, 400 PSIG WOG, MSS SP-110, AGA APPROVED, ASME B28.33, THREADED END
	UNION	2" & SMALLER	ASTM B16.39, CLASS 150, MALLEABLE IRON, HEXAGONAL STOCK BODY, BRONZE-TO-BRONZE SEAT

GAS PRESSURE REGULATOR SCHEDULE

SYMBOL	LOCATION	MANUFACTURER	MODEL NUMBER	REGULATOR SIZE (INCHES)	CAPACITY (CFH)	NOTES
GPR	INDOOR / OUTDOOR	PF REGULATOR	F30051	1/2	928	ALL
			F30052	3/4	1155	
			F30053	1	1501	
			F3013	1-1/4	7894	

GREASE INTERCEPTOR CALCULATIONS

Reference No. 66835 Project Name: Steamboat Springs - Restaurant T.I. #2

Step 1: Flow rate to grease interceptor

Fixture flow rate: (cu in / 231) = gal x 0.75 / 2 min = 2 min flow rate

NAME	TYPE	DIMENSIONS	QTY	CU IN	FLOW RATE	TOTAL DFUs
Bar Sink One Bowl	Bar Sink One Bowl	14" x 14" x 14"	2	5,488	8.9 GPM	4
Dishwasher	Dishwasher (Door Type)	35 gal.	1	8,085	17.5 GPM	3
Dishwasher	Dishwasher (Undercounter)	11 gal.	1	2,541	5.5 GPM	3
Floor Drain	Floor Drain	N/A	5	N/A	0 GPM	10
Floor Sink (Coffee Station)	Floor Sink	N/A	1	N/A	0.5 GPM	2
Floor Sink (soda gun drains)	Floor Sink	N/A	2	N/A	1 GPM	4
FS (Tilt skillet & combi oven)	Floor Sink	N/A	1	N/A	7.5 GPM	2
HOTEL - 3 Comp Sink	3 Compartment Sink	21" x 21" x 14" (3)	1	18,522	30.07 GPM	6
HOTEL - Floor Sink	Floor Sink	N/A	2	N/A	2 GPM	4
Mop Basin	Mop Basin	24" x 24" x 10"	1	5,760	9.35 GPM	3
Pre-Rinse Sink One Bowl	Pre-Rinse Sink One Bowl	20" x 20" x 5"	1	2,000	3.25 GPM	2
Prep Sink Two Bowls	Prep Sink Two Bowls	21" x 21" x 14" (2)	2	24,696	40.1 GPM	4
Warning Table (with drain)	Warning Table (with drain)	N/A	1	N/A	0.5 GPM	1
Total						126.17 GPM

Flow rate used to size interceptor (less of fixture or pipe size)

Pipe size (4 in):

Pipe Size flow rate per Manning's Formula

75 GPM

Step 2: Grease Production

Number of Seats x 4 turns per seat x Grease Production Value x Days between pump-out = Grease output

Number of seats in facility: 136

Grease production value: 0.035 lbs per serving (Bar and Grille: High / No flatware)

Days between pump-outs: 90 days

136 x 4 x 0.035 x 90 = 1713.6 lbs of FOG

SCHIER MODEL	Description:
GB-250	GREASE INTERCEPTOR 100 GPM / 200 GPM, 4" PLAIN/FPT CONNECTIONS, H-20 RATED PICKABLE CAST IRON COVERS Dimensions: Length: 87", Width: 33", Height: 44" Flow Rate/Grease Capacity: 100 GPM / 1895 lbs Liquid Capacity: 277 gal

Specification Note: This Great Basin model has been sized to the flow rate and grease production requirements of the application and may not be substituted by liquid capacity alone. Any substitution requests must be approved by the specifying engineer and the authority having jurisdiction.

Please contact support@schieproducts.com for technical and procurement support for the specified Great Basin model.

*SIZING PER "STANDARD SPECIFICATIONS FOR WATER AND WASTEWATER UTILITIES" DOCUMENT PROVIDED BY THE CITY OF STEAMBOAT SPRINGS.
**SEE SHELL CIVIL PLANS FOR LOCATION OF GREASE INTERCEPTOR AND GREASE WASTE PIPING TO BUILDING.

SANITARY SEWER DEMAND

EQUIPMENT	MINIMUM TRAP AND TRAP ARM	QUANTITY	INDIVIDUAL DRAINAGE FIXTURE UNIT	TOTAL DRAINAGE FIXTURE UNITS
WATER CLOSET, FLUSH VALVE (PUBLIC 1.6 GPF)	4"	2	4.0	8.00
LAVATORY	1-1/4"	2	1.0	2.00
FLOOR DRAIN (EMERGENCY)	2"	3	0.0	0.00
FLOOR SINK	2"	3	2.0	6.00
HAND WASHING SINK	1-1/2"	4	2.0	8.00
GREASE WASTE	4"	1	48.0	48.00
			TOTAL (DFU):	72.00
BASIS FOR DESIGN:				
2021 INTERNATIONAL PLUMBING CODE CHAPTER 7, TABLE 710.1(1) - PIPE SIZE:				4"

WATER HAMMER ARRESTER SCHEDULE

SYMBOL	INLET SIZE (INCHES)	PDI SYMBOL	CAPACITY (DFU)	BASIS OF DESIGN MANUFACTURER & MODEL
WHA-A	1/2	A	1-11	SIoux CHIEF 652-A
WHA-B	3/4	B	12-32	SIoux CHIEF 653-B
WHA-C	1	C	22-60	SIoux CHIEF 654-C
WHA-D	1	D	61-113	SIoux CHIEF 655-D
WHA-E	1	E	114-154	SIoux CHIEF 656-E
WHA-F	1	F	155-330	SIoux CHIEF 657-F

ACCEPTABLE MANUFACTURERS:
SIoux CHIEF "HYDRA-ARRESTER"
MIFAB "MWH"
PPP "SC"
WATTS LPF2
J.R. SMITH 50XX

REMARKS:
(1) ANSI / ASSE 1010 LISTED
(2) LEAD FREE CONSTRUCTION
(3) COPPER TUBE BODY; POLY PISTON, EDM O-RING
(4) MIP THREADED INLET

WATER HEATER (GAS)

LABEL	LOCATION	TANK SIZE (GAL)	RECOVERY GPH @ 100° ΔT	FIRST HOUR RATING (GAL.)	GAS INPUT (BTUH)	EFFICIENCY	VOLTS	PHASE	Hz	MCA	OPERATING WEIGHT (LBS)	MANUFACTURER	MODEL	REMARKS
WH-2	MECH ROOM	75	115	168	100,000	96	120	1	60	5.0	1008	A.O. Smith	BTXL-100	ALL

ACCEPTABLE MANUFACTURERS: REMARKS:
AO SMITH
BRADFORD WHITE
RHEEM
STATE
BOCK
(1) PROVIDE WITH CONCENTRIC VENT KIT.
(2) PROVIDE WITH EXPANSION TANK THERM-X-TROL ST-12.
(3) PROVIDE WITH UPPER AND LOWER SEISMIC STRAPS WITH TWO 5/16" LAG SCREWS HAVING 2" OF EMBED AT EACH CONNECTION LOCATION.

RECIRCULATION PUMP SCHEDULE

LABEL	MANUFACTURER & MODEL NUMBER	PUMP TYPE	SYSTEM SERVED	LIQUID TYPE	GPM	FT. HD.	TEMP RANGE (F)	V/PH/Hz	WATTS	AMPS	REMARKS
RCP-1	BELL & GOSSETT ECOCIRC 20-18	CIRCULATOR, INLINE	SOFTENED DHW	WATER	1	3	36-203	115/160	60	.5	1-5

1. PROVIDE WITH 6 FT CORD WITH PLUG. OUTLET PROVIDED ON ELECTRICAL PLANS.
2. BALANCE DOMESTIC HOT WATER RECIRCULATING LINE. PROVIDE BALANCING VALVE. PROVIDE P&T PORT ON INLET AND DISCHARGE OF PUMP. PROVIDE BALANCE REPORT TO ENGINEER.
3. PROVIDE WITH BRONZE, PLASTIC, OR STAINLESS STEEL IMPELLER AND STAINLESS STEEL BODY.
4. ACCEPTABLE MANUFACTURERS: BELL & GOSSETT, ARMSTRONG, TACO, GRUNDFOS OR PRIOR APPROVED EQUAL.
5. RUN IN CONSTANT PRESSURE MODE IN CONJUNCTION WITH CALEFFI MODEL 116 THERMAL BALANCING VALVES TO ALLOW PUMP TO RUN AT LOWER SPEED WHEN HOT WATER IS RUNNING.
A. CONTRACTOR TO INCLUDE CALEFFI 116 THERMAL BALANCING VALVES IN SUBMITTAL TO ENGINEER. NO SUBSTITUTIONS ALLOWED.
B. PUMP MUST BE CAPABLE OF RUNNING IN CONSTANT PRESSURE MODE.

PLUMBING FIXTURE SCHEDULE

LABEL	DESCRIPTION	WASTE	VENT	CW	HW	MANUFACTURER	MODEL	REMARKS
FD-1	AIR ADMITTANCE VALVE	0"	1 1/2"	0"	0"	OATEY	39016	
FD-1	FLOOR DRAIN	2"	1 1/2"	0"	0"	FIXTURE: ZURN TRAP SEAL: RECTORSEAL	Z415-BZ1 TRAP SEAL: SURESEAL	TRAP SEAL TO MATCH FD SIZE, PRO-SET OR APPROVED EQUAL.
FS-1	FLOOR SINK	2"	1 1/2"	0"	0"	ZURN	ZN1900-2NH-2	12" X 12". PROVIDE DOME STRAINER AND HALF GRATE COVER.
FS-2	FLOOR SINK	3"	1 1/2"	0"	0"	REGENCY	600FS1818SS	18" X 18". PROVIDE DOME AND HALF GRATE COVER ON ALL FLOOR SINKS. PROVIDE TRAP GUARD, PRO-SET OR APPROVED EQUAL.
HB-1	FREEZE-PROOF EXTERIOR HOSE BIB	0"	0"	3/4"	0"	ZURN	Z1305	
HB-2	CHEMICAL HOSE BIB	0"	0"	3/4"	3/4"	WOODFORD	MODEL 24	PROVIDE WITH INTERGRAL VACUUM BREAKER. LEAD FREE.
LAV-A	WALL MOUNTED LAVATORY (ACCESSIBLE)	1 1/4"	1 1/2"	1/2"	1/2"	FIXTURE: KOHLER FAUCET: KOHLER INSULATION: TRUEBRO TMV: WESTONE	K-2035-1 K013461 INSULATION: LAVGUARD 2 TMV: H-77211W1G	MOUNT AT ADA HEIGHT. PROVIDE ADA FAUCET. PROVIDE WITH UNIVERSAL WALL CARRIER WITH CONCEALED CARRIER ARMS. SET TMV AT 100" F.
MOP	SERVICE SINK	3"	1 1/2"	3/4"	0"	FIXTURE: MUSTEE FAUCET: KOHLER	63M K-8907	PROVIDE HOSE AND HOSE HOLDER, MOP HANGER, BUMPER AND WALL GUARDS
WC-A	FLOOR MOUNT FLUSH VALVE WATER CLOSET (ACCESSIBLE)	4"	2"	1 1/2"	0"	FIXTURE: KOHLER FLUSH VALVE: ZURN SEAT: BEMIS	K-96057-SBL ZER6000-CP-WS1 SEAT: 195ECTJ	PROVIDE WITH "NO-SLAM" TOILET SEAT.

WATER SOFTENER SCHEDULE

LABEL	MANUFACTURER & MODEL NUMBER	CONTINUOUS FLOW (GPM)	PEAK FLOW (GPM)	COUNT	DIMENSIONS (EA)	WEIGHT (LBS)	TANK CAPACITY	COUNT	DIMENSIONS (EA)	SALT CAPACITY (LBS)	OPERATING WEIGHT (LBS)	REMARKS
WS-1	PACIFIC WATER A952TA-60-2441	23	31	2	12" X 52"	340 LBS	60,000 GRAIN	1	24"x41"	670 LBS	1,400	ALL

ACCEPTABLE MANUFACTURERS: CULLIGAN CRUSADER MARLO WATTS
REMARKS:
1. REQUIRES 120V OUTLET WITHIN 12'
2. PROVIDED AND INSTALLED BY CONTRACTOR

WATER FILTER SCHEDULE

LABEL	EQUIPMENT SERVED	WATER LINE SIZE	VOLUME (GRAIN)	FLOW (GPM)	MANUFACTURER	MODEL	PRIMARY FILTER	SECONDARY FILTER	REMARKS
WF-1	POST-MIX	3/4"	50,000	5	ECOLAB	ECOLAB SINGLE HEAD FILTER (9320-2266)	ECO-T010 (9320-2198)	N/A	
WF-2	COFFEE	1/2"	50,000	5	ECOLAB	ECOLAB SINGLE HEAD FILTER (9320-2266)	ECO-T010 (9320-2198)	N/A	
WF-3	ICE MAKER	1/2"	75,000	7	ECOLAB	ECOLAB SINGLE HEAD FILTER (9320-2266)	ECO-T014S (9320-2258)	N/A	
WF-4	COMBI-OVEN	1/2"	50,000	5	ECOLAB	ECOLAB TWIN HEAD (9320-2267)	1014 - 14" (9320-2261) - 9,000 grain	ECO-T010S (9320-2256)	REQUIRES H+ION EXCHANGE

DOMESTIC WATER DEMAND


EQUIPMENT	TYPE OF SUPPLY CONTROL	QUANTITY	COLD WATER SUPPLY FIXTURE UNITS PER FIXTURE (WSFU)	HOT WATER SUPPLY FIXTURE UNITS PER FIXTURE (WSFU)	TOTAL WATER SUPPLY FIXTURE UNITS PER FIXTURE (WSFU)	TOTAL WATER SUPPLY FIXTURE UNITS (WSFU)
LAVATORY	FAUCET	2	0.75	0.75	1.00	2.00
WATER CLOSET (1.28 GPF)	FLUSH VALVE	2	6.00	0	6.00	12.00
BAR SINK	FAUCET	3	1.50	1.50	2.00	6.00
VEGETABLE SINK	FAUCET	2	1.50	1.50	2.00	4.00
SERVICE SINK	FAUCET	1	2.25	2.25	3.00	3.00
BEVERAGE DISPENSER	VALVE	3	0.5	0	0.5	1.50
HOSE BIBB	VALVE	1	2.50	0	2.50	2.50
ADDITIONAL HOSE BIBB	VALVE	1	1.50	1.50	2.00	2.00
OTHER KITCHEN FAUCETS	FAUCET	3	1.50	1.50	2.00	6.00
			TOTAL COLD	TOTAL HOT		
			33.25	17.25		
			TOTAL (WSFU):		39.0	
			2021 INTERNATIONAL PLUMBING CODE - TABLE E103.3(3) ESTIMATED PEAK DEMAND (GPM):		26.3	
			PIPE SIZE (COLD WATER SUPPLY TO BUILDING):		1-1/4"	
			2021 INTERNATIONAL PLUMBING CODE - FIGURE E103.3(5) PIPE FRICTION (PSI / 100 FT):		4.0	
			PIPE VELOCITY (FEET / SECOND):		5.0	

NATURAL GAS REQUIREMENTS

EQUIPMENT	QUANTITY	SEA LEVEL FUEL GAS INPUT CAPACITY (BTUH)	JOB SITE FUEL GAS REQUIREMENTS (CFH)	TOTAL FUEL GAS CAPACITY (CFH)	BRANCH PIPE SIZES - EACH PIECE OF EQUIP. (INCHES)
SOUTHBOUND DOUBLE OVEN	1	108,000	108	108	3 PSI @ 500 FT. 1/2" 4 OZ @ 10 FT.
VULCAN RANGE	1	215,000	215	215	1/2" 3/4"
GARLAND RANGE	1	358,000	358	358	3/4" 1"
TILTING SKILLET	1	125,000	125	125	1/2" 3/4"
VULCAN FRYER	2	120,000	120	240	1/2" 3/4"
COMBI OVEN	1	83,500	83.5	83.5	1/2" 3/4"
PATIO HEATER	5	50,000	50	250	1/2" 3/4"
WATER HEATER	1	100,000	100	100	1/2" 3/4"
KMAU	1	391,000	391	391	3/4" 1"
GAS DUCT HEATER	1	250,000	250	250	1/2" 3/4"
TOTAL			---	2,120.5	1 1/4"


NOTE: KITCHEN EQUIPMENT SHOULD COME WITH PRESSURE REGULATOR FROM MANUFACTURER.

PIPE SIZE	MAX CFH AT 500 FT. @ 3 PSI DELIVERY PRESSURE, WITH 2 PSI PRESSURE DROP
1/2"	283
3/4"	593
1"	1,120
1 1/4"	2,290

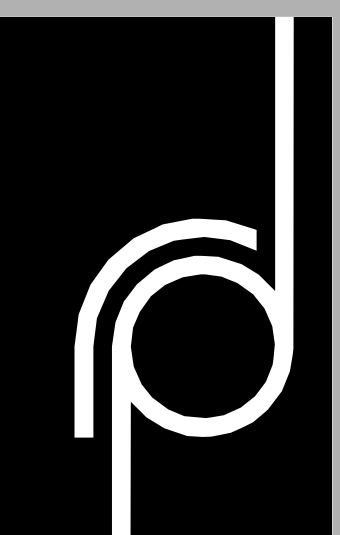

THE RICHARDSON DESIGN PARTNERSHIP, L.L.C.

610 South 600 East
Salt Lake City, Utah 84102
P: 801.355.6886
F: 801.355.6880

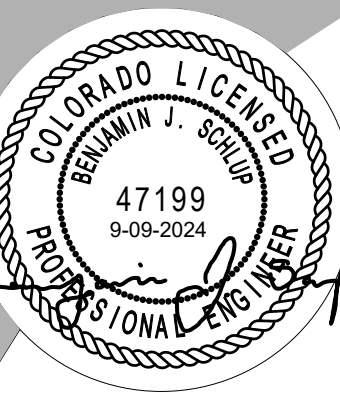

THE ABOVE DESIGN, SPECIFICATION AND CALCULATION ARE THE PROPERTY OF SPECTRUM ENGINEERS, L.L.C. NO PART OF THIS DOCUMENT IS TO BE REPRODUCED OR TRANSMITTED IN ANY FORM OR BY ANY MEANS, ELECTRONIC OR MECHANICAL, INCLUDING PHOTOCOPYING, RECORDING, OR BY ANY INFORMATION STORAGE AND RETRIEVAL SYSTEM, WITHOUT THE WRITTEN PERMISSION OF SPECTRUM ENGINEERS, L.L.C.


SPECTRUM ENGINEERS

324 S. State St., Suite 400
Salt Lake City, UT 84111
800-678-7077
801-328-5151
fax: 801-328-5155
www.spectrum-engineers.com

Reviewed for Code Compliance
10/07/2024
CONSULTANT


SERAC CAPITAL PARTNERS, LLC
5051 WESTHEIMER RD. SUITE 1750
HOUSTON, TX 77056

OWNER:</

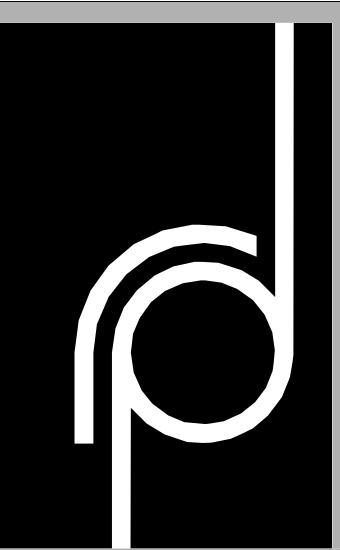

THE RICHARDSON DESIGN PARTNERSHIP, L.L.C.

510 South 600 East
Salt Lake City, Utah 84112
P: 801.355.6886
F: 801.355.6880

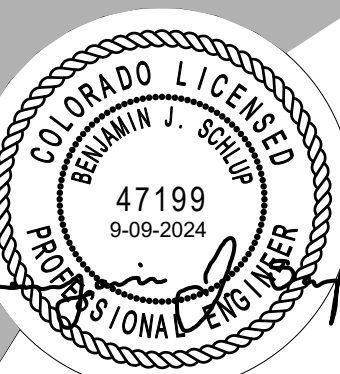

ALL WORK SHALL BE DONE IN ACCORDANCE WITH THE 2018 INTERNATIONAL MECHANICAL AND ELECTRICAL CODE (IMC) AND THE 2017 NATIONAL ELECTRICAL CODE (NEC) AS AMENDED BY THE STATE OF COLORADO. THE CONTRACTOR SHALL BE RESPONSIBLE FOR OBTAINING ALL NECESSARY PERMITS AND INSURANCE. THE DESIGNER SHALL NOT BE RESPONSIBLE FOR THE CONSTRUCTION OF THE PROJECT.

SPECTRUM
ENGINEERS, ARCHITECTS & PLANNERS
324 S. State St., Suite 400
Salt Lake City, UT 84111
800-678-7077
801-328-5151
fax: 801-328-5155
www.spectrum-engineers.com

Reviewed for Code Compliance
10/07/2024
CONSULTANT

SERAC CAPITAL PARTNERS, LLC
OWNER
5051 WESTHEIMER RD. SUITE 1750
HOUSTON, TX 77056

CENTRAL PARK RESTAURANT T.I.
PROJECT
1760 Central Park Dr.
Steamboat Springs, CO

ISSUE DATE	DESCRIPTION
06/17/2024	
REV. DATE	DESCRIPTION
09/10/24	Owner Revisions


PERMIT SET
LEVEL 1 PLUMBING PLAN - DWG
RPL101
PROJECT #: 2023
DRAWN BY: GBT
CHECKED BY: SS

GENERAL SHEET NOTES

- THIS CONTRACTOR SHALL CLOSELY COORDINATE MECHANICAL AND PLUMBING WITH KITCHEN EQUIPMENT, ELECTRICAL, ARCHITECTURAL AND BUILDING STRUCTURE.
- DISSIMILAR METAL PIPING CONNECTIONS SHALL HAVE DIELECTRIC ISOLATORS.
- ALL PLUMBING PIPING TO BE LOCATED ON WARM SIDE OF BUILDING ENVELOPE. ALL ROOF DRAIN PIPING (PRIMARY AND SECONDARY) TO BE LOCATED IN BUILDING ENVELOPE AND TO BE FULLY INSULATED, INCLUDING ANY ROOF DRAIN BOWLS.
- THE CONTRACTOR SHALL FIELD VERIFY EXISTING FIELD CONDITIONS PRIOR TO ORDERING OR FABRICATING. ADDITIONAL COST WILL NOT BE ALLOWED FOR CONTRACTORS FAILURE TO BECOME FAMILIAR WITH EXISTING SITE CONDITIONS.
- TEST WASTE AND VENT PIPING FOR LEAKAGE AFTER PLUMBING FIXTURES HAVE BEEN SET AND TRAPS FILLED WITH WATER. TEST CONNECTIONS AND PROVE THEY ARE GASTIGHT AND WATERTIGHT. PLUG VENT-STACK OPENINGS ON ROOF AND BUILDING DRAINS WHERE THEY LEAVE BUILDING. FOR CAST IRON, INTRODUCE AIR INTO PIPING SYSTEM EQUAL TO PRESSURE OF 1-INCH WG. USE U-TUBE OR MANOMETER INSERTED IN TRAP OF WATER CLOSET TO MEASURE THIS PRESSURE. AIR PRESSURE MUST REMAIN CONSTANT WITHOUT INTRODUCING ADDITIONAL AIR THROUGHOUT PERIOD OF INSPECTION. FOR PLASTIC PIPING PERFORM WATER TEST WITH NO LESS THAN 10' OF HEAD OF WATER. INSPECT PLUMBING FIXTURE CONNECTIONS FOR GAS AND WATER LEAKS. REPAIR LEAKS AND DEFECTS WITH NEW MATERIALS AND RETEST PIPING, OR PORTION THEREOF, UNTIL SATISFACTORY RESULTS ARE OBTAINED. PREPARE REPORTS FOR TESTS AND REQUIRED CORRECTIVE ACTION.
- FLOOR SINKS SHALL BE INSTALLED IN AN ACCESSIBLE LOCATION, WHERE POSSIBLE INSTALL FLOOR SINKS TIGHT TO WALLS.
- ALL EMERGENCY FLOOR SINKS/ FLOOR DRAINS ARE TO HAVE PREVENT-TRAP GUARDS (WHERE APPROVED BY AHJ), ANY DRAIN THAT IS USED TO COLLECT CONDENSATES SHALL NOT REQUIRE TRAP PROTECTION.
- PLUMBING CONTRACTOR SHALL ROUTE INDIRECT DRAINS FROM KITCHEN EQUIPMENT TO NEAREST FLOOR SINK. TERMINATE WITH AN AIR GAP.
- ALL INDIRECT WASTE PIPING THAT EXCEEDS 30' IN DEVELOPED LENGTH MEASURED HORIZONTALLY OR 54' IN TOTAL DEVELOPED LENGTH SHALL BE TRAPPED.
- PAINT ANY EXPOSED CAST IRON PIPING.
- PLUMBING CONTRACTOR SHALL COORDINATE FIXTURE CONNECTION ELEVATIONS WITH KITCHEN EQUIPMENT PLANS.
- ANY PIPING WHICH PENETRATES A COUNTER TOP SHALL BE ROUTED THROUGH A STAINLESS STEEL GROMMET WHICH IS TO BE ADHERED TO THE COUNTER TOP WITH A CLEAR, NON-SHRINKING, MILDEW RESISTANT SILICONE.
- ALL ACCESS COVERS IN RESTROOMS TO BE LOCATED BENEATH SINKS OR ADJACENT TO TOILETS, HIDDEN FROM VIEW WHERE POSSIBLE. ANY ACCESS COVERS OUTSIDE OF THESE REQUIREMENTS SHALL BE STAINLESS STEEL.
- COORDINATE ANY NECESSARY SAW CUTTING, BACKFILL, AND NEW CONCRETE WITH GENERAL.
- PROVIDE A SAND BED WITH SIX (6") INCHES MINIMUM COVERAGE AROUND ALL BELOW GRADE PIPES. PROVIDE BACKFILL FREE OF Boulders LARGER THAN TWO (2") INCHES, COMPACT AND TEST ALL BACKFILL ACCORDING TO ASTM COMPACTION STANDARDS OR PROVIDE PEA GRAVEL BACKFILL. PROVIDE MINIMUM TRENCH WIDTH OF NOT LESS THAN 1.5 TIMES THE PIPE OUTSIDE DIAMETER PLUS 12 INCHES.
- PIPING SHALL NOT BE SUPPORTED FROM THE ROOF DECK, JOIST BRIDGING OR OTHER PIPES. HANG PIPES FROM BEAMS, JOIST OR SUPPLEMENTARY STRUCTURAL MEMBERS, WHERE POSSIBLE INSTALL ALL PIPING WITHIN 12" FROM SUPPORTING STRUCTURE.
- WHERE JURISDICTION REQUIRES, THE CONTRACTOR IS RESPONSIBLE FOR PROVIDING SEISMIC RESTRAINT. PROVIDE DESIGN DRAWINGS TO AUTHORITY HAVING JURISDICTION AND MECHANICAL ENGINEER FOR REVIEW.
- ALL PIPING THROUGH A FOUNDATION WALL OR UNDER A FOOTING TO BE PROVIDED WITH PIPE SLEEVE 2 PIPE SIZES LARGER THAN PIPE PASSING THROUGH WALL OR UNDER FOOTING. SEAL WITH CALK OR FOAM. PIPE SLEEVE UNDER FOOTING TO BE A MINIMUM OF 2" BELOW FOOTING. PIPE TO BE IRON AND EXTEND BEYOND THE WIDTH OF THE FOOTING AT A 45 DEGREE ON BOTH SIDES OF FOOTING.
- PLUMBING PIPING SCHEDULE:
 - ROOF DRAIN, WASTE & VENT ABOVE GRADE = CAST IRON - HUBLESS COUPLINGS WITH HEAVY DUTY COUPLINGS
 - EXPOSED WASTE PIPING IN KITCHENS TO BE EPOXY COATED CAST IRON OR STAINLESS STEEL
 - ROOF DRAIN, WASTE & VENT BELOW GRADE = DWV SOLID CORE PVC - SOLVENT CEMENT
- PROVIDE OPERATION AND MAINTENANCE MANUALS (OMM) WITHIN 30 DAYS OF CERTIFICATE OF OCCUPANCY FOR ALL EQUIPMENT IN DIGITAL FORMAT TO ENGINEER FOR REVIEW. OMM'S SHALL INCLUDE DOCUMENTATION OF ALL WARRANTIES, REPORTS AND TESTS, RECORD DRAWINGS, CONTROLS SEQUENCE OF OPERATIONS WITH DIAGRAMS, & EQUIPMENT INFORMATION. EQUIPMENT INFORMATION INCLUDES MAKE & MODEL, WIRING, PIPING, STARTUP, SHUTDOWN, TROUBLE SHOOTING, AND MAINTENANCE PROCEDURES.
- HVAC DUCTS WITH A DISTRIBUTED WEIGHT GREATER THAN 20LBS/FT, OR THAT HAVE CROSS SECTIONAL AREA 6 SQ FT OR GREATER REQUIRE SEISMIC RESTRAINT. IN ADDITION, DUCT CONVEYING HAZARDOUS MATERIAL, PIPES (OTHER THAN NATURAL GAS, MEDICAL STEAM OR HIGH PRESSURE HOT WATER PIPING) THAT ARE 3" DIAMETER TRADE SIZE OR GREATER THAT ARE SUSPENDED MORE THAN 12" FROM SUPPORTING STRUCTURE REQUIRE SEISMIC RESTRAINTS. PIPES WITH A DIAMETER OF 3" TRADE SIZE OR GREATER SUSPENDED LESS THAN 12" FROM SUPPORT THAT EXCEED A TOTAL LOAD SUPPORTED BY A ANY SINGLE VERTICAL ROD IN EXCESS OF 100 POUNDS REQUIRE SEISMIC RESTRAINT. ALL OTHER DUCTWORK AND PIPING IS EXEMPT FROM SEISMIC BRACING. CONTRACTOR SHALL BE RESPONSIBLE FOR SEISMICALLY RESTRAINING SUCH DUCTS & PIPES, IN ACCORDANCE WITH THE CONTRACT DOCUMENTS. CONTRACTOR SHALL PROVIDE SHOP DRAWINGS AND PRODUCT DATA BASED ON THE NONSTRUCTURAL SEISMIC BRACING NOTES, DRAWINGS AND DETAILS PROVIDED IN THE CONTRACT DOCUMENTS FOR REVIEW BY SEISMIC BRACING ENGINEER.


SHEET KEYNOTES

- TERMINATE WASTE LINE FOR KITCHEN SINK INDIRECTLY AT FLOOR SINK WITH 2" AIR GAP
- CONNECT NEW SANITARY SEWER TO EXISTING SANITARY SEWER
- CONNECT NEW GREASE WASTE TO EXISTING GREASE WASTE
- ROUTE 3/4" COPPER CONDENSATE LINE FROM HVAC FAN COIL TO FLOOR SINK. DRAIN PIPE INDIRECTLY AT FLOOR SINK WITH AIR GAP. PROVIDE/INSTALL CONDENSATE PUMP AS NECESSARY.
- PROVIDE PVC INDIRECT DRAIN PIPE FROM DISHWASHER TO FLOOR SINK. VERIFY IF DISHWASHER IS BEING PROVIDED WITH NEW DRAIN WATER TEMPERING SYSTEM. IF NOT, PROVIDE AND INSTALL NEW DRAIN WATER TEMPERING SYSTEM (DRAPE KOOLER OR EQUAL). CONNECT PVC DRAIN PIPE FROM DISHWASHER TO DRAPE KOOLER TO REDUCE WASTE DISCHARGE TEMPERATURE TO BELOW 140°F. TERMINATE DRAIN PIPE WITH 2" AIR GAP ABOVE FLOOR SINK.
- EXISTING 4" GREASE WASTE INTO TENANT SPACE. GREASE WASTE DRAINS TO GS-250 HYDRO-MECHANICAL GREASE INTERCEPTOR. SEE CIVIL PLANS FOR LOCATION OF GREASE INTERCEPTOR.
- EXISTING 6" SANITARY SEWER THROUGH TENANT SPACE PER SHELL PLANS. FIELD VERIFY EXACT PIPE ROUTING
- PROVIDE 3/4" COPPER CONDENSATE DRAIN PIPING FROM WALK-IN COOLER FAN COIL TO FLOOR SINK. COORDINATE FAN COIL LOCATION WITH WALK-IN COOLER MANUFACTURER. LOCATION SHOWN HERE IS NOT ACCURATE - SHOWN FOR REFERENCE ONLY.
- HARD PIPE COPPER DRAIN LINE FROM HOT FOOD WELL TO FLOOR SINK. TERMINATE INDIRECTLY WITH 1" AIR GAP
- UNDERGROUND WASTE PIPING CONTINUES TO REST OF HOTEL.
- ROUTE COPPER DRAIN PIPE FROM ICE MACHINE TO FLOOR SINK. TERMINATE WITH APPROVED AIR GAP.
- 3" VENT THROUGH ROOF UP THROUGH PLUMBING CHASE ON LEVELS ABOVE TO ROOF.
- COMMON VENT PER IPC SECTION 911.
- ROUTE DRAIN FROM BEER COOLER FAN COIL TO FLOOR SINK UNDER ICE MACHINE.

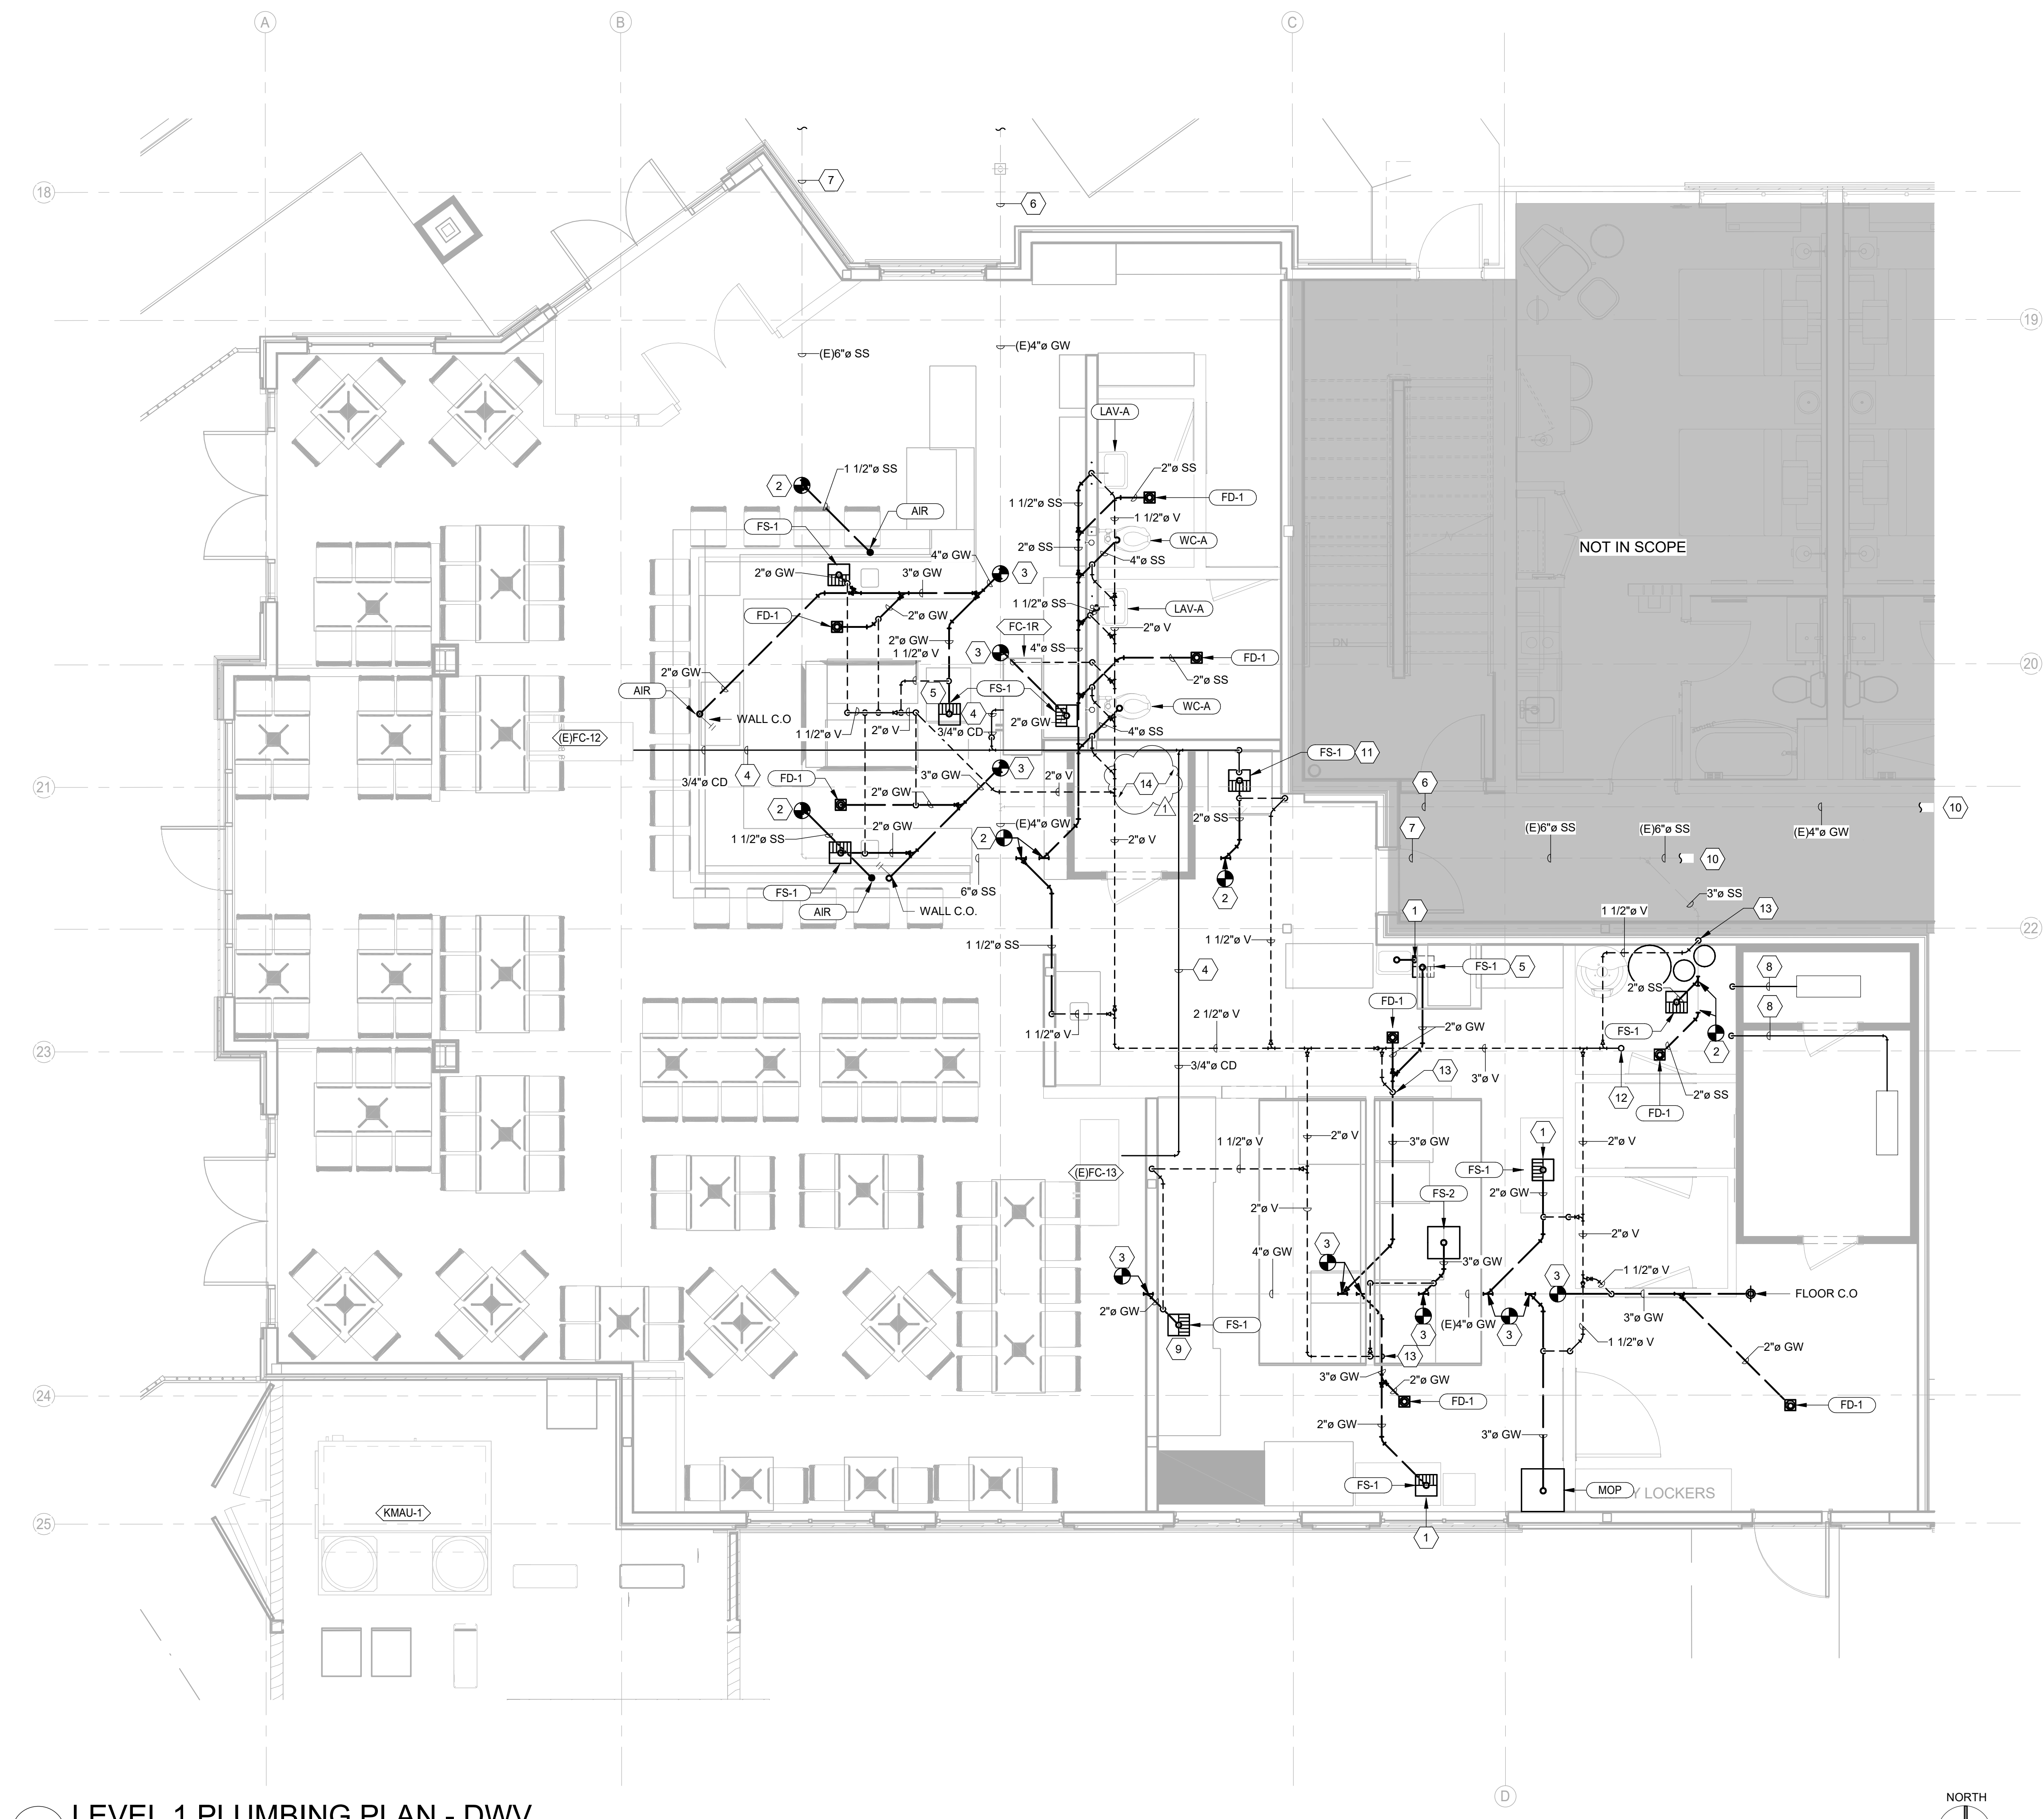


1 LEVEL 1 PLUMBING PLAN - DWG
SCALE: 1/4" = 1'-0"

08/2024 9:14:05 PM
Arched.Dwg (2/1/2024) S:\S - Steamboat Springs CO\202307 - Steamboat Springs Restaurant

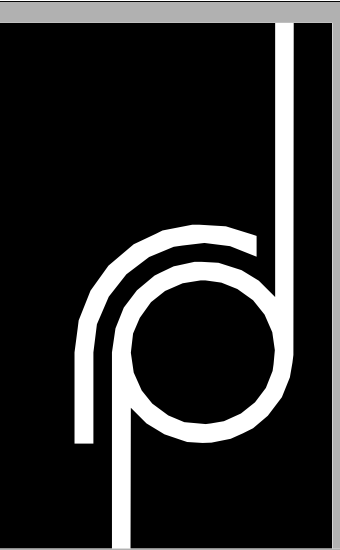

THE RICHARDSON DESIGN PARTNERSHIP, L.L.C.
 510 South 600 East
 Salt Lake City, Utah 84102
 P: 801.355.6886
 F: 801.355.6880

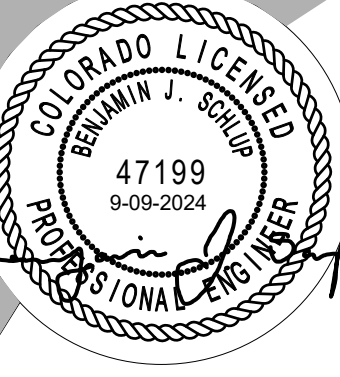

SPECTRUM
 1101 G. I. N. E. S.
 324 S. State St., Suite 400
 Salt Lake City, UT 84111
 800-678-7077
 801-328-9151
 fax: 801-328-5155
 www.spectrum-engineers.com

Reviewed for Code Compliance
 10/07/2024
 CONSULTANT

SERAC CAPITAL PARTNERS, LLC
 5051 WESTHEIMER RD. SUITE 1750
 HOUSTON, TX 77056


CENTRAL PARK RESTAURANT T.I.
 1760 Central Park Dr.
 Steamboat Springs, CO

ISSUE DATE	DESCRIPTION
06/17/2024	
09/10/24	Owner Revisions

PROJECT #	DATE	BY	CHECKED BY
RPL102	10/07/2024	DR	SR


PERMIT SET
 LEVEL 1 PLUMBING PLAN - WATER
 RPL102

GENERAL SHEET NOTES	GENERAL SHEET NOTES	GENERAL SHEET NOTES
<ol style="list-style-type: none"> ALL DOMESTIC WATER PIPING TO BE COPPER. ALL HOT WATER AND HOT WATER RECIRCULATING PIPING TO BE INSULATED WITH 1" UP TO 1-1/4" PIPE AND 1-1/2" INSULATION FOR PIPING 1-1/2" AND LARGER. DOMESTIC COLD WATER PIPING TO BE INSULATED WITH 1/2" UP TO 1-1/4" PIPE AND 1" INSULATION FOR PIPING 1-1/2" OR LARGER. THIS CONTRACTOR SHALL CLOSELY COORDINATE MECHANICAL AND PLUMBING WITH KITCHEN EQUIPMENT, ELECTRICAL, ARCHITECTURAL AND BUILDING STRUCTURE. DISSIMILAR METAL PIPING CONNECTIONS SHALL HAVE DIELECTRIC ISOLATORS. ALL DOMESTIC WATER PIPING TO BE PRESSURE TESTED, CLEANED, AND DISINFECTED. PRESSURE TEST: CAP AND SUBJECT PIPING TO STATIC WATER PRESSURE OF 120 PSIG FOR FOUR HOURS. LEAKS AND LOSS IN TEST PRESSURE CONSTITUTE DEFECTS THAT MUST BE REPAIRED. PROVIDE RESULTS IN WRITTEN REPORT TO ENGINEER UPON COMPLETION. CLEAN AND DISINFECT. FLUSH PIPING SYSTEM. FILL SYSTEM WITH WATER/CHLORINE SOLUTION WITH AT LEAST 50 PPM OF CHLORINE FOR 24 HOURS. THOROUGHLY FLUSH SYSTEM. SUBMIT WATER SAMPLES IN STERILE BOTTLES TO AUTHORITIES HAVING JURISDICTION. PROVIDE REPORT TO ENGINEER STATING PROCEDURE FOLLOWED AND SIGNATURES OF GC AND THAT OF PERSONS PERFORMING PROCEDURE. BALL VALVES SHALL BE FULL PORT AND LEAD FREE. PROVIDE WITH HANDLE/STEM EXTENSIONS FOR PROPER FUNCTION WHEN FULLY INSULATED. EXTENSIONS TO BE SEALED AND VAPOR PROOF. ALL PLUMBING PIPING TO BE LOCATED ON WARM SIDE OF BUILDING ENVELOPE. ALL ROOF DRAIN PIPING (PRIMARY AND SECONDARY) TO BE LOCATED IN BUILDING ENVELOPE AND TO BE FULLY INSULATED, INCLUDING ANY ROOF DRAIN BOWLS. 	<ol style="list-style-type: none"> WATER HAMMER ARRESTORS SHALL BE SIZED AND INSTALLED PER PLUMBING AND DRAINAGE INSTITUTE (STANDARD PD-HW 201) REQUIREMENTS IN ACCESSIBLE LOCATIONS ON THE COLD WATER AND HOT WATER PIPING WHERE FLUSH VALVES OR QUICK CLOSING VALVES ARE USED. PROVIDE BALANCE REPORT OF DOMESTIC WATER RECIRCULATING SYSTEM TO ENGINEER. PROVIDE P&T PORTS AND PRESSURE GAUGES ON EACH SIDE OF RECIRCULATING PUMP. PROVIDE THERMOMETER ON DISCHARGE SIDE OF PUMP. THE CONTRACTOR SHALL FIELD VERIFY EXISTING FIELD CONDITIONS PRIOR TO ORDERING OR FABRICATING. ADDITIONAL COST WILL NOT BE ALLOWED FOR CONTRACTOR'S FAILURE TO BECOME FAMILIAR WITH EXISTING SITE CONDITIONS. COORDINATE ANY NECESSARY SAW CUTTING, BACKFILL, AND NEW CONCRETE WITH GENERAL. PROVIDE A SAND BED WITH SIX (6) INCHES MINIMUM COVERAGE AROUND ALL BELOW GRADE PIPES. PROVIDE BACKFILL FREE OF BOULDERS LARGER THAN TWO (2) INCHES. COMPACT AND TEST ALL BACKFILL ACCORDING TO ASTM COMPACTION STANDARDS OR PROVIDE FEA GRAVEL BACKFILL. PROVIDE MINIMUM TRENCH WIDTH OF NOT LESS THAN 1.5 TIMES THE PIPE OUTSIDE DIAMETER PLUS 12 INCHES. PIPING SHALL NOT BE SUPPORTED FROM THE ROOF DECK, JOIST BRIDGING OR OTHER PIPES. HANG PIPES FROM BEAMS, JOIST OR SUPPLEMENTARY STRUCTURAL MEMBERS, WHERE POSSIBLE INSTALL ALL PIPING WITHIN 12" FROM SUPPORTING STRUCTURE. WHERE JURISDICTION REQUIRES, THE CONTRACTOR IS RESPONSIBLE FOR PROVIDING SEISMIC RESTRAINT. PROVIDE DESIGN DRAWINGS TO AUTHORITY HAVING JURISDICTION AND MECHANICAL ENGINEER FOR REVIEW. 	<ol style="list-style-type: none"> ALL PIPING THROUGH A FOUNDATION WALL OR UNDER A FOOTING TO BE PROVIDED WITH PIPE SLEEVE 2 PIPE SIZES LARGER THAN PIPE PASSING THROUGH WALL OR UNDER FOOTING. SEAL WITH CALK OR FOAM. PIPE SLEEVE UNDER FOOTING TO BE A MINIMUM OF 2" BELOW FOOTING. PIPE TO BE IRON AND EXTEND BEYOND THE WIDTH OF THE FOOTING AT 45 DEGREE ON BOTH SIDES OF FOOTING. PLUMBING CONTRACTOR SHALL COORDINATE FIXTURE CONNECTION ELEVATIONS WITH KITCHEN EQUIPMENT PLANS. PIPE ROUTING AS SHOWN ON DRAWINGS IS DIAGRAMMATIC AND IS NOT TO BE SCALED. WHERE ALTERNATE ROUTING, OFFSETS AND TRANSITIONS ARE REQUIRED FOR COORDINATION OF WORK, THIS CONTRACTOR SHALL MAKE CHANGES WITHOUT ADDITIONAL COSTS. WATER LINES FOR CARBONATED DRINK DISPENSING SHALL HAVE STAINLESS STEEL RPZ BACKFLOW PROTECTION. ALL TUBING / PIPING FOR DRINK DISPENSING EQUIPMENT SHALL BE NSF STAMPED. PROVIDE HOT / COLD WATER CHECK VALVES FOR ALL MOP SINKS, 3-COMPARTMENT SINKS, PREP SINKS, AND ANY SINK WITH AN OVERHEAD SPRAYER. ANY PIPING WHICH PENETRATES A COUNTER TOP SHALL BE ROUTED THROUGH A STAINLESS STEEL GROMMET WHICH IS TO BE ADHERED TO THE COUNTER TOP WITH A CLEAR, NON-SHRINKING, MILDEW RESISTANT SILICONE. MAIN DOMESTIC WATER PIPE ROUTING SHALL BE ABOVE CEILING. WHERE DROPS OCCUR, PIPES SHALL BE CONCEALED INSIDE WALLS. INSPECTION AND PERMIT BY STATE OR COUNTY HEALTH DEPARTMENT IS REQUIRED FOR CHEMICAL DISPENSER STATIONS. ALL ACCESS COVERS IN RESTROOMS TO BE LOCATED BENEATH SINKS OR ADJACENT TO TOILETS. HIDDEN IN VIEW WHERE POSSIBLE. ANY ACCESS COVERS OUTSIDE OF THESE REQUIREMENTS SHALL BE STAINLESS STEEL. PLUMBING PIPING SCHEDULE: <ol style="list-style-type: none"> DOMESTIC WATER ABOVE GRADE= TYPE L COPPER - SOLDERED DOMESTIC WATER BELOW GRADE= TYPE K COPPER - SOLDERED PROVIDE OPERATION AND MAINTENANCE MANUALS (O&M) WITHIN 30 DAYS OF CERTIFICATE OF OCCUPANCY FOR ALL EQUIPMENT IN DIGITAL FORMAT TO ENGINEER FOR REVIEW. O&M'S SHALL INCLUDE DOCUMENTATION OF ALL WARRANTIES, REPORTS AND TESTS. RECORD DRAWINGS, CONTROLS SEQUENCE OF OPERATIONS WITH DIAGRAMS, & EQUIPMENT INFORMATION. EQUIPMENT INFORMATION INCLUDES MAKE & MODEL, WIRING, PIPING, STARTUP, SHUTDOWN, TROUBLE SHOOTING, AND MAINTENANCE PROCEDURES. HVAC DUCTS WITH A DISTRIBUTED WEIGHT GREATER THAN 20 LBS/FT, OR THAT HAVE CROSS SECTIONAL AREA 6 SQ FT OR GREATER REQUIRE SEISMIC RESTRAINT. IN ADDITION, DUCT CONVEYING HAZARDOUS MATERIAL, PIPES (OTHER THAN NATURAL GAS, MEDICAL GAS, STEAM OR HIGH PRESSURE HOT WATER PIPING) THAT ARE 3" DIAMETER TRADE SIZE OR GREATER THAT ARE SUSPENDED MORE THAN 12" FROM SUPPORTING STRUCTURE REQUIRE SEISMIC RESTRAINTS. PIPES WITH A DIAMETER OF 3" TRADE SIZE OR GREATER SUSPENDED LESS THAN 12" FROM SUPPORT THAT EXCEED A TOTAL LOAD SUPPORTED BY A SINGLE VERTICAL ROD IN EXCESS OF 100 POUNDS REQUIRE SEISMIC RESTRAINT (ALL OTHER DUCTWORK AND PIPING IS EXEMPT FROM SEISMIC BRACING). CONTRACTOR SHALL BE RESPONSIBLE FOR SEISMICALLY RESTRAINING SUCH DUCTS & PIPES, IN ACCORDANCE WITH THE CONTRACT DOCUMENTS. CONTRACTOR SHALL PROVIDE SHOP DRAWINGS AND PRODUCT DATA BASED ON THE NONSTRUCTURAL SEISMIC BRACING NOTES, DRAWINGS AND DETAILS PROVIDED IN THE CONTRACT DOCUMENTS FOR REVIEW BY SEISMIC BRACING ENGINEER.

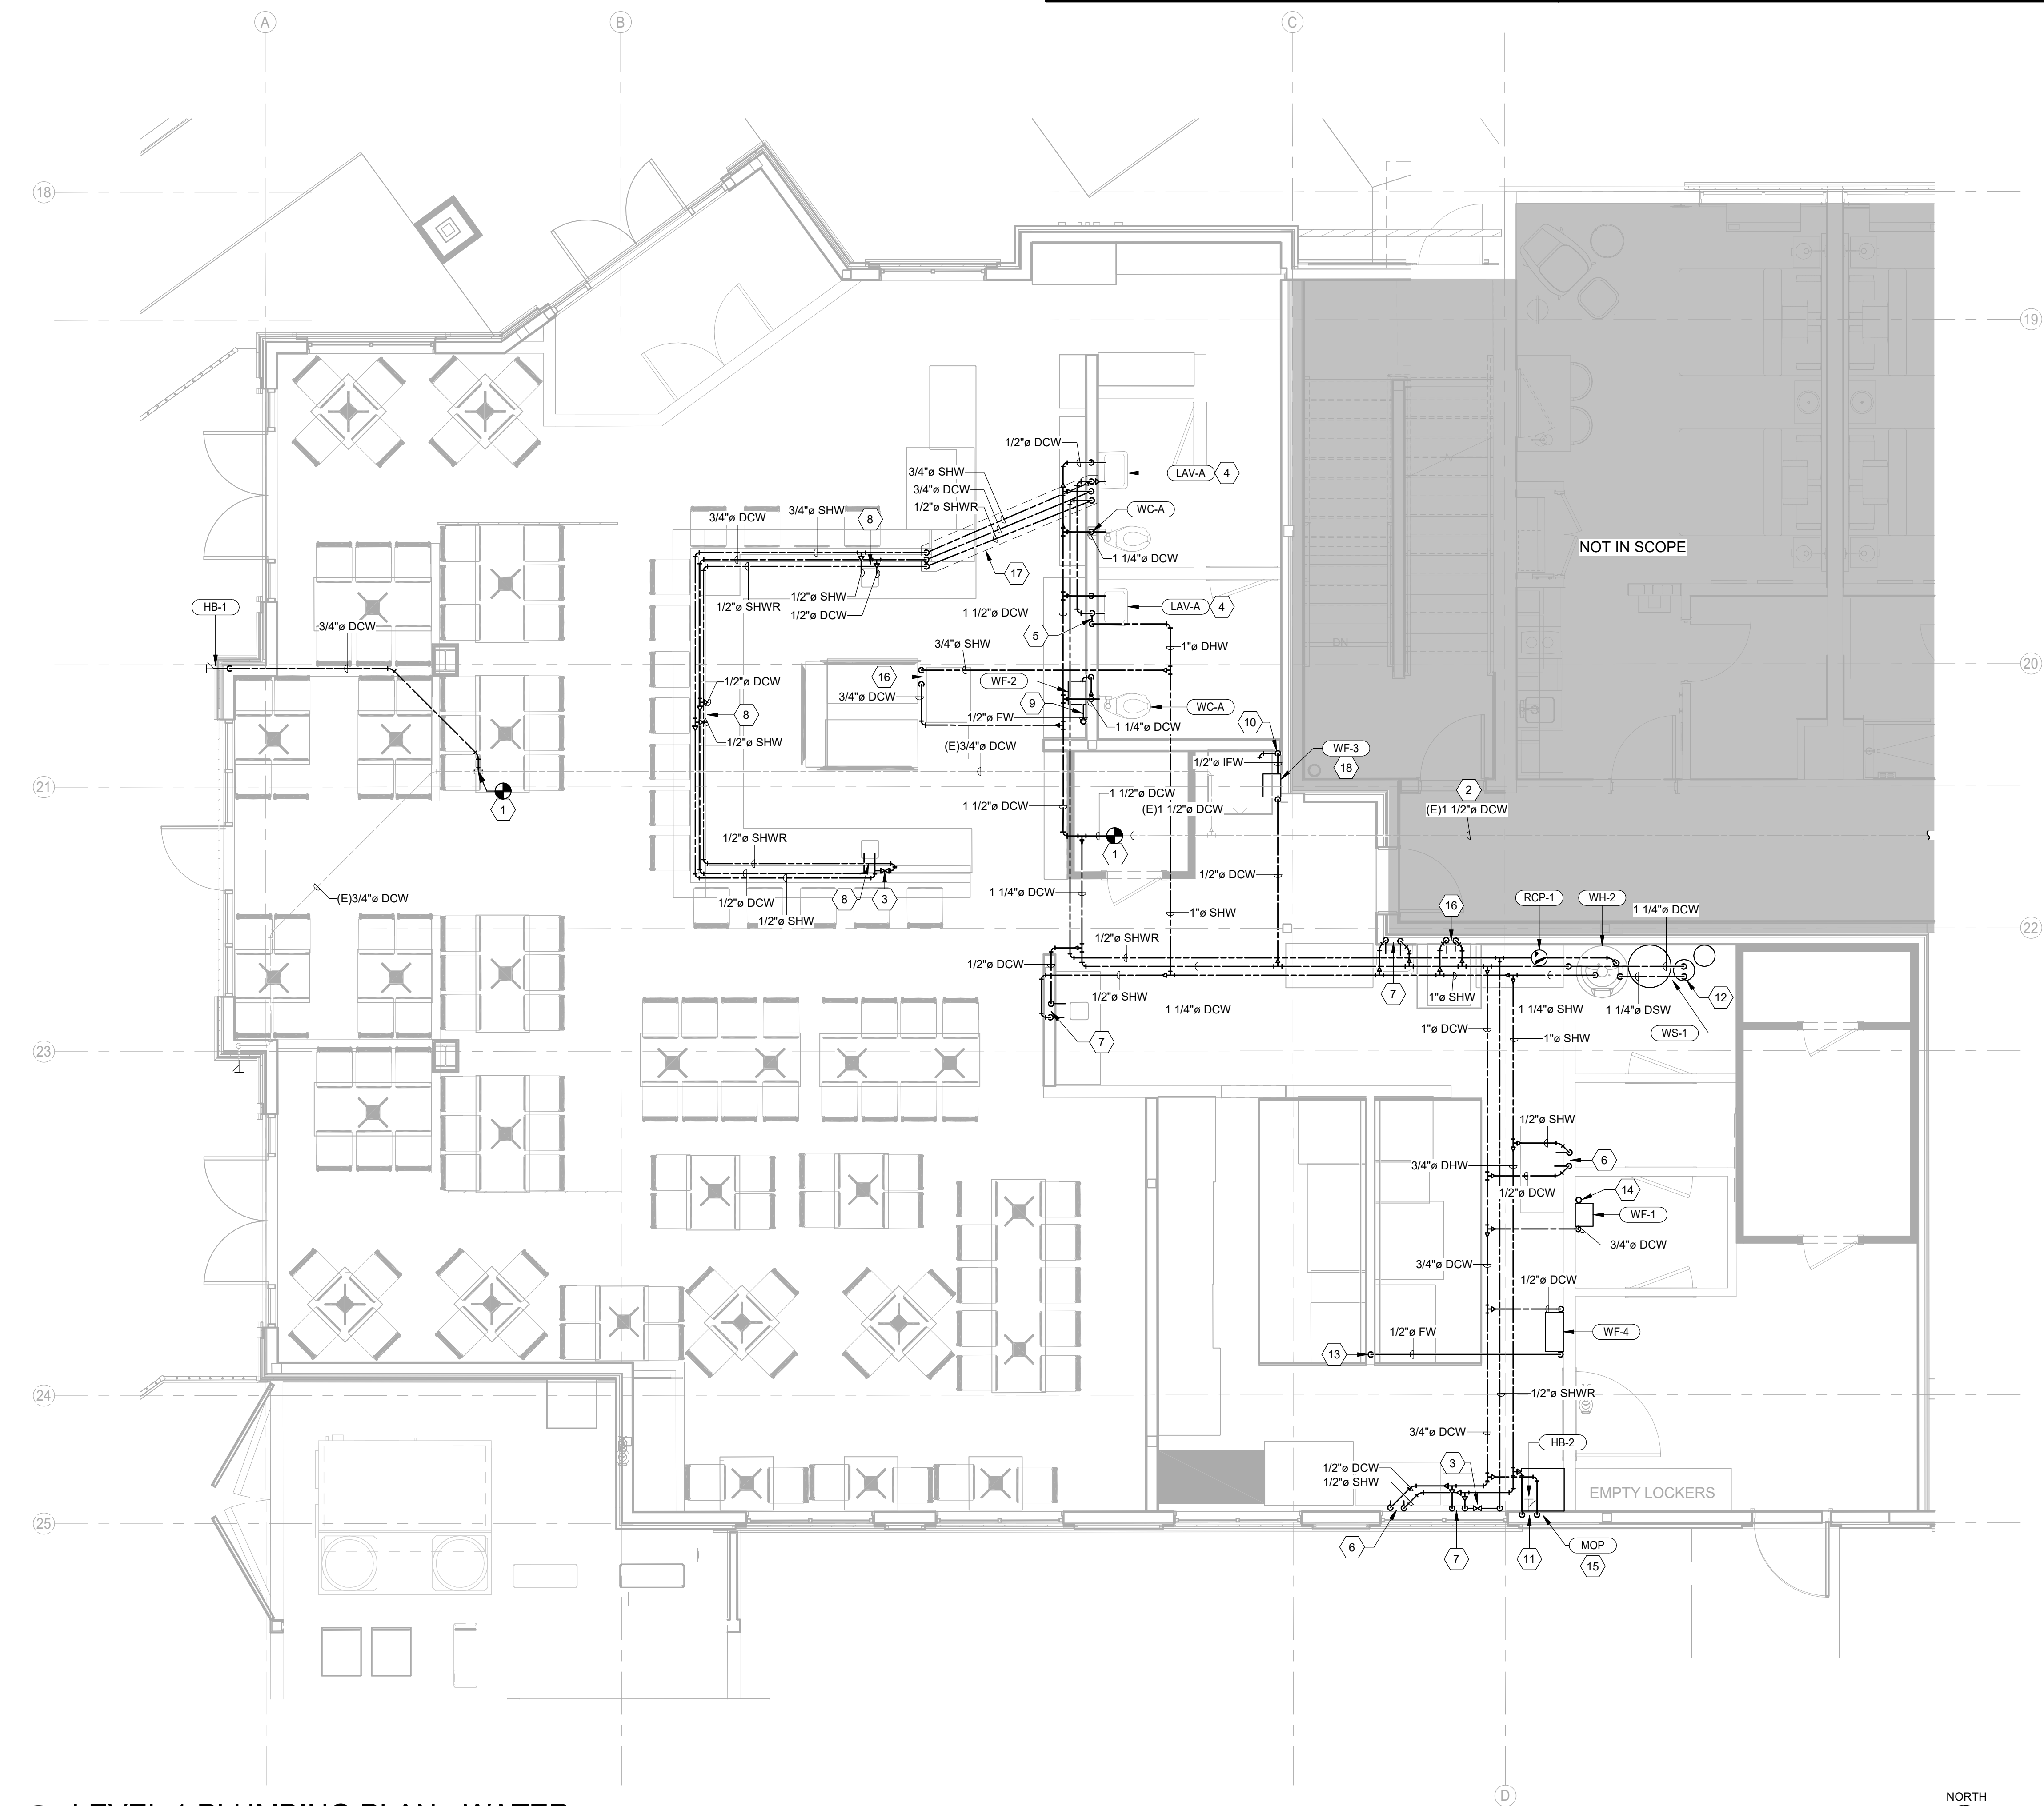


1 LEVEL 1 PLUMBING PLAN - WATER
 SCALE: 1/4" = 1'-0"

08/20/24, 9:11:13 AM
 Autodesk Docs (22770) SWS - Steamboat Springs Restaurant.txd

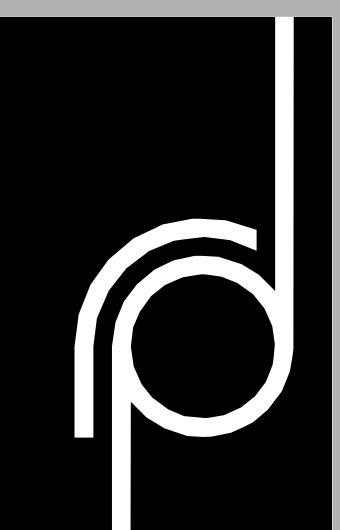

THE RICHARDSON DESIGN PARTNERSHIP, L.L.C.
 510 South 600 East
 Salt Lake City, Utah 84102
 P: 801.355.6886
 F: 801.355.6880

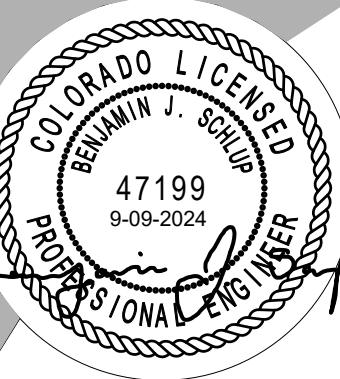

THE ABOVE DESIGN, SPECIFICATIONS AND/OR CALCULATIONS ARE THE PROPERTY OF SPECTRUM ENGINEERS, L.L.C. AND ARE NOT TO BE REPRODUCED, COPIED, OR TRANSMITTED IN ANY FORM OR BY ANY MEANS, ELECTRONIC OR MECHANICAL, WITHOUT THE WRITTEN PERMISSION OF SPECTRUM ENGINEERS, L.L.C.

SPECTRUM ENGINEERS, L.L.C.
 324 S. State St., Suite 400
 Salt Lake City, UT 84111
 800-678-7077
 801-328-5151
 fax: 801-328-5155
 www.spectrum-engineers.com

Reviewed for Code Compliance
 10/07/2024
 CONSULTANT

SERAC CAPITAL PARTNERS, LLC
 5051 WESTHEIMER RD. SUITE 1750
 HOUSTON, TX 77056
 OWNER:

CENTRAL PARK RESTAURANT T.I.
 1760 Central Park Dr.
 Steamboat Springs, CO
 PROJECT:

ISSUE DATE	DESCRIPTION
06/17/2024	
REV. DATE	DESCRIPTION
09/10/24	Owner Revisions


PERMIT SET
 LEVEL 1 PLUMBING PLAN - GAS
 PROJECT #: 2408
 DRAWN BY: GBT
 SHEET #: RPL103
 CHECKED BY: SSJ

GENERAL SHEET NOTES


- THIS CONTRACTOR SHALL CLOSELY COORDINATE MECHANICAL AND PLUMBING WITH KITCHEN EQUIPMENT, ELECTRICAL, ARCHITECTURAL AND BUILDING STRUCTURE.
- DISSIMILAR METAL PIPING CONNECTIONS SHALL HAVE DIELECTRIC ISOLATORS.
- ALL GAS PIPING ON ROOF TO BE ON ROLLER PIPE SUPPORT. PROVIDE RUBBER BASE OR EXTRA LAYER OF MEMBRANE UNDER EACH PIPE SUPPORT. ALL PIPE SUPPORTS TO BE A MAXIMUM OF 10' ON CENTER.
- RUN ALL GAS PIPING ABOVE CEILING INSIDE TRUSS WEBBING.
- ALL NATURAL GAS PIPING 2" AND OVER OR 1/2" AND OVER SHALL BE WELDED.
- PROVIDE A MARINE TOPSIDE BLACK PAINT (DTM ACRYLIC, COLOR P-6) ON ALL NEW GAS PIPING.
- INSTALL GAS REGULATORS APPROXIMATELY 10' UPSTREAM OF EQUIPMENT CONNECTION.
- ALL GAS PRESSURE REGULATORS ARE TO BE VENTED TO THE OUTSIDE OF THE BUILDING BY THE MECHANICAL CONTRACTOR OR PROVIDE /INSTALL VENTLESS REGULATORS IF ALLOWED BY THE LOCAL JURISDICTION. NONE OF THE VENT PIPING OFF THE REGULATORS ARE SHOWN ON THE PLANS. IF VENTED REGULATORS ARE REQUIRED, SIZE VENTS PER MANUFACTURERS RECOMMENDATION FOR THE GIVEN DISTANCE.
- THE CONTRACTOR SHALL FIELD VERIFY EXISTING FIELD CONDITIONS PRIOR TO ORDERING OR FABRICATING. ADDITIONAL COST WILL NOT BE ALLOWED FOR CONTRACTOR'S FAILURE TO BECOME FAMILIAR WITH EXISTING SITE CONDITIONS.
- COORDINATE ANY NECESSARY SAW CUTTING, BACKFILL, AND NEW CONCRETE WITH GENERAL.
- PROVIDE A SAND BED WITH SIX (6") INCHES MINIMUM COVERAGE AROUND ALL BELOW GRADE PIPES. PROVIDE BACKFILL FREE OF Boulders LARGER THAN TWO (2") INCHES. COMPACT AND TEST ALL BACKFILL ACCORDING TO ASTM COMPACTION STANDARDS OR PROVIDE PEA GRAVEL BACKFILL. PROVIDE MINIMUM TRENCH WIDTH OF NOT LESS THAN 1.5 TIMES THE PIPE OUTSIDE DIAMETER PLUS 12 INCHES.
- PIPING SHALL NOT BE SUPPORTED FROM THE ROOF DECK, JOIST BRIDGING OR OTHER PIPES. HANG PIPES FROM BEAMS, JOIST OR SUPPLEMENTARY STRUCTURAL MEMBERS, WHERE POSSIBLE INSTALL ALL PIPING WITHIN 12" FROM SUPPORTING STRUCTURE.
- WHERE JURISDICTION REQUIRES, THE CONTRACTOR IS RESPONSIBLE FOR PROVIDING SEISMIC RESTRAINT. PROVIDE DESIGN DRAWINGS TO AUTHORITY HAVING JURISDICTION AND MECHANICAL ENGINEER FOR REVIEW.
- ALL PIPING THROUGH A FOUNDATION WALL OR UNDER A FOOTING TO BE PROVIDED WITH PIPE SLEEVE 2 PIPE SIZES LARGER THAN PIPE PASSING THROUGH WALL OR UNDER FOOTING. SEAL WITH CAULK OR FOAM. PIPE SLEEVE UNDER FOOTING TO BE A MINIMUM OF 2" BELOW FOOTING. PIPE TO BE IRON AND EXTEND BEYOND THE WIDTH OF THE FOOTING AT A 45 DEGREE ON BOTH SIDES OF FOOTING.
- PLUMBING PIPING SCHEDULE:
 1. NATURAL GAS PIPING 2" AND SMALLER = SCHEDULE 40 BLACK STEEL PIPE - THREADED
 2. NATURAL GAS PIPING 2-1/2" AND LARGER = SCHEDULE 40 BLACK STEEL PIPE - WELDED
 3. NATURAL GAS PIPING BELOW GRADE = POLYETHYLENE PIPE - FUSION WELDED
 4. NATURAL GAS PIPING OVER 1" DIAMETER TRADE SIZE THAT IS SUSPENDED MORE THAN 12" FROM SUPPORTING STRUCTURE REQUIRES SEISMIC RESTRAINT. CONTRACTOR SHALL BE RESPONSIBLE FOR SEISMICALLY RESTRAINING SUCH PIPES, AND SUBMIT AS A DEFERRED SUBMITTAL THE CALCULATIONS BY A LICENSED STRUCTURAL ENGINEER IN THE STATE WHICH WORK IS PERFORMED TO THE AUTHORITY HAVING JURISDICTION. CONTRACTOR SHALL PROVIDE SHOP DRAWINGS AND PRODUCT DATA BASED ON THE NONSTRUCTURAL SEISMIC BRACING NOTES, DRAWINGS AND DETAILS PROVIDED IN THE CONTRACT DOCUMENTS FOR REVIEW BY ENGINEER.
- PROVIDE OPERATION AND MAINTENANCE MANUALS (O&M) WITHIN 30 DAYS OF CERTIFICATE OF OCCUPANCY FOR ALL EQUIPMENT IN DIGITAL FORMAT TO ENGINEER FOR REVIEW. O&M'S SHALL INCLUDE DOCUMENTATION OF ALL WARRANTIES, REPORTS AND TESTS, RECORD DRAWINGS, CONTROLS SEQUENCE OF OPERATIONS WITH DIAGRAMS, & EQUIPMENT INFORMATION. EQUIPMENT INFORMATION INCLUDES MAKE & MODEL, WIRING, PIPING, STARTUP, SHUTDOWN, TROUBLE SHOOTING, AND MAINTENANCE PROCEDURES.
- NATURAL GAS PIPING OVER 1" DIAMETER TRADE SIZE THAT IS SUSPENDED MORE THAN 12" FROM SUPPORTING STRUCTURE REQUIRES SEISMIC RESTRAINT. CONTRACTOR SHALL BE RESPONSIBLE FOR SEISMICALLY RESTRAINING SUCH PIPES, AND SUBMIT AS A DEFERRED SUBMITTAL THE CALCULATIONS BY A LICENSED STRUCTURAL ENGINEER IN THE STATE WHICH WORK IS PERFORMED TO THE AUTHORITY HAVING JURISDICTION. CONTRACTOR SHALL PROVIDE SHOP DRAWINGS AND PRODUCT DATA BASED ON THE NONSTRUCTURAL SEISMIC BRACING NOTES, DRAWINGS AND DETAILS PROVIDED IN THE CONTRACT DOCUMENTS FOR REVIEW BY ENGINEER.
- HVAC DUCTS WITH A DISTRIBUTED WEIGHT GREATER THAN 20LBS/FT, OR THAT HAVE CROSS SECTIONAL AREA 6 SQ FT OR GREATER REQUIRE SEISMIC RESTRAINT. IN ADDITION, DUCT CONVEYING HAZARDOUS MATERIAL, PIPES (OTHER THAN NATURAL GAS, MEDICAL GAS, STEAM OR HIGH PRESSURE HOT WATER PIPING) THAT ARE 3" DIAMETER TRADE SIZE OR GREATER THAT ARE SUSPENDED MORE THAN 12" FROM SUPPORTING STRUCTURE REQUIRE SEISMIC RESTRAINTS. PIPES WITH A DIAMETER OF 3" TRADE SIZE OR GREATER SUSPENDED LESS THAN 12" FROM SUPPORT THAT EXCEED A TOTAL LOAD SUPPORTED BY A ANY SINGLE VERTICAL ROD IN EXCESS OF 100 POUNDS REQUIRE SEISMIC RESTRAINT (ALL OTHER DUCTWORK AND PIPING IS EXEMPT FROM SEISMIC BRACING). CONTRACTOR SHALL BE RESPONSIBLE FOR SEISMICALLY RESTRAINING SUCH DUCTS & PIPES, IN ACCORDANCE WITH THE CONTRACT DOCUMENTS. CONTRACTOR SHALL PROVIDE SHOP DRAWINGS AND PRODUCT DATA BASED ON THE NONSTRUCTURAL SEISMIC BRACING NOTES, DRAWINGS AND DETAILS PROVIDED IN THE CONTRACT DOCUMENTS FOR REVIEW BY SEISMIC BRACING ENGINEER.

SHEET KEYNOTES


- PROVIDE MECHANICAL TIMER AND EMERGENCY SHUTOFF SWITCH. AMERICAN FLAME E-STOP GAS TIMER OR EQUAL. MODEL ESTOPS-SH. TIMER AND SHUTOFF SWITCH SHALL BE MECHANICALLY OPERATED AND SHALL NOT REQUIRE AN ELECTRIFIED POWER SOURCE.
- NATURAL GAS PIPING TO WATER HEATER. PIPING IS AT 3 PSI PRESSURE TO PRESSURE REGULATOR. INSTALL SHUTOFF VALVE AND PRESSURE REGULATOR (3 PSI TO 4 OZ) ABOVE CEILING. PIPING ON SECONDARY SIDE OF REGULATOR IS 4 OZ. BRANCH 1/2" GAS PIPE TO WATER HEATER.
- EXISTING 1-1/4" GAS PIPE INTO TENANT SPACE. CONNECT NEW GAS PIPING TO EXISTING GAS STUB OUT ABOVE CEILING.
- INSTALL AUTOMATIC ANSUL GAS SHUTOFF AND MANUAL SHUTOFF BELOW CEILING PER CAPTIVEAIRE KITCHEN PLANS PRIOR TO GAS COOKING EQUIPMENT AT HOODS.
- 3/4" NATURAL GAS LINE TO KMAU. PIPING IS AT 3 PSI PRESSURE TO PRESSURE REGULATOR. INSTALL SHUTOFF VALVE AND PRESSURE REGULATOR (3 PSI TO 4 OZ). PIPING ON SECONDARY SIDE OF REGULATOR IS SIZE FOR 4 OZ PRESSURE.
- PROVIDE SHUTOFF VALVE, PRESSURE REGULATOR (3 PSI TO 4 OZ), MOVABLE GAS CONNECTOR KIT, QUICK DISCONNECT, AND ALL FINAL CONNECTIONS PER MANUFACTURER INSTALLATION INSTRUCTIONS FOR ALL GAS-FIRED EQUIPMENT.
- 1/2" NATURAL GAS LINE TO DUCT HEATER. PIPING IS AT 3 PSI PRESSURE TO PRESSURE REGULATOR. INSTALL SHUTOFF VALVE AND PRESSURE REGULATOR (3 PSI TO 4 OZ). PIPING ON SECONDARY SIDE OF REGULATOR IS 1/2" 4 OZ. GAS PIPING.
- GAS LINE IS TO BE STUBBED INTO A CONCRETE ACCESS BOX.

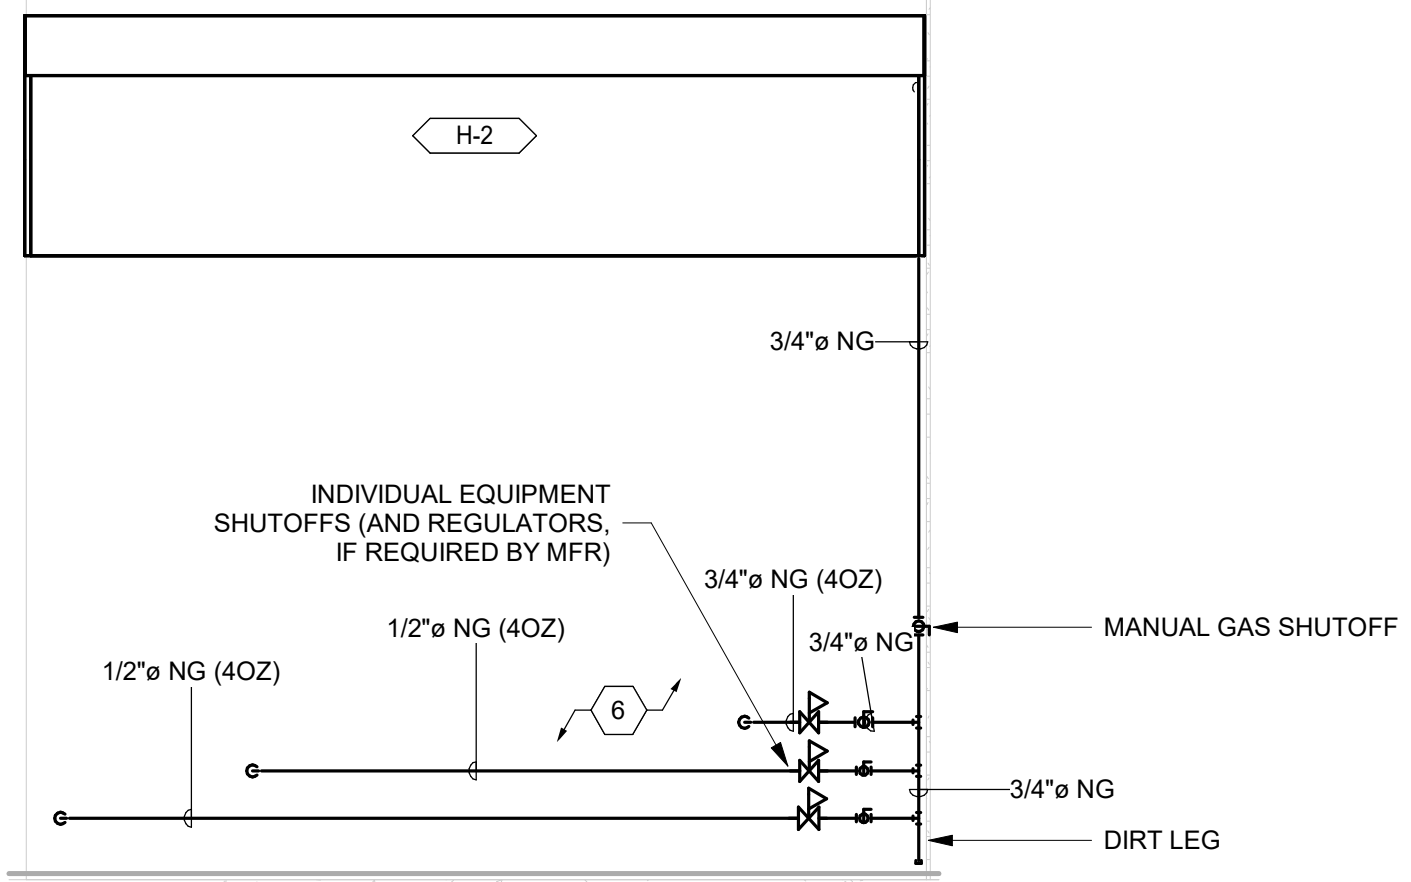


3 HOOD "H-2" GAS PIPING
 SCALE: NTS

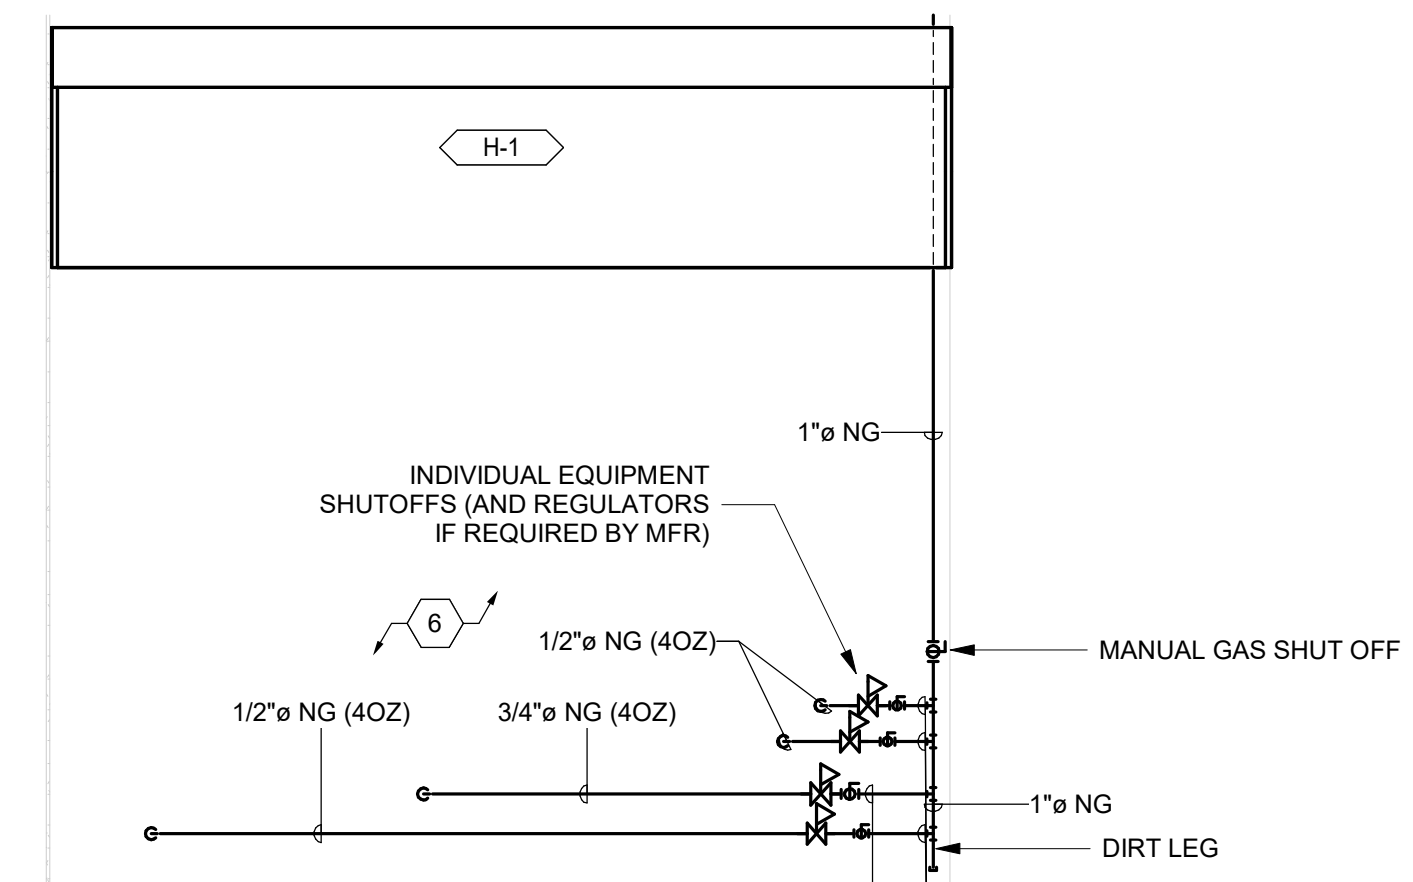


2 HOOD "H-1" GAS PIPING
 SCALE: NTS

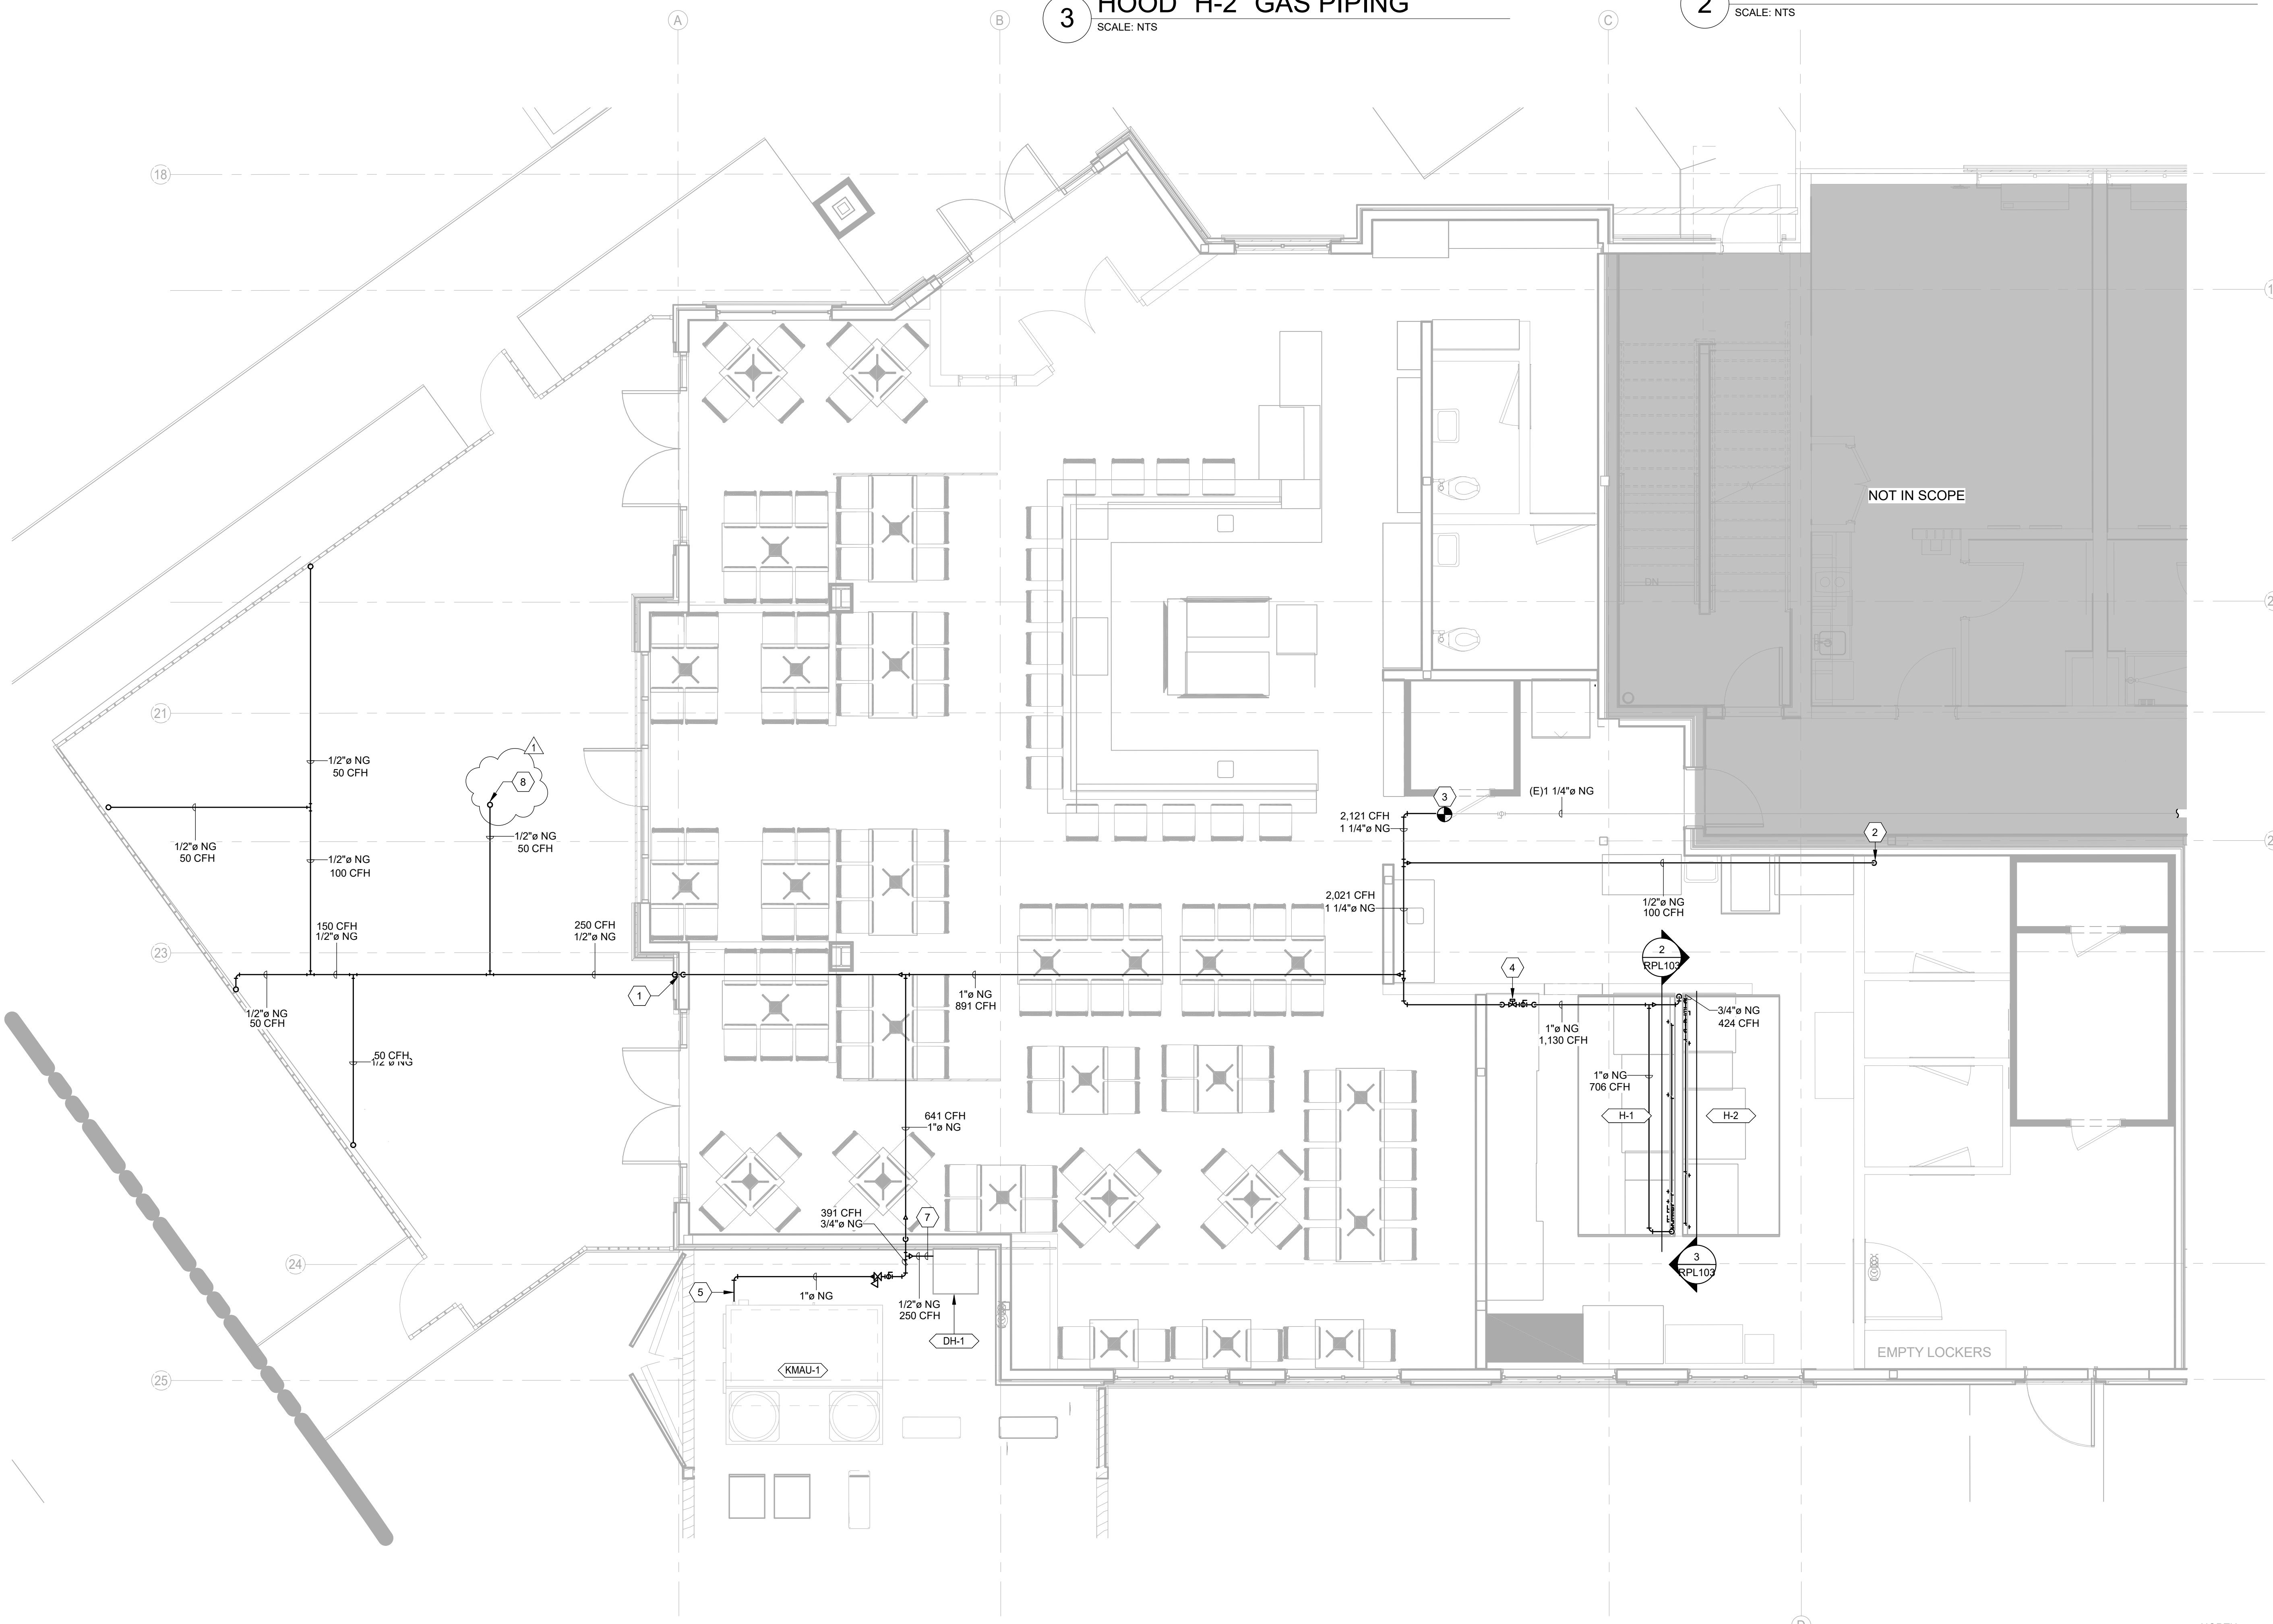


1 LEVEL 1 PLUMBING PLAN - GAS
 SCALE: 1/4" = 1'-0"

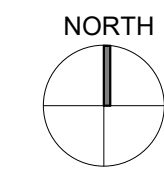

08/20/24, 5:14:10 PM
 Autodesk Docs: 227701945 - Steamboat Springs Restaurant

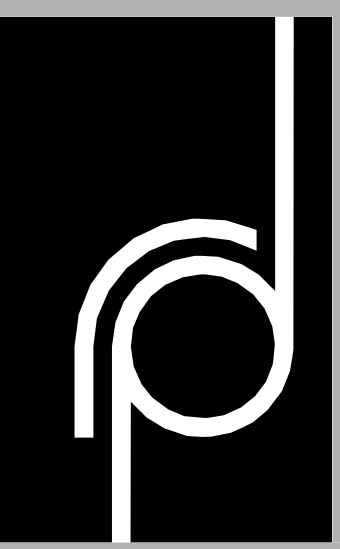

THE
RICHARDSON
DESIGN
PARTNERSHIP,
L.L.C.
510 South 600 East
Salt Lake City, Utah 84102
P: 801.355.6886
F: 801.355.6880

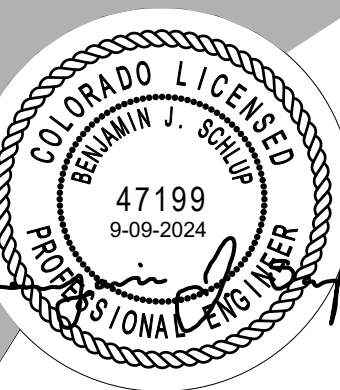

THE ABOVE DESIGN, SPECIFICATION AND/OR CALCULATION HAS BEEN PREPARED BY AN INDIVIDUAL WHOSE NAME IS LISTED AS THE AUTHOR OF THIS DESIGN AND WHO IS A LICENSED PROFESSIONAL ENGINEER IN THE STATE OF COLORADO. THE DESIGNER ACCEPTS FULL RESPONSIBILITY FOR THE ACCURACY AND COMPLETENESS OF THE DESIGN. THE DESIGNER'S LIABILITY IS LIMITED TO THE DESIGN AND CALCULATION ONLY. THE DESIGNER DOES NOT ACCEPT LIABILITY FOR THE DESIGN OR CALCULATION OF ANY OTHER WORK OR FOR ANY OTHER WORK NOT SHOWN ON THIS DRAWING. THE DESIGNER'S LIABILITY IS LIMITED TO THE DESIGN AND CALCULATION ONLY.

SPECTRUM
ENGINEERS
324 S. State St., Suite 400
Salt Lake City, UT 84111
800-878-7077
801-328-5151
fax: 801-328-5155
www.spectrum-engineers.com

**Reviewed for
Code
Compliance**
10/07/2024
CONSULTANT

SERAC CAPITAL PARTNERS, LLC
OWNER:
5051 WESTHEIMER RD. SUITE 1750
HOUSTON, TX 77056


**CENTRAL PARK
RESTAURANT T.I.**
PROJECT:
1760 Central Park Dr.
Steamboat Springs, CO

ISSUE DATE	DESCRIPTION
06/17/2024	
09/10/24	Owner Revisions

REV. DATE	DESCRIPTION
09/10/24	Owner Revisions

PERMIT SET
ROOF PLUMBING PLAN
PROJECT # 2408
DRAWN BY: OPT
CHECKED BY: SSJ
RPL104

SHEET KEYNOTES	
1	COORDINATE WITH EXHAUST FAN DUCTING AND EXHAUST FAN LOCATIONS

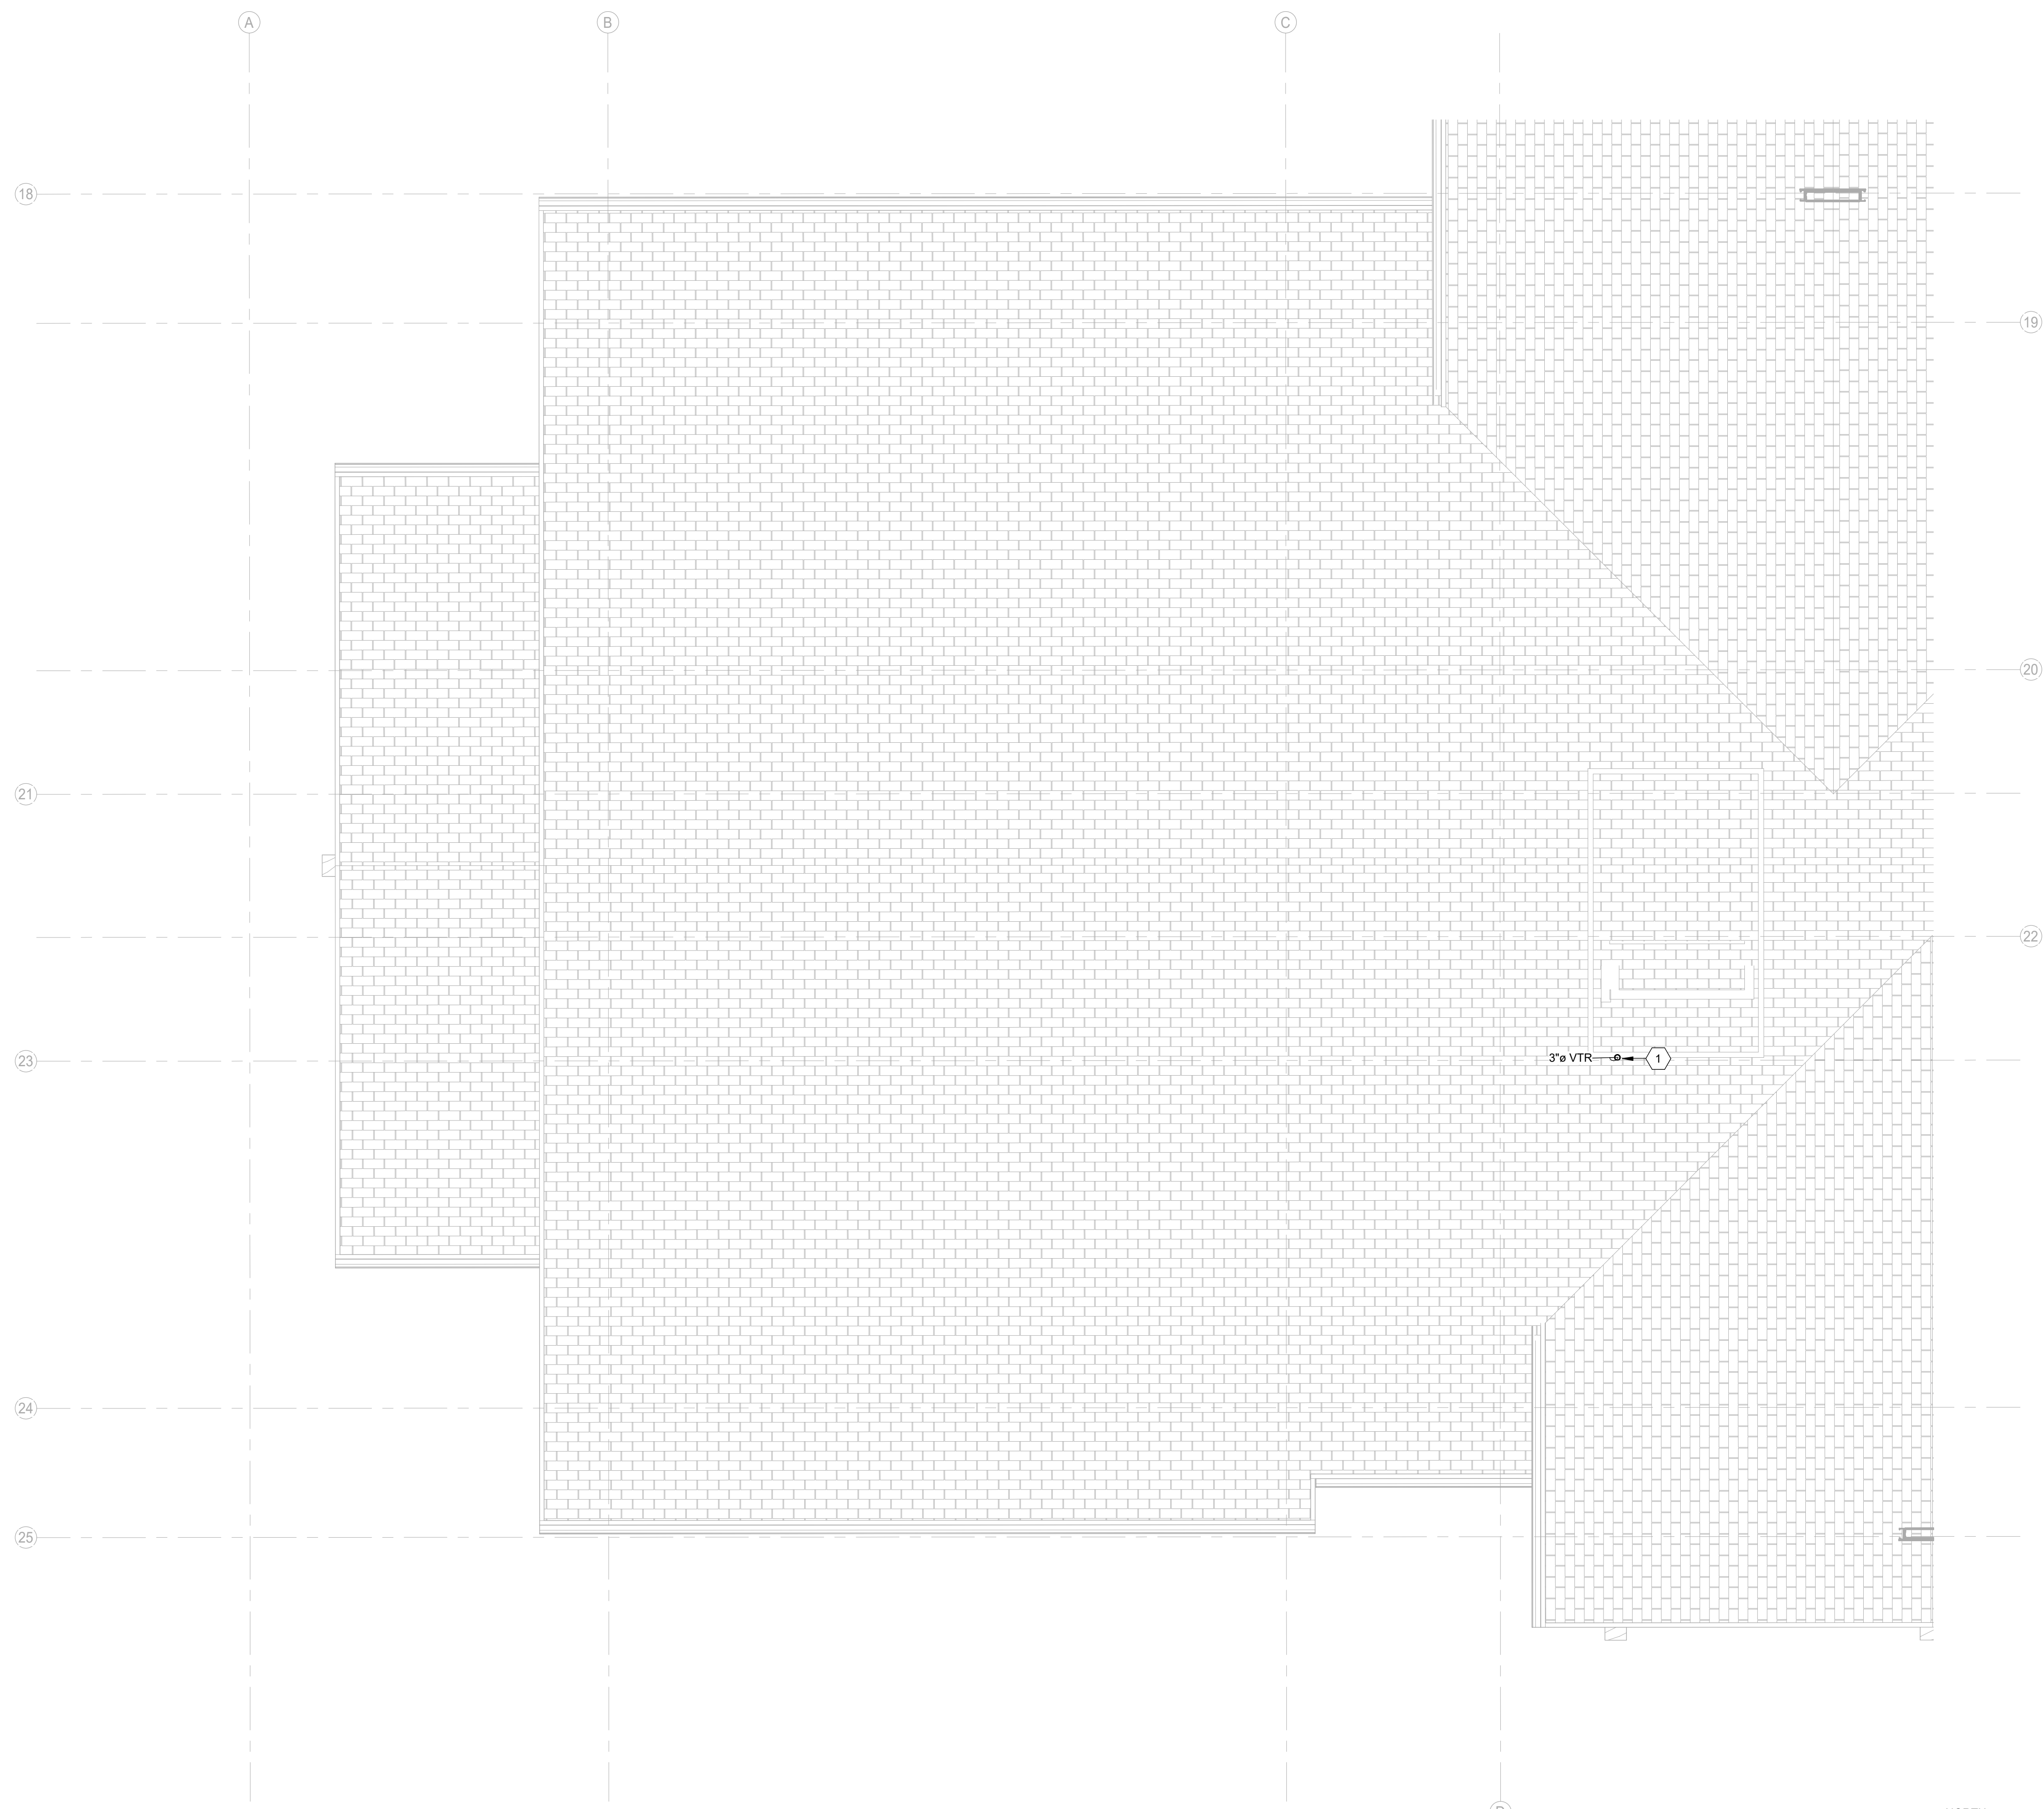

1 ROOF PLUMBING PLAN - DWV
SCALE: 1/4" = 1'-0"

