




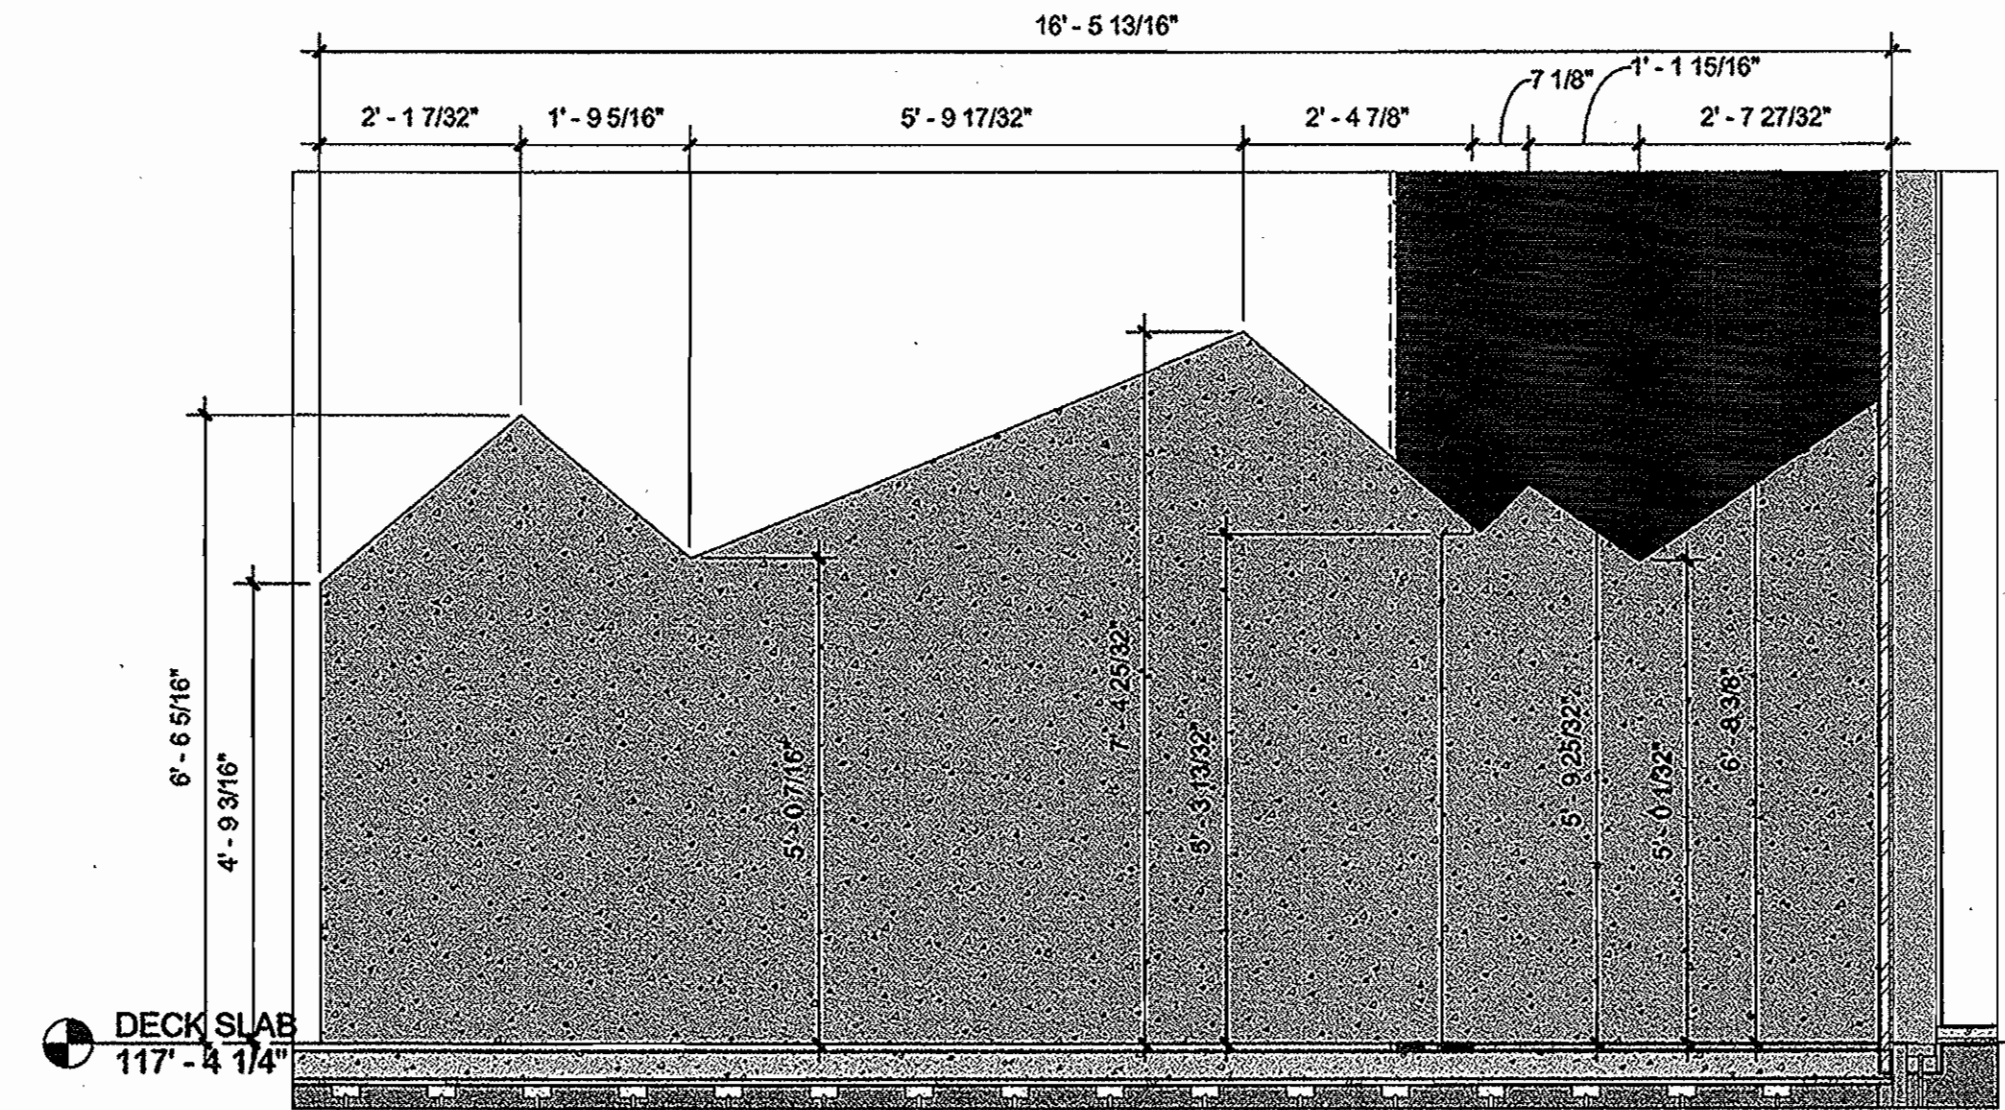

3 U4,5 EAST UPPER WALL
1/2" = 1'-0"

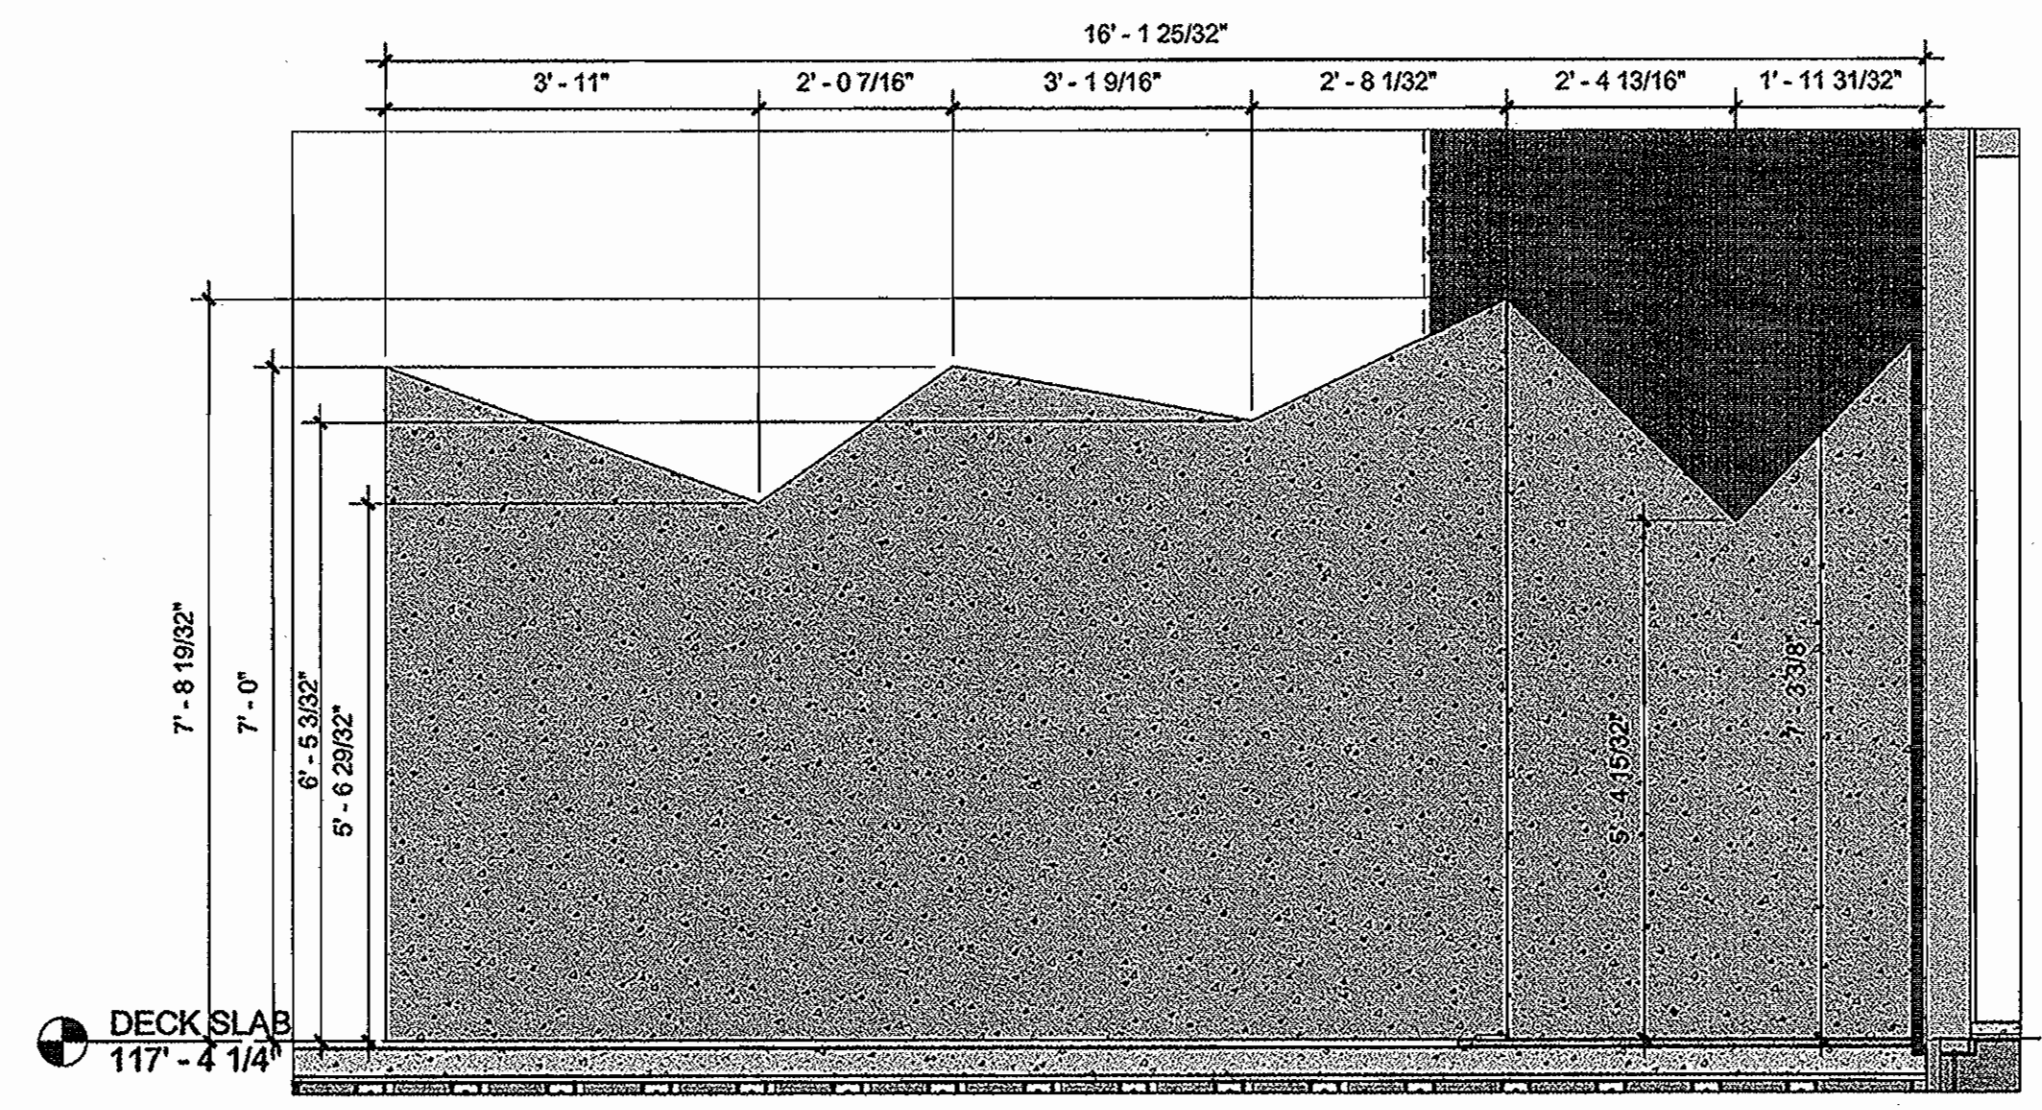

2 U3,4 EAST UPPER WALL
1/2" = 1'-0"

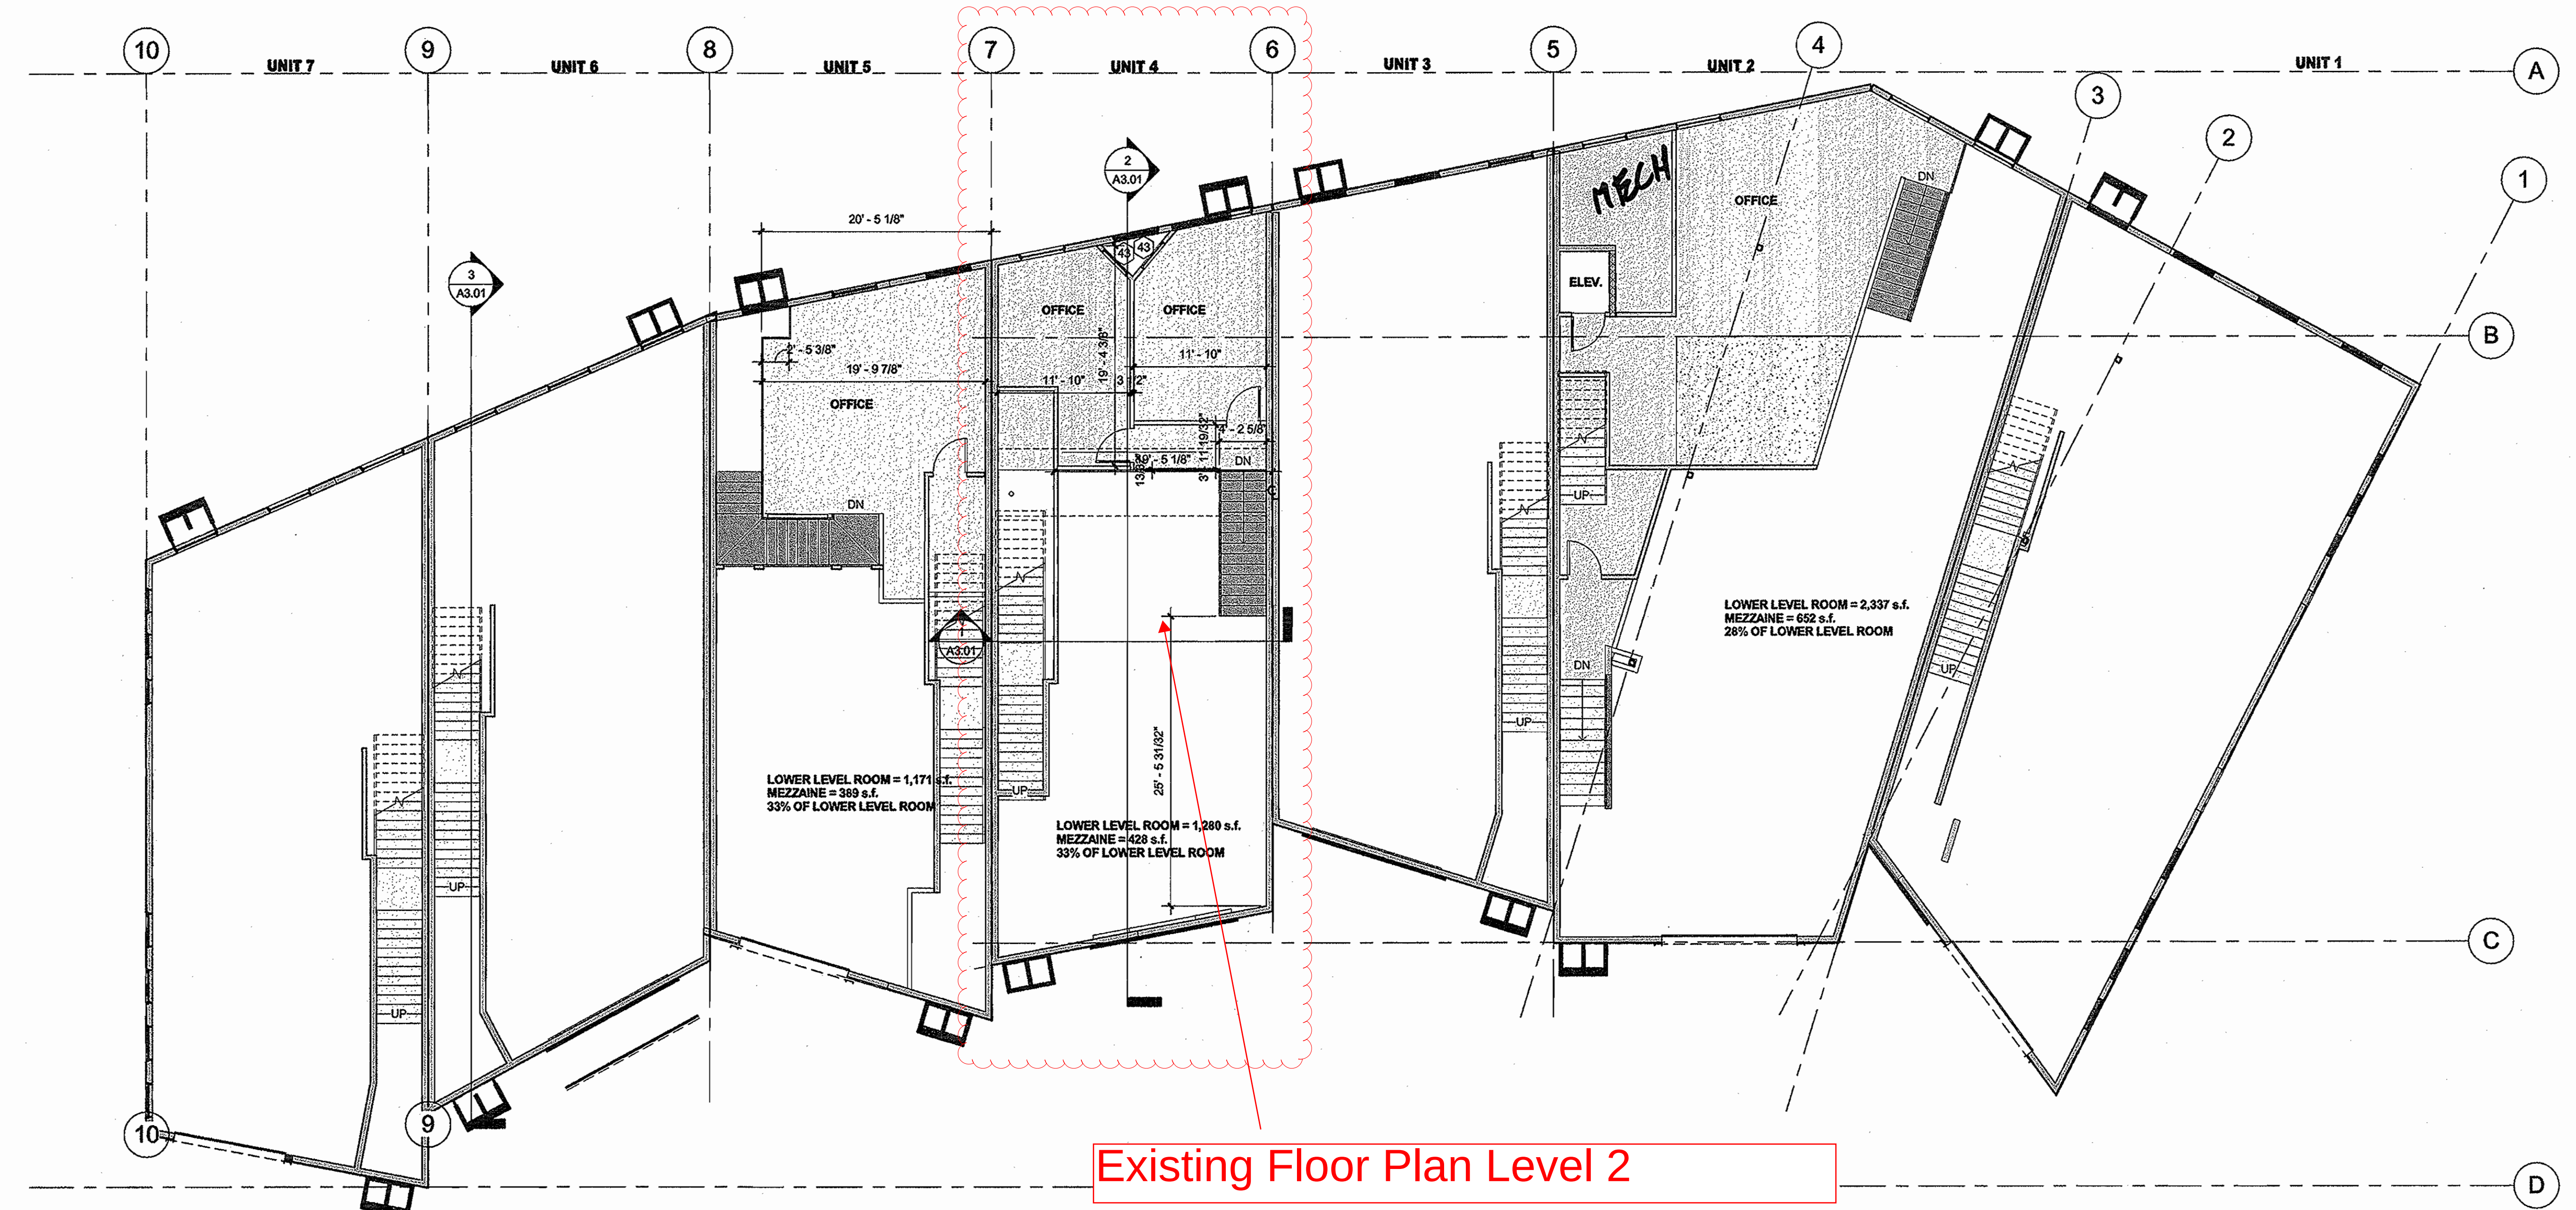

RIVERFRONT
INDUSTRIAL PARK
1522 SHIELD DRIVE
STEAMBOAT SPRINGS, CO

FOR
CONSTRUCTION

BUILDING 3
PROJECT #05004

DATE	ITEM
3.20.06	PROGRESS SET
10.31.06	FDN. ONLY PERMIT
5.11.07	REV. FDN. PERMIT
4.30.08	FULL PERMIT SET

1 B3 MEZZANINE FLOOR PLAN
1/8" = 1'-0"


A1.01a

Code Study: 1900 Bridge Lane Unit #4 Clouded below on original plans

Project submitted under the 2021 IEBC Code for minor interior alteration work to add a shower to an existing bathroom.

Existing Occupancy of Main Floor and 2 Level was a B-Occupancy and S-1 Occupancy.

Proposed Occupancy Uses: Private residential accessory use space associated with existing 3rd floor residential R-2 Dwelling. The main floor is used for hobby space, and private residential offices on 2nd level.

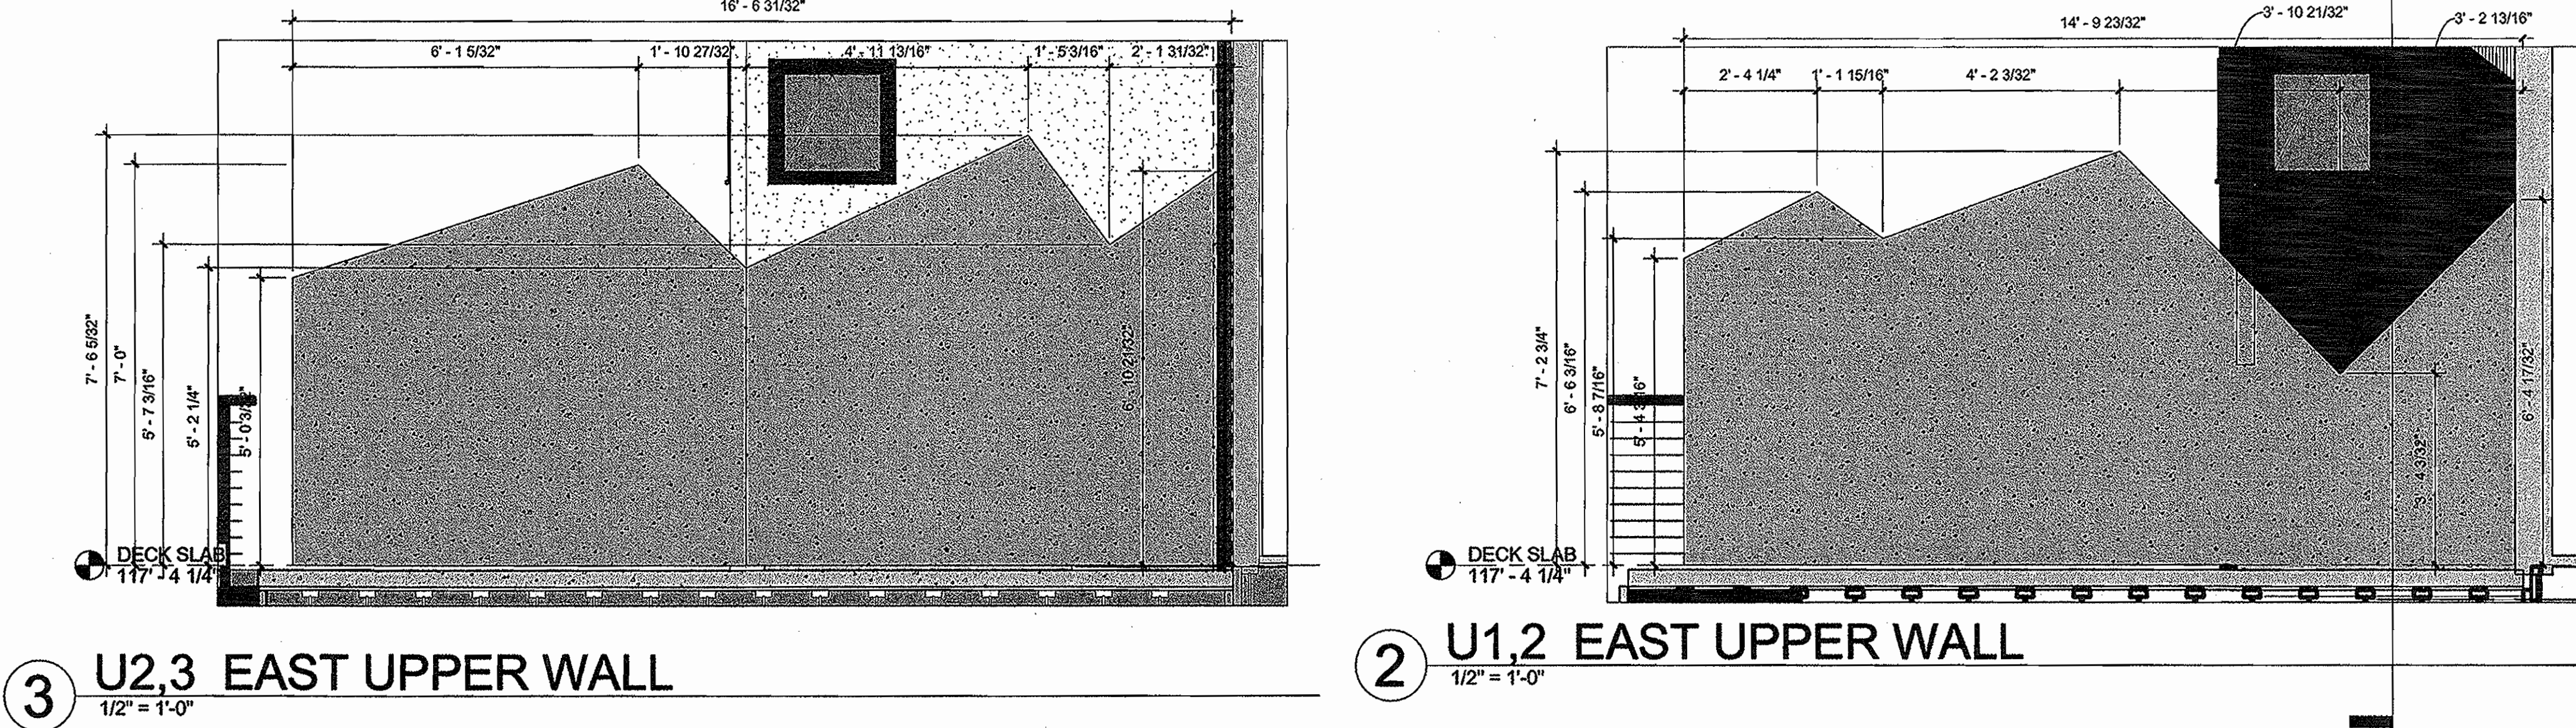

ARCHITECTURE
one

Architecture One
P.O. Box 774304
1953 Bridge Lane, Suite 2700
Steamboat Springs, CO 80477
970.871.0074 FAX 970.871.0077

RCR30
Record Set


STATE OF COLORADO
BENJAMIN
AKSOEN, JR.
203481
5.15.20
LICENSED ARCHITECT

**RIVERFRONT
INDUSTRIAL PARK**
1522 SHIELD DRIVE
STEAMBOAT SPRINGS, CO

FOR
CONSTRUCTION


BUILDING 3
PROJECT #05004

DATE	ITEM
3.20.06	PROGRESS SET
10.31.06	FDN. ONLY PERMIT
5.11.07	REV. FDN. PERMIT
4.30.08	FULL PERMIT SET
5.15.08	REV. F. PERMIT SET

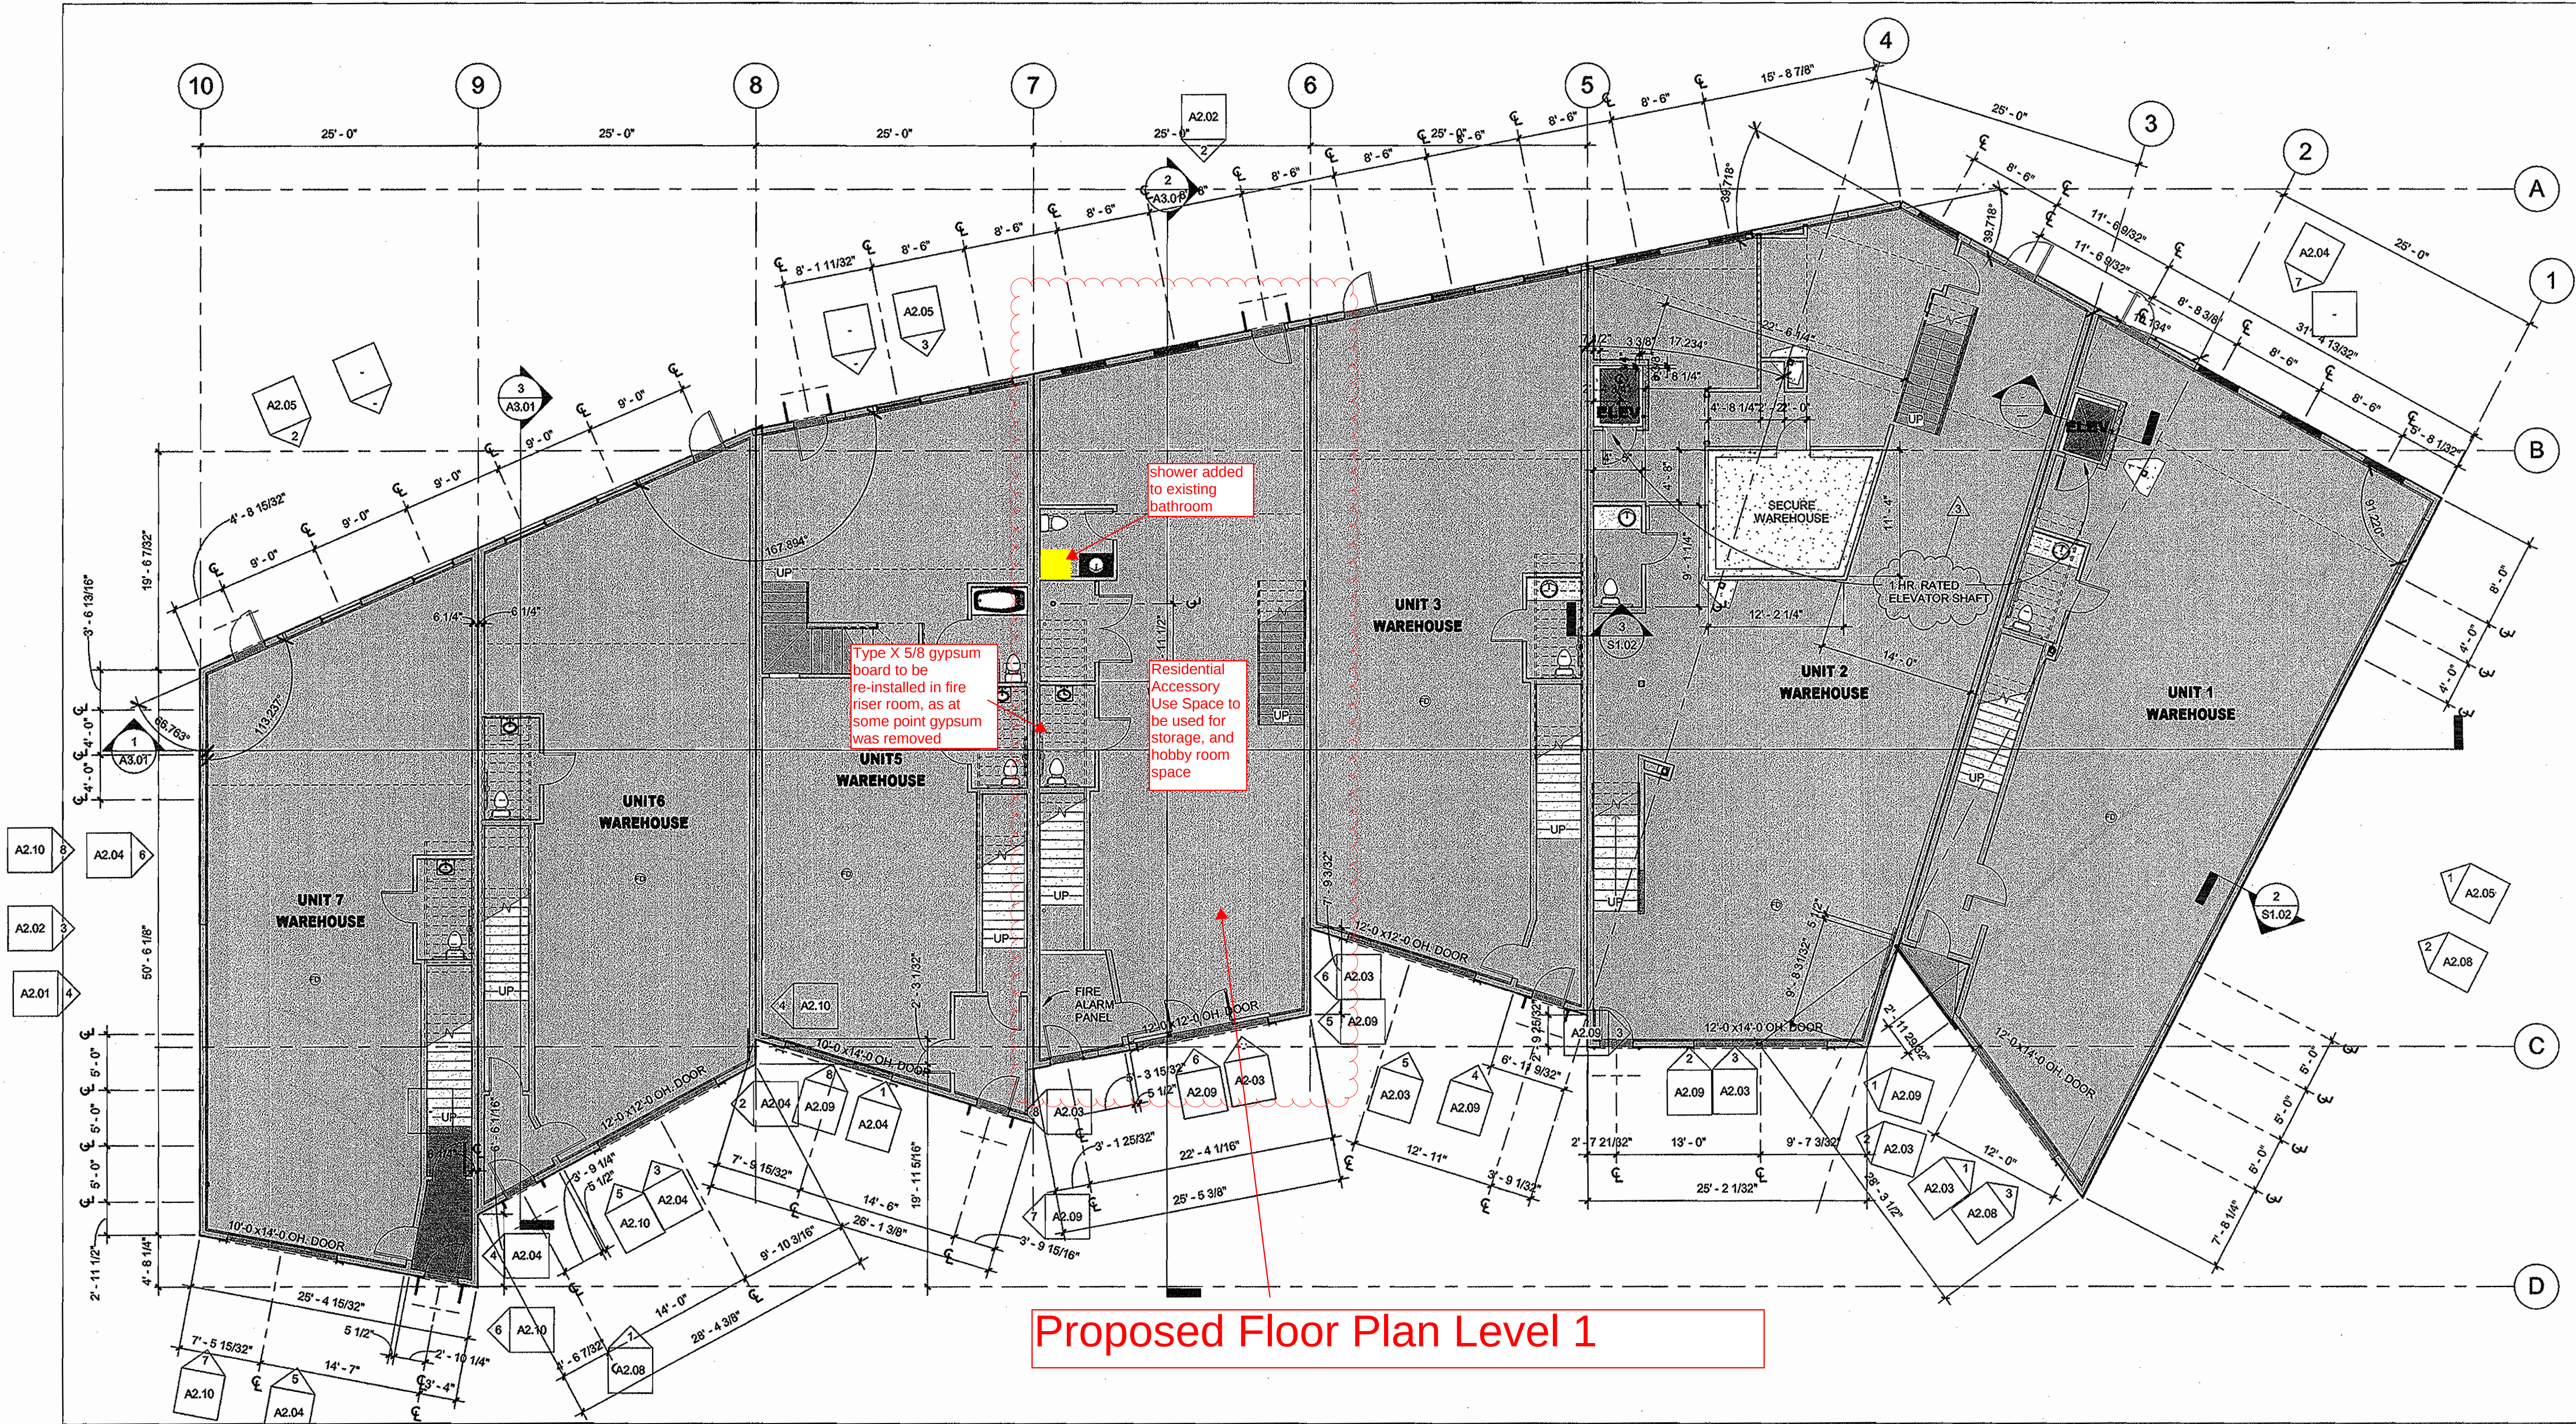


Proposed Floor Plan Level 1


1 B3 LEVEL 1 FLOOR PLAN
1/8" = 1'-0"

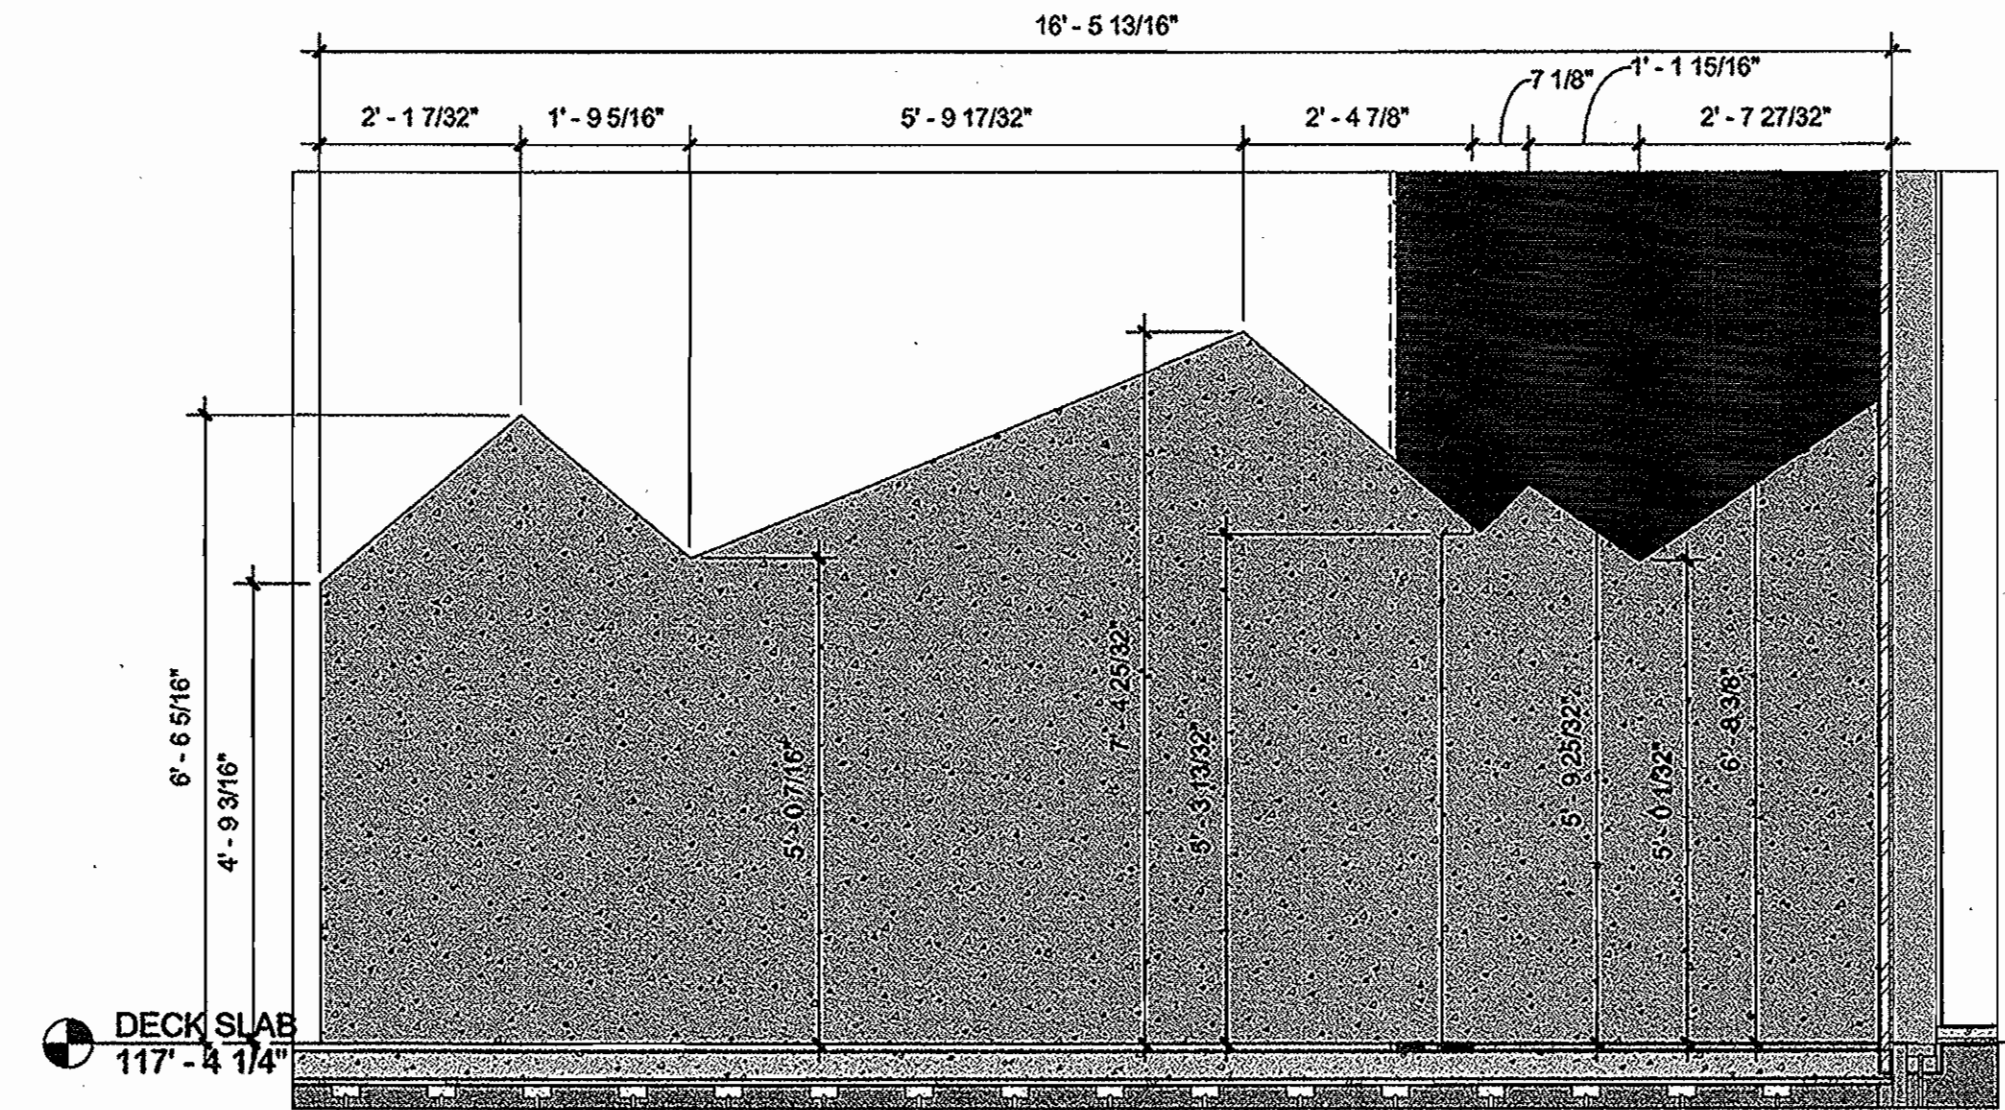

3 U4,5 EAST UPPER WALL
1/2" = 1'-0"

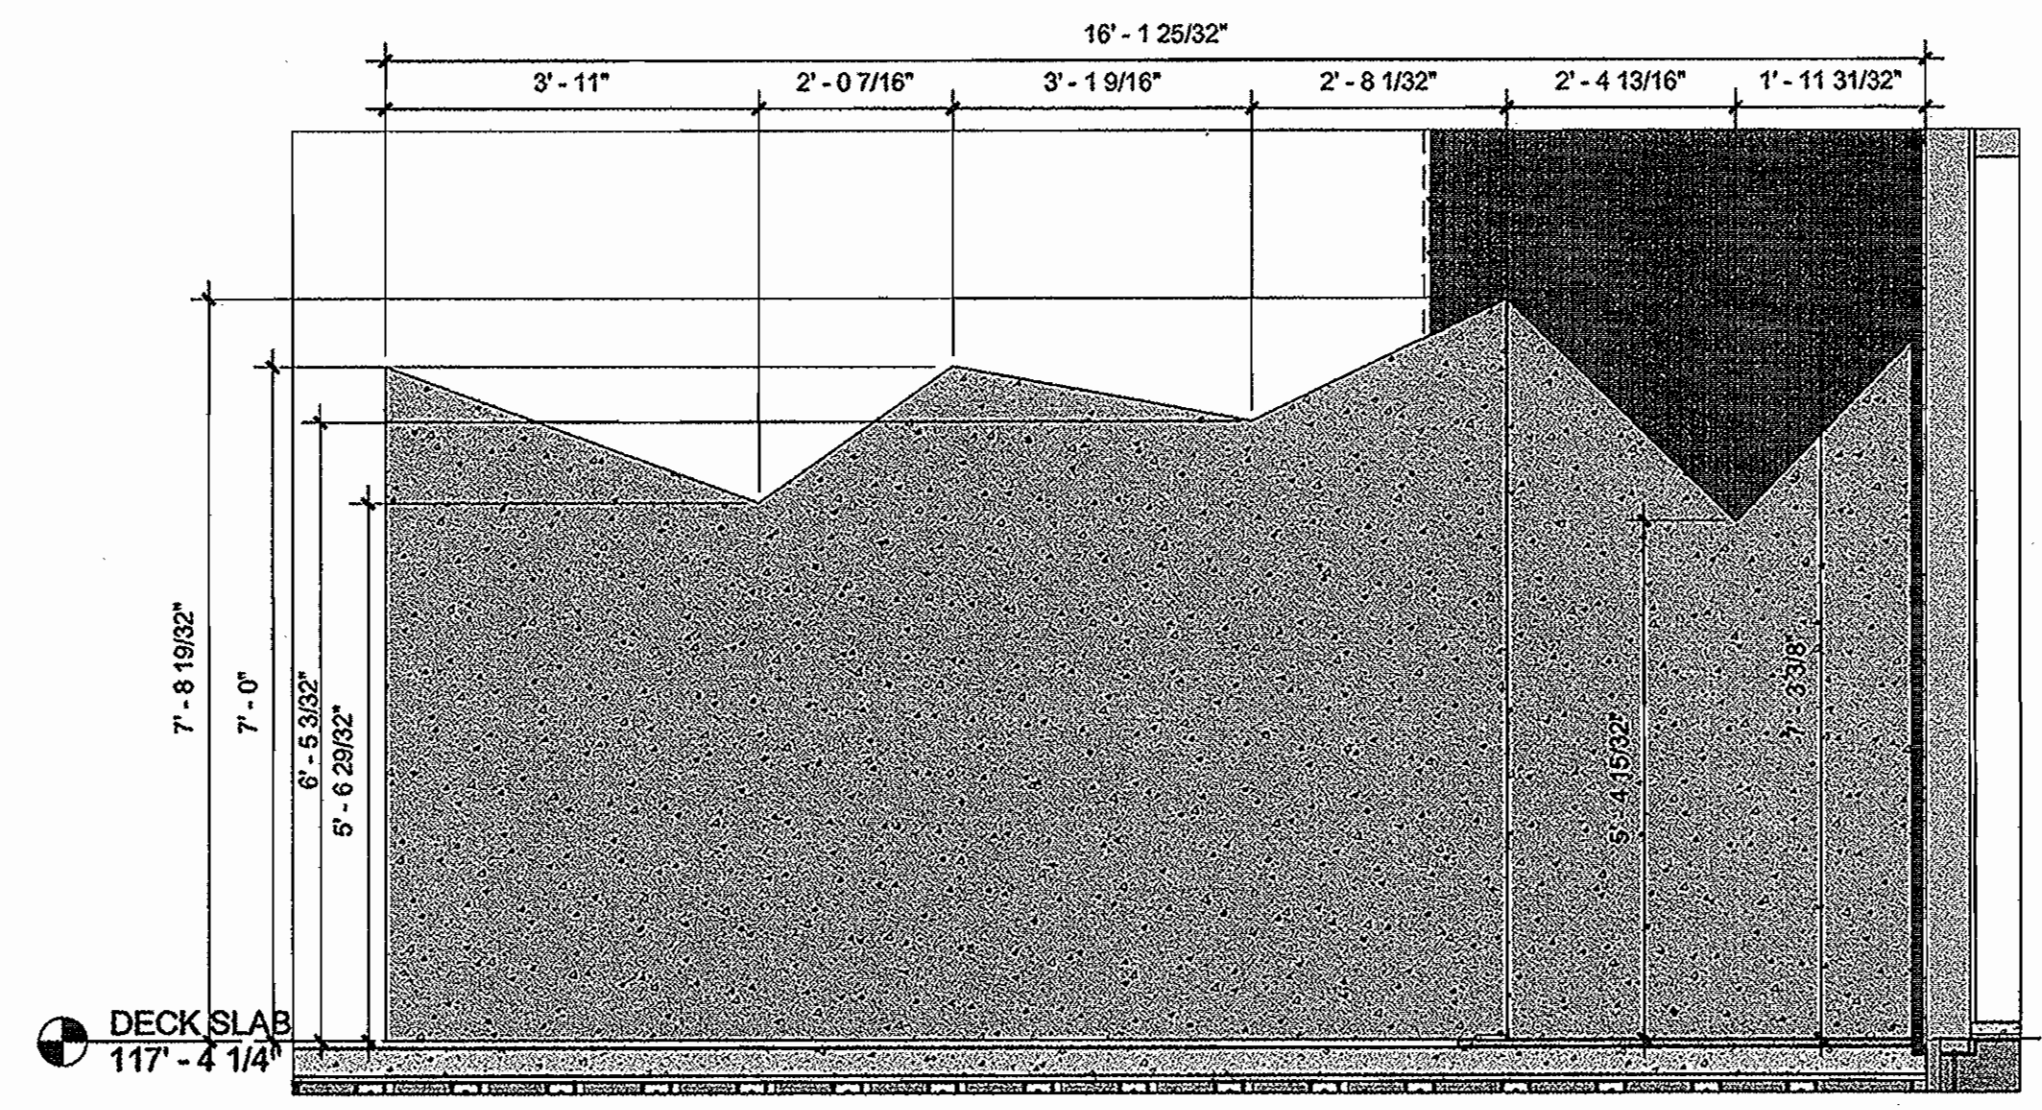

2 U3,4 EAST UPPER WALL
1/2" = 1'-0"

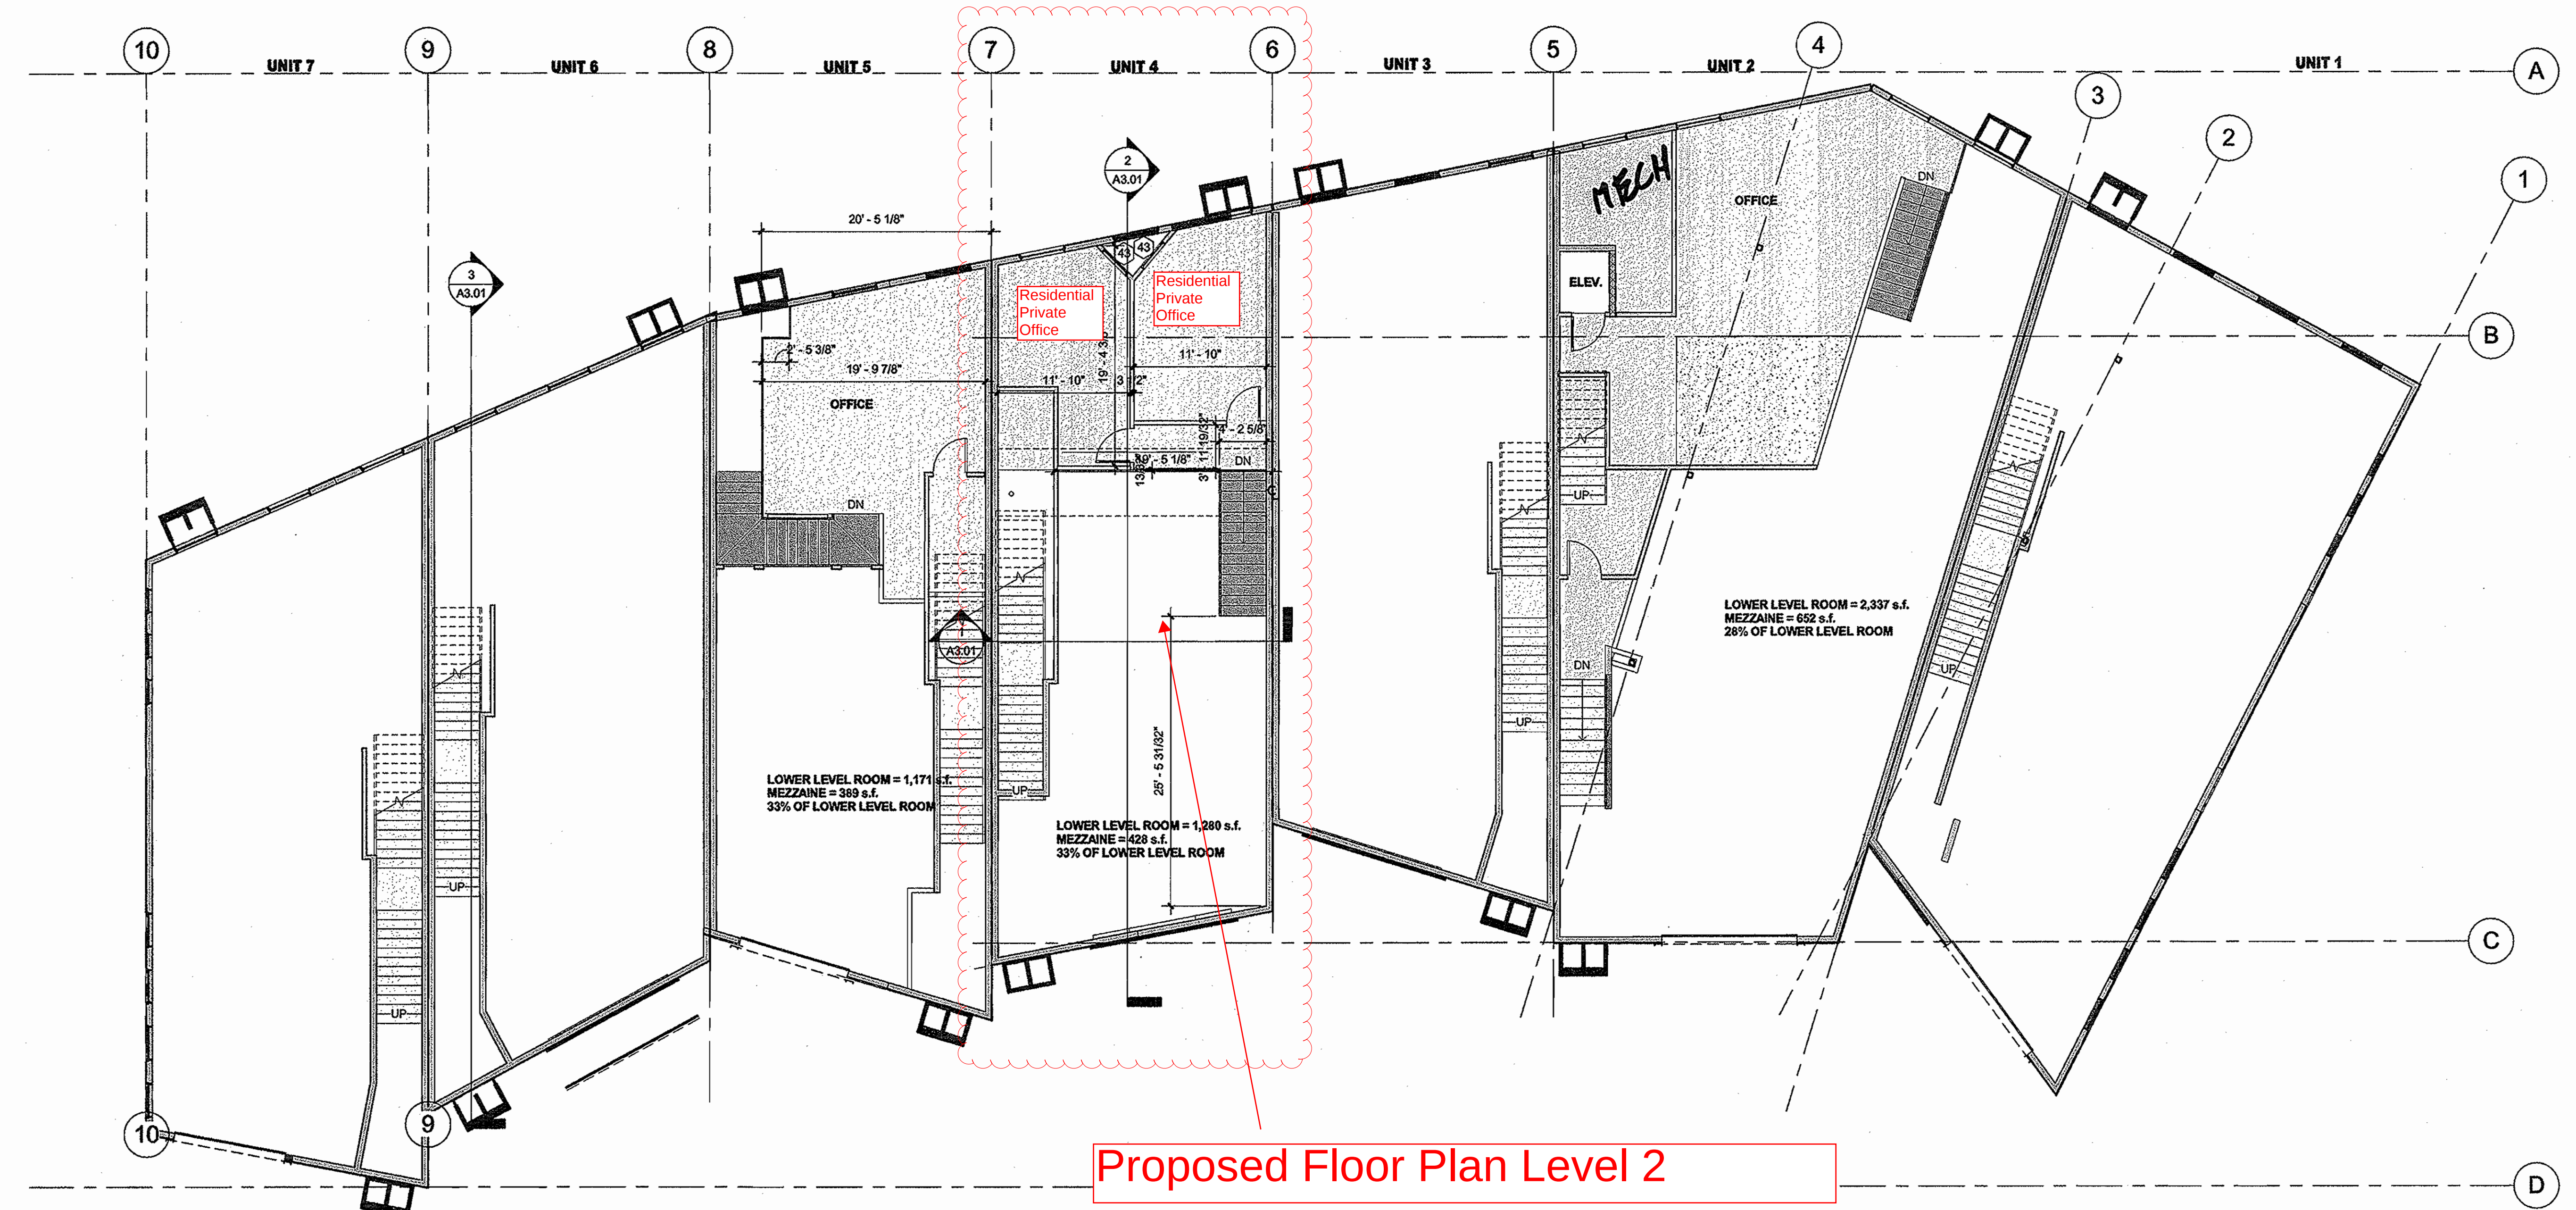

RIVERFRONT
INDUSTRIAL PARK
1522 SHIELD DRIVE
STEAMBOAT SPRINGS, CO

FOR
CONSTRUCTION

BUILDING 3
PROJECT #05004

DATE	ITEM
3.20.06	PROGRESS SET
10.31.06	FDN. ONLY PERMIT
5.11.07	REV. FDN. PERMIT
4.30.08	FULL PERMIT SET

A1.01a

1 B3 MEZZANINE FLOOR PLAN
1/8" = 1'-0"