


CONSTRUCTION DOCUMENTS  
URAAC/SSRA ICONIC ENTRY

LOCATED IN PORTIONS OF SECTIONS 21 & 28, TOWNSHIP 6 NORTH, RANGE 84 WEST  
OF THE 6th PRINCIPAL MERIDIAN  
CITY OF STEAMBOAT SPRINGS, ROUTT COUNTY, COLORADO

RCRBD  
RECORD SET

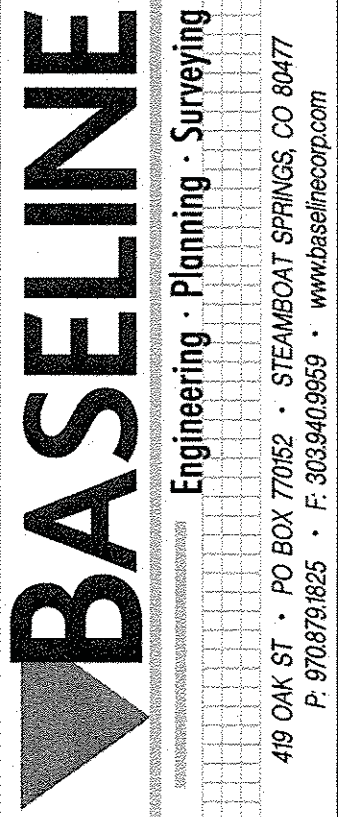

DESIGNED BY	SMB
DRAWN BY	SMB
CHECKED BY	CSR

PREPARED BY	DATE
CSR	5/3/18
CSR	6/7/18

REVISION	DESCRIPTION
DESIGN TEAM REVIEW/COORDINATION	
ADDRESS TAG COMMENTS	

CITY OF STEAMBOAT SPRINGS	ROUTT COUNTY
URAAC/SSRA ICONIC ENTRY	
MT. WERNER CIRCLE/MT. WERNER ROAD	
COVER SHEET	

STEAMBOAT SPRINGS	40319	6/7/18
PROFESSIONAL ENGINEER		
FOR AND ON BEHALF OF		
BASELINE CORPORATION		
INITIAL SUBMITTAL	5/3/18	
DRAWING SIZE	24" X 36"	
SURVEY FIRM	10/11/14	
D&D, INC.		
JOB NO.	C020169	
DRAWING NAME	C020169 CD COVER.dwg	
SHEET	1 OF 13	

PROJECT CONTACTS



CIVIL ENGINEER:  
BASELINE ENGINEERING  
CHRIS RUNDALL  
(970) 879-1825



CLIENT:  
STEAMBOAT SPRINGS REDEVELOPMENT AUTHORITY  
DANNY PAUL & RALPH WALTON  
(970) 871-8210



GAS:  
ATMOS ENERGY  
DON CRANE  
(970) 846-1505



ELECTRIC:  
YAMPA VALLEY ELECTRIC  
LARRY BALL  
(970) 879-1160



TELEPHONE:  
CENTURY LINK  
KELLY MCCLERNON  
970-328-8288

Mount Werner Water District





WATER & SANITARY SEWER:  
MT. WERNER WATER DISTRICT  
RICHARD BUCCINO  
(970) 879-2424



CABLE:  
COMCAST  
DAVE STEPISNIK  
(970) 539-0610



BROADBAND/FIBER:  
RESORT INTERNET  
CHRIS PROCTOR  
(970) 389-6399

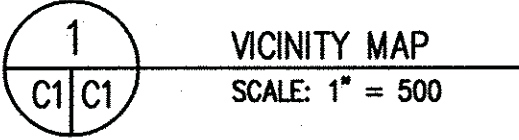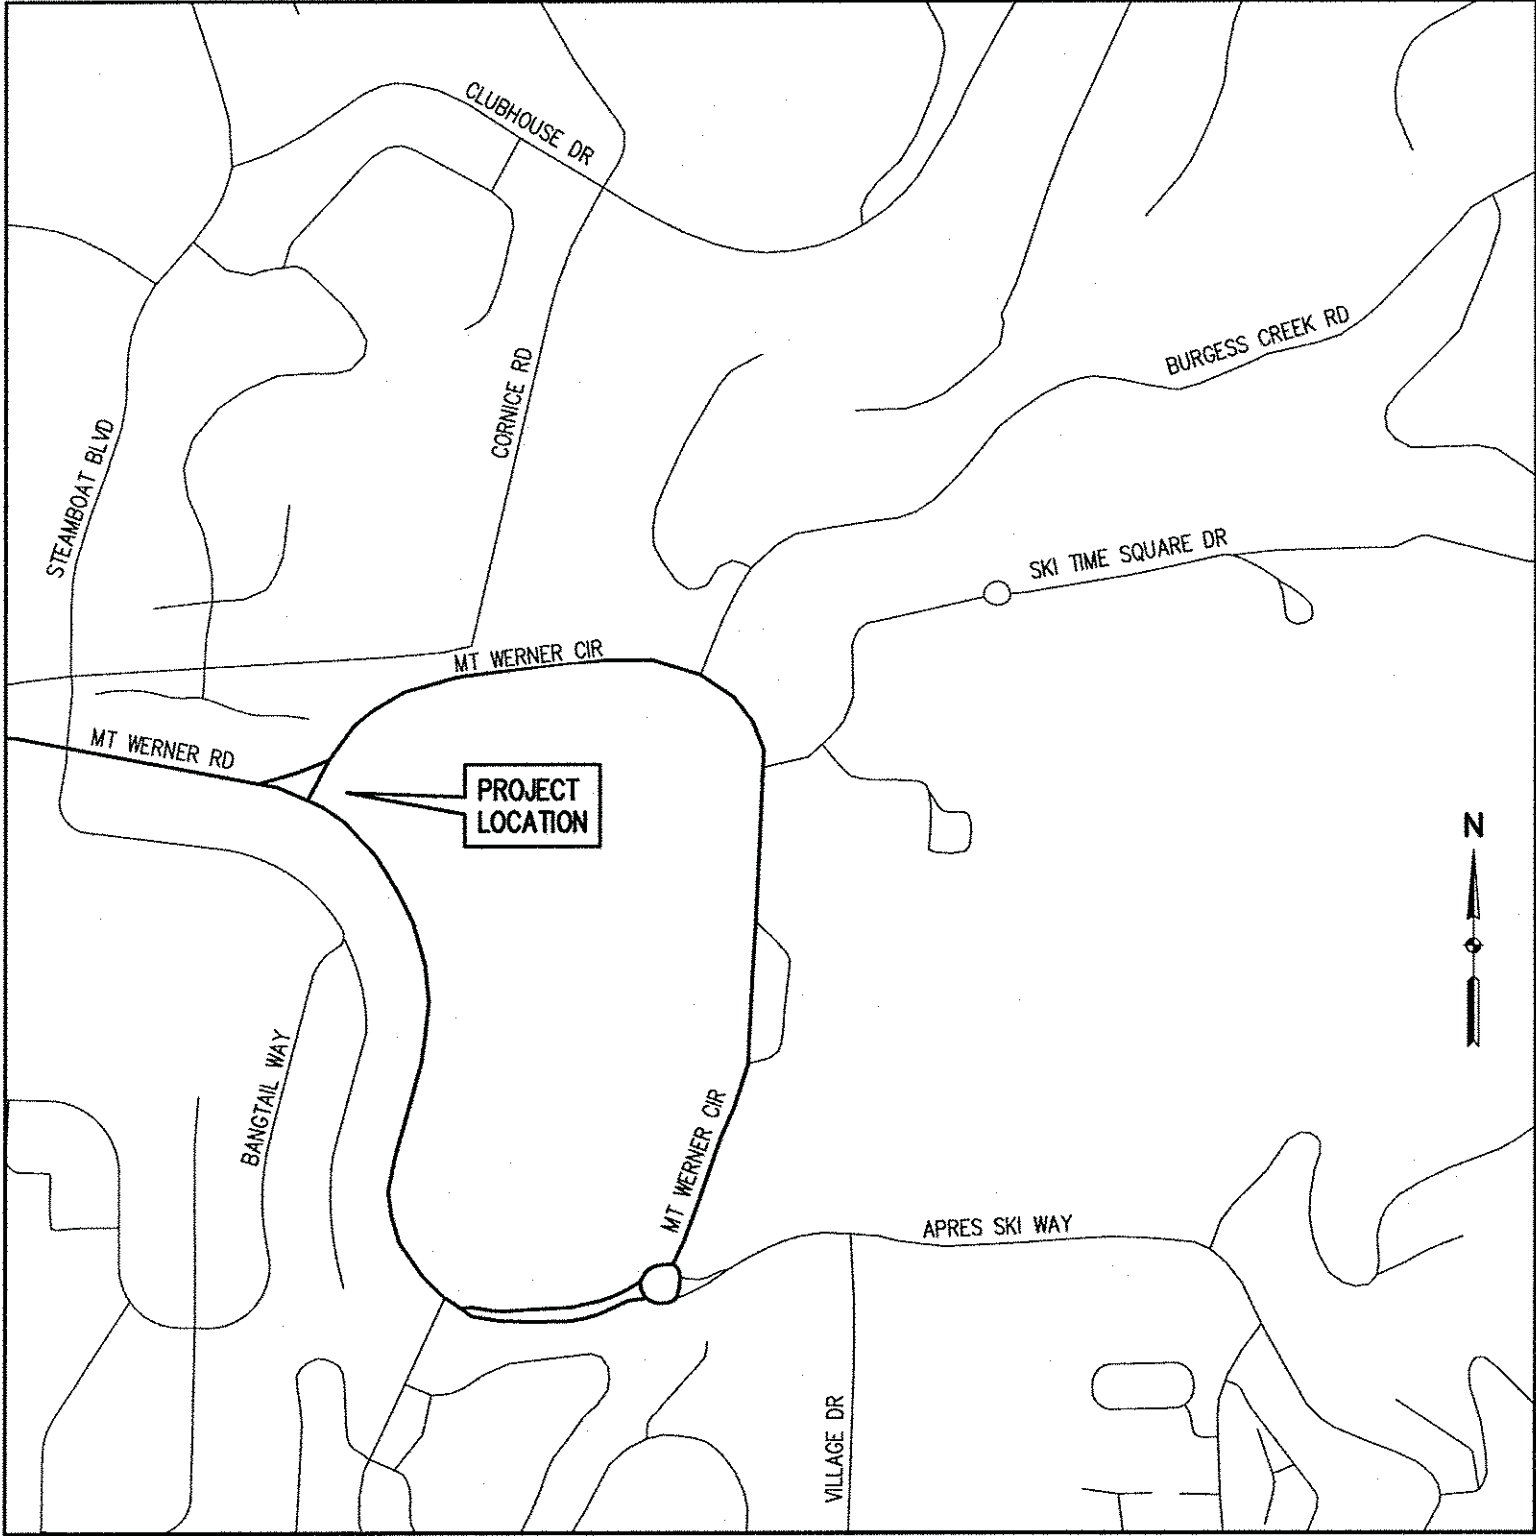

SHEET INDEX

- NO. SHEET TITLE  
C1 COVER SHEET  
C2 NOTES AND LEGEND  
C3 PHASE 1 - SITE & UTILITY PLAN  
C4 PHASE 1 - GRADING AND EROSION CONTROL PLAN  
~~C5 PHASE 2 - SITE PLAN~~  
~~C6 PHASE 2 - SIDEWALK CONNECTION SITE PLAN~~  
~~C7 PHASE 2 - GRADING PLAN~~  
~~C8 PHASE 2 - SIDEWALK CONNECTION GRADING PLAN~~  
~~C9 PHASE 2 - EROSION CONTROL PLAN~~  
~~C10 PHASE 2 - SIDEWALK CONNECTION EROSION CONTROL PLAN~~  
C11 STORM WATER MANAGEMENT PLAN  
C12 DETAILS  
C13 EROSION CONTROL DETAILS  
L100 LANDSCAPE PLAN  
L101 LANDSCAPE & IRRIGATION DETAILS & SPECIFICATIONS  
LPI Lighting Plan 1  
LPZ Lighting Plan 2  
MEMO Lighting Plan Specifications

NOTE: PHASE 2 CIVIL  
WORK IS NOT PART OF  
BUILDING PERMIT  
APPLICATION

PREPARED FOR:  
**STEAMBOAT SPRINGS REDEVELOPMENT AUTHORITY**  
137 10TH ST.  
STEAMBOAT SPRINGS, COLORADO 80477

PROJECT BENCHMARK:  
A RECOVERED 3" BRASS CAP MONUMENTING THE NORTHEAST  
CORNER OF SECTION 28, TOWNSHIP 6 NORTH, RANGE 84 WEST  
OF THE 6TH P.M. SAID BRASS CAP ALSO BEING CITY OF  
STEAMBOAT SPRINGS GS CONTROL POINT NUMBER 344.  
NORTHING = 1,412,535.68  
EASTING = 2,636,559.05  
ELEVATION = 6935.40 (NAVD88)

PROJECT APPROVED BY COUNCIL _____		
FINAL DESIGN APPROVALS		
	DATE	INITIALS
ENGINEERING	6/27/18	SR
PLANNING	6/26/18	JS
PUBLIC UTILITIES (MT. WERNER/CITY)	6/27/18	CS
OTHER ( )		



Know what's below.  
Call before you dig.



O:\C020169 Iconic Entry\Drawings\C020169 CD COVER.dwg, 6/7/2018 9:54:42 AM, Chris Rundall

CITY OF STEAMBOAT SPRINGS STANDARD CONSTRUCTION NOTES

GENERAL NOTES

- BENCHMARK = SEE COVER SHEET. NOTE THE PROJECT IS ON THE NAVD 88 VERTICAL DATUM AND NAD 1983 HORIZONTAL DATUM AS REQUIRED BY THE CITY.
- TOPOGRAPHIC AND EXISTING CONDITIONS MAPPED BY D&D INC. ON 10/11/14. LANDMARK CONSULTANTS, INC. UPDATED THE SURVEY IN 2017 TO MATCH IN WITH THE DATUM OF THE SKI TIME SQUARE DR AND MT WERNER CIRCLE ROUNDABOUT PROJECT. ADDITIONALLY A SURVEY PERFORMED BY WHELAN LAND SURVEYS DATED 12/8/17 WAS INCORPORATED INTO THE PLANS WITH A HORIZONTAL DATUM TRANSFORMATION.
- CITY OF STEAMBOAT SPRINGS PLAN REVIEW AND APPROVAL IS ONLY FOR GENERAL CONFORMANCE WITH CITY DESIGN CRITERIA AND THE CITY CODE. THE CITY IS NOT RESPONSIBLE FOR THE COMPLETENESS, ACCURACY AND ADEQUACY OF THE DRAWINGS. DESIGN, DIMENSIONS, AND ELEVATIONS SHALL BE CONFIRMED AND CORRELATED AT THE JOB SITE.
- ONE COPY OF THE APPROVED CONSTRUCTION PLANS AND SPECIFICATIONS SHALL BE KEPT ON THE JOB SITE AT ALL TIMES. PRIOR TO THE START OF CONSTRUCTION, CONTRACTOR TO VERIFY WITH PROJECT ENGINEER THE LATEST REVISION DATE OF THE APPROVED CONSTRUCTION PLANS.
- CONTRACTOR SHALL VERIFY THE LOCATION OF ALL UTILITIES. CALL THE UTILITY NOTIFICATION CENTER OF COLORADO (UNCC) AT 1-800-922-1987 AND ANY NECESSARY PRIVATE UTILITY TO PERFORM LOCATES PRIOR TO CONDUCTING ANY SITE WORK.
- ALL INFRASTRUCTURE CONSTRUCTION AND RELATED WORK SHALL CONFORM TO THE CITY OF STEAMBOAT SPRINGS STANDARD SPECIFICATIONS, LATEST REVISION.
- ALL WATER AND SANITARY SEWER CONSTRUCTION AND RELATED WORK SHALL CONFORM TO MT. WERNER WATER DISTRICT STANDARDS AND SPECIFICATIONS.
- CONTRACTOR SHALL OBTAIN ALL NECESSARY PERMITS AND APPROVALS REQUIRED TO PERFORM THE WORK SUCH AS RIGHT-OF-WAY PERMIT, GRADING AND EXCAVATION PERMIT, CONSTRUCTION DEWATERING PERMIT, STORM WATER QUALITY PERMIT, ARMY CORP. OF ENGINEER PERMIT, ETC. IT IS THE CONTRACTOR'S RESPONSIBILITY TO OBTAIN A COPY OF ALL APPLICABLE CODES, LICENSES, SPECIFICATIONS, AND STANDARDS NECESSARY TO PERFORM THE WORK, AND BE FAMILIAR WITH THEIR CONTENTS PRIOR TO COMMENCING ANY WORK.
- PRIOR TO ANY WORK IN THE CITY RIGHT-OF-WAY INCLUDING STREET CUTS, CONTACT THE CITY OF STEAMBOAT SPRINGS STREET DEPARTMENT AT 970.879.1807 FOR PERMIT REQUIREMENTS. NO WORK SHALL OCCUR IN THE ROW BETWEEN NOVEMBER 1 - APRIL 1 UNLESS A WRITTEN VARIANCE HAS BEEN APPROVED AND ISSUED BY THE CITY PUBLIC WORKS DIRECTOR.
- PRIOR TO CLOSURE OF ANY STREET OR PART OF STREET, AN APPROVED OBSTRUCTION PERMIT MUST BE ISSUED BY CITY CONSTRUCTION SERVICES FOREMAN.
- CONTRACTOR IS RESPONSIBLE FOR CONTACTING THE COLORADO DEPARTMENT OF TRANSPORTATION (CDOT) AND OBTAINING ANY REQUIRED PERMITS OR APPROVALS FOR WORK ON OR ADJACENT TO CDOT ROW.
- PRIOR TO START OF CONSTRUCTION CONTRACTOR SHALL COORDINATE WITH PROJECT ENGINEER TO IDENTIFY PROJECT INSPECTION AND TESTING REQUIREMENTS. CONTRACTOR SHALL PROVIDE FOR INSPECTIONS AND TESTING AT AN ADEQUATE FREQUENCY FOR THE PROJECT ENGINEER TO DOCUMENT THAT PROJECT IS CONSTRUCTED IN CONFORMANCE WITH THE APPROVED PLANS AND SPECIFICATIONS.
- CONTRACTOR IS RESPONSIBLE FOR ALL NECESSARY TRAFFIC CONTROL. TRAFFIC CONTROL SHALL BE IN ACCORDANCE WITH THE MANUAL ON UNIFORM TRAFFIC CONTROL DEVICES (MUTCD), LATEST EDITION.
- CONTRACTOR SHALL PROVIDE ALL NECESSARY TRAFFIC CONTROL (SIGNS, BARRICADES, FLAGMEN, LIGHTS, ETC) IN ACCORDANCE WITH THE MUTCD, CURRENT EDITION.
- CONTRACTOR MUST SUBMIT A CONSTRUCTION SITE MANAGEMENT PLAN (CSMP) FOR REVIEW AND APPROVAL BY THE CITY CONSTRUCTION SERVICES FOREMAN PRIOR TO START OF CONSTRUCTION. THE CSMP MUST BE MAINTAINED ON-SITE AND UPDATED AS NEEDED TO REFLECT CURRENT CONDITIONS.
- THE FOLLOWING PRIVATE IMPROVEMENTS REQUIRE CONSTRUCTION OBSERVATION PER THE CITY'S ENGINEERING SERVICES SPECIFICATION: NONE.
- RECORD DRAWINGS ARE REQUIRED FOR: STORM SEWER

GRADING

- GRADING SHALL OCCUR WITHIN THE PROPERTY LIMITS. WHERE OFF-SITE WORK IS APPROVED, WRITTEN PERMISSION OF THE ADJACENT PROPERTY OWNER MUST BE OBTAINED PRIOR TO ANY OFF-SITE GRADING OR CONSTRUCTION.
- NO WORK SHALL OCCUR IN WETLANDS OR FLOODPLAINS WITHOUT APPROPRIATE PERMITS. ANY WORK SHALL BE IN ACCORDANCE WITH THE ISSUED PERMITS.
- VEGETATED SLOPES GREATER THAN 2:1 REQUIRE SOIL STABILIZATION.

EROSION CONTROL

- CONTRACTOR SHALL SUBMIT A CONSTRUCTION SITE MANAGEMENT PLAN (CSMP) TO THE CITY FOR APPROVAL PRIOR TO BUILDING PERMIT ISSUANCE.
- CONTRACTOR SHALL WORK IN A MANNER THAT MINIMIZES THE POTENTIAL FOR EROSION.
- CONTRACTOR SHALL BE RESPONSIBLE FOR INSTALLING, INSPECTING, AND MAINTAINING ALL NECESSARY EROSION AND SEDIMENT CONTROL DURING CONSTRUCTION AND REMOVING EROSION CONTROL WHEN PROJECT IS COMPLETE AND VEGETATION IS ESTABLISHED.
- ANY AREA DISTURBED BY CONSTRUCTION AND NOT PAVED OR NATURAL ROCK SURFACE SHALL BE REVEGETATED WITHIN ONE CONSTRUCTION SEASON.

PAVING

- PAVING OF PUBLIC STREETS SHALL NOT START UNTIL SUB GRADE COMPACTION AND MATERIAL TESTS ARE TAKEN AND ACCEPTED BY THE PUBLIC WORKS DIRECTOR.
- EXISTING ASPHALT PAVEMENT SHALL BE STRAIGHT SAW CUT WHEN ADJOINING WITH NEW ASPHALT PAVEMENT OR WHEN ACCESS TO UNDERGROUND UTILITIES IS REQUIRED. TACK COAT SHALL BE APPLIED TO ALL EXPOSED SURFACES INCLUDING SAW CUTS, POTHOLES, TRENCHES, AND ASPHALT OVERLAY. ASPHALT PATCHES IN THE RIGHT-OF-WAY SHALL BE PER CITY SPECIFICATIONS.
- ADJUST RIMS OF CLEANOUTS, MANHOLES, VALVE COVERS TO FINAL GRADE.
- CONTRACTOR TO CONTACT CITY STREETS SUPERINTENDENT AT (970) 879-1807 TO SCHEDULE INSTALLATION OF PUBLIC STREET SIGNS. ALL OTHER TRAFFIC CONTROL SIGNS ARE THE RESPONSIBILITY OF THE CONTRACTOR.

PROJECT GENERAL NOTES

- UNLESS OTHERWISE SPECIFIED, THE CONTRACTOR SHALL BE RESPONSIBLE FOR HIS OWN CONSTRUCTION STAKING. THE CONTRACTOR SHALL FURTHER BE RESPONSIBLE FOR THE ACCURACY OF ALL STAKING IN ACCORDANCE WITH THE APPROVED PLANS. IN THE EVENT THAT DISCREPANCIES ARE FOUND, THE CONTRACTOR SHALL IMMEDIATELY NOTIFY THE ENGINEER OR PROJECT MANAGER PRIOR TO COMMENCING WITH CONSTRUCTION OPERATIONS.
- THE CONTRACTOR SHALL NOTIFY THE OWNER AND ENGINEER OF ANY PROBLEM IN CONFORMING TO THE APPROVED PLANS FOR ANY ELEMENT OF THE PROPOSED IMPROVEMENTS PRIOR TO ITS CONSTRUCTION.
- ANY COMPONENTS OF WORK NOT ADDRESSED BY CITY OF STEAMBOAT SPRINGS STANDARD SPECIFICATIONS SHALL CONFORM TO THE CDOT STANDARD SPECIFICATIONS FOR ROAD AND BRIDGE CONSTRUCTION, CURRENT EDITION. IN ADDITION TO CITY AND CDOT STANDARD SPECIFICATIONS, THE PROJECT SPECIAL PROVISIONS AND STANDARD SPECIAL PROVISIONS, CONTROL CONSTRUCTION OF THIS PROJECT.
- THE TEMPORARY CONSTRUCTION EASEMENTS ARE LIMITED TO SPECIFIC CONSTRUCTION ITEMS AND THE AREA IS TO BE RETURNED TO EXISTING CONDITION AS SOON AS POSSIBLE. THE AREAS ARE NOT TO BE USED FOR STORAGE OR PARKING.
- ALL TREES, BUSHES AND OTHER FIXED OBJECTS WITHIN THE LIMITS OF CONSTRUCTION AS NOTED ON THE PLANS SHALL BE REMOVED UNLESS OTHERWISE NOTED. ALL OTHER TREES AND BUSHES SHALL BE PROTECTED, UNLESS OTHERWISE NOTED.
- WATER SHALL BE USED AS A DUST PALLIATIVE WHERE REQUIRED. THE CONTRACTOR SHALL PROVIDE A WATER TRUCK ON-SITE FOR DUST CONTROL. WATER SHALL NOT BE PAID FOR SEPARATELY.
- THE CONTRACTOR SHALL KEEP THE WORK AREA DRY OF STANDING WATER AND SHALL KEEP THE EXCAVATION AREAS FREE FROM STORM RUN-OFF.
- THE CONTRACTOR SHALL BE RESPONSIBLE FOR THE ACCEPTANCE AND CONTROL OF ALL SURFACE AND SUBSURFACE DRAINAGE AND GROUNDWATER ENTERING THE PROJECT AREA. ANY DEWATERING NEEDED WILL NOT BE PAID FOR SEPARATELY, BUT SHALL BE INCLUDED IN THE WORK.
- THE PHYSICAL FEATURES AND EXISTING UTILITIES WITHIN THE LIMITS OF THE PROJECT HAVE BEEN SHOWN BASED ON THE BEST AVAILABLE INFORMATION AT THE TIME OF DESIGN. THE CONTRACTOR SHALL VERIFY AND BE RESPONSIBLE FOR ALL FEATURES AND EXISTING UTILITIES PRIOR TO BEGINNING ANY WORK.
- THE CONTRACTOR SHALL LIMIT CONSTRUCTION ACTIVITIES TO THOSE AREAS WITHIN THE CONSTRUCTION LIMITS AS SHOWN ON THE PLANS. ANY DISTURBANCE BEYOND THESE LIMITS SHALL BE RESTORED TO ORIGINAL CONDITION BY THE CONTRACTOR AT THE CONTRACTOR'S EXPENSE. CONSTRUCTION ACTIVITIES IN ADDITION TO NORMAL CONSTRUCTION PROCEDURE SHALL INCLUDE THE PARKING OF VEHICLES OR EQUIPMENT, DISPOSAL OF LITTER, AND ANY OTHER ACTION WHICH WOULD ALTER EXISTING CONDITIONS.
- ANY DAMAGE TO EXISTING FACILITIES SHALL BE REPAIRED IMMEDIATELY AND PRIOR TO CONTINUING OTHER WORK. ANY MUD OR OTHER MATERIAL TRACKED OR OTHERWISE DEPOSITED ON THE ROADWAY SHALL BE REMOVED DAILY OR AS ORDERED BY THE INSPECTOR.
- ANY MATERIALS REMOVED FROM THIS PROJECT WILL BE DISPOSED OF BY THE CONTRACTOR. AT THE CITY'S DISCRETION, SOME MATERIALS MAY REMAIN THE PROPERTY OF THE CITY OR THE ADJACENT PROPERTY OWNERS.
- THE CONTRACTOR SHALL PROVIDE AND MAINTAIN ACCESS TO PUBLIC STREETS AND PRIVATE PROPERTY ADJOINING THE PROJECT. THE CONTRACTOR WILL NOT BE ALLOWED TO SHUT OFF ACCESS TO ANY PROPERTY AND MUST COORDINATE HIS WORK WITH THE PROPERTY OWNERS.
- ONE-HALF INCH EXPANSION JOINT MATERIAL SHALL BE INSTALLED WHEN ABUTTING ANY EXISTING CONCRETE TO A FIXED STRUCTURE. ZIP CAP SPACERS SHALL BE USED TO PROVIDE A CLEAN JOINT PRIOR TO CALKING.
- THE CONTRACTOR SHALL PROVIDE SHORING AT ALL LOCATIONS NECESSARY TO SUPPORT THE EARTH AND/OR ROADWAY ADJACENT TO AN EXCAVATION, EMBANKMENT, OR OTHER CONSTRUCTION OPERATION. LOCATIONS SHALL BE AS DETERMINED BY THE CONTRACTOR'S SEQUENCE OF OPERATIONS AND TRAFFIC CONTROL ARRANGEMENTS. SHORING SHALL NOT BE PAID FOR SEPARATELY, BUT SHALL BE INCLUDED IN THE WORK.
- CONTRACTOR IS RESPONSIBLE FOR DETERMINING AND OBTAINING A SUITABLE STAGING AREA.
- WITH NOTIFICATION OF THE RESPECTIVE OWNER, ADJUST RIMS OF ALL MANHOLES, CLEANOUTS, VALVE BOXES AND SURVEY MONUMENTS TO FINISH GRADE PRIOR TO FINAL PAVEMENT LIFT.
- THE CONTRACTOR SHALL BE RESPONSIBLE FOR AND PAY FOR ALL TESTING. ALL SUBGRADE, CONCRETE, AND ASPHALTIC PAVEMENT TESTING SHALL CONFORM TO THE STEAMBOAT SPRINGS STANDARD SPECIFICATIONS. ALL TEST RESULTS SHALL BE FORWARDED TO THE ENGINEER FOR HIS REVIEW AND APPROVAL.
- THE CONTRACTOR SHALL PROVIDE A MEDIUM BROOM FINISH ON ALL CONCRETE WALKS, RAMPS AND PAVING SURFACES.
- THE CONTRACTOR SHALL BE RESPONSIBLE FOR THE DEMOLITION AND REMOVAL OF ALL CONCRETE, FOUNDATIONS, WALKS, WALLS, TREES AND OTHER DEBRIS INDICATED ON THE SURVEY OR SPECIFIED IN THE SITE WORK SPECIFICATIONS. ALL SALVAGEABLE STORM SEWER GRATES, INLETS OR MANHOLE RING AND COVERS WHICH ARE NOT BEING RE-USED ON SITE SHALL BE RETURNED TO STEAMBOAT SPRINGS.
- THE CONTRACTOR SHALL PROTECT ALL STRUCTURES DURING THE CONSTRUCTION OF THIS PROJECT. THE CONTRACTOR SHALL BE LIABLE FOR ANY DAMAGE.
- THE CONTRACTOR SHALL BE RESPONSIBLE FOR ERECTING AND MAINTAINING BARRICADES AND OTHER TRAFFIC CONTROL DEVICES AS NECESSARY AROUND THE PERIMETER AND ADJACENT PUBLIC STREETS. THE CONTRACTOR SHALL BE REQUIRED TO COORDINATE WITH ALL BUSINESS OWNERS ON ANTICIPATED CLOSURE OF THE ACCESS POINTS ONTO ADJACENT PROPERTY. CONTRACTOR TO PROVIDE A TRAFFIC CONTROL PLAN TO THE CITY FOR REVIEW AND APPROVAL.
- THE CONTRACTOR SHALL BE RESPONSIBLE FOR ALL TRENCH BOX AND/OR SHORING DESIGN ASSOCIATED WITH ALL COMPONENTS OF THIS WORK.
- PHASE 1 PROJECT DISTURBANCE = 0.64 ACRES. PHASE 2 PROJECT DISTURBANCE = 1.32 ACRES. TOTAL PROJECT DISTURBANCE = 1.63 ACERS.

LEGEND

EXISTING LINETYPES	PROPOSED LINETYPES	
		MINOR CONTOUR (1' INTERVAL)
		MAJOR CONTOUR (5' INTERVAL)
		RIGHT-OF-WAY
		EASEMENT
		EDGE OF BUILDING
		BUILDING OVERHANG
		PHASE & APPROX. DISTURBANCE LIMITS
		ROADWAY CENTERLINE
		EDGE OF ASPHALT
		EDGE OF CONCRETE
		EDGE OF GRAVEL
		CURB AND GUTTER (SPILL/CATCH)
		WOOD FENCE
		DITCH FLOWLINE
		STORM SEWER
		WATER LINE
		SANITARY SEWER MAIN
		IRRIGATION LINE
		UNDERGROUND ELECTRIC
		UNDERGROUND TELEPHONE
		CABLE TV
		FIBER OPTIC

EXISTING SYMBOLS	PROPOSED SYMBOLS	
		SPOT ELEVATION
		NOMINAL SLOPE ON CUT OR FILL
		FLOW DIRECTION, TYPICALLY IN GRASSED SWALE
		FLOW DIRECTION, TYPICALLY ON PAVED SURFACES
		FIRE HYDRANT
		WATER VALVE
		SANITARY MANHOLE
		TYPE '13' VALLEY INLET
		METAL FLARED END SECTION
		LIGHT POLE
		ELECTRIC PEDESTAL
		CONIFEROUS TREE
		DECIDUOUS TREE
		SIGN
		IRRIGATION BOX
		FIBER OPTIC MARKER
		TELEPHONE MANHOLE
		POLE MOUNTED LIGHT
		ELECTRICAL JUNCTION BOX

	SIDEWALK PAVING		EXISTING ASPHALT
	GRAVEL		PROPOSED ASPHALT
	WETLANDS		

STANDARD ABBREVIATIONS

FL = FLOWLINE  
INV = INVERT  
TP = TOP OF PAVEMENT  
TC = TOP OF CONCRETE  
TO = TOP OF GRAVEL  
TBC = TOP BACK OF CURB  
HP = HIGH POINT  
LP = LOW POINT  
GB = GRADE BREAK  
EOA = EDGE OF ASPHALT  
EOG = EDGE OF GRAVEL  
TOW = TOP OF WALL  
BOW = BOTTOM OF WALL  
TOS = TOP OF STEP  
BOS = BOTTOM OF STEP  
ME = MATCH EXISTING  
CMP = CORRUGATED METAL PIPE  
HDPE = HIGH-DENSITY POLYETHYLENE  
BC = GRADE AT BUILDING CORNER  
SP = FINISH GRADE SPOT ELEVATION

RCRBD  
RECORD SET

BASELINE

Engineering - Planning - Surveying

419 OAK ST. • PO BOX 77052 • STEAMBOAT SPRINGS, CO 80477  
P. 970.879.025 • F. 303.940.9569 • www.baselinerecord.com

DESIGNED BY	SMB
DRAWN BY	SMB
CHECKED BY	CSR

REVISION	DESCRIPTION	DATE
DESIGN TEAM REVIEW/COORDINATION	CSR	5/3/18
ADDRESS TAC COMMENTS	CSR	6/7/18

CITY OF STEAMBOAT SPRINGS	ROUTT COUNTY
STEAMBOAT SPRINGS	URAAC/SSRA ICONIC ENTRY MT. WERNER CIRCLE/MT. WERNER ROAD
	NOTES AND LEGEND

PREPARED UNDER THE DIRECT SUPERVISION OF



FOR AND ON BEHALF OF  
BASELINE CORPORATION


INITIAL SUBMITTAL	5/3/18
DRAWING SIZE	24" X 36"
SURVEY FIRM	D&D, INC.
SURVEY DATE	10/11/14
JOB NO.	C020169
DRAWING NAME	C020169 CD COVER.dwg
SHEET	2 OF 13







O:\CO20169 Iconic Entry\Drawings\CO20169 CIVIL CDs.dwg, 6/7/2018 9:57:01 AM, Chris Rundell

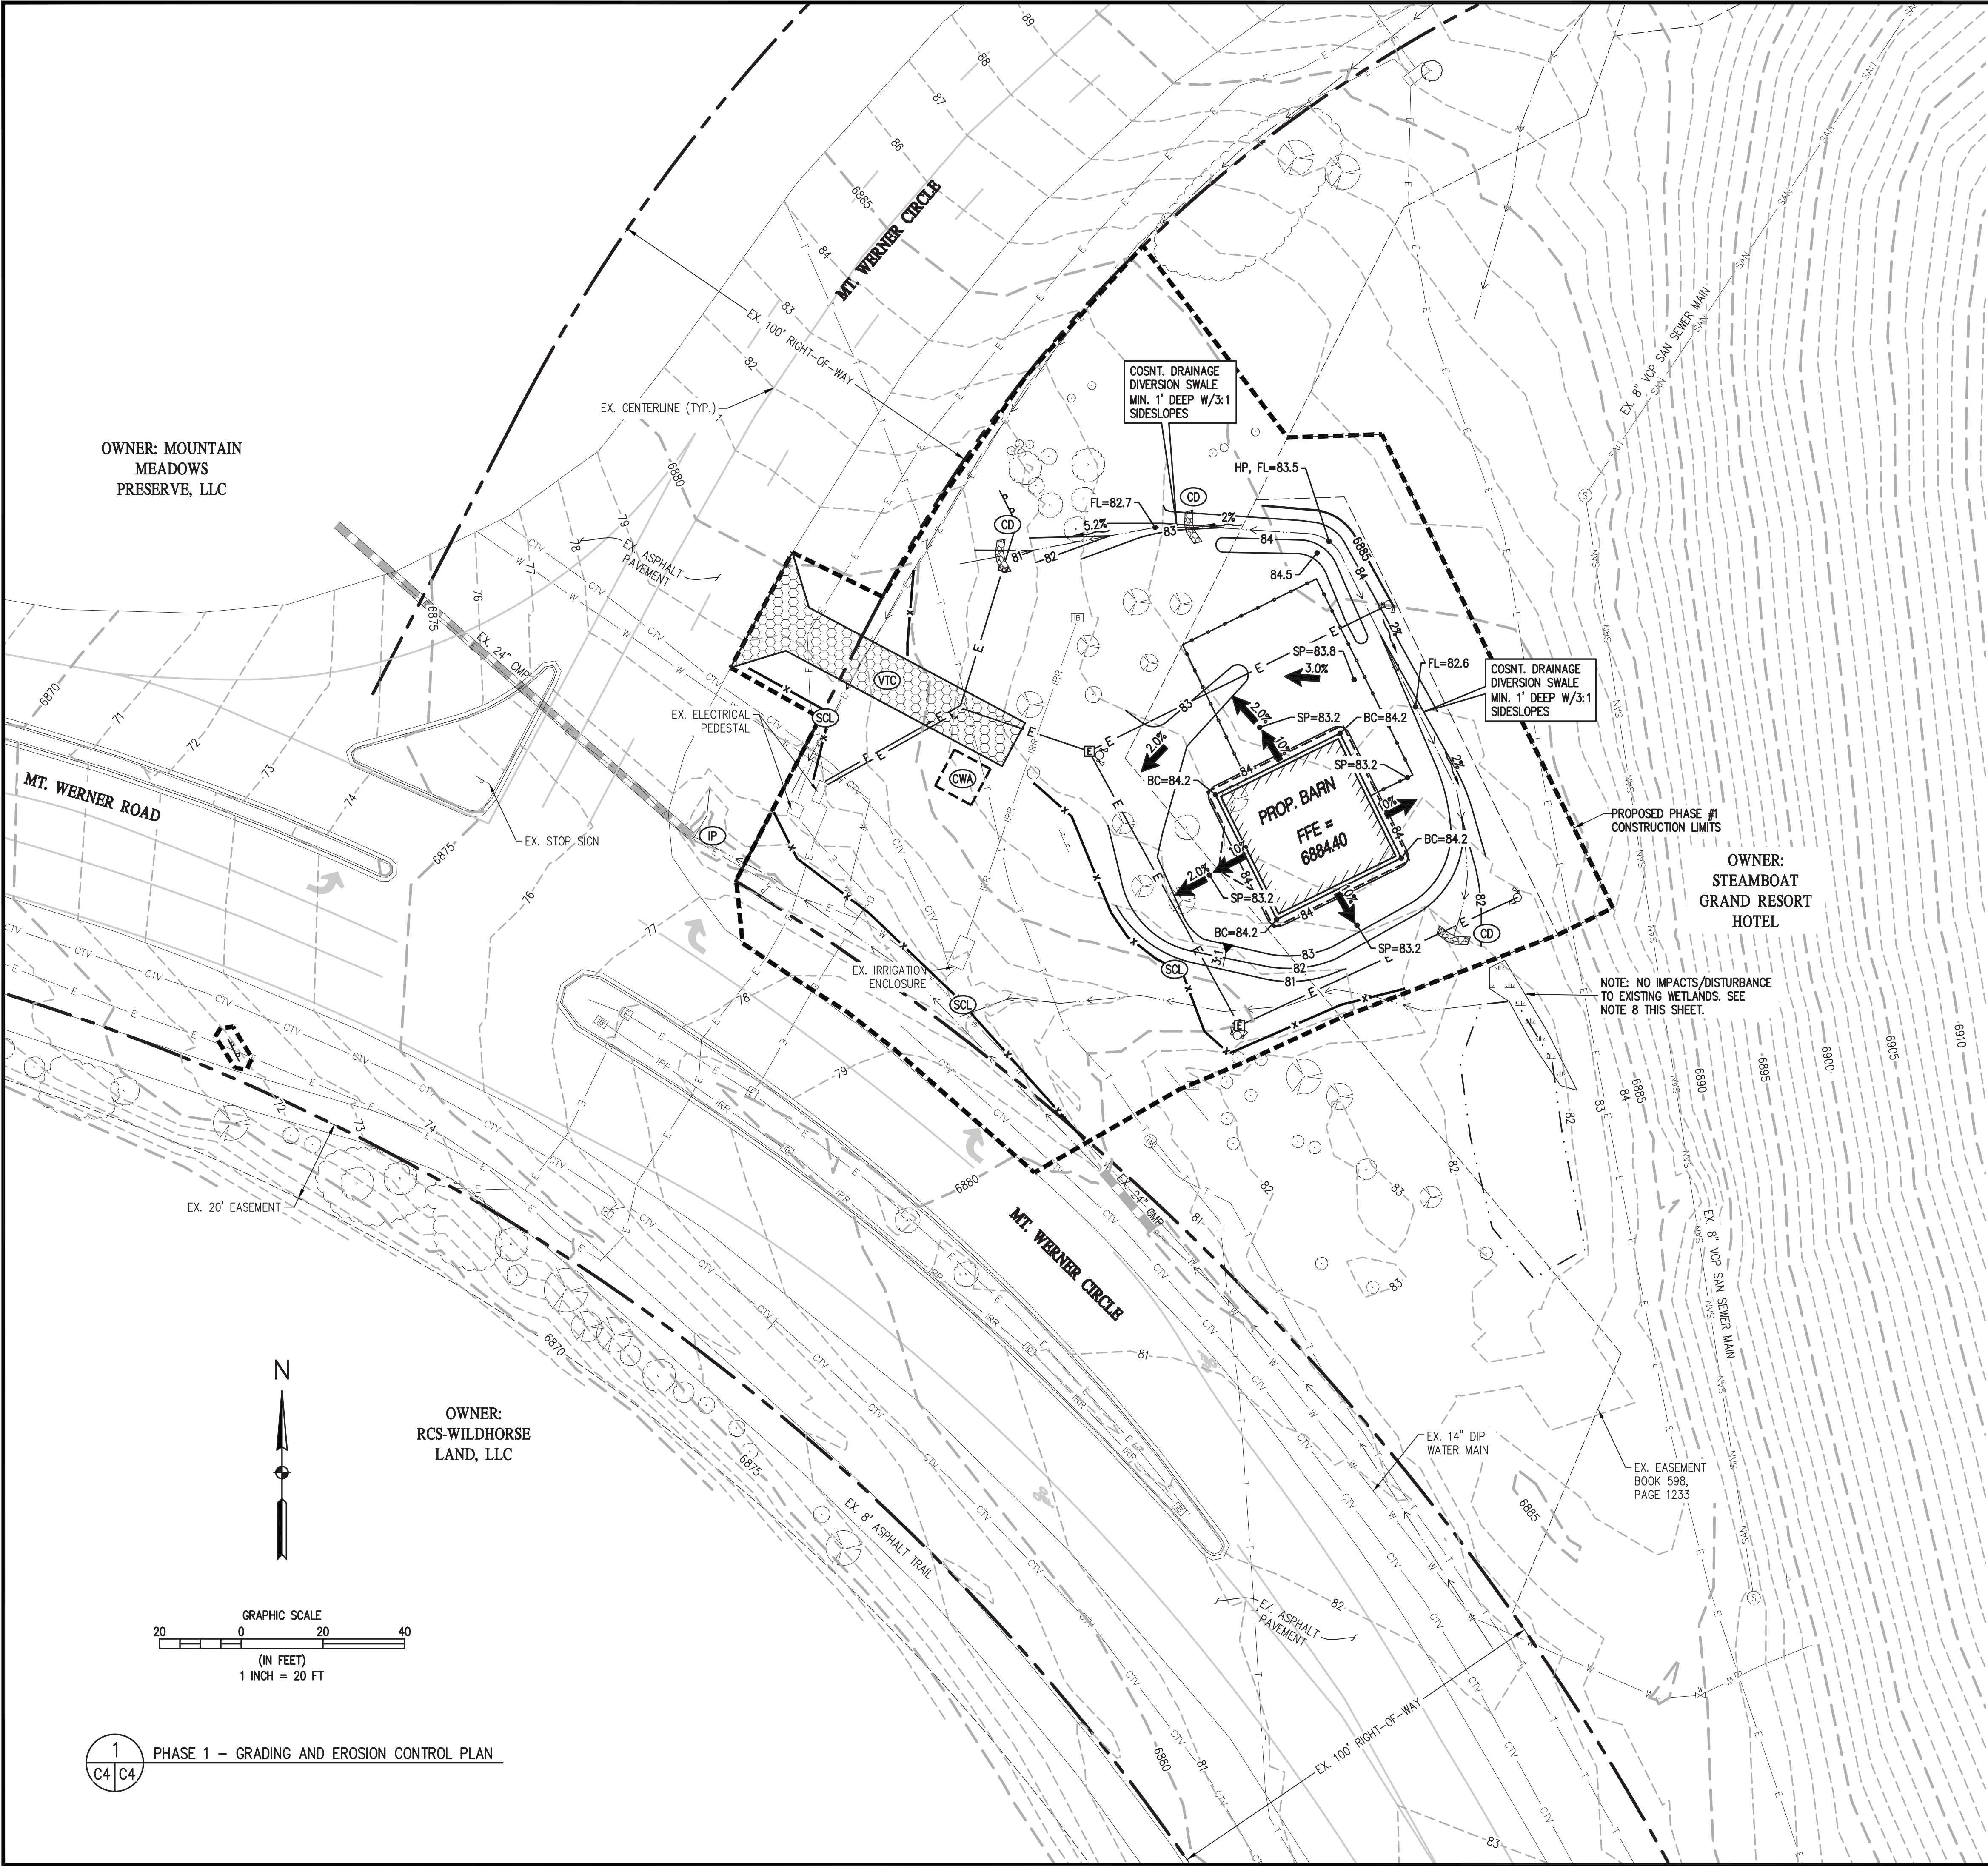

RCRBD  
RECORD SET

EROSION AND SEDIMENT CONTROL LEGEND

- IP INLET PROTECTION
- OP OUTLET PROTECTION
- RS ROCK SOCK
- VTC VEHICLE TRACKING CONTROL
- LOD LIMITS OF DISTURBANCE
- CWA CONCRETE WASHOUT AREA
- SP STOCKPILE
- SSA STABILIZED STORAGE AREA
- SCL SEDIMENT CONTROL LOG
- ECB EROSION CONTROL BLANKET
- CD ROCK CHECK DAM

EROSION CONTROL NOTES:

1. CONTRACTOR IS RESPONSIBLE TO LOCATE CONCRETE WASHOUT AREA, STOCKPILE LOCATION, AND STABILIZED STORAGE AREA WHERE IT WILL NOT INTERFERE WITH TRAFFIC AND ADJACENT PROPERTY OWNERS AND UPDATE THE PLAN ACCORDINGLY.
2. ANY STOCKPILES SHALL HAVE A SEDIMENT CONTROL LOG OR SILT FENCE AROUND THE PERIMETER OF THE STOCKPILE.
3. CONTRACTOR TO PLACE VEHICLE TRACKING CONTROL (VTC) AT ALL LOCATIONS WHERE THERE IS THE POTENTIAL TO TRACK MUD ON THE EXISTING PAVEMENT. VTC LOCATION TO BE COORDINATED WITH THE BUILDING MOVER.
4. ROCK CHECK DAMS ARE TO REMAIN IN PLACE AS PERMANENT BMP.
5. SILT FENCE MAY BE USED IN LIEU OF SEDIMENT CONTROL LOG.
6. REFER TO LANDSCAPE PLANS FOR REVEGETATION AND PLANTINGS.
7. CONTRACTOR TO COORDINATE ON EXACT LOCATION OF VEHICLE TRACKING CONTROL PAD WITH HOUSE MOVER AND OWNER'S REP. A TEMPORARY CULVERT MAY NECESSARY DEPENDING ON THE LOCATION. CONTRACTOR TO COORDINATE WITH ENGINEER.
8. CONTRACTOR TO INSTALL TEMPORARY ORANGE CONSTRUCTION FENCING ALONG TEMPORARY CONSTRUCTION EASEMENT LINE IN THE AREA ADJACENT TO THE EXISTING WETLANDS TO DELINEATE DISTURBANCE AREA AND AVOID INADVERTENT IMPACTS TO WETLANDS.

**BASELINE**  
Engineering - Planning - Surveying


419 OAK ST. • PO BOX 77052 • STEAMBOAT SPRINGS, CO 80477  
P. 970.679.025 • F. 303.340.9569 • www.baselinengr.com

DESIGNED BY	DATE	PREPARED BY	REVISION DESCRIPTION
SMB	5/3/18	CSR	DESIGN TEAM REVIEW/COORDINATION
DRAWN BY	6/7/18	CSR	ADDRESS TAC COMMENTS
CHECKED BY			
CSR			

CITY OF STEAMBOAT SPRINGS  
ROUTE COUNTY  
URAAC/SSRA ICONIC ENTRY  
MT. WERNER CIRCLE/MT. WERNER ROAD  
PHASE 1 - GRADING AND EROSION CONTROL PLAN

STEAMBOAT SPRINGS

PREPARED UNDER THE DIRECT SUPERVISION OF

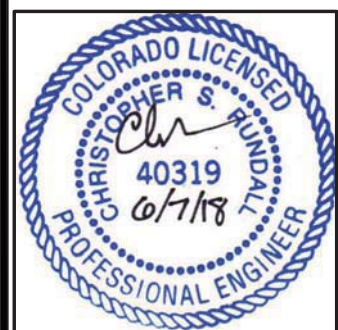

FOR AND ON BEHALF OF	BASELINE CORPORATION
INITIAL SUBMITTAL	5/3/18
DRAWING SIZE	24" X 36"
SURVEY FIRM	D&D, INC.
SURVEY DATE	10/11/14
JOB NO.	CO20169
DRAWING NAME	CO20169 CIVIL CDs.dwg
SHEET	4 OF 13



O:\C020169 Iconic Entry Drawings\C020169 CIVIL CDs.dwg, 6/7/2018 9:57:09 AM, Chris Rundall

REGULATORY SIGN NOTES:

1. ALL SIGN POSTS SHALL BE 2-3/8" DIAMETER GALVANIZED STEEL WITH CAP. THE SIGN SUPPORT SHALL BE THE TUBULAR CONCRETE FOOTING WITH WEDGE SHOWN ON CDOT DETAIL S-614-8 SHEET 1.
2. ALL REGULATORY SIGNS SHALL BE HIGH INTENSITY PRISMATIC (HIP.) PEDESTRIAN CROSSING SIGN R1-6 SHALL BE FLUORESCENT GREEN DIAMOND GRADE.
3. ALL SIGN MATERIAL SHALL BE ALUMINUM (0.080").
4. THE SIZE OF THE INDIVIDUAL SIGNS ARE TO MEET THE "CONVENTIONAL ROAD SINGLE LANE" CATEGORY LISTED IN THE MUTCD TABLES 2B-1 AND 2C-2.

OWNER: MOUNTAIN  
MEADOWS  
PRESERVE, LLC

OWNER:  
STEAMBOAT  
GRAND RESORT  
HOTEL

NOTE: PHASE 2 CIVIL WORK  
IS NOT PART OF BUILDING  
PERMIT APPLICATION

**BASELINE**  
Engineering - Planning - Surveying

419 OAK ST. • PO BOX 77052 • STEAMBOAT SPRINGS, CO 80477  
P. 970.679.025 • F. 303.940.9569 • www.baselinecorp.com


DESIGNED BY	SMB
DRAWN BY	SMB
CHECKED BY	CSR

DATE	5/3/18
PREPARED BY	CSR
DESIGN TEAM REVIEW/COORDINATION	CSR
ADDRESS TAC COMMENTS	

REVISION	DESCRIPTION
1	DESIGN TEAM REVIEW/COORDINATION
2	ADDRESS TAC COMMENTS

CITY OF STEAMBOAT SPRINGS  
STEAMBOAT SPRINGS  
ROUTT COUNTY  
URAAC/SSRA ICONIC ENTRY  
MT. WERNER CIRCLE/MT. WERNER ROAD  
PHASE 2 - SITE PLAN

PREPARED UNDER THE DIRECT  
SUPERVISION OF

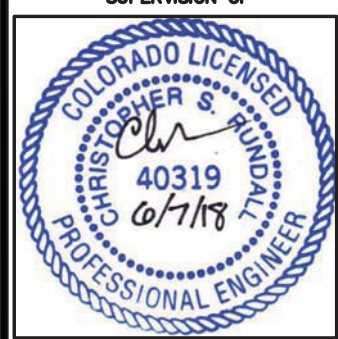


FOR AND ON BEHALF OF BASELINE CORPORATION	
INITIAL SUBMITTAL	5/3/18
DRAWING SIZE	24" X 36"
SURVEY FIRM	D&D, INC.
SURVEY DATE	10/11/14
JOB NO.	C020169
DRAWING NAME	C020169 CIVIL CDs.dwg
SHEET	5 OF 13

C5


SPEED  
LIMIT  
**25**  
R2-1



PHASE 1 IMPROVEMENT:  
REFER TO PHASE 1  
SITE PLAN

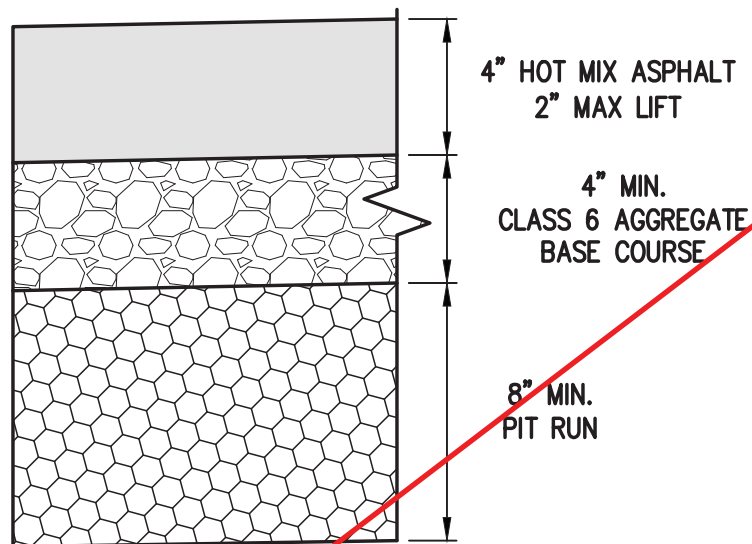

FLEXIBLE PAVEMENT SECTION  
NOT TO SCALE

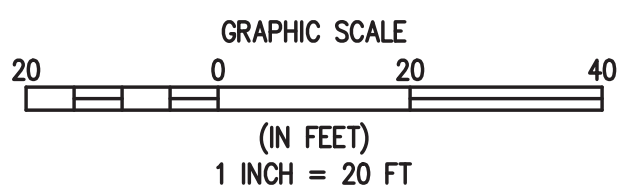

1  
C5 C5  
PHASE 2 - SITE PLAN

SITE PLAN NOTES:


1. RAILING AT STAIRS TO BE 1-3/4" ROUND OR SQUARE METAL TUBING - GALVANIZED OR POWDER COATED. RAILING SHALL MEET ALL BUILDING CODE REQUIREMENTS. CONTRACTOR TO SUBMIT SHOP DRAWING FOR REVIEW/APPROVAL.
2. ALL IMPROVEMENTS TO COMPLY WITH APPLICABLE CDOT M&S STANDARD DETAILS (M-603-4, M-608-1, ETC.)







C:\CO20169 Iconic Entry Drawings\CO20169 CIVIL CDs.dwg, 6/7/2018 9:59:59 AM, Chris Rundall

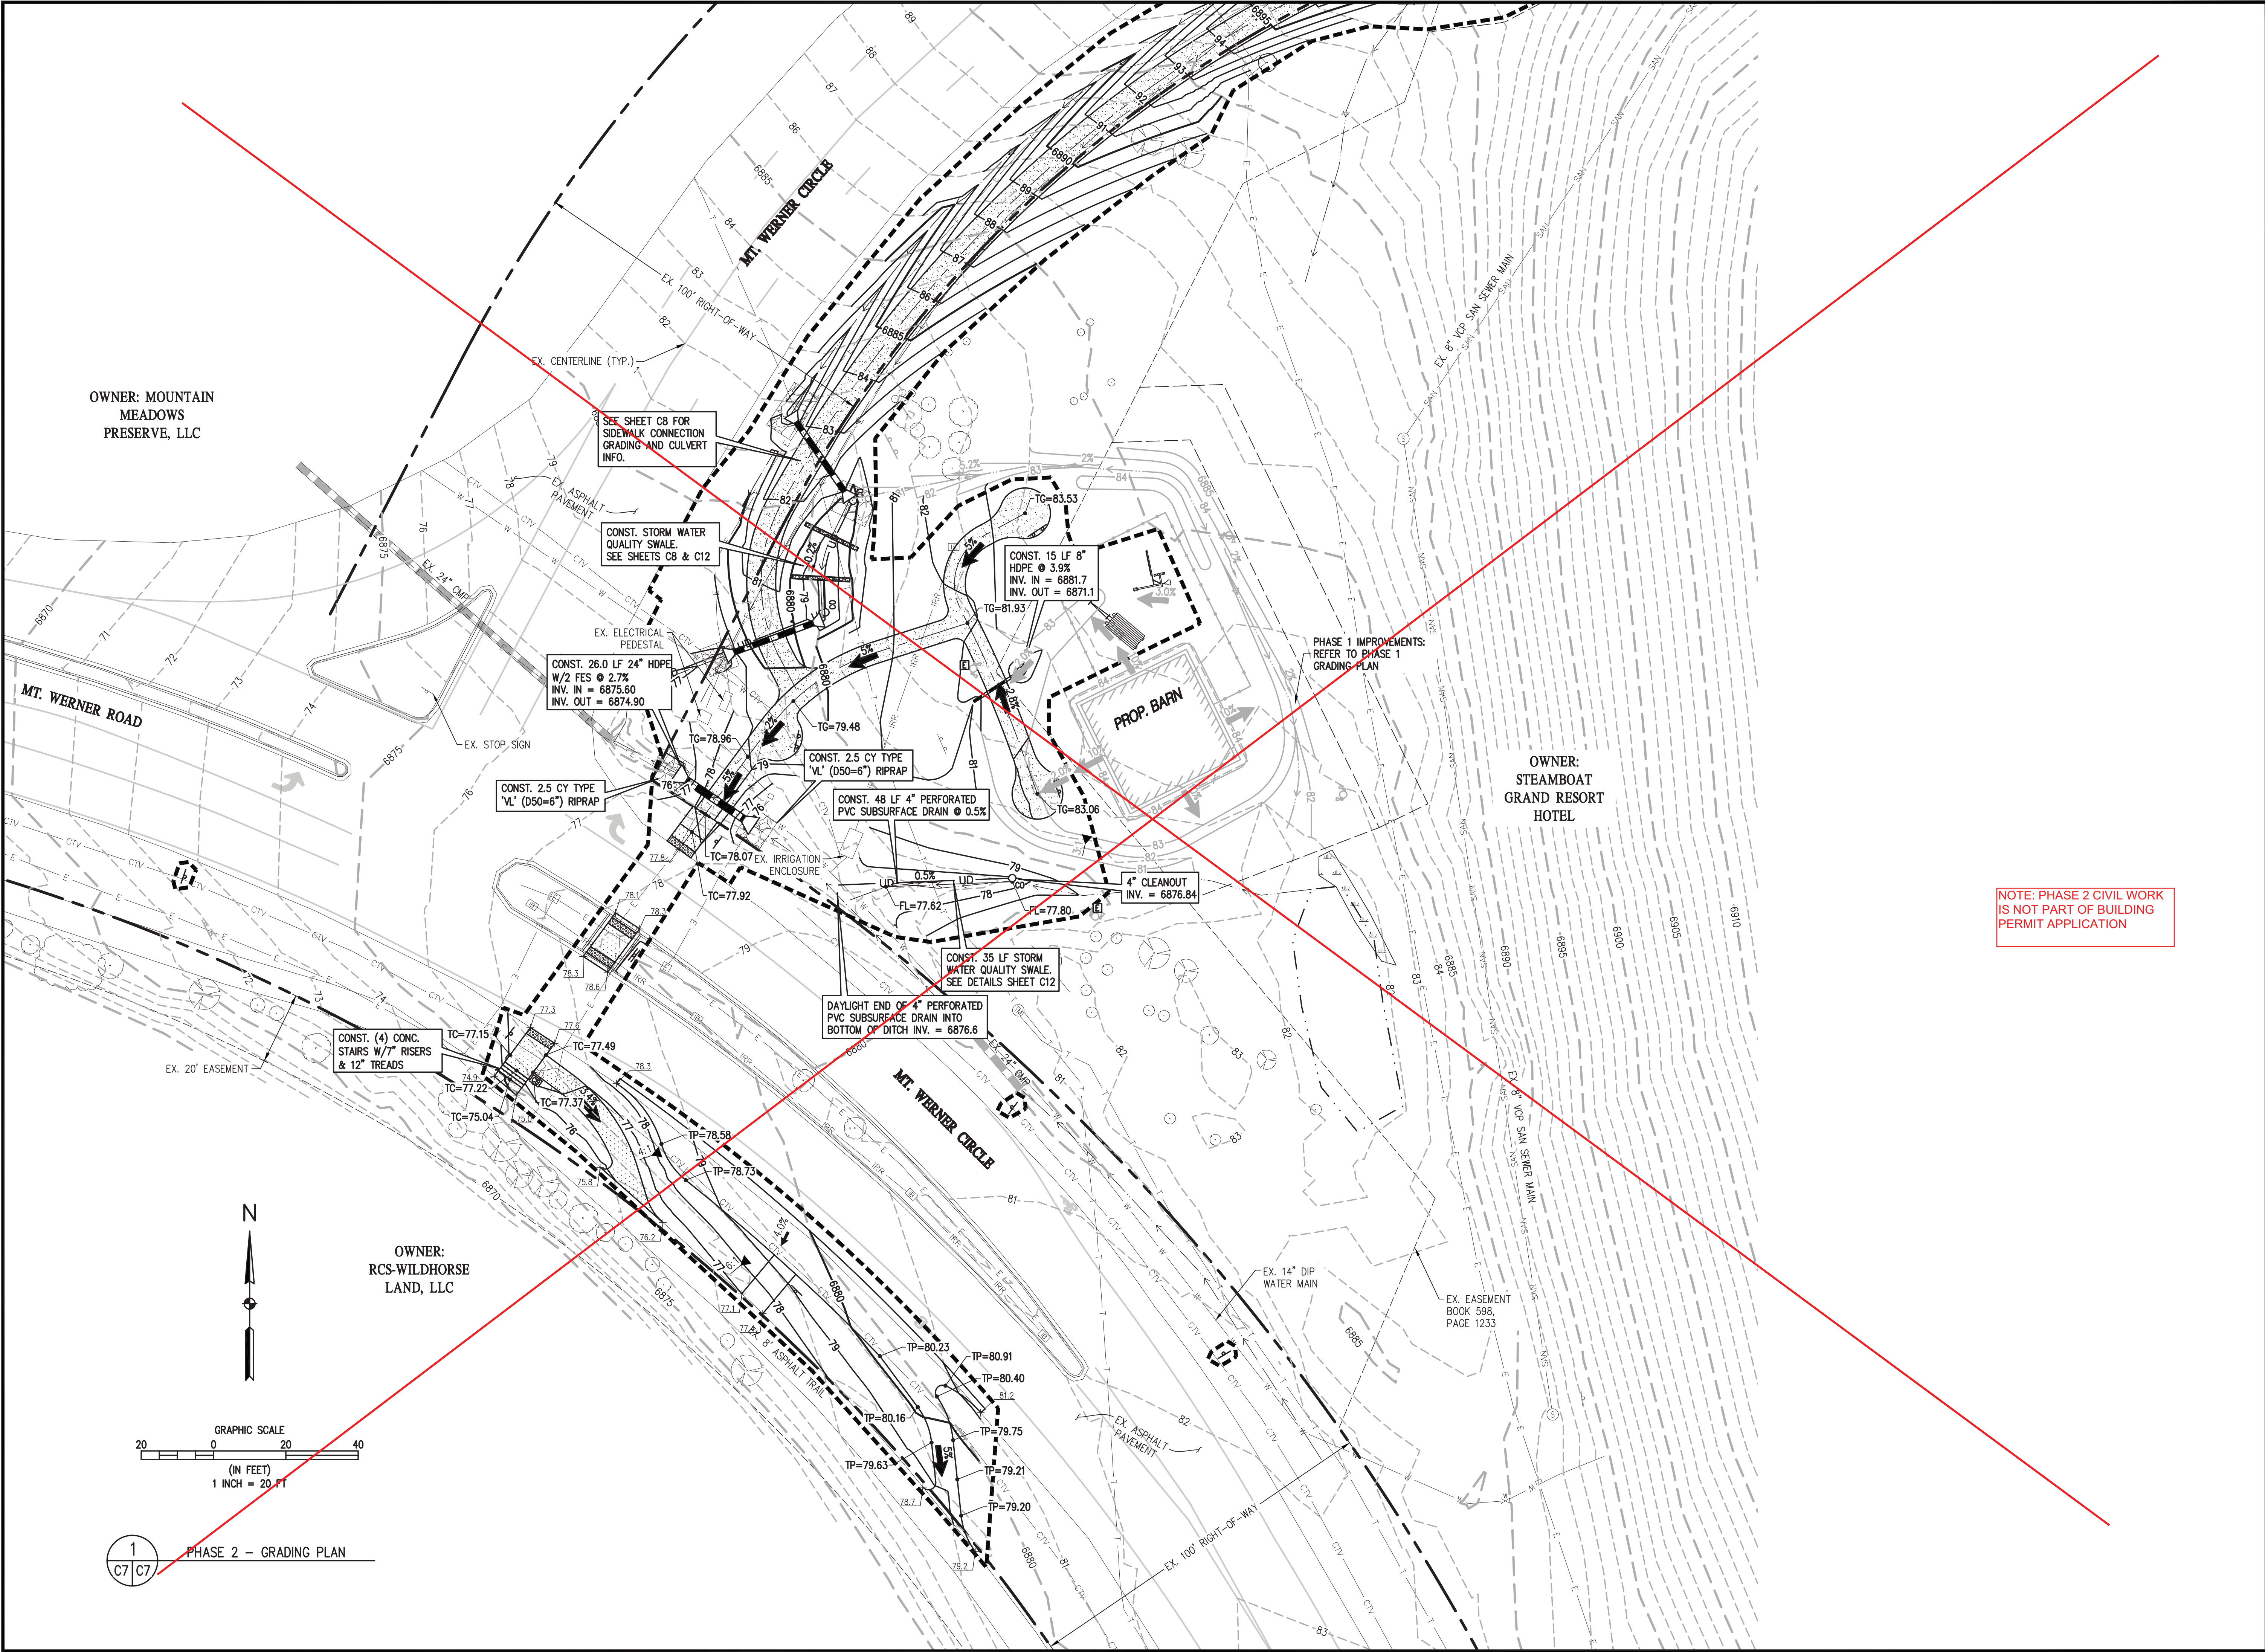

OWNER: MOUNTAIN  
MEADOWS  
PRESERVE, LLC

MT. WERNER ROAD

OWNER:  
STEAMBOAT  
GRAND RESORT  
HOTEL

NOTE: PHASE 2 CIVIL WORK  
IS NOT PART OF BUILDING  
PERMIT APPLICATION

1  
C7/C7 PHASE 2 - GRADING PLAN

BASELINE

Engineering • Planning • Surveying

419 OAK ST. • PO BOX 77052 • STEAMBOAT SPRINGS, CO 80477  
P. 970.679.025 • F. 303.940.9569 • www.baselineincorp.com

DESIGNED BY  
SMB

DRAWN BY  
SMB

CHECKED BY  
CSR

DATE  
5/3/18

PREPARED BY  
CSR

REVISION DESCRIPTION

DESIGN TEAM REVIEW/COORDINATION

ADDRESS TAC COMMENTS

CITY OF STEAMBOAT SPRINGS

ROUTT COUNTY

URAAC/SSRA ICONIC ENTRY  
MT. WERNER CIRCLE/MT. WERNER ROAD  
PHASE 2 - GRADING PLAN

FOR AND ON BEHALF OF  
BASELINE CORPORATION

PROFESSIONAL ENGINEER  
40319  
6/7/18

INITIAL SUBMITTAL 5/3/18

DRAWING SIZE 24" X 36"

SURVEY FIRM SURVEY DATE  
D&D, INC. 10/11/14

JOB NO. CO20169

DRAWING NAME  
CO20169 CIVIL CDs.dwg


SHEET 7 OF 13

C7








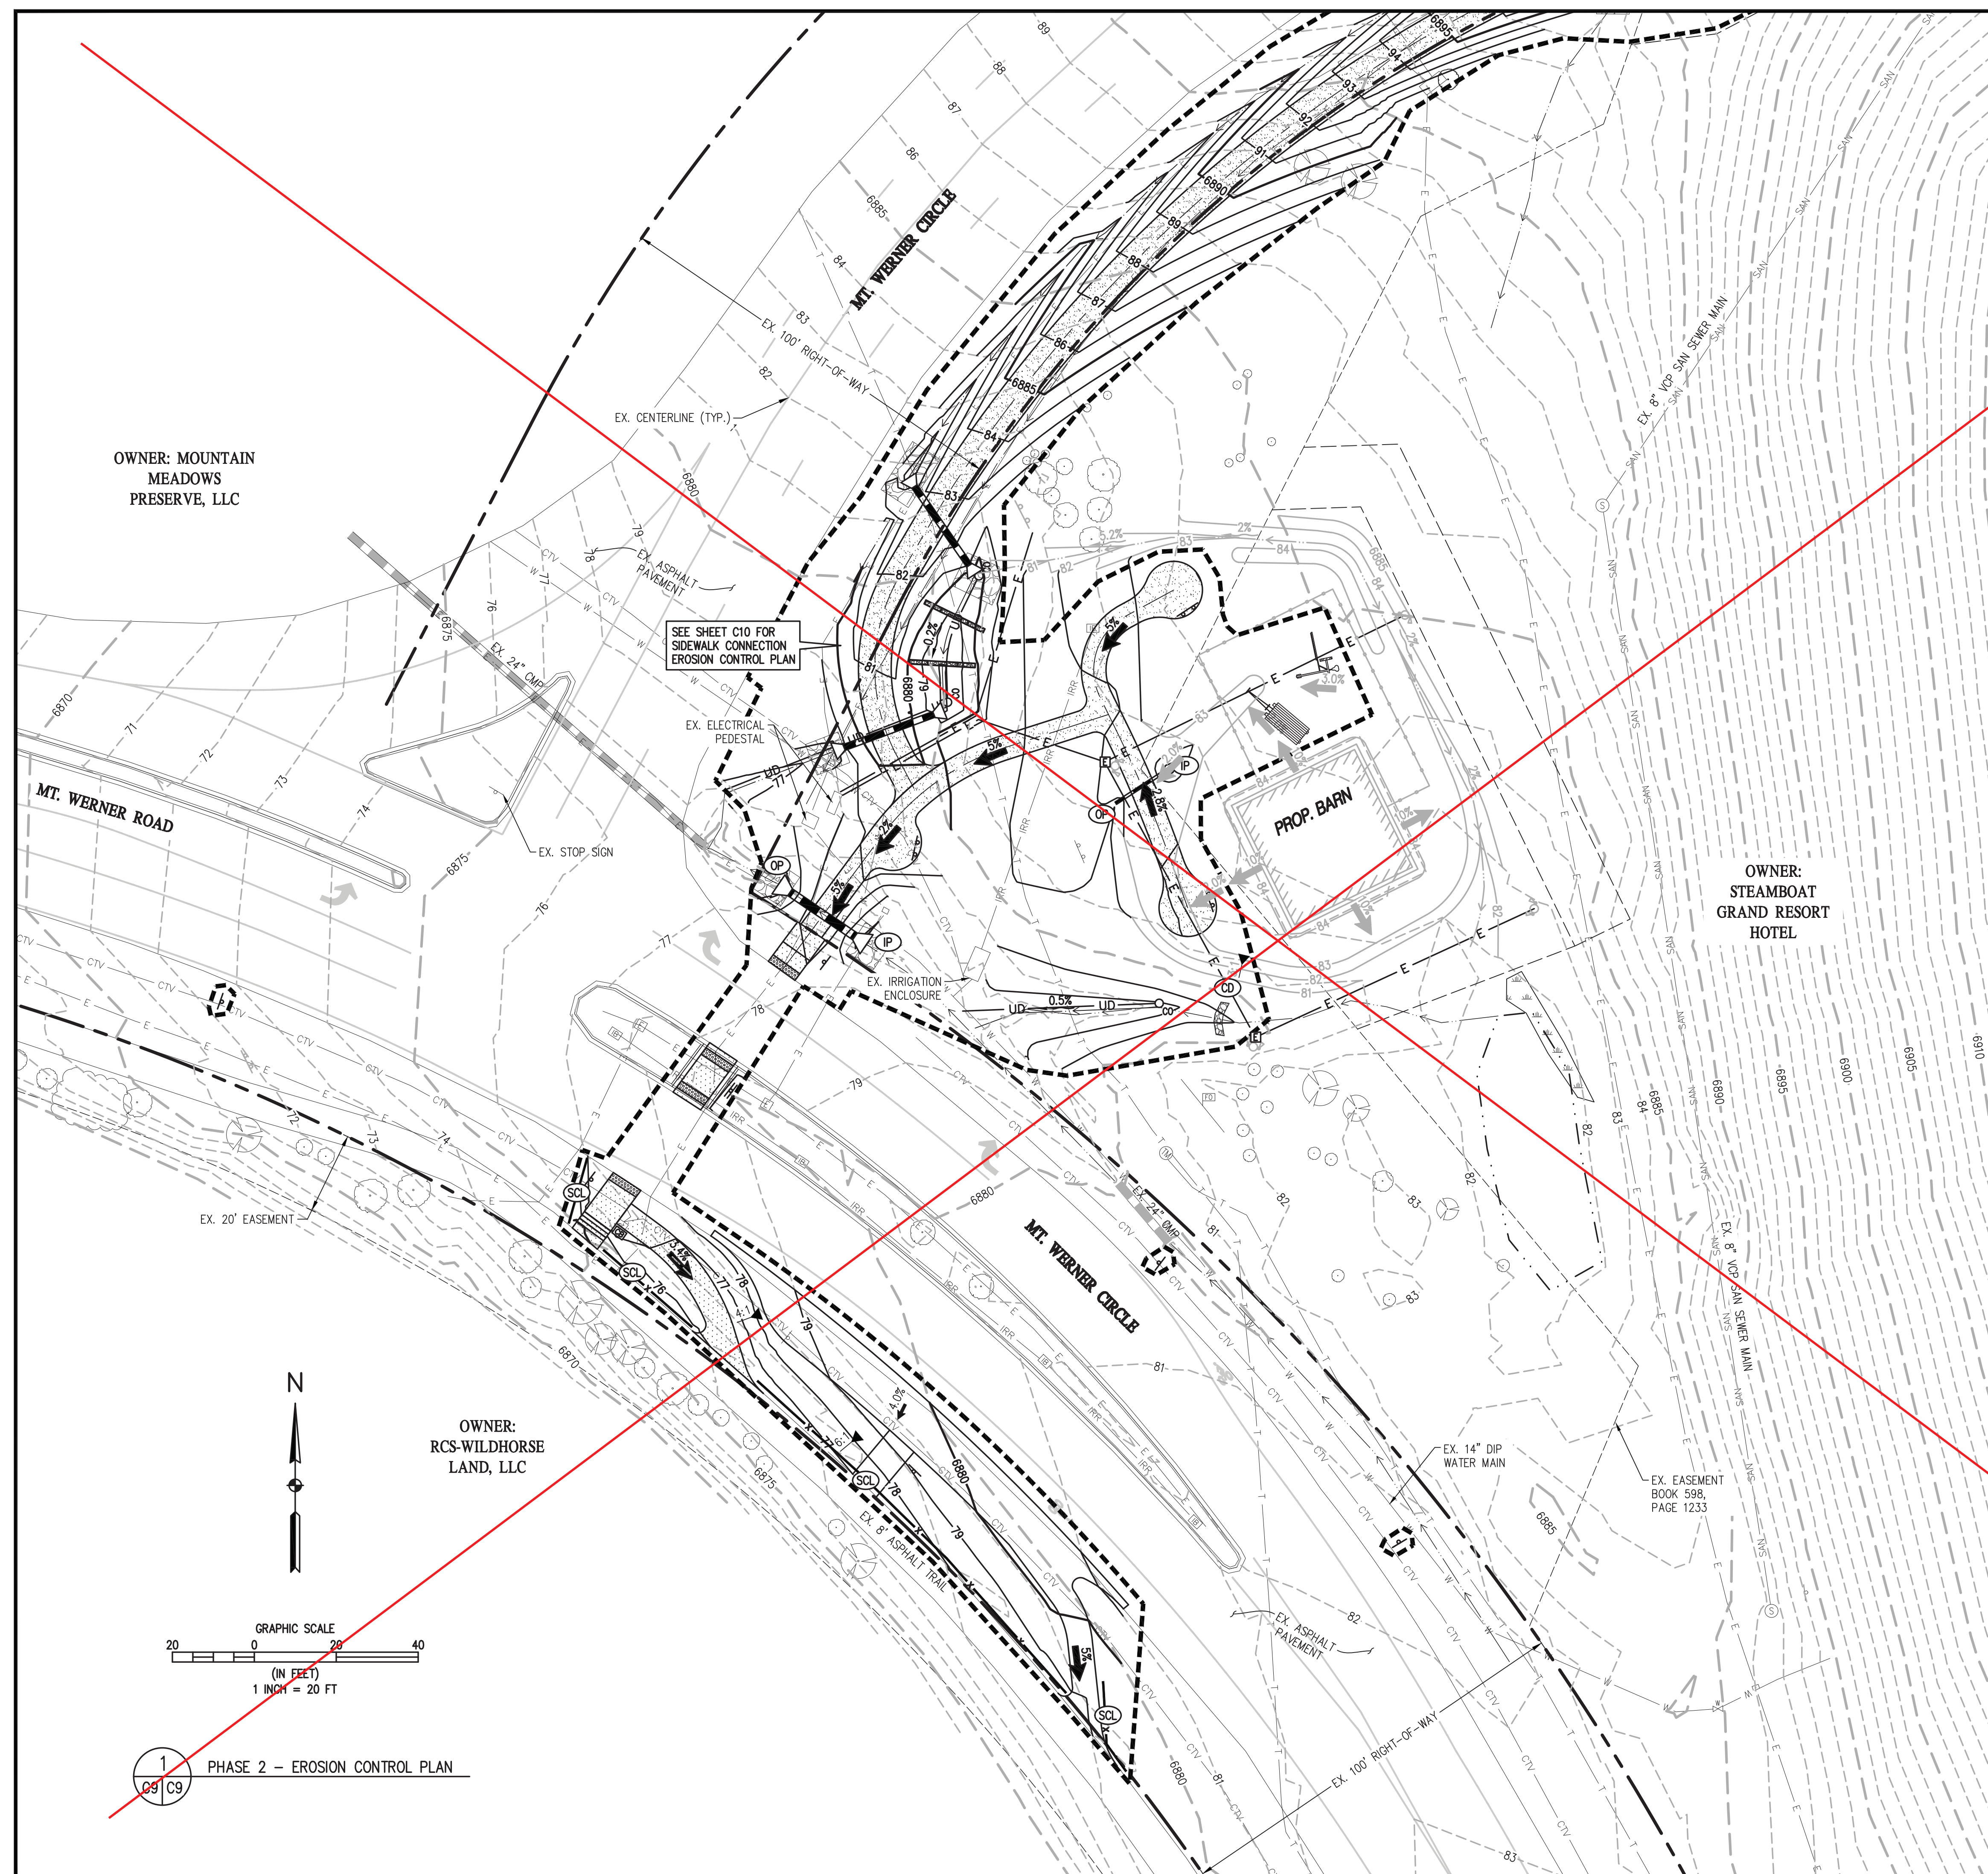

**EROSION AND SEDIMENT CONTROL LEGEND**

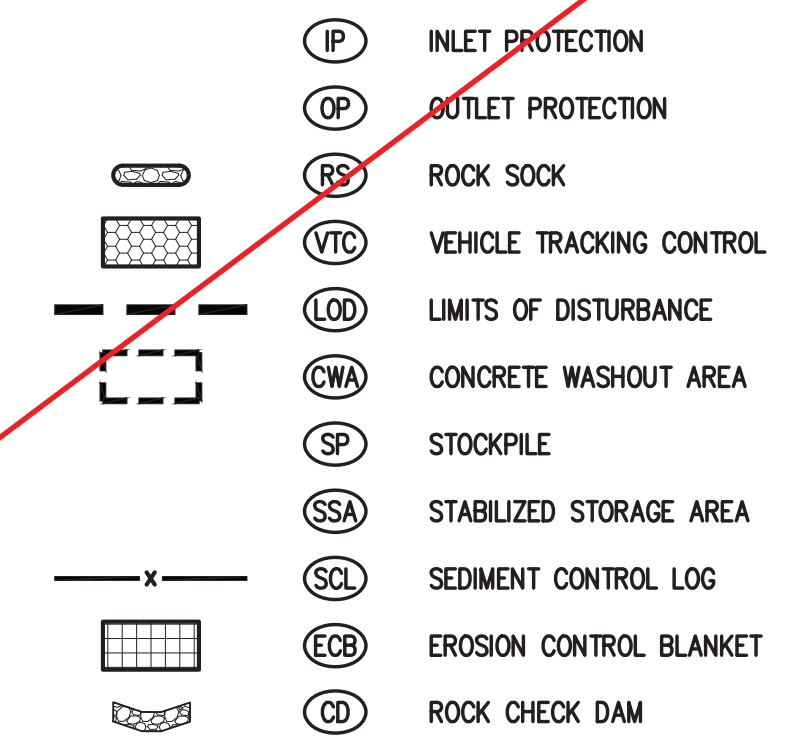

EROSION CONTROL NOTES:

1. CONTRACTOR IS RESPONSIBLE TO LOCATE CONCRETE WASHOUT AREA, STOCKPILE LOCATION, AND STABILIZED STORAGE AREA WHERE IT WILL NOT INTERFERE WITH TRAFFIC AND ADJACENT PROPERTY OWNERS AND UPDATE THE PLAN ACCORDINGLY.
2. ANY STOCKPILES SHALL HAVE A SEDIMENT CONTROL LOG OR SILT FENCE ALONG THE PERIMETER OF THE STOCKPILE.
3. CONTRACTOR TO PLACE VEHICLE TRACKING CONTROL (VTC) AT ALL LOCATIONS WHERE THERE IS THE POTENTIAL TO TRACK MUD ON THE EXISTING PAVEMENT. VTC LOCATION TO BE COORDINATED WITH THE BUILDING MOVER.
4. ROCK CHECK DAMS ARE TO REMAIN IN PLACE AS PERMANENT BMP.
5. SILT FENCE MAY BE USED IN LIEU OF SEDIMENT CONTROL LOG.
6. REFER TO LANDSCAPE PLANS FOR REVEGETATION AND PLANTINGS.

NOTE: PHASE 2 CIVIL WORK  
IS NOT PART OF BUILDING  
PERMIT APPLICATION

OWNER: MOUNTAIN  
MEADOWS  
PRESERVE, LLC

OWNER:  
STEAMBOAT  
GRAND RESORT  
HOTEL

OWNER:  
RCS-WILDHORSE  
LAND, LLC

GRAPHIC SCALE

(IN FEET)

1 INCH = 20 FT

## PHASE 2 – EROSION CONTROL PLAN

**BASELINE**  
Engineering • Planning • Surviving

419 OAK ST • PO BOX 770152 • STEAMBOAT SPRINGS, CO 80477  
P: 970.879.1825 • F: 303.940.9959 • [www.baselinecorp.com](http://www.baselinecorp.com)

DESIGNED BY SMB	DRAWN BY SMB	CHECKED BY CSR
--------------------	-----------------	-------------------

PREPARED BY	DATE
CSR	5/3/18
CSR	6/7/18

REVISION	DESCRIPTION
	DESIGN TEAM REVIEW/COORDINATION
	ADDRESS TAC COMMENTS


	ROUTT COUNTY
--	--------------

CITY OF STEAMBOAT SPRINGS

URAAC/SSRA ICONIC ENTRY  
MT. WERNER CIRCLE/MT. WERNER ROAD  
PHASE 2 - EROSION CONTROL PLAN

**CIT**  
STEAMBOAT SPRINGS

PREPARED UNDER THE DIRECT  
SUPERVISION OF

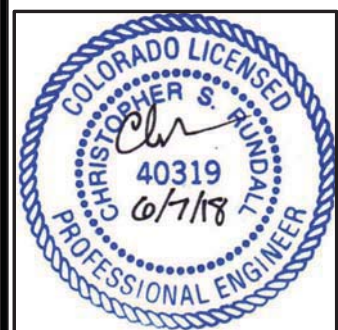

FOR AND ON BEHALF OF BASELINE CORPORATION	
INITIAL SUBMITTAL	5/3/18
DRAWING SIZE	24" X 36"
SURVEY FIRM D&D, INC.	SURVEY DATE 10/11/14
JOB NO.	C020169
DRAWING NAME C020169 CIVIL CDs.dwg	
SHEET	9 OF 13

C9




N:\C020166 Ski Time Square Mt Werner Intersection\Drawings\20169 TRAIL EC PLAN.dwg, 6/7/2018 10:04:52 AM, Chris Rundall

EROSION AND SEDIMENT CONTROL LEGEND

- IP INLET PROTECTION  
OP OUTLET PROTECTION  
RS ROCK SOCK  
VTC VEHICLE TRACKING CONTROL  
LOD LIMITS OF DISTURBANCE  
CWA CONCRETE WASHOUT AREA  
SP STOCKPILE  
SSA STABILIZED STORAGE AREA  
SCL SEDIMENT CONTROL LOG  
ECB EROSION CONTROL BLANKET  
CD ROCK CHECK DAM

EROSION CONTROL NOTES:

1. CONTRACTOR IS RESPONSIBLE TO LOCATE CONCRETE WASHOUT AREA, STOCKPILE LOCATION, AND STABILIZED STORAGE AREA WHERE IT WILL NOT INTERFERE WITH TRAFFIC AND ADJACENT PROPERTY OWNERS AND UPDATE THE PLAN ACCORDINGLY.  
2. ANY STOCKPILES SHALL HAVE A SEDIMENT CONTROL LOG OR SILT FENCE AROUND THE PERIMETER OF THE STOCKPILE.  
3. CONTRACTOR TO PLACE VEHICLE TRACKING CONTROL (VTC) AT ALL LOCATION WHERE THERE IS THE POTENTIAL TO TRACK MUD ON THE EXISTING PAVEMENT.  
4. ROCK CHECK DAMS ARE TO REMAIN IN PLACE AS PERMANENT BMP.  
5. SILT FENCE MAY BE USED IN LIEU OF SEDIMENT CONTROL LOG.

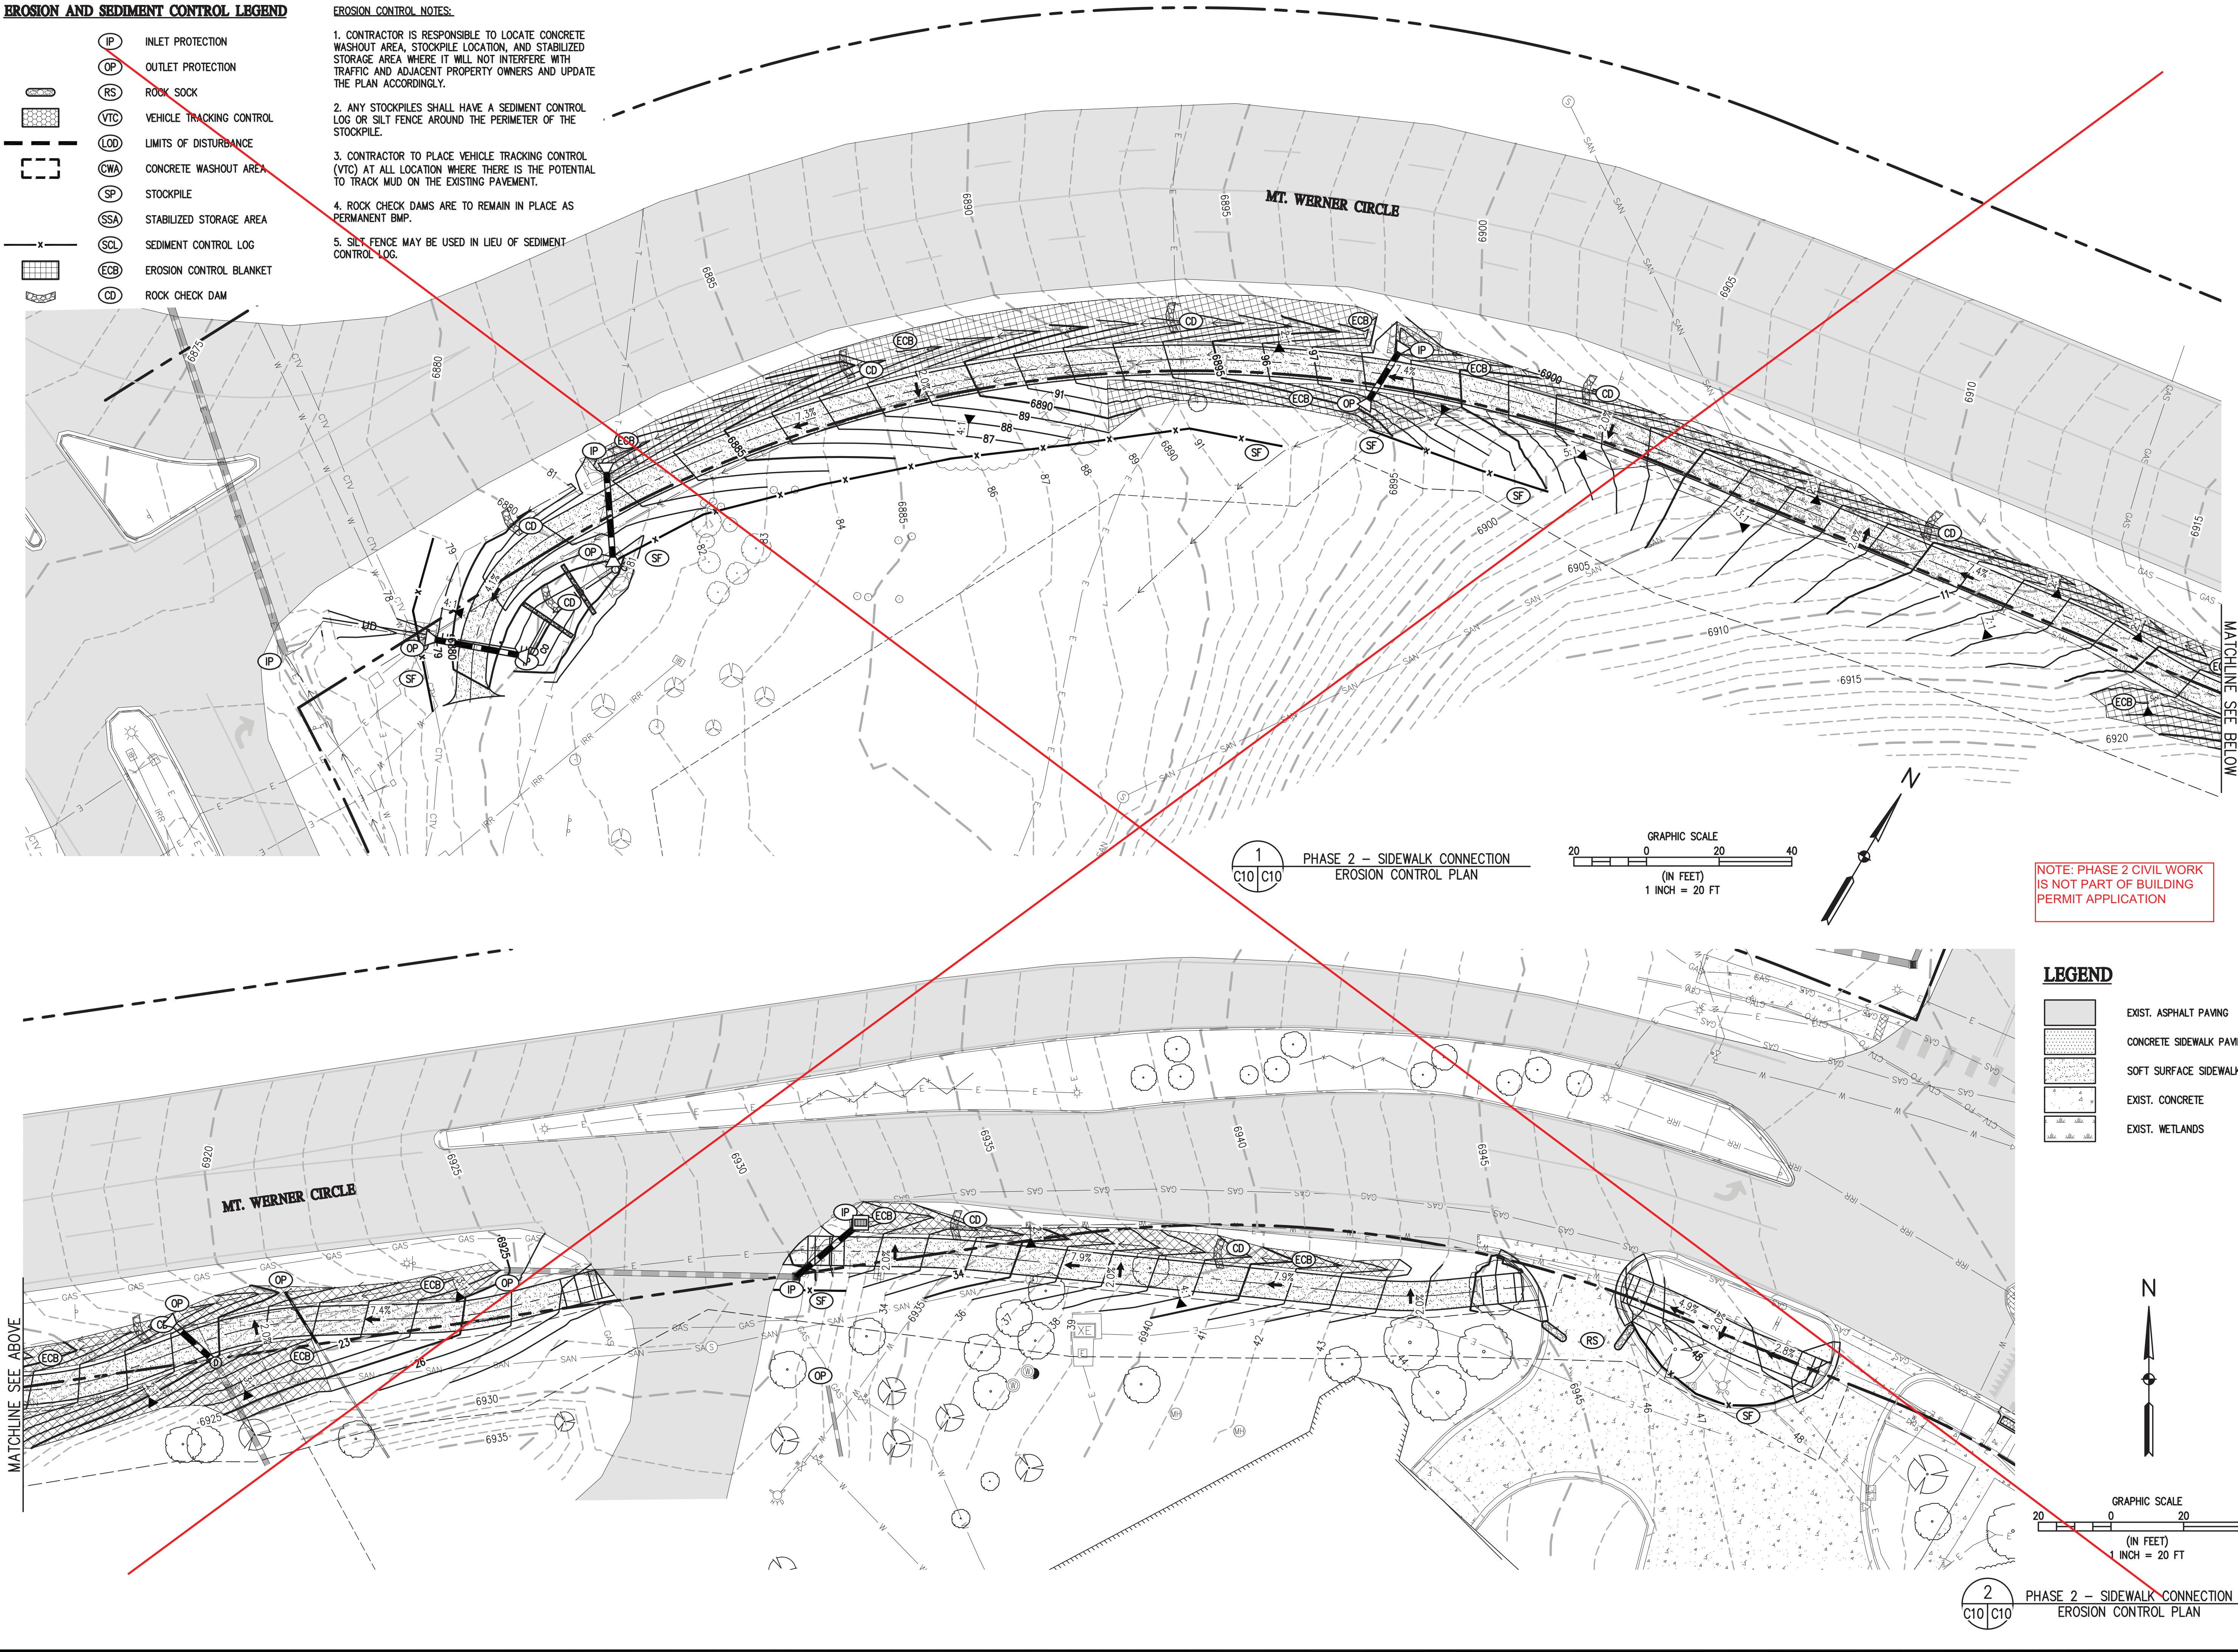

**BASELINE**  
Engineering - Planning - Surveying

419 OAK ST. • PO BOX 77052 • STEAMBOAT SPRINGS, CO 80477  
P. 970.878.025 • F. 303.340.9569 • www.baselinecorp.com

DESIGNED BY	SMB
DRAWN BY	SMB
CHECKED BY	CSR
DATE	5/3/18
PREPARED BY	CSR
REVISION DESCRIPTION	DESIGN TEAM REVIEW/COORDINATION
ADDRESS	TAC COMMENTS

**CITY OF STEAMBOAT SPRINGS**  
ROUTT COUNTY  
URAC/SSRA ICONIC ENTRY  
MT. WERNER CIRCLE/MT. WERNER ROAD  
PHASE 2 - SIDEWALK CONNECTION EROSION CONTROL PLAN

FOR AND ON BEHALF OF  
BASELINE CORPORATION  
40319  
6/7/18  
PROFESSIONAL ENGINEER

INITIAL SUBMITTAL 5/3/18  
DRAWING SIZE 24" X 36"  
SURVEY FIRM D&D, INC.  
SURVEY DATE 10/11/14  
JOB NO. C020169  
DRAWING NAME 20169 TRAIL EC PLAN.dwg  
SHEET 10 OF 13  
C10



Q:\C020169 Iconic Entry\Drawings\C020169\_CD\_COVER.dwg, 6/7/2018 10:05:03 AM, Chris Rundall

EROSION AND SEDIMENT CONTROL PLAN GENERAL NOTES:

1. THE DISTURBANCE AREA FOR THE PROJECT IS GREATER THAN ONE ACRE; THEREFORE, A STATE OF COLORADO CONSTRUCTION STORMWATER DISCHARGE PERMIT IS REQUIRED. NO ADDITIONAL PERMITTING FROM THE ARMY CORPS OF ENGINEERS WILL BE REQUIRED.
2. THE CONTRACTOR IS RESPONSIBLE FOR IMPLEMENTING AND MAINTAINING EROSION AND SEDIMENT CONTROL MEASURES AT ALL TIMES DURING CONSTRUCTION. THE STORMWATER MANAGEMENT PLANS MAY BE MODIFIED WITH APPROPRIATE APPROVALS FROM THE ENGINEER, AND MAY REQUIRE ADDITIONAL MEASURES AS FIELD CONDITIONS WARRANT.
3. A THOROUGH INSPECTION OF THE STORMWATER MANAGEMENT PLAN BEST MANAGEMENT PRACTICES (BMPs) SHALL BE PERFORMED EVERY FOURTEEN (14) CALENDAR DAYS AND AFTER ANY PRECIPITATION OR SNOWMELT EVENT. PERIODIC INSPECTIONS SHALL ALSO INCLUDE INSPECTING EQUIPMENT FOR LEAKS AND REVIEWING EQUIPMENT MAINTENANCE PRACTICE. ALL INSPECTIONS AND MAINTENANCE SHALL BE DOCUMENTED BY THE PROJECT EROSION CONTROL SUPERVISOR AND MADE AVAILABLE TO THE ENGINEER UPON REQUEST. ANY EROSION CONTROL BMP THAT HAS BEEN COMPROMISED OR HAS BEEN DISTURBED SHALL BE REPLACED OR RECONSTRUCTED. IT IS THE RESPONSIBILITY OF THE CONTRACTOR TO HAVE ALL EROSION CONTROL BMPs IN PLACE AND EFFECTIVE PRIOR TO A STORM EVENT.
4. THE STORMWATER MANAGEMENT PLAN LOG BOOK SHALL BE UPDATED EVERY FOURTEEN (14) DAYS. THIS LOG SHALL REMAIN ON SITE AVAILABLE FOR REVIEW BY THE ENGINEER UPON REQUEST. MAINTENANCE ACTIVITIES TO CORRECT PROBLEMS NOTED DURING INSPECTIONS MUST BE DOCUMENTED AND KEPT IN THE STORMWATER MANAGEMENT PLAN LOG BOOK. THE STORMWATER MANAGEMENT PLAN MUST BE UPDATED TO REFLECT ALL CHANGES TO BMP'S AND PHASING AS THE CHANGES OCCUR.
5. ALL STREETS WITHIN AND IMMEDIATELY SURROUNDING A CONSTRUCTION SITE SHALL BE CLEANED OF DIRT AND DEBRIS ON A WEEKLY BASIS AND IMMEDIATELY FOLLOWING A SPILL OR TRACKING OF EARTH MATERIALS. STREETS SHALL BE CLEANED BY SCRAPING AND SWEEPING THE DIRT OFF THE ROADWAYS. SCRAPED OR SWEEPED MATERIAL SHALL NOT BE DEPOSITED IN THE ROADSIDE DITCHES OR IN THE CREEK. DIRT TRACKED ONTO ROADWAYS AND OTHER PAVED SURFACES SHALL BE CLEANED UP BY THE END OF THE WORKDAY.
6. ALL CONSTRUCTION SITE OPERATORS SHALL CONTROL WASTE SUCH AS DISCARDED BUILDING MATERIALS, CONCRETE TRUCK WASHOUT, HAZARDOUS CHEMICALS (TO INCLUDE BUT NOT LIMITED TO HEAVY EQUIPMENT MAINTENANCE FLUIDS, MOTOR OIL, ANTIFREEZE AND VEHICLE FUEL), LITTER, AND SANITARY WASTE AT THE CONSTRUCTION SITE THAT MAY CAUSE ADVERSE IMPACTS TO STORMWATER QUALITY.
7. ALL POTENTIAL POLLUTION SOURCES ON-SITE SHALL BE IDENTIFIED AND CONTROL MEASURES INSTALLED AND PRACTICED TO MINIMIZE THE LIKELIHOOD OF A RELEASE.
8. ALL PORTABLE TOILET FACILITIES SHALL BE LOCATED AWAY FROM GUTTERS, INLETS DITCHES, DRAINAGEWAYS, RECEIVING WATERS AND AREAS SUSCEPTIBLE TO FLOODING OR DAMAGE BY CONSTRUCTION EQUIPMENT.
9. ALL PORTABLE TOILET FACILITIES SHALL BE SECURED IN PLACE BY STAKES INTO THE GROUND TO PREVENT TIPPING.
10. STOCKPILES INCLUDING LANDSCAPING MATERIALS, EARTH MATERIALS AND DIRT FROM GRADING OR EXCAVATION SHALL NOT BE LOCATED ADJACENT TO WATERWAYS.
11. ALL MATERIAL IMPORTED TO OR EXPORTED FROM THE SITE SHALL BE PROPERLY COVERED TO PREVENT THE LOSS OF MATERIAL DURING TRANSPORT. HAUL ROUTES MUST BE PRE-APPROVED BY THE CITY. NO MATERIAL SHALL BE TRANSPORTED TO ANOTHER SITE WITHOUT FIRST OBTAINING A GRADING PERMIT FROM THE CITY.
12. THE CONCRETE WASHOUT CONTAINMENT STRUCTURE SHALL CONTAIN ALL WASHOUT WATER. STORMWATER SHALL NOT CARRY WASTES FROM WASHOUT LOCATION.
13. THE CONCRETE WASHOUT CONTAINMENT STRUCTURE SHALL BE LOCATED A MINIMUM OF FIFTY (50) FEET HORIZONTAL FROM WATERS OF THE STATE. THE CONCRETE WASHOUT CONTAINMENT STRUCTURE SHALL BE SIGNED AS - "CONCRETE WASHOUT."

PERFORMANCE STANDARD NOTES:

1. TEMPORARY EROSION CONTROL FACILITIES AND/OR PERMANENT FACILITIES INTENDED TO CONTROL EROSION OF AN EARTH DISTURBANCE OPERATION SHALL BE INSTALLED BEFORE ANY EARTH DISTURBANCE OPERATIONS TAKE PLACE.
2. EARTH DISTURBANCES SHALL BE CONDUCTED IN SUCH A MANNER SO AS TO EFFECTIVELY REDUCE ACCELERATED SOIL EROSION AND RESULTING SEDIMENTATION.
3. PERSONS ENGAGED IN EARTH DISTURBANCES SHALL DESIGN, IMPLEMENT, AND MAINTAIN ACCEPTABLE SOIL EROSION AND SEDIMENTATION CONTROL MEASURES, IN CONFORMANCE WITH THE EROSION CONTROL TECHNICAL STANDARDS ADOPTED BY CDOT.
4. EARTH DISTURBANCES SHALL BE DESIGNED, CONSTRUCTED AND COMPLETED IN SUCH A MANNER SO THAT THE EXPOSED AREA OF ANY DISTURBED LAND SHALL BE LIMITED TO THE SHORTEST POSSIBLE PERIOD OF TIME.
5. SEDIMENT CAUSED BY ACCELERATED SOIL EROSION SHALL BE REMOVED FROM RUNOFF WATER BEFORE IT LEAVES THE SITE OF THE EARTH DISTURBANCE.
6. ANY TEMPORARY OR PERMANENT FACILITY DESIGNED AND CONSTRUCTED FOR THE CONVEYANCE OF WATER AROUND, THROUGH, OR FROM THE EARTH DISTURBANCE AREA SHALL BE DESIGNED TO LIMIT THE WATER FLOW TO A NON-EROSIVE VELOCITY.
7. RECORDS OF SPILLS, LEAKS, OR OVERFLOWS THAT RESULT IN THE DISCHARGE OF POLLUTANTS MUST BE DOCUMENTED AND MAINTAINED. SOME SPILLS MAY NEED TO BE REPORTED TO THE DIVISION IMMEDIATELY: SPECIFICALLY, A RELEASE OF ANY CHEMICAL, OIL, PETROLEUM PRODUCT, SEWAGE, ETC., WHICH MAY ENTER WATERS OF THE STATE, MUST BE REPORTED. MORE GUIDANCE IS AVAILABLE ON THE WEB AT [WWW.CDPHE.STATE.CO.US/EMP/SPILLSANDRELEASED.HTM](http://WWW.CDPHE.STATE.CO.US/EMP/SPILLSANDRELEASED.HTM). THE DIVISION'S TOLL FREE 24-HOUR ENVIRONMENTAL EMERGENCY SPILL REPORTING LINE IS 1.877.518.5608. IN ADDITION TO CONTACTING CDPHE, ALSO IMMEDIATELY CALL THE STEAMBOAT SPRINGS ENGINEERING DEPARTMENT AT 970-879-2060

BMP MAINTENANCE NOTES:

1. IT IS ANTICIPATED THAT THE BMPs IMPLEMENTED AT THE SITE WILL HAVE TO BE MODIFIED TO ADAPT TO CHANGING CONDITIONS OR TO ENSURE THAT POTENTIAL POLLUTANTS ARE BEING PROPERLY MANAGED AT THE SITE. WHEN BMPs ARE MODIFIED, THE SWMP MUST BE MODIFIED TO ACCURATELY REFLECT THE ACTUAL FIELD CONDITIONS.
2. THE OWNER/CONTRACTOR SHALL CONTINUOUSLY MAINTAIN ALL SEDIMENT CONTROL LOGS AND SILT FENCING SO THAT IT FUNCTIONS PROPERLY DURING CONSTRUCTION AND WORK SUSPENSIONS. ALL SEDIMENT CONTROL LOGS AND SILT FENCING SHALL BE REMOVED BY THE CONTRACTOR UPON SUBSTANTIAL PERMANENT STABILIZATION UNLESS OTHERWISE DIRECTED BY THE ENGINEER.
3. ALL INLET/OUTLET PROTECTIONS WILL BE CHECKED FOR MAINTENANCE AND FAILURE. SEDIMENT SHALL BE REMOVED AND PROPERLY DISPOSED OF ONCE IT HAS ACCUMULATED TO HALF THE DESIGN OF THE TRAP.
4. ALL SPILLS SHALL BE CLEANED UP IMMEDIATELY AFTER DISCOVERY, OR CONTAINED UNTIL APPROPRIATE CLEANUP METHODS CAN BE EMPLOYED. MANUFACTURE'S RECOMMENDED METHODS FOR SPILL CLEANUP SHALL BE FOLLOWED, ALONG WITH PROPER DISPOSAL METHODS.
5. EACH CONCRETE TRUCK OPERATOR SHALL BE AWARE OF THE DESIGNATED CONCRETE WASHOUT AREA.
6. THE CONTRACTOR SHALL CHECK THE CAPACITY FOR ALL CONCRETE WASHOUT AREAS. WASTE MATERIALS MUST BE REMOVED BY THE CONTRACTOR AND LEGALLY DISPOSED OF WHEN ACCUMULATIONS AMOUNT TO TWO-THRDS OF THE WET STORAGE CAPACITY OF THE STRUCTURE.
7. ALL CONCRETE WASHOUT AREAS SHALL BE CLEARLY MARKED. THE CONCRETE WASHOUT CONTAINMENT DETAIL WILL INCLUDE ORANGE PLASTIC CONSTRUCTION FENCING OR EQUIVALENT AROUND THE WASHOUT STRUCTURE AND A SIGN POSTED WITH THE WORDS "CONCRETE WASHOUT".
8. THE CONCRETE WASHOUT AREA SHALL BE REPAIRED AND/OR ENLARGED AS NECESSARY TO MAINTAIN CAPACITY FOR WASTED CONCRETE.
9. AT THE END OF CONSTRUCTION, ALL CONCRETE SHALL BE REMOVED FROM THE SITE AND LEGALLY DISPOSED OF AT AN APPROVED WASTE SITE.

STANDARD STEAMBOAT SPRINGS CONSTRUCTION SITE MANAGEMENT PLAN NOTES:

1. THIS PLAN SHALL BE KEPT ON SITE AT ALL TIMES AND UPDATED TO REFLECT ANY CHANGES.
2. CONCRETE WASTE AND WASHOUT WATER FROM MIXING TRUCKS SHALL BE CONTAINED ON SITE, REMOVED FROM THE SITE, AND PROPERLY DISPOSED. MATERIALS SHOULD NOT ENTER STATE WATERS.
3. CONTRACTOR IS RESPONSIBLE FOR INSTALLING AND MAINTAINING TEMPORARY EROSION AND SEDIMENT CONTROL DURING CONSTRUCTION AND ESTABLISHING ANY REQUIRED PERMANENT BEST MANAGEMENT PRACTICES (BMPs).
4. CONTRACTOR IS RESPONSIBLE FOR COMPLYING WITH ALL LOCAL, STATE, AND FEDERAL LAWS. IN ADDITION CONTRACTOR MUST OBTAIN REQUIRED PERMITS.
5. CLEARING OR GRADING SHALL NOT BEGIN UNTIL ALL SEDIMENT CONTROL DEVICES HAVE BEEN INSTALLED.
6. THE CONTRACTOR SHALL PROMPTLY REMOVE ALL SEDIMENT, MUD, AND CONSTRUCTION DEBRIS THAT MAY ACCUMULATE IN THE RIGHT OF WAY, PRIVATE PROPERTY, OR WATER WAYS AS A RESULT OF THE CONSTRUCTION ACTIVITIES.
7. ALL INGRESS, EGRESS POINTS AND VEHICLE ACCESS POINTS ONTO DISTURBED SITE MUST BE STABILIZED WITH A VEHICLE TRACKING CONTROL PAD. ACCESS SHALL ONLY BE VIA APPROVED LOCATIONS AS SHOWN ON APPROVED CSMp.
8. SOIL STABILIZATION MEASURES SHALL BE IN PLACE AND AREAS ARE TO BE REVEGETATED:(1) FOR STOCKPILES, IF INACTIVE FOR MORE THAN 30 DAYS (2) FOR AREAS OF LAND DISTURBANCE WITHIN ONE GROWING SEASON.
9. INLET PROTECTION SHALL BE INSTALLED IN CONJUNCTION WITH STORM DRAIN INLETS WHERE DRAINAGE AREA IS NOT VEGETATED.
10. BMPs SHALL BE USED, MODIFIED, AND MAINTAINED WHENEVER NECESSARY TO REFLECT CURRENT CONDITIONS. BMPs SHALL BE INSPECTED WEEKLY AND AFTER EVERY PRECIPITATION EVENT. ACCUMULATED SEDIMENT SHALL BE REMOVED FROM BMPs WHEN THE SEDIMENT LEVEL REACHES ½ THE HEIGHT OF THE BMP.
11. EMERGENCY ACCESS MUST BE KEPT OBSTACLE FREE AND PASSABLE AT ALL TIMES.
12. FOR ANY WORK TO BE DONE IN THE RIGHT OF WAY, COORDINATE WITH THE CITY CONSTRUCTION SITE MANAGER REGARDING SPECIAL PERMITTING. NO WORK SHALL BE CONDUCTED IN THE ROW BETWEEN NOVEMBER 1 AND APRIL 1 WITHOUT PRIOR APPROVAL FROM THE DIRECTOR OF PUBLIC WORKS.
13. WHERE REQUIRED AS PART OF THE ROW PERMIT OR WHERE SITE WORK AFFECTS THE PEDESTRIAN OR VEHICLE TRAVEL WAY, TRAFFIC CONTROL SHALL BE INSTALLED. ALL TRAFFIC CONTROL SHALL BE IN ACCORDANCE WITH THE MANUAL ON UNIFORM TRAFFIC CONTROL DEVICES, LATEST EDITION.
14. SIDEWALKS ADJACENT TO CONSTRUCTION SITES SHALL BE MAINTAINED, FOR PUBLIC USE, BY THE CONTRACTOR. IN AREAS WHERE CONSTRUCTION IS TAKING PLACE NEXT TO THE SIDEWALK AND OVERHEAD HAZARDS ARE POSSIBLE, CONTRACTOR IS RESPONSIBLE FOR INSTALLING AND MAINTAINING SIDEWALK PROTECTION.

STANDARD EROSION AND SEDIMENT CONTROL NOTES

1. THE CONTRACTOR MUST NOTIFY THE CITY OF STEAMBOAT SPRINGS AT LEAST THREE DAYS PRIOR TO STARTING CONSTRUCTION.
2. ALL GRADING, EROSION, AND SEDIMENT CONTROL MUST CONFORM TO APPROVED PLANS. REVISIONS TO DISTURBANCE AREAS, SLOPES, AND/OR EROSION AND SEDIMENT CONTROL MEASURES ARE NOT PERMITTED WITHOUT PRIOR APPROVAL FROM THE CITY OF STEAMBOAT SPRINGS.
3. THE CONTRACTOR IS RESPONSIBLE FOR OBTAINING A PERMIT FOR STORMWATER DISCHARGES ASSOCIATED WITH CONSTRUCTION ACTIVITY FROM THE COLORADO DEPARTMENT OF PUBLIC HEALTH AND ENVIRONMENT, AT LEAST 10 DAYS PRIOR THE START OF CONSTRUCTION ACTIVITIES FOR LAND DISTURBANCE AREAS OF ONE ACRE OR GREATER. THE PERMIT MUST BE KEPT CURRENT THROUGHOUT THE CONSTRUCTION DURATION. STATE STORMWATER PERMIT APPLICATIONS ARE AVAILABLE AT THIS ADDRESS: [HTTP://WWW.CDPHE.STATE.CO.US/WQ/PERMITSUNIT/WQCDPMTHTML](http://WWW.CDPHE.STATE.CO.US/WQ/PERMITSUNIT/WQCDPMTHTML)
4. EROSION CONTROL BEST MANAGEMENT PRACTICES (BMPs) MUST BE INSTALLED PRIOR TO GRADING ACTIVITIES, TO THE MAXIMUM EXTENT PRACTICABLE. ANY PROJECT THAT REQUIRES A STATE STORMWATER DISCHARGE PERMIT REQUIRES PHASING. PHASED EROSION CONTROL PLANS MUST BE PREPARED BY THE CONTRACTOR.
5. ALL TEMPORARY AND PERMANENT SOIL EROSION AND SEDIMENT CONTROL PRACTICES MUST BE MAINTAINED AND REPAIRED AS NEEDED TO ASSURE CONTINUED PERFORMANCE OF THEIR INTENDED FUNCTION. FOR EXAMPLE, EROSION CONTROL BLANKETS, SEDIMENT CONTROL LOGS, OR SILT FENCES WILL REQUIRE REPLACEMENT WHEN THE BMP FAILS. SEDIMENT TRAPS AND BASINS WILL REQUIRE SEDIMENT REMOVAL ACCORDING TO CDPHE GUIDELINES.
6. ALL TOPSOIL, WHERE PHYSICALLY PRACTICABLE, MUST BE SALVAGED AND NO TOPSOIL SHALL BE REMOVED FROM THE SITE EXCEPT AS SET FORTH IN THE APPROVED PLANS. TOPSOIL AND OVERBURDEN MUST BE SEGREGATED AND STOCKPILED SEPARATELY. TOPSOIL AND OVERBURDEN MUST BE REDISTRIBUTED WITHIN THE GRADED AREA AFTER ROUGH GRADING TO PROVIDE A SUITABLE BASE FOR AREAS THAT MUST BE SEEDED AND PLANTED. RUNOFF FROM THE STOCKPILED AREA MUST BE CONTROLLED TO PREVENT EROSION AND SEDIMENTATION OF RECEIVING WATERS. TOPSOIL IS TO BE AMENDED WITH COMPOST TO PROMOTE SEED GROWTH.
7. THE LANDOWNER AND/OR CONTRACTOR MUST IMMEDIATELY TAKE ALL NECESSARY STEPS TO CONTROL SEDIMENT DISCHARGE.
8. THE LANDOWNER AND/OR CONTRACTOR IS RESPONSIBLE FOR CLEAN UP AND REMOVAL OF ALL SEDIMENT AND DEBRIS FROM ALL DRAINAGE INFRASTRUCTURE AND OTHER PUBLIC FACILITIES.
9. THE LANDOWNER AND/OR CONTRACTOR MUST TAKE REASONABLE PRECAUTIONS TO ENSURE THAT VEHICLES DO NOT TRACK OR SPILL EARTH MATERIALS ON TO STREETS/ROADS AND MUST IMMEDIATELY REMOVE SUCH MATERIALS IF THIS OCCURS.
10. THE CONTRACTOR IS RESPONSIBLE FOR CONTROLLING \*LITTER SUCH AS DISCARDED BUILDING MATERIALS, CONCRETE TRUCK WASHOUT, CHEMICALS, AND SANITARY WASTE, AS APPLICABLE. IN ADDITION, SPILL PREVENTION AND CONTAINMENT BMPs FOR CONSTRUCTION MATERIALS, WASTE, AND FUEL MUST BE PROVIDED, AS APPLICABLE. LOCATIONS OF STOCKPILES, CONCRETE WASHOUT AREAS, AND TRASH RECEPTACLES MUST BE CLEARLY SHOWN ON THE PLANS. \*LITTERING IS DEFINED AND ENFORCED BY COLORADO REVISED STATUTES, SECTION 18-4-511.
11. THE STORM SEWER LINES WILL BE CLEANED BY CONTRACTOR UPON COMPLETION OF THE PROJECT.

12. SEEDING AND MULCHING SHALL BE COMPLETED WITHIN 30 DAYS OF INITIAL EXPOSURE OR 7 DAYS AFTER GRADING IS SUBSTANTIALLY COMPLETED IN A GIVEN AREA. THIS MAY REQUIRE MULTIPLE MOBILIZATIONS FOR SEEDING AND MULCHING.
13. TEMPORARY VEGETATIVE COVER CONSISTING OF ANNUAL RYE GRASS MUST BE HYDRO-SEEDED AT 20 POUNDS PURE LIVE SEED PER ACRE. MULCH CONSISTING OF GRASS HAY, APPLIED AT A RATE OF ONE TON PER ACRE AND CRIMPED MUST BE USED TO STABILIZE THE EXPOSED SURFACE.
14. MULCH CONSISTING OF GRASS HAY, APPLIED AT A RATE OF ONE TON PER ACRE AND CRIMPED MUST BE USED TO STABILIZE THE EXPOSED SURFACE. SEE EROSION CONTROL PLAN FOR LOCATIONS OF EROSION CONTROL BLANKETS.
15. FUGITIVE DUST EMISSIONS RESULTING FROM GRADING ACTIVITIES AND/OR WIND SHALL BE CONTROLLED USING THE BEST AVAILABLE CONTROL TECHNOLOGY, AS DEFINED BY THE COLORADO DEPARTMENT OF PUBLIC HEALTH AND ENVIRONMENT, AT THE TIME OF GRADING. DURING GRADING, APPLYING A COMBINATION OF WATER, TACKIFIER AND SILT FENCE TO BREAK UP WIND SURFACE VELOCITIES MAY CONTROL DUST. IF WIND SPEEDS EXCEED THE ABILITY OF BMPs TO CONTROL FUGITIVE DUST, GRADING ACTIVITIES MUST CEASE. THE CONTRACTOR SHALL OBTAIN A PERMIT FROM THE CDPHE AIR POLLUTION CONTROL DIVISION IF REQUIRED.
16. ALL DISTURBED FILL SLOPES GREATER THAN OR EQUAL TO 3:1, FLOMLINES OF SWALES, GUTTER DOWNSPOUTS, OR ADDITIONAL AREAS AT THE DISCRETION OF CITY STAFF, SHALL BE PROTECTED WITH AN EROSION BLANKET. SEE EROSION CONTROL PLANS FOR ADDITIONAL LOCATIONS OF EROSION CONTROL BLANKETS.
17. THE CITY OF STEAMBOAT SPRINGS, OR ITS AUTHORIZED REPRESENTATIVE, MAY MODIFY THE EROSION AND SEDIMENT CONTROL PLAN AS FIELD CONDITIONS WARRANT.
18. THE CONTRACTOR IS RESPONSIBLE FOR PREPARING AND SUBMITTING A TEMPORARY DEWATERING PLAN IF NEEDED TO THE CITY OF STEAMBOAT SPRINGS FOR REVIEW AND APPROVAL 10 DAYS PRIOR TO INITIATING CONSTRUCTION.
19. BMP MAINTENANCE AND REPLACEMENT MAY REQUIRE PERIODIC WORK. THIS IS TO OCCUR PER CDPHE REQUIREMENTS IMMEDIATELY, AND AT SPECIFIC POINTS OF SEDIMENT ACCUMULATION, PHASING, OR DAILY ACTIVITIES.

SITE DESCRIPTION	
CONSTRUCTION ACTIVITY	PHASE 1: RELOCATION OF ICONIC BARN AND ASSOCIATED GRADING. PHASE 2: CONSTRUCTION OF SOFT SURFACE TRAIL, PARKING STALLS AND CONNECTION TO SIDEWALK
DISTURBANCE AREA	DISTURBANCE AREA = APPROX. 1.63 ACRES
RUNOFF COEFFICIENTS	C100 = 0.61
EXISTING VEGETATION	MAJORITY OF COVER IS NATIVE GRASS WITH TREES AND BUSHES
SOIL CONDITION	GENERALLY, SUBRADE SOIL CONDITIONS CONSIST OF LOAM SOILS THAT ARE WELL DRAINED AND HYDROLOGIC SOIL TYPE C
PROPOSED LANDSCAPE AREA	0.8 ACRES
POTENTIAL POLLUTION SOURCES	SEDIMENT, ASPHALT PAVEMENT, VEHICLE REFUELING, LEAKING VEHICLES, OFF-SITE VEHICLE TRACKING, CONCRETE
LOCATION OF NON-STORMWATER DISCHARGE	THE CONTRACTOR WILL DESIGNATE A CONFINED, CONCRETE WASH-OUT AREA ON SITE.
NAME AND LOCATION OF RECEIVING WATERS	YAMPA RIVER LOCATED APPROX. 3000 FEET TO THE WEST OF THE SITE.

OVERALL SCOPE / PROJECT CHARACTERISTICS

INDUSTRIAL ACTIVITIES	NONE KNOWN
FINAL SITE DISPOSITION	THE SITE WILL BE RETURNED TO ORIGINAL CONDITIONS OR BETTER. TREES WILL BE REMOVED THAT CONFLICT WITH PROPOSED IMPROVEMENTS. DISTURBED SLOPES WILL RECEIVE HYDROMULCH SEEDING WITH FIBER BOND MATRIX.
EROSION CONTROL MEASURES	STRAW WATTLES OR SILT FENCE WILL BE AT THE TOE OF FILL SLOPES TO MINIMIZE SEDIMENT TRANSPORT. INLET AND OUTLET PROTECTION WILL BE PROVIDED AT ALL CULVERTS AND STORM SEWER. GRAVEL FILTER BAGS WILL BE PLACED WITHIN SWALES. A CONCRETE WASH-OUT AREA WILL BE PROVIDED. A VEHICLE TRACKING PAD WILL BE PROVIDED AT MT WERNER CIRCLE TO ACCESS THE SITE AND REDUCE TRACKING MUD ONTO THE EXISTING ASPHALT.
OFFSITE FLOWS	MINIMAL OFF-SITE FLOWS ENTER THE PROJECT.


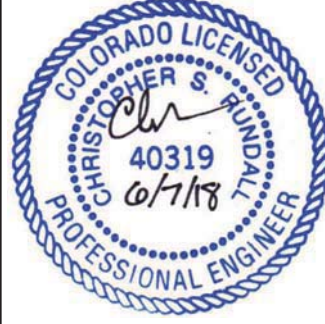
SCHEDULE OF GRADING ACTIVITIES/SEQUENCE

- |                                     |  |
|-------------------------------------|--|
| 1. INSTALL EROSION CONTROL MEASURES | 5. FINE GRADING                                      |
| 2. EARTHWORK/GRADING                | 6. SOFT SURFACE SIDEWALK CONSTRUCTION                |
| 3. BARN RELOCATION (PHASE 1)        | 7. ASPHALT PAVING AND TRAIL CONNECTIONS SOUTH OF MWC |
| 4. CULVERT CONSTRUCTION (PHASE 2)   | 8. FINAL STABILIZATION                               |

BEST MANAGEMENT PRACTICES (BMP's)

STORM WATER QUALITY BEST MANAGEMENT PRACTICES SHALL BE IMPLEMENTED TO MINIMIZE SOIL EROSION, SEDIMENTATION, INCREASED POLLUTION LOADS AND CHANGED WATER FLOW CHARACTERISTICS RESULTING FROM LAND DISTURBING ACTIVITY TO THE MAXIMUM EXTENT PRACTICAL, AS TO MINIMIZE POLLUTION OF RECEIVING WATERS.	
MATERIALS HANDLING AND SPILL PREVENTION	MATERIALS EXPECTED TO BE PRESENT ARE AS FOLLOWS: PETROLEUM PRODUCTS & CONCRETE. NO CHEMICALS OR FUELS ARE TO BE STORED ON SITE. THE FOLLOWING MATERIAL MANAGEMENT PRACTICES SHALL BE USED TO REDUCE THE RISK OF SPILLS OR OTHER ACCIDENTAL EXPOSURE OF MATERIALS AND SUBSTANCES TO STORM WATER RUNOFF. •PRODUCTS WILL BE KEPT IN ORIGINAL CONTAINERS WITH ORIGINAL MANUFACTURER LABEL. •ALL OF THE PRODUCT WILL BE USED UP BEFORE DISPOSING OF THE CONTAINER. •ALL ON-SITE VEHICLES WILL BE MONITORED FOR LEAKS AND RECEIVE REGULAR PREVENTATIVE MAINTENANCE. •CONCRETE TRUCKS WILL BE ALLOWED MINIMAL WASHING ONLY IN DESIGNATED WASHOUT AREA. •THE SWMP ADMINISTRATOR SHALL BE NOTIFIED OF ANY SPILLS. CONTAINMENT OF THE SPILL MUST OCCUR IMMEDIATELY. IN THE EVENT OF A SPILL, THE FOLLOWING AGENCIES MUST BE CONTACTED: COLORADO DEPARTMENT OF PUBLIC HEALTH AND ENVIRONMENT 303-692-3500 STEAMBOAT SPRINGS ENGINEERING DEPARTMENT - 970-879-2060
OTHER CONTROLS	WASTE MATERIALS WILL BE COLLECTED AND STORED IN A SECURELY LIDDED METAL DUMPSTER. ALL TRASH AND CONSTRUCTION DEBRIS FROM THE SITE WILL BE DEPOSITED IN A DUMPSTER. ALL PERSONNEL WILL BE INSTRUCTED REGARDING THE CORRECT PROCEDURE FOR WASTE DISPOSAL. ALL SANITARY WASTE WILL BE COLLECTED FROM PORTABLE UNITS A MINIMUM OF THREE TIMES PER WEEK. THE PAVED STREET ADJACENT TO THE SITE SHALL BE SWEEPED TO REMOVE ANY EXCESS MUD, DIRT OR ROCK TRACKED FROM THE SITE.
INSPECTION AND MAINTENANCE	INSPECTIONS: 1. PERFORM EVERY 14 DAYS, AND FOLLOWING A STORM EVENT 2. COMPLETE AN INSPECTION REPORT FOR EACH INSPECTION PERFORMED 3. KEEP INSPECTION REPORTS ON SITE:  1. PERFORM MAINTENANCE ON ITEMS OR AREAS IDENTIFIED IN THE INSPECTION REPORT IMMEDIATELY. 2. PERFORM MAINTENANCE AS INDICATED IN THE URBAN DRAINAGE & FLOOD CONTROL DISTRICT, URBAN STORM DRAINAGE CRITERIA MANUAL, VOL 3, PER MANUFACTURER'S SPECIFICATIONS OR OTHER SOURCES DETERMINED TO BE ACCEPTABLE.  AN EFFICIENT RECORD-KEEPING SYSTEM IS A HELPFUL TOOL IN MANAGING INSPECTION AND MAINTENANCE REPORTS. IT IS RECOMMENDED THAT A LOGBOOK BE MAINTAINED FOR INSPECTION REPORTS, MAINTENANCE RECORDS, SPILL RESPONSE, WEATHER CONDITIONS, TRAINING CORRESPONDENCE, ETC.

RCRBD  
RECORD SET

 <div>Engineering - Planning - Surveying 419 OAK ST. • PO BOX 77052 • STEAMBOAT SPRINGS, CO 80477 P. 970.879.025 • F. 303.940.9569 • <a href="http://www.baselinecorp.com">www.baselinecorp.com</a></div>	DESIGNED BY SMB	DATE 5/3/18	REVISION DESCRIPTION DESIGN TEAM REVIEW/COORDINATION ADDRESS TAC COMMENTS	PREPARED BY CSR	ROUTT COUNTY
	DRAWN BY SMB	6/7/18			
CITY OF STEAMBOAT SPRINGS	URAC/SSRA ICONIC ENTRY MT. WERNER CIRCLE/MT. WERNER ROAD STORM WATER MANAGEMENT PLAN				STEAMBOAT SPRINGS
	PREPARED UNDER THE DIRECT SUPERVISION OF 				
FOR AND ON BEHALF OF BASELINE CORPORATION				INITIAL SUBMITTAL 5/3/18	
DRAWING SIZE 24" X 36"				SURVEY FIRM SURVEY DATE D&D, INC. 10/11/14	
JOB NO. C020169				DRAWING NAME C020169 CD COVER.dwg	
SHEET 11 OF 13				C11	



DESIGNED BY	SMB
DRAWN BY	SMB
CHECKED BY	CSR

DATE	5/3/18
PREPARED BY	CSR
DESIGN TEAM REVIEW/COORDINATION	CSR
ADDRESS TAC COMMENTS	

REVISION DESCRIPTION	
DESIGN TEAM REVIEW/COORDINATION	
ADDRESS TAC COMMENTS	

ROUTE COUNTY

CITY OF STEAMBOAT SPRINGS

URAAC/SSRA ICONIC ENTRY  
MT. WERNER CIRCLE/MT. WERNER ROAD

DETAILS

STEAMBOAT SPRINGS

PREPARED UNDER THE DIRECT SUPERVISION OF



FOR AND ON BEHALF OF  
BASELINE CORPORATION

INITIAL SUBMITTAL 5/3/18

DRAWING SIZE 24" X 36"

SURVEY FIRM SURVEY DATE

D&D, INC. 10/11/14


JOB NO. C020169

DRAWING NAME



20169 TRAIL DETAILS.dwg

SHEET 12 OF 13





C12

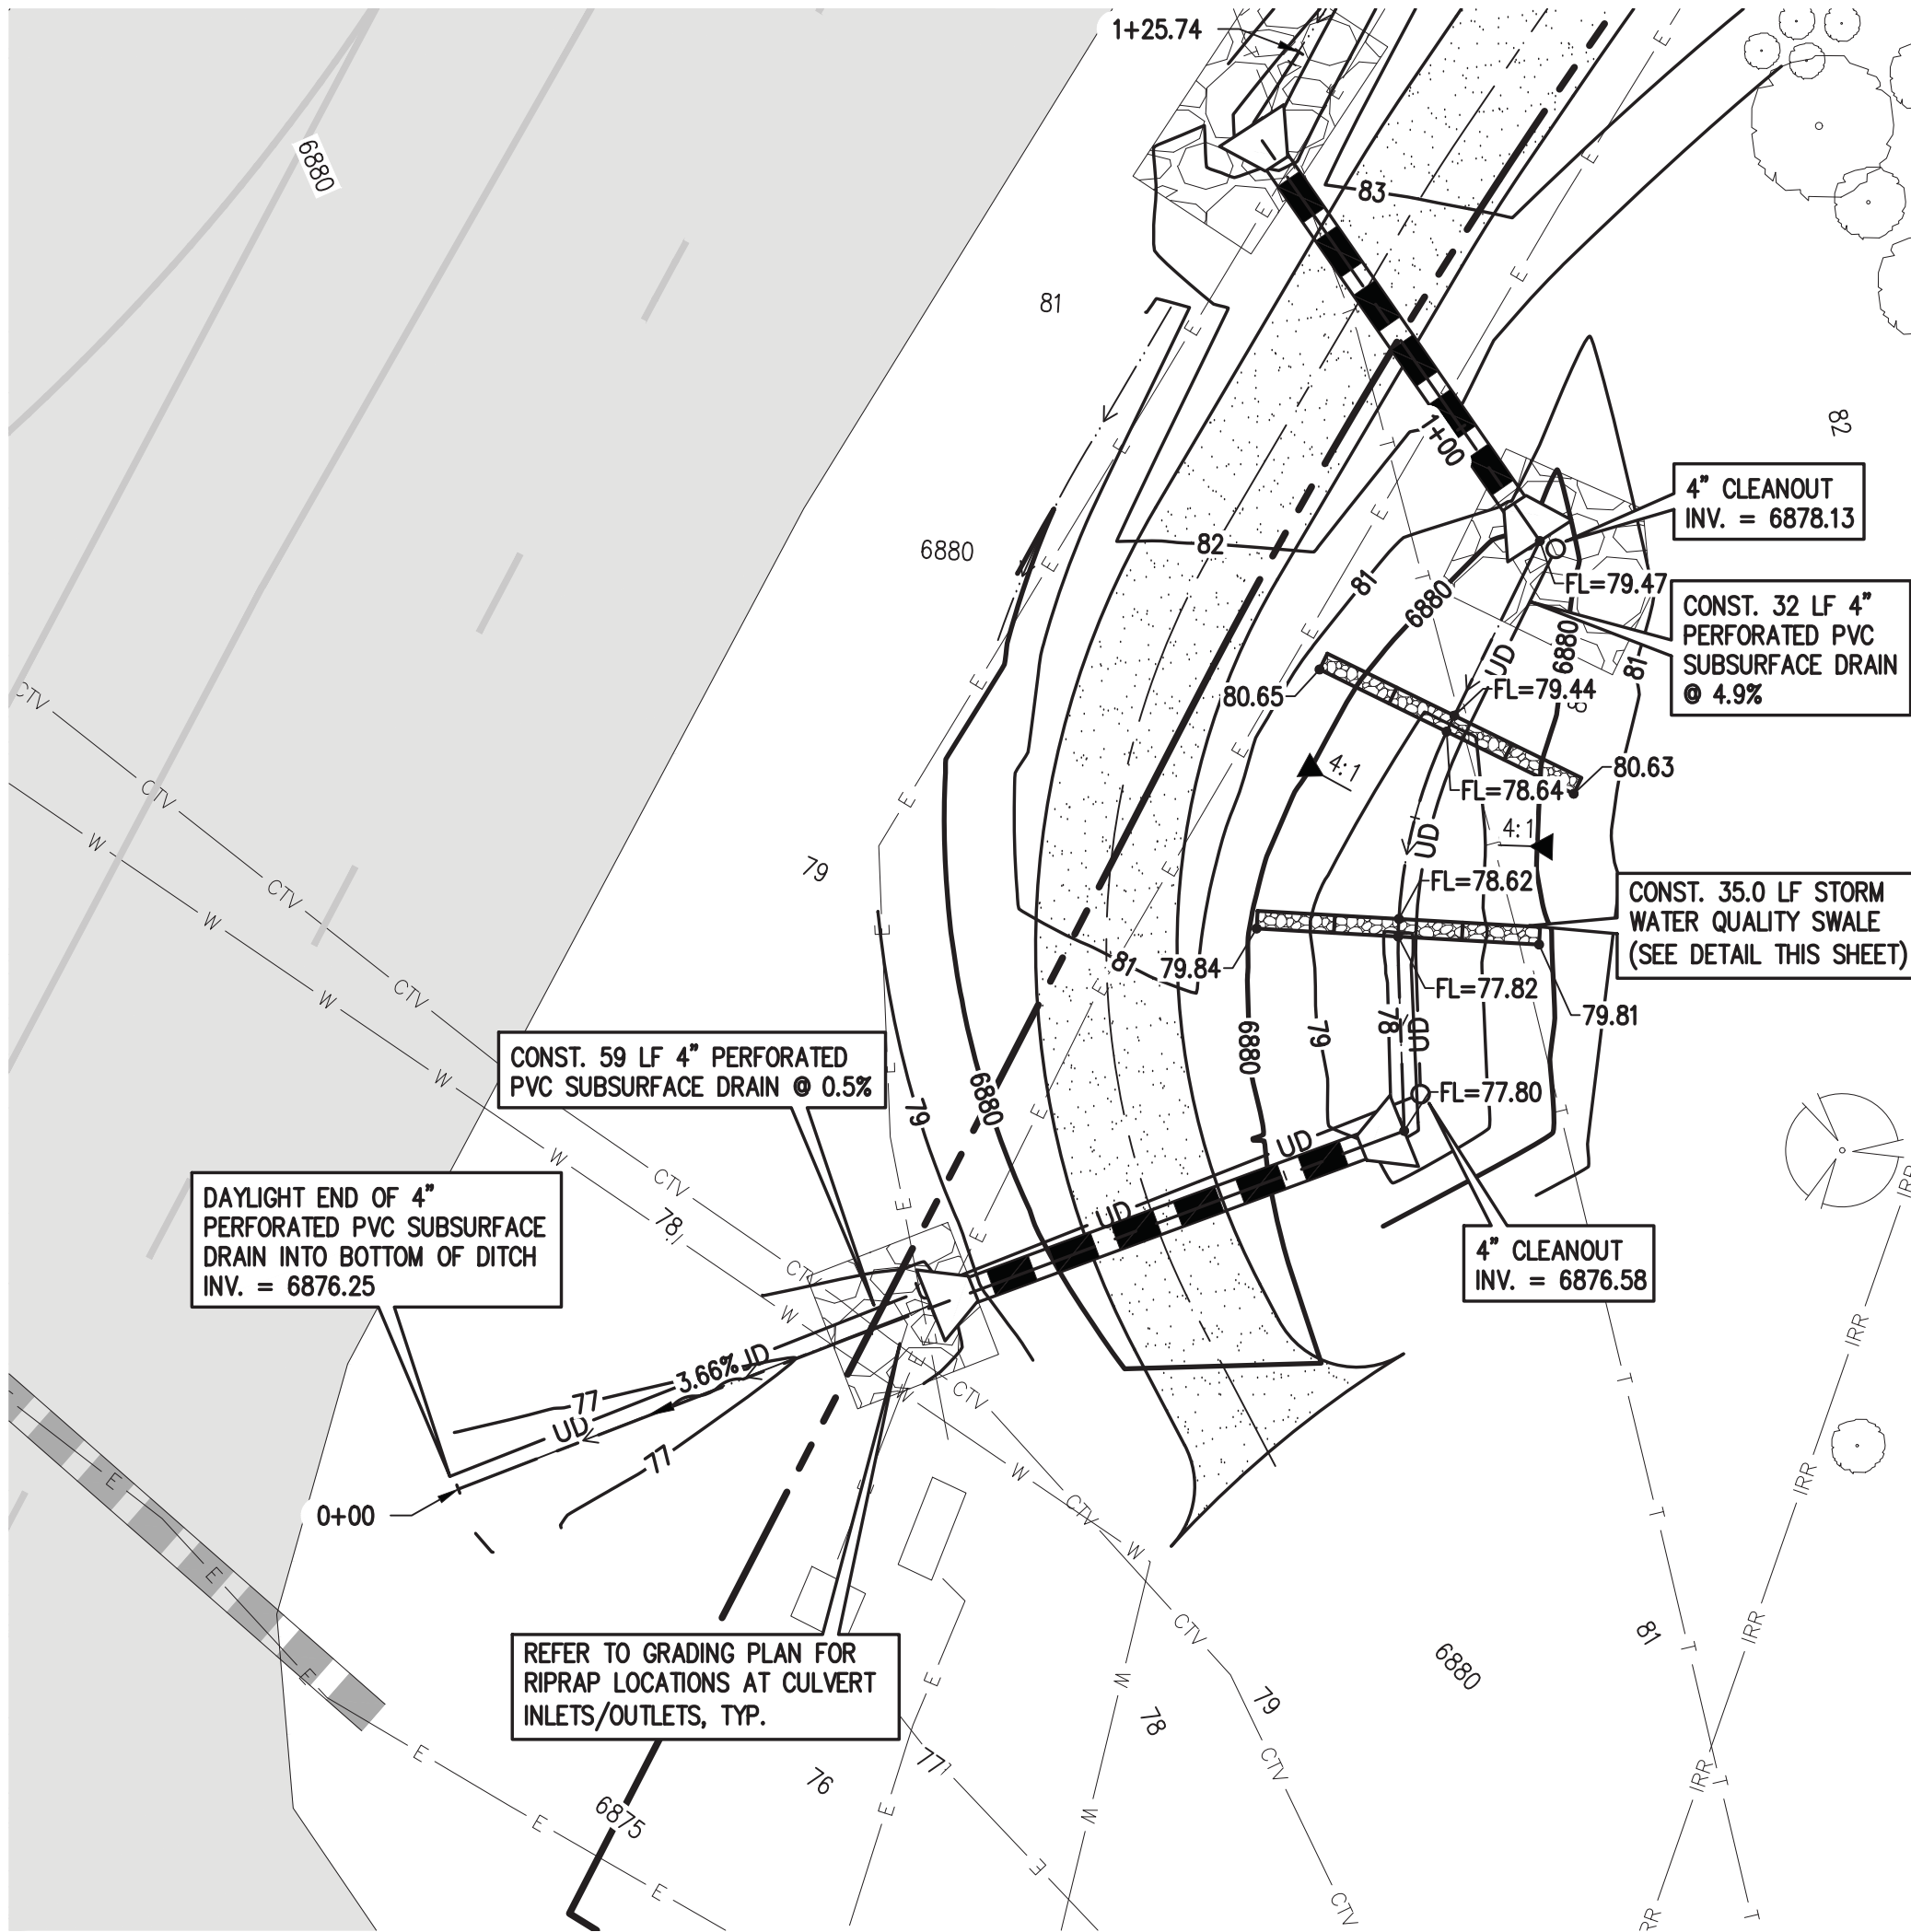


1 WATER QUALITY SWALE DETAIL  
SCALE: 1" = 10'

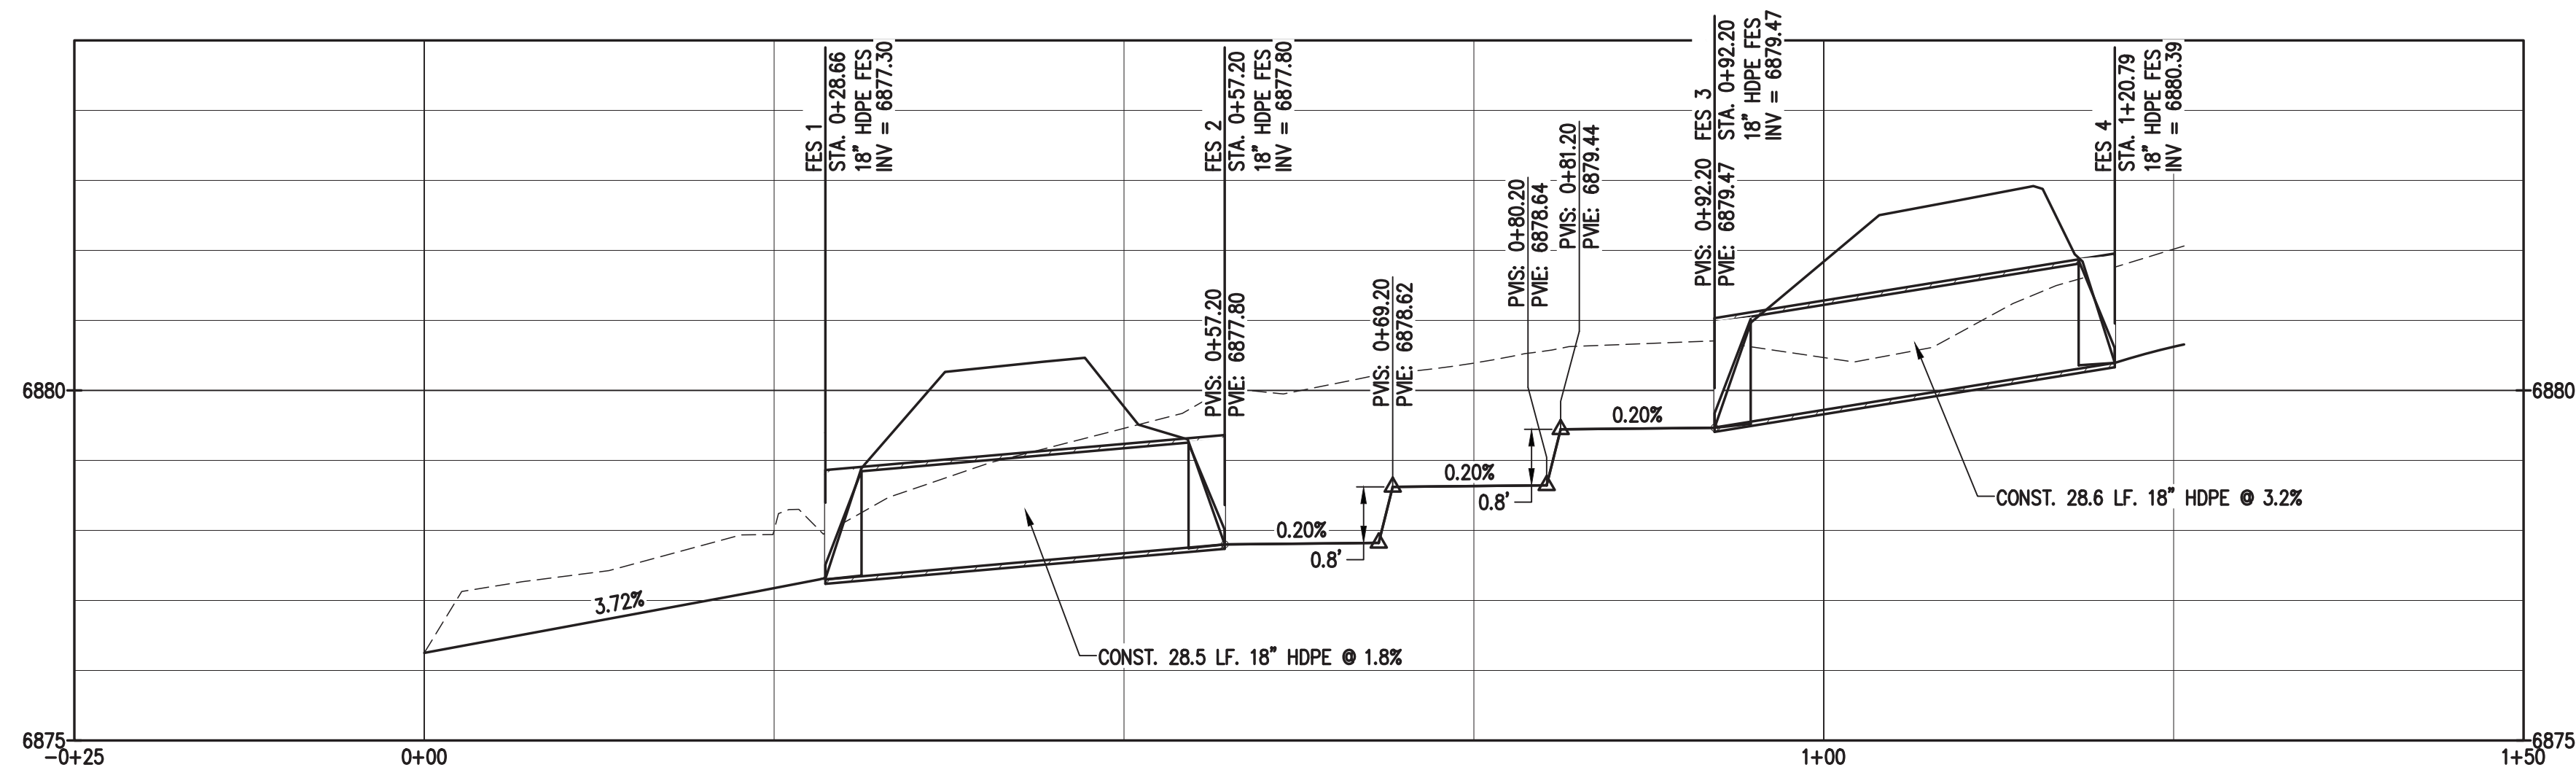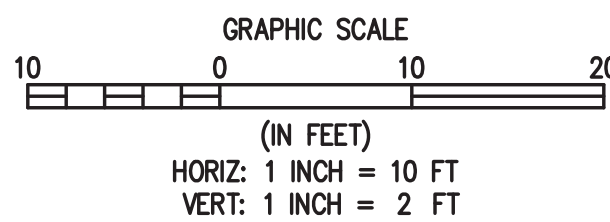

2 WATER QUALITY SWALE PROFILE

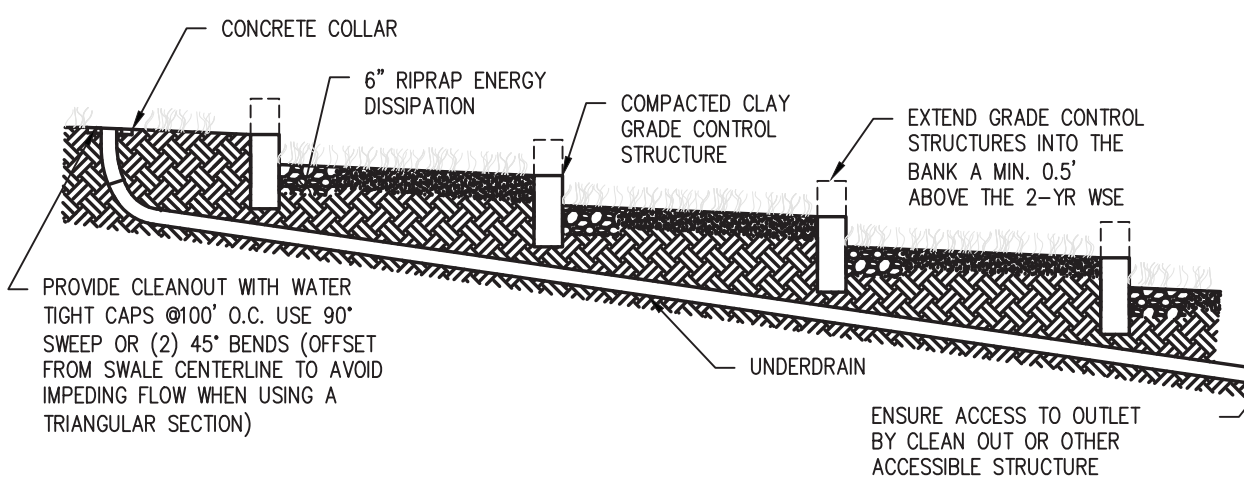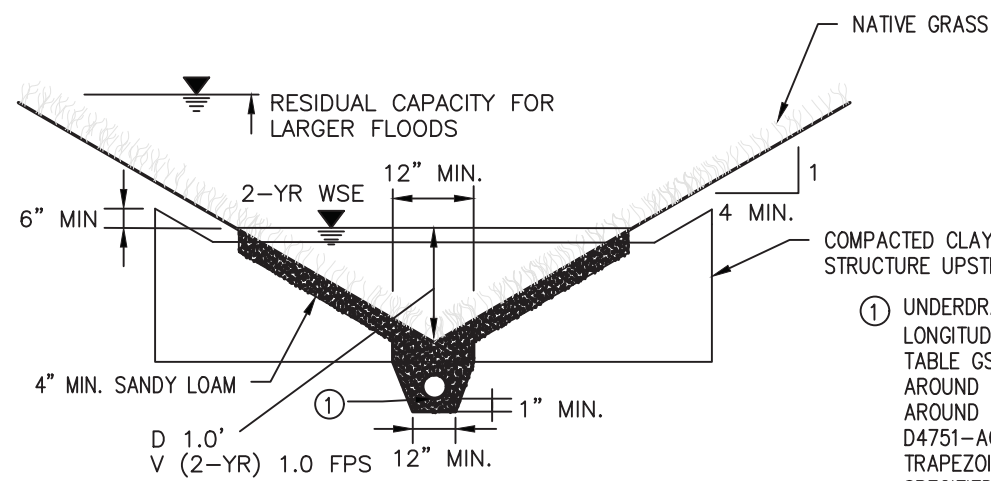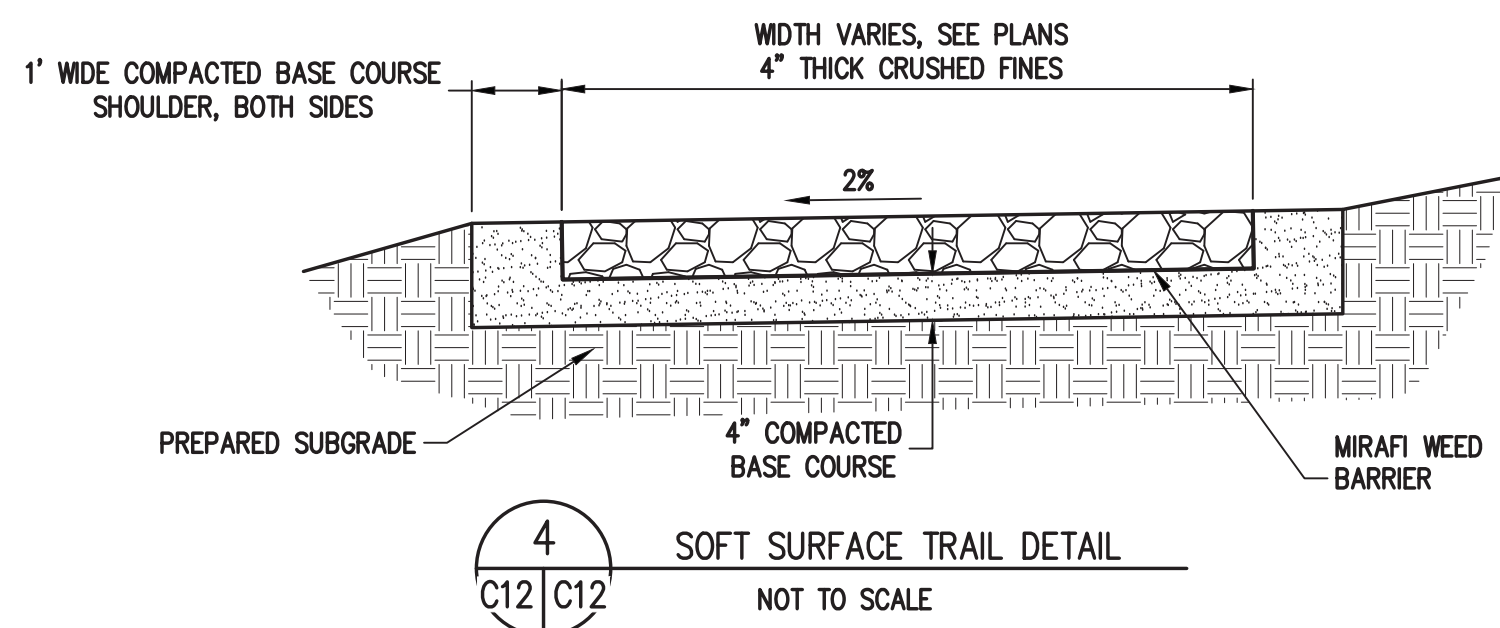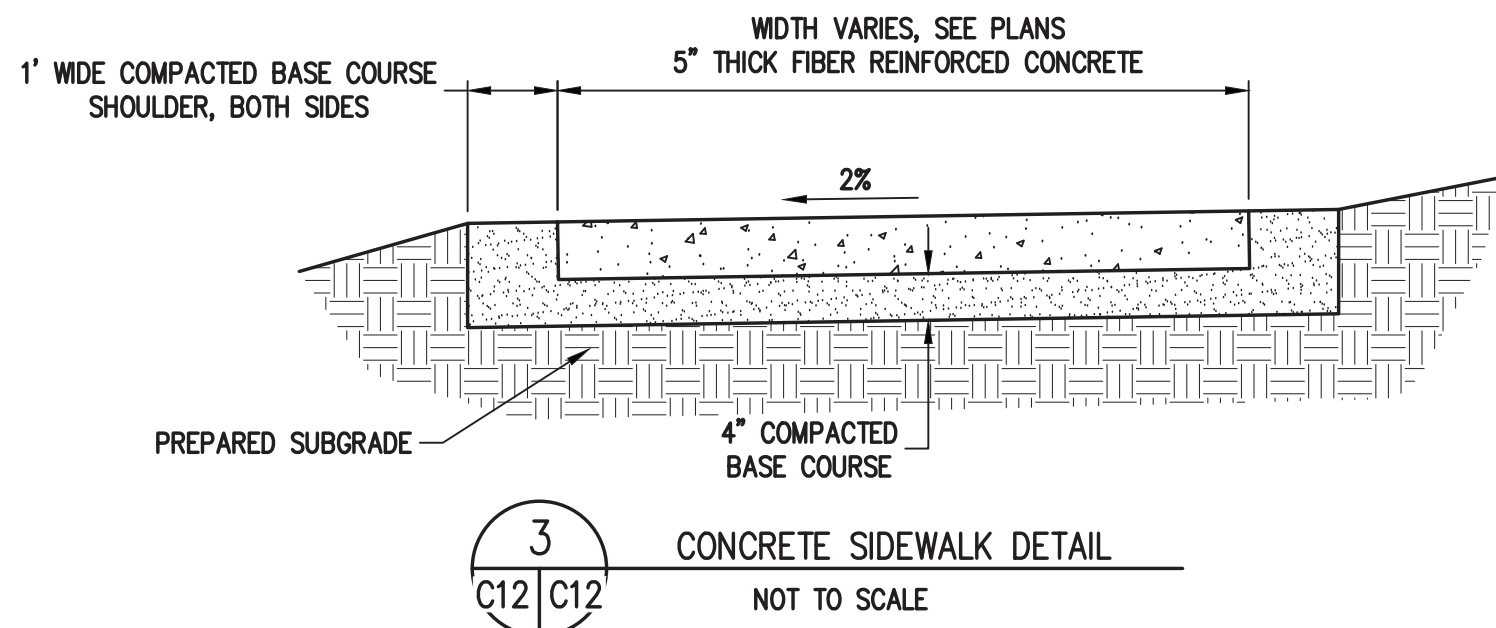


SWALE PROFILE

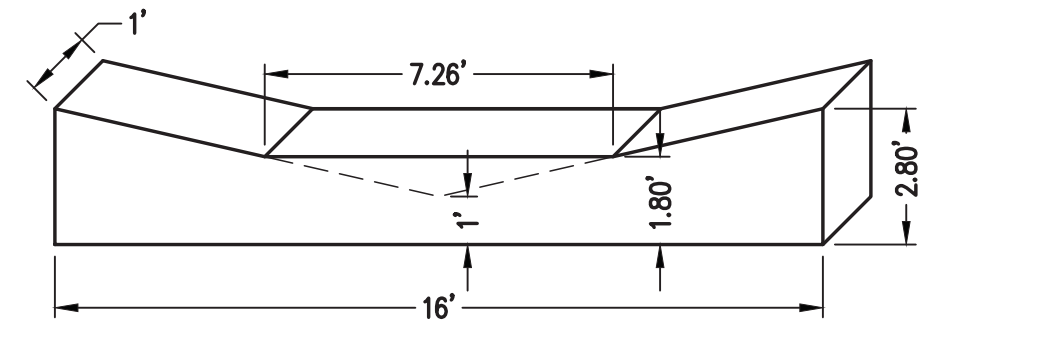

COMPACTED CLAY GRADE CONTROL STRUCTURE ISOMETRIC



5 WATER QUALITY SWALE DETAIL

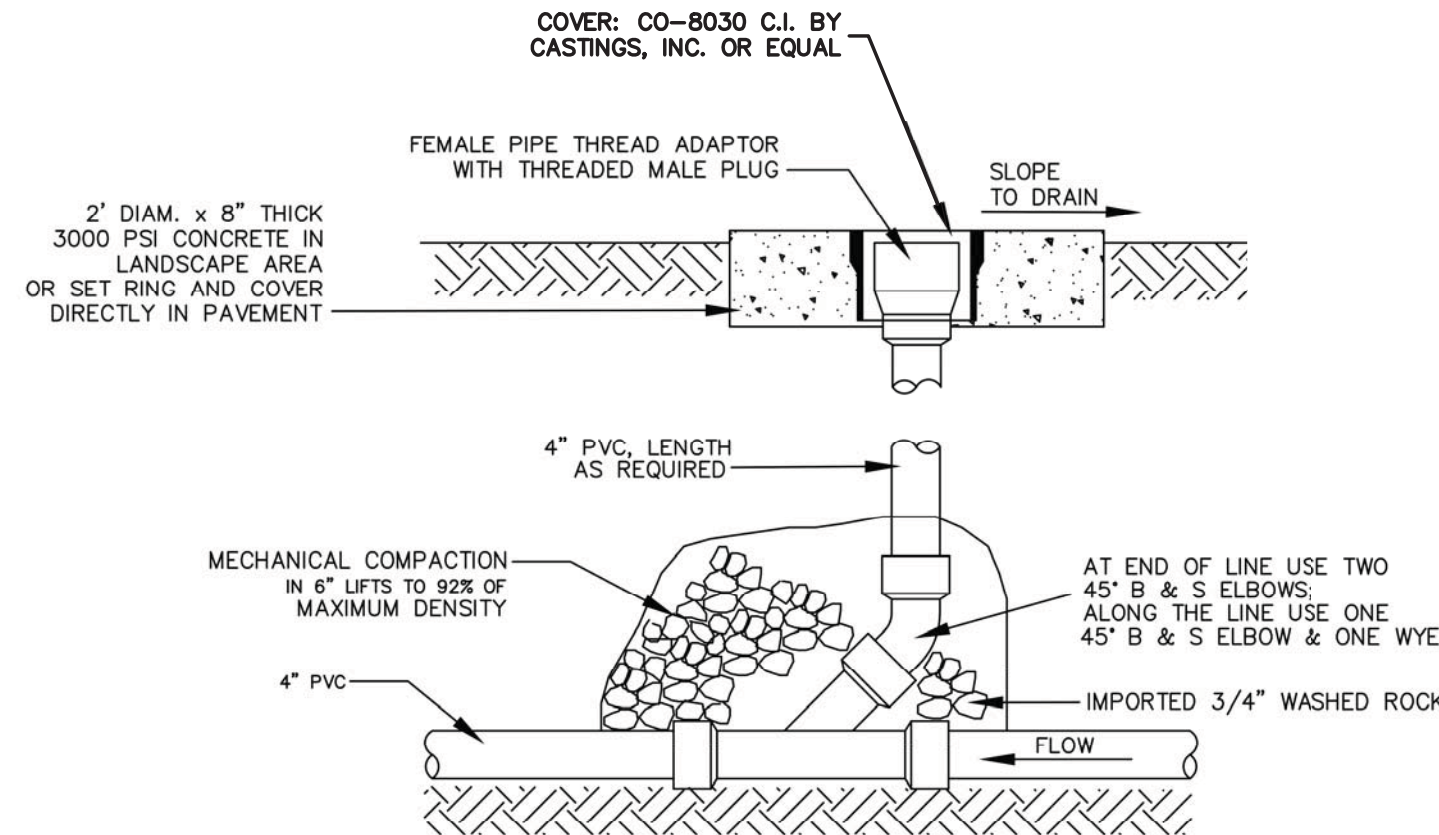

6 UNDERDRAIN CLEANOUT DETAIL  
NOT TO SCALE



NOTE: SEE PLAN SHEETS  
FOR INVERTS.



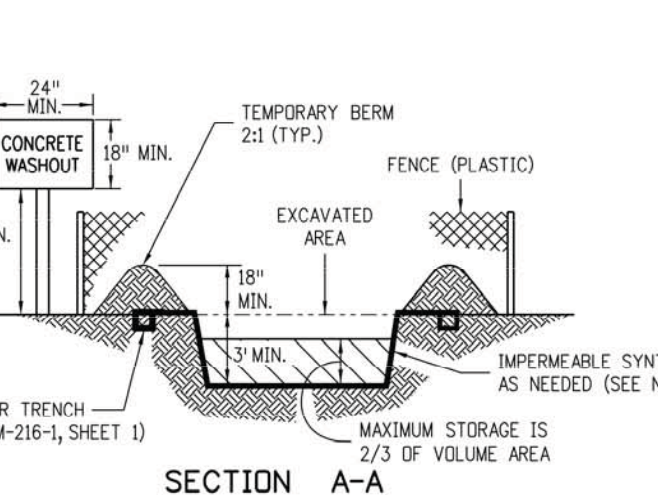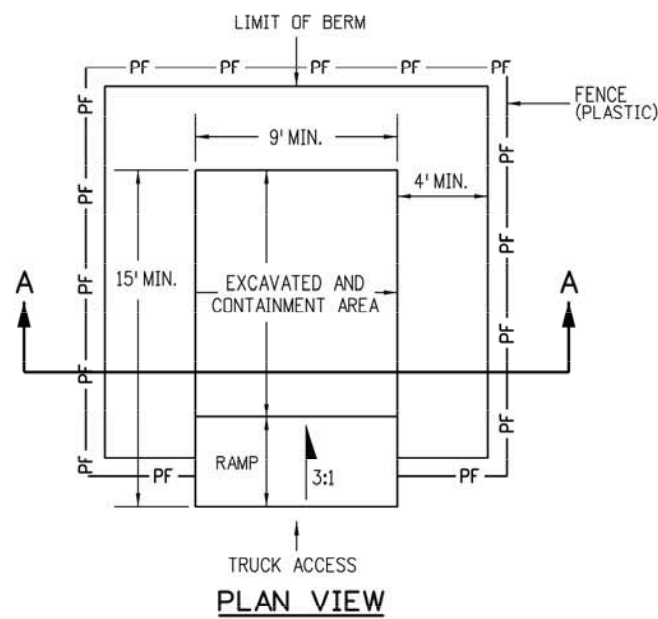



- NOTES:
- A FENCE (PLASTIC) CONFORMING TO SECTION 607 SHALL BE INSTALLED AROUND THE CONCRETE WASHOUT AREA, EXCEPT AT THE OPENING.
  - THE CONCRETE WASHOUT SIGN SHALL HAVE LETTERS AT LEAST 3 INCHES HIGH AND CONFORM TO SUBSECTION 630.02.
  - ALL MATERIALS AND LABOR TO COMPLETE THE CONCRETE WASHOUT STRUCTURE SHALL BE INCLUDED IN THE COST OF WORK AND NOT PAID FOR SEPARATELY.
  - THE BOTTOM OF EXCAVATION SHALL BE A MINIMUM OF FIVE FEET ABOVE GROUND WATER. IF NOT, IT SHALL BE LINED WITH AN IMPERMEABLE SYNTHETIC LINER THAT IS DESIGNED TO CONTROL SEEPAGE AT A MAXIMUM RATE OF 6 TO 10 CENTIMETERS PER SECOND.
  - THE PAY ITEM NUMBER FOR CONCRETE WASHOUT STRUCTURE (EA) IS 208-00045.

CONCRETE WASHOUT STRUCTURE

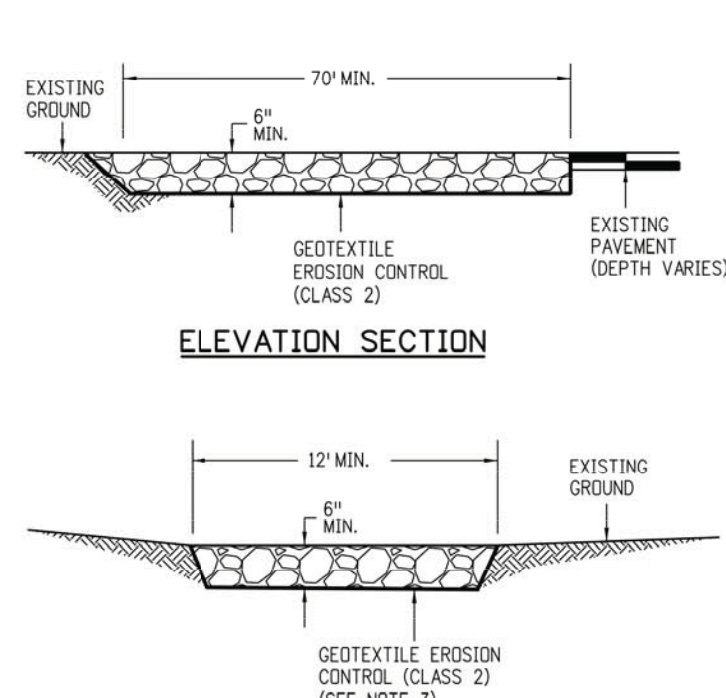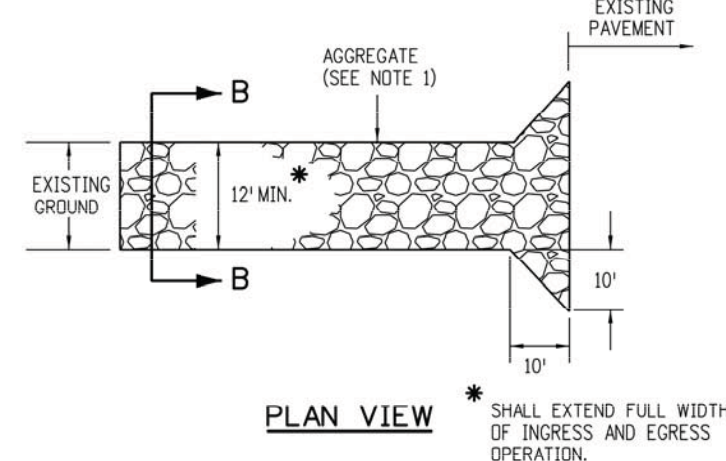



- NOTES:
- AGGREGATE SHALL CONFORM TO SUBSECTION 208.02 (K).
  - THE CONTRACTOR SHALL PROTECT CURB AND GUTTER THAT CROSSES THE ENTRANCE FROM DAMAGE. PROTECTION OF THE CURB AND GUTTER SHALL BE INCLUDED IN THE COST OF WORK AND NOT PAID FOR SEPARATELY.
  - GEOTEXTILE SHALL CONFORM TO SUBSECTION 712.08.
  - ALL MATERIALS AND LABOR TO COMPLETE THE VEHICLE TRACKING PAD SHALL BE INCLUDED IN THE COST OF WORK AND NOT PAID FOR SEPARATELY.
  - THE PAY ITEM NUMBER FOR VEHICLE TRACKING PAD (EA) IS 208-00070.

VEHICLE TRACKING PAD

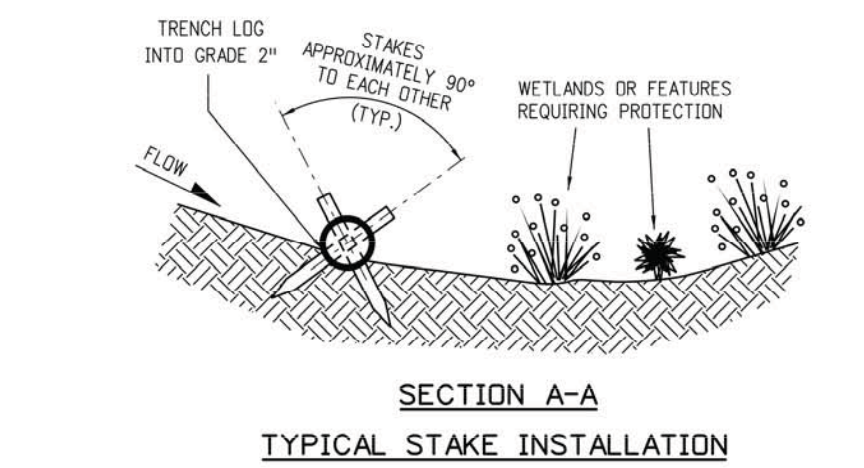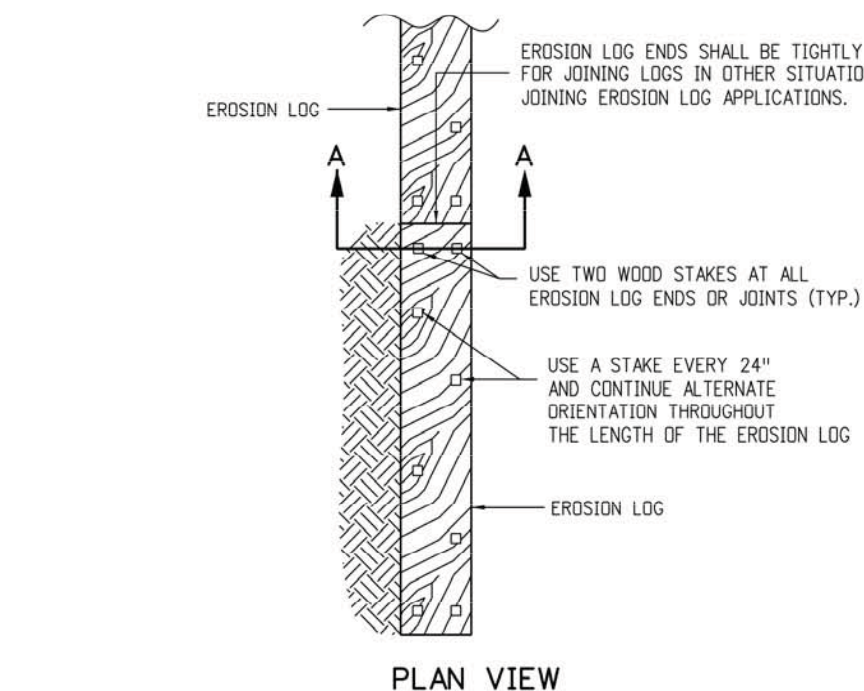



- NOTES:
- AGGREGATE SHALL CONFORM TO SUBSECTION 208.02 (K).
  - THE CONTRACTOR SHALL PROTECT CURB AND GUTTER THAT CROSSES THE ENTRANCE FROM DAMAGE. PROTECTION OF THE CURB AND GUTTER SHALL BE INCLUDED IN THE COST OF WORK AND NOT PAID FOR SEPARATELY.
  - GEOTEXTILE SHALL CONFORM TO SUBSECTION 712.08.
  - ALL MATERIALS AND LABOR TO COMPLETE THE VEHICLE TRACKING PAD SHALL BE INCLUDED IN THE COST OF WORK AND NOT PAID FOR SEPARATELY.
  - THE PAY ITEM NUMBER FOR VEHICLE TRACKING PAD (EA) IS 208-00070.

VEHICLE TRACKING PAD

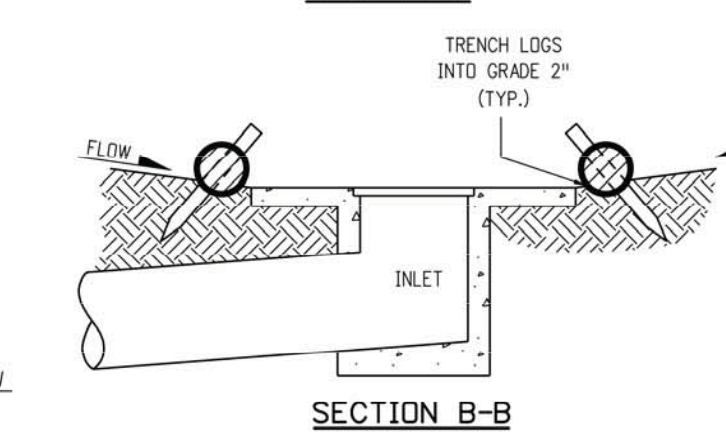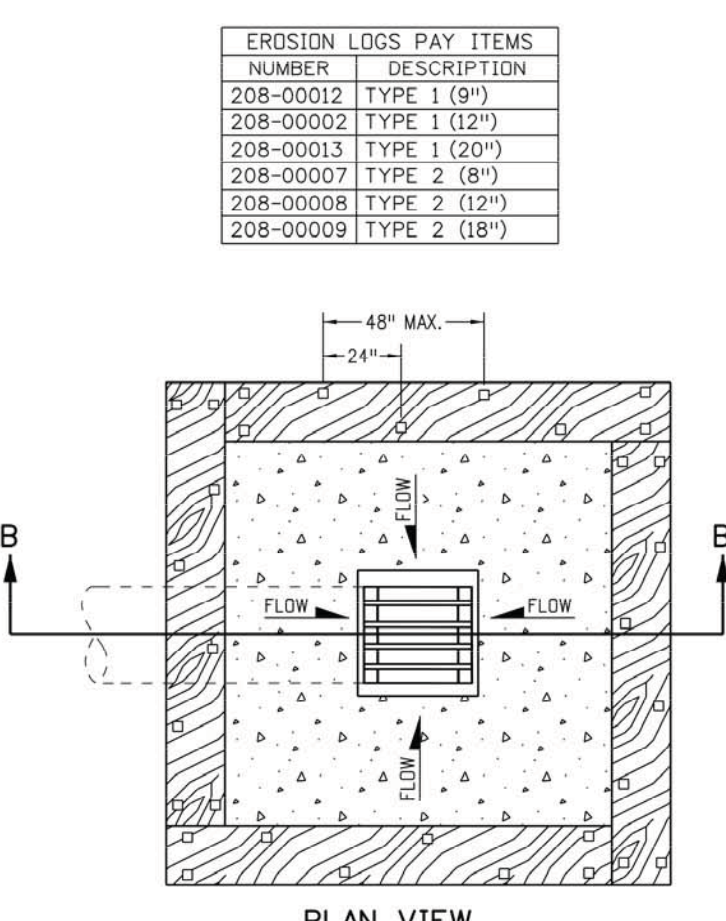

- NOTES:
- AGGREGATE SHALL CONFORM TO SUBSECTION 208.02 (K).
  - THE CONTRACTOR SHALL PROTECT CURB AND GUTTER THAT CROSSES THE ENTRANCE FROM DAMAGE. PROTECTION OF THE CURB AND GUTTER SHALL BE INCLUDED IN THE COST OF WORK AND NOT PAID FOR SEPARATELY.
  - GEOTEXTILE SHALL CONFORM TO SUBSECTION 712.08.
  - ALL MATERIALS AND LABOR TO COMPLETE THE VEHICLE TRACKING PAD SHALL BE INCLUDED IN THE COST OF WORK AND NOT PAID FOR SEPARATELY.
  - THE PAY ITEM NUMBER FOR VEHICLE TRACKING PAD (EA) IS 208-00070.

VEHICLE TRACKING PAD

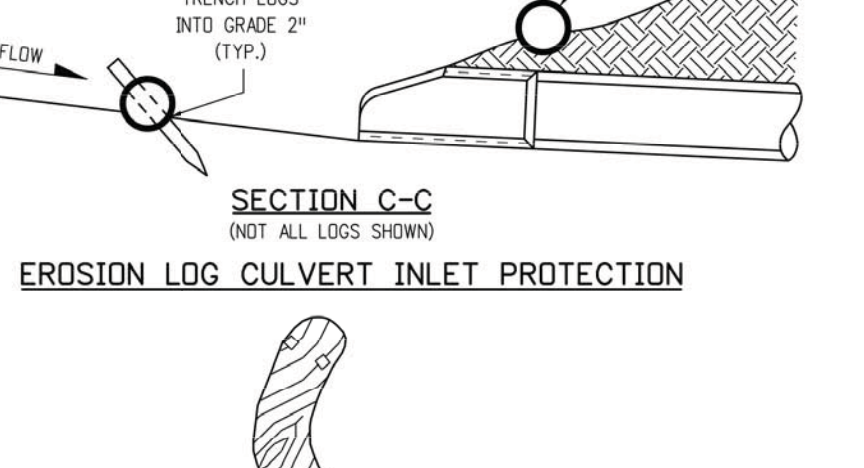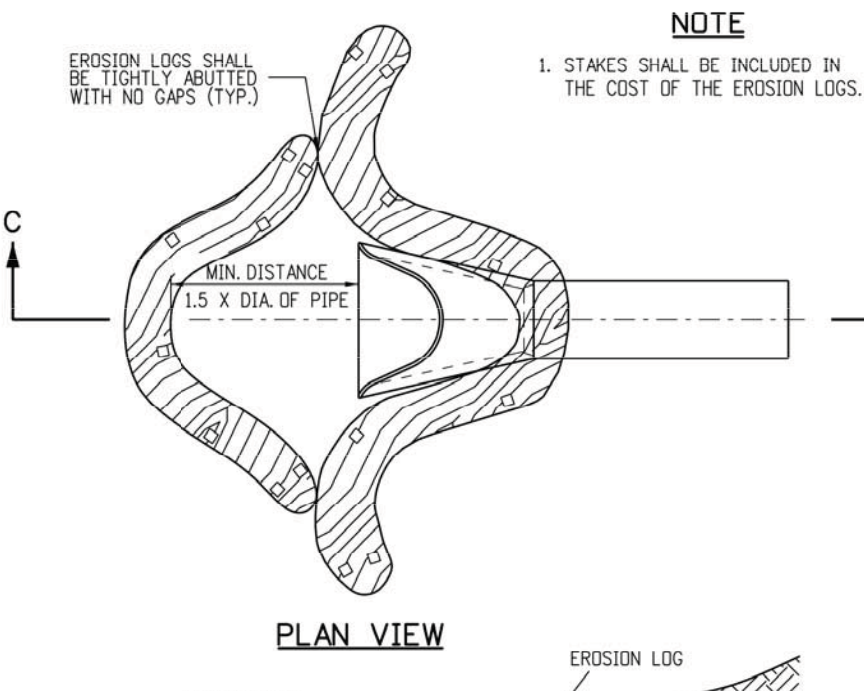

- NOTES:
- AGGREGATE SHALL CONFORM TO SUBSECTION 208.02 (K).
  - THE CONTRACTOR SHALL PROTECT CURB AND GUTTER THAT CROSSES THE ENTRANCE FROM DAMAGE. PROTECTION OF THE CURB AND GUTTER SHALL BE INCLUDED IN THE COST OF WORK AND NOT PAID FOR SEPARATELY.
  - GEOTEXTILE SHALL CONFORM TO SUBSECTION 712.08.
  - ALL MATERIALS AND LABOR TO COMPLETE THE VEHICLE TRACKING PAD SHALL BE INCLUDED IN THE COST OF WORK AND NOT PAID FOR SEPARATELY.
  - THE PAY ITEM NUMBER FOR VEHICLE TRACKING PAD (EA) IS 208-00070.

VEHICLE TRACKING PAD

Computer File Information	
Creation Date: 07/04/12	Initials: JBK
Last Modification Date: 08/10/17	Initials: LTA
Full Path: www.coloradodot.info/business/designsupport	
Drawing File Name: 208010101.dgn	
CAD Ver.: MicroStation V8	Scale: Not to Scale Units: English

Sheet Revisions	
Date:	Comments
07/16/15	Added the two sub-sections for the washout structure.
03/29/16	Minor revisions to some dimensions and general notes.

Colorado Department of Transportation	4201 East Arkansas Avenue CDOT HQ, 4th Floor Denver, CO 80222 Phone: 303-757-9021 FAX: 303-757-9868
Division of Project Support	JBK/LTA

TEMPORARY EROSION CONTROL	STANDARD PLAN NO. M-208-1
Issued By: Project Development Branch on July 4, 2012	Sheet No. 1 of 11

Computer File Information	Sheet Revisions
Creation Date: 07/04/12	Initials: JBK
Last Modification Date: 08/10/17	Initials: LTA
Full Path: www.coloradodot.info/business/designsupport	
Drawing File Name: 208010101.dgn	
CAD Ver.: MicroStation V8	Scale: Not to Scale Units: English

Sheet Revisions	
Date:	Comments
03/29/16	Minor revisions to some dimensions and general notes.



Colorado Department of Transportation	4201 East Arkansas Avenue CDOT HQ, 4th Floor Denver, CO 80222 Phone: 303-757-9021 FAX: 303-757-9868
Division of Project Support	JBK/LTA

TEMPORARY EROSION CONTROL	STANDARD PLAN NO. M-208-1
Issued By: Project Development Branch on July 4, 2012	Sheet No. 2 of 11

Computer File Information	Sheet Revisions
Creation Date: 07/04/12	Initials: JBK
Last Modification Date: 08/10/17	Initials: LTA
Full Path: www.coloradodot.info/business/designsupport	
Drawing File Name: 208010101.dgn	
CAD Ver.: MicroStation V8	Scale: Not to Scale Units: English



Sheet Revisions	
Date:	Comments
03/29/16	Minor revisions to some dimensions and general notes.

Colorado Department of Transportation	4201 East Arkansas Avenue CDOT HQ, 4th Floor Denver, CO 80222 Phone: 303-757-9021 FAX: 303-757-9868
Division of Project Support	JBK/LTA

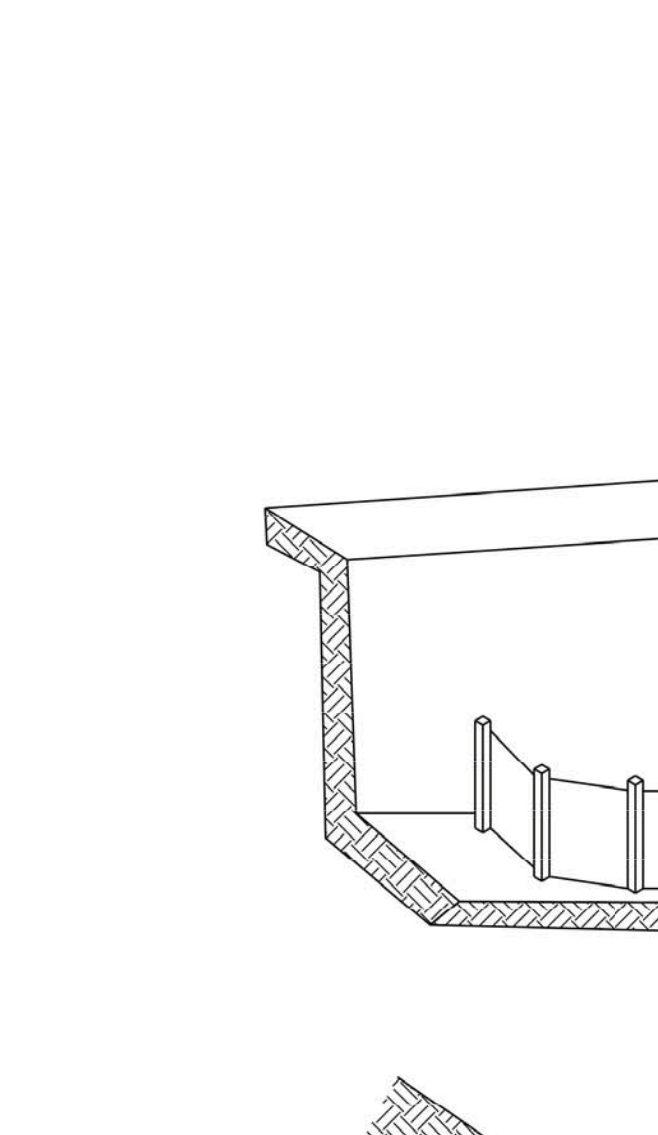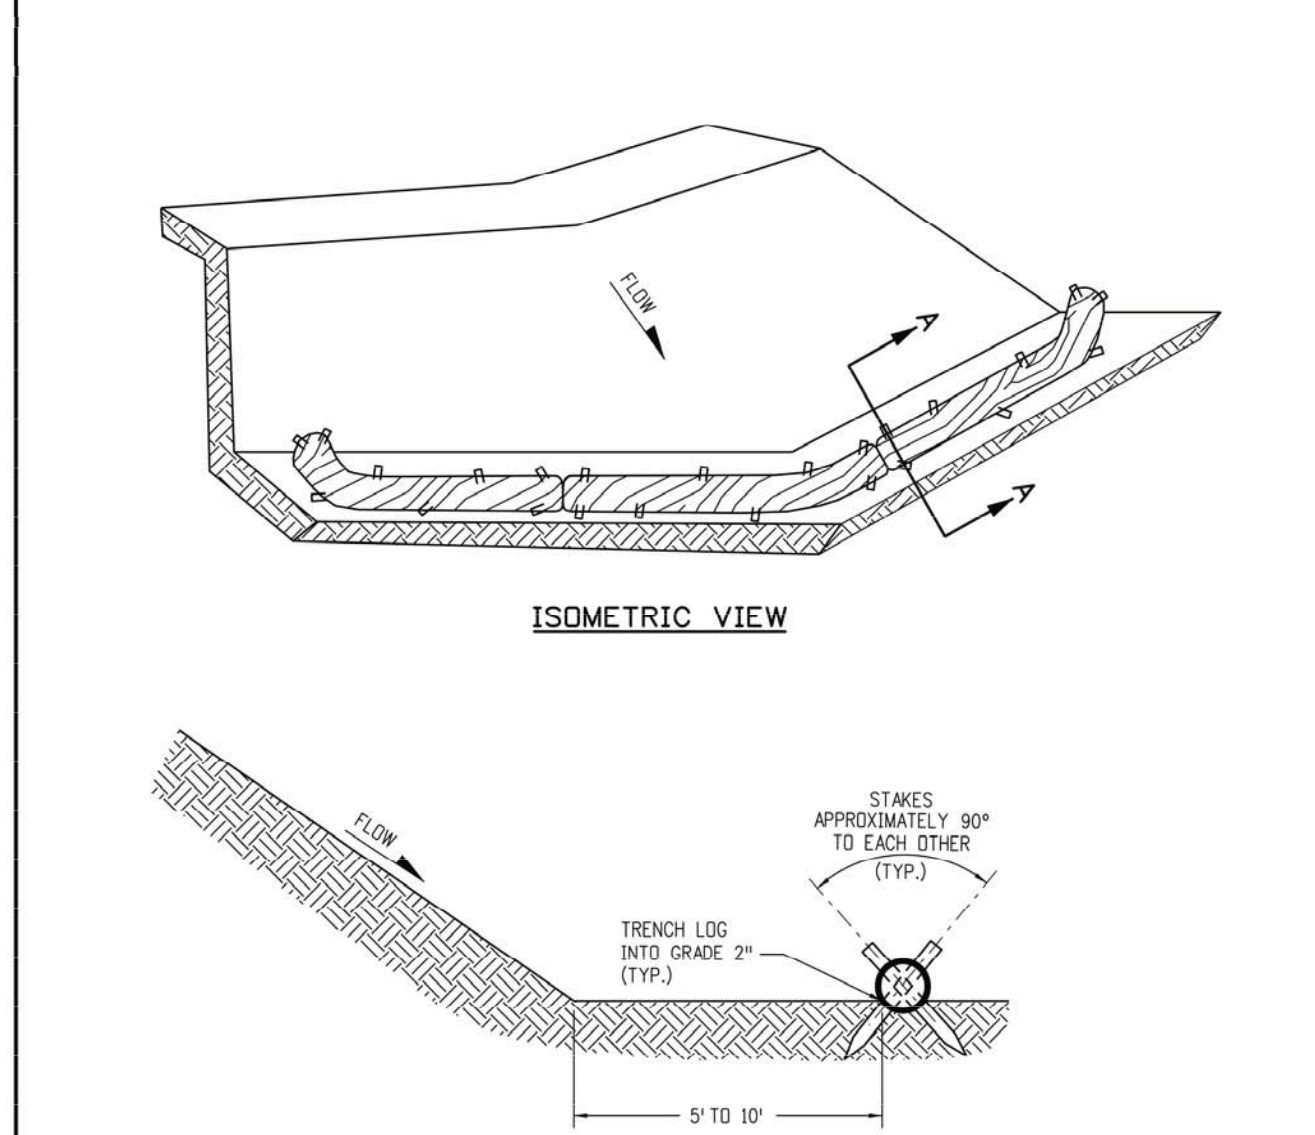



- NOTES:
- EROSION LOGS USED AT TOE OF SLOPE SHALL BE PLACED 5 TO 10 FEET BEYOND TOE OF SLOPE TO PROVIDE STORAGE CAPACITY.
  - EROSION LOGS SHALL BE PLACED ON THE CONTOUR WITH ENDS FLARED UP SLOPE.
  - SEE SHEET 2 OF 11 FOR JOINING LOGS DETAIL.

EROSION LOG TOE OF SLOPE PROTECTION

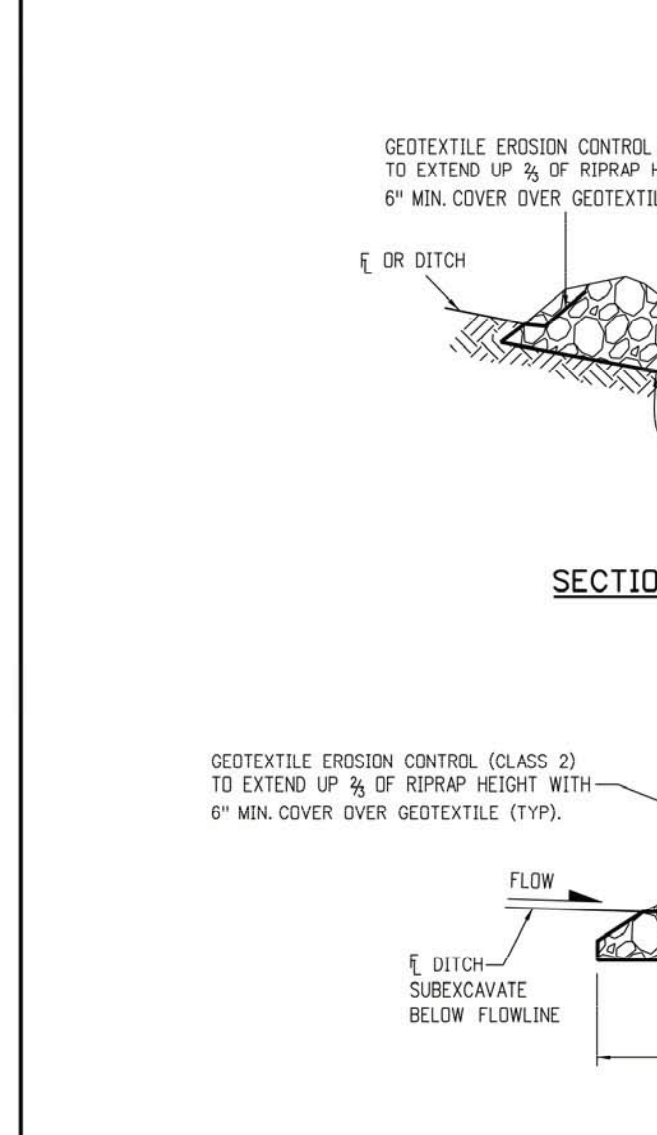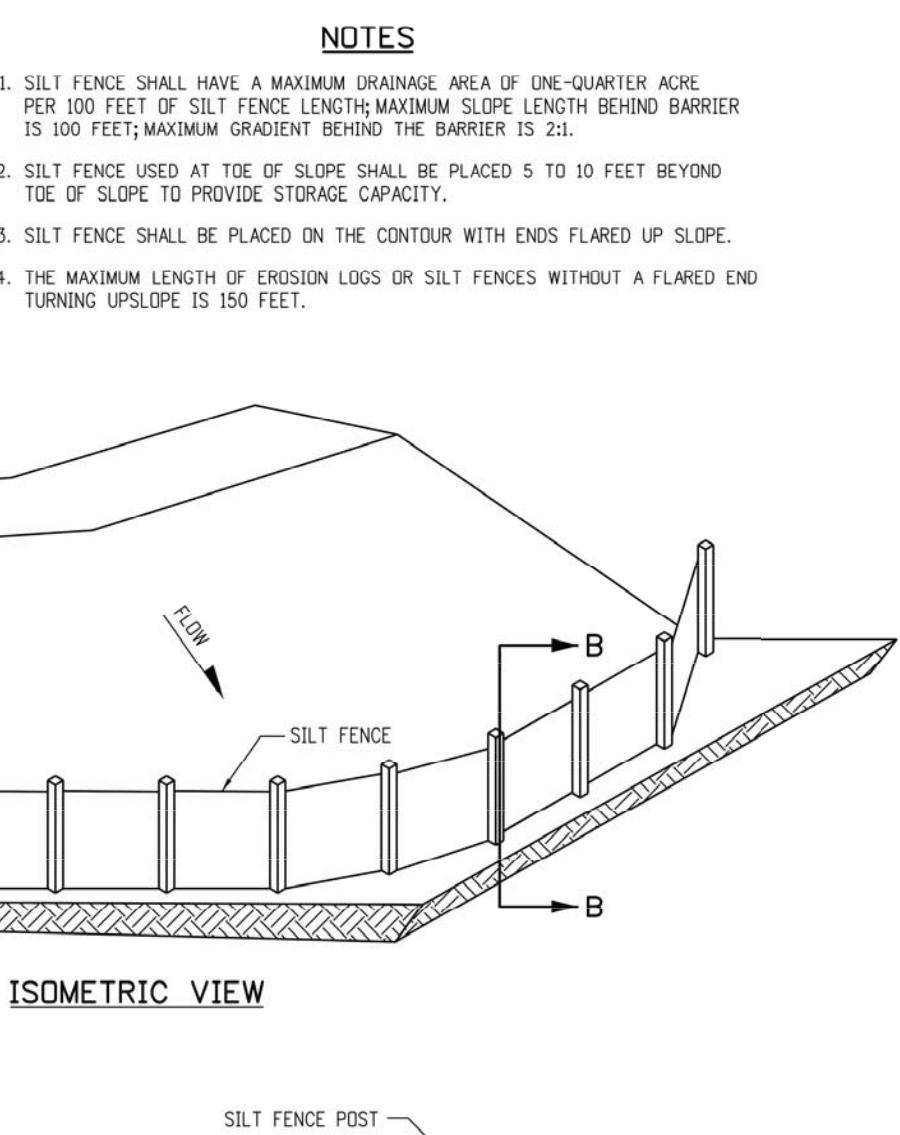



- NOTES:
- EROSION LOGS USED AT TOE OF SLOPE SHALL BE PLACED 5 TO 10 FEET BEYOND TOE OF SLOPE TO PROVIDE STORAGE CAPACITY.
  - EROSION LOGS SHALL BE PLACED ON THE CONTOUR WITH ENDS FLARED UP SLOPE.
  - SEE SHEET 2 OF 11 FOR JOINING LOGS DETAIL.

EROSION LOG TOE OF SLOPE PROTECTION

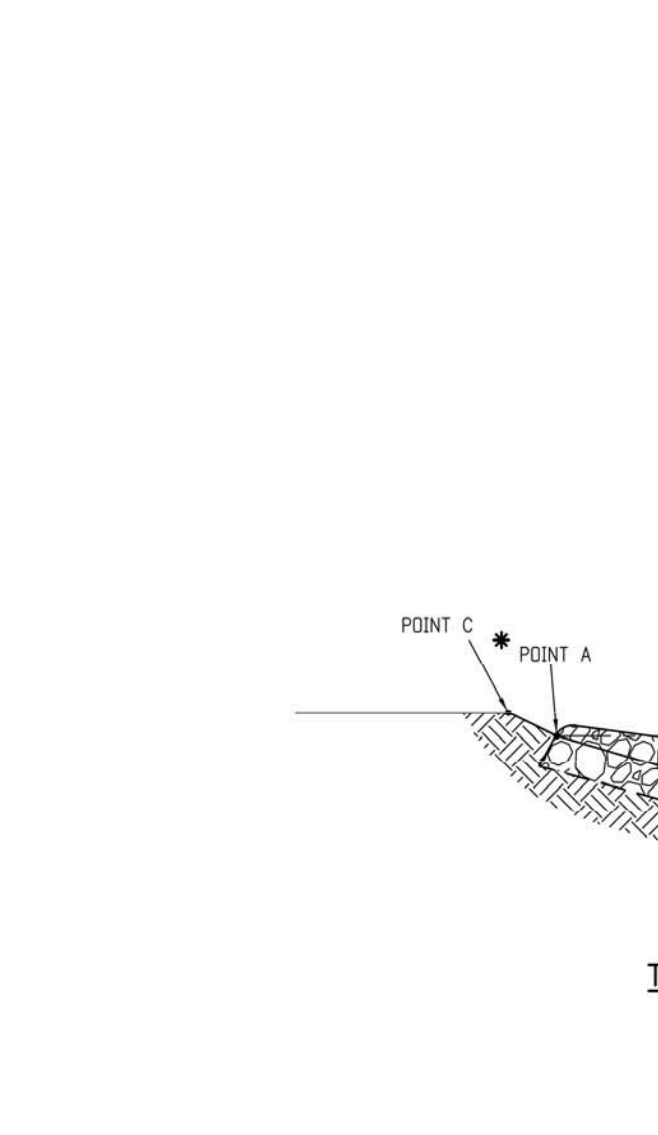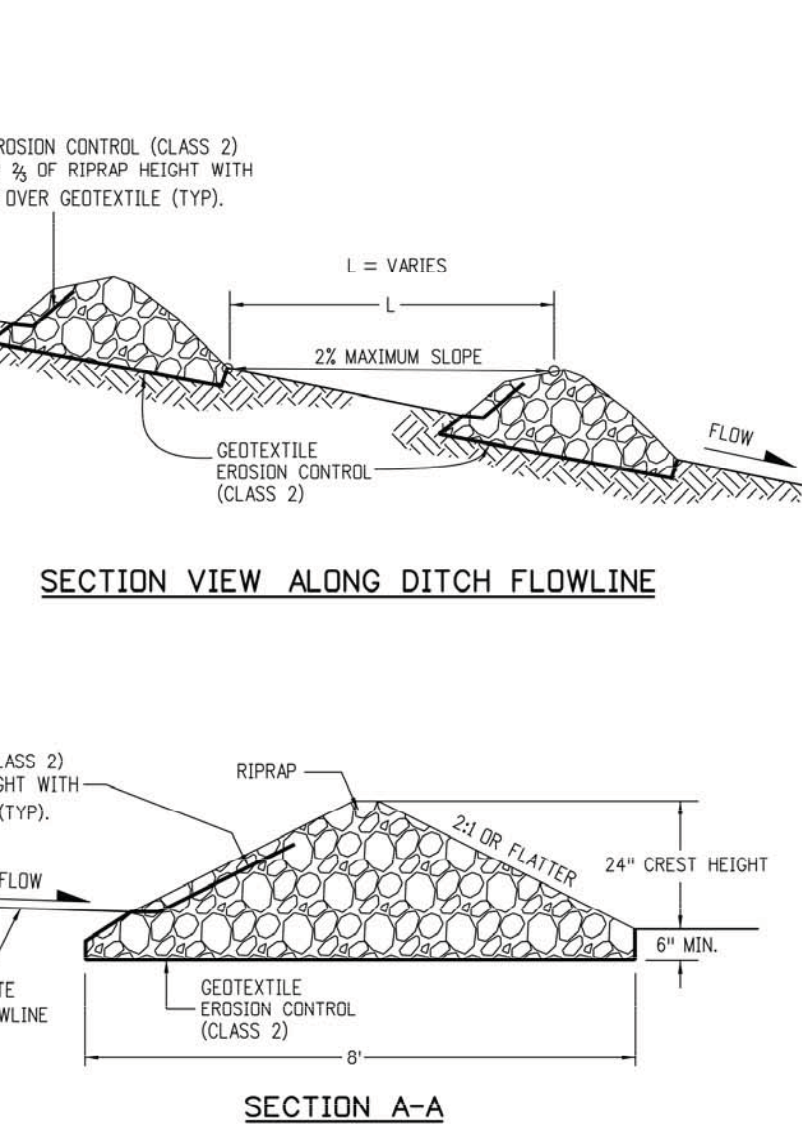

- NOTES:
- EROSION LOGS USED AT TOE OF SLOPE SHALL BE PLACED 5 TO 10 FEET BEYOND TOE OF SLOPE TO PROVIDE STORAGE CAPACITY.
  - EROSION LOGS SHALL BE PLACED ON THE CONTOUR WITH ENDS FLARED UP SLOPE.
  - SEE SHEET 2 OF 11 FOR JOINING LOGS DETAIL.

EROSION LOG TOE OF SLOPE PROTECTION

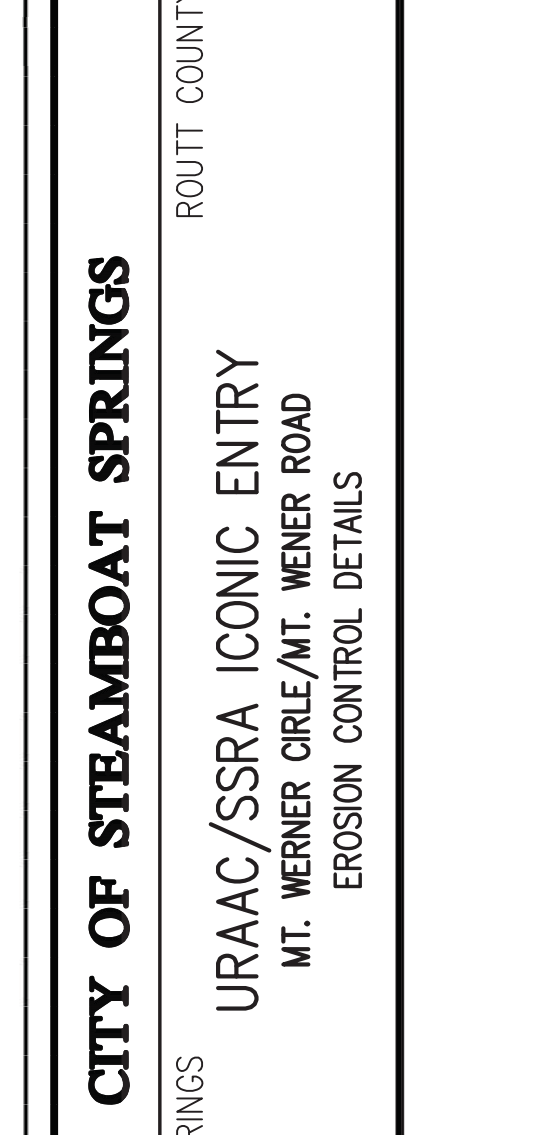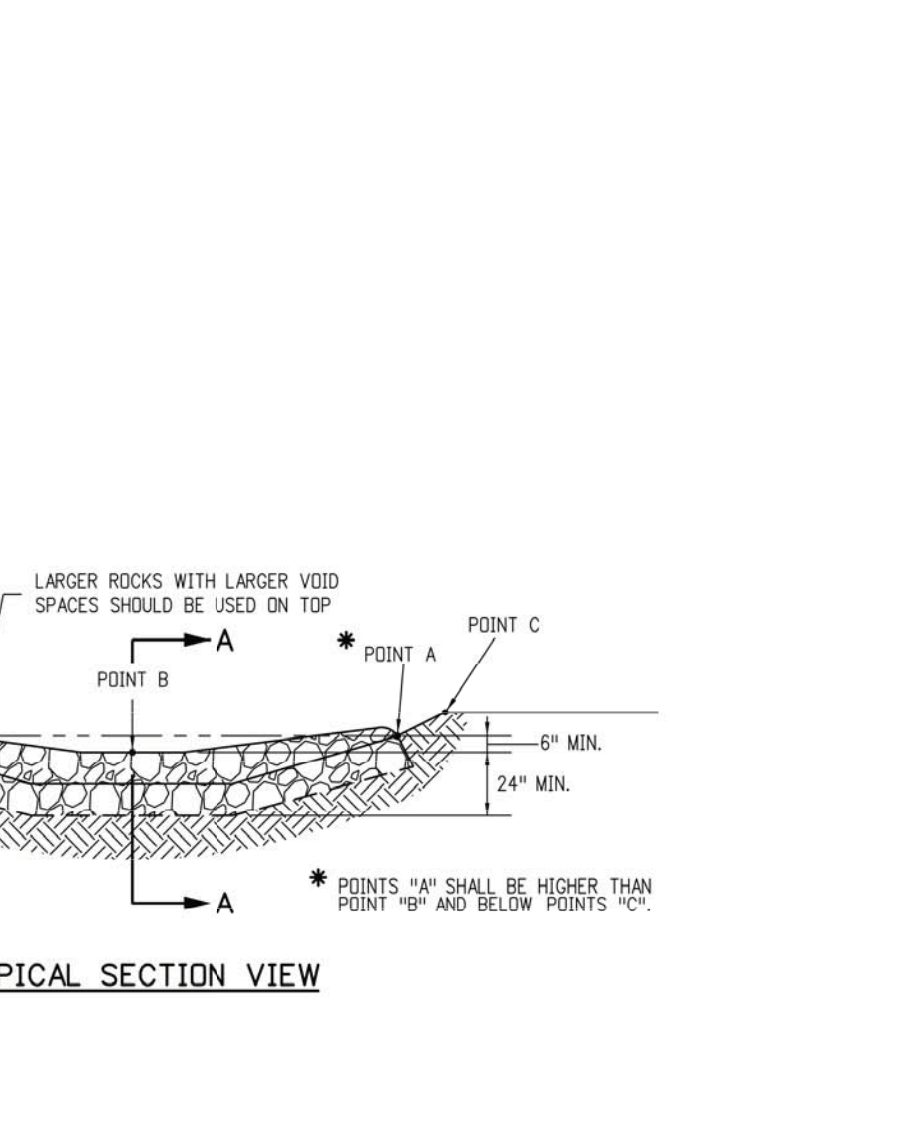

- NOTES:
- EROSION LOGS USED AT TOE OF SLOPE SHALL BE PLACED 5 TO 10 FEET BEYOND TOE OF SLOPE TO PROVIDE STORAGE CAPACITY.
  - EROSION LOGS SHALL BE PLACED ON THE CONTOUR WITH ENDS FLARED UP SLOPE.
  - SEE SHEET 2 OF 11 FOR JOINING LOGS DETAIL.

EROSION LOG TOE OF SLOPE PROTECTION

Computer File Information	
Creation Date: 07/04/12	Initials: JBK
Last Modification Date: 08/10/17	Initials: LTA
Full Path: www.coloradodot.info/business/designsupport	
Drawing File Name: 208010101.dgn	
CAD Ver.: MicroStation V8	Scale: Not to Scale Units: English

Sheet Revisions	
Date:	Comments
03/29/16	Minor revisions to some dimensions and general notes.

Colorado Department of Transportation	4201 East Arkansas Avenue CDOT HQ, 4th Floor Denver, CO 80222 Phone: 303-757-9021 FAX: 303-757-9868
Division of Project Support	JBK/LTA

TEMPORARY EROSION CONTROL	STANDARD PLAN NO. M-208-1
Issued By: Project Development Branch on July 4, 2012	Sheet No. 3 of 11

Computer File Information	Sheet Revisions
Creation Date: 07/04/12	Initials: JBK
Last Modification Date: 08/10/17	Initials: LTA
Full Path: www.coloradodot.info/business/designsupport	
Drawing File Name: 208010101.dgn	
CAD Ver.: MicroStation V8	Scale: Not to Scale Units: English

Sheet Revisions	
Date:	Comments
03/29/16	Minor revisions to some Notes.

Colorado Department of Transportation	4201 East Arkansas Avenue CDOT HQ, 4th Floor Denver, CO 80222 Phone: 303-757-9021 FAX: 303-757-9868
Division of Project Support	JBK/LTA

TEMPORARY EROSION CONTROL	STANDARD PLAN NO. M-208-1
Issued By: Project Development Branch on July 4, 2012	Sheet No. 11 of 11


Computer File Information	Sheet Revisions
Creation Date: 07/04/12	Initials: JBK
Last Modification Date: 08/10/17	Initials: LTA
Full Path: www.coloradodot.info/business/designsupport	
Drawing File Name: 208010101.dgn	
CAD Ver.: MicroStation V8	Scale: Not to Scale Units: English

Sheet Revisions	
Date:	Comments
03/29/16	Minor revisions to some Notes.


Colorado Department of Transportation	4201 East Arkansas Avenue CDOT HQ, 4th Floor Denver, CO 80222 Phone: 303-757-9021 FAX: 303-757-9868
Division of Project Support	JBK/LTA




LANDSCAPE PLAN

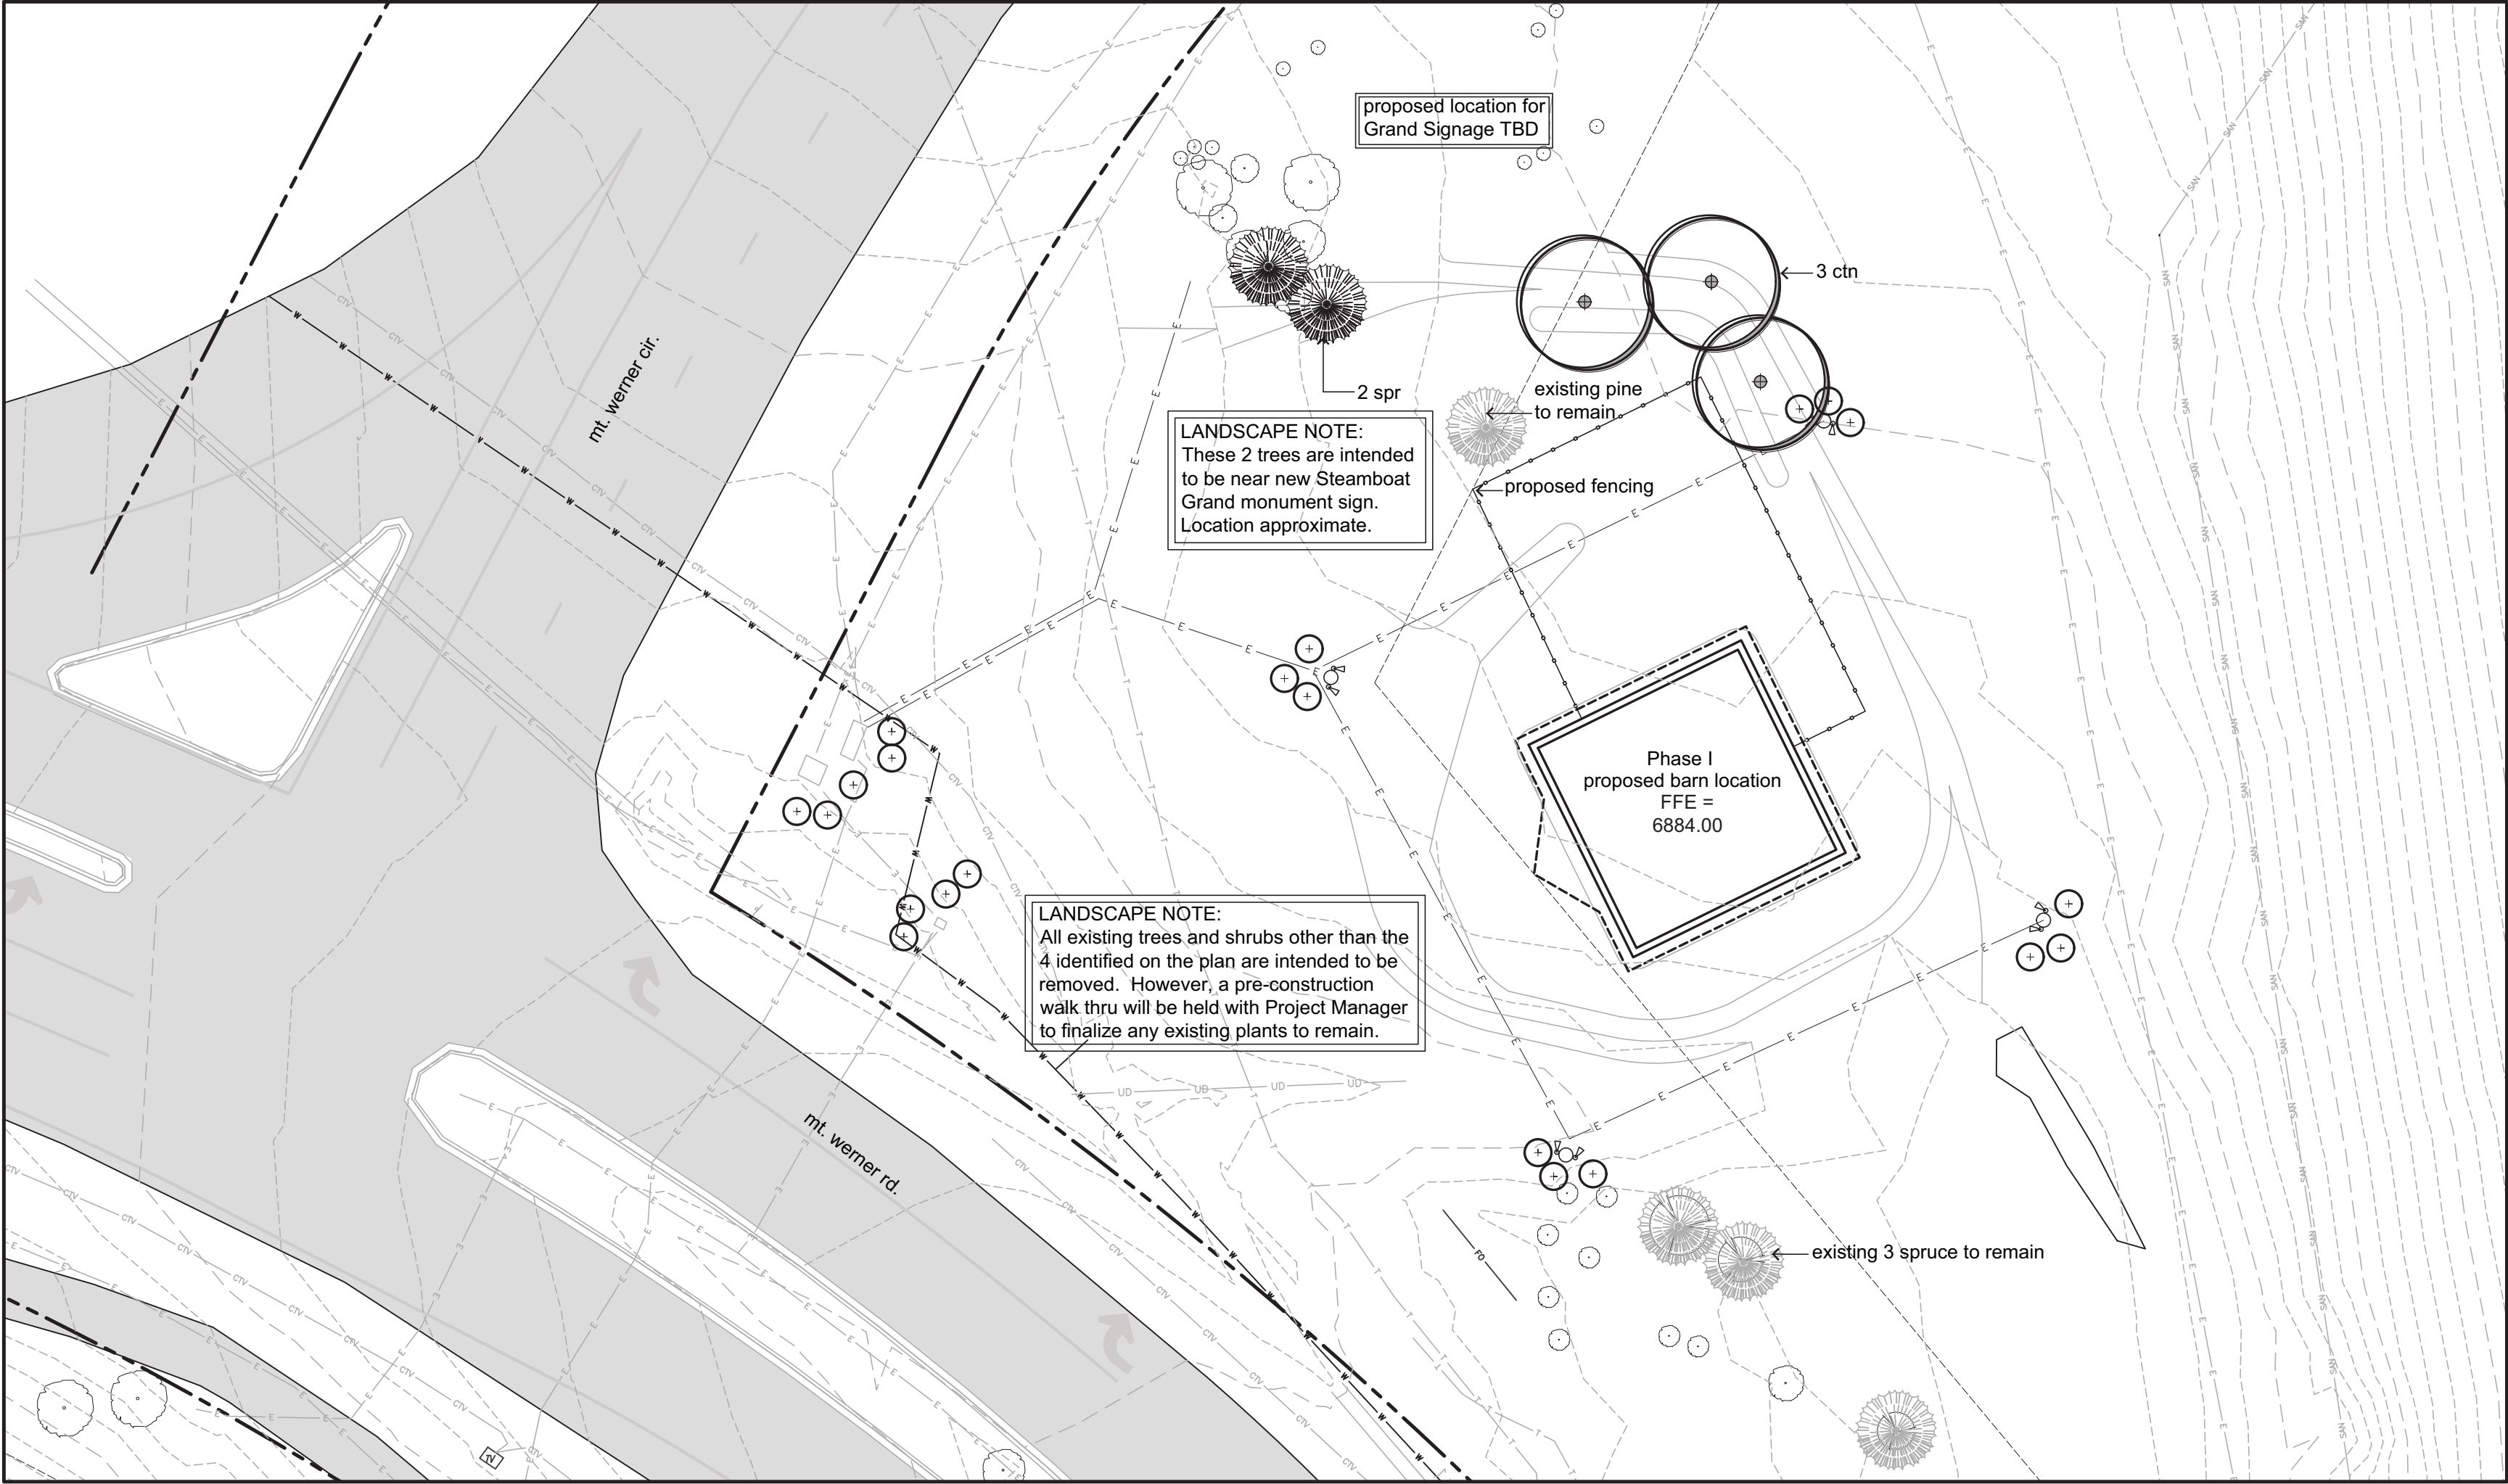

IRRIGATION PLAN

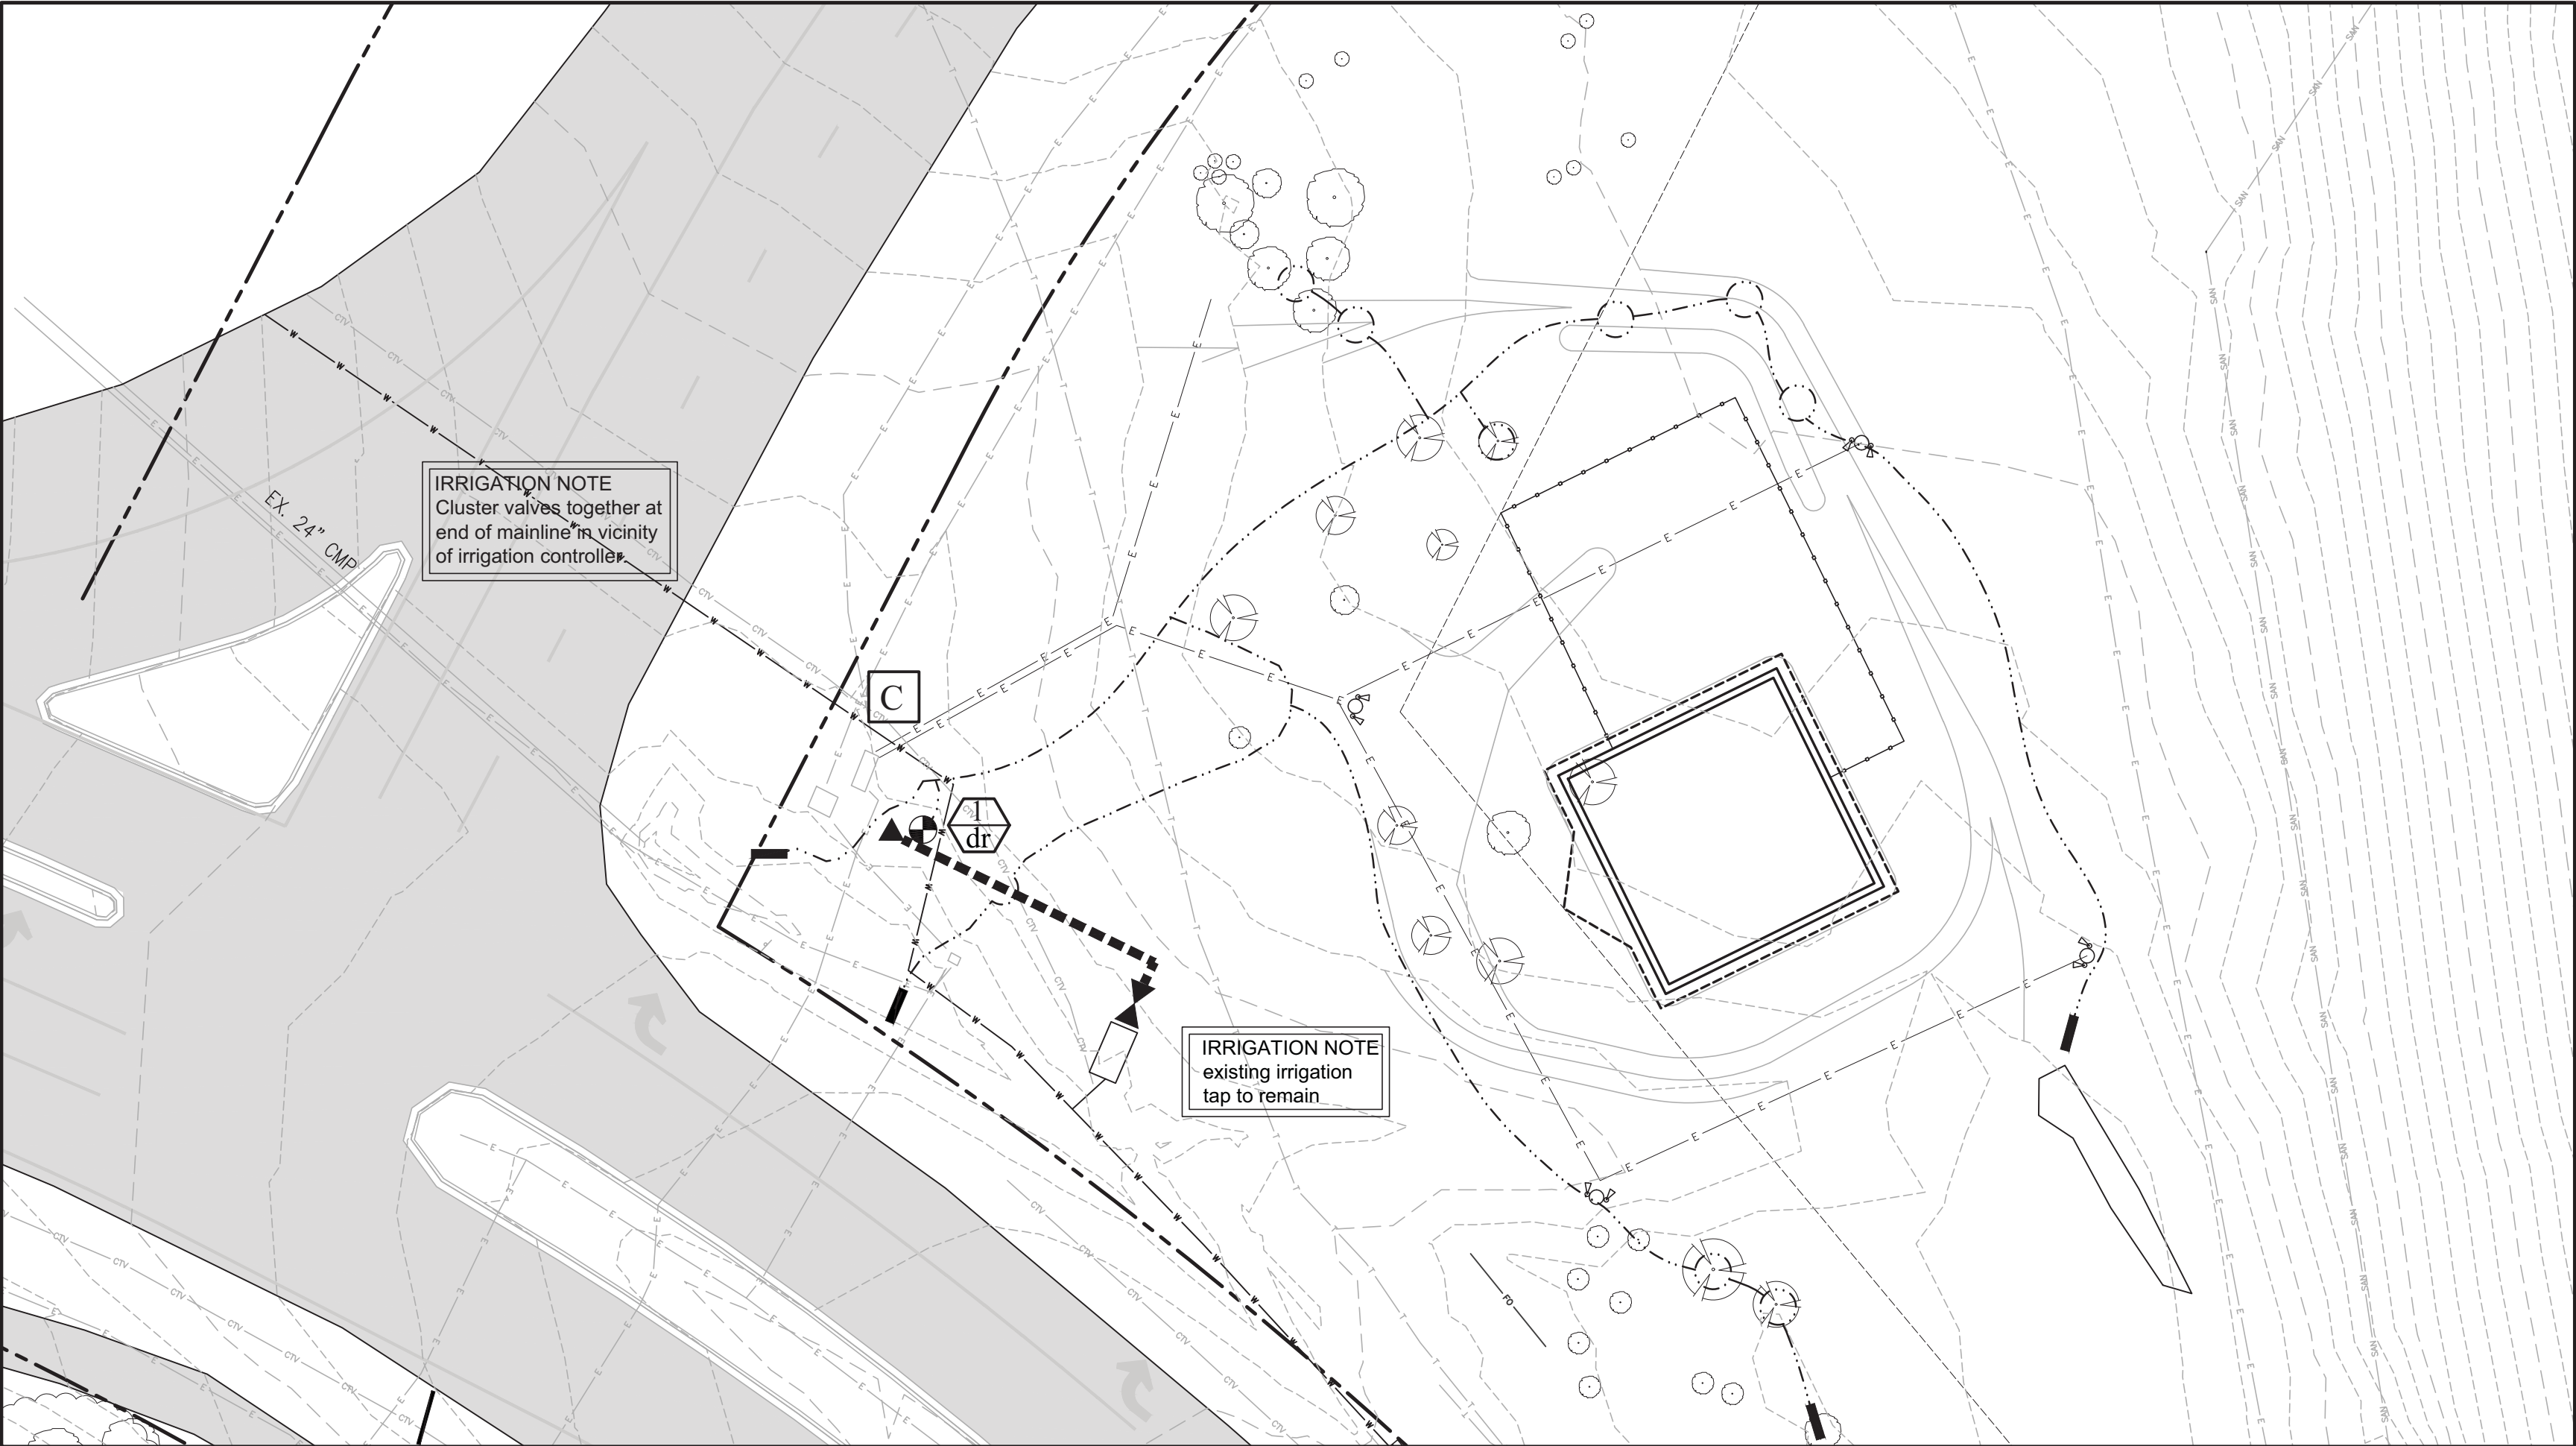

LANDSCAPE LEGEND

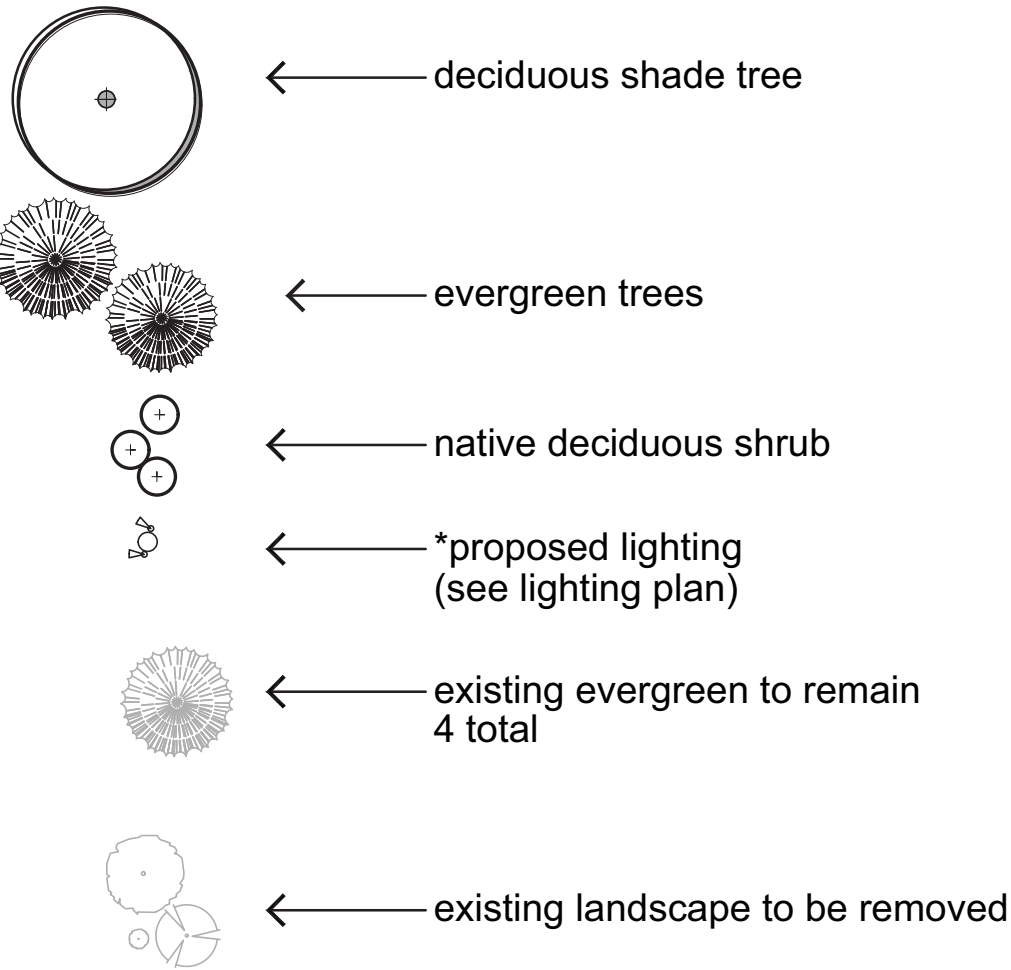

PLANT LIST

#	SYM	BOTANIC NAME	COMMON NAME	SIZE
2	spr	picea pungens	colorado spruce	9'-10' ht.
3	ctn	populus angustifolia	narrowleaf cottonwood	2.5" cal.
21	chk	prunus virginiana	native chokecherry	5 gal.

\* All plants, related irrigation and lighting will be installed in Phase I.

TREE COUNT


2	proposed colorado spruce
3	proposed narrowleaf cottonwood
7	proposed shrubs (21 shrubs = 7 trees)
3	existing colorado spruce to remain
1	ponderosa pine to remain

16 total

NOTES

- Existing conditions provided by Baseline Engineering.
- Site grading plan provided by Baseline Engineering.
- Prior to the start of any excavation for the project contractor shall notify utility locating company for location of all existing utilities.
- Project manager to approve layout of all proposed work prior to installation.

IRRIGATION LEGEND

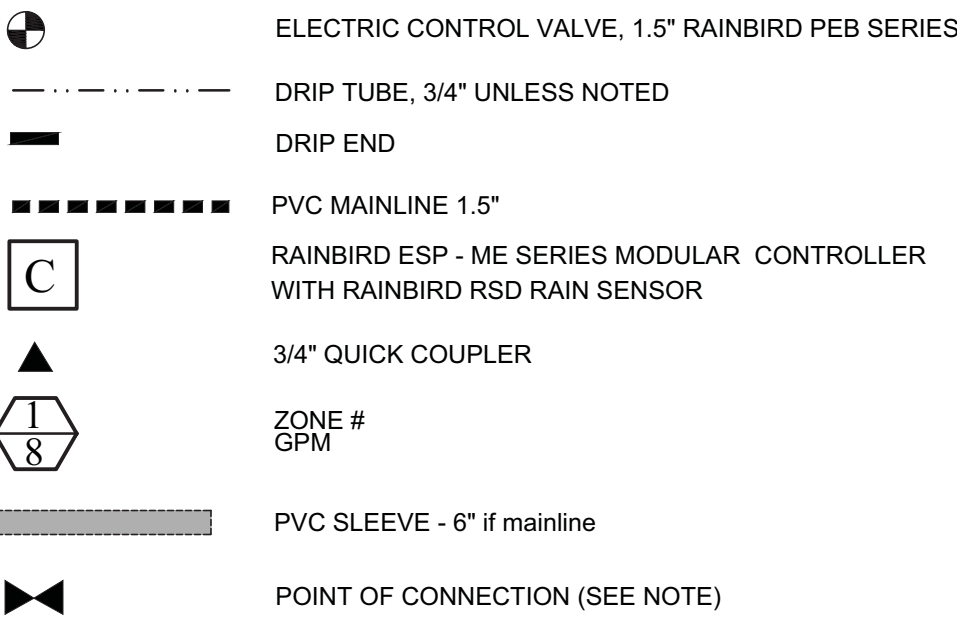

Operating System design parameters - up to 30gpm @ 45psi-Contractor to field verify prior to start of installation  
Point of Connection  
In Place - confirm  
• 1 1/2" backflow prevention device  
• 1 1/2" pressure reducing valve

Irrigation Controller  
• to be installed approximately where shown

GENERAL IRRIGATION NOTES

- Existing Conditions and Site layout plan provided by Baseline Engineering.
- Prior to the start of any excavation for the project the Irrigation Contractor shall notify all local utility locating services for the location of all existing utilities.
- Irrigation drawing is diagrammatic in nature. All heads, valves, mainline, laterals, driptube, sleeves, and related irrigation components are to be located outside of all Public ROW's shown on Civil Drawings. Irrigation Contractor to field locate all ROW's and utility easements to insure that irrigation components are not installed within these areas.
- Contractor shall maintain positive drainage away from all building foundations, structures and planting beds at all times.
- These plans and associated specifications for irrigation system installation begin on the downstream side of backflow prevention device. Specifications and installation of irrigation tap and backflow preventer by others.
- See sheet L.101 for irrigation details and specifications.


Landscape Plan

URACC / SSRA ICONIC ENTRY  
The Arnold Barn Re-Location  
Steamboat Springs, CO

MBC DESIGN, INC.  
LANDSCAPE ARCHITECTURE  
SITE DESIGN  
WATER USE in LANDSCAPE  
P.O. Box 773522  
Steamboat Springs, CO 80477  
(970) 879-7740

sheet #  
L.100




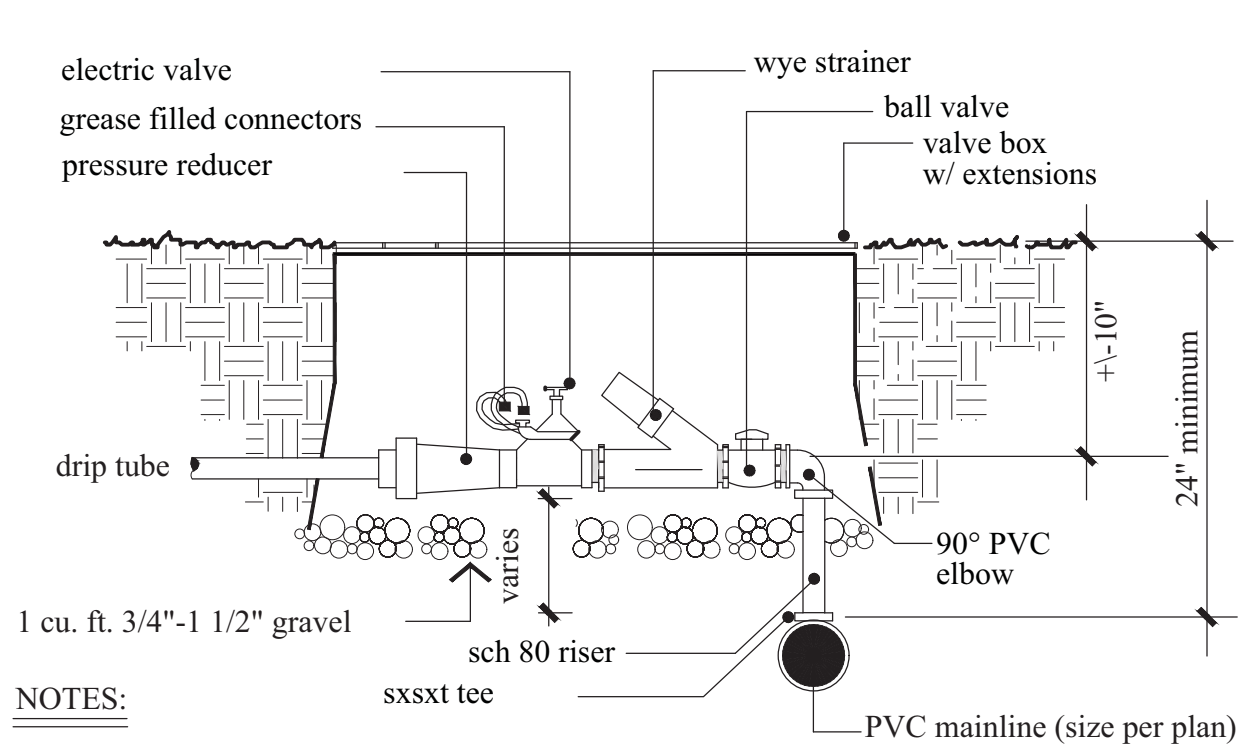


NOTES:

-one valve per large valve box, maximum


**1**  
L.101 DRIP VALVE ASSEMBLY  
no scale

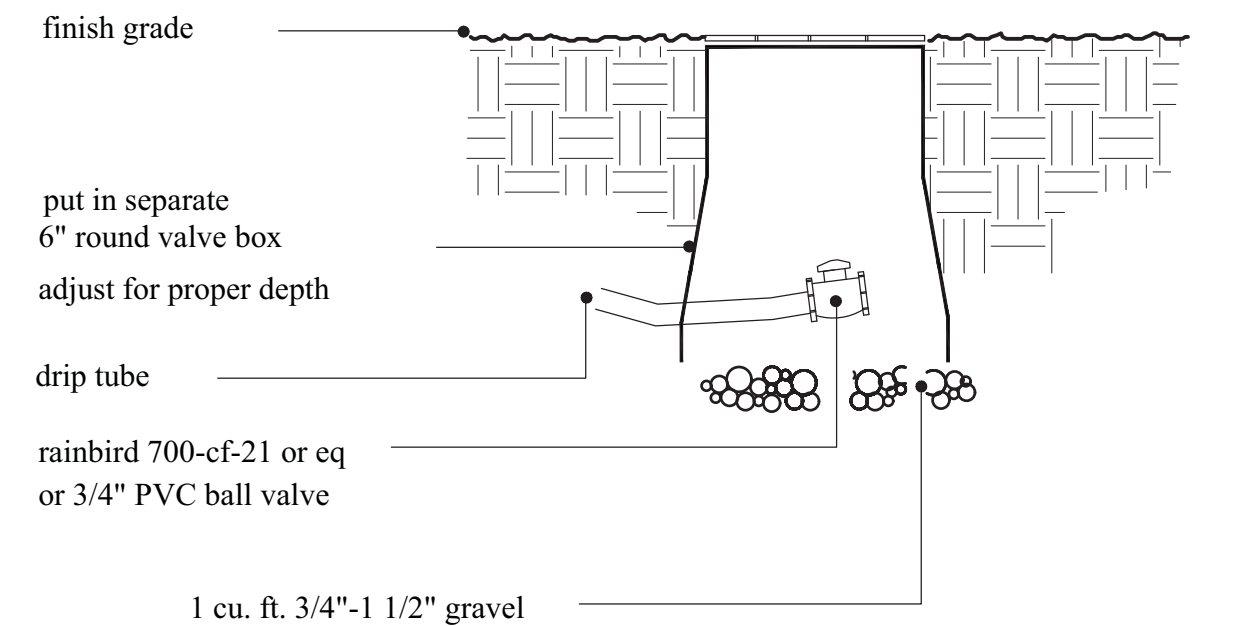


**4**  
L.101 DRIP TUBE END CLOSURE  
no scale

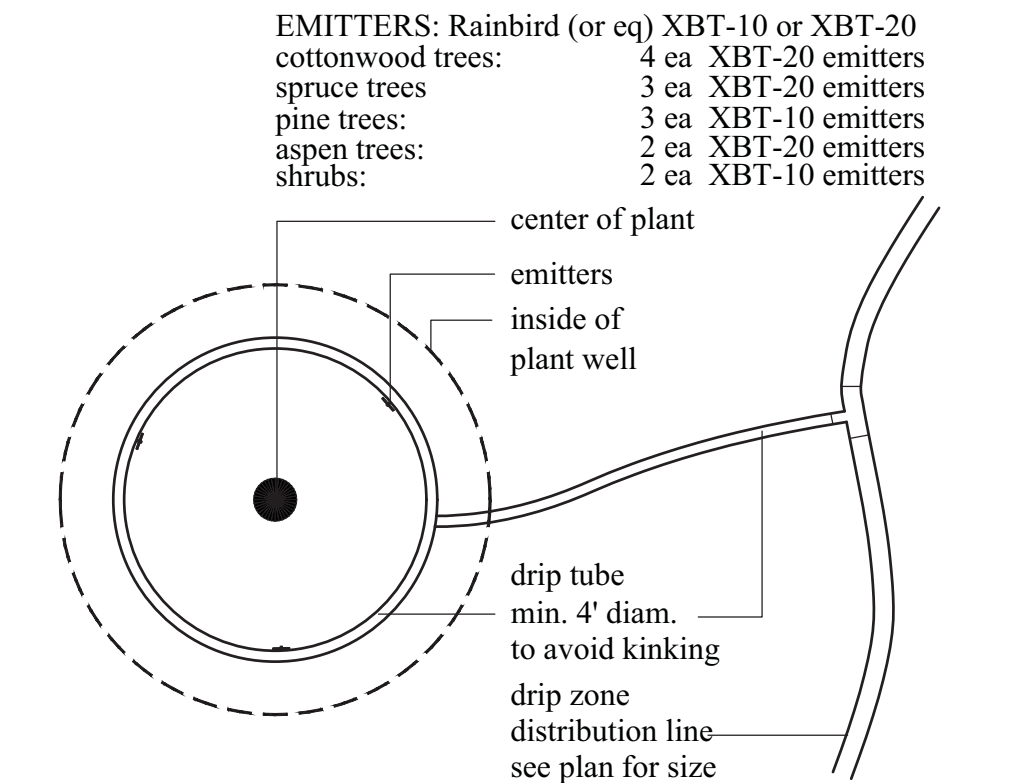

**2**  
L.101 TUBE & EMITTERS AT TREES  
no scale

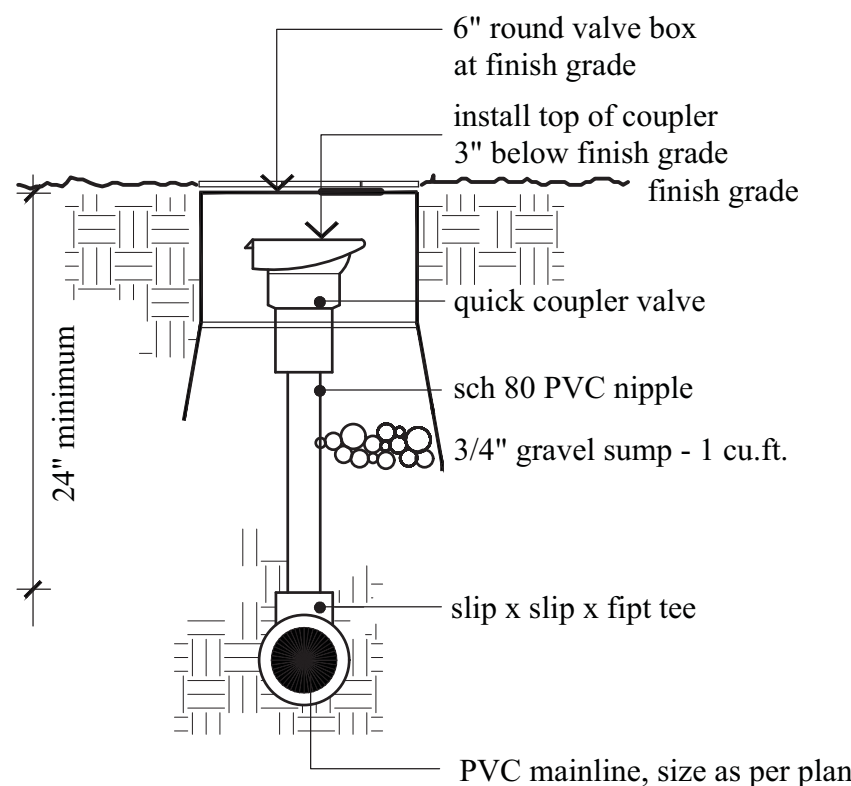


**5**  
L.101 QUICK COUPLER VALVE DETAIL  
no scale


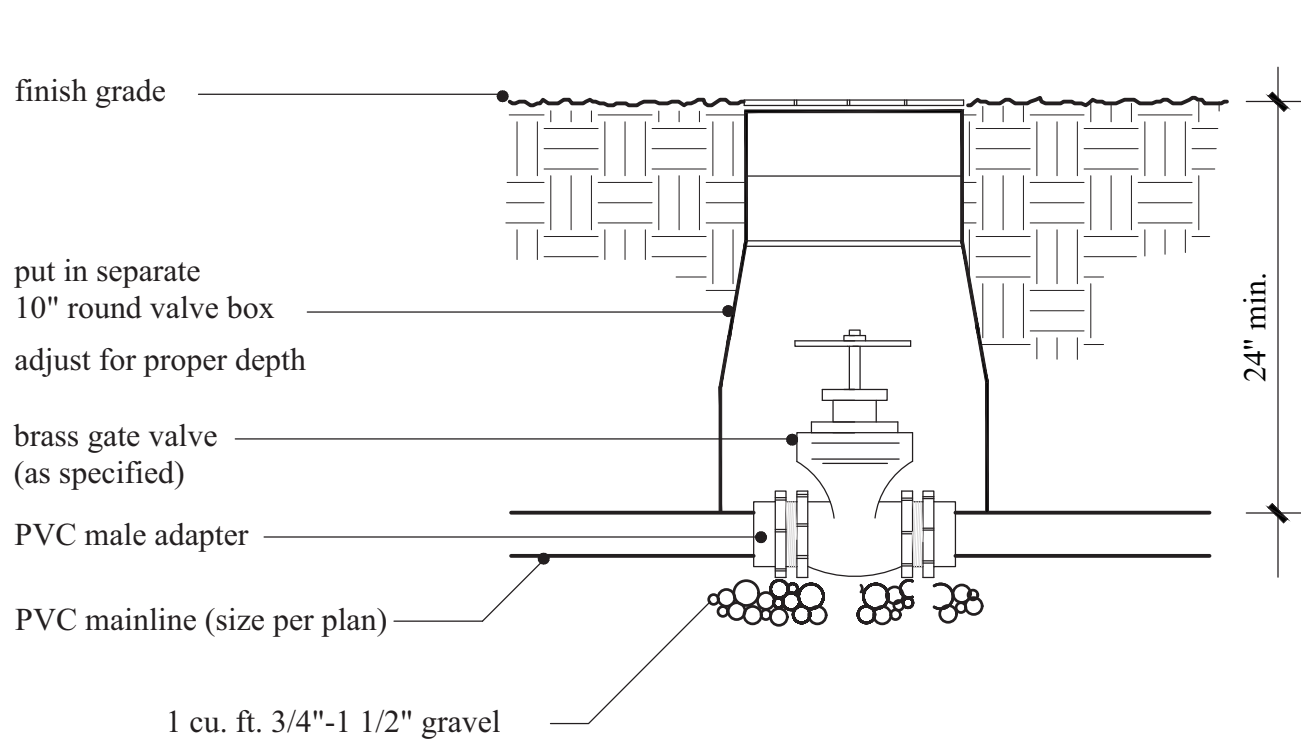


**3**  
L.101 GATE VALVE/ISOLATION VALVE  
no scale

## MAINLINE CONTROL WIRING & WIRING NOT IN MAINLINE TRENCH DRIPTUBE 4\"

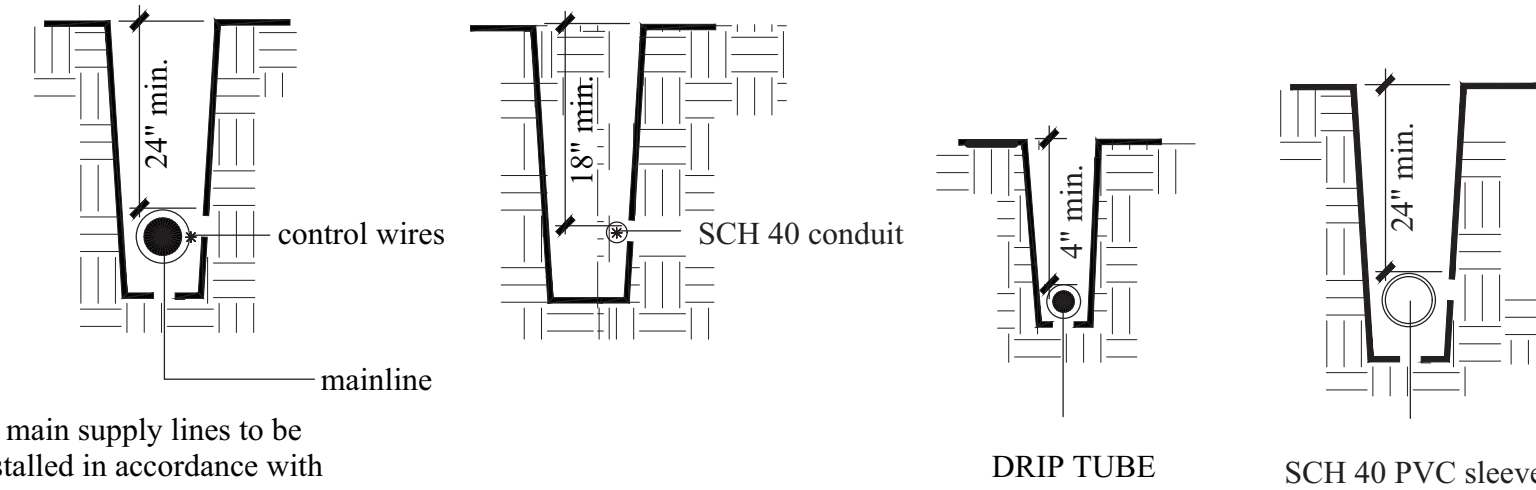

**6**  
L.101 TYPICAL TRENCHING DETAIL  
no scale

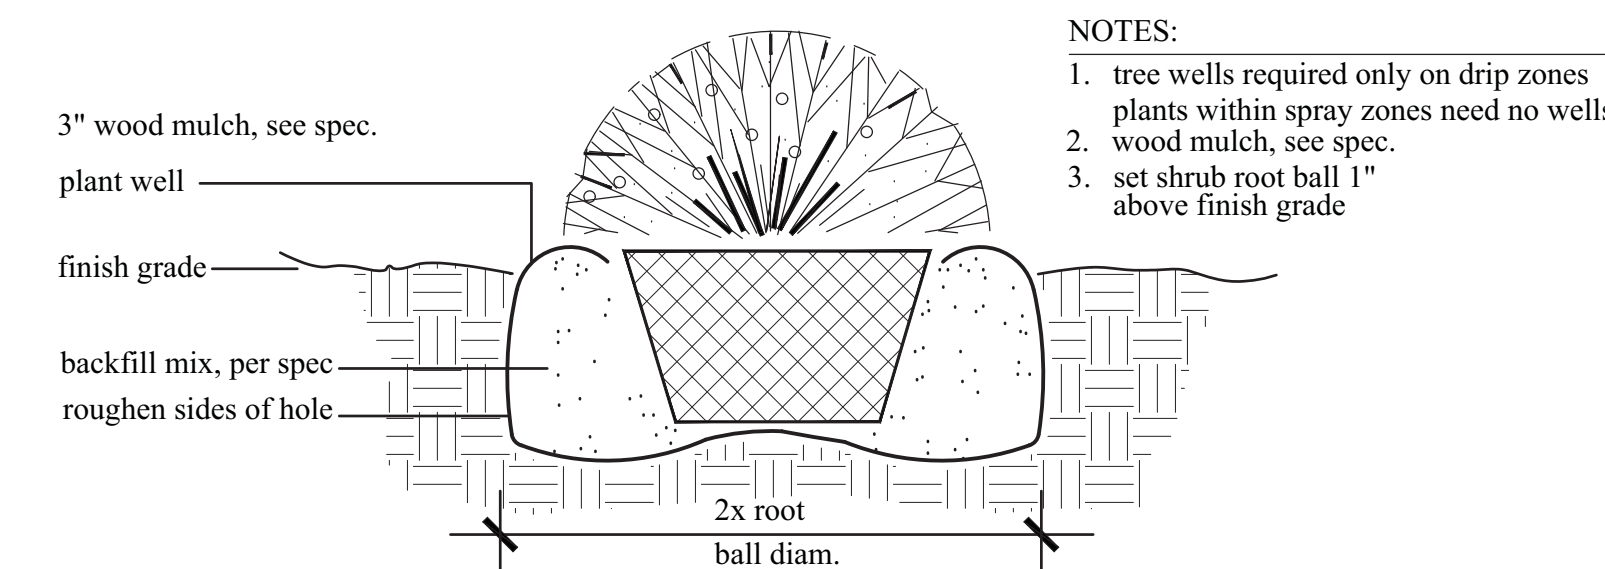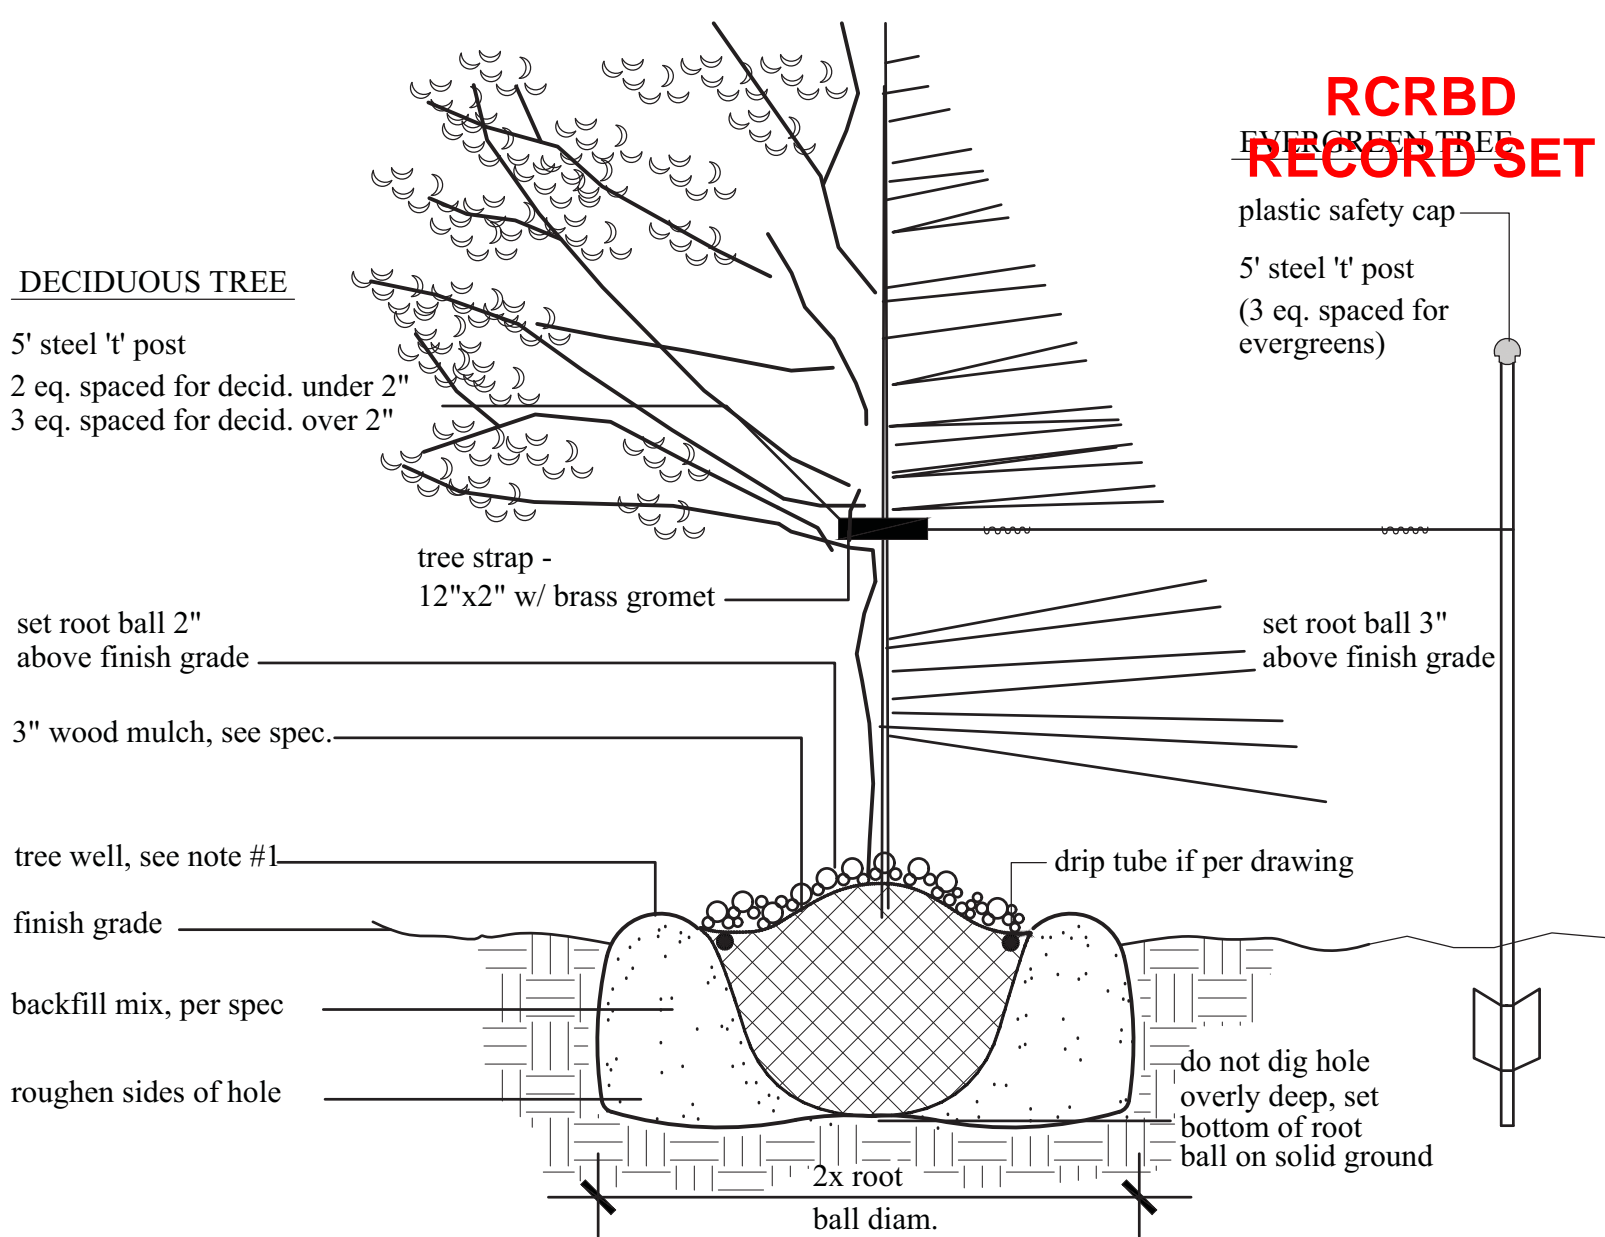

**7**  
L.101 PLANTING DETAILS  
no scale

## DESCRIPTION of WORK - IRRIGATION

- Work shall include all labor, materials and equipment and obtaining of all permits required to complete the sprinkler system as indicated on the irrigation plan and these specifications. The work shall comply with the requirements of all legally constituted authorities having jurisdiction.
- Work shall be performed in accordance with the best standards of practice relating to the various trades and under the continuous supervision of a competent foreman capable of interpreting Drawings and Specifications. The Contractor shall notify the Project Manager as soon as any discrepancies between Drawings and Specifications are discovered.
- Coordinate work of this section with site work, plumbing and other trades and schedule in a manner to avoid damage to other work.
- It is intended that the Drawings and Specifications specify an efficient and complete sprinkler irrigation system for use in accordance with the Manufacturer's recommendations and meeting the Project Manager's approval without further cost to the Owner.
- All plot and/or scale dimensions are approximate. Before beginning any phase of work, the Contractor shall check and verify all dimensions on the Drawings and shall notify the Project Manager of any discrepancies.
- The Contractor shall verify the authenticity of all finish grades within the project area for insurance of proper coverage of the sprinkler system. All finish grades shall be approved prior to installation of the irrigation sprinklers.
- All work specified on the Drawings by notes or details shall be furnished and installed whether or not specifically mentioned in the Specifications.
- Omissions from the Specifications or Drawings, or any misdescriptions of details or work which are absolutely necessary to carry out the intentions of the Drawings and Specifications shall not relieve the Contractor from performing such omitted details of work, but they shall be executed as if fully set forth and described in the Specifications and Drawings, at the Contractor's own expense.

### SUBMITTALS

#### A. Material List

All materials shall be new and the best quality of its kind. In addition to compliance with these Specifications and Drawings, all materials and equipment must be accepted by the Project Manager.

#### B. Record Drawings

The Contractor shall be furnished with three (3) sets of Drawings which indicate the work which is part of this contract. The Contractor shall record all changes in the work (including exact measurements of buried valves and locations) on two (2) sets, which will become the property of the Owner at the time of acceptance.

The Contractor shall dimension from two (2) reference points, (sidewalk or road intersection, etc.) the location of the following items:

- Connection of existing water lines, routing of pressure supply lines, sleeve locations, sprinkler control valves.

The Contractor shall deliver, on or before the date of final inspection, the corrected and completed Drawings to the Owner or his representative. Additionally, the contractor shall arrange for a surveyor to add to the CAD base map file points for valves, sleeves and irrigation mainline. Delivery of the Record Drawings will not relieve the Contractor of the responsibility of furnishing the Owner with required location information during the one (1) year guarantee period.

#### C. Operation and Maintenance Data

Submit written operating instructions, watering schedule, and winterizing operations to the Owner prior to final acceptance.

### JOB CONDITIONS

#### A. Site Conditions

The Contractor shall coordinate his work with that of other trades wherever possible so as not to conflict. Before starting work, the Contractor shall inspect the site and check all grades to satisfy himself that he may safely proceed. Changes or alterations in the system to meet site conditions shall be made at the Contractor's expense.

#### B. Existing Utilities and Conditions

Before excavation, the Contractor shall call for location of all private and public cables, conduits, sewers, septic tanks, and other underground utilities, and shall be cautious enough as not to damage them. If such obstacles conflict with the proposed work, the Contractor shall immediately notify the Project Manager for arrangements for relocations.

In the event of damage, the Contractor shall repair or replace these lines to the satisfaction of the Owner of these lines.

#### C. Water Supply Source

The water supply source will be in place by others and shall be 1 1/2\"/>

Contractor to confirm design pressure and flow is available prior to the start of installation. Minor changes caused by actual site conditions shall be made by the Contractor at no expense to the Owner.

### WARRANTY

The entire sprinkler system work shall be guaranteed for the period of one (1) year from the date of acceptance of work.

Should any trouble develop within the time specified above, due to faulty workmanship or material, the defect shall be corrected by the Contractor without expense to the Owner. Any settling of backfilled trenches which may occur during the guarantee period shall be repaired without expense to the Owner, including complete restoration of all damaged property.

As part of contract, during the guarantee period the Contractor shall make adjustments to the system as necessary, winterize the system in the 1st Fall with compressed air, put it in operation in the 1st Spring and perform all other necessary service work without additional cost to the Owner.

### MEASUREMENT AND PAYMENT

Measurement of the sprinkler system shall be on the basis of the entire system furnished and installed complete and in place, including all pipe, fittings, sprinkler heads, valves, automatic controller, wiring and incidentals necessary to complete the item and provide the coverage of the areas to be landscaped. Payment will be made on a % complete basis of the lump sum bid. A 10% retainage will be held from each payment and be released upon final acceptance of system and delivery of all specified as built information.

### MAINTENANCE

A. Contractor to maintain irrigation system, controller programing, and valve adjustments within guidelines acceptable to Landscape Architect until final acceptance.

### MATERIALS

- Pipe
  - Mainline. Pipe shall be PVC Pipe Belled end for solvent welds, Class 200 (SDR-21) as manufactured by Continental Plastics Industries, Inc., or approved equal. All pipe shall be continuous, new and permanently marked with the manufacturer's name. All pipe shall conform to the United States Department of Commerce commercial standard ASTM D-2241 NSF approved.
  - Fittings and Connections. All PVC pipe fittings shall be ASTM D-2241 Schedule 80 molded fittings suitable for solvent weld or with nipples and swing joint assemblies, screwed connections.
- Valves And Keys
  - Electric Remote Control Valve. Valves shall be of type and size as indicated drawings.
  - Quick Coupling Valves (2-piece body). The quick coupling valves, where indicated in the Drawings, shall be of type and size as indicated on drawings. Sprinkler Quick-Coupling Valve Keys. The valve keys shall be of the same manufacturer as the quick coupling valves and shall be of proper size to fit the valves as previously specified. Top key shall have male and/or female thread, as specified, for the sprinkler connection.
  - Isolation/Gate Valve. All brass, size per plan.
  - Valve Boxes. All remote control valves, gate valves and quick coupler valves shall be installed in suitable thermoplastic valve access boxes of proper size as required for easy access to the valve.

D. Automatic Controller. Irrigation Contractor shall supply the controller to site electrician. The controller will be installed where convenient along with other electrical components such as meter and panel for barn lighting. See plan.

E. Irrigation Control Wiring. All wiring to be used for connecting the automatic controller to the electric remote control valves shall be the type UF-600V, #14, single wire direct burial UF irrigation control cable. All pilot or "hot" wires are to be of one color and all "common" wires are to be another color. Extra wire will be used in the case of wire failure. See drawings for notes on additional, future, and spare wiring.

### EXECUTION

#### INSTALLATION SCHEDULE, IMPLEMENTATION & SYSTEM TESTING

The irrigation work shall be scheduled by the Contractor in such a way that it is not interrupted for periods so long that plant materials and lawns are injured permanently. When Contractor is prepared for one of the required inspections, he shall give the Project Manager & Landscape Architect twenty-four (24) hours notice to visit the site and perform the inspection. This does not preclude the right of the Project Manager to make informal inspections at any time during the work of this section. The required inspections for which the Contractor must notify the Project Manager are as follows:

- Planting, Utility And Sprinkler Location Staking. The Landscape Architect shall inspect the staked locations of all utility lines, proposed trees and shrubs and sprinkler lines and heads for conformance to these Drawings and Specifications. The Landscape Architect reserves the right to move, shift or adjust any or all of the stakes to better achieve the design intentions as shown on the Drawings. No trenching shall be done until approval of inspection is complete.
- Mainline Pressure Test. In the presence of the Project Manager & Landscape Architect, the Contractor shall conduct a pressure test on the mainline pipe at the full applicable system design pressure to determine if there are any leaks in the pipe or joints. A minimum of twenty four inches (24") of soil will be placed over lines, with all joints exposed during testing, and all valves uncovered. Failure to execute testing in this manner will be corrected at the Contractor's expense.

### CONTROL WIRING

Control and Common Wire Installation. Control, common and extra wires shall be installed beside the mainline (see Details). Wire shall then be placed as loose as possible and with as much slack as possible to allow for expansion and contraction of the wire. Where it is necessary to run wire in a separate trench, the wire shall have a minimum cover of twelve inches (18") and shall be sleeved in Schedule 40 PVC electrical conduit. Verification of wire types and installation procedures should be checked to conform to local codes. Connecting and splicing of wire at the valve or in the field may be made by using Pen-lite wire connectors or grease filled wire nuts (as designated by the Details).

### AUTOMATIC CONTROLLER

Controller shall be as specified. Irrigation contractor to provide controller to project electrician for mounting and connection to 110v power.

### VALVES AND VALVE BOXES

Control Valves and Quick Coupler Valves. Quick Coupler valves shall be installed as per details on this sheet.

Valve Boxes. Control valve boxes shall be installed on a minimum of one (1) cubic foot base of gravel for proper foundation of box and easy leveling of box to proper grade and also to provide drainage of the access box.

### TAP AND BACKFLOW PREVENTER

Backflow preventer and pressure reducing valve are in place per water district details and not a part of this contract. Contractor to confirm design pressure and flow is available prior to the start of installation. See Point of Connection note.

### FLUSHING

After all new sprinkler piping is in place and connected for a given section, and all necessary work has been completed, prior to the installation of the sprinkler heads, all control valves shall be opened and a full head of water used to flush out the system.

### PLASTIC PIPELINE, FITTINGS

All workmanship and materials shall be in conjunction with all applicable local codes and ordinances of legally constituted authorities: where the provisions of these Specifications exceed such requirements, these Specifications shall govern. All plastic pipe shall be installed in a manner so as to provide for expansion and contraction as recommended by the Manufacturer.

### BACKFILLING

In no event shall trenches be backfilled until all required tests of the system have been completed and until the line has been approved by the Project Manager. Trenches shall be carefully backfilled with the excavated soil after all dirt clods and rocks larger than three inches (3") in diameter have been either broken up or removed. The backfill shall then be equally distributed on both sides of the pipe in twelve inch (12") layers and thoroughly compacted.

Puddling or jetting shall be used during backfilling operations. An excess of water shall be avoided in order to prevent disturbance of the ground around the periphery of the pipe and also to prevent unnecessary pressure on the pipe. When jetting is used, jets shall be of approved quality and sufficient length to reach the bottom of each layer.

Backfilling of trenches which cross future paths, as indicated on the Drawings, shall be thoroughly compacted to ninety-five percent (95%) relative compaction.

Any settling of backfilled trenches which may occur during the guarantee period shall be repaired without expense to the Owner, including complete restoration of all damaged property.

### LINES UNDER PAVEMENT

Provide sleeves using Schedule 40 PVC pipe sized as per Drawings where mainline and wire cross under future paths. Have surveyor locate all sleeves under paving and include within as built information.

Backfill trenches under paving, asphaltic concrete or concrete, with sand six inches (6") below and three inches (3") above the pipe, compacted in six inch (6") layers to ninety-five percent (95%) Standard Proctor density, using manual or mechanical tamping devices. Leave trenches flush with subgrade level to receive paving. Set in place, cap and pressure test all piping under paving prior to the paving work.

Provide a minimum cover of twenty inches (24") between the top of the pipe and the bottom of the aggregate base for all piping installed under paving.

### ADJUSTMENTS AND WINTERIZATION

During the guarantee period, the Contractor shall make adjustments to the system as necessary, drain the system in the Fall and put it in operation in the Spring and perform all other necessary service work without additional cost to the Owner.

The Contractor shall winterize the completed system at the conclusion of the first sprinkling season upon notification (within [3] days) to the Owner. All water shall be removed from the system by using compressed air. Contractor shall re-open, operate and adjust system malfunctions accordingly during the following year as requested by the Owner. The Contractor shall be responsible for properly draining the backflow preventer and making adjustments/replacements during the guarantee period.

### PROTECTION AND REPAIRS

Protection of Property. It shall be the responsibility of the Contractor for the protection and preservation of all plant materials, structure, ground surfaces, etc., from damage during irrigation construction. If damage does occur, all damage shall be completely repaired or restored by the Contractor at his own expense to the satisfaction of the Project Manager.

### CLEAN UP

A. Perform clean up as a continuous operation throughout the duration of the work.

### FINAL INSPECTION

When the Contractor is satisfied that the system is operating properly, that it is balanced and adjusted, and that all work and clean up is completed, he shall notify the Project Manager that he is prepared for Final Inspection with date and time at least seventy-two (72) hours in advance. At the given time the sprinkler system shall be inspected by the Project Manager and Landscape Architect for the following:

Gate valves and control valves operating properly and not leaking.

All drip emitters operational  
Controllers operating properly and programmed.

Any inconsistencies to the Drawings or Specifications shall be noted in writing by the Project Manager and/or the Landscape Architect and given to the Contractor.

## DESCRIPTION of WORK - LANDSCAPE

The work included under this section consists of furnishing all fees and permits, all labor, tools, equipment, material, transportation and services required to furnish and properly install all planting and related items as required by the Contract Drawings Sheet L-100 and these Specifications. The general extent of the planting is as noted, indicated and/or detailed on the Drawings and includes, but is not necessarily limited to the following:

- Excavating, planting, and backfilling for all plant materials.
- Walk through and replacement guarantee.
- Maintenance through construction period.

### PROJECT CONDITIONS

- Planting work shall be done under the direct supervision of a qualified superintendent working on the site with experienced laborers familiar with planting procedures.
- The Owner may schedule a pre-construction conference with Contractor at least 7 days before beginning work under this Section. Purpose of this conference is to review questions Contractor may have regarding the work, administrative procedures during construction and project work schedule.

### SUBMITTALS

Mulches - wood mulch

### WORK SCHEDULE

Proceed with the work as rapidly as the site becomes available, consistent with normal seasonal limitations for planting work.

### PRODUCT DELIVERY, STORAGE AND HANDLING

Labeling. Furnish standard products in manufacturer's standard containers bearing original labels legibly showing quantity, analysis, genus/species and name of manufacturer/grower.

### GUARANTEE

- Warrant that all plant materials are true to species and variety. Warrant that all trees and shrubs planted under this Contract will be healthy and in flourishing condition of active growth one year from date of Final Acceptance.

### REPLACEMENTS

- For a period of one (1) year after final acceptance of all work and at no additional cost to the Owner, the Contractor is to replace any plant material that is not healthy and flourishing and/or dead.

### PRODUCTS

### PLANT MATERIALS

- Plant Material - All plant material shall be supplied in sizes as indicated in plant list.
- Substitutions are not permitted except on proof that plant materials specified are not available. Request for substitution must be made to the Owner. Cost of substitute plants shall be approved by the Owner. Larger plants than those specified in the plant list may be supplied in which case the root system shall be proportional to the size of the component parts of the plant in the opinion of the Project Manager.
- The Owner and Project Manager shall have the right to reject plants prior to and during progress of work for size, conditions of top structure, condition of root structure, defects or injuries, or non-conformity to specifications.

### TREE STAKING AND GUYING

Tree brace straps shall be provided at connection of guy or pole support wires to tree trunk.  
Staking poles shall be standard "T" five (5) foot high steel fence posts, dark green or approved color.  
Guy wire shall be 14 gauge single strand pliable wire or equal.

### MULCHING MATERIAL

- Western Cedar Mulch. To be used in maintained plant beds. Shredded Cedar of a brown color free of twigs, sticks, dirt, sawdust and stones to be approved by Landscape Architect prior to installation. Chipper mulch is not acceptable.

### EXECUTION

### PLANTING

- Locations of all Material shall be flagged and approved by the Landscape Architect and Owners Representative before planting. 4' survey lath is to be used for tree layout. 5 gal. and less size plants will be placed for layout approval. Any materials placed in ground without location approval, will be subject to re-location at Contractor's expense. Do not install irrigation heads or piping prior to bed layout approval.
- In drip applications, build 3 inch berm around the edge of the rootball to form basin for holding water.

### STAKING AND GUYING

All trees shall be staked and guyed as detailed.

### MULCHES

- Mulching shall take place after all shrubs and trees have been planted and all drip systems have been inspected.
- Install a 3 inch deep layer of wood mulch in all shrub and tree rings.

### GENERAL CLEAN-UP

During the process of the work, the site shall be kept in a condition which is clean, neat, and free from the accumulation of cans, surplus materials, and waste materials. All planting areas shall be neatly dressed and finished and all walks, paved areas, and the like flushed clean to the satisfaction of the Owner.

### FINAL WALK-THROUGH

- The Contractor shall arrange for presence of the Owner Representative, Project Manager and Landscape Architect 72 hours in advance.
- The Owner shall be satisfied with all aspects of the entire project. Once all items have been resolved to the satisfaction of the Owner, the Owner shall notify the Contractor in writing of final acceptance and the one year warranty on all materials and labor shall begin.

date 9-12-17
city submittal #1
rev. 11-17-17
city submittal #2
rev. 12-6-17
lac comments
rev. 5-11-18
construction set

## Landscape & Irrigation Details and Specifications

## URACC / SSRA ICONIC ENTRY The Arnold Barn Re-Location Steamboat Springs, CO





SKETCH: SK-001


PROJECT: **ARNOLD BARN**

DATE: 11/13/2017

SCALE: N.T.S.

DRAWING BY: **BJW**

10 ft. tall pole with two (2)  
Type SA fixtures attached to  
each pole. Typical of four (4)  
poles.

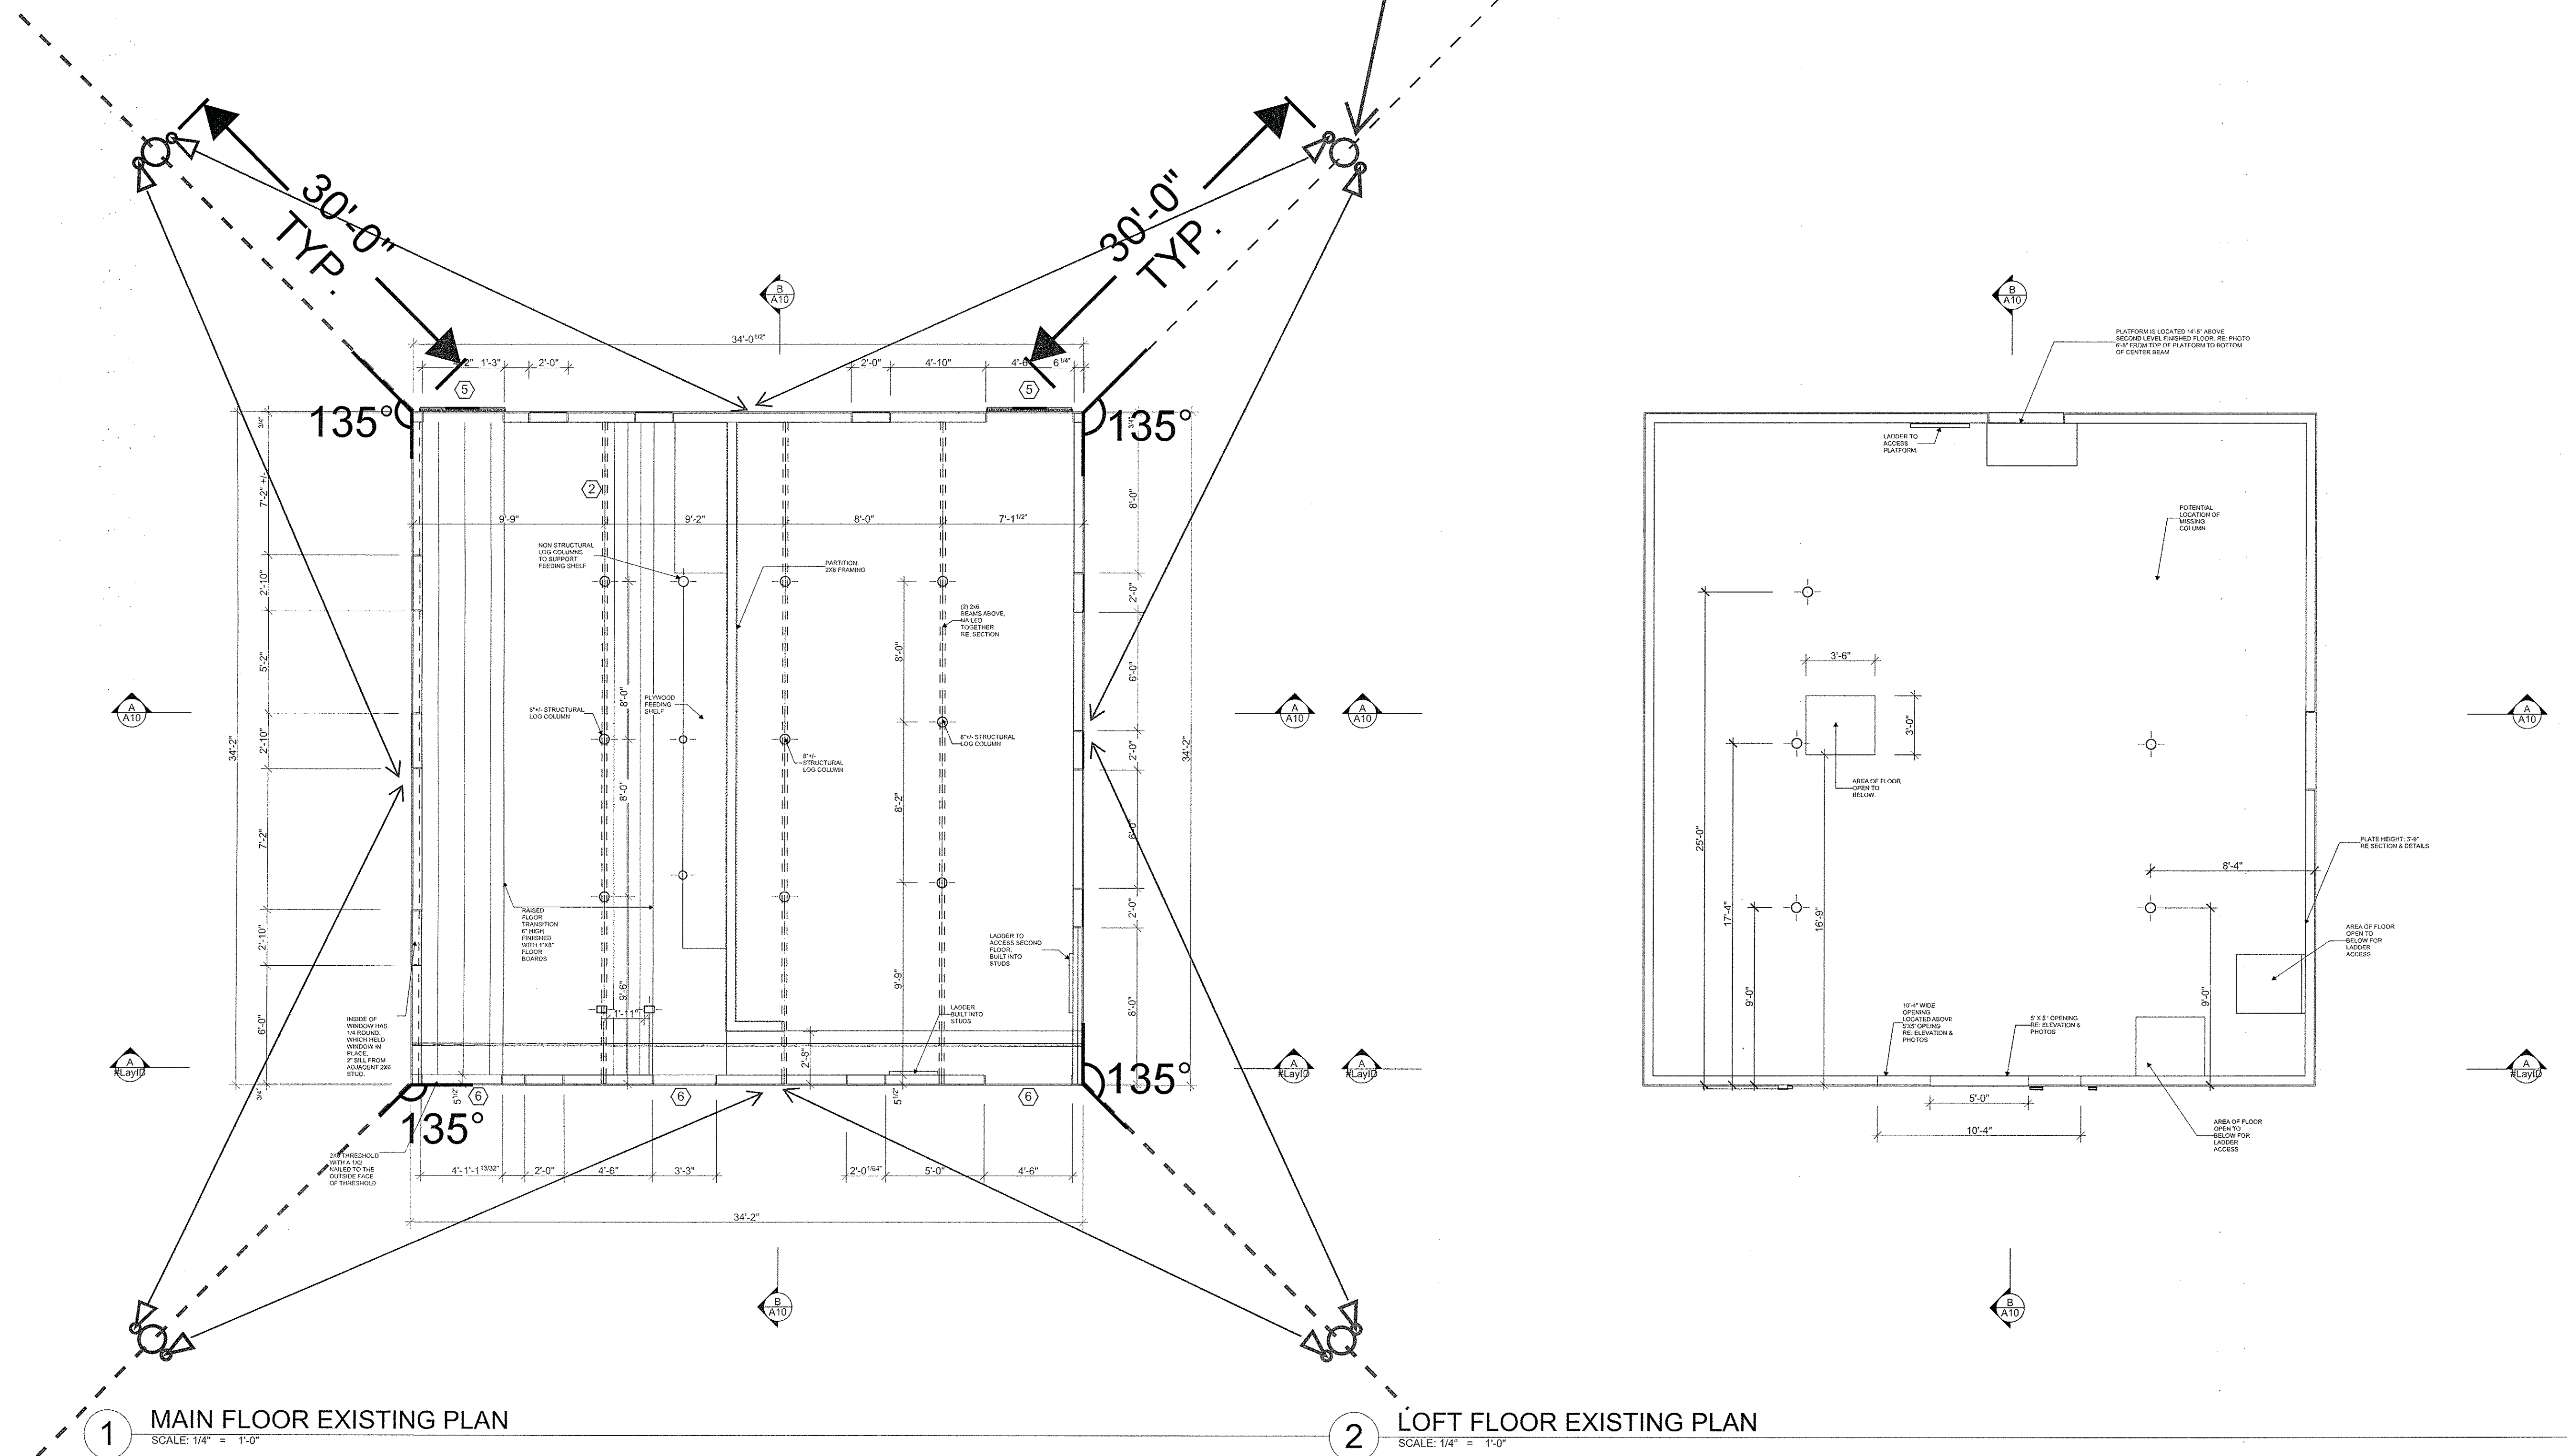

AN ICONIC ENTRY FOR THE  
**ARNOLD BARN INTERPRETIVE DISPLAY**  
2305 MT. WERNER CR.,  
STEAMBOAT SPRINGS, CO. 80487-9023

TITLE

LIGHTING  
PLAN

JOB NO. PROJECT NUMBER  
DRAWN BY LRR  
CHECKED BY JMK  
ISSUE DATE 9/12/2017

REVISIONS:  
DATE

DRAWING NUMBER  
LP 1



SKETCH: **SK-001**





PROJECT: **ARNOLD BARN**

DATE: **11/13/2017**

SCALE: **N.T.S.**

DRAWING BY: **BJW**

10 ft. tall pole with two (2)  
Type SA fixtures attached to  
each pole. Typical of four (4)  
poles.

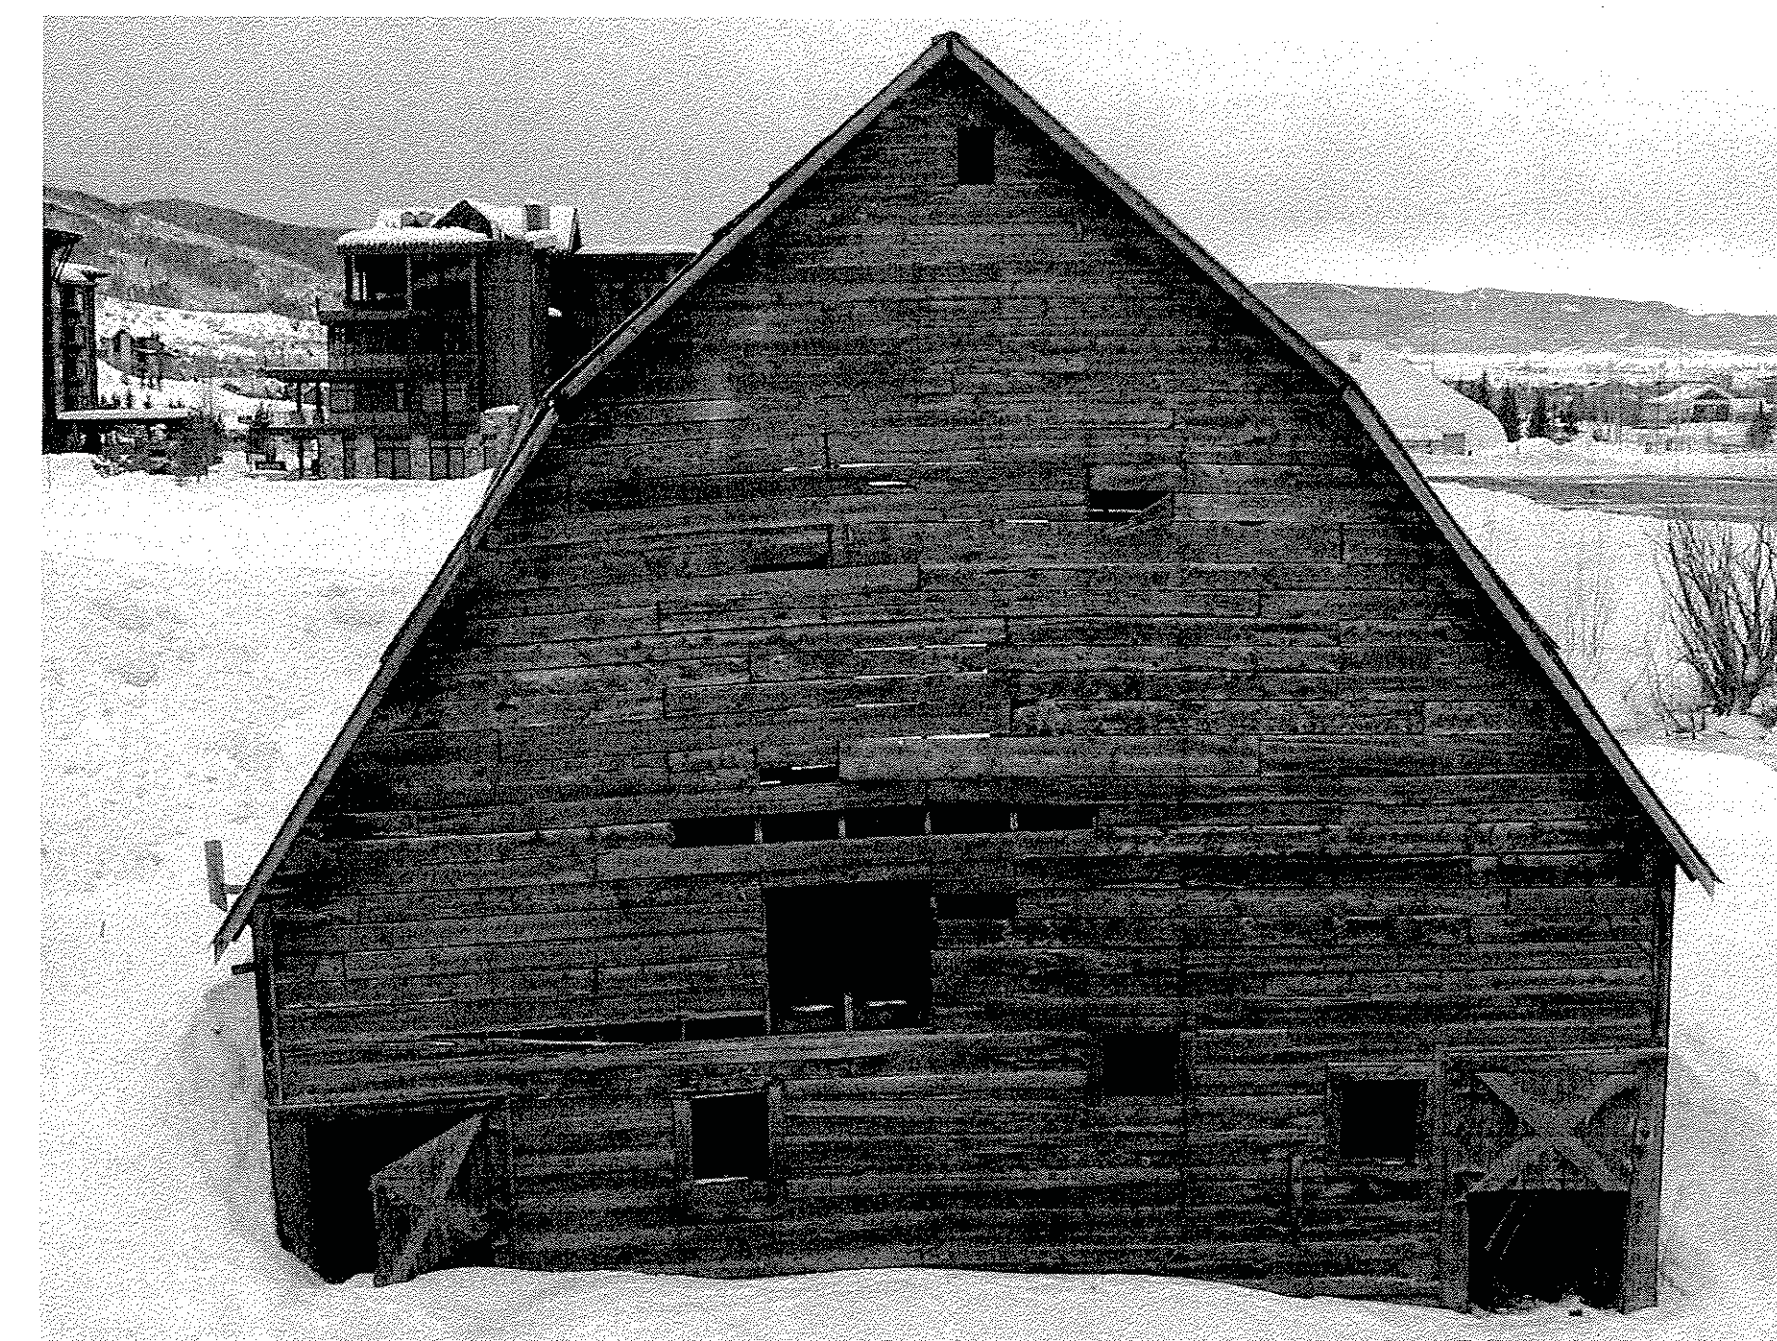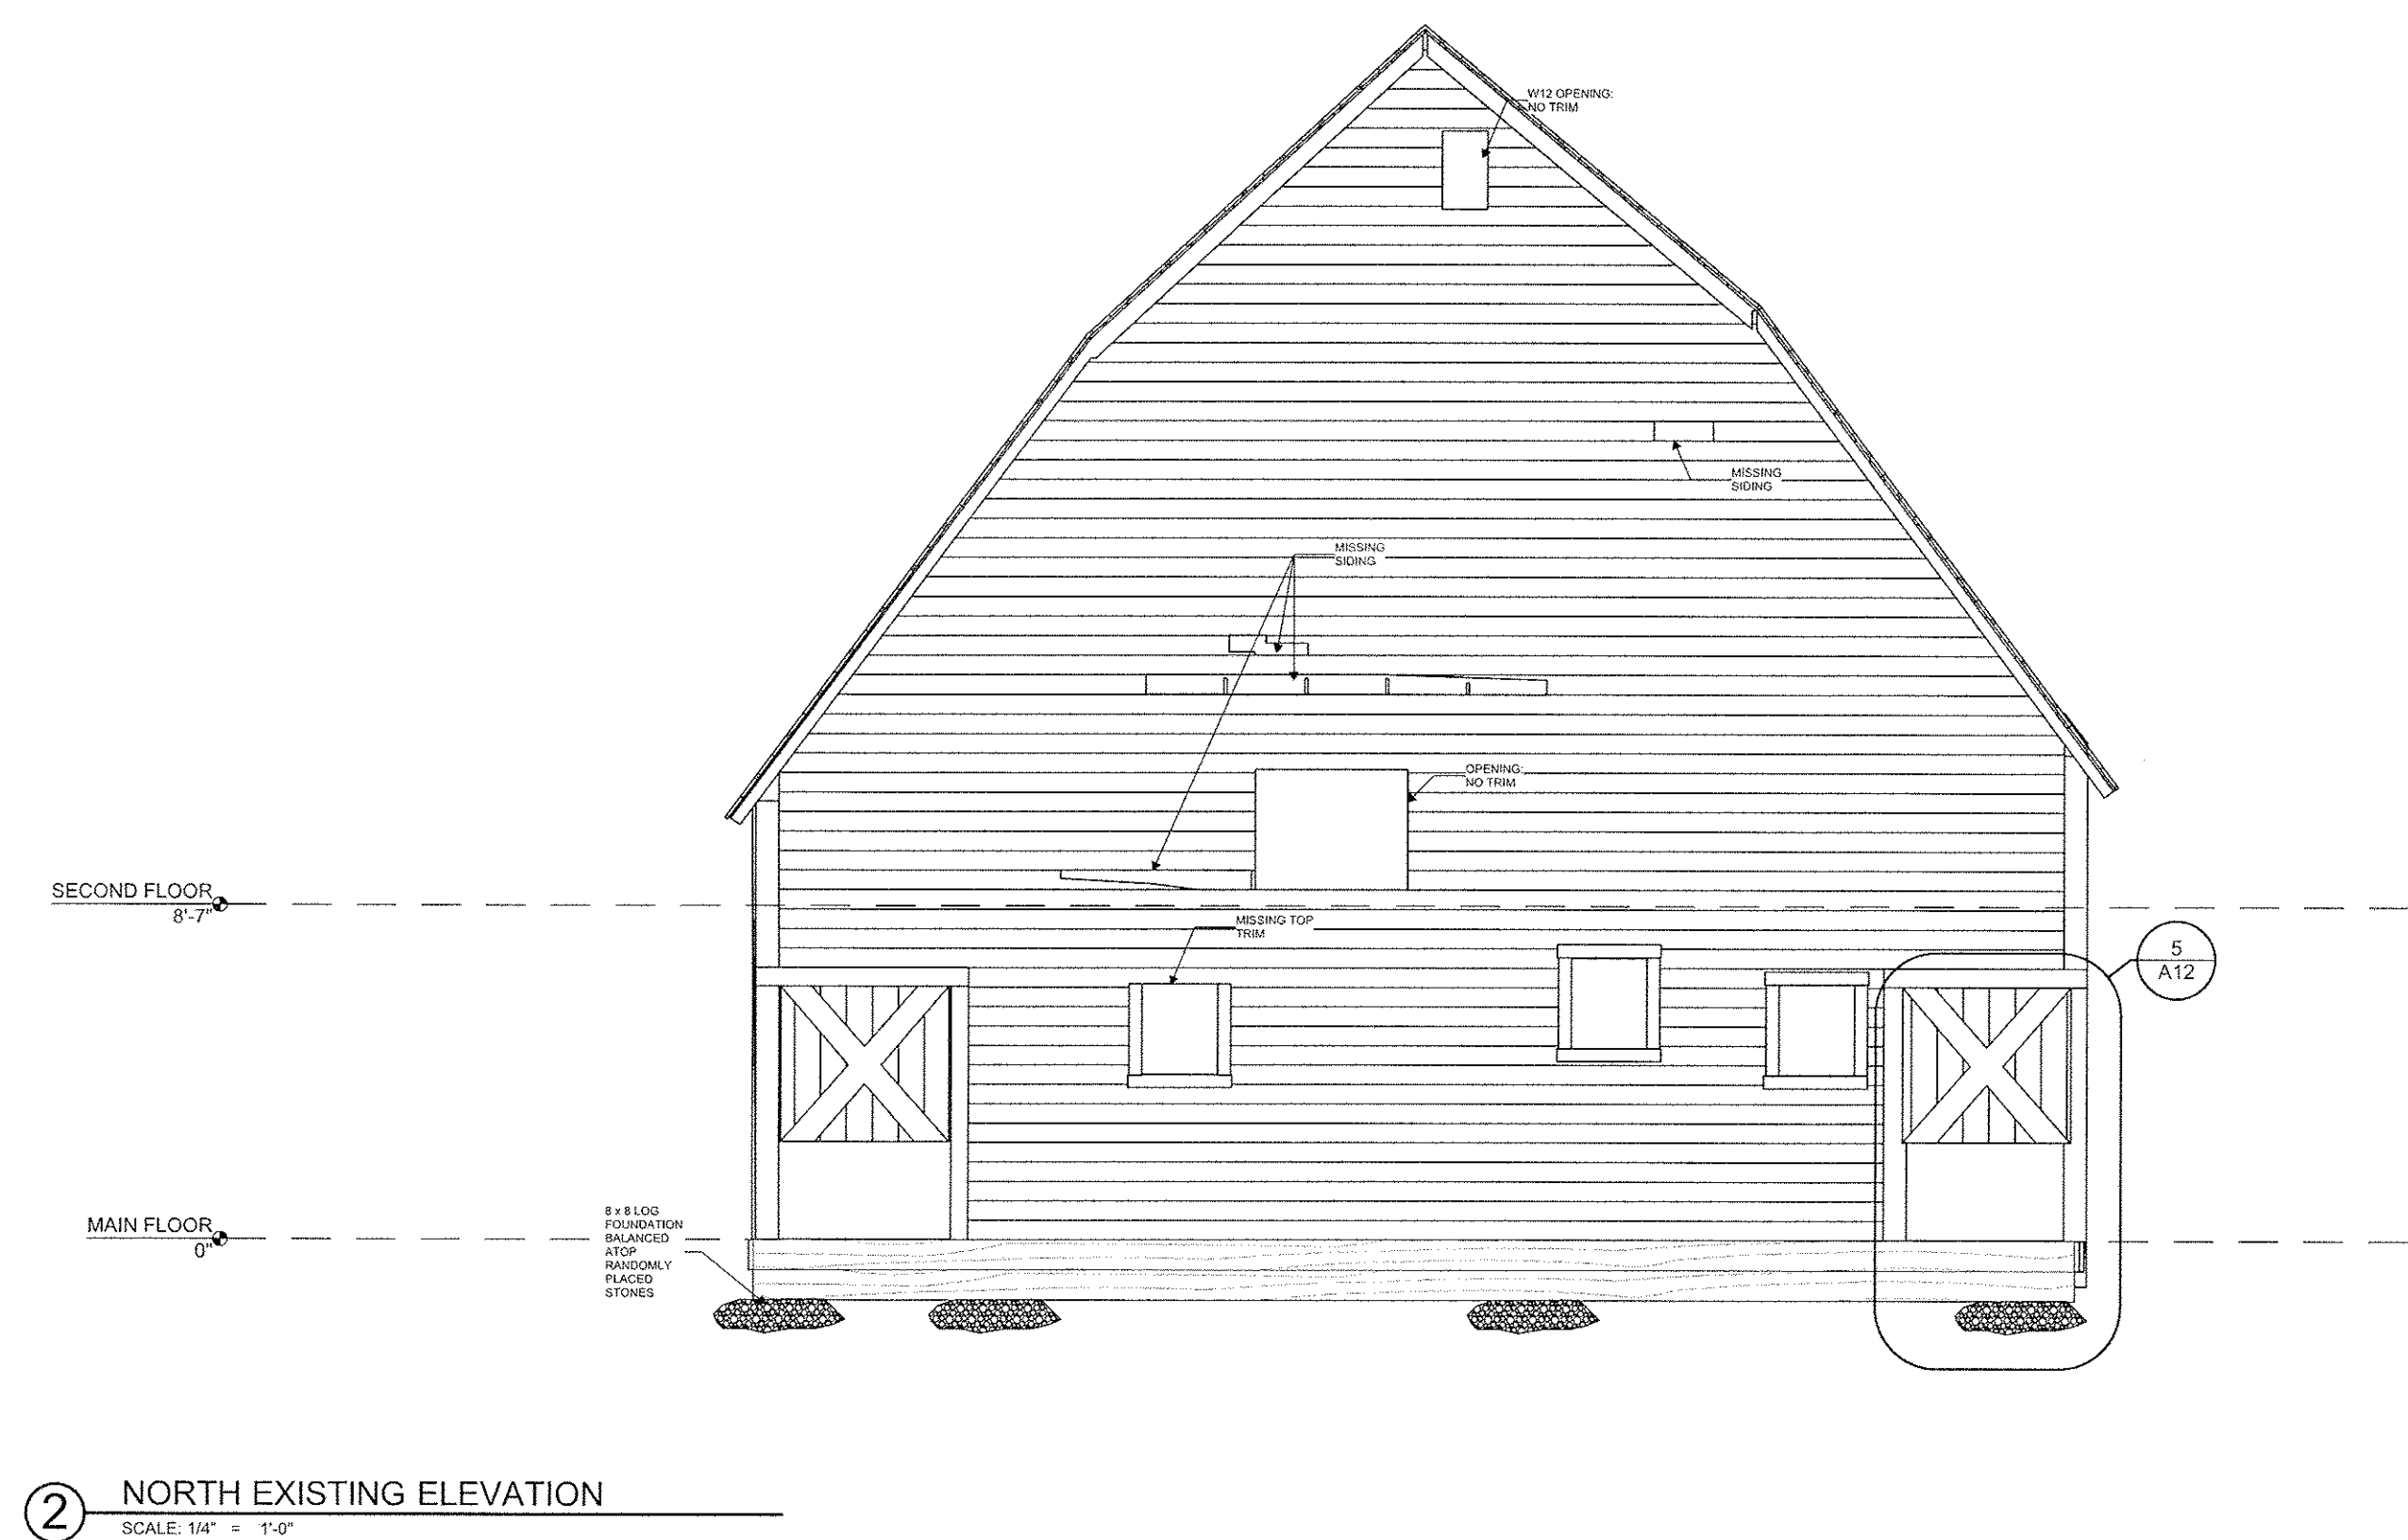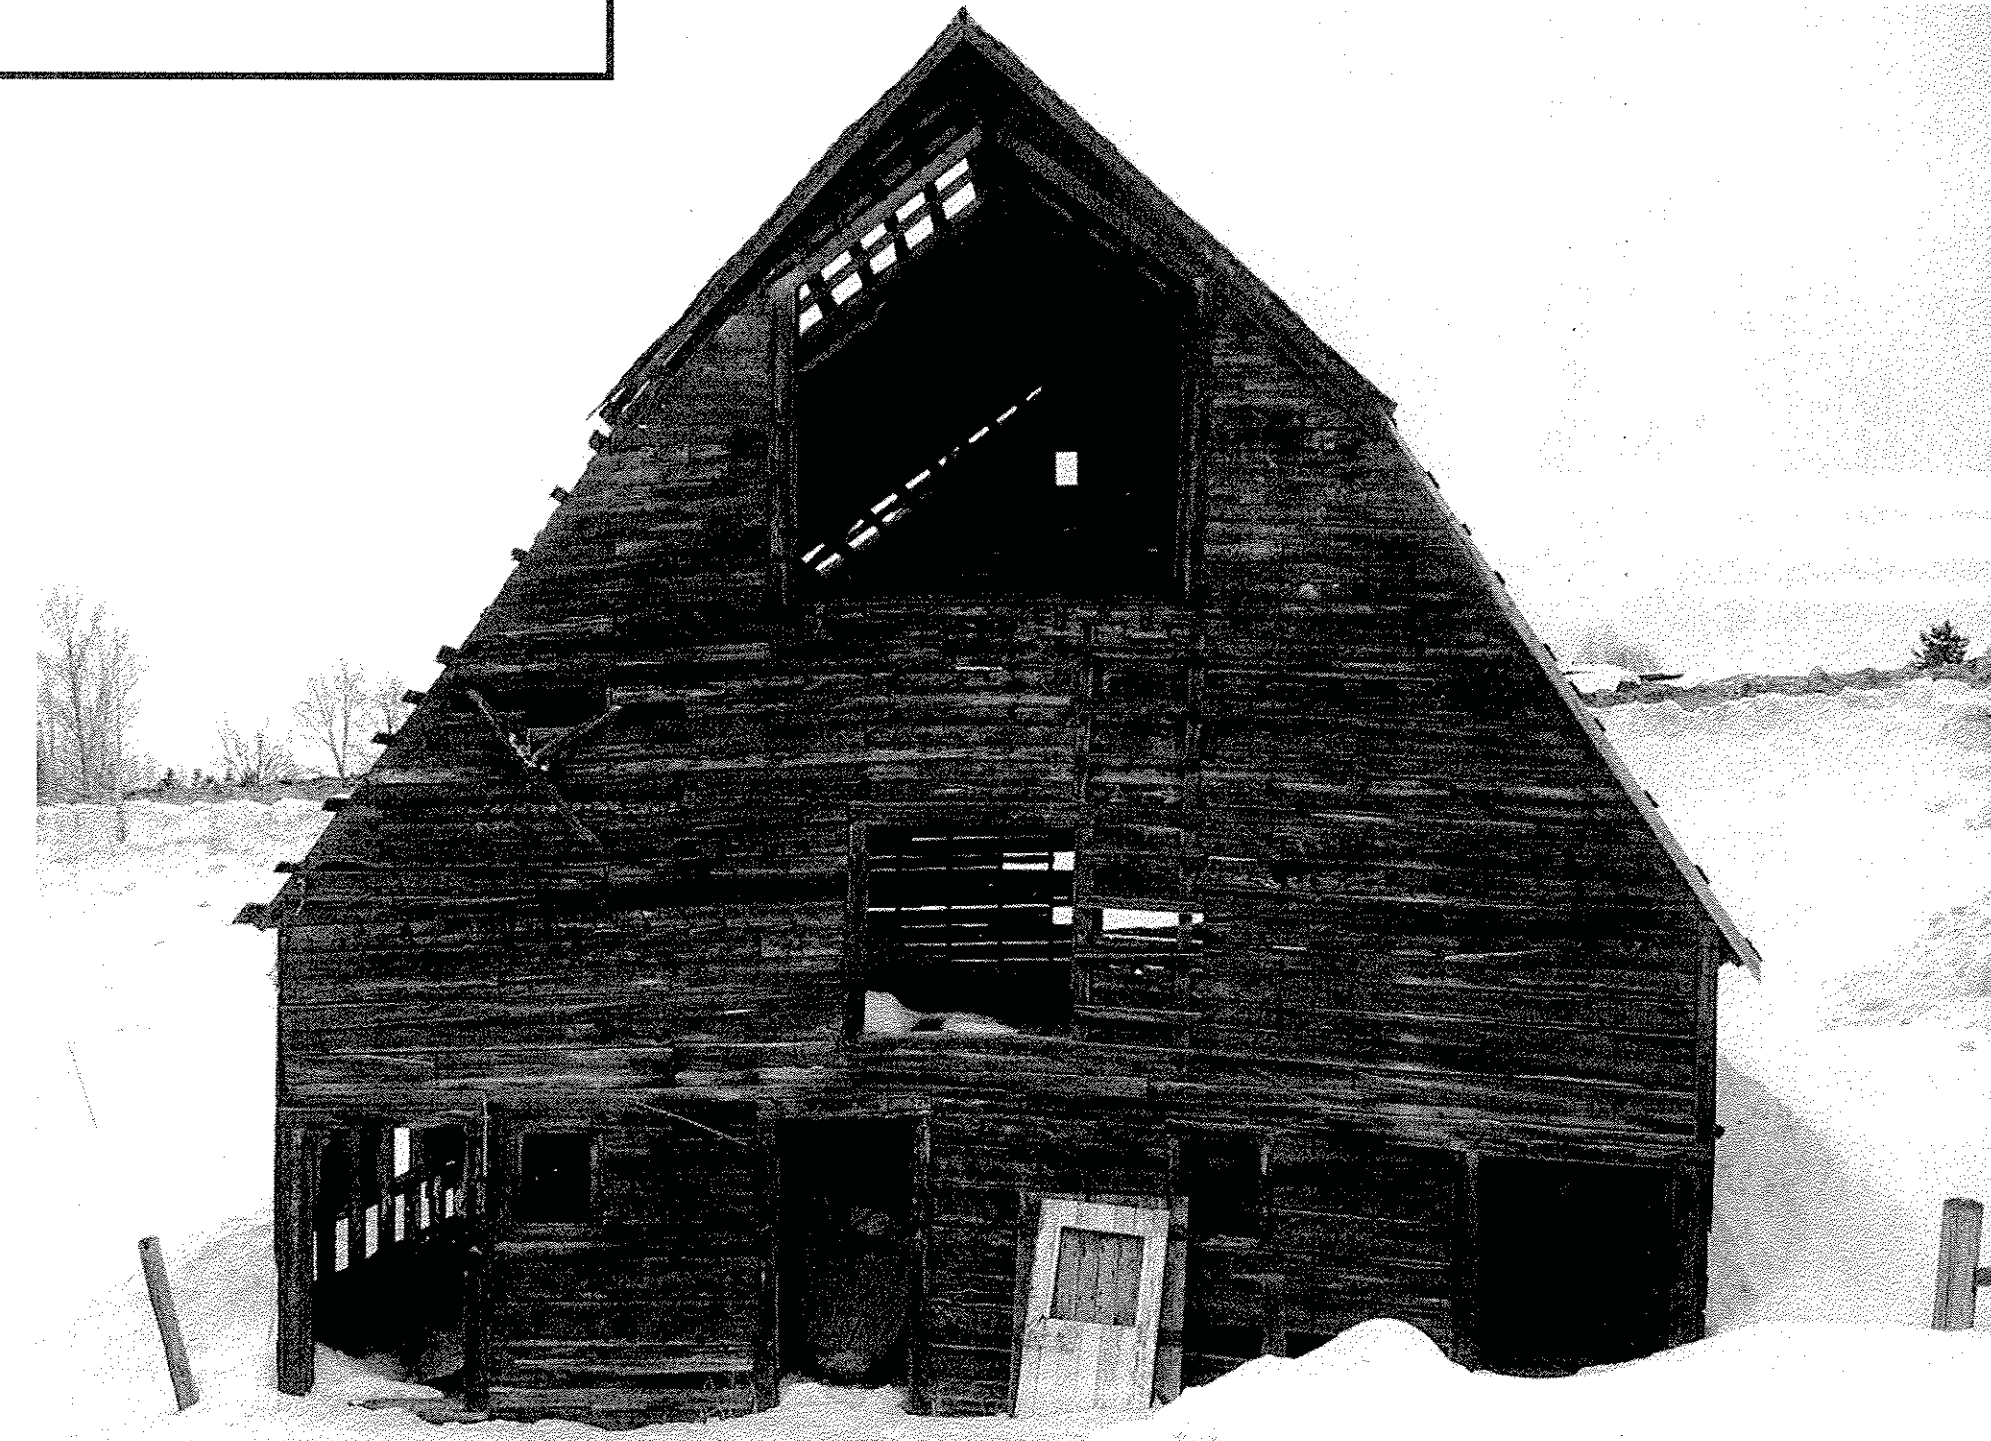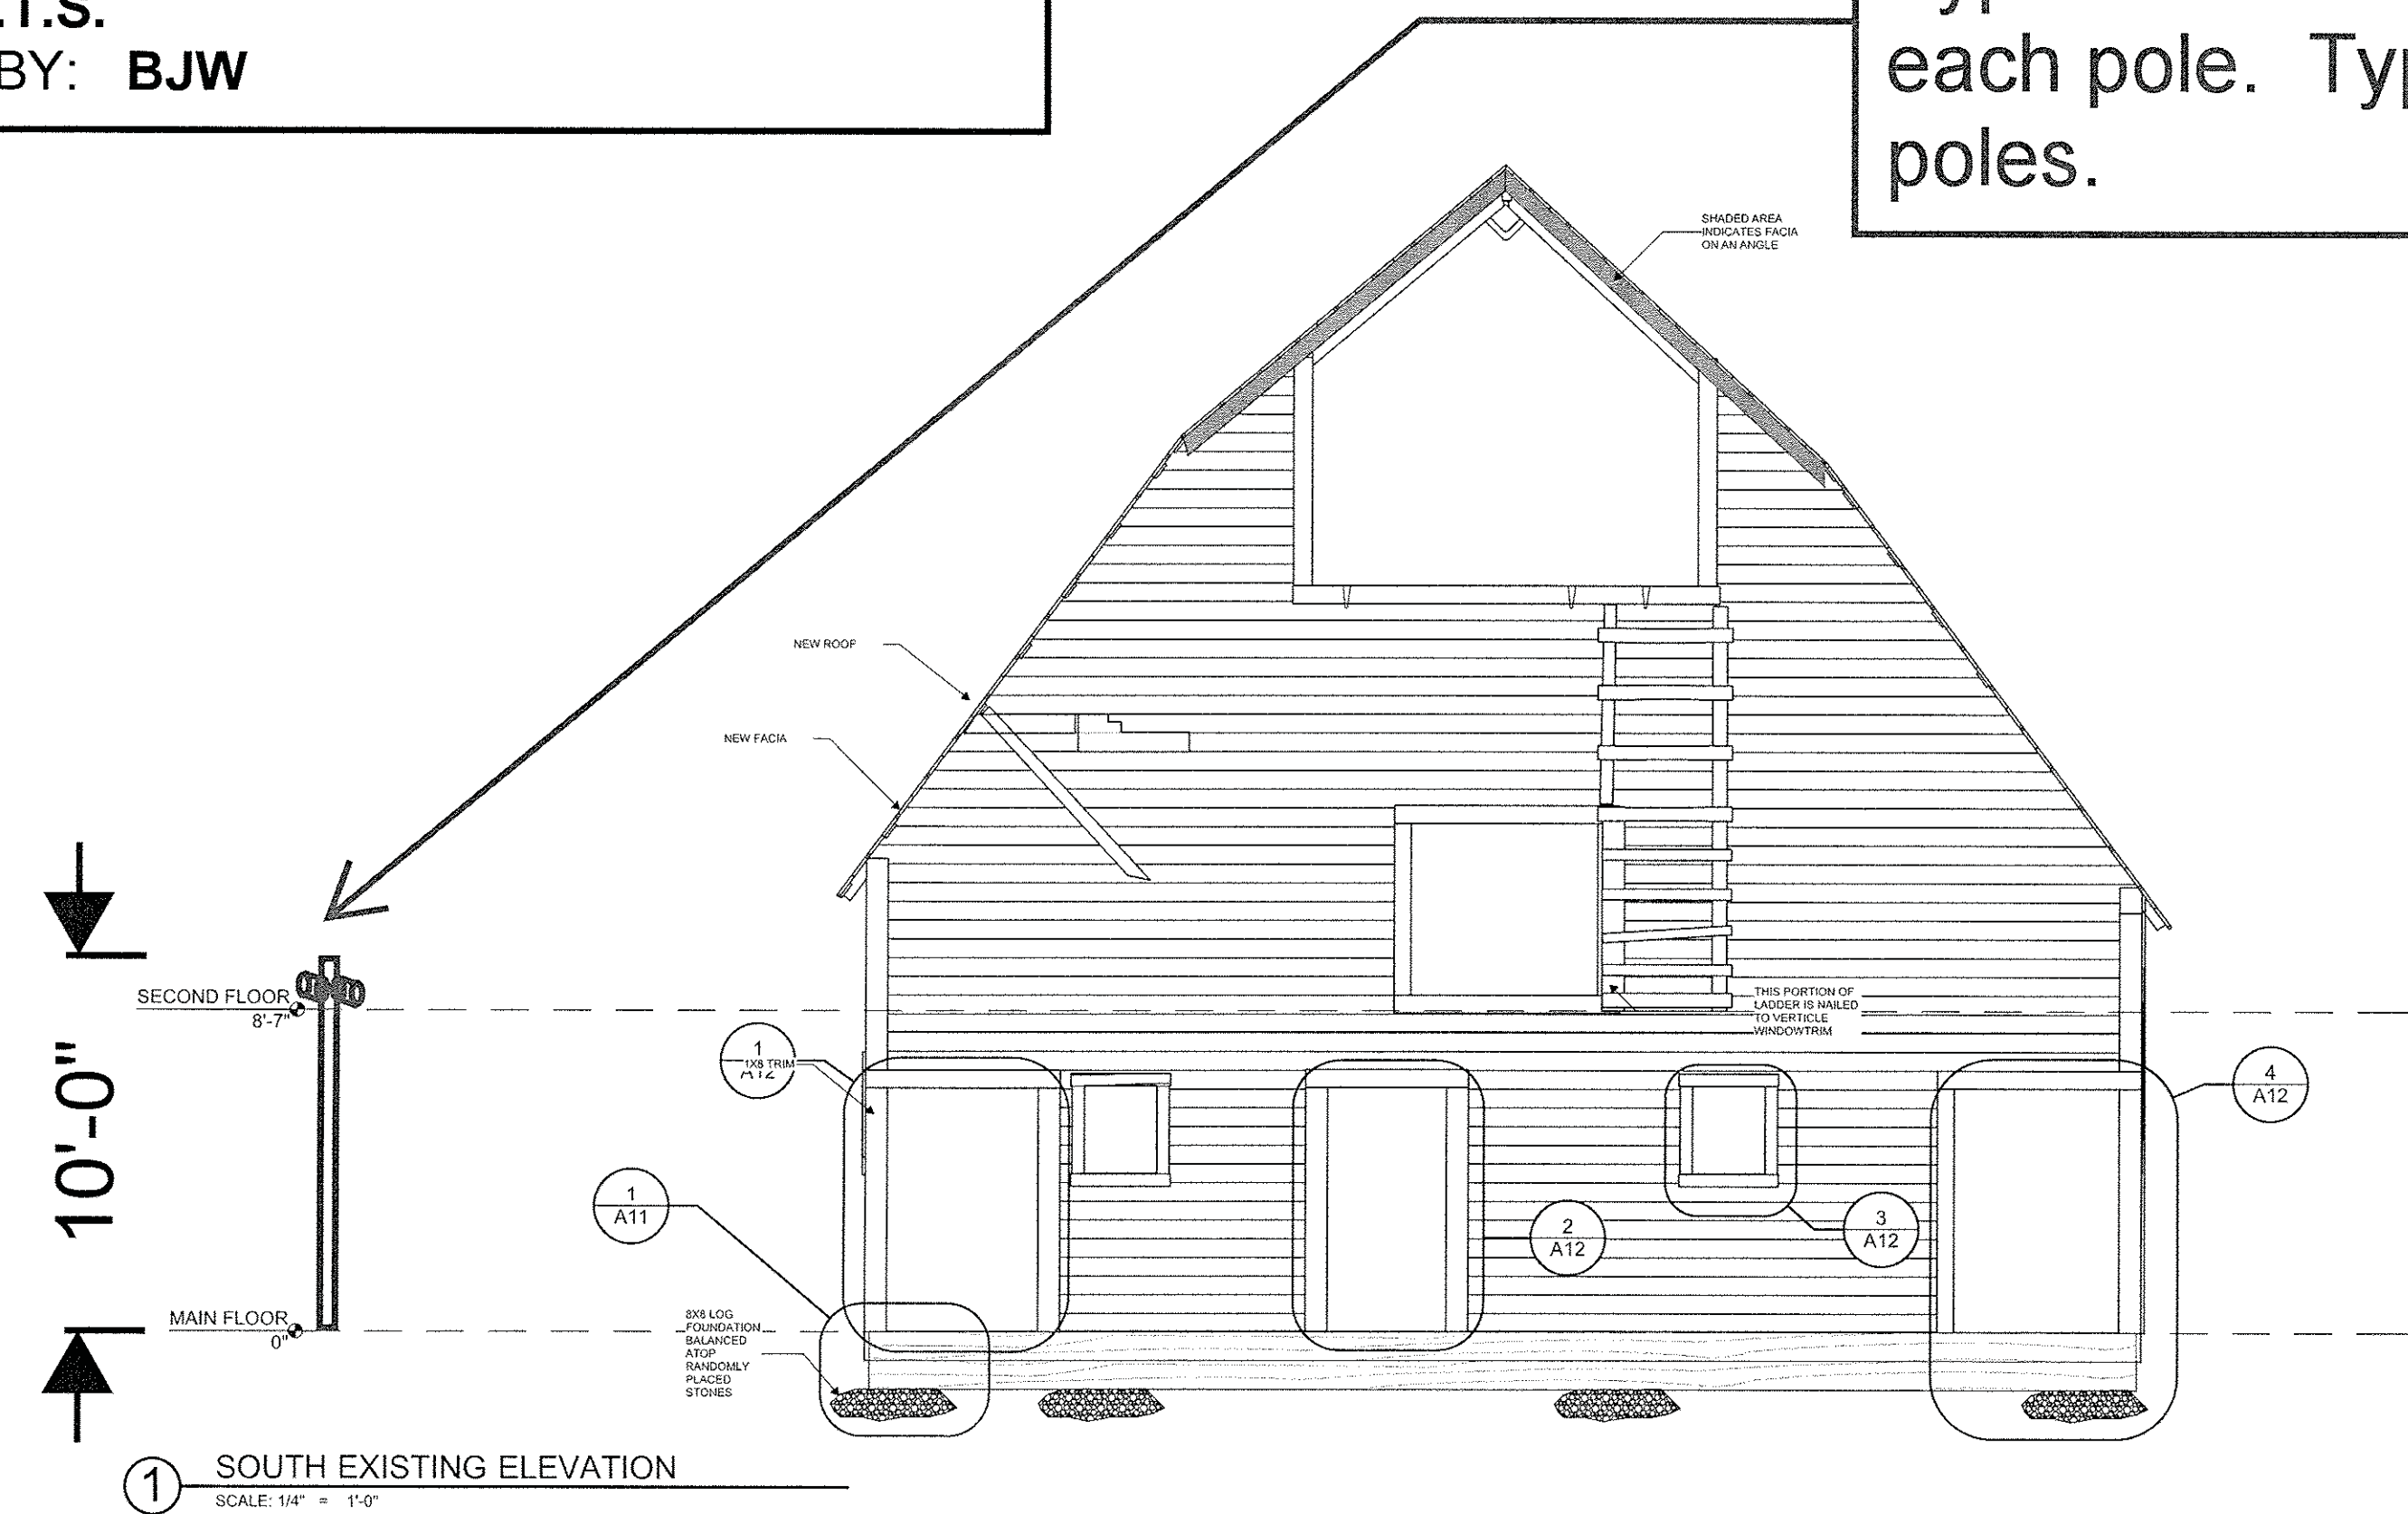

AN ICONIC ENTRY FOR THE  
ARNOLD BARN INTERPRETIVE DISPLAY  
2305 MT. WERNER CIR.  
STEAMBOAT SPRINGS, CO. 80487-9023

TITLE  
LIGHTING  
PLAN

JOB NO. PROJECT NUMBER  
DRAWN BY LRB  
CHECKED BY JMK  
ISSUE DATE 9/12/2017

REVISIONS:  
DATE

DRAWING NUMBER

LP 2





---

**Mountain Architecture ♦ Design Group, P.C.**

FROM: JAN M. KAMINSKI   
TO: RALPH WALTON  
CITY OF STEAMBOAT SPRINGS  
STEAMBOAT SPRINGS REDEVELOPMENT AUTHORITY  
CC: TOBY STAUFFER, STAFF PLANNER  
CITY OF STEAMBOAT SPRINGS  
PLANNING AND COMMUNITY DEVELOPMENT  
DATE: JUNE 25, 2018  
SUBJECT: URAAC ICONIC ENTRY – DPF-17-11

---

Condition 7 of the Development Plan/ Final Development Plan states" Project lighting shall be installed with timing technology and the applicant, Steamboat Springs Redevelopment Authority, ("SSRA") shall enter into a development agreement with the Steamboat Grand Resort Hotel Condominium Association, Inc., ("Grand HOA"), and Steamboat Ski & Resort Corporation, ("SSRC") to allow for future modification of the lighting schedule.

The exterior lighting for the Arnold Barn will either be controlled with a photocell on, timeclock off scenario, or astronomic timeclock. The photocell allows the fixtures to be turned on when ambient light levels drop below a certain level, and turned off at a predetermined time each night. The trigger illuminance level and off time can be programmed. An astronomic timeclock feature will turn the fixtures on and off if used. This would turn the fixtures on based around astronomic data for sunset times in Steamboat Springs, and off at a predetermined time.

Regarding dimming, these fixtures are dimmable with a 0-10V dimming protocol. If dimming is desired to tune the lighting levels, this could be done with an appropriately sized 0-10V dimmer mounted in a dry location on the property. This dimmer could be set once to the desired intensity, with the photocell and timeclock controlling on/off. These controls will be located in a secure place in the barn and installed concurrent with the site lighting.



## ET2800 Series

### 365/7-Day Astronomic Electronic Control

The ET2800 Series 365/7-Day Astronomic Electronic Controls feature independent 7-day programming for convenient flexibility when load switching differs daily. These electronic controls provide dependable and uncomplicated performance, plus to-the-minute programming for accurate load control and reduced energy costs. Up to 48 ON and 48 OFF events can be preset to automatically repeat. Each event can be applied to any combination of circuits and days. Each circuit can be independently scheduled for Astronomic (Dusk/Dawn) ON/OFF events. In addition, the programming can be easily disabled by changing to the manual operating mode. An additional mode of operation allows for ON/OFF buttons to be used as a 2-hour override, in compliance with current regulations. Manual circuit control buttons operate circuits independently, based on the mode of operation. 50 Holiday Block Scheduling exception dates are available to prevent regularly scheduled events, or allow for a holiday schedule. All models come equipped with a supercapacitor to provide time and date retention for a minimum of 100 hours, and do not require batteries. Each electronic control is housed in a lockable enclosure for vandalism and tampering protection.

### Features

- Program can be repeated on a weekly basis
- Multi-volt operation from 120-277 VAC 60 Hz, with auto-voltage detection
- To-the-minute programming for accurate load control and reduced energy costs
- Astronomic feature provides sunset ON and sunrise OFF settings, eliminating the need for separate photo control devices
- Astronomic programming can be combined with independent programs to provide a sunset ON and timed OFF program
- Relays with Zero-Cross Technology to extend the life of the control
- 2-circuit models are field configurable for: 2 independent outputs, DPST output, or 1 channel ON pulse/OFF pulse output
- 4-circuit models are field configurable for: 4 independent outputs, 2 DPST outputs, 1 DPST and 2 SPST, or 2 channel ON pulse/OFF pulse output
- USB port to easily copy and paste schedules from one control to another or simply backup schedule
- Automatic Daylight Saving Time (DST) ON/OFF adjustment
- Non-volatile EEPROM memory for lifetime programming protection
- Temporary override or permanent manual override available via control buttons
- Additional mode of operation allowing ON/OFF buttons to become a 2 hour override control
- 100-hour super capacitor eliminates battery dependency
- 50 Holiday Blocks with schedules

### Ratings

Enclosure Options:

Standard: Type 1 Gray Painted Steel  
CR: Type 3R Gray Metal Enclosure  
CP: Type 3R High-Impact UV Resistant Polycarbonate Plastic with Clear Cover

Knockouts:

Combination 1/2" & 3/4" Knockouts  
Bottom: 2, Left: 1, Right: 1, Back: 1

Input Voltage:

120, 208, 240, or 277 VAC 50/60 Hz

Project: \_\_\_\_\_

Location: \_\_\_\_\_

Product Type: \_\_\_\_\_

Contact/Phone: \_\_\_\_\_

Model #: \_\_\_\_\_



ET2825C



ET2845CP



ET2805CR





# ET2800 Series



Operating Temperature: -40° F to 155° F (-40° C to 68° C)

## ET2800 Models

### NO Contact Ratings:

Resistive: 30 A @ 120/240 VAC  
Resistive: 20 A @ 28 VDC  
Inductive: 30 A @ 120/240 VAC  
Tungsten: 5 A @ 120/240 VAC  
Magnetic Ballast: 20 A @ 277 VAC  
Electronic Ballast/LED: 10 A @ 120/277 VAC  
Motor: 1 HP @ 120 VAC  
Motor: 2 HP @ 240 VAC

### SPDT NO Contact Ratings:

Resistive: 20 A @ 120-240 VAC  
Resistive: 20 A @ 28 VDC  
Inductive: 20 A @ 120-240 VAC  
Magnetic Ballast: 20 A @ 120-277 VAC  
Electronic Ballast/LED: 10 A @ 120/277 VAC  
Motor: 1 HP @ 120 VAC  
Motor: 2 HP @ 240 VAC

### SPDT NC Contact Ratings:

Resistive: 10 A @ 120-240 VAC  
Resistive: 10 A @ 28 VDC  
Inductive: 10 A @ 120-240 VAC  
Magnetic Ballast: 3 A @ 120-277 VAC  
Motor: ¼ HP @ 120 VAC  
Motor: ½ HP @ 240 VAC

### Pulse Feature:

2-second pulse option for contactor and bell ringing applications  
(2 and 4-circuit models only)

### Auto DST:

Automatic adjustment for Daylight Saving Time

### Super Capacitor Backup:

A super capacitor to maintain date and time accuracy for a minimum of 100-hours if power is lost

### Wiring Terminals:

#18 to #10 AWG wire

### Minimum ON/OFF Time:

1 minute

### Maximum ON/OFF Time:

6 days, 23 hours, 59 minutes

### Warranty:

Limited 2 year

Model Number	Circuits	Switch	Volts AC	Rating	Enclosure	Shipping Weight
ET2805C	1	SPST	120-277 VAC	30 A	Indoor Metal	2.95 lbs.
ET2805CP	1	SPST	120-277 VAC	30 A	Indoor/Outdoor Plastic	2.25 lbs.
ET2805CR	1	SPST	120-277 VAC	30 A	Outdoor Metal	3.30 lbs.
ET2815C	1	SPDT	120-277 VAC	20 A	Indoor Metal	2.95 lbs.
ET2815CP	1	SPDT	120-277 VAC	20 A	Indoor/Outdoor Plastic	2.25 lbs.
ET2815CR	1	SPDT	120-277 VAC	20 A	Outdoor Metal	3.30 lbs.
ET2825C	2	SPST	120-277 VAC	30 A	Indoor Metal	2.95 lbs.
ET2825CP	2	SPST	120-277 VAC	30 A	Indoor/Outdoor Plastic	2.25 lbs.
ET2825CR	2	SPST	120-277 VAC	30 A	Outdoor Metal	3.30 lbs.
ET2845C	4	SPST	120-277 VAC	30 A	Indoor Metal	2.95 lbs.
ET2845CP	4	SPST	120-277 VAC	30 A	Indoor/Outdoor Plastic	2.25 lbs.
ET2845CR	4	SPST	120-277 VAC	30 A	Outdoor Metal	3.30 lbs.

All 2 or 4-circuit models can be wired to DPST

2-circuit models = 2 x SPST or 1 x DPST

4-circuit models = 4 x SPST, 2 x DPST, or 1 x DPST and 2 x SPST



## Specification

The 365/7-Day Astronomic Electronic Control shall be capable of permitting up to 48 ON/48 OFF events. In addition, the electronic control shall include selectable Astronomic (dusk/dawn) settings for each day and circuit to allow load switching at sunset and/or sunrise without a photo control device. The electronic control shall provide a minimum ON or OFF time of 1 minute. The electronic control to be powered by \_\_\_\_ (120)(208)(240)(277) VAC, \_\_\_\_ 60 Hz power supply. The electronic control mechanism features a snap-in design to provide easy mechanism removal for mounting the enclosure. The electronic control enclosure shall be a \_\_\_\_ (Type 1 Steel)(Type 3R Steel)(Type 3R Plastic) lockable enclosure that shall be painted with an electrostatic process to eliminate the potential for corrosion. The electronic control shall provide clear terminal identification on a transparent non-curling terminal insulator. The electronic control shall have a USB port to provide for schedule backup and transfer capabilities. Switch configuration shall be \_\_\_\_ (SPST)(DPST)(SPDT) with a UL or CSA listed switch rating of:

### If SPST:

- Resistive: 30 A @ 120/240 VAC
- Resistive: 20 A @ 28 VDC
- Inductive: 30 A @ 120/240 VAC
- Tungsten: 5 A @ 120/240 VAC
- Ballast: 20 A @ 120-277 VAC
- Electronic Ballast: 10 A @ 120/277 VAC
- Motor: 1 HP @ 120 VAC
- Motor: 2 HP @ 240 VAC


### If SPDT:

- Resistive: 20 A @ 120/240 VAC
- Resistive: 20 A @ 28 VDC
- Inductive: 20 A @ 120/240 VAC
- Magnetic Ballast: 20 A @ 120/240 VAC
- Electronic Ballast: 10 A @ 120/277 VAC
- Motor: 1 HP @ 120 VAC
- Motor: 2 HP @ 240 VAC


The electronic control shall be UL or CSA listed under UL category 916 Energy Management Equipment and shall be Intermatic model \_\_\_\_ (See Model Numbers Listed).

## Diagrams


### All Units

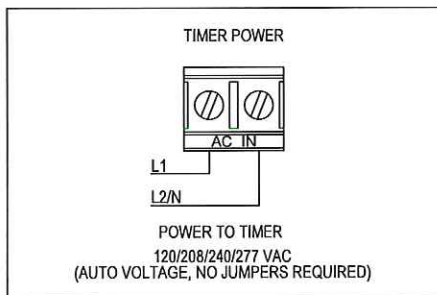

### 1 Circuit SPST

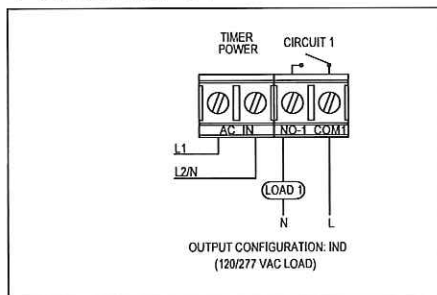

### 1 Circuit SPDT




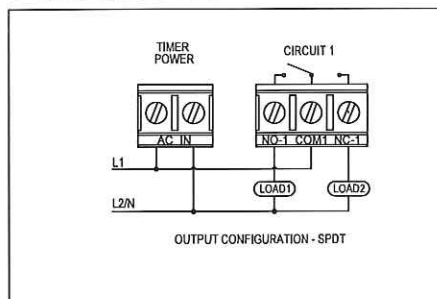




# ET2800 Series



## 2 Circuit SPST

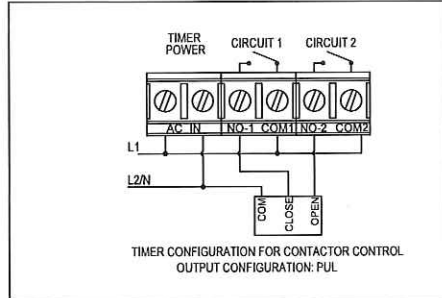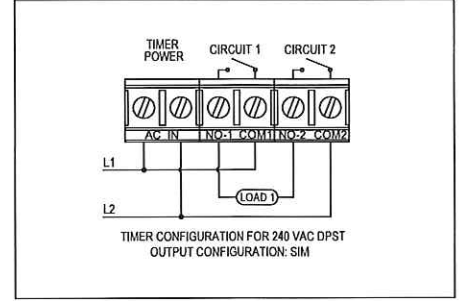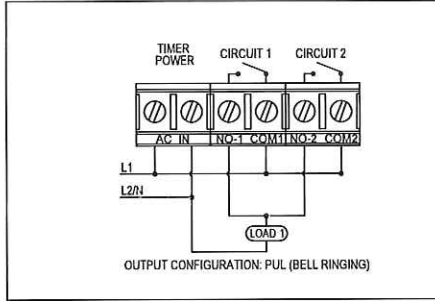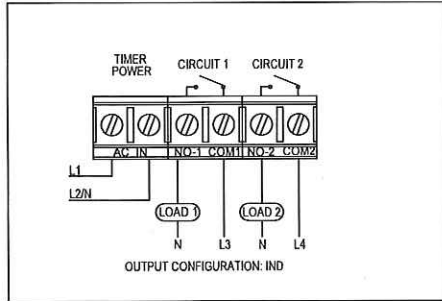








There are many different ways to set the relays on the ET2800 Series Time Switch. The four relays can be used individually or in pairs. Refer to the table below for a complete list of ways to set the relays and the illustrations for some of the common wiring installations

IND/IND
IND/SIM
IND/PUL

Note:  
IND= Independent SIM= Simultaneous

PUL= Pulse

## 4 Circuit SPST

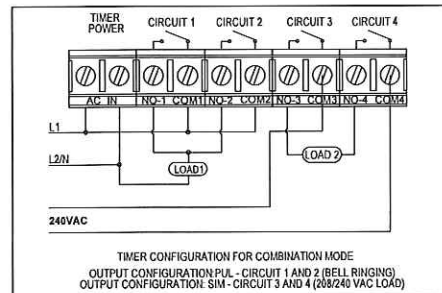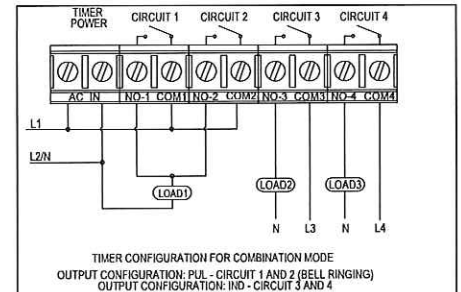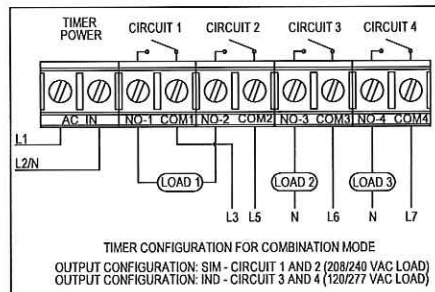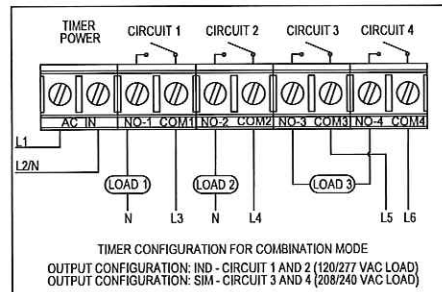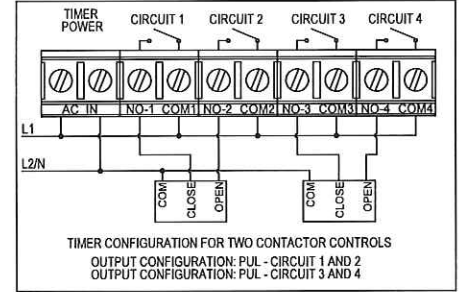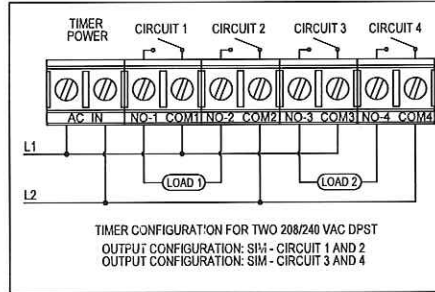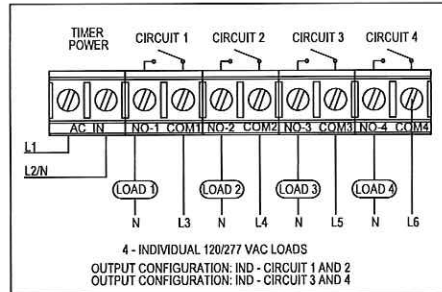

There are many different ways to set the relays on the ET2800 Series Time Switch. The four relays can be used individually or in pairs of two. Refer to the table below for a complete list of ways to set the relays and the illustrations for some of the common wiring installations

IND/IND	SIM/IND	PUL/IND
IND/SIM	SIM/SIM	PUL/SIM
IND/PUL	SIM/PUL	PUL/PUL

Note:  
IND= Independent SIM= Simultaneous

PUL= Pulse




## Diva 0–10 V Controls

Controls for 0–10 V LED drivers and fluorescent ballasts.

### Features

- Large paddle switch with a captive linear-slide control for a standard designer-opening wallplate.
- 0–10 V control link controls third party fixtures.
- DVSTV- wires as single pole or 3-way, 120–277 V~ switch.
- DVTV- wires as a 24 V= switch. A power pack is required to switch 120–277 V~ and 347 V~.
- Patented switching technology extends product lifetime.
- Coordinating Claro and Satin Colors wallplates<sup>1</sup> (available separately).
- High-end and low-end trim user adjustable for optimal performance.

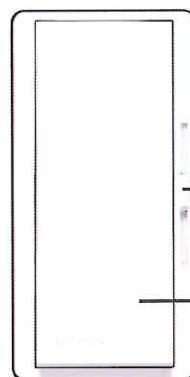

Diva 0–10 V Control

### Model Numbers

Model Number	Operating Voltage	Wiring	Load Switching Capacity	0–10 V Sink Capacity
DVSTV-XX <sup>3</sup>	120–277 V~	Single pole/3-way <sup>2</sup>	8 A	50 mA
DVSTV-453PH-WH <sup>1</sup> DVSTV-453PH-WH-C <sup>1,6</sup>	120–277 V~	Single pole/3-way <sup>2</sup>	450 W 3.75 A (120 V~) 1.62 A (277 V~)	50 mA
DVTV-XX <sup>3</sup> DVSTV-YY <sup>4</sup>	24 V=	Single pole only	0 A <sup>5</sup>	30 mA

<sup>1</sup> DVSTV-453PH-WH and DVSTV-453PH-WH-C available in white gloss only.

<sup>2</sup> For 3-way switching, use Claro switches or other mechanical switches.

<sup>3</sup> "XX" in the model number represents gloss finish color code. See **Standard Colors and Finishes** on Page 4.

<sup>4</sup> "YY" in the model number represents satin finish color code. See **Standard Colors and Finishes** on Page 4.

<sup>5</sup> A Lutron power pack (PP-DV or PP-347H) is required for switching ballasts and drivers. For Lutron power pack specification, please see Lutron P/N 369544.

<sup>6</sup> Clamshell packaged product for Canada.

Job Name:	Model Numbers:	
<input type="text"/>	<input type="text"/>	<input type="text"/>
Job Number:	<input type="text"/>	<input type="text"/>



## Specifications

### DVSTV- Models

#### Regulatory Approvals

- cULus Listed
- NOM

#### Power

##### Operating Voltage

120–277 V~ 50/60 Hz

##### Output Ratings

- Switch rating of 8 A.
- 0–10 V control link for 50 mA maximum output (sink only).

##### 0–10 V Control Link

- 0–10 V control link is Class 1.
- Controls up to 25 ballasts or drivers (IEC 60929 Annex E.2 requires the ballast/driver to limit the current draw to 2.0 mA maximum).

#### Performance

- Power pack cannot be used with DVSTV- models.
- Works with all ballasts and drivers that provide a current source compliant to IEC 60629 Annex E.2, and whose inrush current does not exceed NEMA410 standards for electronic ballast/driver loads of 8 A steady state current.
- Adjustable high-end and low-end trim for optimal dimming performance.
- Power failure memory: should power be interrupted, the control will return to its previously set level prior to the interruption when power is restored.
- Captive linear slider.
- Precise color matching.

#### Environment

- For indoor use only.
- Ambient operating temperature: 32 °F to 104 °F (0 °C to 40 °C), 0% to 90% humidity, non-condensing.

#### Application Requirements

- No derating required if ganged.
- Night light not available.
- Always consult local wiring codes.

#### Warranty

- [www.lutron.com/TechnicalDocumentLibrary/369-119\\_Wallbox\\_Warranty.pdf](http://www.lutron.com/TechnicalDocumentLibrary/369-119_Wallbox_Warranty.pdf)

Job Name: <input type="text"/>	Model Numbers: <input type="text"/>	
Job Number: <input type="text"/>	<input type="text"/>	<input type="text"/>



**Specifications (continued)****DVSTV-453PH-WH Model****Regulatory Approvals**

- cULus Listed
- NOM

**Power****Operating Voltage**

120–277 V~ 50/60 Hz

**Output Ratings**

- Switch rating of 450 W.
- 0–10 V control link for 50 mA maximum output (sink only).

**0–10 V Control Link**

- 0–10 V control link is Class 1.
- Controls up to 25 ballasts or drivers (IEC 60929 Annex E.2 requires the ballast/driver to limit the current draw to 2.0 mA maximum).

**Performance**

- Power pack cannot be used with DVSTV- models.
- Works with all ballasts and drivers that provide a current source compliant to IEC 60629 Annex E.2, and whose inrush current does not exceed NEMA410 standards for electronic ballast/driver loads of 8 A steady state current.
- Adjustable high-end and low-end trim for optimal dimming performance.
- Power failure memory: should power be interrupted, the control will return to its previously set level prior to the interruption when power is restored.
- Captive linear slider.
- Precise color matching.

**Environment**

- For indoor use only.
- Ambient operating temperature: 32 °F to 104 °F (0 °C to 40 °C), 0% to 90% humidity, non-condensing.

**Application Requirements**

- No derating required if ganged.
- Night light not available.
- Always consult local wiring codes.

**Warranty**

- [www.lutron.com/TechnicalDocumentLibrary/369-119\\_Wallbox\\_Warranty.pdf](http://www.lutron.com/TechnicalDocumentLibrary/369-119_Wallbox_Warranty.pdf)

Job Name:	<input type="text"/>		
Job Number:	<input type="text"/>	Model Numbers:	<input type="text"/>
	<input type="text"/>		<input type="text"/>



**Specifications (continued)****DVTV- and DVSCTV- Models****Power****Operating Voltage**24 V $\equiv$  100 mA**Output Ratings**

- Power pack required for load switching. Power pack is rated for 16 A.
- 30 mA maximum output (sink only).

**0–10 V Control Link**

- 0–10 V control is Class 2.
- Controls up to 15 ballasts or drivers (IEC 60929 Annex E.2 requires the ballast/driver to limit the current draw to 2.0 mA maximum).

**Performance**

- For 120-277 V $\sim$  installations switching more than 8 A, use DVTV- with Lutron power pack (PP-DV). See Lutron P/N 369544.
- For 347 V $\sim$  installations, use DVTV- with Lutron power pack (PP-347H) See Lutron P/N 369544.
- Works with all ballasts and drivers that provide a current source compliant to IEC 60629 Annex E.2.
- Adjustable high-end and low-end trim for optimal dimming performance.
- Power failure memory: should power be interrupted, the 0–10 V $\equiv$  signal will return to its previously set level prior to the interruption when power is restored.
- Captive linear slider.
- Precise color matching.

**Environment**

- For indoor use only.
- Ambient operating temperature: 32 °F to 104 °F (0 °C to 40 °C), 0% to 90% humidity, non-condensing.

**Application Requirements**

- No derating required if ganged.
- Night light not available.
- Always consult local wiring codes.


**Warranty**

- [www.lutron.com/TechnicalDocumentLibrary/369-119\\_Wallbox\\_Warranty.pdf](http://www.lutron.com/TechnicalDocumentLibrary/369-119_Wallbox_Warranty.pdf)

Job Name:	Model Numbers:	
<input type="text"/>	<input type="text"/>	<input type="text"/>
Job Number:	<input type="text"/>	<input type="text"/>



## Dimensions

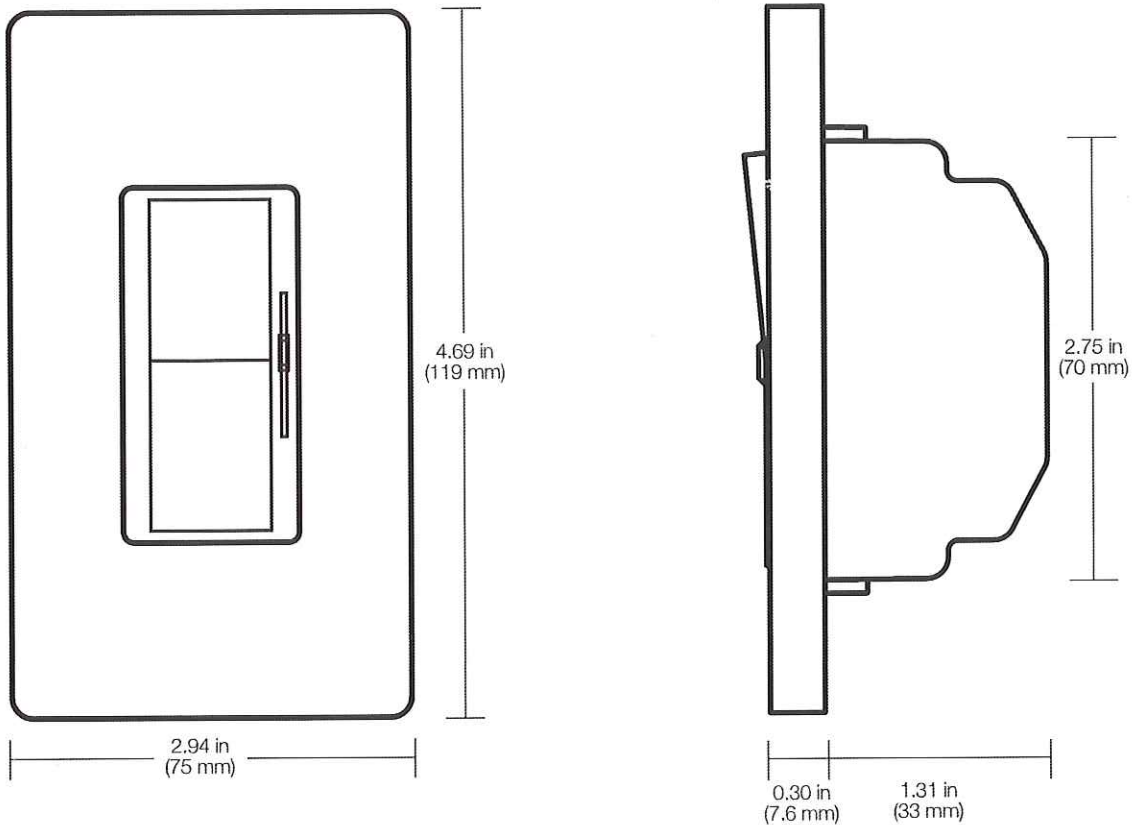

## Standard Colors and Finishes

### Gloss Finishes\*

Add color suffix to model #

**Example: DVSTV-WH**

WH	White
IV	Ivory
AL	Almond
LA	Light Almond
GR	Gray
BR	Brown
BL	Black

### Satin Colors\*

Add color suffix to model #

**Example: DVSCTV-SW**

HT	Hot	MN	Midnight
MR	Merlot	TC	Terracotta
PL	Plum	SI	Sienna
TQ	Turquoise	GB	Green Briar
SG	Sea Glass	BG	Bluestone
TP	Taupe	MS	Mocha Stone
ES	Eggshell	GS	Goldstone
BI	Biscuit	DS	Desert Stone
SW	Snow	ST	Stone
PD	Palladium	LS	Limestone

\* DVSTV-453PH-WH and DVSTV-453PH-WH-C available in white gloss only.


Job Name:	Model Numbers:	
<input type="text"/>	<input type="text"/>	<input type="text"/>
Job Number:	<input type="text"/>	<input type="text"/>



# High-End and Low-End Adjustments

## DVSTV- Models


### Bottom View

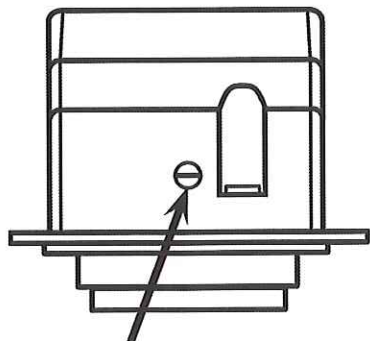

Maximum Light Level  
(High-End) Trim

## All Models


### Front View

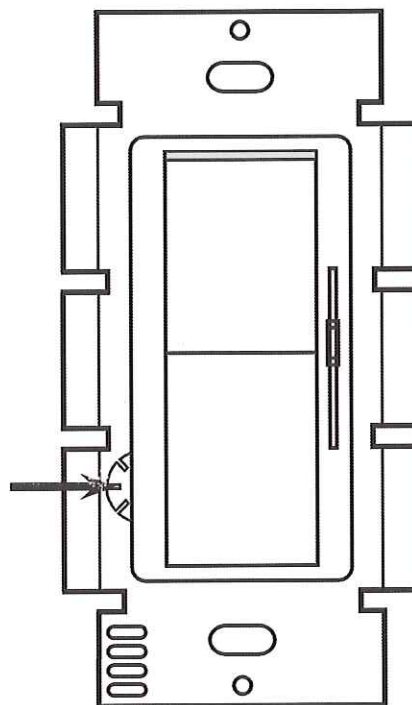

Minimum Light Level  
(Low-End) Trim

## DVTV- and DVSCTV- Models

### Side View

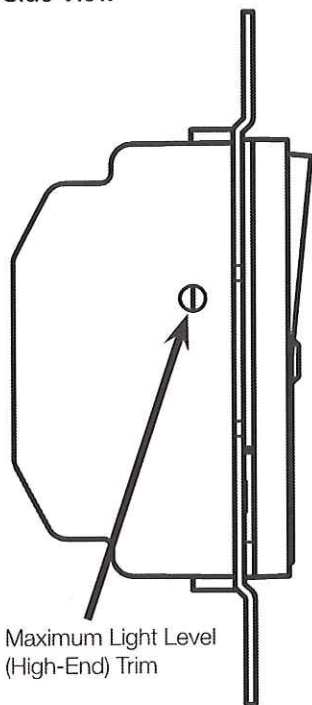

Maximum Light Level  
(High-End) Trim


Job Name:	Model Numbers:	
<input type="text"/>	<input type="text"/>	<input type="text"/>
Job Number:	<input type="text"/>	<input type="text"/>




## Wiring Diagrams

### DVSTV-

#### Single Pole Wiring

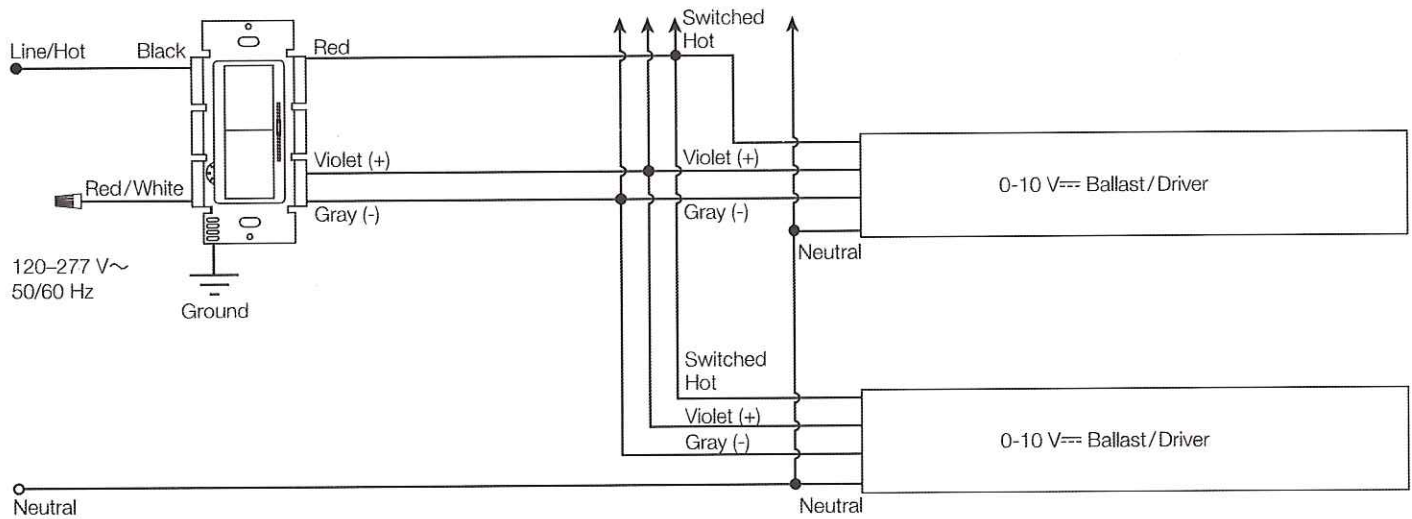

#### 3-Way Wiring

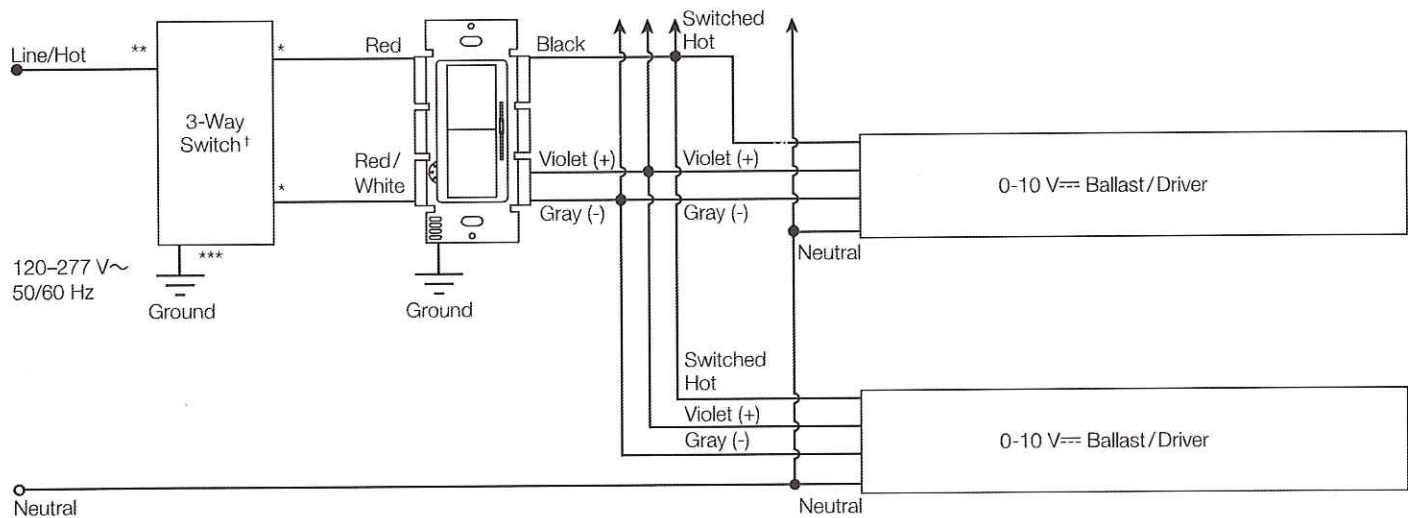

\* Copper/Black screw terminal

\*\* Brass/Gold screw terminal

\*\*\* Green screw terminal

† For proper wiring, please refer to installation instructions for 3-way switch.


Job Name:	Model Numbers:	
<input type="text"/>	<input type="text"/>	<input type="text"/>
Job Number:	<input type="text"/>	<input type="text"/>



## Wiring Diagrams (continued)

## DVSTV- (continued)

## 4-Way Wiring

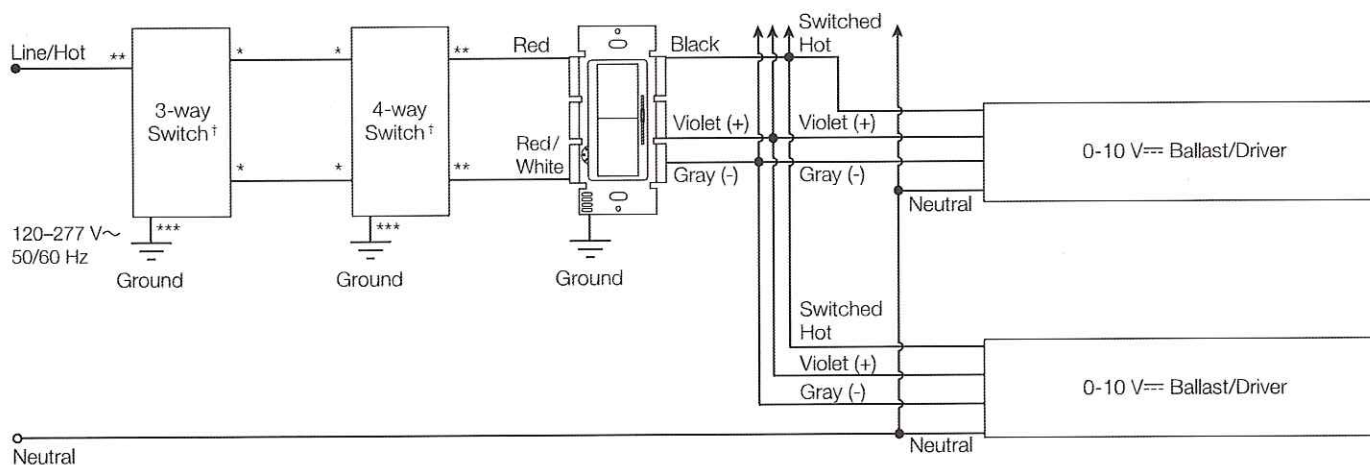

**Note:** For 4-way wiring, control must be installed line side or load side. It cannot be installed in the 4-way location.

<sup>\*</sup> Copper/Black screw terminal

<sup>\*\*</sup> Brass/Gold screw terminal

<sup>\*\*\*</sup> Green screw terminal

<sup>†</sup> For proper wiring, please refer to installation instructions for 3-way/4-way switch.

Job Name:

Model Numbers:

Job Number:




## Wiring Diagrams (continued)

### DVTV- and DVSCTV-


#### Dimming With ON/OFF Control

##### Wiring Diagram Using a Power Pack

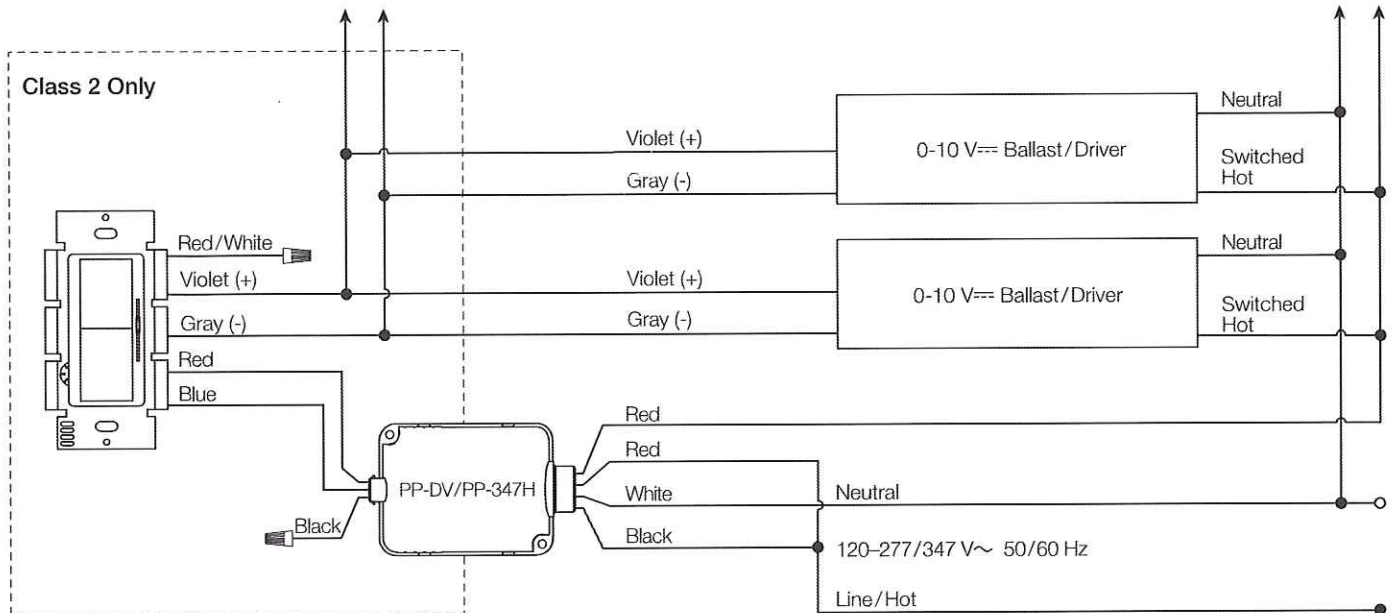

#### Dimming With ON/OFF Control For Drivers Which Support Dim To OFF Capability

##### Power Wiring Not Shown—See Lighting Device For Wiring

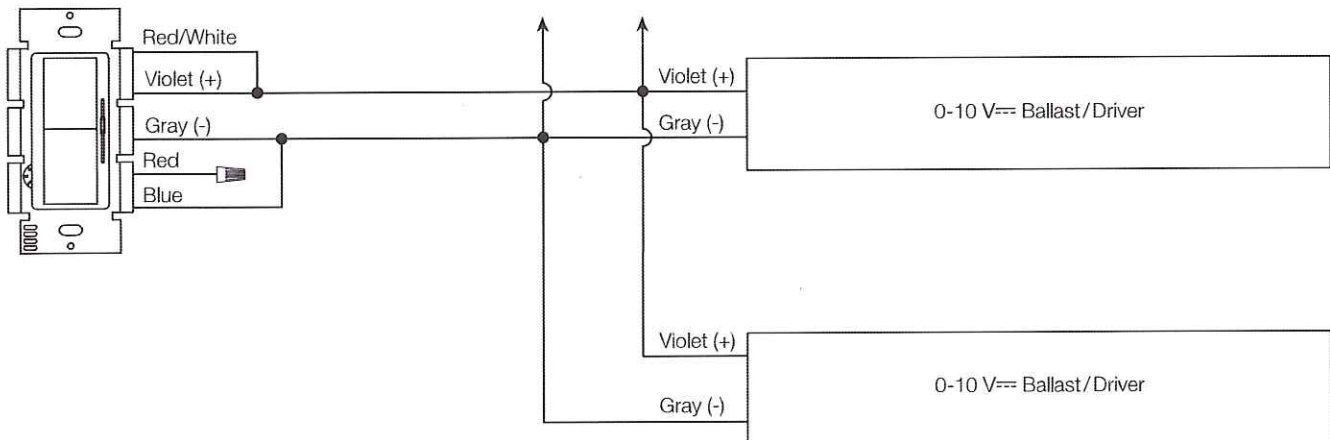

©Lutron, Lutron, Diva, Claro, and Satin Colors are trademarks of Lutron Electronics Co., Inc., registered in the U.S. and other countries.

Job Name:

Model Numbers:

Job Number:



# FLC230 LED

## 667-3420

1/11

FIXTURE TYPE SA  
SCHULER SHOOK  
PROJECT: ARNOLD BARN

**we-ef**



### Description

IP66, Class I, IK07. Marine-grade, die-cast aluminium alloy. 5CE superior corrosion protection including PCS hardware. Silicone CCG\_R\_ Controlled Compression Gasket. Safety glass lens. One cable gland. Second gland for through wiring on request. Integral EC electronic converter, thermally separated. CAD-optimised optics for superior illumination and glare control. OLC\_R\_ One LED Concept. Factory installed LED circuit board. 1-10V, DALI Interface or Eco Step Dim\_R\_ on request. Maximum one internal optical accessory possible.

<b>Beam Type</b>	symmetric, wide beam [W]
------------------	--------------------------

<b>Lamp Type</b>	LED-12/24W / 700 mA - 3000 K
------------------	------------------------------

<b>CRI</b>	80
------------	----

<b>Gear Type</b>	electronic gear
------------------	-----------------

### Nominal Luminous Flux (lm)

LED Lumens	271.4 lm
------------	----------

LEDs	12
------	----

Total Lumens	3257 lm
--------------	---------

Tj	85 °C
----	-------

### Rated Luminous Flux (lm)

LED Lumens	224.4 lm
------------	----------

Total Lumens	2692.9 lm
--------------	-----------

Ta	25 °C
----	-------

<b>Rated Input Power</b>	28 W
--------------------------	------





# FLC230 LED

## 667-3420

2/11

FIXTURE TYPE SA  
SCHULER SHOOK  
PROJECT: ARNOLD BARN

**we-ef**

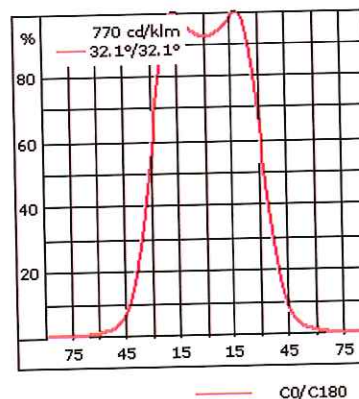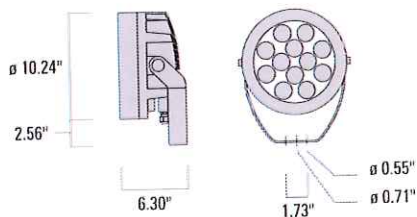

### Material Specification

Body:	Marine-grade, die-cast aluminium alloy
Weight (lbs):	16.80
Lens:	Safety glass lens
Gasket:	Silicone CCG® Controlled Compression Gasket
Fasteners:	PCS Polymer Coated Stainless Steel Hardware
Ingress protection:	IP66
Impact protection:	IK07
Corrosion protection:	5CE superior corrosion protection system
Finish:	Powdercoat finish in Black RAL9004, White RAL9016, Grey Metallic RAL9007 or Dark Bronze RAL8019

### Electrical Specification

Power supply:	Integral [ECG] electronic driver 120-277V
Power factor:	> 0.9
Ballast:	Integral EC electronic converter in thermally-separated compartment
Cable:	One cable entry, second cable entry on request

### Lifetime

LED >60,000 h Ta 25°(L70/B10) Control gear >50,000 h Ta 25°



# FLC230 LED

667-3420

3/11

FIXTURE TYPE SA  
SCHULER SHOOK  
PROJECT: ARNOLD BARN


**we-ef**

## Mounting Accessories


### Floodlight mounting bracket TA

Floodlight mounting brackets made from hot dipped galvanized steel. For mounting up to four floodlights. Special executions are available on request, e.g. other spigot fixing dimensions, etc.


	C1	D x L	L	Weight (lbs)
667-9310 TA1 Mounting bracket, single (Ø 3 x 7.87)	5.12	2.99 x 7.87	2.99	4.19 lbs

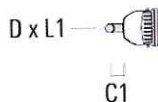

	C1	D x L	L	Weight (lbs)
667-9311 TA2 Mounting bracket, double (Ø 4.25 x 7.87)	5.12	2.99 x 7.87	2.99	4.19 lbs

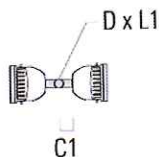

	C1	D x L	L	Weight (lbs)
667-9313 TA3 Mounting bracket, triple (Ø 3.50 x 7.87)	25.59	3.50 x 7.87	3.5	39.46 lbs

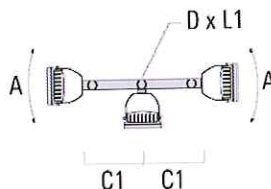



# FLC230 LED


667-3420

4/11


**FIXTURE TYPE SA**  
SCHULER SHOOK  
PROJECT: ARNOLD BARN

**we-ef**


	C1	D x L	Weight (lbs)
667-9318 TA3 Mounting bracket, triple (Ø 4.25 x 7.87)	25.59	4.25 x 7.87	24.20 lbs

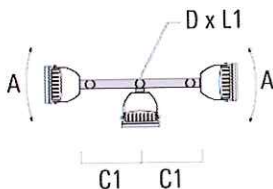


	C1	D x L	L	Weight (lbs)
667-9312 TA2-L Mounting bracket, double (Ø 3.0" x 7.87" long)	16.54	2.99 x 7.87	2.99	35.49 lbs

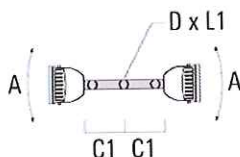

	C1	D x L	L	Weight (lbs)
667-9316 TA2-L Mounting bracket, double (Ø 4.25 x 7.87 long)	16.54	4.25 x 7.87	4.25	44.53 lbs

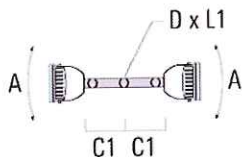

	C1	D x L	L	Weight (lbs)
667-9315 TA1 Mounting bracket, single (Ø 4.25 x 7.87)	5.12	4.25 x 7.87	4.25	16.53 lbs

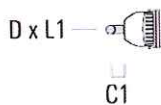



# FLC230 LED


667-3420

5/11


**FIXTURE TYPE SA**  
SCHULER SHOOK  
PROJECT: ARNOLD BARN

**we-ef**

	C1	D x L	Weight (lbs)
667-9314 TA4 Mounting bracket, quad (Ø 3.50 x 7.87)	25.59	3.50 x 7.87	20.80 lbs

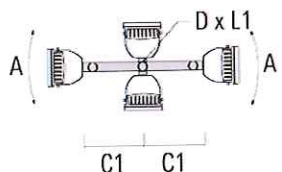


	C1	D x L	Weight (lbs)
667-9319 TA4 Mounting bracket, quad (Ø 4.25 x 7.87)	25.59	4.25 x 7.87	53.00 lbs

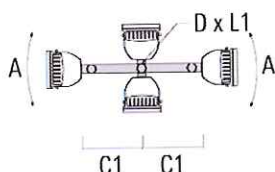

## Planted root

Planted root made from hot dipped galvanized steel. Includes mounting hardware. Must be used in conjunction with EM short post.

	D1	D2	D3	D4	H1	H2	M1	Weight (lbs)
665-9302 Planted root ESV4	5.71	5.12	4.02	4.25	15.75	13.78	8	4.40 lbs

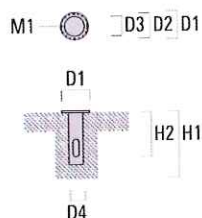

## Pole clamp TS

Pole clamps made from die-cast aluminium with stainless steel hardware. For mounting of one or two floodlights. Max. permissible weight per installed floodlight 49.6 lbs.



# FLC230 LED


667-3420

6/11

FIXTURE TYPE SA  
SCHULER SHOOK  
PROJECT: ARNOLD BARN


**we-ef**

	D1	Weight (lbs)
■ 667-9348 TS1-2/M12 Pole clamp, single (Ø 4.0"-4.5")	4.0-4.50	3.53 lbs

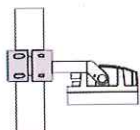


D1

	D1	Weight (lbs)
■ 667-9322 TS1-2/M12 Pole clamp, single (Ø 4.0"-4.5")	4.0-4.50	3.53 lbs

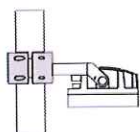


D1

	D1	Weight (lbs)
■ 667-9349 TS2-2/M16 Pole clamp, double (Ø 4.0"-4.5")	4.0-4.50	3.31 lbs

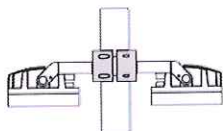

D1

	D1	Weight (lbs)
■ 667-9320 TS1-2/M12 Pole clamp, single (Ø 3"-3.5")	3.0-3.50	3.31 lbs

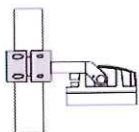

D1



# FLC230 LED

667-3420

7/11


## FIXTURE TYPE SA

SCHULER SHOOK


PROJECT: ARNOLD BARN

**we-ef**

	D1	Weight (lbs)
667-9321 TS2-2/M12 Pole clamp, double (Ø 3"-3.5")	3.0-3.50	3.09 lbs

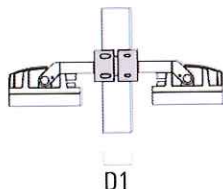


	D1	Weight (lbs)
667-9323 TS2-2/M16 Pole clamp, double (Ø 4.5"-5.25")	4.50-5.25	3.53 lbs

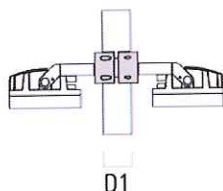

### Short post EM

Short posts made from die-cast aluminium with concealed stainless steel hardware. For mounting of one floodlight.

	D1	D2	H1	M1	Weight (lbs)
667-9301 EM1-M16	6.30	5.12	7.87	9	4.85 lbs

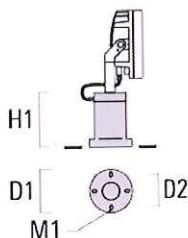

### Surface Mount Canopy SMC

Suitable for mounting FLC230/240/250/254 series floodlight to any horizontal or vertical surface over a recessed junction box.



# FLC230 LED


667-3420

8/11

FIXTURE TYPE SA  
SCHULER SHOOK  
PROJECT: ARNOLD BARN

**we-ef**

	D1	D2	Weight (lbs)
683-9329 SMC-200	10.83	9.25	7 lbs

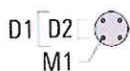



# FLC230 LED

667-3420

9/11

FIXTURE TYPE SA  
SCHULER SHOOK  
PROJECT: ARNOLD BARN

**we-ef**

## Optical Accessories

### Surface wash lens IO-360

Broadens light distribution in all planes. A maximum of one internal optical accessory.

C1

667-8120 IO-360-FLC230-LED

7.83



C1

### Glare shield

Glare shield made from corrosion resistant aluminum. Inner surfaces matt black powdercoated.


A

C1

667-9221 ES-FLC230-LED

5.17

8.90

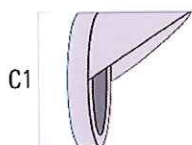

C1

A

### Honeycomb louvre IW

Honeycomb louvre, matt black Teflon® coated. For luminaires equipped with [W] [M] light distribution. A maximum of one internal optical accessory.



# FLC230 LED

667-3420

10/11

## FIXTURE TYPE SA

SCHULER SHOOK

PROJECT: ARNOLD BARN

**we-ef**

C1

667-8210 IW-FLC230-LED

7.83



C1

### Linear spread lens IO-180

Broadens light distribution in one plane only. A maximum of one internal optical accessory.

C1

667-8119 IO-180-FLC230-LED

7.83



C1

### Snoot

Framing snoot made from corrosion resistant aluminium. Provides all-round glare cut-off as well as effective framing of beam. Inner surfaces matt black powdercoated.


A

C1

667-9222 Snoot ET

180

293

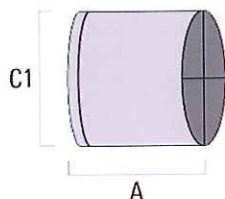



# FLC230 LED

667-3420

11/11

## FIXTURE TYPE SA

SCHULER SHOOK

PROJECT: ARNOLD BARN

**we-ef**

### Wallwash lens IO-20

Specifically developed for the lighting of architectural surfaces, in combination with WE-EF [M] symmetric medium beam LED optics. Luminaires fitted with the IO-20 wallwash lens are typically positioned at  $0.125 \times h$  away from the target surface and spaced up to  $1.75 \times d$  apart:  $h$  = height of wall/target surface  $d = 0.125 \times h$  = distance from the wall/target surface  $s = 1.75 \times d$  = spacing between luminaires The IO-20 LED wallwash lens is factory-installed within the luminaire. The factory-sealed qualities and advantages of the luminaire are fully maintained. A maximum of one internal optical accessory.

C1

667-8118 IO-20-FLC230-LED

7.83



C1



# Pole clamp TS


667-9323

**we-ef**

1/1

## Pole clamp TS

Pole clamps made from die-cast aluminium with stainless steel hardware. For mounting of one or two floodlights. Max. permissible weight per installed floodlight 49.6 lbs.

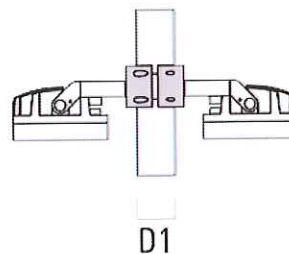

		D1	Weight (lbs)
667-9323	TS2-2/M16 Pole clamp, double (Ø 4.5"-5.25")	4.50-5.25	3.53



# Pole clamp TS


667-9349

**we-ef**

1/1


## Pole clamp TS

Pole clamps made from die-cast aluminium with stainless steel hardware. For mounting of one or two floodlights. Max. permissible weight per installed floodlight 49.6 lbs.

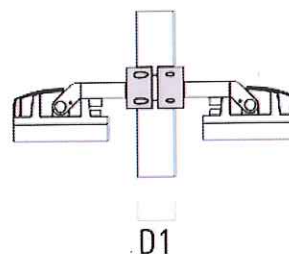

		D1	Weight (lbs)
■ 667-9349	TS2-2/M16 Pole clamp, double (Ø 4.0"-4.5")	4.0-4.50	3.31



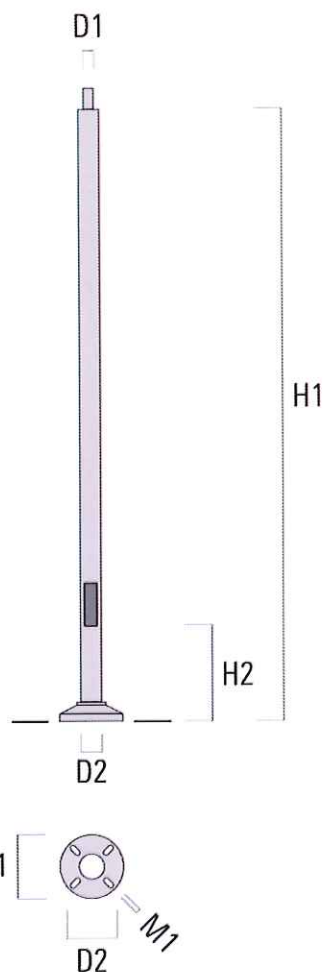

## Description

Straight round aluminum. Chromated pre-treatment with superior powdercoat finish in black RAL 9004, grey metallic RAL 9007 or white RAL 9016. Specify finish. Consult WE-EF color chart for other options. Specify suitable pole top tenon for inteded brackets. Service door with tamper-proof hardware. Base plate welded tubular shaft. Spun aluminum base plate cover.

		D1 $\phi$	D2 $\phi$	H1	H2	Weight (lbs)
693-1220	AML-Z-008-40-125	4	4	96	23.62	19
693-1221	AML-Z-10-40-125	4	4	120	23.62	22
693-1222	AML-Z-10-50-125	5	5	120	23.62	27
693-1223	AML-Z-12-40-125	4	4	144	23.62	26
693-1224	AML-Z-12-50-156	5	5	144	23.62	38
693-1225	AML-Z-14-50-156	5	5	168	23.62	44
693-1230	AML-Z-16-50-188	5	5	192	23.62	58
693-1231	AML-Z-16-60-156	6	6	192	23.62	59
693-1232	AML-Z-18-50-188	5	5	216	23.62	65
693-1233	AML-Z-18-60-188	6	6	216	23.62	78
693-1234	AML-Z-20-60-156	6	6	240	23.62	73
693-1235	AML-Z-20-60-188	6	6	240	23.62	86



# AML-Z

**we-ef**

2/2

		D1 $\phi$	D2 $\phi$	H1	H2	Weight (lbs)
693-1236	AML-Z-25-60-188	6	6	300	23.62	106



# Snoot


667-9222

1/1

**we-ef**

## Snoot

Framing snoot made from corrosion resistant aluminium. Provides all-round glare cut-off as well as effective framing of beam. Inner surfaces matt black powdercoated.

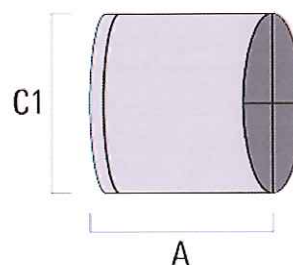

		A	C1
667-9222	ET-FLC230-LED	180	293



APPROVED


ATMOS ENERGY CORPORATION  
2# Systems will not be allowed unless proof of an appliance requiring a MINIMUM of over 7" W.C. is provided to Atmos Energy Corporation personnel for review.  
Meter location must be approved by an Atmos Energy Corporation employee during a mandatory site visit to be scheduled after foundation is in place.  
Meters will not be allowed under a shedding roofline or where overhanging snow is a danger to the meter set.

RCRBD  
RECORD SET

PJ2649-6  
Fire Prevention  
In: 06/04/2018  
Out: 06/10/2018

ICONIC ENTRY - ARNOLD BARN INTERPRETIVE DISPLAY

MOUNT WERNER CIRCLE  
STEAMBOAT SPRINGS, CO

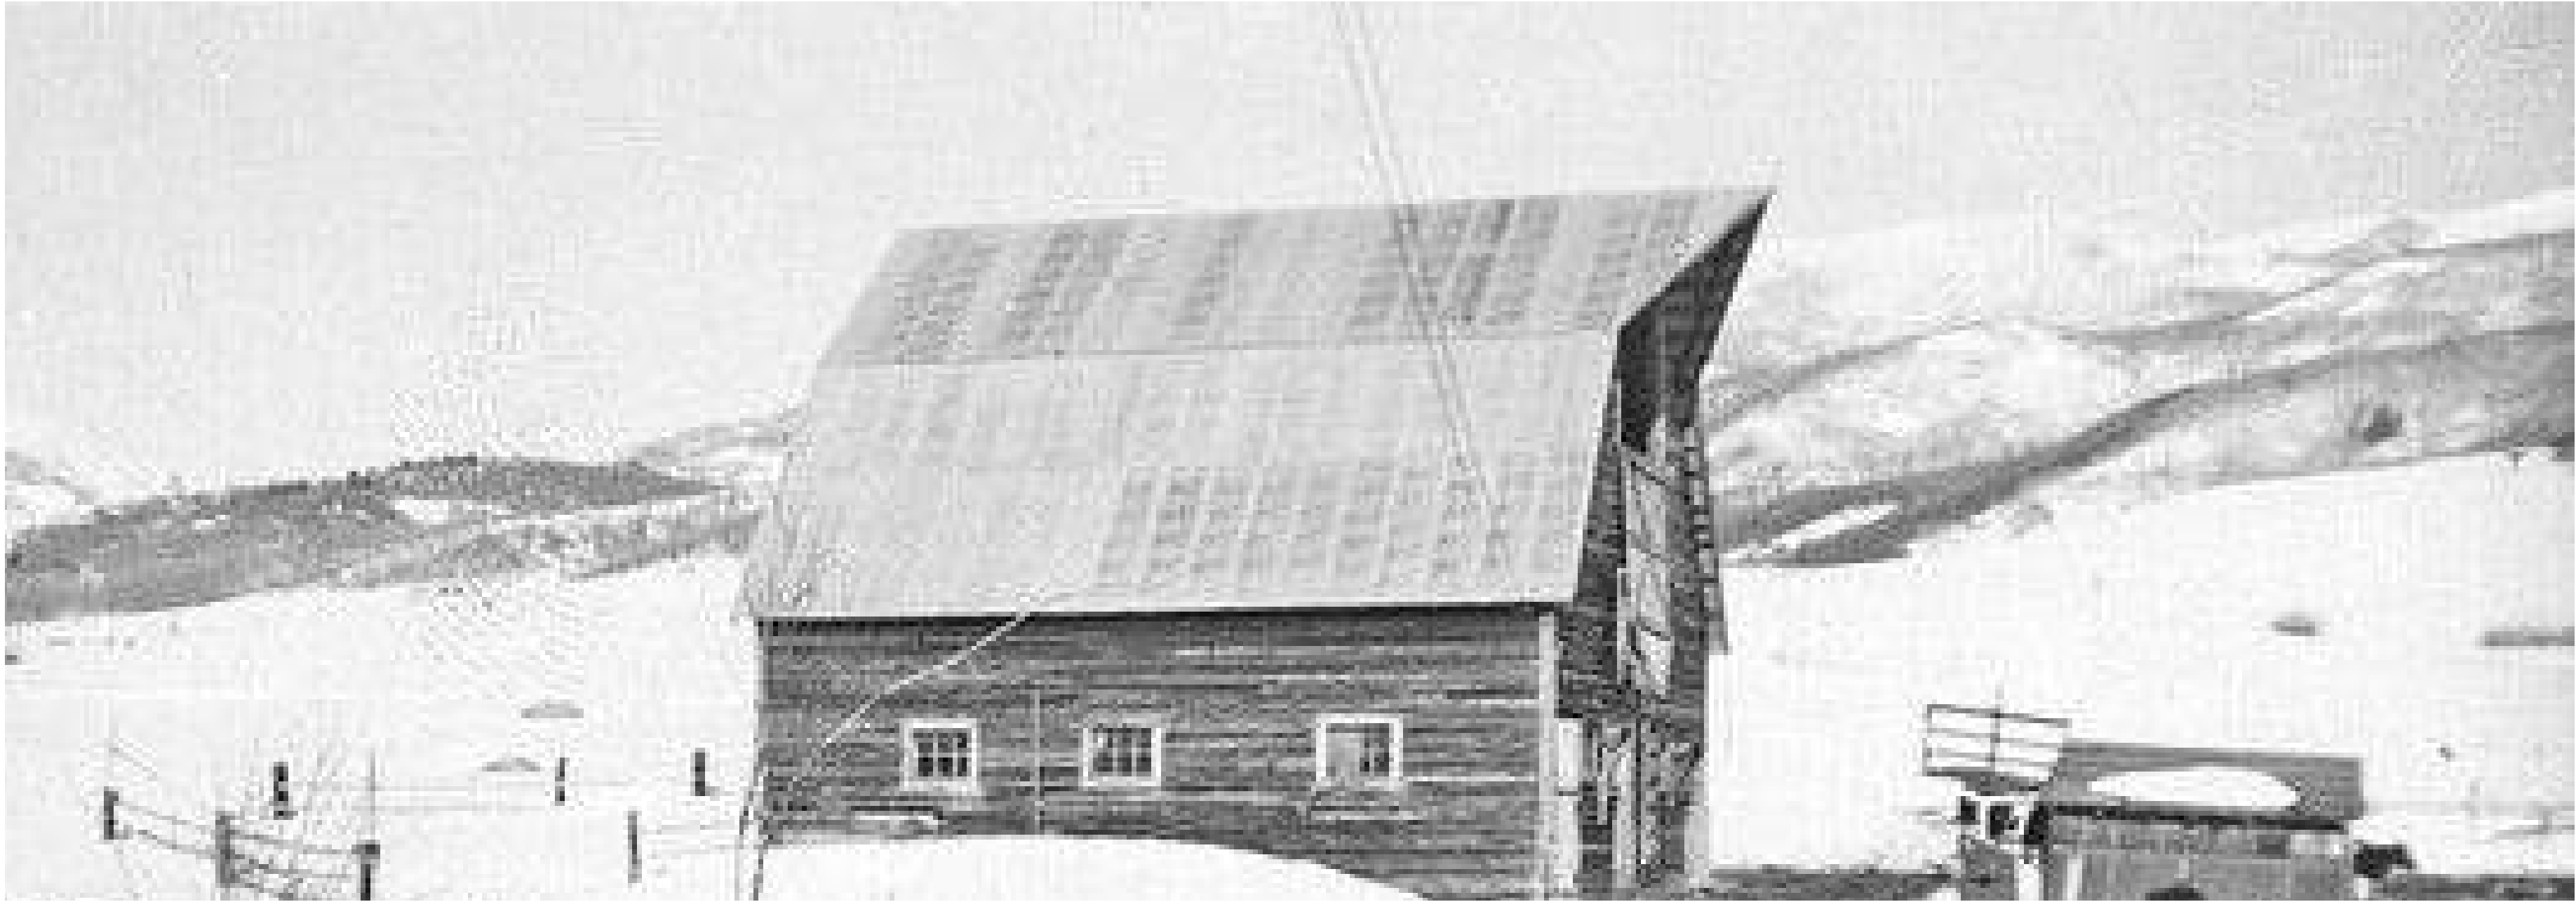

A NATURAL RESOURCE AREA IN THE RR-1 ZONE DISTRICT

PROJECT TEAM:

CIVIL ENGINEER

Baseline Engineering, Planning, & Surveying  
Project Contact: Chris Rundall  
419 Oak St., Steamboat Springs, CO 80487  
970.879.1825

LANDSCAPE

MGC DESIGN, INC  
Project Contact: Mike Campbell  
141 9TH St, Steamboat Springs, CO 80487  
970.879.7740

ARCHITECTURAL

MOUNTAIN ARCHITECTURE DESIGN GROUP  
Project Contact: Jan Kaminski  
634 Oak St, Steamboat Springs, CO 80487  
970.879.5764

STRUCTURAL

Steamboat Engineering And Design, Inc  
Project Contact: Jake Mielke  
2740 Acre Lane, Ste. E. Steamboat Springs, CO 80487  
970.871.9101

CONTRACTOR

FOX Construction, Inc  
Project Contact: Sarah Fox & Kevin Kopasz  
2034 Snow Bowl Plaza, Steamboat Springs, CO 80487  
970.871.7529

TABLE OF CONTENTS:

C1	COVER SHEET
C2	NOTES AND LEGEND
C3	PHASE 1 -- SITE AND UTILITY
C4	PHASE 1 -- GRADING AND EROSION CONTROL PLAN
C5	PHASE 2 -- SITE PLAN
C6	PHASE 2 -- SIDEWALK CONNECTION SITE PLAN
C7	PHASE 2 -- GRADING PLAN
C8	PHASE 2 -- SIDEWALK CONNECTION GRADING PLAN
C9	PHASE 2 -- EROSION CONTROL PLAN
C10	PHASE 2 -- SIDEWALK CONNECTION EROSION CONTROL PLAN
C11	STORM WATER MANAGEMENT PLAN
C12	DETAILS
C13	EROSION CONTROL DETAILS

L.100	LANDSCAPE AND IRRIGATION
L.200	NOTE & DETAILS


A2	EXISTING FLOOR PLANS
A3	EXISTING ROOF PLAN
A4	EXISTING ELEVATIONS
A5	EXISTING ELEVATIONS
A6	EXISTING SETCION & DETAILS
A7	MAIN & LOFT FLOOR PLAN TREATMENTS
A8	ROOF PLAN
A9	ELEVATIONS
A10	ELEVATIONS
A11	DOORS & WINDOW DETAILS

S1	FOUNDATION PLAN & SECTIONS
S2	BUILDING SECTION

LP1	PROPOSED LIGHTING PLAN
LP2	PROPOSED LIGHTING

ARNOLD BARN:  
EXISTING LOCATION

ARNOLD BARN:  
NEW LOCATION

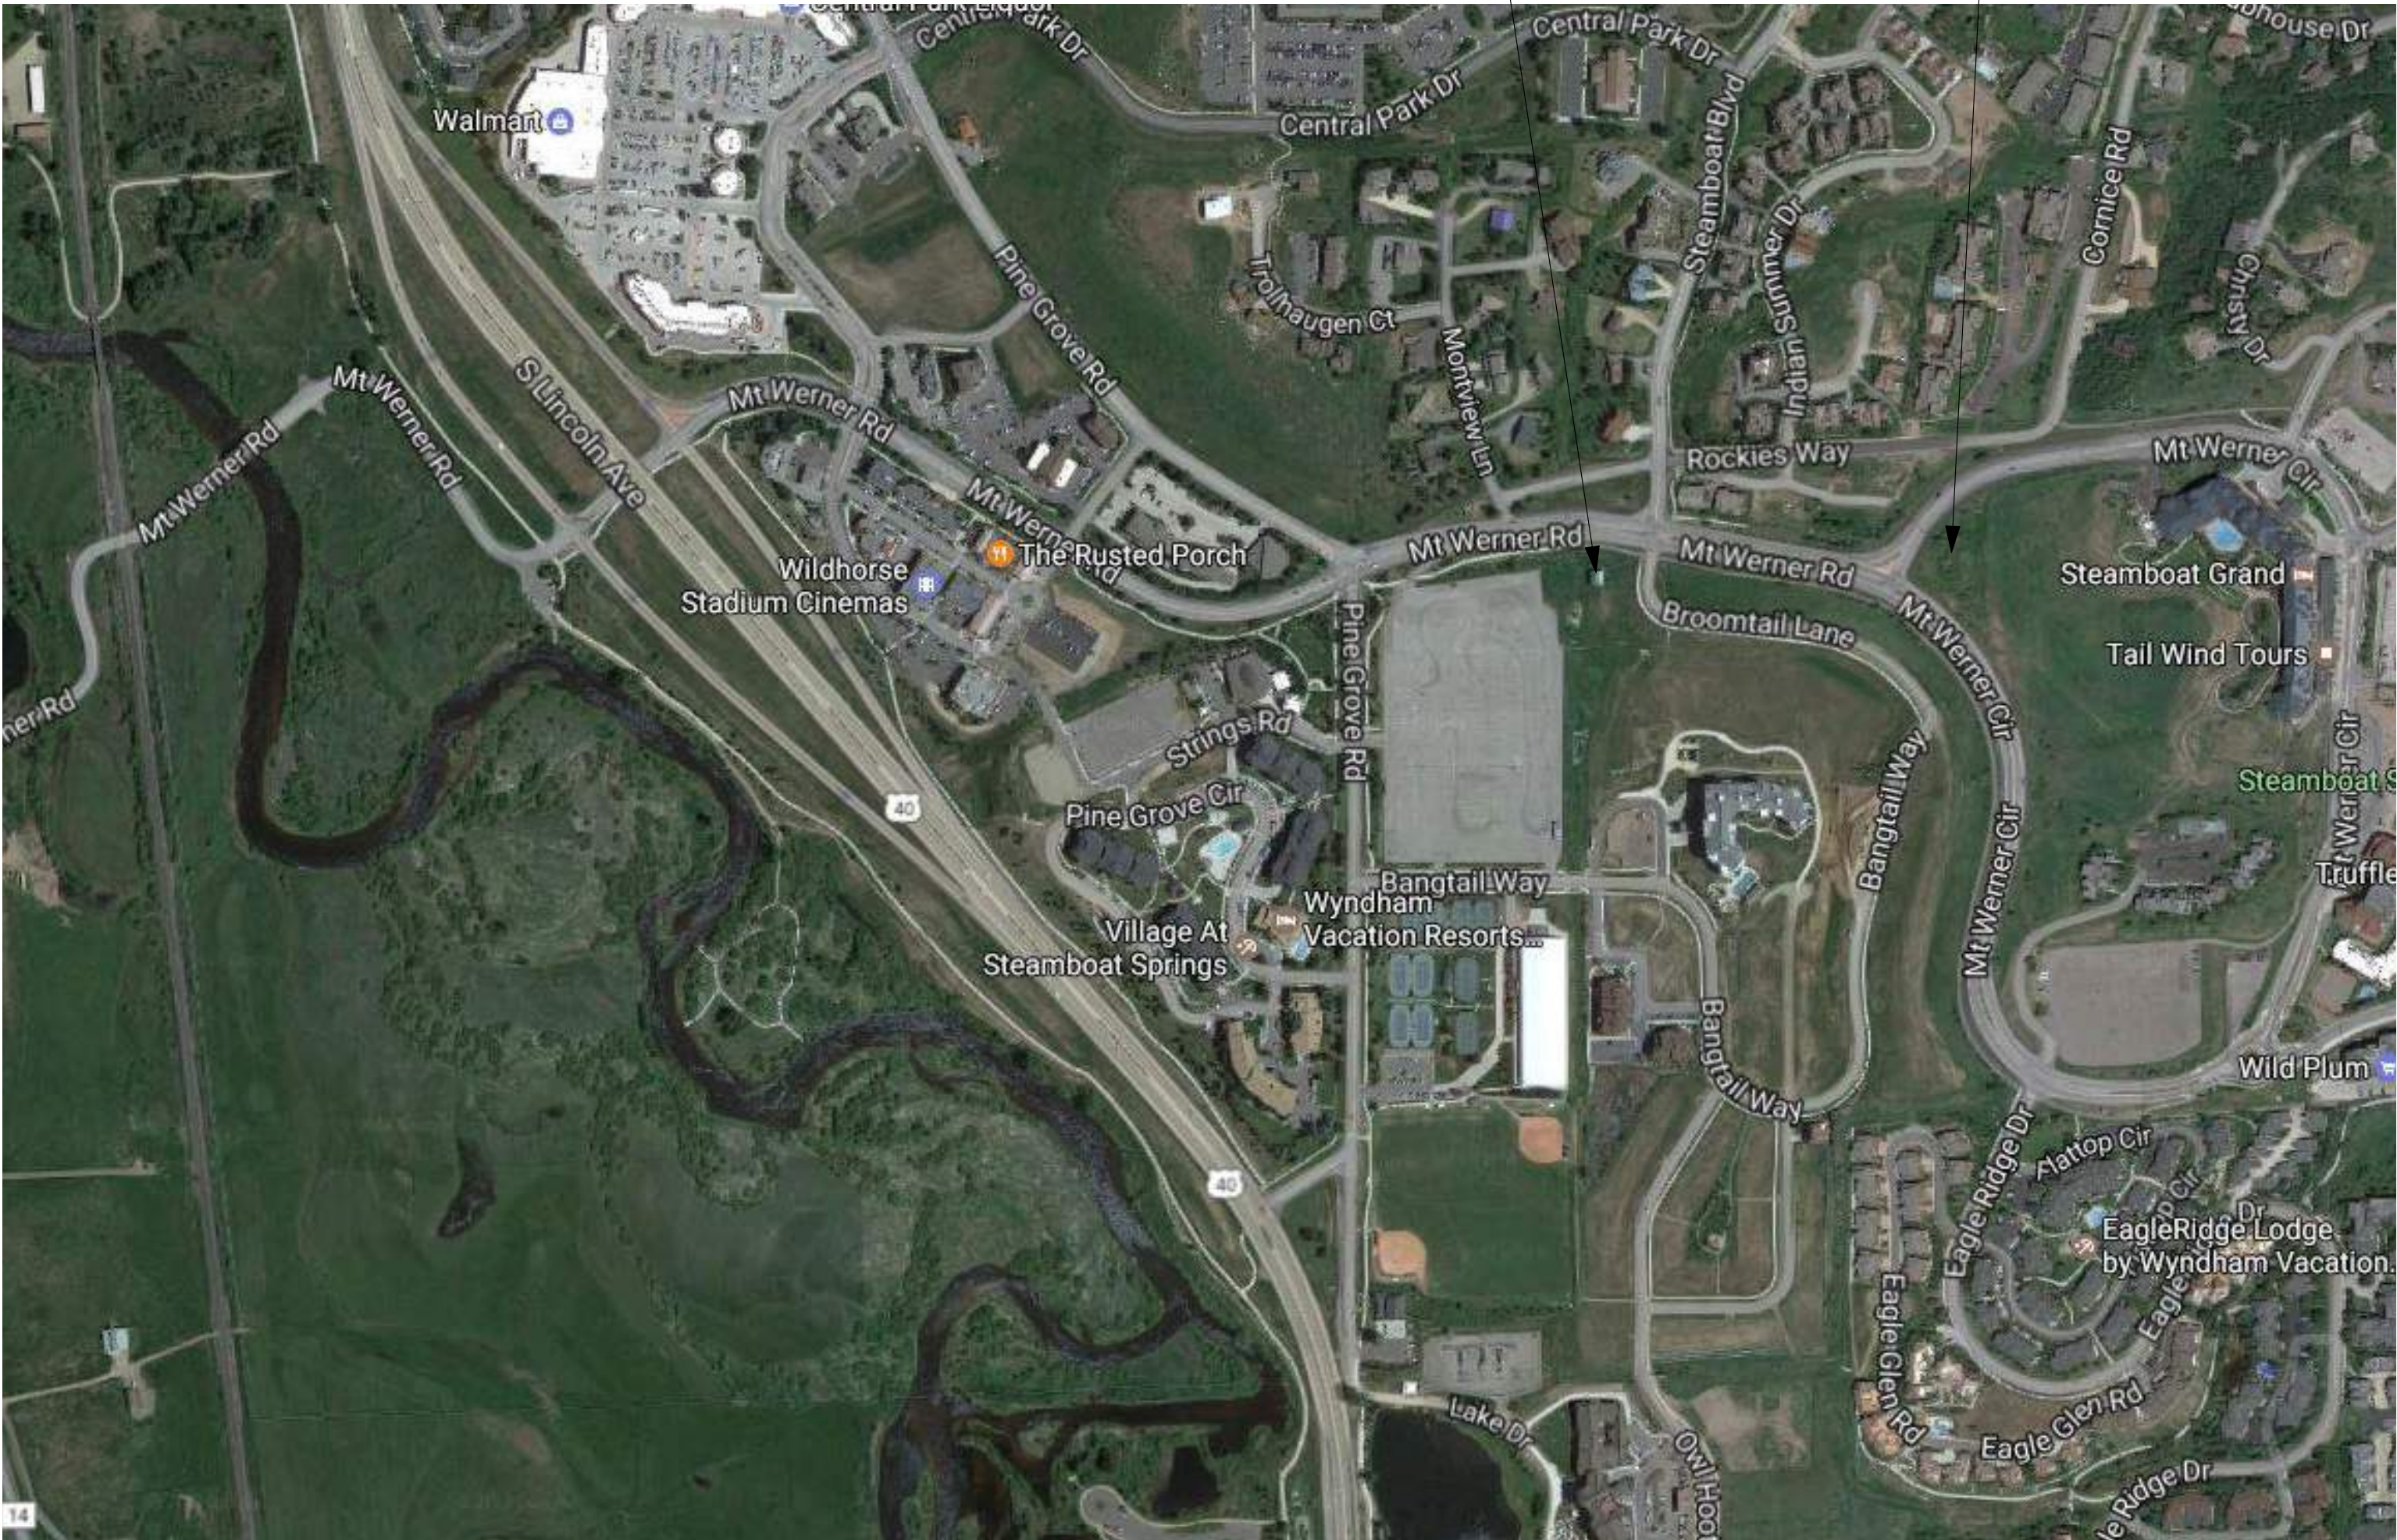

VICINITY MAP



MOUNTAIN ARCHITECTURE  
DESIGN GROUP P.C.  
Jan Michael Kaminski,  
President  
P.O. BOX 1000  
STEAMBOAT SPRINGS, COLORADO 80487  
(970) 879-5764  
jan@mountainarch.com

AN ICONIC ENTRY FOR THE  
ARNOLD BARN INTERPRETIVE DISPLAY  
2305 MT. WERNER CIR.  
STEAMBOAT SPRINGS, CO. 80487-9023

TITLE  
COVER SHEET

JOB NO. PROJECT NUMBER  
DRAWN BY LRR  
CHECKED BY JMK  
ISSUE DATE 5/25/2018

REVISIONS:  
1 DATE

DRAWING NUMBER  
CS

Yampa Valley Electric Assoc. INC  
This approval addresses only the  
meter and service location  
Approved: Scott Flowers 6/19/18



CONSTRUCTION DOCUMENTS  
URAAC/SSRA ICONIC ENTRY

LOCATED IN PORTIONS OF SECTIONS 21 & 28, TOWNSHIP 6 NORTH, RANGE 84 WEST  
OF THE 6th PRINCIPAL MERIDIAN  
CITY OF STEAMBOAT SPRINGS, ROUTT COUNTY, COLORADO

RCRBD  
RECORD SET

PROJECT CONTACTS



CIVIL ENGINEER:  
BASELINE ENGINEERING  
CHRIS RUNDALL  
(970) 879-1825



CLIENT:  
STEAMBOAT SPRINGS REDEVELOPMENT AUTHORITY  
DANNY PAUL & RALPH WALTON  
(970) 871-8210



GAS:  
ATMOS ENERGY  
DON CRANE  
(970) 846-1505



ELECTRIC:  
YAMPA VALLEY ELECTRIC  
LARRY BALL  
(970) 879-1160



CenturyLink

TELEPHONE:  
CENTURY LINK  
KELLY MCCLERNON  
970-328-8288



Mount Werner Water District


WATER & SANITARY SEWER:  
MT. WERNER WATER DISTRICT  
RICHARD BUCCINO  
(970) 879-2424



CABLE:  
COMCAST  
DAVE STEPISNIK  
(970) 539-0610



BROADBAND/FIBER:  
RESORT INTERNET  
CHRIS PROCTOR  
(970) 389-6399

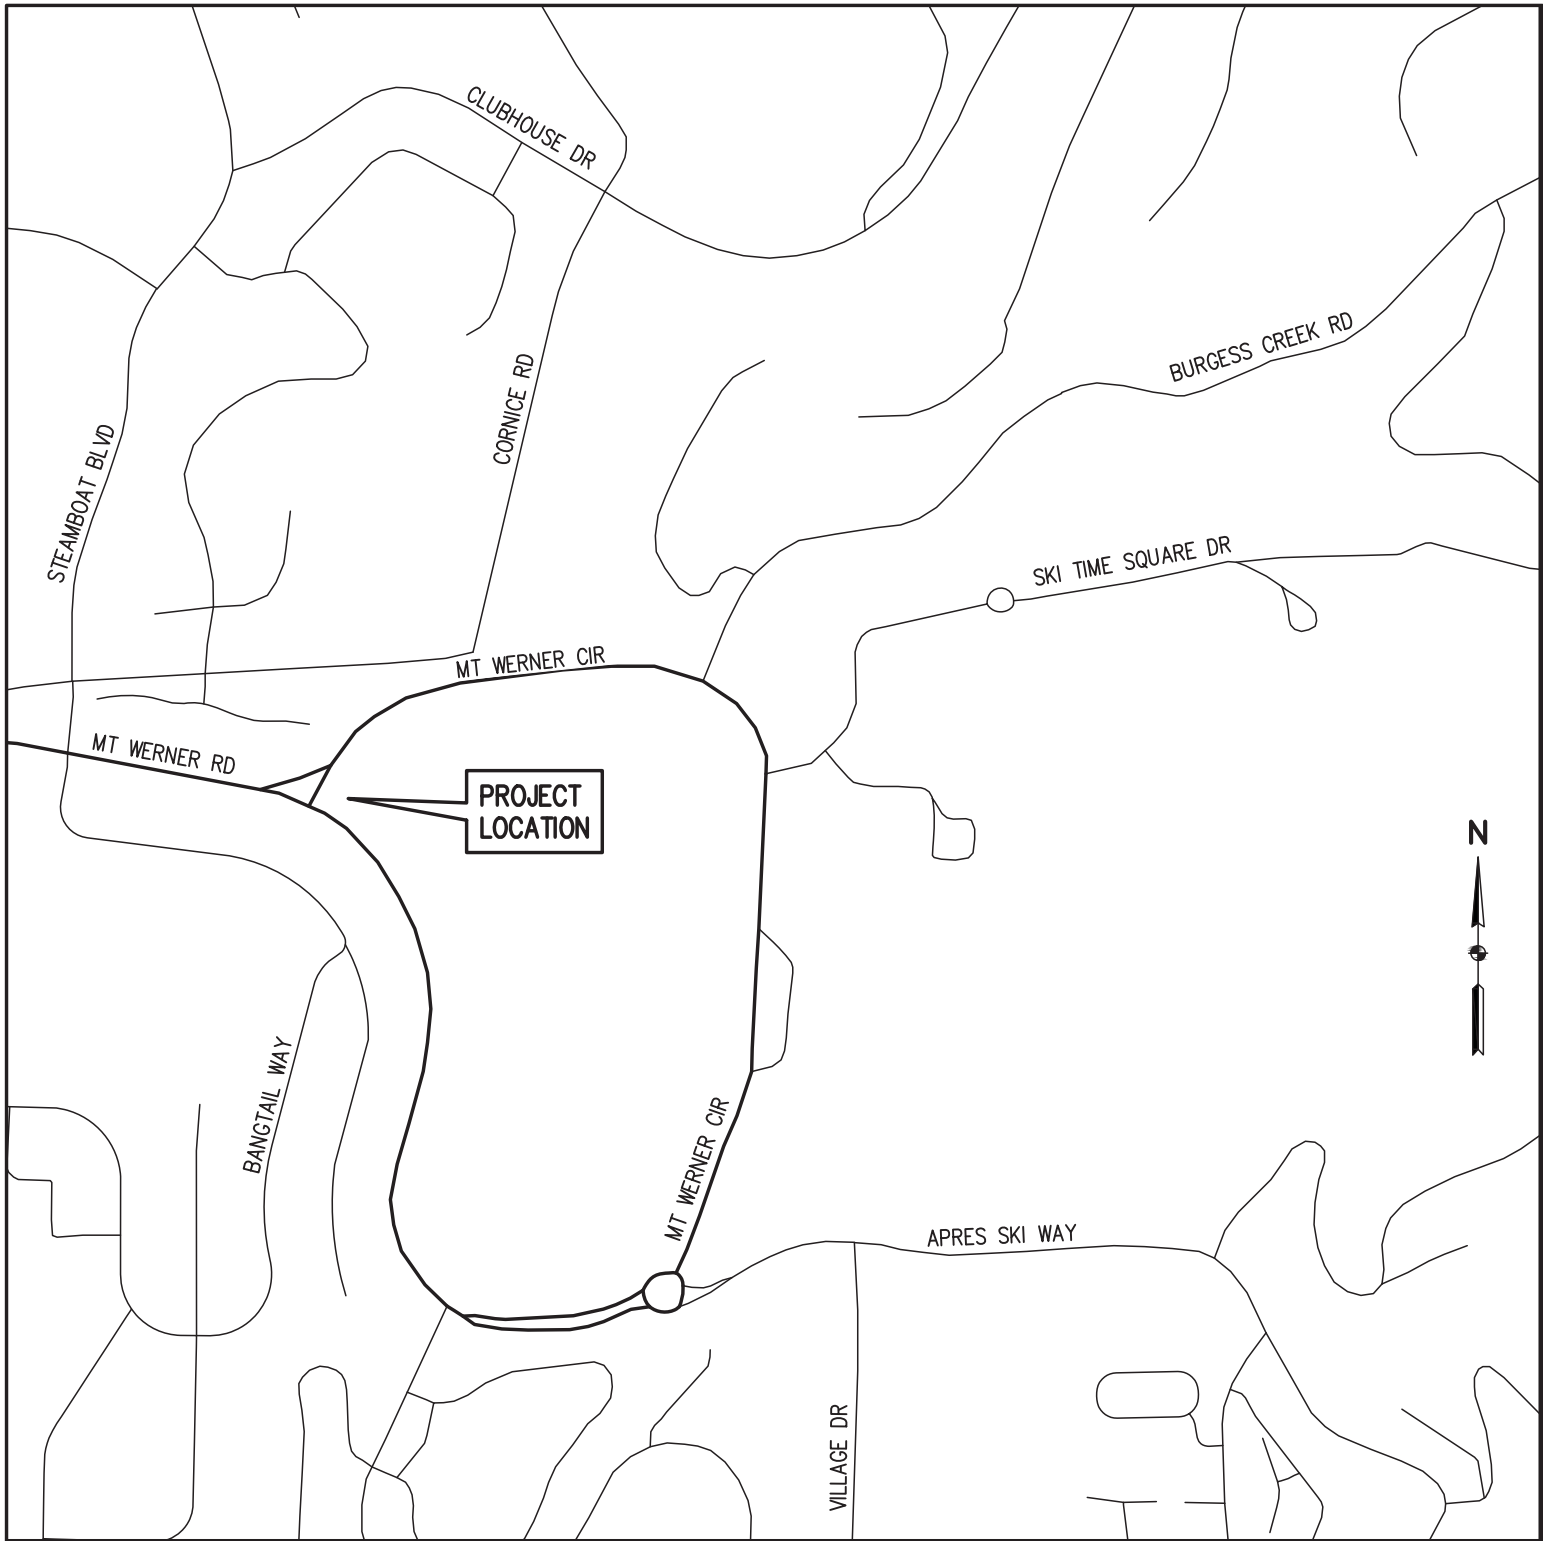

1  
C1 C1  
VICINITY MAP  
SCALE: 1" = 500

SHEET INDEX

- NO. SHEET TITLE  
C1 COVER SHEET  
C2 NOTES AND LEGEND  
C3 PHASE 1 - SITE & UTILITY PLAN  
C4 PHASE 1 - GRADING AND EROSION CONTROL PLAN  
C5 PHASE 2 - SITE PLAN  
C6 PHASE 2 - SIDEWALK CONNECTION SITE PLAN  
C7 PHASE 2 - GRADING PLAN  
C8 PHASE 2 - SIDEWALK CONNECTION GRADING PLAN  
C9 PHASE 2 - EROSION CONTROL PLAN  
C10 PHASE 2 - SIDEWALK CONNECTION EROSION CONTROL PLAN  
C11 STORM WATER MANAGEMENT PLAN  
C12 DETAILS  
C13 EROSION CONTROL DETAILS

PREPARED FOR:  
STEAMBOAT SPRINGS REDEVELOPMENT AUTHORITY  
137 10TH ST.  
STEAMBOAT SPRINGS, COLORADO 80477

PROJECT BENCHMARK:  
A RECOVERED 3" BRASS CAP MONUMENTING THE NORTHEAST  
CORNER OF SECTION 28, TOWNSHIP 6 NORTH, RANGE 84 WEST  
OF THE 6TH P.M. SAID BRASS CAP ALSO BEING CITY OF  
STEAMBOAT SPRINGS GIS CONTROL POINT NUMBER 344.  
NORTHING = 1,412,535.68  
EASTING = 2,636,559.05  
ELEVATION = 6935.40 (NAVD88)



Engineering · Planning · Surveying  
419 OAK ST. • PO BOX 77052 • STEAMBOAT SPRINGS, CO 80477  
P. 970.879.1825 • F. 303.940.9569 • www.baselinecorp.com

DESIGNED BY  
SMB  
DRAWN BY  
SMB  
CHECKED BY  
CSR

DATE  
5/3/18  
PREPARED BY  
CSR

REVISION DESCRIPTION  
DESIGN TEAM REVIEW/COORDINATION

CITY OF STEAMBOAT SPRINGS  
STEAMBOAT SPRINGS  
ROUTT COUNTY  
URAAC/SSRA ICONIC ENTRY  
MT. WERNER CIRCLE/MT. WERNER ROAD  
COVER SHEET

FOR AND ON BEHALF OF  
SUPERVISOR OF



FOR AND ON BEHALF OF  
BASELINE CORPORATION

INITIAL SUBMITTAL 4/25/17

DRAWING SIZE 24" X 36"

SURVEY FIRM SURVEY DATE  
D&D, INC. 10/11/14

JOB NO. C020169

DRAWING NAME  
C020169 CD COVER.dwg

SHEET 1 OF 13

C1



Know what's below.  
Call before you dig.



O:\C020169 Iconic Entry\Drawings\C020169 CD COVER.dwg, 5/3/2018 3:45:08 PM, Chris Rundall

CITY OF STEAMBOAT SPRINGS STANDARD CONSTRUCTION NOTES

GENERAL NOTES

- BENCHMARK = SEE COVER SHEET. NOTE THE PROJECT IS ON THE NAVD 88 VERTICAL DATUM AND NAD 1983 HORIZONTAL DATUM AS REQUIRED BY THE CITY.
- TOPOGRAPHIC AND EXISTING CONDITIONS MAPPED BY D&D INC. ON 10/11/14. LANDMARK CONSULTANTS, INC. UPDATED THE SURVEY IN 2017 TO MATCH IN WITH THE DATUM OF THE SKI TIME SQUARE DR AND MT WERNER CIRCLE ROUNDABOUT PROJECT. ADDITIONALLY A SURVEY PERFORMED BY WHELAN LAND SURVEYS DATED 12/8/17 WAS INCORPORATED INTO THE PLANS WITH A HORIZONTAL DATUM TRANSFORMATION.
- CITY OF STEAMBOAT SPRINGS PLAN REVIEW AND APPROVAL IS ONLY FOR GENERAL CONFORMANCE WITH CITY DESIGN CRITERIA AND THE CITY CODE. THE CITY IS NOT RESPONSIBLE FOR THE COMPLETENESS, ACCURACY AND ADEQUACY OF THE DRAWINGS. DESIGN, DIMENSIONS, AND ELEVATIONS SHALL BE CONFIRMED AND CORRELATED AT THE JOB SITE.
- ONE COPY OF THE APPROVED CONSTRUCTION PLANS AND SPECIFICATIONS SHALL BE KEPT ON THE JOB SITE AT ALL TIMES. PRIOR TO THE START OF CONSTRUCTION, CONTRACTOR TO VERIFY WITH PROJECT ENGINEER THE LATEST REVISION DATE OF THE APPROVED CONSTRUCTION PLANS.
- CONTRACTOR SHALL VERIFY THE LOCATION OF ALL UTILITIES. CALL THE UTILITY NOTIFICATION CENTER OF COLORADO (UNCC) AT 1-800-922-1987 AND ANY NECESSARY PRIVATE UTILITY TO PERFORM LOCATES PRIOR TO CONDUCTING ANY SITE WORK.
- ALL INFRASTRUCTURE CONSTRUCTION AND RELATED WORK SHALL CONFORM TO THE CITY OF STEAMBOAT SPRINGS STANDARD SPECIFICATIONS, LATEST REVISION.
- ALL WATER AND SANITARY SEWER CONSTRUCTION AND RELATED WORK SHALL CONFORM TO MT. WERNER WATER DISTRICT STANDARDS AND SPECIFICATIONS.
- CONTRACTOR SHALL OBTAIN ALL NECESSARY PERMITS AND APPROVALS REQUIRED TO PERFORM THE WORK SUCH AS RIGHT-OF-WAY PERMIT, GRADING AND EXCAVATION PERMIT, CONSTRUCTION DEWATERING PERMIT, STORM WATER QUALITY PERMIT, ARMY CORP. OF ENGINEER PERMIT, ETC. IT IS THE CONTRACTOR'S RESPONSIBILITY TO OBTAIN A COPY OF ALL APPLICABLE CODES, LICENSES, SPECIFICATIONS, AND STANDARDS NECESSARY TO PERFORM THE WORK, AND BE FAMILIAR WITH THEIR CONTENTS PRIOR TO COMMENCING ANY WORK.
- PRIOR TO ANY WORK IN THE CITY RIGHT-OF-WAY INCLUDING STREET CUTS, CONTACT THE CITY OF STEAMBOAT SPRINGS STREET DEPARTMENT AT 970.879.1807 FOR PERMIT REQUIREMENTS. NO WORK SHALL OCCUR IN THE ROW BETWEEN NOVEMBER 1 - APRIL 1 UNLESS A WRITTEN VARIANCE HAS BEEN APPROVED AND ISSUED BY THE CITY PUBLIC WORKS DIRECTOR.
- PRIOR TO CLOSURE OF ANY STREET OR PART OF STREET, AN APPROVED OBSTRUCTION PERMIT MUST BE ISSUED BY CITY CONSTRUCTION SERVICES FOREMAN.
- CONTRACTOR IS RESPONSIBLE FOR CONTACTING THE COLORADO DEPARTMENT OF TRANSPORTATION (CDOT) AND OBTAINING ANY REQUIRED PERMITS OR APPROVALS FOR WORK ON OR ADJACENT TO CDOT ROW.
- PRIOR TO START OF CONSTRUCTION CONTRACTOR SHALL COORDINATE WITH PROJECT ENGINEER TO IDENTIFY PROJECT INSPECTION AND TESTING REQUIREMENTS. CONTRACTOR SHALL PROVIDE FOR INSPECTIONS AND TESTING AT AN ADEQUATE FREQUENCY FOR THE PROJECT ENGINEER TO DOCUMENT THAT PROJECT IS CONSTRUCTED IN CONFORMANCE WITH THE APPROVED PLANS AND SPECIFICATIONS.
- CONTRACTOR IS RESPONSIBLE FOR ALL NECESSARY TRAFFIC CONTROL. TRAFFIC CONTROL SHALL BE IN ACCORDANCE WITH THE MANUAL ON UNIFORM TRAFFIC CONTROL DEVICES (MUTCD), LATEST EDITION.
- CONTRACTOR SHALL PROVIDE ALL NECESSARY TRAFFIC CONTROL (SIGNS, BARRICADES, FLAGMEN, LIGHTS, ETC) IN ACCORDANCE WITH THE MUTCD, CURRENT EDITION.
- CONTRACTOR MUST SUBMIT A CONSTRUCTION SITE MANAGEMENT PLAN (CSMP) FOR REVIEW AND APPROVAL BY THE CITY CONSTRUCTION SERVICES FOREMAN PRIOR TO START OF CONSTRUCTION. THE CSMP MUST BE MAINTAINED ON-SITE AND UPDATED AS NEEDED TO REFLECT CURRENT CONDITIONS.
- THE FOLLOWING PRIVATE IMPROVEMENTS REQUIRE CONSTRUCTION OBSERVATION PER THE CITY'S ENGINEERING SERVICES SPECIFICATION: NONE.
- RECORD DRAWINGS ARE REQUIRED FOR: STORM SEWER

GRADING

- GRADING SHALL OCCUR WITHIN THE PROPERTY LIMITS. WHERE OFF-SITE WORK IS APPROVED, WRITTEN PERMISSION OF THE ADJACENT PROPERTY OWNER MUST BE OBTAINED PRIOR TO ANY OFF-SITE GRADING OR CONSTRUCTION.
- NO WORK SHALL OCCUR IN WETLANDS OR FLOODPLAINS WITHOUT APPROPRIATE PERMITS. ANY WORK SHALL BE IN ACCORDANCE WITH THE ISSUED PERMITS.
- VEGETATED SLOPES GREATER THAN 2:1 REQUIRE SOIL STABILIZATION.

EROSION CONTROL

- CONTRACTOR SHALL SUBMIT A CONSTRUCTION SITE MANAGEMENT PLAN (CSMP) TO THE CITY FOR APPROVAL PRIOR TO BUILDING PERMIT ISSUANCE.
- CONTRACTOR SHALL WORK IN A MANNER THAT MINIMIZES THE POTENTIAL FOR EROSION.
- CONTRACTOR SHALL BE RESPONSIBLE FOR INSTALLING, INSPECTING, AND MAINTAINING ALL NECESSARY EROSION AND SEDIMENT CONTROL DURING CONSTRUCTION AND REMOVING EROSION CONTROL WHEN PROJECT IS COMPLETE AND VEGETATION IS ESTABLISHED.
- ANY AREA DISTURBED BY CONSTRUCTION AND NOT PAVED OR NATURAL ROCK SURFACE SHALL BE REVEGETATED WITHIN ONE CONSTRUCTION SEASON.

PAVING

- PAVING OF PUBLIC STREETS SHALL NOT START UNTIL SUB GRADE COMPACTION AND MATERIAL TESTS ARE TAKEN AND ACCEPTED BY THE PUBLIC WORKS DIRECTOR.
- EXISTING ASPHALT PAVEMENT SHALL BE STRAIGHT SAW CUT WHEN ADJOINING WITH NEW ASPHALT PAVEMENT OR WHEN ACCESS TO UNDERGROUND UTILITIES IS REQUIRED. TACK COAT SHALL BE APPLIED TO ALL EXPOSED SURFACES INCLUDING SAW CUTS, POTHOLES, TRENCHES, AND ASPHALT OVERLAY. ASPHALT PATCHES IN THE RIGHT-OF-WAY SHALL BE PER CITY SPECIFICATIONS.
- ADJUST RIMS OF CLEANOUTS, MANHOLES, VALVE COVERS TO FINAL GRADE.
- CONTRACTOR TO CONTACT CITY STREETS SUPERINTENDENT AT (970) 879-1807 TO SCHEDULE INSTALLATION OF PUBLIC STREET SIGNS. ALL OTHER TRAFFIC CONTROL SIGNS ARE THE RESPONSIBILITY OF THE CONTRACTOR.

PROJECT GENERAL NOTES

- UNLESS OTHERWISE SPECIFIED, THE CONTRACTOR SHALL BE RESPONSIBLE FOR HIS OWN CONSTRUCTION STAKING. THE CONTRACTOR SHALL FURTHER BE RESPONSIBLE FOR THE ACCURACY OF ALL STAKING IN ACCORDANCE WITH THE APPROVED PLANS. IN THE EVENT THAT DISCREPANCIES ARE FOUND, THE CONTRACTOR SHALL IMMEDIATELY NOTIFY THE ENGINEER OR PROJECT MANAGER PRIOR TO COMMENCING WITH CONSTRUCTION OPERATIONS.
- THE CONTRACTOR SHALL NOTIFY THE OWNER AND ENGINEER OF ANY PROBLEM IN CONFORMING TO THE APPROVED PLANS FOR ANY ELEMENT OF THE PROPOSED IMPROVEMENTS PRIOR TO ITS CONSTRUCTION.
- ANY COMPONENTS OF WORK NOT ADDRESSED BY CITY OF STEAMBOAT SPRINGS STANDARD SPECIFICATIONS SHALL CONFORM TO THE CDOT STANDARD SPECIFICATIONS FOR ROAD AND BRIDGE CONSTRUCTION, CURRENT EDITION. IN ADDITION TO CITY AND CDOT STANDARD SPECIFICATIONS, THE PROJECT SPECIAL PROVISIONS AND STANDARD SPECIAL PROVISIONS, CONTROL CONSTRUCTION OF THIS PROJECT.
- THE TEMPORARY CONSTRUCTION EASEMENTS ARE LIMITED TO SPECIFIC CONSTRUCTION ITEMS AND THE AREA IS TO BE RETURNED TO EXISTING CONDITION AS SOON AS POSSIBLE. THE AREAS ARE NOT TO BE USED FOR STORAGE OR PARKING.
- ALL TREES, BUSHES AND OTHER FIXED OBJECTS WITHIN THE LIMITS OF CONSTRUCTION AS NOTED ON THE PLANS SHALL BE REMOVED UNLESS OTHERWISE NOTED. ALL OTHER TREES AND BUSHES SHALL BE PROTECTED, UNLESS OTHERWISE NOTED.
- WATER SHALL BE USED AS A DUST PALLIATIVE WHERE REQUIRED. THE CONTRACTOR SHALL PROVIDE A WATER TRUCK ON-SITE FOR DUST CONTROL. WATER SHALL NOT BE PAID FOR SEPARATELY.
- THE CONTRACTOR SHALL KEEP THE WORK AREA DRY OF STANDING WATER AND SHALL KEEP THE EXCAVATION AREAS FREE FROM STORM RUN-OFF.
- THE CONTRACTOR SHALL BE RESPONSIBLE FOR THE ACCEPTANCE AND CONTROL OF ALL SURFACE AND SUBSURFACE DRAINAGE AND GROUNDWATER ENTERING THE PROJECT AREA. ANY DEWATERING NEEDED WILL NOT BE PAID FOR SEPARATELY, BUT SHALL BE INCLUDED IN THE WORK.
- THE PHYSICAL FEATURES AND EXISTING UTILITIES WITHIN THE LIMITS OF THE PROJECT HAVE BEEN SHOWN BASED ON THE BEST AVAILABLE INFORMATION AT THE TIME OF DESIGN. THE CONTRACTOR SHALL VERIFY AND BE RESPONSIBLE FOR ALL FEATURES AND EXISTING UTILITIES PRIOR TO BEGINNING ANY WORK.
- THE CONTRACTOR SHALL LIMIT CONSTRUCTION ACTIVITIES TO THOSE AREAS WITHIN THE CONSTRUCTION LIMITS AS SHOWN ON THE PLANS. ANY DISTURBANCE BEYOND THESE LIMITS SHALL BE RESTORED TO ORIGINAL CONDITION BY THE CONTRACTOR AT THE CONTRACTOR'S EXPENSE. CONSTRUCTION ACTIVITIES IN ADDITION TO NORMAL CONSTRUCTION PROCEDURE SHALL INCLUDE THE PARKING OF VEHICLES OR EQUIPMENT, DISPOSAL OF LITTER, AND ANY OTHER ACTION WHICH WOULD ALTER EXISTING CONDITIONS.
- ANY DAMAGE TO EXISTING FACILITIES SHALL BE REPAIRED IMMEDIATELY AND PRIOR TO CONTINUING OTHER WORK. ANY MUD OR OTHER MATERIAL TRACKED OR OTHERWISE DEPOSITED ON THE ROADWAY SHALL BE REMOVED DAILY OR AS ORDERED BY THE INSPECTOR.
- ANY MATERIALS REMOVED FROM THIS PROJECT WILL BE DISPOSED OF BY THE CONTRACTOR. AT THE CITY'S DISCRETION, SOME MATERIALS MAY REMAIN THE PROPERTY OF THE CITY OR THE ADJACENT PROPERTY OWNERS.
- THE CONTRACTOR SHALL PROVIDE AND MAINTAIN ACCESS TO PUBLIC STREETS AND PRIVATE PROPERTY ADJOINING THE PROJECT. THE CONTRACTOR WILL NOT BE ALLOWED TO SHUT OFF ACCESS TO ANY PROPERTY AND MUST COORDINATE HIS WORK WITH THE PROPERTY OWNERS.
- ONE-HALF INCH EXPANSION JOINT MATERIAL SHALL BE INSTALLED WHEN ABUTTING ANY EXISTING CONCRETE TO A FIXED STRUCTURE. ZIP CAP SPACERS SHALL BE USED TO PROVIDE A CLEAN JOINT PRIOR TO CALKING.
- THE CONTRACTOR SHALL PROVIDE SHORING AT ALL LOCATIONS NECESSARY TO SUPPORT THE EARTH AND/OR ROADWAY ADJACENT TO AN EXCAVATION, EMBANKMENT, OR OTHER CONSTRUCTION OPERATION. LOCATIONS SHALL BE AS DETERMINED BY THE CONTRACTOR'S SEQUENCE OF OPERATIONS AND TRAFFIC CONTROL ARRANGEMENTS. SHORING SHALL NOT BE PAID FOR SEPARATELY, BUT SHALL BE INCLUDED IN THE WORK.
- CONTRACTOR IS RESPONSIBLE FOR DETERMINING AND OBTAINING A SUITABLE STAGING AREA.
- WITH NOTIFICATION OF THE RESPECTIVE OWNER, ADJUST RIMS OF ALL MANHOLES, CLEANOUTS, VALVE BOXES AND SURVEY MONUMENTS TO FINISH GRADE PRIOR TO FINAL PAVEMENT LIFT.
- THE CONTRACTOR SHALL BE RESPONSIBLE FOR AND PAY FOR ALL TESTING. ALL SUBGRADE, CONCRETE, AND ASPHALTIC PAVEMENT TESTING SHALL CONFORM TO THE STEAMBOAT SPRINGS STANDARD SPECIFICATIONS. ALL TEST RESULTS SHALL BE FORWARDED TO THE ENGINEER FOR HIS REVIEW AND APPROVAL.
- THE CONTRACTOR SHALL PROVIDE A MEDIUM BROOM FINISH ON ALL CONCRETE WALKS, RAMPS AND PAVING SURFACES.
- THE CONTRACTOR SHALL BE RESPONSIBLE FOR THE DEMOLITION AND REMOVAL OF ALL CONCRETE, FOUNDATIONS, WALKS, WALLS, TREES AND OTHER DEBRIS INDICATED ON THE SURVEY OR SPECIFIED IN THE SITE WORK SPECIFICATIONS. ALL SALVAGEABLE STORM SEWER GRATES, INLETS OR MANHOLE RING AND COVERS WHICH ARE NOT BEING RE-USED ON SITE SHALL BE RETURNED TO STEAMBOAT SPRINGS.
- THE CONTRACTOR SHALL PROTECT ALL STRUCTURES DURING THE CONSTRUCTION OF THIS PROJECT. THE CONTRACTOR SHALL BE LIABLE FOR ANY DAMAGE.
- THE CONTRACTOR SHALL BE RESPONSIBLE FOR ERECTING AND MAINTAINING BARRICADES AND OTHER TRAFFIC CONTROL DEVICES AS NECESSARY AROUND THE PERIMETER AND ADJACENT PUBLIC STREETS. THE CONTRACTOR SHALL BE REQUIRED TO COORDINATE WITH ALL BUSINESS OWNERS ON ANTICIPATED CLOSURE OF THE ACCESS POINTS ONTO ADJACENT PROPERTY. CONTRACTOR TO PROVIDE A TRAFFIC CONTROL PLAN TO THE CITY FOR REVIEW AND APPROVAL.
- THE CONTRACTOR SHALL BE RESPONSIBLE FOR ALL TRENCH BOX AND/OR SHORING DESIGN ASSOCIATED WITH ALL COMPONENTS OF THIS WORK.
- PHASE 1 PROJECT DISTURBANCE = 0.64 ACRES. PHASE 2 PROJECT DISTURBANCE = 1.32 ACRES. TOTAL PROJECT DISTURBANCE = 1.63 ACERS.

LEGEND

EXISTING LINETYPES	PROPOSED LINETYPES	
		MINOR CONTOUR (1' INTERVAL)
		MAJOR CONTOUR (5' INTERVAL)
		RIGHT-OF-WAY
		EASEMENT
		EDGE OF BUILDING
		BUILDING OVERHANG
		PHASE & APPROX. DISTURBANCE LIMITS
		ROADWAY CENTERLINE
		EDGE OF ASPHALT
		EDGE OF CONCRETE
		EDGE OF GRAVEL
		CURB AND GUTTER (SPILL/CATCH)
		WOOD FENCE
		DITCH FLOWLINE
		STORM SEWER
		WATER LINE
		SANITARY SEWER MAIN
		IRRIGATION LINE
		UNDERGROUND ELECTRIC
		UNDERGROUND TELEPHONE
		CABLE TV
		FIBER OPTIC

EXISTING SYMBOLS	PROPOSED SYMBOLS	
		SPOT ELEVATION
		NOMINAL SLOPE ON CUT OR FILL
		FLOW DIRECTION, TYPICALLY IN GRASSED SWALE
		FLOW DIRECTION, TYPICALLY ON PAVED SURFACES
		FIRE HYDRANT
		WATER VALVE
		SANITARY MANHOLE
		TYPE '13' VALLEY INLET
		METAL FLARED END SECTION
		LIGHT POLE
		ELECTRIC PEDESTAL
		CONIFEROUS TREE
		DECIDUOUS TREE
		SIGN
		IRRIGATION BOX
		FIBER OPTIC MARKER
		TELEPHONE MANHOLE
		POLE MOUNTED LIGHT
		ELECTRICAL JUNCTION BOX

	SIDEWALK PAVING		EXISTING ASPHALT
	GRAVEL		PROPOSED ASPHALT
	WETLANDS		

STANDARD ABBREVIATIONS

FL = FLOWLINE  
INV = INVERT  
TP = TOP OF PAVEMENT  
TC = TOP OF CONCRETE  
TO = TOP OF GRAVEL  
TBC = TOP BACK OF CURB  
HP = HIGH POINT  
LP = LOW POINT  
GB = GRADE BREAK  
EOA = EDGE OF ASPHALT  
EOG = EDGE OF GRAVEL  
TOW = TOP OF WALL  
BOW = BOTTOM OF WALL  
TOS = TOP OF STEP  
BOS = BOTTOM OF STEP  
ME = MATCH EXISTING  
CMP = CORRUGATED METAL PIPE  
HDPE = HIGH-DENSITY POLYETHYLENE  
BC = GRADE AT BUILDING CORNER  
SP = FINISH GRADE SPOT ELEVATION

RCRBD  
RECORD SET

BASELINE

Engineering - Planning - Surveying

419 OAK ST. • PO BOX 77052 • STEAMBOAT SPRINGS, CO 80477  
P. 970.879.025 • F. 303.940.9569 • www.baselinecorp.com

DESIGNED BY	SMB	DATE	5/3/18
DRAWN BY	SMB	PREPARED BY	CSR
CHECKED BY	CSR	REVISION	DESCRIPTION
		DESIGN TEAM	REVIEW/COORDINATION

CITY OF STEAMBOAT SPRINGS

STEAMBOAT SPRINGS

URAAC/SSRA ICONIC ENTRY  
MT. WERNER CIRCLE/MT. WERNER ROAD

ROUTT COUNTY

NOTES AND LEGEND

FOR AND ON BEHALF OF  
BASELINE CORPORATION

PROFESSIONAL ENGINEER

40319  
5/3/18

INITIAL SUBMITTAL 4/25/17

DRAWING SIZE 24" X 36"

SURVEY FIRM D&D, INC. SURVEY DATE 10/11/14

JOB NO. C020169

DRAWING NAME C020169 CD COVER.dwg

SHEET 2 OF 13



C:\C020169 Iconic Entry Drawings\C020169 CIVIL CDs.dwg, 5/3/2018 3:45:45 PM, Chris Rundell

● Etched polypropylene face  
● Face anchored in concrete  
● Ultra-violet inhibitor  
● Exceeds ASTM-D1693 Standards for Environmental Stress Cracking Resistance  
● Meets Caltrans #3 1/2 State Specifications

**R-Series Composite Lid No. N09R 20 lbs.**

**Electrical Box No. N09 BOX 90 lbs.**

**FL09T**

**N09J**

**B09-61D**

**N09-61J**

A high density reinforced concrete box with non-setting shoulders positioned to maintain grade and facilitate back filling. Approximate dimensions and weight shown.

Oldcastle Ordering Code	Item	Approx. Shipping Weight	Description
N09BOX	BOX	90 lbs.	N09 Electrical Box (10 1/4" x 16 3/4") - Meets #3-1/2 State Specifications - 28 per pallet
N09R	LID	20 lbs.	R-Series Composite Lid with Polypropylene Ring (Order N90 Bolt Down Kit Separately)
FL09T	LID	5 lbs.	Fibrelite Lid, Non-Concrete, Bolt Down (Order N90 Bolt Down Kit Separately)
N09J	LID	22 lbs.	Cast Iron Lid Bolt Down, (Order N90 Bolt Down Kit Separately)
B09-61D	COVER	22 lbs.	Steel Checker Plate Cover, Bolt Down (Order N90 Bolt Down Kit Separately)
N09-61J	COVER	22 lbs.	Steel Checker Plate Cover, Bolt Down (Order N90 Bolt Down Kit Separately)
B09X12	EXTENSION	87 lbs.	12" Reinforced Concrete Box Extension - 28 per pallet
B09SL	SLAB	32 lbs.	Reinforced Concrete Slab (13 3/4" x 19 1/4") Galvanizing available on all steel covers.

**Oldcastle Enclosure Solutions**

Phone: (800) 486-7070 Fax: (800) 486-6804  
Copyright © 2011 Oldcastle Precast Inc.

**N09 BOX**

FILE NAME: N09\_ISO  
ISSUE DATE: January, 2011  
www.oldcastleprecast.com

**N09 ELECTRICAL BOX 10-1/4" x 16-3/4"**

**CHRISTY**

2  
C3/C3 ELECTRICAL JUNCTION BOX  
NOT TO SCALE

21

Meter & meter panels are to be located as described by YVEA. They shall not be enclosed, covered or concealed. Violation shall result in Termination of service.


Yampa Valley Electric Assoc. INC  
Meter is to be installed in new meter pedestal installed by consumer next to transformer.  
This approval addresses only the meter and service location  
Approved: Scott Flowers 6/19/18

OWNER: MOUNTAIN MEADOWS PRESERVE, LLC

OWNER: RCS-WILDHORSE LAND, LLC

#### UTILITY NOTES:

1. ELECTRICAL CONDUIT ROUTING SHOWN ON THIS PLAN IS PRELIMINARY IN NATURE. CONTRACTOR TO COORDINATE WITH YVEA ON POWER FEED LOCATION AND METER LOCATIONS. CONDUIT ROUTING SHALL BE ADJUSTED ACCORDINGLY.
2. SEPARATE ELECTRICAL METERS ARE REQUIRED FOR THE ARNOLD BARN LIGHTING AND THE STEAMBOAT GRAND SIGN.

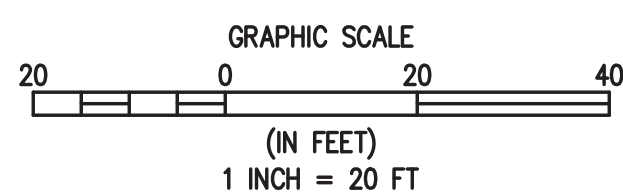

1  
C3/C3 PHASE 1 - SITE & UTILITY PLAN

RCRBD  
RECORD SET

**BASELINE**  
Engineering - Planning - Surveying  
419 OAK ST. • PO BOX 77052 • STEAMBOAT SPRINGS, CO 80477  
P. 970.879.825 • F. 303.940.9569 • www.baselinecorp.com

DESIGNED BY  
SMB  
DRAWN BY  
SMB  
CHECKED BY  
CSR

DATE  
5/3/18  
PREPARED BY  
CSR

REVISION DESCRIPTION  
DESIGN TEAM REVIEW/COORDINATION

CITY OF STEAMBOAT SPRINGS  
ROUTT COUNTY  
URAAC/SSRA ICONIC ENTRY  
MT. WERNER CIRCLE/MT. WERNER ROAD  
PHASE 1 - SITE & UTILITY PLAN

STEAMBOAT SPRINGS

PREPARED UNDER THE DIRECT SUPERVISION OF




FOR AND ON BEHALF OF  
BASELINE CORPORATION  
INITIAL SUBMITTAL 4/25/17  
DRAWING SIZE 24" x 36"  
SURVEY FIRM D&D, INC. SURVEY DATE 10/11/14  
JOB NO. C020169  
DRAWING NAME C020169 CIVIL CDs.dwg  
SHEET 3 OF 13

C3



O:\CO20169 Iconic Entry\Drawings\CO20169 CIVIL CDs.dwg, 5/3/2018 3:45:57 PM, Chris Rundall

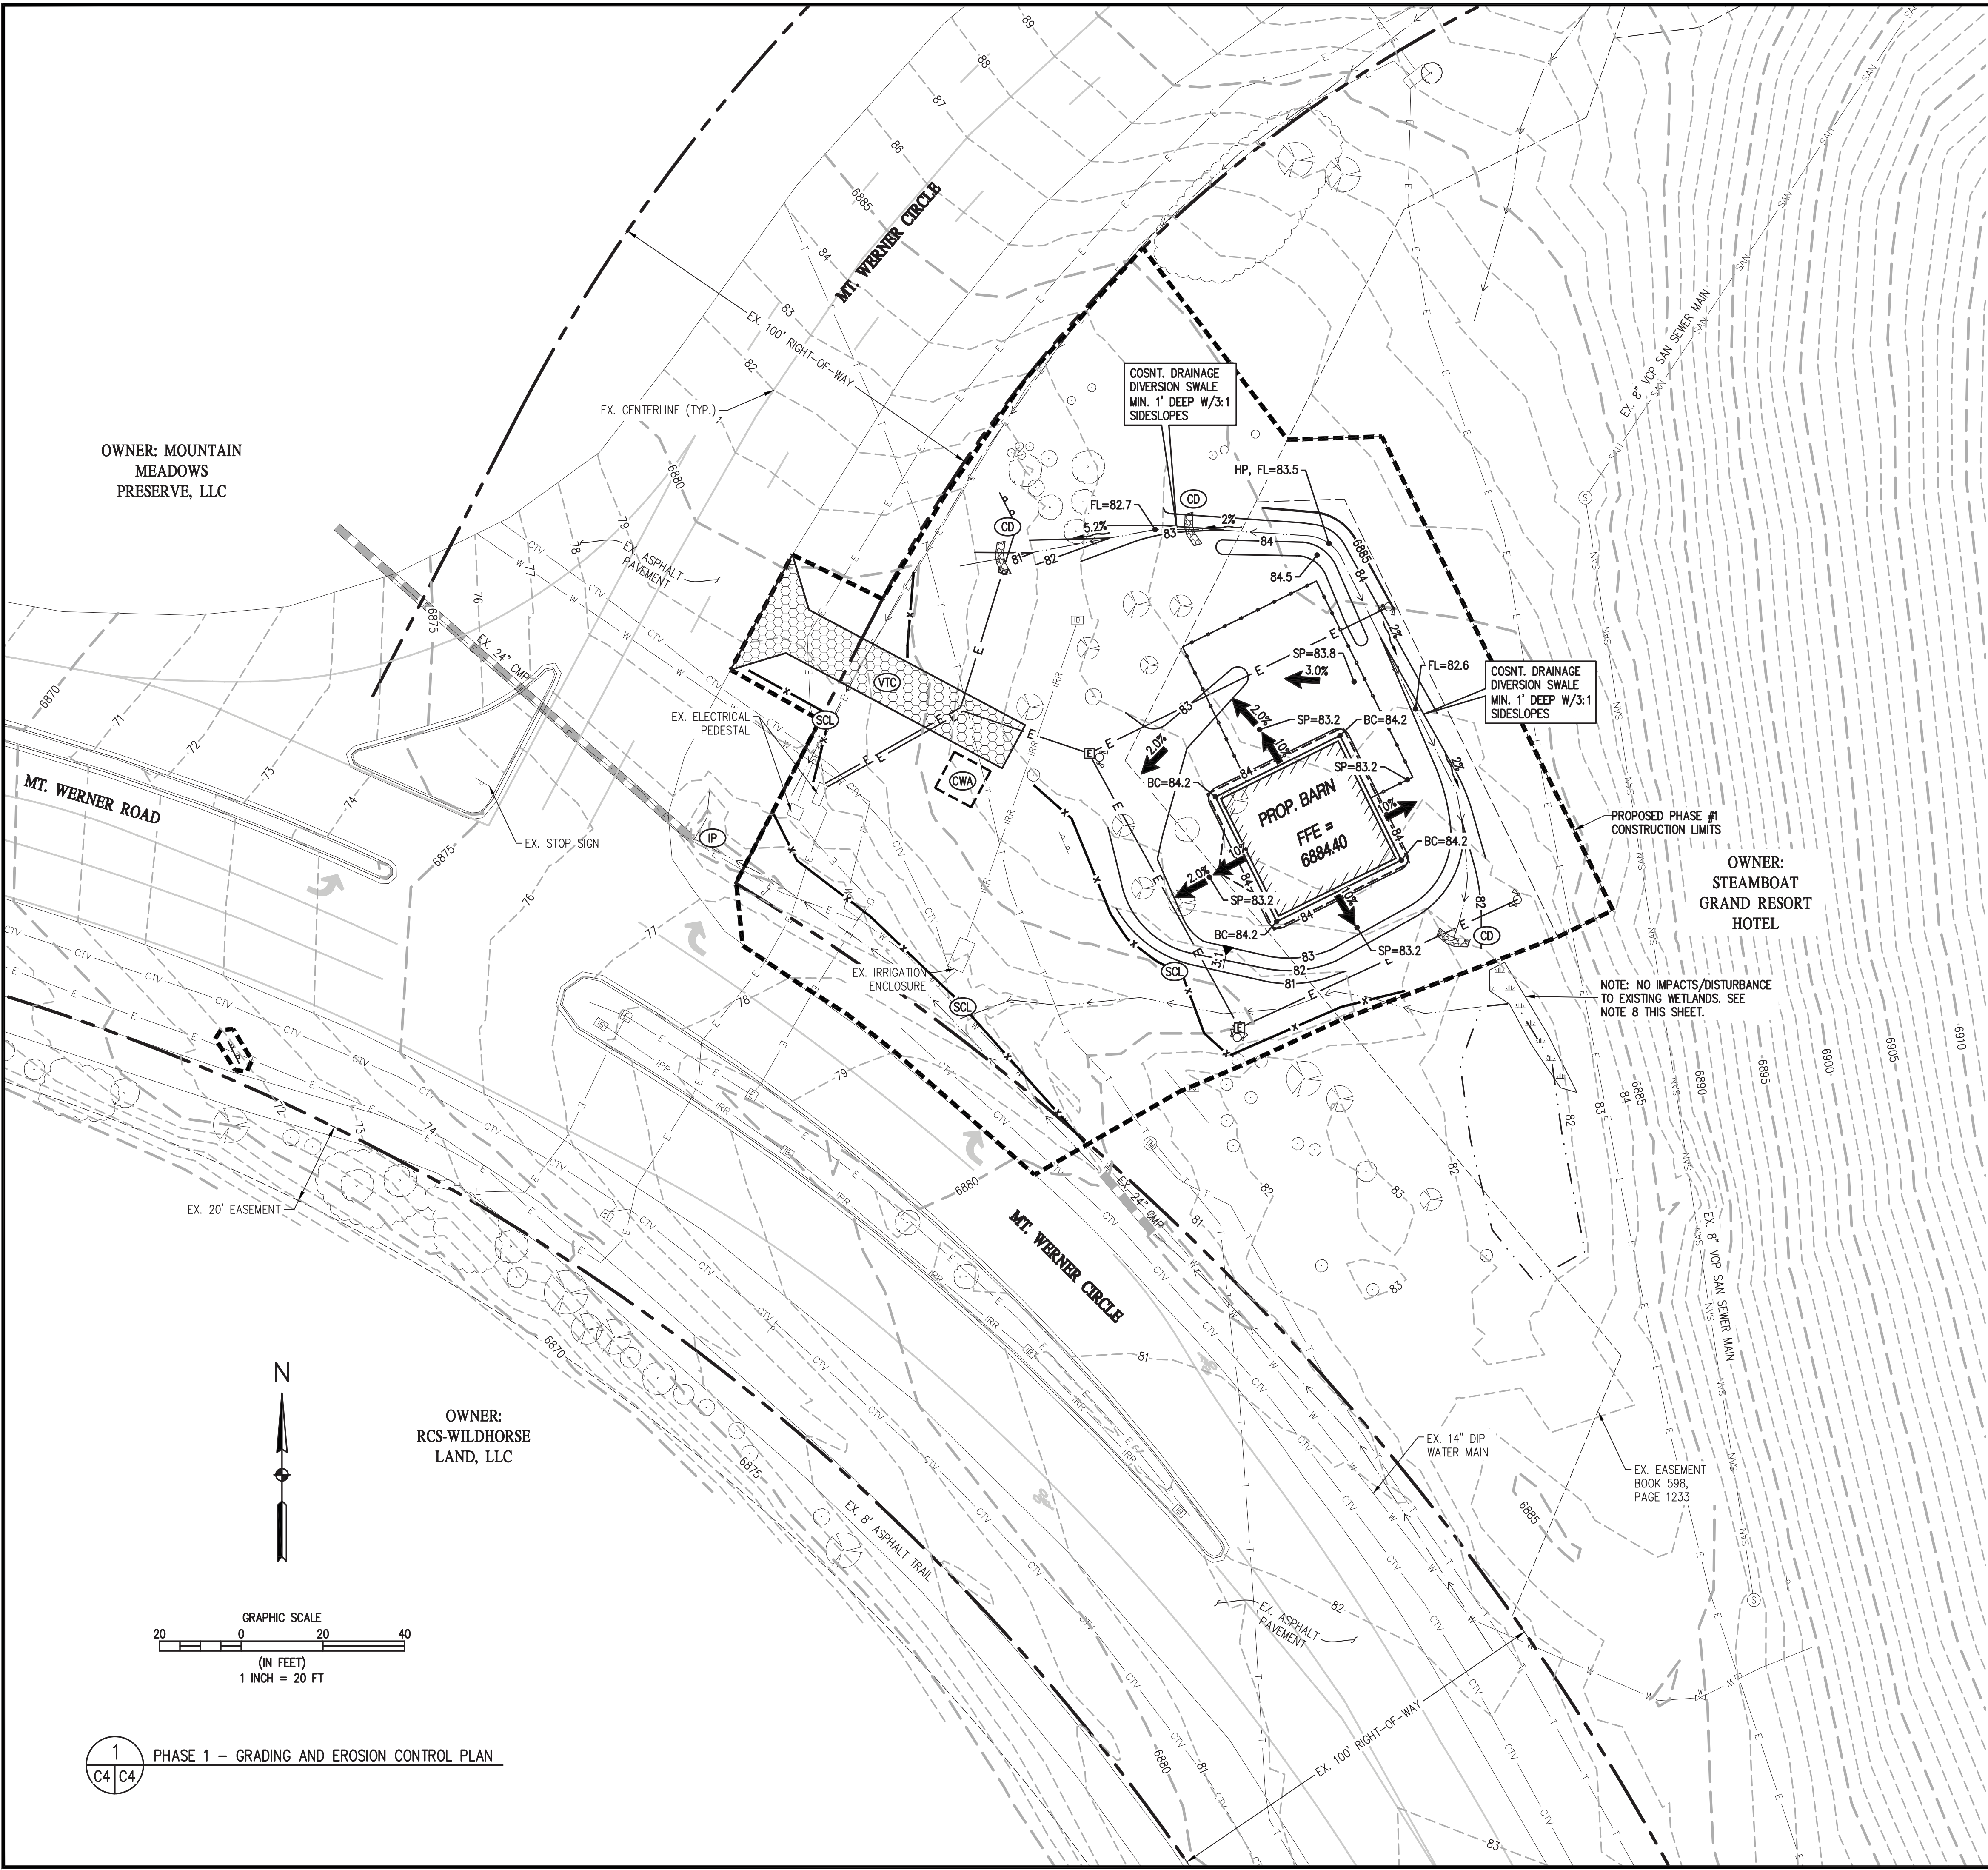

## RCRBD RECORD SET EROSION AND SEDIMENT CONTROL LEGEND

	INLET PROTECTION
	OUTLET PROTECTION
	ROCK SOCK
	VEHICLE TRACKING CONTROL
	LIMITS OF DISTURBANCE
	CONCRETE WASHOUT AREA
	STOCKPILE
	STABILIZED STORAGE AREA
	SEDIMENT CONTROL LOG
	EROSION CONTROL BLANKET
	ROCK CHECK DAM

### EROSION CONTROL NOTES:

- CONTRACTOR IS RESPONSIBLE TO LOCATE CONCRETE WASHOUT AREA, STOCKPILE LOCATION, AND STABILIZED STORAGE AREA WHERE IT WILL NOT INTERFERE WITH TRAFFIC AND ADJACENT PROPERTY OWNERS AND UPDATE THE PLAN ACCORDINGLY.
- ANY STOCKPILES SHALL HAVE A SEDIMENT CONTROL LOG OR SILT FENCE AROUND THE PERIMETER OF THE STOCKPILE.
- CONTRACTOR TO PLACE VEHICLE TRACKING CONTROL (VTC) AT ALL LOCATIONS WHERE THERE IS THE POTENTIAL TO TRACK MUD ON THE EXISTING PAVEMENT. VTC LOCATION TO BE COORDINATED WITH THE BUILDING MOVER.
- ROCK CHECK DAMS ARE TO REMAIN IN PLACE AS PERMANENT BMP.
- SILT FENCE MAY BE USED IN LIEU OF SEDIMENT CONTROL LOG.
- REFER TO LANDSCAPE PLANS FOR REVEGETATION AND PLANTINGS.
- CONTRACTOR TO COORDINATE ON EXACT LOCATION OF VEHICLE TRACKING CONTROL PAD WITH HOUSE MOVER AND OWNER'S REP. A TEMPORARY CULVERT MAY NECESSARY DEPENDING ON THE LOCATION. CONTRACTOR TO COORDINATE WITH ENGINEER.
- CONTRACTOR TO INSTALL TEMPORARY ORANGE CONSTRUCTION FENCING ALONG TEMPORARY CONSTRUCTION EASEMENT LINE IN THE AREA ADJACENT TO THE EXISTING WETLANDS TO DELINEATE DISTURBANCE AREA AND AVOID INADVERTENT IMPACTS TO WETLANDS.

CITY OF STEAMBOAT SPRINGS

ROUTE COUNTY

URAAC/SSRA ICONIC ENTRY

MT. WERNER CIRCLE/MT. WERNER ROAD

PHASE 1 – GRADING AND EROSION CONTROL PLAN

PREPARED UNDER THE DIRECT SUPERVISION OF



FOR AND ON BEHALF OF	BASELINE CORPORATION
INITIAL SUBMITTAL	4/25/17
DRAWING SIZE	24" X 36"
SURVEY FIRM	D&D, INC.
SURVEY DATE	10/11/14
JOB NO.	CO20169
DRAWING NAME	CO20169 CIVIL CDs.dwg
SHEET	4 OF 13

C4

**BASELINE**

Engineering - Planning - Surveying

419 OAK ST. • PO BOX 77052 • STEAMBOAT SPRINGS, CO 80477  
P. 970.679.025 • F. 303.940.9569 • www.baselinecorp.com

DESIGNED BY	SMB
DRAWN BY	SMB
CHECKED BY	CSR

DATE

5/3/18

PREPARED BY

CSR

DESIGN TEAM

REVIEW/COORDINATION

REVISION DESCRIPTION

DESIGN TEAM

REVIEW/COORDINATION

REVISION DESCRIPTION

DESIGN TEAM



O:\C020169 Iconic Entry Drawings\C020169 CIVIL CDs.dwg, 5/3/2018 3:46:02 PM, Chris Rundall

REGULATORY SIGN NOTES:


1. ALL SIGN POSTS SHALL BE 2-3/8" DIAMETER GALVANIZED STEEL WITH CAP. THE SIGN SUPPORT SHALL BE THE TUBULAR CONCRETE FOOTING WITH WEDGE SHOWN ON CDOT DETAIL S-614-8 SHEET 1.
2. ALL REGULATORY SIGNS SHALL BE HIGH INTENSITY PRISMATIC (HIP.) PEDESTRIAN CROSSING SIGN R1-6 SHALL BE FLUORESCENT GREEN DIAMOND GRADE.
3. ALL SIGN MATERIAL SHALL BE ALUMINUM (0.080").
4. THE SIZE OF THE INDIVIDUAL SIGNS ARE TO MEET THE "CONVENTIONAL ROAD SINGLE LANE" CATEGORY LISTED IN THE MUTCD TABLES 2B-1 AND 2C-2.

OWNER: MOUNTAIN MEADOWS PRESERVE, LLC

OWNER: STEAMBOAT GRAND RESORT HOTEL


OWNER: RCS-WILDHORSE LAND, LLC

SPEED LIMIT 25 R2-1

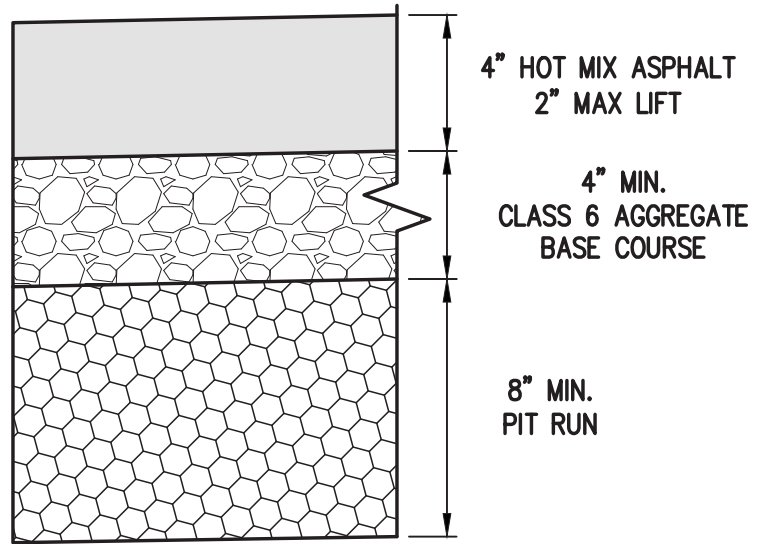

2 C5 C5

FLEXIBLE PAVEMENT SECTION NOT TO SCALE

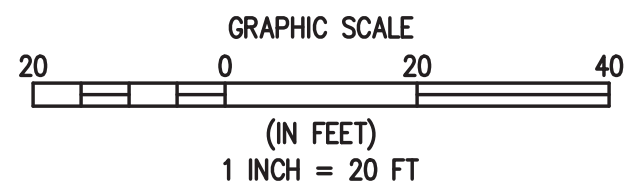

1 C5 C5

PHASE 2 - SITE PLAN

SITE PLAN NOTES:

1. RAILING AT STAIRS TO BE 1-3/4" ROUND OR SQUARE METAL TUBING - GALVANIZED OR POWDER COATED. RAILING SHALL MEET ALL BUILDING CODE REQUIREMENTS. CONTRACTOR TO SUBMIT SHOP DRAWING FOR REVIEW/APPROVAL.
2. ALL IMPROVEMENTS TO COMPLY WITH APPLICABLE CDOT M&S STANDARD DETAILS (M-603-4, M-608-1, ETC.)

RCRBD RECORD SET

BASELINE

Engineering - Planning - Surveying  
419 OAK ST. • PO BOX 77052 • STEAMBOAT SPRINGS, CO 80477  
P. 970.679.025 • F. 303.940.9569 • www.baselinecorp.com

DESIGNED BY SMB  
DRAWN BY SMB  
CHECKED BY CSR

DATE 5/3/18  
PREPARED BY CSR

REVISION DESCRIPTION  
DESIGN TEAM REVIEW/COORDINATION

CITY OF STEAMBOAT SPRINGS  
STEAMBOAT SPRINGS  
ROUTT COUNTY  
URAAC/SSRA ICONIC ENTRY  
MT. WERNER CIRCLE/MT. WERNER ROAD  
PHASE 2 - SITE PLAN



PREPARED UNDER THE DIRECT SUPERVISION OF



FOR AND ON BEHALF OF  
BASELINE CORPORATION  
INITIAL SUBMITTAL 4/25/17  
DRAWING SIZE 24" X 36"  
SURVEY FIRM D&D, INC. SURVEY DATE 10/11/14  
JOB NO. C020169  
DRAWING NAME C020169 CIVIL CDs.dwg  
SHEET 5 OF 13  
C5



N:\C020166 Ski Time Square Mt Werner Intersection Drawings\20169 TRAIL SITE PLAN.dwg, 5/3/2018 3:46:17 PM, Chris Rundell

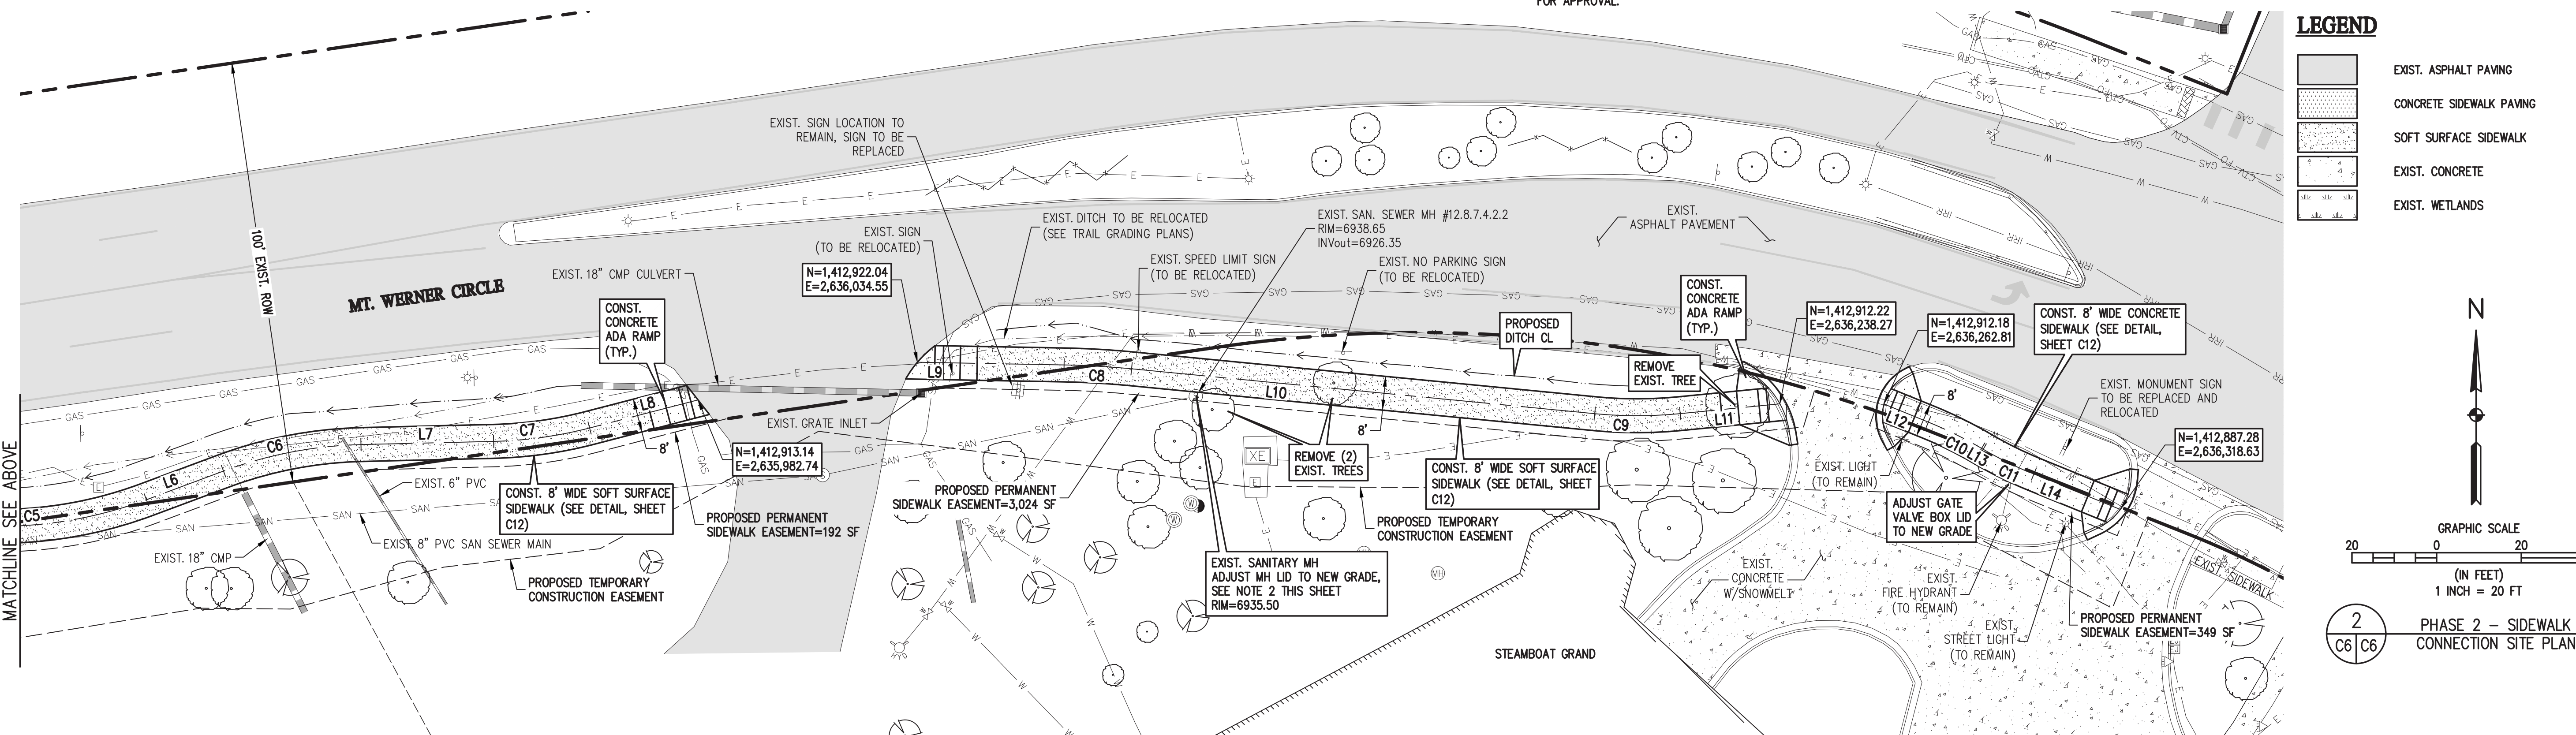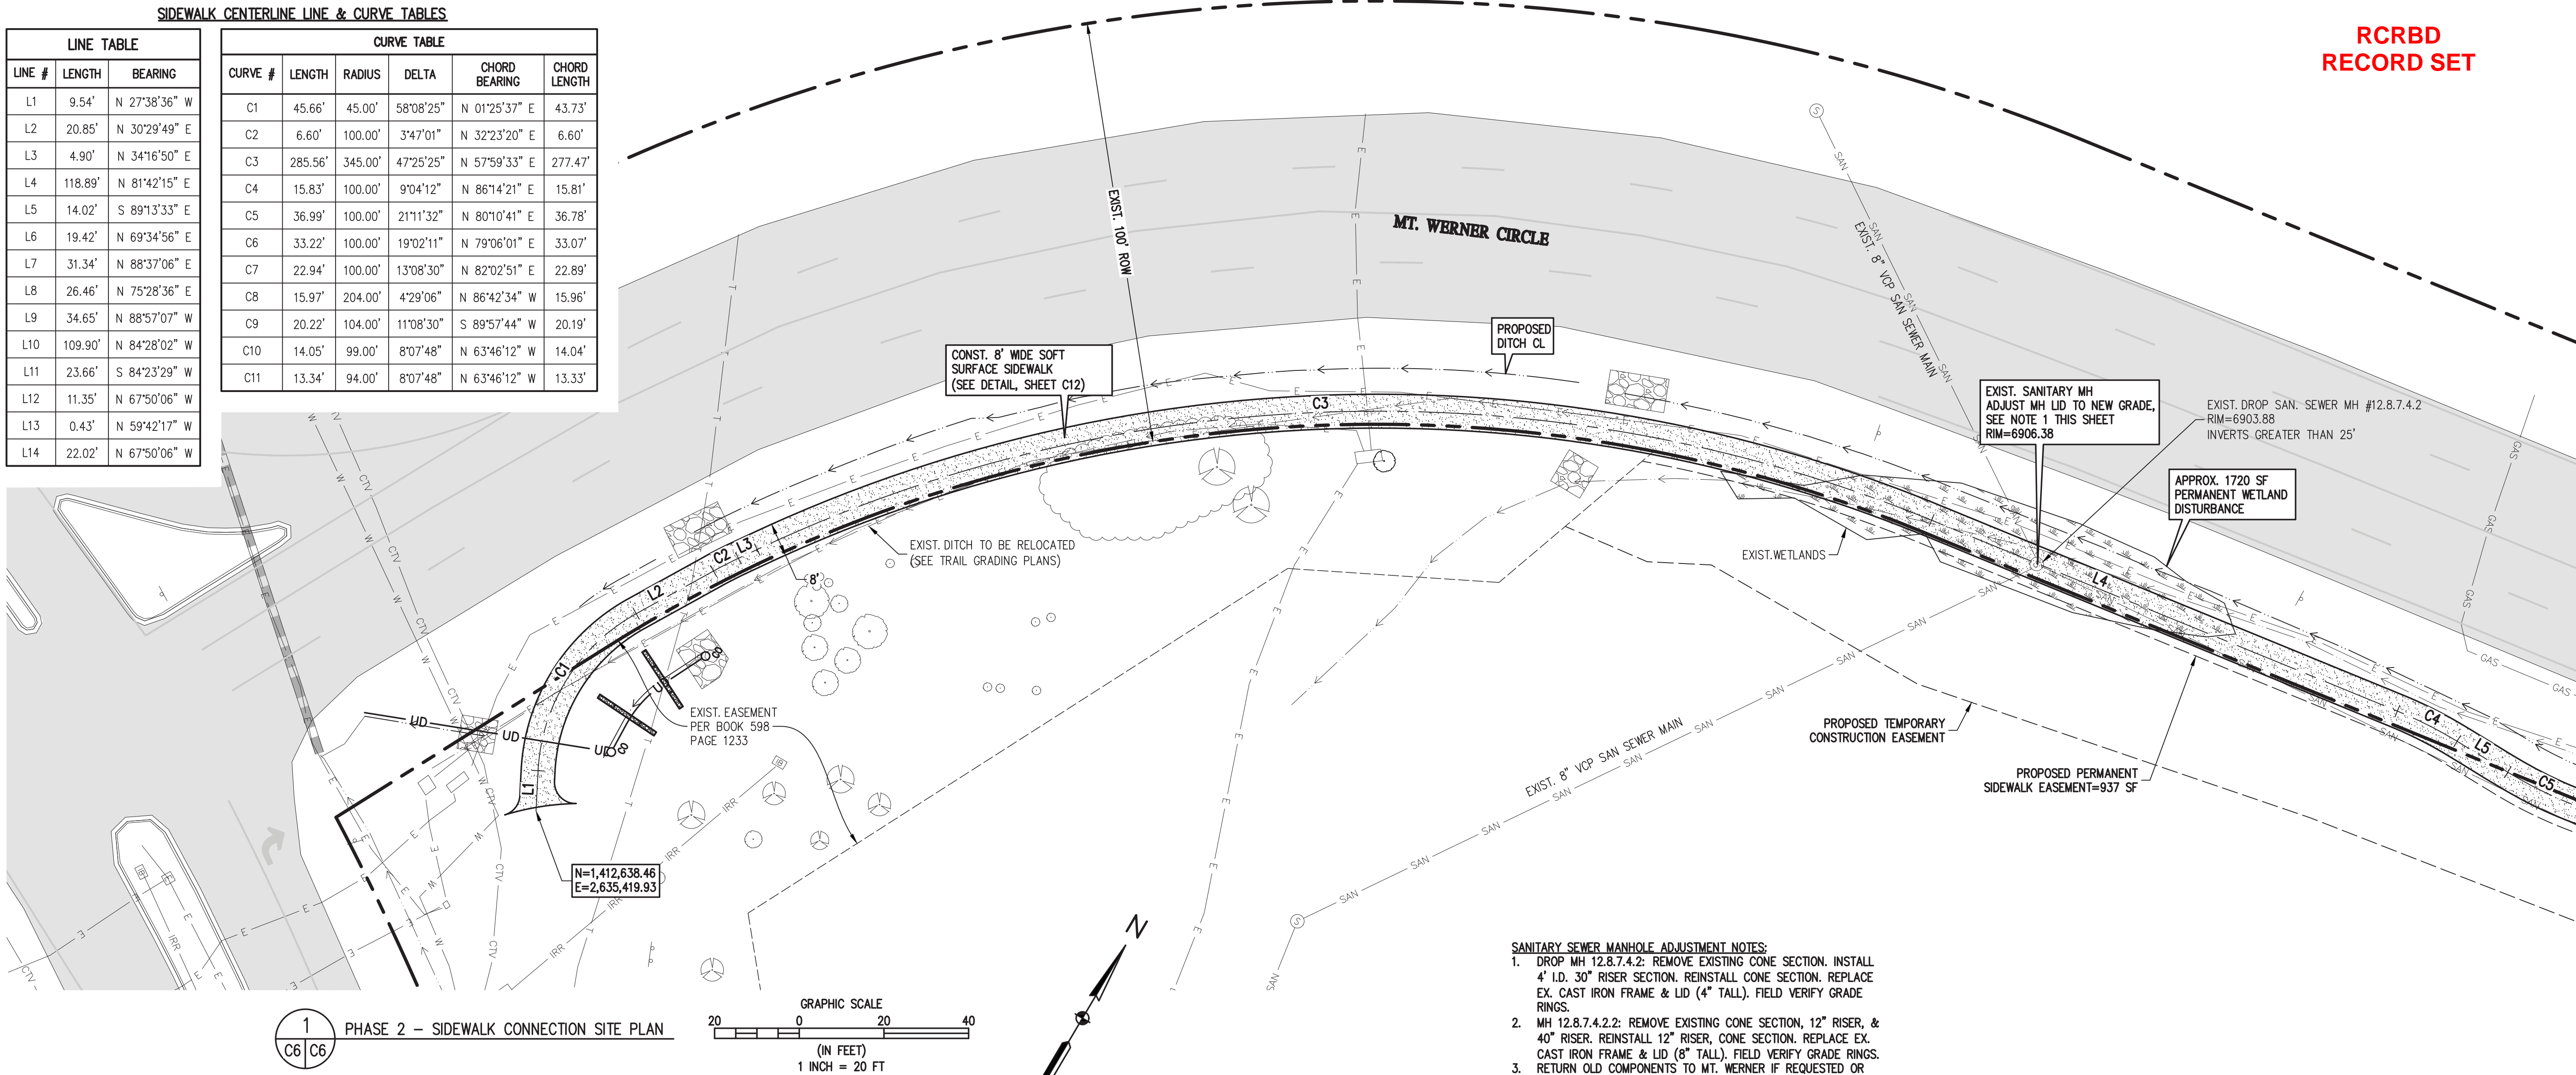

RCRBD  
RECORD SET

**BASELINE**  
Engineering - Planning - Surveying  
419 OAK ST. • PO BOX 77052 • STEAMBOAT SPRINGS, CO 80477  
P. 970.879.825 • F. 303.940.9569 • www.baselinecorp.com

DESIGNED BY	SMB
DRAWN BY	SMB
CHECKED BY	CSR
DATE	5/3/18
PREPARED BY	CSR
REVISION DESCRIPTION	DESIGN TEAM REVIEW/COORDINATION

**CITY OF STEAMBOAT SPRINGS**  
STEAMBOAT SPRINGS  
ROUTT COUNTY

**URAAC/SSRA ICONIC ENTRY**  
MT. WERNER CIRCLE/MT. WERNER ROAD  
PHASE 2 - SIDEWALK CONNECTION SITE PLAN

PREPARED UNDER THE DIRECT SUPERVISION OF

**PROFESSIONAL ENGINEER**  
40319  
5/3/18

FOR AND ON BEHALF OF  
BASELINE CORPORATION




INITIAL SUBMITTAL	4/25/17
DRAWING SIZE	24" X 36"
SURVEY FIRM	D&D, INC.
SURVEY DATE	10/11/14
JOB NO.	C020169
DRAWING NAME	20169 TRAIL SITE PLAN.dwg
SHEET	6 OF 13

C6



C:\CO20169 Iconic Entry Drawings\CO20169 CIVIL CDs.dwg, 5/3/2018 3:46:54 PM, Chris Rundell

OWNER: MOUNTAIN  
MEADOWS  
PRESERVE, LLC

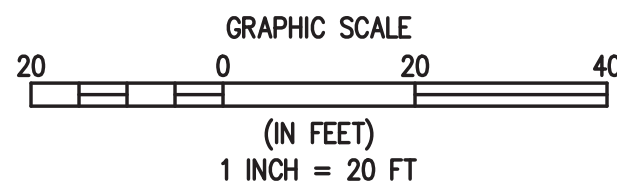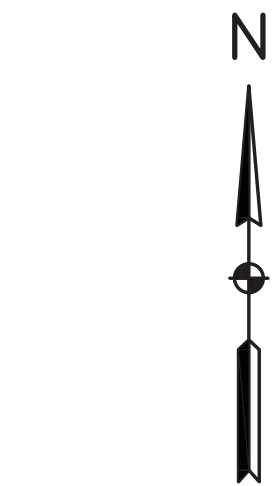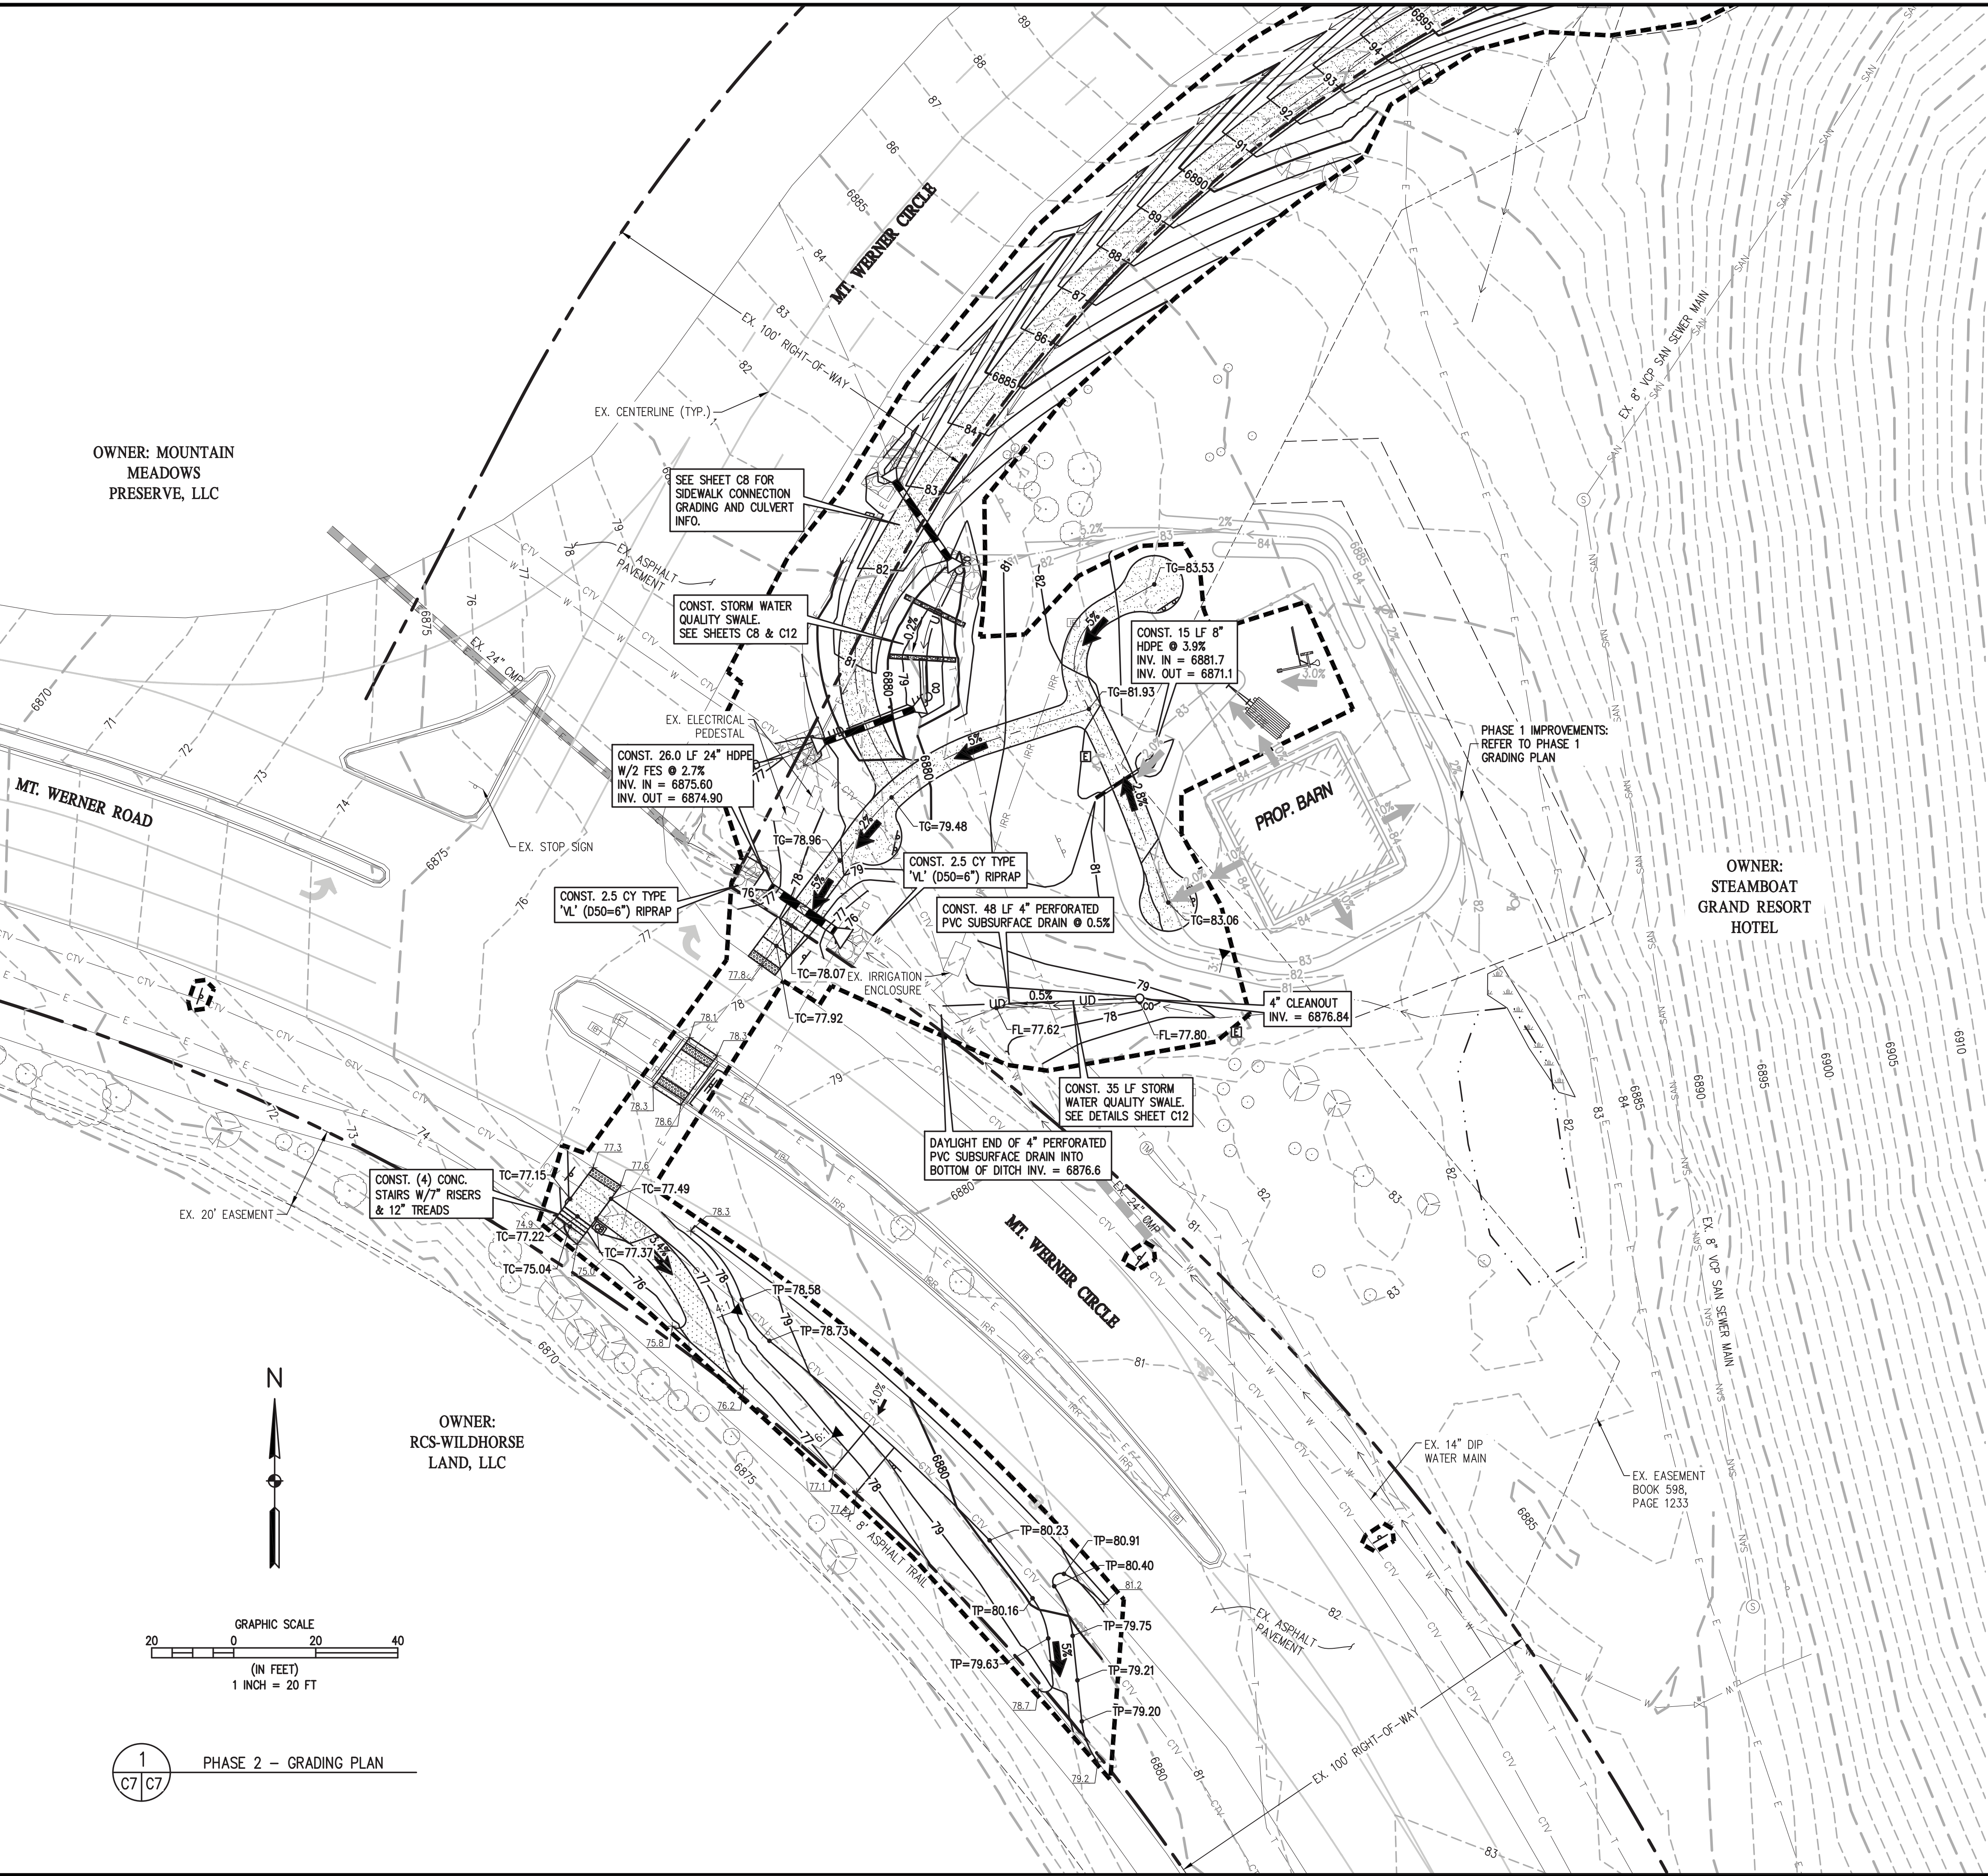

1  
C7/C7 PHASE 2 - GRADING PLAN

RCRBD  
RECORD SET

**BASELINE**

Engineering - Planning - Surveying  
419 OAK ST. • PO BOX 77052 • STEAMBOAT SPRINGS, CO 80477  
P. 970.879.825 • F. 303.940.9569 • www.baselinengr.com

DESIGNED BY  
SMB  
DRAWN BY  
SMB  
CHECKED BY  
CSR

DATE  
5/3/18  
PREPARED BY  
CSR

REVISION DESCRIPTION  
DESIGN TEAM REVIEW/COORDINATION

CITY OF STEAMBOAT SPRINGS  
ROUTT COUNTY  
URAAC/SSRA ICONIC ENTRY  
MT. WERNER CIRCLE/MT. WERNER ROAD  
PHASE 2 - GRADING PLAN

STEAMBOAT SPRINGS

PREPARED UNDER THE DIRECT  
SUPERVISION OF





FOR AND ON BEHALF OF  
BASELINE CORPORATION  
INITIAL SUBMITTAL 4/25/17  
DRAWING SIZE 24" X 36"  
SURVEY FIRM SURVEY DATE  
D&D, INC. 10/11/14  
JOB NO. CO20169  
DRAWING NAME  
CO20169 CIVIL CDs.dwg  
SHEET 7 OF 13

C7



N:\C020166 Ski Time Square Mt Werner Intersection\Drawings\20169 TRAIL GRADING PLAN.dwg, 5/3/2018 3:47:14 PM, Chris Rundell

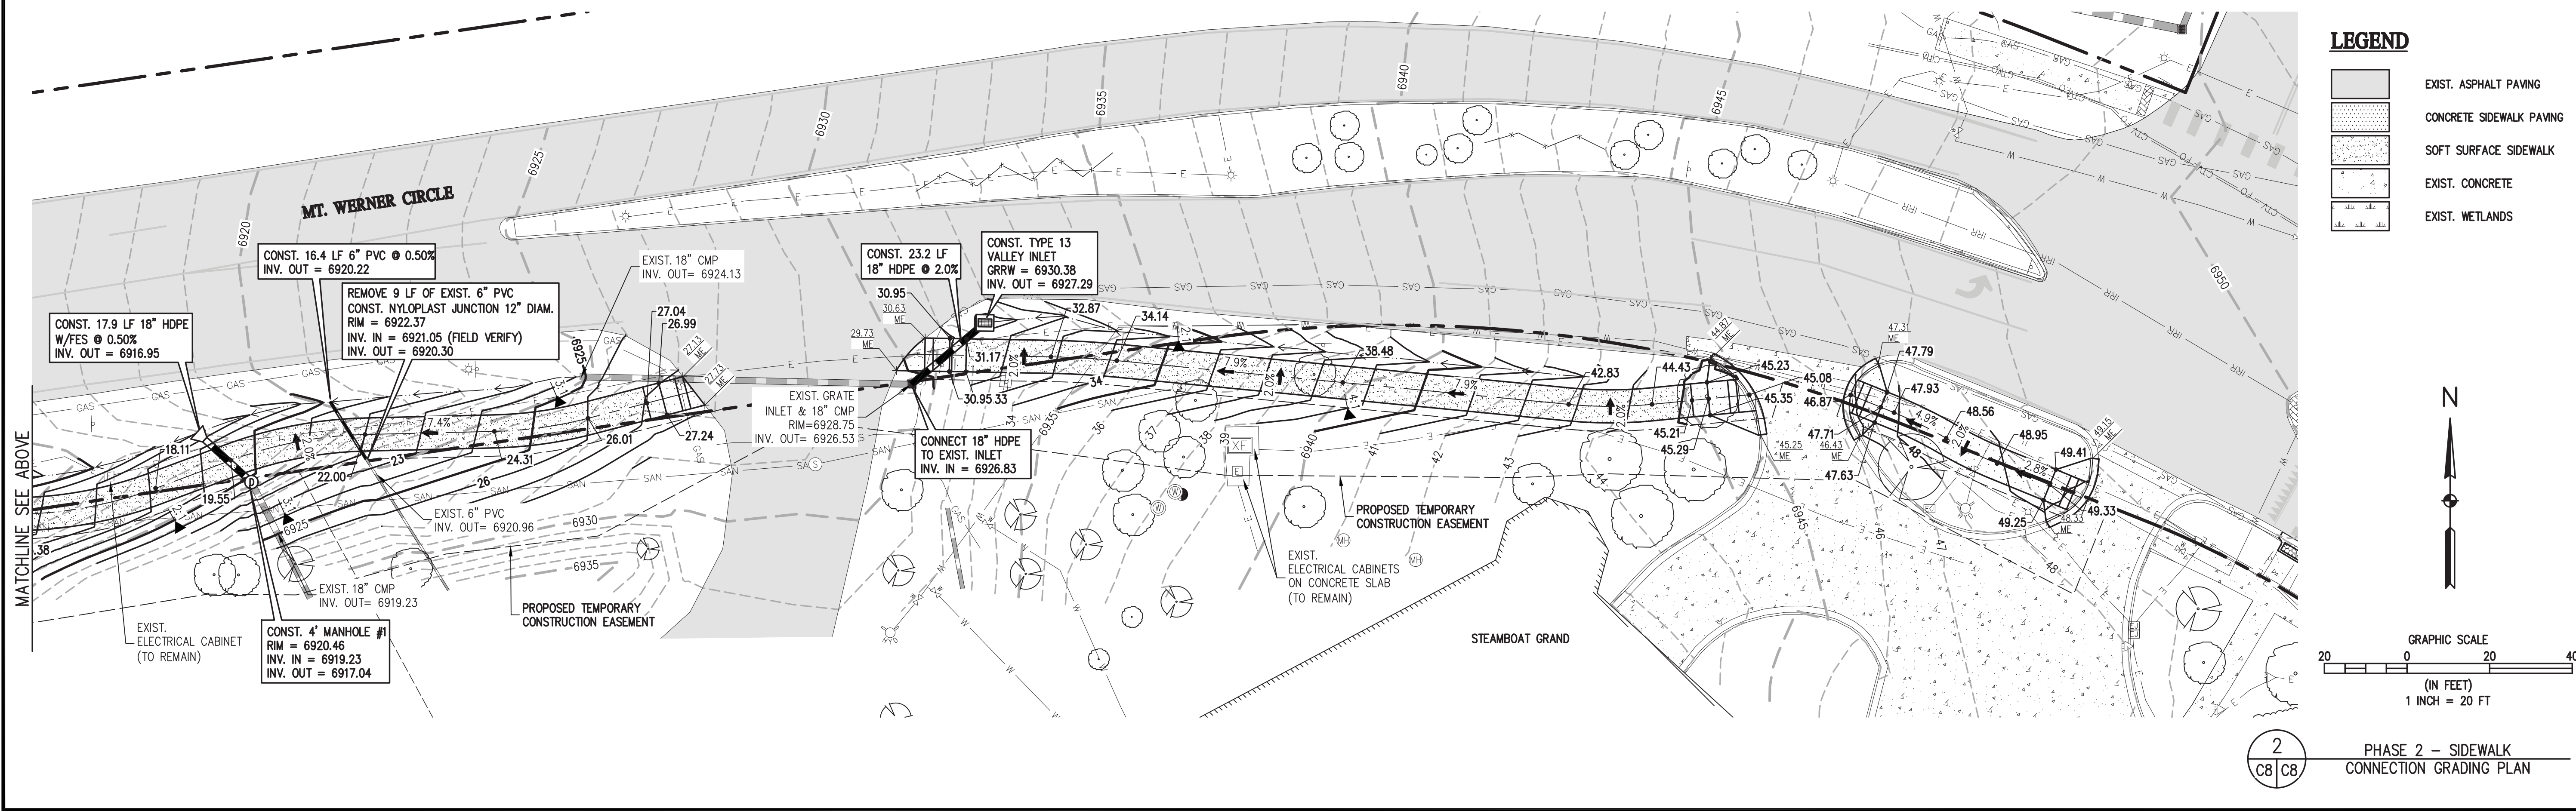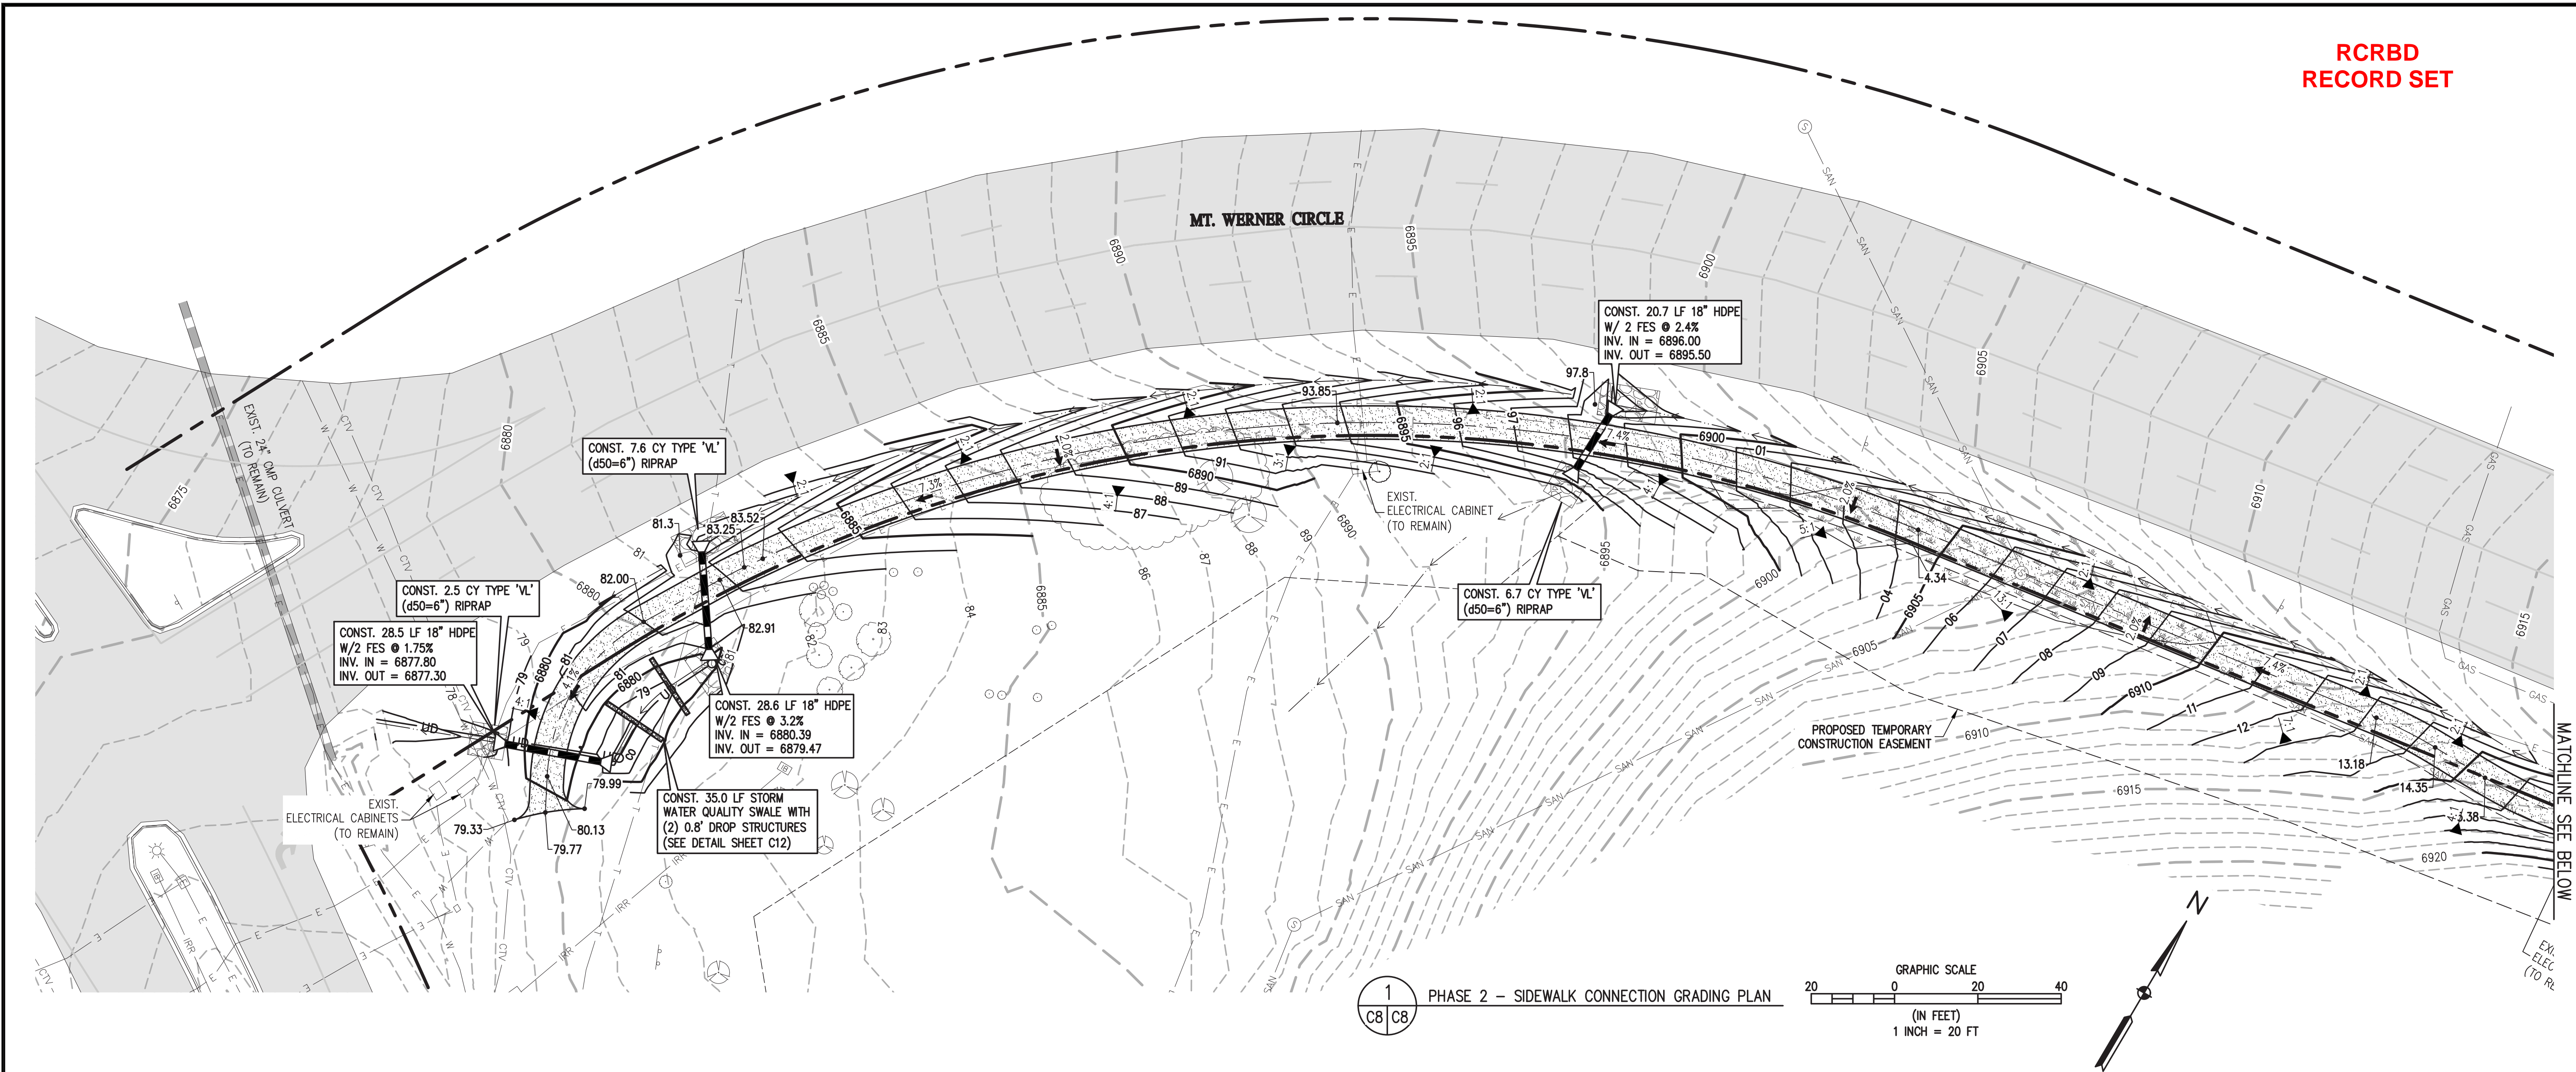

**BASELINE**  
Engineering - Planning - Surveying  
419 OAK ST. • PO BOX 77052 • STEAMBOAT SPRINGS, CO 80477  
P. 970791825 • F. 3033400869 • www.baselinecorp.com

DESIGNED BY	SMB	DATE	5/3/18
DRAWN BY	SMB	PREPARED BY	CSR
CHECKED BY	CSR	REVISION DESCRIPTION	DESIGN TEAM REVIEW/COORDINATION

CITY OF STEAMBOAT SPRINGS  
URAC/SSRA ICONIC ENTRY  
MT. WERNER CIRCLE/MT. WERNER ROAD  
PHASE 2 - SIDEWALK CONNECTION GRADING PLAN

ROUTE COUNTY

STEAMBOAT SPRINGS

PREPARED UNDER THE DIRECT SUPERVISION OF

COLORADO LICENSED PROFESSIONAL ENGINEER  
40319  
5/3/18

FOR AND ON BEHALF OF  
BASELINE CORPORATION

INITIAL SUBMITTAL 4/25/17

DRAWING SIZE 24" X 36"

SURVEY FIRM SURVEY DATE  
D&D, INC. 10/11/14

JOB NO. C020169

DRAWING NAME  
20169 TRAIL GRADING PLAN.dwg

SHEET 8 OF 13

C8








N:\C020166 Ski Time Square Mt Werner Intersection\Drawings\20169 TRAIL EC PLAN.dwg, 5/3/2018 3:48:07 PM, Chris Rundall

EROSION AND SEDIMENT CONTROL LEGEND



- IP INLET PROTECTION  
OP OUTLET PROTECTION  
RS ROCK SOCK  
VTC VEHICLE TRACKING CONTROL  
LOD LIMITS OF DISTURBANCE  
CWA CONCRETE WASHOUT AREA  
SP STOCKPILE  
SSA STABILIZED STORAGE AREA  
SCL SEDIMENT CONTROL LOG  
ECB EROSION CONTROL BLANKET  
CD ROCK CHECK DAM

EROSION CONTROL NOTES:

1. CONTRACTOR IS RESPONSIBLE TO LOCATE CONCRETE WASHOUT AREA, STOCKPILE LOCATION, AND STABILIZED STORAGE AREA WHERE IT WILL NOT INTERFERE WITH TRAFFIC AND ADJACENT PROPERTY OWNERS AND UPDATE THE PLAN ACCORDINGLY.  
2. ANY STOCKPILES SHALL HAVE A SEDIMENT CONTROL LOG OR SILT FENCE AROUND THE PERIMETER OF THE STOCKPILE.  
3. CONTRACTOR TO PLACE VEHICLE TRACKING CONTROL (VTC) AT ALL LOCATION WHERE THERE IS THE POTENTIAL TO TRACK MUD ON THE EXISTING PAVEMENT.  
4. ROCK CHECK DAMS ARE TO REMAIN IN PLACE AS PERMANENT BMP.  
5. SILT FENCE MAY BE USED IN LIEU OF SEDIMENT CONTROL LOG.

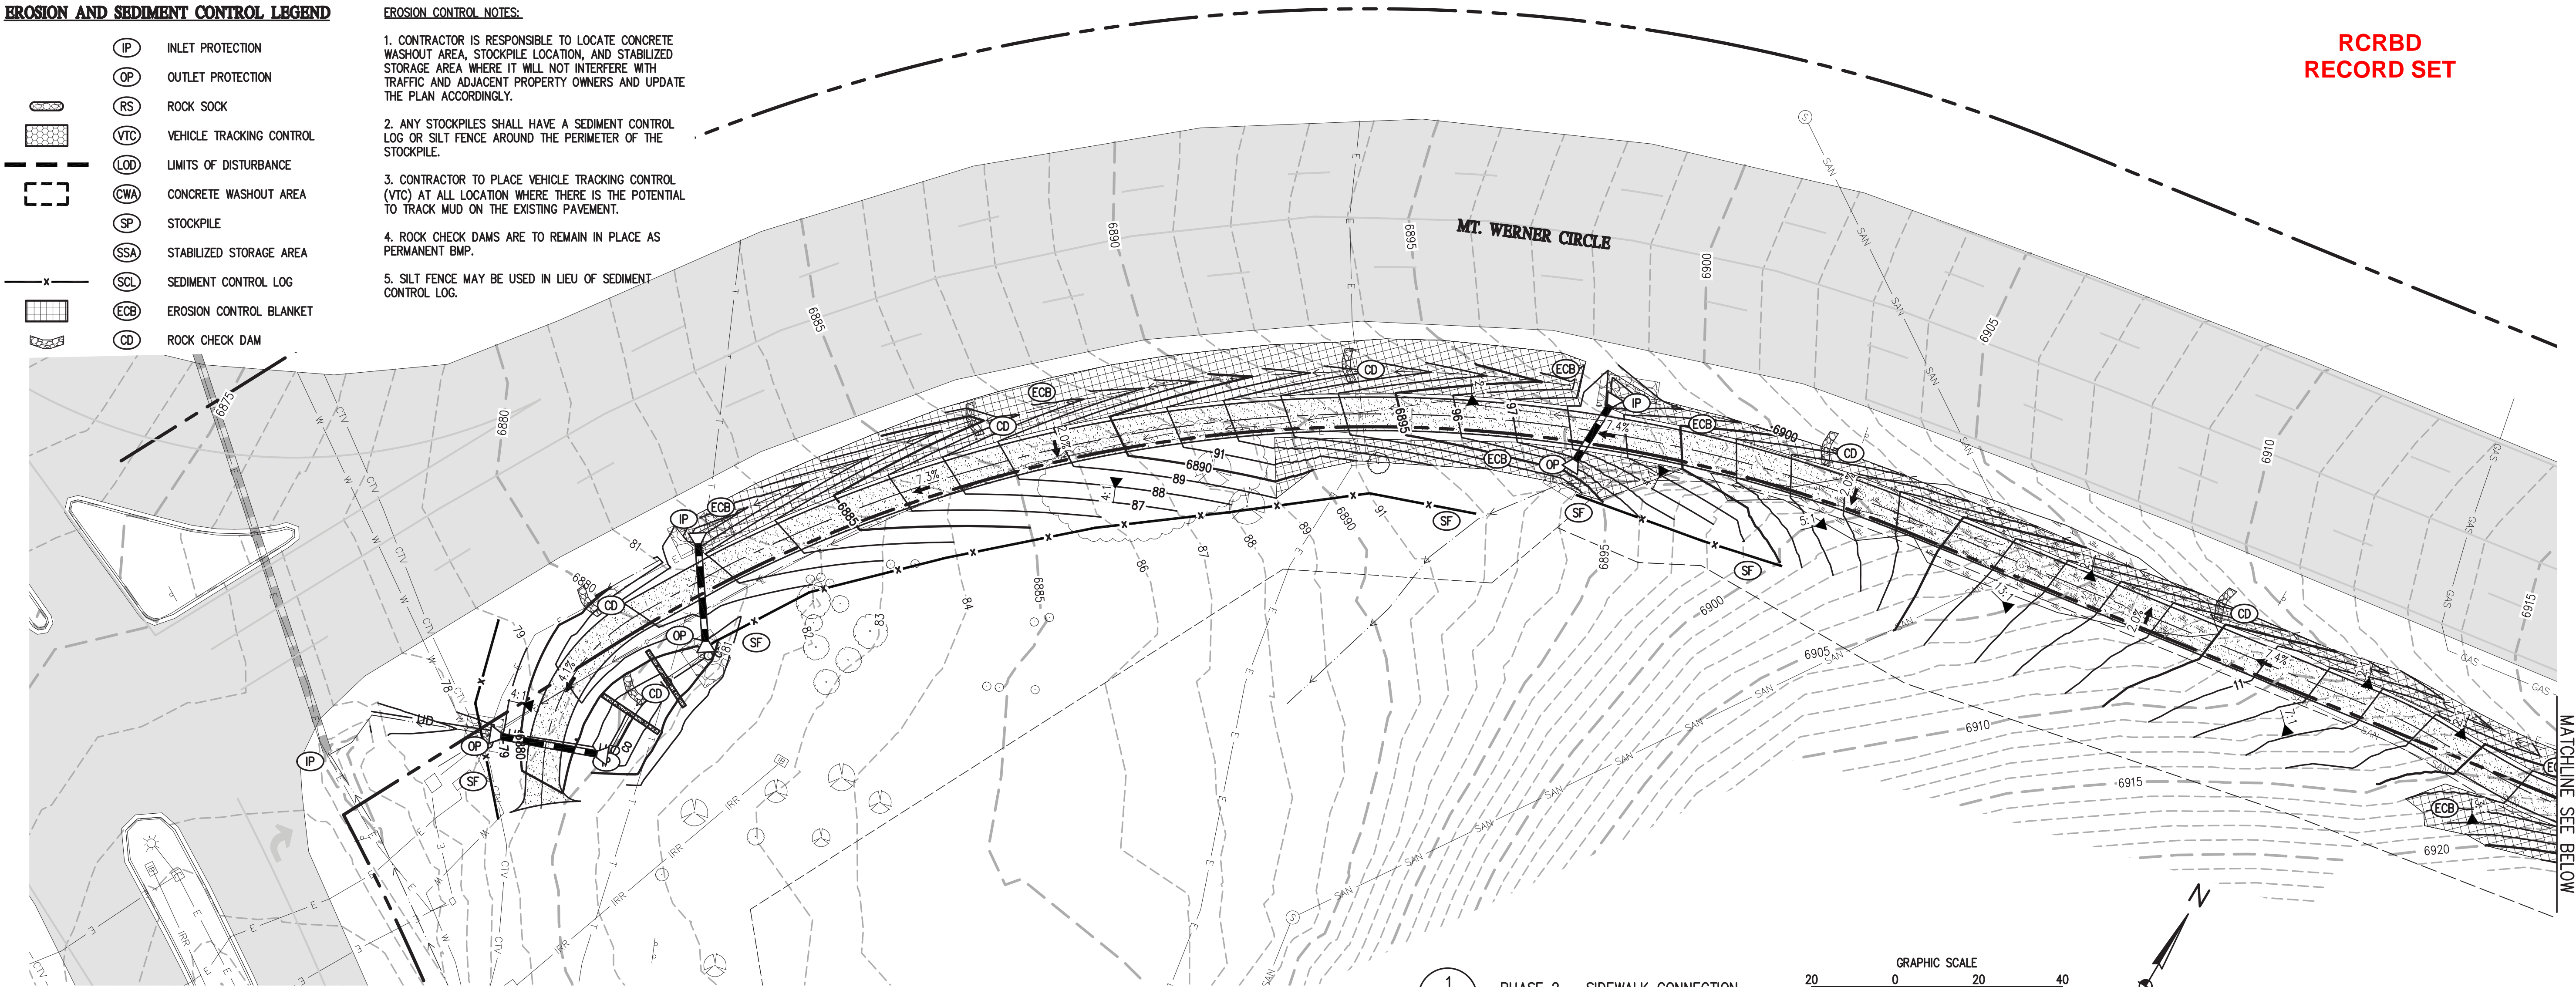


1 PHASE 2 - SIDEWALK CONNECTION  
C10 C10 EROSION CONTROL PLAN

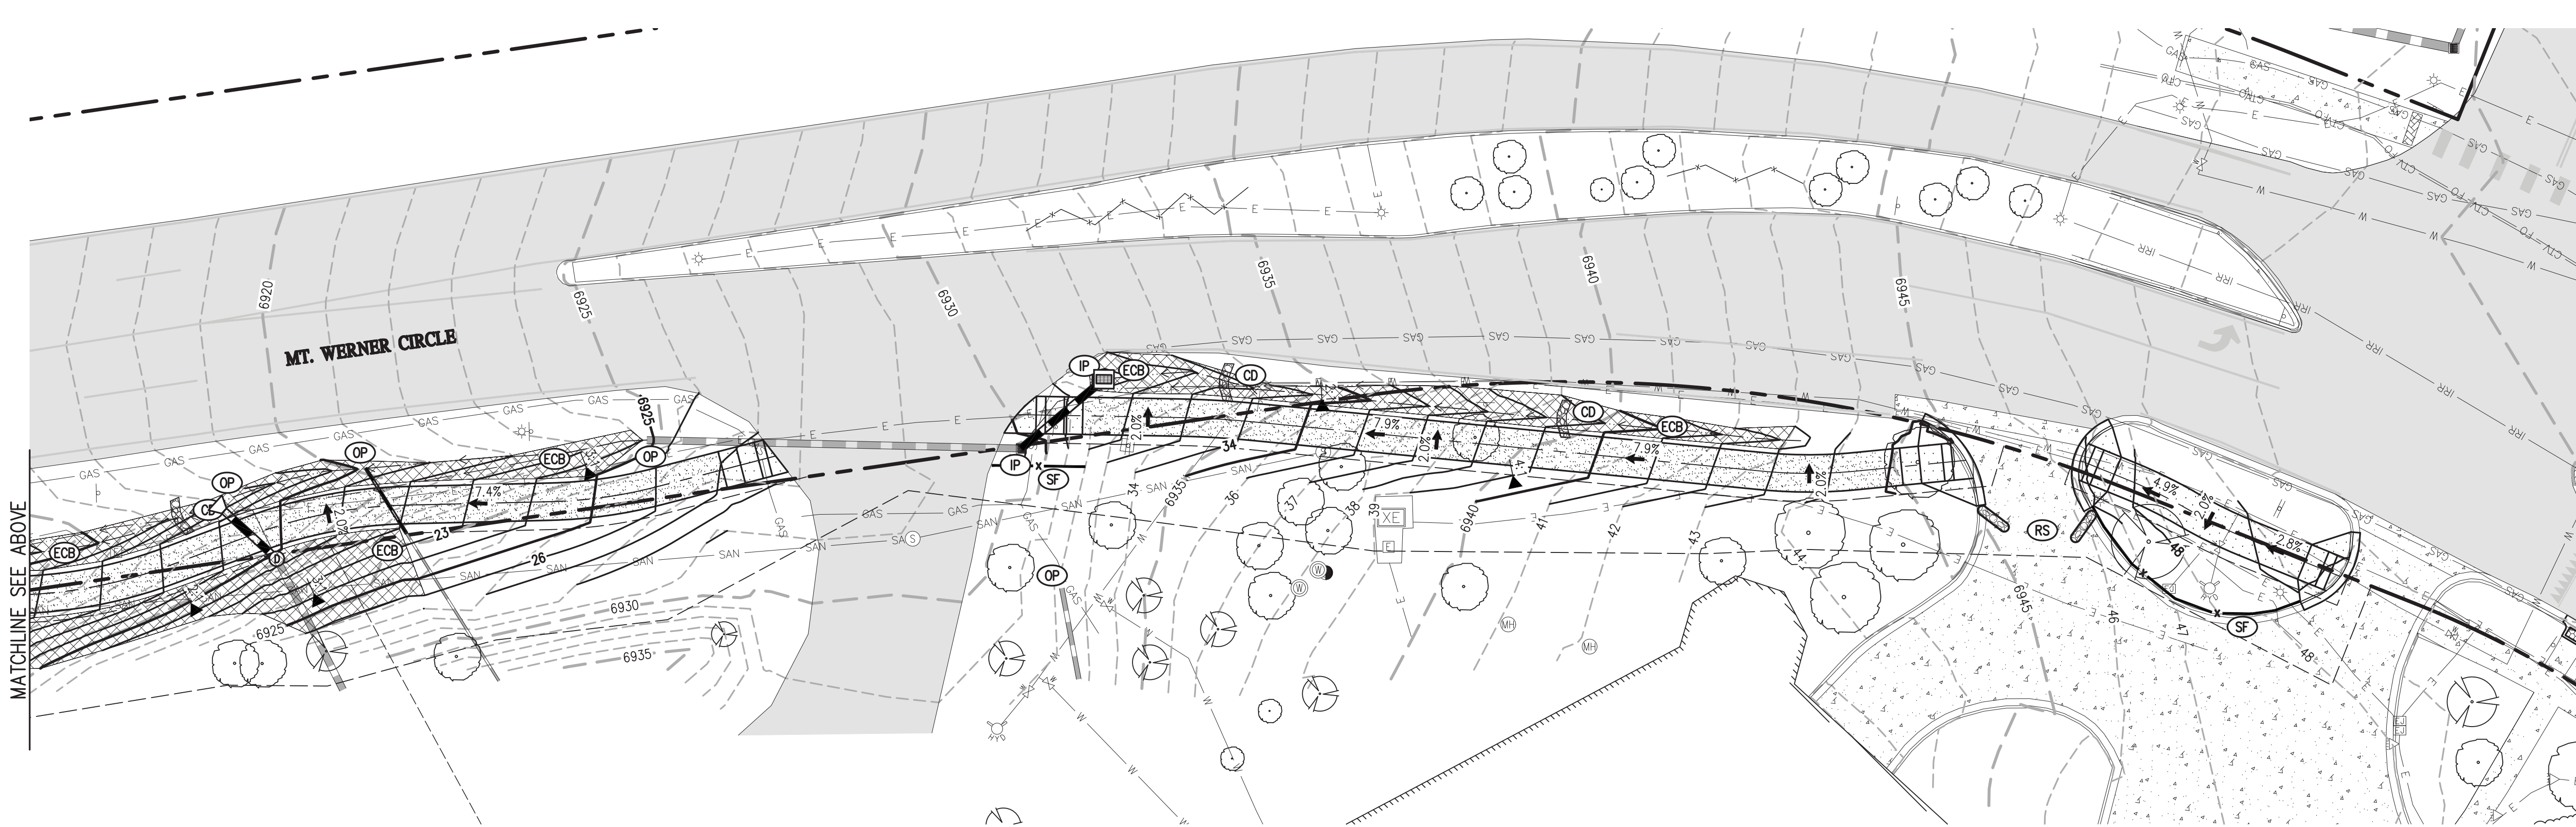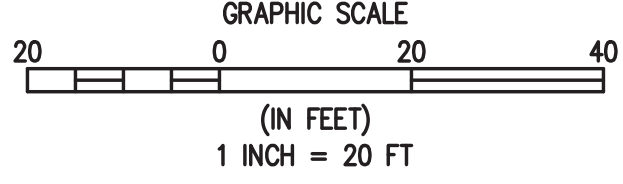

- LEGEND
- EXIST. ASPHALT PAVING  
CONCRETE SIDEWALK PAVING  
SOFT SURFACE SIDEWALK  
EXIST. CONCRETE  
EXIST. WETLANDS

2 PHASE 2 - SIDEWALK CONNECTION  
C10 C10 EROSION CONTROL PLAN

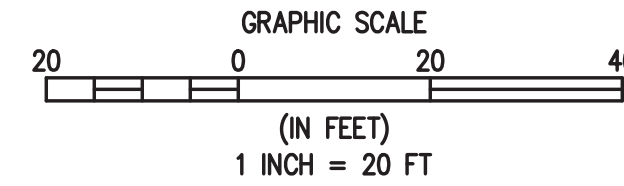

**BASELINE**  
Engineering - Planning - Surveying  
419 OAK ST. • PO BOX 77052 • STEAMBOAT SPRINGS, CO 80477  
P. 970.678.025 • F. 303.340.9569 • www.baselinecorp.com

DESIGNED BY	SMB
DRAWN BY	SMB
CHECKED BY	CSR
DATE	5/3/18
PREPARED BY	CSR
REVISION DESCRIPTION	DESIGN TEAM REVIEW/COORDINATION

CITY OF STEAMBOAT SPRINGS  
ROUTT COUNTY  
URAAC/SSRA ICONIC ENTRY  
MT. WERNER CIRCLE/MT. WERNER ROAD  
PHASE 2 - SIDEWALK CONNECTION EROSION CONTROL PLAN

PREPARED UNDER THE DIRECT SUPERVISION OF

COLORADO LICENSED  
SURVEYOR & ENGINEER  
40319  
5/3/18  
PROFESSIONAL ENGINEER

FOR AND ON BEHALF OF  
BASELINE CORPORATION

INITIAL SUBMITTAL	4/25/17
DRAWING SIZE	24" X 36"
SURVEY FIRM	D&D, INC.
SURVEY DATE	10/11/14
JOB NO.	C020169
DRAWING NAME	20169 TRAIL EC PLAN.dwg
SHEET	10 OF 13

C10



EROSION AND SEDIMENT CONTROL PLAN GENERAL NOTES:

1. THE DISTURBANCE AREA FOR THE PROJECT IS GREATER THAN ONE ACRE; THEREFORE, A STATE OF COLORADO CONSTRUCTION STORMWATER DISCHARGE PERMIT IS REQUIRED. NO ADDITIONAL PERMITTING FROM THE ARMY CORPS OF ENGINEERS WILL BE REQUIRED.
2. THE CONTRACTOR IS RESPONSIBLE FOR IMPLEMENTING AND MAINTAINING EROSION AND SEDIMENT CONTROL MEASURES AT ALL TIMES DURING CONSTRUCTION. THE STORMWATER MANAGEMENT PLANS MAY BE MODIFIED WITH APPROPRIATE APPROVALS FROM THE ENGINEER, AND MAY REQUIRE ADDITIONAL MEASURES AS FIELD CONDITIONS WARRANT.
3. A THOROUGH INSPECTION OF THE STORMWATER MANAGEMENT PLAN BEST MANAGEMENT PRACTICES (BMPs) SHALL BE PERFORMED EVERY FOURTEEN (14) CALENDAR DAYS AND AFTER ANY PRECIPITATION OR SNOWMELT EVENT. PERIODIC INSPECTIONS SHALL ALSO INCLUDE INSPECTING EQUIPMENT FOR LEAKS AND REVIEWING EQUIPMENT MAINTENANCE PRACTICE. ALL INSPECTIONS AND MAINTENANCE SHALL BE DOCUMENTED BY THE PROJECT EROSION CONTROL SUPERVISOR AND MADE AVAILABLE TO THE ENGINEER UPON REQUEST. ANY EROSION CONTROL BMP THAT HAS BEEN COMPROMISED OR HAS BEEN DISTURBED SHALL BE REPLACED OR RECONSTRUCTED. IT IS THE RESPONSIBILITY OF THE CONTRACTOR TO HAVE ALL EROSION CONTROL BMPs IN PLACE AND EFFECTIVE PRIOR TO A STORM EVENT.
4. THE STORMWATER MANAGEMENT PLAN LOG BOOK SHALL BE UPDATED EVERY FOURTEEN (14) DAYS. THIS LOG SHALL REMAIN ON SITE AVAILABLE FOR REVIEW BY THE ENGINEER UPON REQUEST. MAINTENANCE ACTIVITIES TO CORRECT PROBLEMS NOTED DURING INSPECTIONS MUST BE DOCUMENTED AND KEPT IN THE STORMWATER MANAGEMENT PLAN LOG BOOK. THE STORMWATER MANAGEMENT PLAN MUST BE UPDATED TO REFLECT ALL CHANGES TO BMP'S AND PHASING AS THE CHANGES OCCUR.
5. ALL STREETS WITHIN AND IMMEDIATELY SURROUNDING A CONSTRUCTION SITE SHALL BE CLEANED OF DIRT AND DEBRIS ON A WEEKLY BASIS AND IMMEDIATELY FOLLOWING A SPILL OR TRACKING OF EARTH MATERIALS. STREETS SHALL BE CLEANED BY SCRAPING AND SWEEPING THE DIRT OFF THE ROADWAYS. SCRAPED OR SWEEPED MATERIAL SHALL NOT BE DEPOSITED IN THE ROADSIDE DITCHES OR IN THE CREEK. DIRT TRACKED ONTO ROADWAYS AND OTHER PAVED SURFACES SHALL BE CLEANED UP BY THE END OF THE WORKDAY.
6. ALL CONSTRUCTION SITE OPERATORS SHALL CONTROL WASTE SUCH AS DISCARDED BUILDING MATERIALS, CONCRETE TRUCK WASHOUT, HAZARDOUS CHEMICALS (TO INCLUDE BUT NOT LIMITED TO HEAVY EQUIPMENT MAINTENANCE FLUIDS, MOTOR OIL, ANTIFREEZE AND VEHICLE FUEL), LITTER, AND SANITARY WASTE AT THE CONSTRUCTION SITE THAT MAY CAUSE ADVERSE IMPACTS TO STORMWATER QUALITY.
7. ALL POTENTIAL POLLUTION SOURCES ON-SITE SHALL BE IDENTIFIED AND CONTROL MEASURES INSTALLED AND PRACTICED TO MINIMIZE THE LIKELIHOOD OF A RELEASE.
8. ALL PORTABLE TOILET FACILITIES SHALL BE LOCATED AWAY FROM GUTTERS, INLETS DITCHES, DRAINAGEWAYS, RECEIVING WATERS AND AREAS SUSCEPTIBLE TO FLOODING OR DAMAGE BY CONSTRUCTION EQUIPMENT.
9. ALL PORTABLE TOILET FACILITIES SHALL BE SECURED IN PLACE BY STAKES INTO THE GROUND TO PREVENT TIPPING.
10. STOCKPILES INCLUDING LANDSCAPING MATERIALS, EARTH MATERIALS AND DIRT FROM GRADING OR EXCAVATION SHALL NOT BE LOCATED ADJACENT TO WATERWAYS.
11. ALL MATERIAL IMPORTED TO OR EXPORTED FROM THE SITE SHALL BE PROPERLY COVERED TO PREVENT THE LOSS OF MATERIAL DURING TRANSPORT. HAUL ROUTES MUST BE PRE-APPROVED BY THE CITY. NO MATERIAL SHALL BE TRANSPORTED TO ANOTHER SITE WITHOUT FIRST OBTAINING A GRADING PERMIT FROM THE CITY.
12. THE CONCRETE WASHOUT CONTAINMENT STRUCTURE SHALL CONTAIN ALL WASHOUT WATER. STORMWATER SHALL NOT CARRY WASTES FROM WASHOUT LOCATION.
13. THE CONCRETE WASHOUT CONTAINMENT STRUCTURE SHALL BE LOCATED A MINIMUM OF FIFTY (50) FEET HORIZONTAL FROM WATERS OF THE STATE. THE CONCRETE WASHOUT CONTAINMENT STRUCTURE SHALL BE SIGNED AS - "CONCRETE WASHOUT."

PERFORMANCE STANDARD NOTES:

1. TEMPORARY EROSION CONTROL FACILITIES AND/OR PERMANENT FACILITIES INTENDED TO CONTROL EROSION OF AN EARTH DISTURBANCE OPERATION SHALL BE INSTALLED BEFORE ANY EARTH DISTURBANCE OPERATIONS TAKE PLACE.
2. EARTH DISTURBANCES SHALL BE CONDUCTED IN SUCH A MANNER SO AS TO EFFECTIVELY REDUCE ACCELERATED SOIL EROSION AND RESULTING SEDIMENTATION.
3. PERSONS ENGAGED IN EARTH DISTURBANCES SHALL DESIGN, IMPLEMENT, AND MAINTAIN ACCEPTABLE SOIL EROSION AND SEDIMENTATION CONTROL MEASURES, IN CONFORMANCE WITH THE EROSION CONTROL TECHNICAL STANDARDS ADOPTED BY CDOT.
4. EARTH DISTURBANCES SHALL BE DESIGNED, CONSTRUCTED AND COMPLETED IN SUCH A MANNER SO THAT THE EXPOSED AREA OF ANY DISTURBED LAND SHALL BE LIMITED TO THE SHORTEST POSSIBLE PERIOD OF TIME.
5. SEDIMENT CAUSED BY ACCELERATED SOIL EROSION SHALL BE REMOVED FROM RUNOFF WATER BEFORE IT LEAVES THE SITE OF THE EARTH DISTURBANCE.
6. ANY TEMPORARY OR PERMANENT FACILITY DESIGNED AND CONSTRUCTED FOR THE CONVEYANCE OF WATER AROUND, THROUGH, OR FROM THE EARTH DISTURBANCE AREA SHALL BE DESIGNED TO LIMIT THE WATER FLOW TO A NON-EROSIVE VELOCITY.
7. RECORDS OF SPILLS, LEAKS, OR OVERFLOWS THAT RESULT IN THE DISCHARGE OF POLLUTANTS MUST BE DOCUMENTED AND MAINTAINED. SOME SPILLS MAY NEED TO BE REPORTED TO THE DIVISION IMMEDIATELY: SPECIFICALLY, A RELEASE OF ANY CHEMICAL, OIL, PETROLEUM PRODUCT, SEWAGE, ETC., WHICH MAY ENTER WATERS OF THE STATE, MUST BE REPORTED. MORE GUIDANCE IS AVAILABLE ON THE WEB AT [WWW.CDPHE.STATE.CO.US/EMP/SPILLSANDRELEASED.HTM](http://WWW.CDPHE.STATE.CO.US/EMP/SPILLSANDRELEASED.HTM). THE DIVISION'S TOLL FREE 24-HOUR ENVIRONMENTAL EMERGENCY SPILL REPORTING LINE IS 1.877.518.5608. IN ADDITION TO CONTACTING CDPHE, ALSO IMMEDIATELY CALL THE STEAMBOAT SPRINGS ENGINEERING DEPARTMENT AT 970-879-2060

BMP MAINTENANCE NOTES:

1. IT IS ANTICIPATED THAT THE BMPs IMPLEMENTED AT THE SITE WILL HAVE TO BE MODIFIED TO ADAPT TO CHANGING CONDITIONS OR TO ENSURE THAT POTENTIAL POLLUTANTS ARE BEING PROPERLY MANAGED AT THE SITE. WHEN BMPs ARE MODIFIED, THE SWMP MUST BE MODIFIED TO ACCURATELY REFLECT THE ACTUAL FIELD CONDITIONS.
2. THE OWNER/CONTRACTOR SHALL CONTINUOUSLY MAINTAIN ALL SEDIMENT CONTROL LOGS AND SILT FENCING SO THAT IT FUNCTIONS PROPERLY DURING CONSTRUCTION AND WORK SUSPENSIONS. ALL SEDIMENT CONTROL LOGS AND SILT FENCING SHALL BE REMOVED BY THE CONTRACTOR UPON SUBSTANTIAL PERMANENT STABILIZATION UNLESS OTHERWISE DIRECTED BY THE ENGINEER.
3. ALL INLET/OUTLET PROTECTIONS WILL BE CHECKED FOR MAINTENANCE AND FAILURE. SEDIMENT SHALL BE REMOVED AND PROPERLY DISPOSED OF ONCE IT HAS ACCUMULATED TO HALF THE DESIGN OF THE TRAP.
4. ALL SPILLS SHALL BE CLEANED UP IMMEDIATELY AFTER DISCOVERY, OR CONTAINED UNTIL APPROPRIATE CLEANUP METHODS CAN BE EMPLOYED. MANUFACTURE'S RECOMMENDED METHODS FOR SPILL CLEANUP SHALL BE FOLLOWED, ALONG WITH PROPER DISPOSAL METHODS.
5. EACH CONCRETE TRUCK OPERATOR SHALL BE AWARE OF THE DESIGNATED CONCRETE WASHOUT AREA.
6. THE CONTRACTOR SHALL CHECK THE CAPACITY FOR ALL CONCRETE WASHOUT AREAS. WASTE MATERIALS MUST BE REMOVED BY THE CONTRACTOR AND LEGALLY DISPOSED OF WHEN ACCUMULATIONS AMOUNT TO TWO-THRDS OF THE WET STORAGE CAPACITY OF THE STRUCTURE.
7. ALL CONCRETE WASHOUT AREAS SHALL BE CLEARLY MARKED. THE CONCRETE WASHOUT CONTAINMENT DETAIL WILL INCLUDE ORANGE PLASTIC CONSTRUCTION FENCING OR EQUIVALENT AROUND THE WASHOUT STRUCTURE AND A SIGN POSTED WITH THE WORDS "CONCRETE WASHOUT".
8. THE CONCRETE WASHOUT AREA SHALL BE REPAIRED AND/OR ENLARGED AS NECESSARY TO MAINTAIN CAPACITY FOR WASTED CONCRETE.
9. AT THE END OF CONSTRUCTION, ALL CONCRETE SHALL BE REMOVED FROM THE SITE AND LEGALLY DISPOSED OF AT AN APPROVED WASTE SITE.

STANDARD STEAMBOAT SPRINGS CONSTRUCTION SITE MANAGEMENT PLAN NOTES:

1. THIS PLAN SHALL BE KEPT ON SITE AT ALL TIMES AND UPDATED TO REFLECT ANY CHANGES.
2. CONCRETE WASTE AND WASHOUT WATER FROM MIXING TRUCKS SHALL BE CONTAINED ON SITE, REMOVED FROM THE SITE, AND PROPERLY DISPOSED. MATERIALS SHOULD NOT ENTER STATE WATERS.
3. CONTRACTOR IS RESPONSIBLE FOR INSTALLING AND MAINTAINING TEMPORARY EROSION AND SEDIMENT CONTROL DURING CONSTRUCTION AND ESTABLISHING ANY REQUIRED PERMANENT BEST MANAGEMENT PRACTICES (BMPs).
4. CONTRACTOR IS RESPONSIBLE FOR COMPLYING WITH ALL LOCAL, STATE, AND FEDERAL LAWS. IN ADDITION CONTRACTOR MUST OBTAIN REQUIRED PERMITS.
5. CLEARING OR GRADING SHALL NOT BEGIN UNTIL ALL SEDIMENT CONTROL DEVICES HAVE BEEN INSTALLED.
6. THE CONTRACTOR SHALL PROMPTLY REMOVE ALL SEDIMENT, MUD, AND CONSTRUCTION DEBRIS THAT MAY ACCUMULATE IN THE RIGHT OF WAY, PRIVATE PROPERTY, OR WATER WAYS AS A RESULT OF THE CONSTRUCTION ACTIVITIES.
7. ALL INGRESS, EGRESS POINTS AND VEHICLE ACCESS POINTS ONTO DISTURBED SITE MUST BE STABILIZED WITH A VEHICLE TRACKING CONTROL PAD. ACCESS SHALL ONLY BE VIA APPROVED LOCATIONS AS SHOWN ON APPROVED CSMp.
8. SOIL STABILIZATION MEASURES SHALL BE IN PLACE AND AREAS ARE TO BE REVEGETATED:(1) FOR STOCKPILES, IF INACTIVE FOR MORE THAN 30 DAYS (2) FOR AREAS OF LAND DISTURBANCE WITHIN ONE GROWING SEASON.
9. INLET PROTECTION SHALL BE INSTALLED IN CONJUNCTION WITH STORM DRAIN INLETS WHERE DRAINAGE AREA IS NOT VEGETATED.
10. BMPs SHALL BE USED, MODIFIED, AND MAINTAINED WHENEVER NECESSARY TO REFLECT CURRENT CONDITIONS. BMPs SHALL BE INSPECTED WEEKLY AND AFTER EVERY PRECIPITATION EVENT. ACCUMULATED SEDIMENT SHALL BE REMOVED FROM BMPs WHEN THE SEDIMENT LEVEL REACHES ½ THE HEIGHT OF THE BMP.
11. EMERGENCY ACCESS MUST BE KEPT OBSTACLE FREE AND PASSABLE AT ALL TIMES.
12. FOR ANY WORK TO BE DONE IN THE RIGHT OF WAY, COORDINATE WITH THE CITY CONSTRUCTION SITE MANAGER REGARDING SPECIAL PERMITTING. NO WORK SHALL BE CONDUCTED IN THE ROW BETWEEN NOVEMBER 1 AND APRIL 1 WITHOUT PRIOR APPROVAL FROM THE DIRECTOR OF PUBLIC WORKS.
13. WHERE REQUIRED AS PART OF THE ROW PERMIT OR WHERE SITE WORK AFFECTS THE PEDESTRIAN OR VEHICLE TRAVEL WAY, TRAFFIC CONTROL SHALL BE INSTALLED. ALL TRAFFIC CONTROL SHALL BE IN ACCORDANCE WITH THE MANUAL ON UNIFORM TRAFFIC CONTROL DEVICES, LATEST EDITION.
14. SIDEWALKS ADJACENT TO CONSTRUCTION SITES SHALL BE MAINTAINED, FOR PUBLIC USE, BY THE CONTRACTOR. IN AREAS WHERE CONSTRUCTION IS TAKING PLACE NEXT TO THE SIDEWALK AND OVERHEAD HAZARDS ARE POSSIBLE, CONTRACTOR IS RESPONSIBLE FOR INSTALLING AND MAINTAINING SIDEWALK PROTECTION.

STANDARD EROSION AND SEDIMENT CONTROL NOTES

1. THE CONTRACTOR MUST NOTIFY THE CITY OF STEAMBOAT SPRINGS AT LEAST THREE DAYS PRIOR TO STARTING CONSTRUCTION.
2. ALL GRADING, EROSION, AND SEDIMENT CONTROL MUST CONFORM TO APPROVED PLANS. REVISIONS TO DISTURBANCE AREAS, SLOPES, AND/OR EROSION AND SEDIMENT CONTROL MEASURES ARE NOT PERMITTED WITHOUT PRIOR APPROVAL FROM THE CITY OF STEAMBOAT SPRINGS.
3. THE CONTRACTOR IS RESPONSIBLE FOR OBTAINING A PERMIT FOR STORMWATER DISCHARGES ASSOCIATED WITH CONSTRUCTION ACTIVITY FROM THE COLORADO DEPARTMENT OF PUBLIC HEALTH AND ENVIRONMENT, AT LEAST 10 DAYS PRIOR THE START OF CONSTRUCTION ACTIVITIES FOR LAND DISTURBANCE AREAS OF ONE ACRE OR GREATER. THE PERMIT MUST BE KEPT CURRENT THROUGHOUT THE CONSTRUCTION DURATION. STATE STORMWATER PERMIT APPLICATIONS ARE AVAILABLE AT THIS ADDRESS: [HTTP://WWW.CDPHE.STATE.CO.US/WQ/PERMITSUNIT/WQCDPMTHTML](http://WWW.CDPHE.STATE.CO.US/WQ/PERMITSUNIT/WQCDPMTHTML)
4. EROSION CONTROL BEST MANAGEMENT PRACTICES (BMPs) MUST BE INSTALLED PRIOR TO GRADING ACTIVITIES, TO THE MAXIMUM EXTENT PRACTICABLE. ANY PROJECT THAT REQUIRES A STATE STORMWATER DISCHARGE PERMIT REQUIRES PHASING. PHASED EROSION CONTROL PLANS MUST BE PREPARED BY THE CONTRACTOR.
5. ALL TEMPORARY AND PERMANENT SOIL EROSION AND SEDIMENT CONTROL PRACTICES MUST BE MAINTAINED AND REPAIRED AS NEEDED TO ASSURE CONTINUED PERFORMANCE OF THEIR INTENDED FUNCTION. FOR EXAMPLE, EROSION CONTROL BLANKETS, SEDIMENT CONTROL LOGS, OR SILT FENCES WILL REQUIRE REPLACEMENT WHEN THE BMP FAILS. SEDIMENT TRAPS AND BASINS WILL REQUIRE SEDIMENT REMOVAL ACCORDING TO CDPHE GUIDELINES.
6. ALL TOPSOIL, WHERE PHYSICALLY PRACTICABLE, MUST BE SALVAGED AND NO TOPSOIL SHALL BE REMOVED FROM THE SITE EXCEPT AS SET FORTH IN THE APPROVED PLANS. TOPSOIL AND OVERBURDEN MUST BE SEGREGATED AND STOCKPILED SEPARATELY. TOPSOIL AND OVERBURDEN MUST BE REDISTRIBUTED WITHIN THE GRADED AREA AFTER ROUGH GRADING TO PROVIDE A SUITABLE BASE FOR AREAS THAT MUST BE SEEDED AND PLANTED. RUNOFF FROM THE STOCKPILED AREA MUST BE CONTROLLED TO PREVENT EROSION AND SEDIMENTATION OF RECEIVING WATERS. TOPSOIL IS TO BE AMENDED WITH COMPOST TO PROMOTE SEED GROWTH.
7. THE LANDOWNER AND/OR CONTRACTOR MUST IMMEDIATELY TAKE ALL NECESSARY STEPS TO CONTROL SEDIMENT DISCHARGE.
8. THE LANDOWNER AND/OR CONTRACTOR IS RESPONSIBLE FOR CLEAN UP AND REMOVAL OF ALL SEDIMENT AND DEBRIS FROM ALL DRAINAGE INFRASTRUCTURE AND OTHER PUBLIC FACILITIES.
9. THE LANDOWNER AND/OR CONTRACTOR MUST TAKE REASONABLE PRECAUTIONS TO ENSURE THAT VEHICLES DO NOT TRACK OR SPILL EARTH MATERIALS ON TO STREETS/ROADS AND MUST IMMEDIATELY REMOVE SUCH MATERIALS IF THIS OCCURS.
10. THE CONTRACTOR IS RESPONSIBLE FOR CONTROLLING \*LITTER SUCH AS DISCARDED BUILDING MATERIALS, CONCRETE TRUCK WASHOUT, CHEMICALS, AND SANITARY WASTE, AS APPLICABLE. IN ADDITION, SPILL PREVENTION AND CONTAINMENT BMPs FOR CONSTRUCTION MATERIALS, WASTE, AND FUEL MUST BE PROVIDED, AS APPLICABLE. LOCATIONS OF STOCKPILES, CONCRETE WASHOUT AREAS, AND TRASH RECEPTACLES MUST BE CLEARLY SHOWN ON THE PLANS. \*LITTERING IS DEFINED AND ENFORCED BY COLORADO REVISED STATUTES, SECTION 18-4-511.
11. THE STORM SEWER LINES WILL BE CLEANED BY CONTRACTOR UPON COMPLETION OF THE PROJECT.
12. SEEDING AND MULCHING SHALL BE COMPLETED WITHIN 30 DAYS OF INITIAL EXPOSURE OR 7 DAYS AFTER GRADING IS SUBSTANTIALLY COMPLETED IN A GIVEN AREA. THIS MAY REQUIRE MULTIPLE MOBILIZATIONS FOR SEEDING AND MULCHING.
13. TEMPORARY VEGETATIVE COVER CONSISTING OF ANNUAL RYE GRASS MUST BE HYDRO-SEEDED AT 20 POUNDS PURE LIVE SEED PER ACRE. MULCH CONSISTING OF GRASS HAY, APPLIED AT A RATE OF ONE TON PER ACRE AND CRIMPED MUST BE USED TO STABILIZE THE EXPOSED SURFACE.
14. MULCH CONSISTING OF GRASS HAY, APPLIED AT A RATE OF ONE TON PER ACRE AND CRIMPED MUST BE USED TO STABILIZE THE EXPOSED SURFACE. SEE EROSION CONTROL PLAN FOR LOCATIONS OF EROSION CONTROL BLANKETS.
15. FUGITIVE DUST EMISSIONS RESULTING FROM GRADING ACTIVITIES AND/OR WIND SHALL BE CONTROLLED USING THE BEST AVAILABLE CONTROL TECHNOLOGY, AS DEFINED BY THE COLORADO DEPARTMENT OF PUBLIC HEALTH AND ENVIRONMENT, AT THE TIME OF GRADING. DURING GRADING, APPLYING A COMBINATION OF WATER, TACKIFIER AND SILT FENCE TO BREAK UP WIND SURFACE VELOCITIES MAY CONTROL DUST. IF WIND SPEEDS EXCEED THE ABILITY OF BMPs TO CONTROL FUGITIVE DUST, GRADING ACTIVITIES MUST CEASE. THE CONTRACTOR SHALL OBTAIN A PERMIT FROM THE CDPHE AIR POLLUTION CONTROL DIVISION IF REQUIRED.
16. ALL DISTURBED FILL SLOPES GREATER THAN OR EQUAL TO 3:1, FLOWLINES OF SWALES, GUTTER DOWNSPOUTS, OR ADDITIONAL AREAS AT THE DISCRETION OF CITY STAFF, SHALL BE PROTECTED WITH AN EROSION BLANKET. SEE EROSION CONTROL PLANS FOR ADDITIONAL LOCATIONS OF EROSION CONTROL BLANKETS.
17. THE CITY OF STEAMBOAT SPRINGS, OR ITS AUTHORIZED REPRESENTATIVE, MAY MODIFY THE EROSION AND SEDIMENT CONTROL PLAN AS FIELD CONDITIONS WARRANT.
18. THE CONTRACTOR IS RESPONSIBLE FOR PREPARING AND SUBMITTING A TEMPORARY DEWATERING PLAN IF NEEDED TO THE CITY OF STEAMBOAT SPRINGS FOR REVIEW AND APPROVAL 10 DAYS PRIOR TO INITIATING CONSTRUCTION.
19. BMP MAINTENANCE AND REPLACEMENT MAY REQUIRE PERIODIC WORK. THIS IS TO OCCUR PER CDPHE REQUIREMENTS IMMEDIATELY, AND AT SPECIFIC POINTS OF SEDIMENT ACCUMULATION, PHASING, OR DAILY ACTIVITIES.

SITE DESCRIPTION	
CONSTRUCTION ACTIVITY	PHASE 1: RELOCATION OF ICONIC BARN AND ASSOCIATED GRADING. PHASE 2: CONSTRUCTION OF SOFT SURFACE TRAIL, PARKING STALLS AND CONNECTION TO SIDEWALK
DISTURBANCE AREA	DISTURBANCE AREA = APPROX. 1.63 ACRES
RUNOFF COEFFICIENTS	C100 = 0.61
EXISTING VEGETATION	MAJORITY OF COVER IS NATIVE GRASS WITH TREES AND BUSHES
SOIL CONDITION	GENERALLY, SUBRADE SOIL CONDITIONS CONSIST OF LOAM SOILS THAT ARE WELL DRAINED AND HYDROLOGIC SOIL TYPE C
PROPOSED LANDSCAPE AREA	0.8 ACRES
POTENTIAL POLLUTION SOURCES	SEDIMENT, ASPHALT PAVEMENT, VEHICLE REFUELING, LEAKING VEHICLES, OFF-SITE VEHICLE TRACKING, CONCRETE
LOCATION OF NON-STORMWATER DISCHARGE	THE CONTRACTOR WILL DESIGNATE A CONFINED, CONCRETE WASH-OUT AREA ON SITE.
NAME AND LOCATION OF RECEIVING WATERS	YAMPA RIVER LOCATED APPROX. 3000 FEET TO THE WEST OF THE SITE.

OVERALL SCOPE / PROJECT CHARACTERISTICS

INDUSTRIAL ACTIVITIES	NONE KNOWN
FINAL SITE DISPOSITION	THE SITE WILL BE RETURNED TO ORIGINAL CONDITIONS OR BETTER. TREES WILL BE REMOVED THAT CONFLICT WITH PROPOSED IMPROVEMENTS. DISTURBED SLOPES WILL RECEIVE HYDROMULCH SEEDING WITH FIBER BOND MATRIX.
EROSION CONTROL MEASURES	STRAW WATTLES OR SILT FENCE WILL BE AT THE TOE OF FILL SLOPES TO MINIMIZE SEDIMENT TRANSPORT. INLET AND OUTLET PROTECTION WILL BE PROVIDED AT ALL CULVERTS AND STORM SEWER. GRAVEL FILTER BAGS WILL BE PLACED WITHIN SWALES. A CONCRETE WASH-OUT AREA WILL BE PROVIDED. A VEHICLE TRACKING PAD WILL BE PROVIDED AT MT WERNER CIRCLE TO ACCESS THE SITE AND REDUCE TRACKING MUD ONTO THE EXISTING ASPHALT.
OFFSITE FLOWS	MINIMAL OFF-SITE FLOWS ENTER THE PROJECT.

SCHEDULE OF GRADING ACTIVITIES/SEQUENCE

1. INSTALL EROSION CONTROL MEASURES	5. FINE GRADING
2. EARTHWORK/GRADING	6. SOFT SURFACE SIDEWALK CONSTRUCTION
3. BARN RELOCATION (PHASE 1)	7. ASPHALT PAVING AND TRAIL CONNECTIONS SOUTH OF MWC
4. CULVERT CONSTRUCTION (PHASE 2)	8. FINAL STABILIZATION

BEST MANAGEMENT PRACTICES (BMP's)

STORM WATER QUALITY BEST MANAGEMENT PRACTICES SHALL BE IMPLEMENTED TO MINIMIZE SOIL EROSION, SEDIMENTATION, INCREASED POLLUTION LOADS AND CHANGED WATER FLOW CHARACTERISTICS RESULTING FROM LAND DISTURBING ACTIVITY TO THE MAXIMUM EXTENT PRACTICAL, AS TO MINIMIZE POLLUTION OF RECEIVING WATERS.	
MATERIALS HANDLING AND SPILL PREVENTION	MATERIALS EXPECTED TO BE PRESENT ARE AS FOLLOWS: PETROLEUM PRODUCTS & CONCRETE. NO CHEMICALS OR FUELS ARE TO BE STORED ON SITE. THE FOLLOWING MATERIAL MANAGEMENT PRACTICES SHALL BE USED TO REDUCE THE RISK OF SPILLS OR OTHER ACCIDENTAL EXPOSURE OF MATERIALS AND SUBSTANCES TO STORM WATER RUNOFF. •PRODUCTS WILL BE KEPT IN ORIGINAL CONTAINERS WITH ORIGINAL MANUFACTURER LABEL. •ALL OF THE PRODUCT WILL BE USED UP BEFORE DISPOSING OF THE CONTAINER. •ALL ON-SITE VEHICLES WILL BE MONITORED FOR LEAKS AND RECEIVE REGULAR PREVENTATIVE MAINTENANCE. •CONCRETE TRUCKS WILL BE ALLOWED MINIMAL WASHING ONLY IN DESIGNATED WASHOUT AREA. •THE SWMP ADMINISTRATOR SHALL BE NOTIFIED OF ANY SPILLS. CONTAINMENT OF THE SPILL MUST OCCUR IMMEDIATELY. IN THE EVENT OF A SPILL, THE FOLLOWING AGENCIES MUST BE CONTACTED: COLORADO DEPARTMENT OF PUBLIC HEALTH AND ENVIRONMENT 303-692-3500 STEAMBOAT SPRINGS ENGINEERING DEPARTMENT - 970-879-2060
OTHER CONTROLS	WASTE MATERIALS WILL BE COLLECTED AND STORED IN A SECURELY LIDDED METAL DUMPSTER. ALL TRASH AND CONSTRUCTION DEBRIS FROM THE SITE WILL BE DEPOSITED IN A DUMPSTER. ALL PERSONNEL WILL BE INSTRUCTED REGARDING THE CORRECT PROCEDURE FOR WASTE DISPOSAL. ALL SANITARY WASTE WILL BE COLLECTED FROM PORTABLE UNITS A MINIMUM OF THREE TIMES PER WEEK. THE PAVED STREET ADJACENT TO THE SITE SHALL BE SWEEPED TO REMOVE ANY EXCESS MUD, DIRT OR ROCK TRACKED FROM THE SITE.
INSPECTION AND MAINTENANCE	INSPECTIONS: 1. PERFORM EVERY 14 DAYS, AND FOLLOWING A STORM EVENT 2. COMPLETE AN INSPECTION REPORT FOR EACH INSPECTION PERFORMED 3. KEEP INSPECTION REPORTS ON SITE:  1. PERFORM MAINTENANCE ON ITEMS OR AREAS IDENTIFIED IN THE INSPECTION REPORT IMMEDIATELY. 2. PERFORM MAINTENANCE AS INDICATED IN THE URBAN DRAINAGE & FLOOD CONTROL DISTRICT, URBAN STORM DRAINAGE CRITERIA MANUAL, VOL 3, PER MANUFACTURER'S SPECIFICATIONS OR OTHER SOURCES DETERMINED TO BE ACCEPTABLE.  AN EFFICIENT RECORD-KEEPING SYSTEM IS A HELPFUL TOOL IN MANAGING INSPECTION AND MAINTENANCE REPORTS. IT IS RECOMMENDED THAT A LOGBOOK BE MAINTAINED FOR INSPECTION REPORTS, MAINTENANCE RECORDS, SPILL RESPONSE, WEATHER CONDITIONS, TRAINING CORRESPONDENCE, ETC.

RCRBD  
RECORD SET



Engineering - Planning - Surveying  
419 OAK ST. • PO BOX 77052 • STEAMBOAT SPRINGS, CO 80477  
P. 970.879.025 • F. 303.940.9569 • [www.baselinecorp.com](http://www.baselinecorp.com)


DESIGNED BY	SMB
DRAWN BY	SMB
CHECKED BY	CSR

PREPARED BY	DATE
CSR	5/3/18

REVISION DESCRIPTION	DESIGN TEAM REVIEW/COORDINATION
DESIGN TEAM REVIEW/COORDINATION	


CITY OF STEAMBOAT SPRINGS	ROUTT COUNTY
STEAMBOAT SPRINGS	URAAC/SSRA ICONIC ENTRY MT. WERNER CIRCLE/MT. WERNER ROAD STORM WATER MANAGEMENT PLAN

PREPARED UNDER THE DIRECT SUPERVISION OF


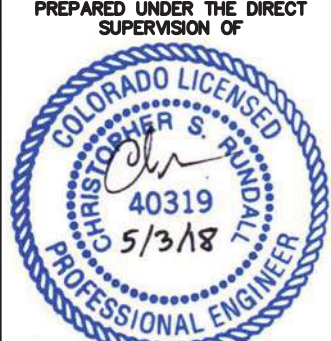


FOR AND ON BEHALF OF	BASELINE CORPORATION
INITIAL SUBMITTAL	4/25/17
DRAWING SIZE	24" X 36"
SURVEY FIRM	D&D, INC.
SURVEY DATE	10/11/14
JOB NO.	C020169
DRAWING NAME	C020169 CD COVER.dwg
SHEET	11 OF 13




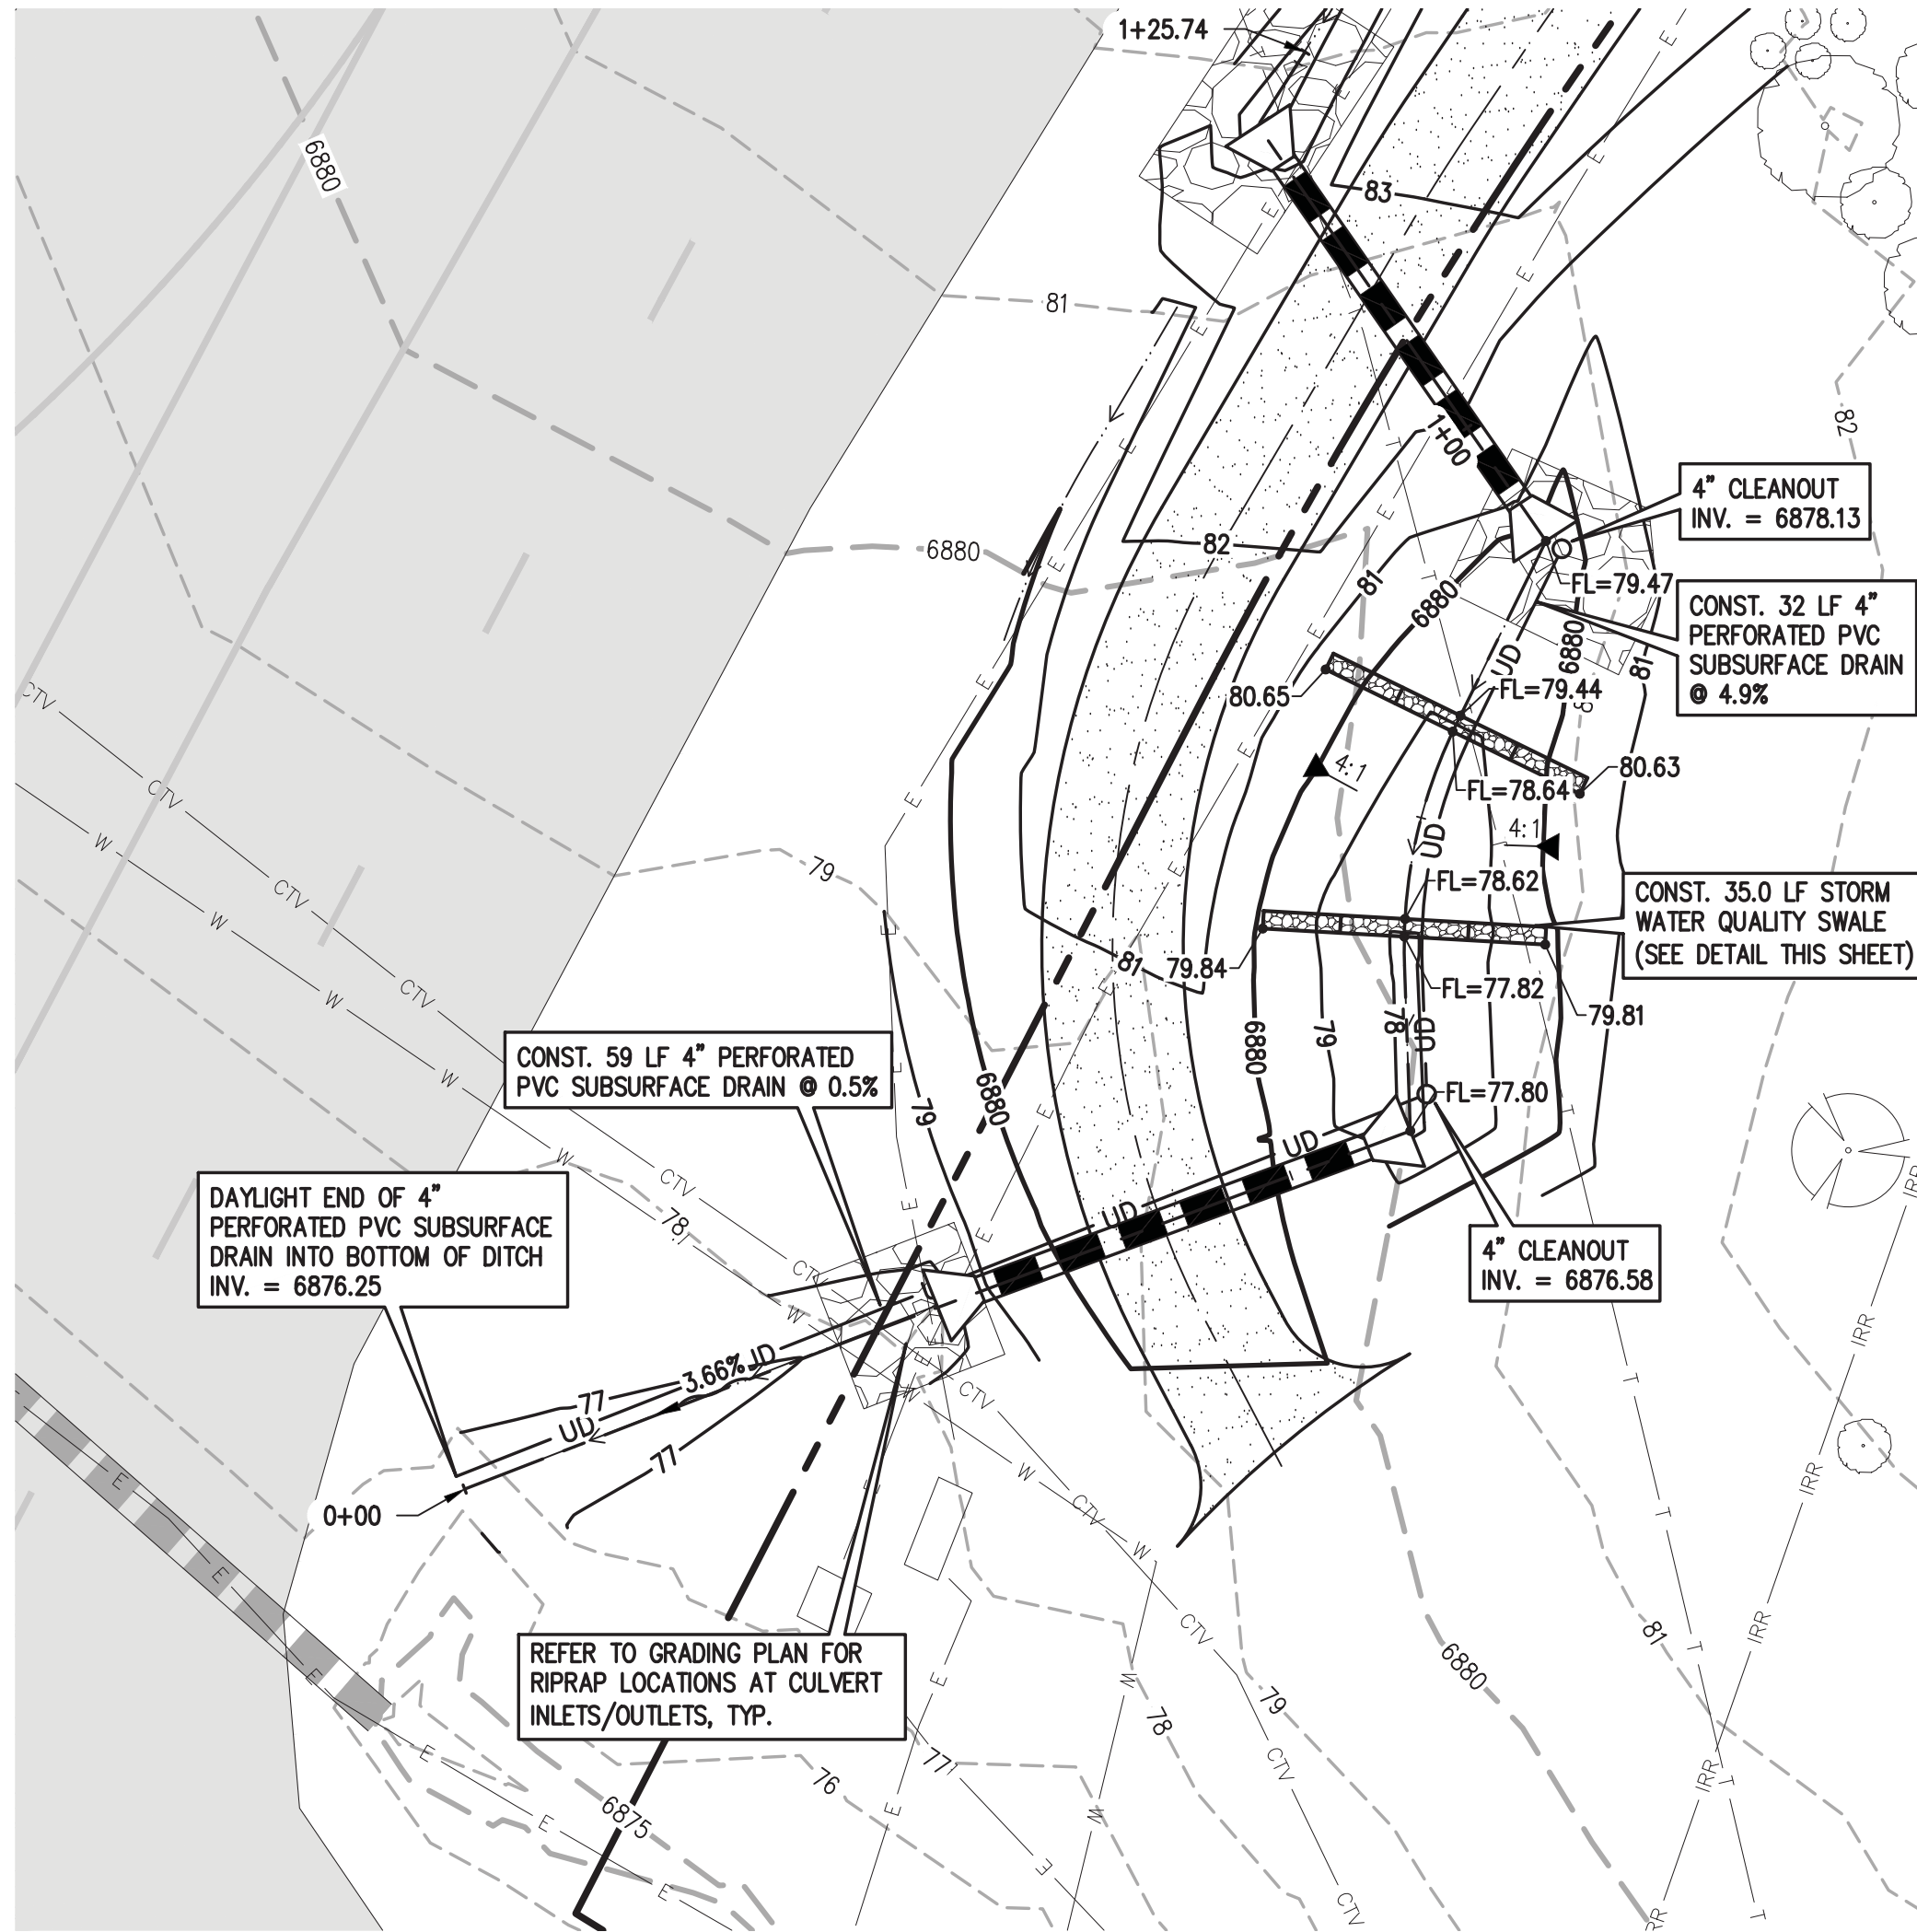


1 WATER QUALITY SWALE DETAIL  
SCALE: 1" = 10'

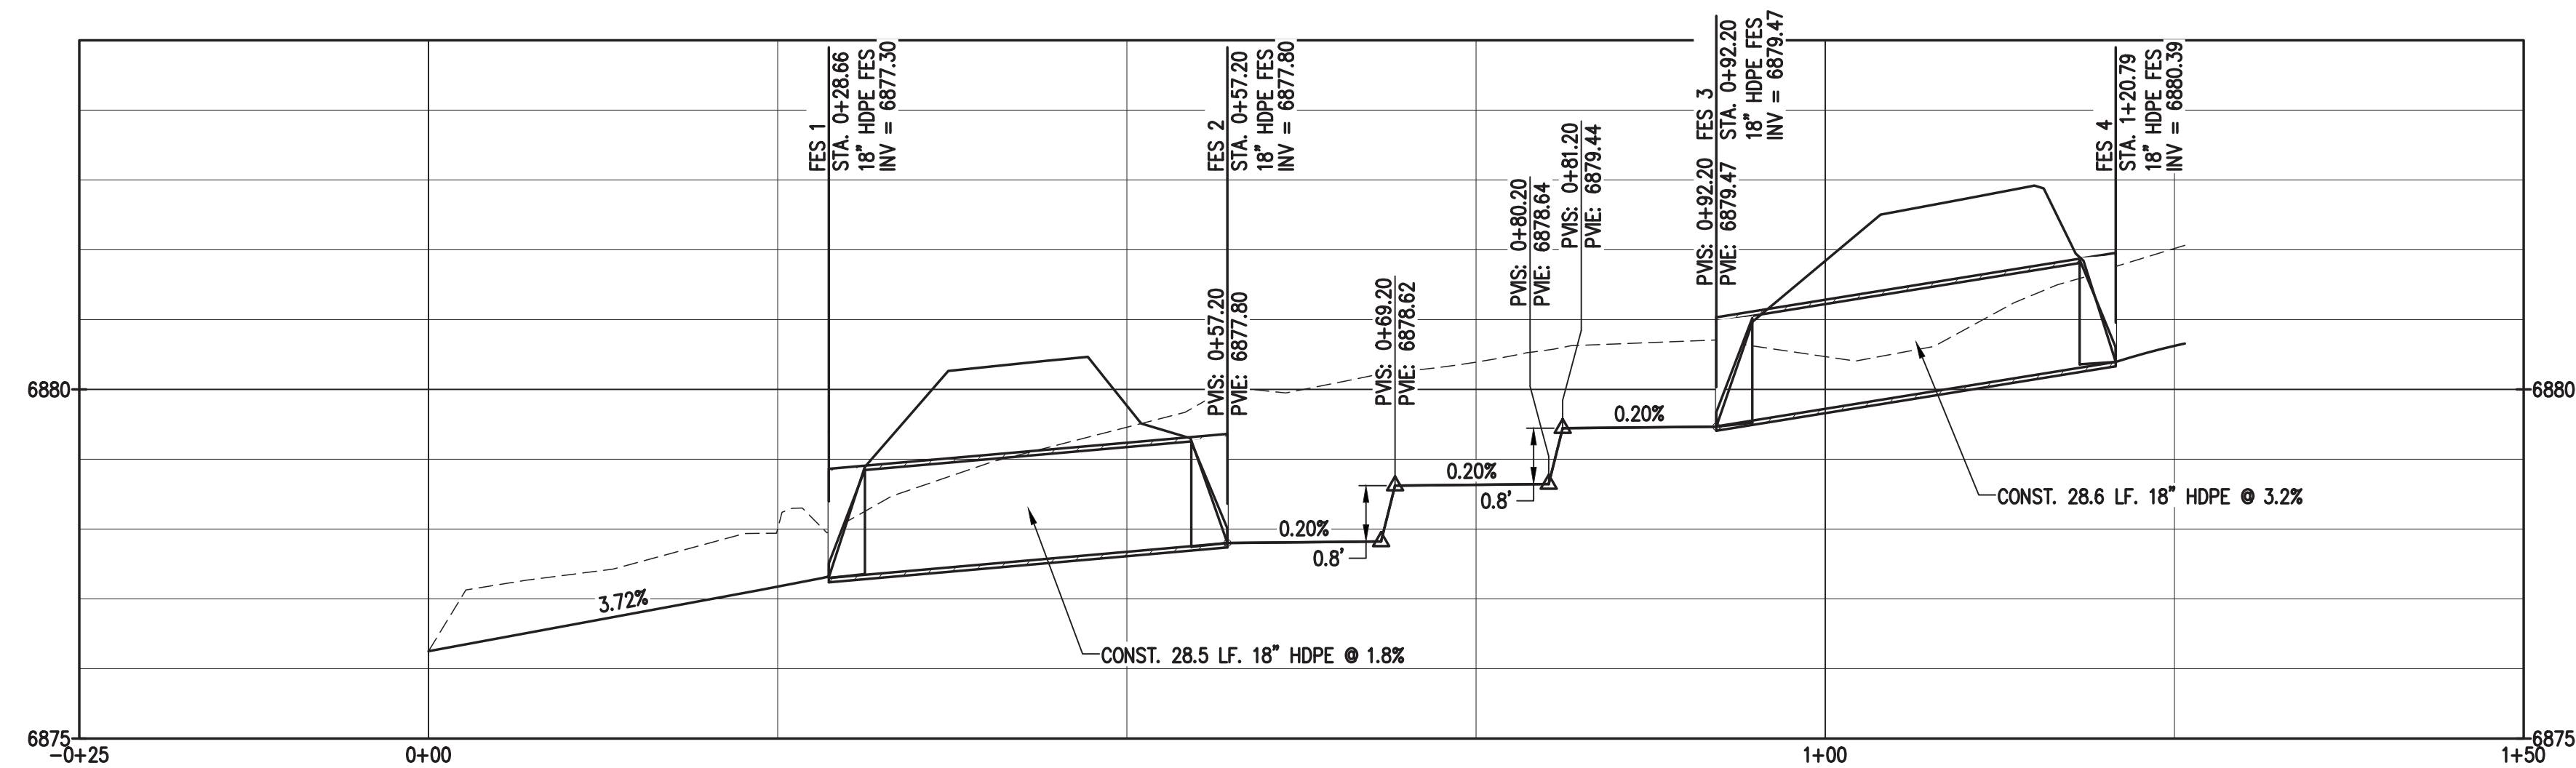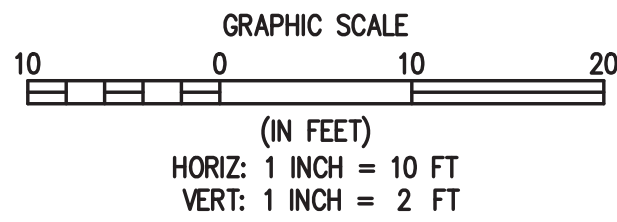


2 WATER QUALITY SWALE PROFILE

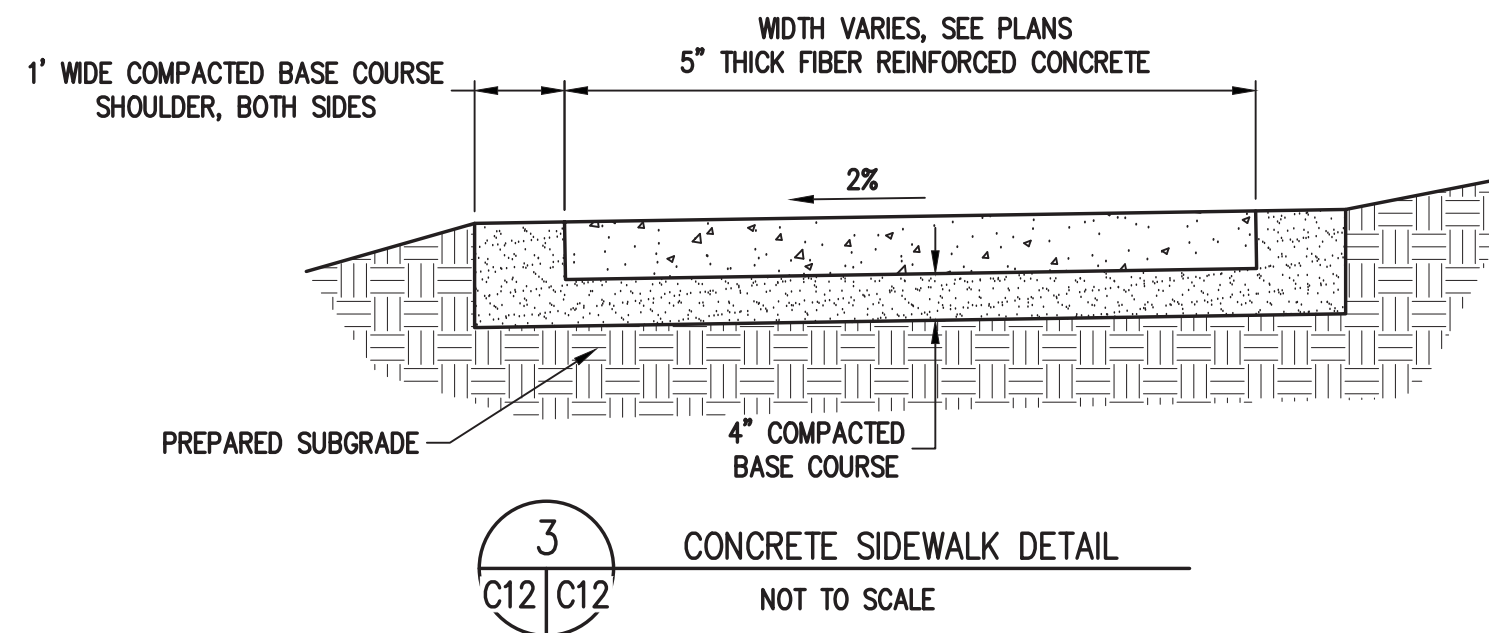


3 CONCRETE SIDEWALK DETAIL  
NOT TO SCALE

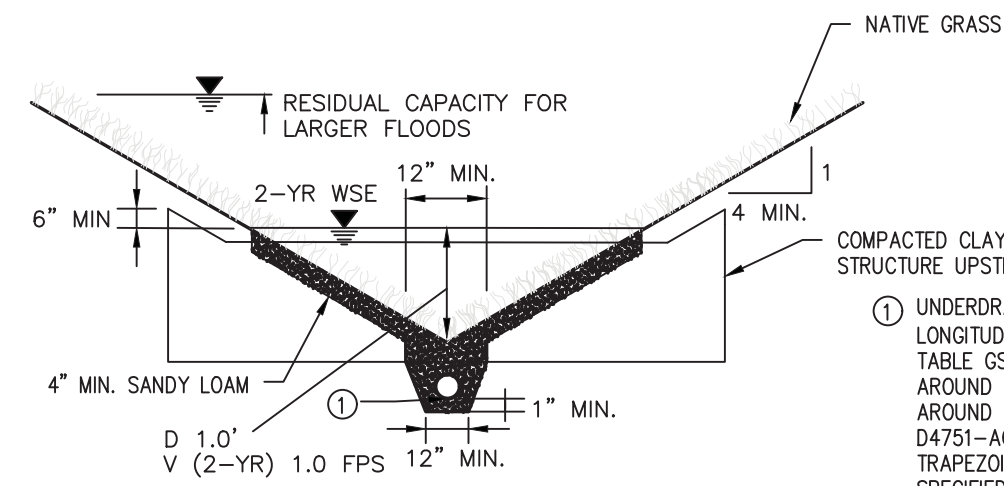


TRIANGULAR SWALE SECTION  
NTS

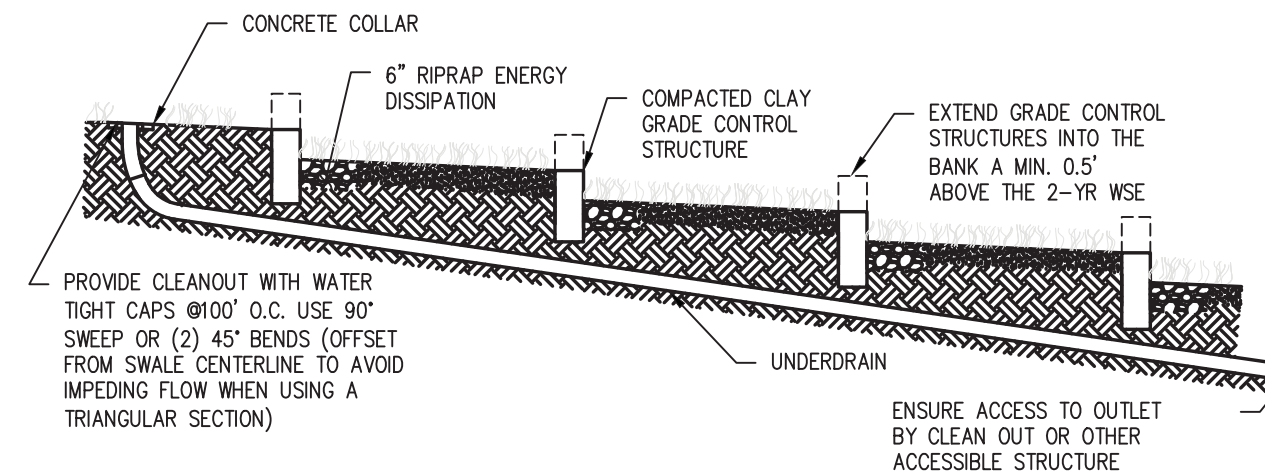

SWALE PROFILE  
NTS

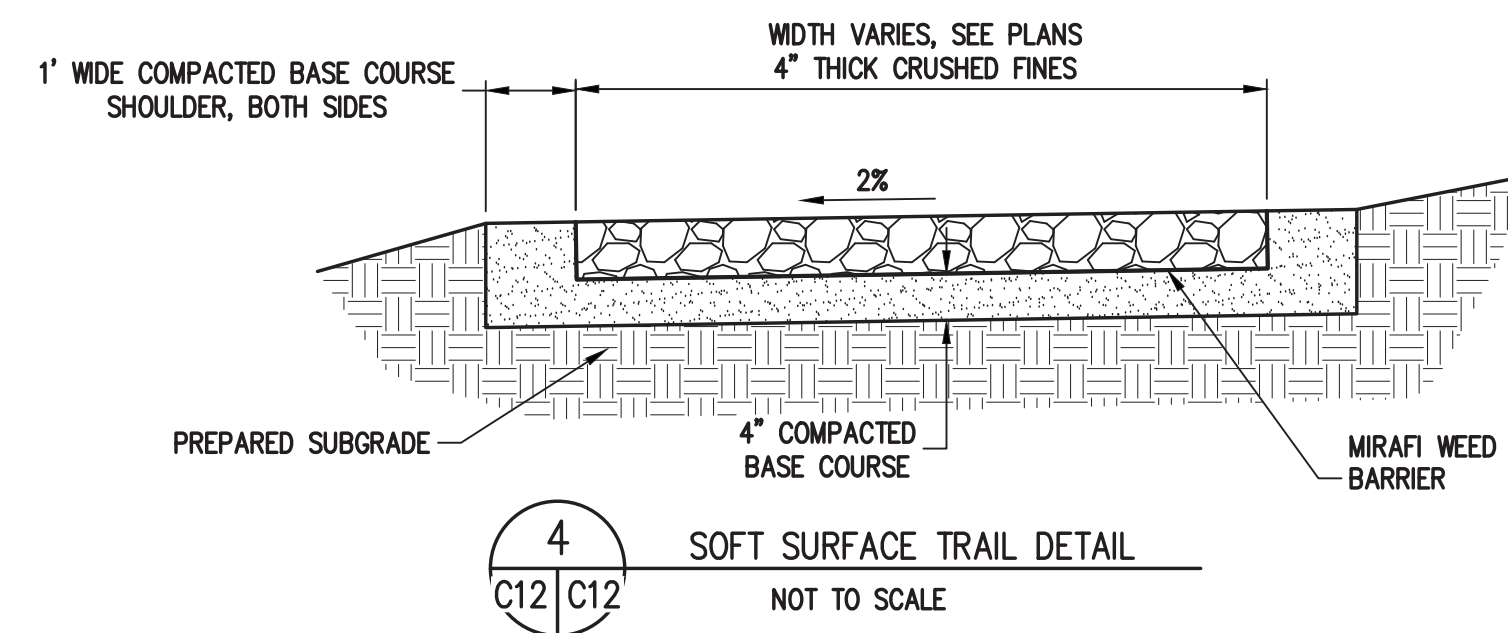


4 SOFT SURFACE TRAIL DETAIL  
NOT TO SCALE

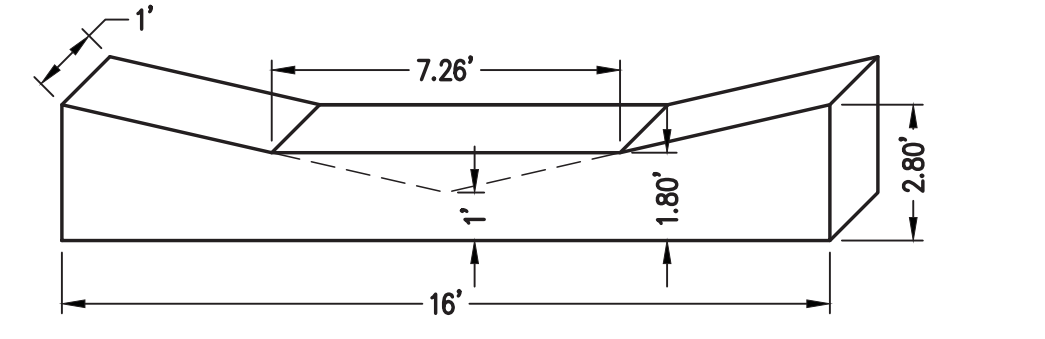

COMPACTED CLAY GRADE CONTROL STRUCTURE ISOMETRIC  
NTS

5 WATER QUALITY SWALE DETAIL

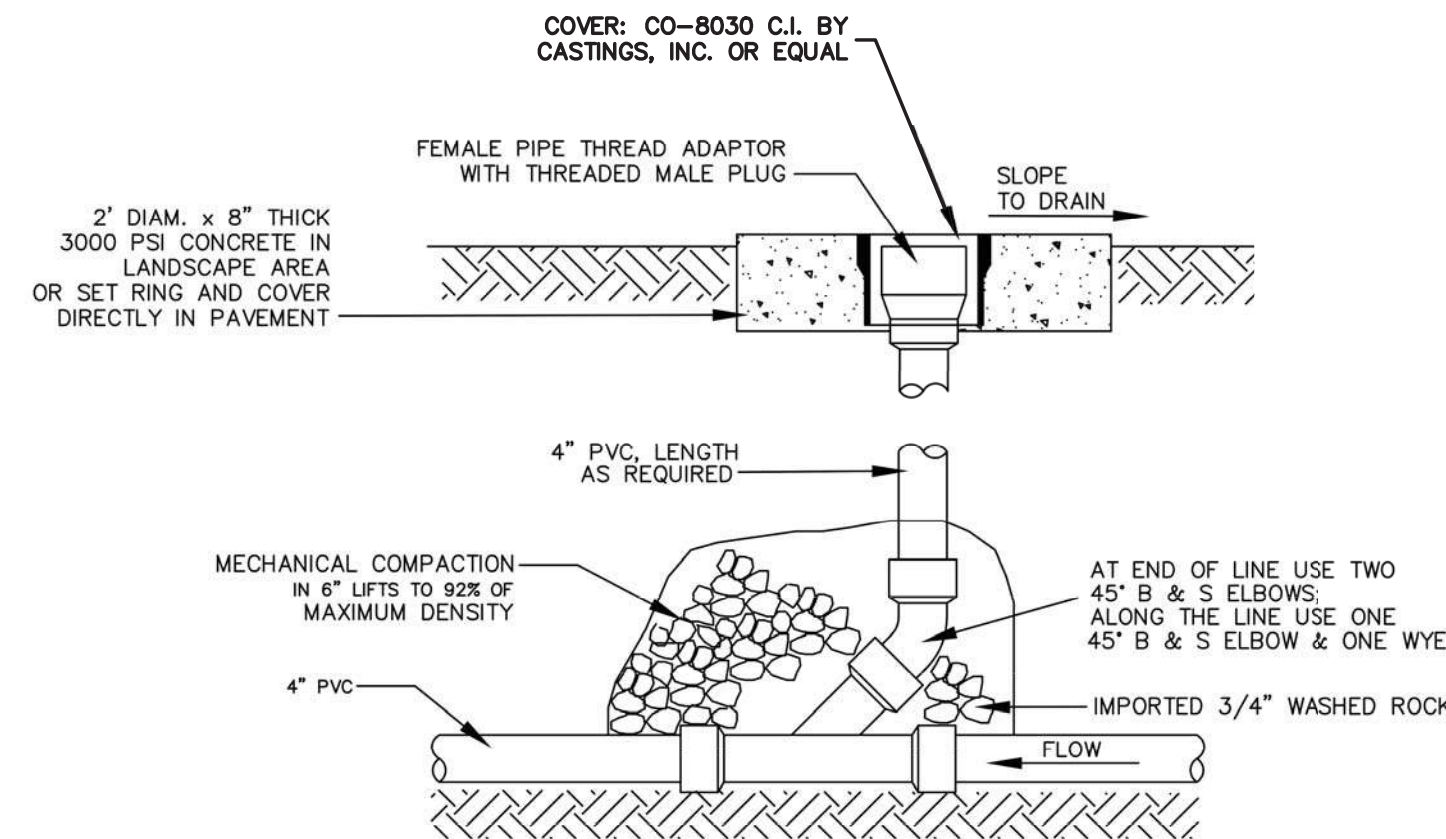


6 UNDERDRAIN CLEANOUT DETAIL  
NOT TO SCALE

NOTE: SEE PLAN SHEETS  
FOR INVERTS.





RCRBD  
RECORD SET

DESIGNED BY	SMB
DRAWN BY	SMB
CHECKED BY	CSR
DATE	5/3/18
PREPARED BY	CSR
REVISION DESCRIPTION	DESIGN TEAM REVIEW/COORDINATION

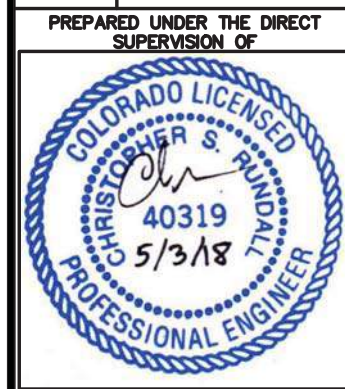

FOR AND ON BEHALF OF	BASELINE CORPORATION
INITIAL SUBMITTAL	4/25/17
DRAWING SIZE	24" X 36"
SURVEY FIRM	D&D, INC.
SURVEY DATE	10/11/14
JOB NO.	C020169
DRAWING NAME	20169 TRAIL DETAILS.dwg
SHEET	12 OF 13



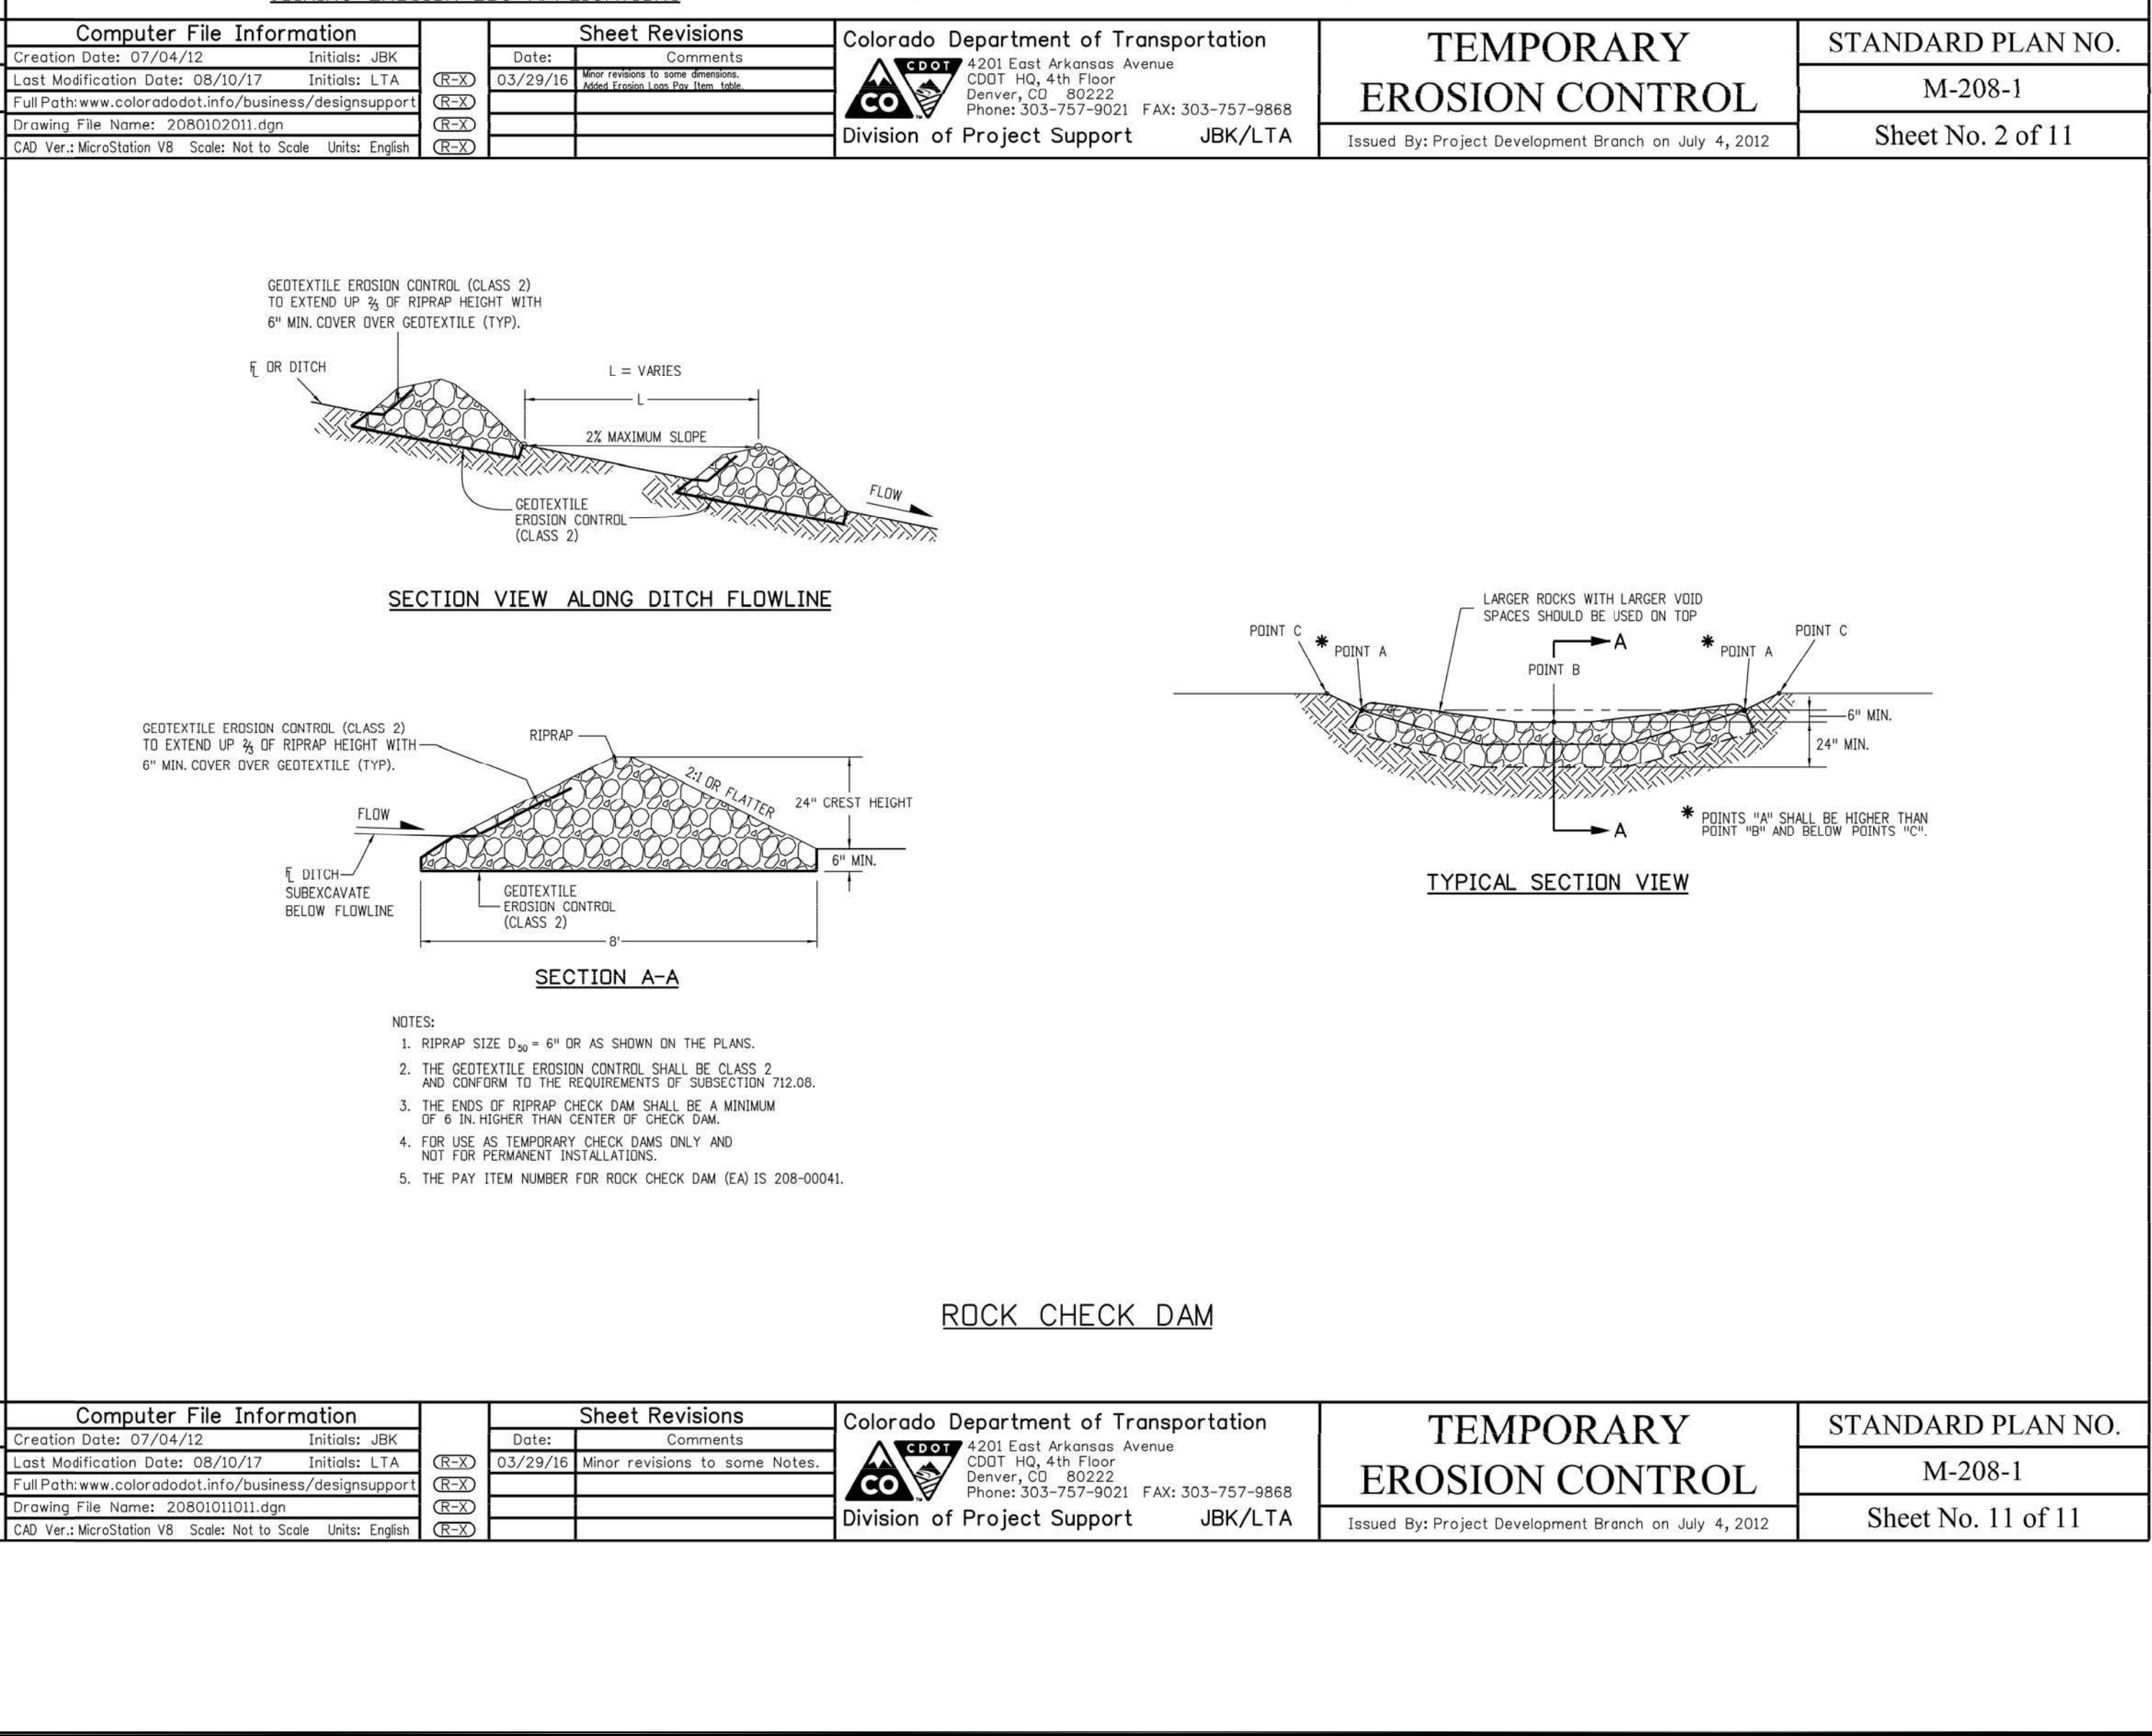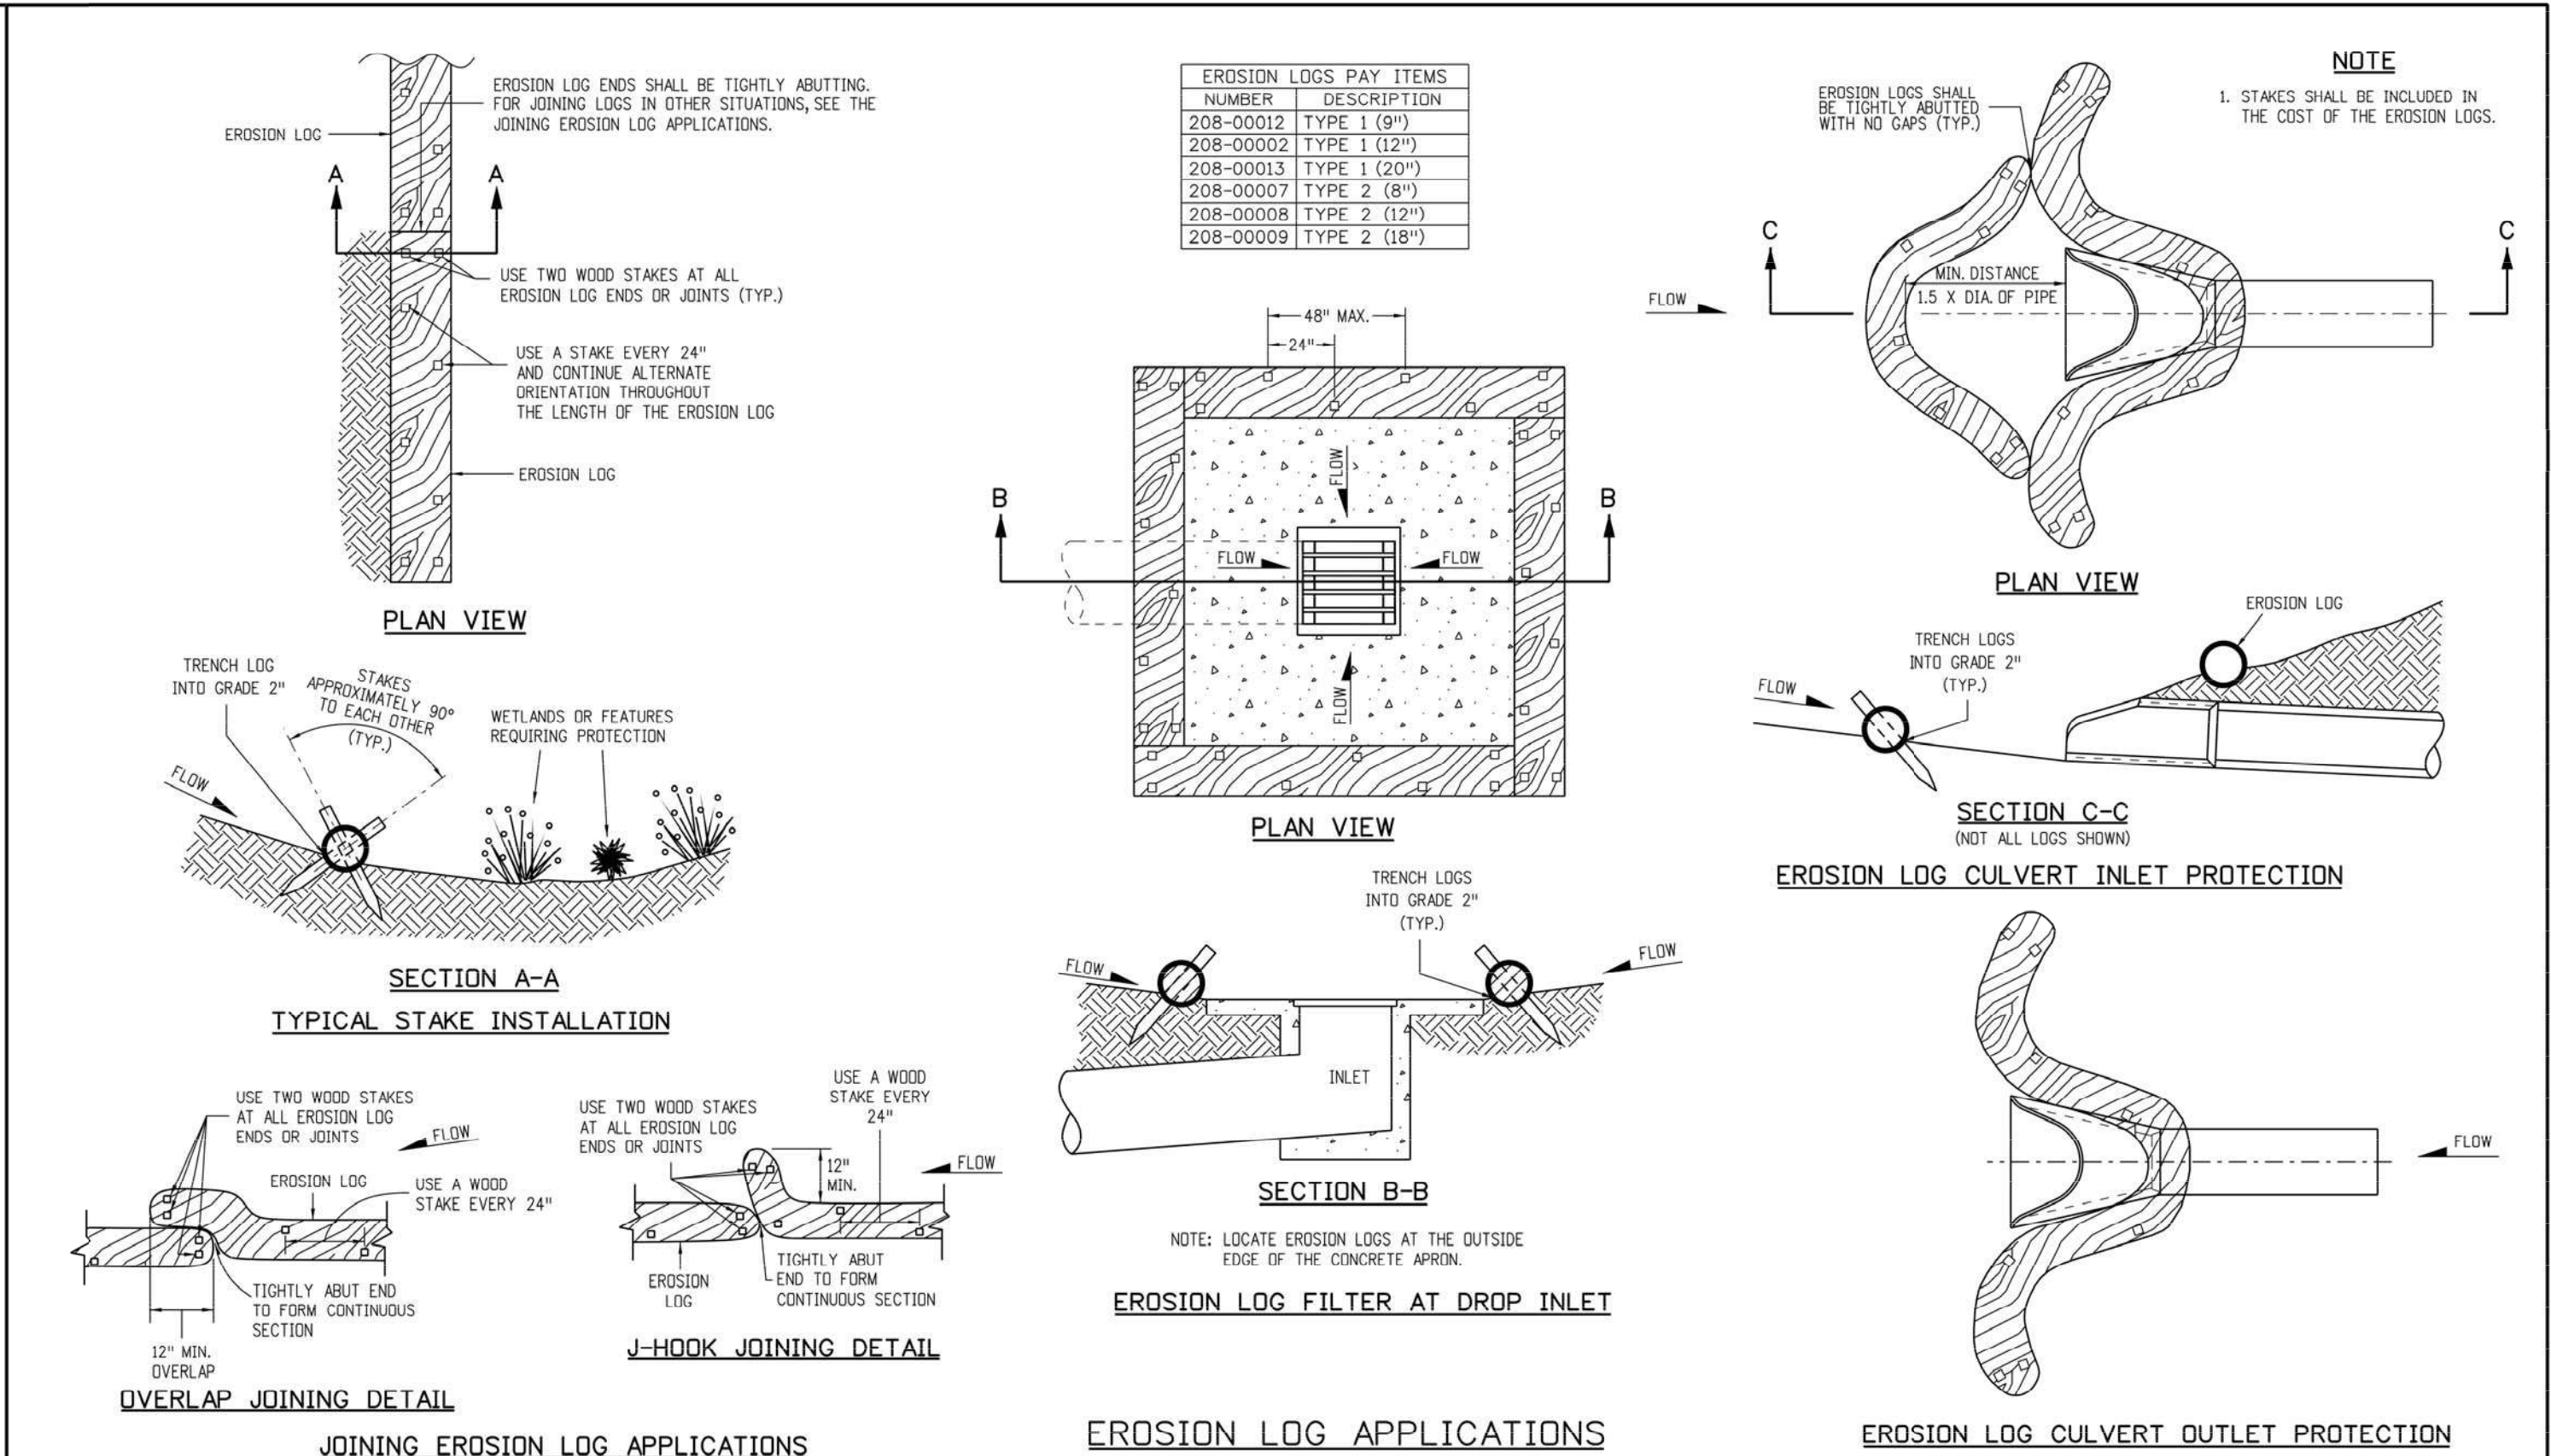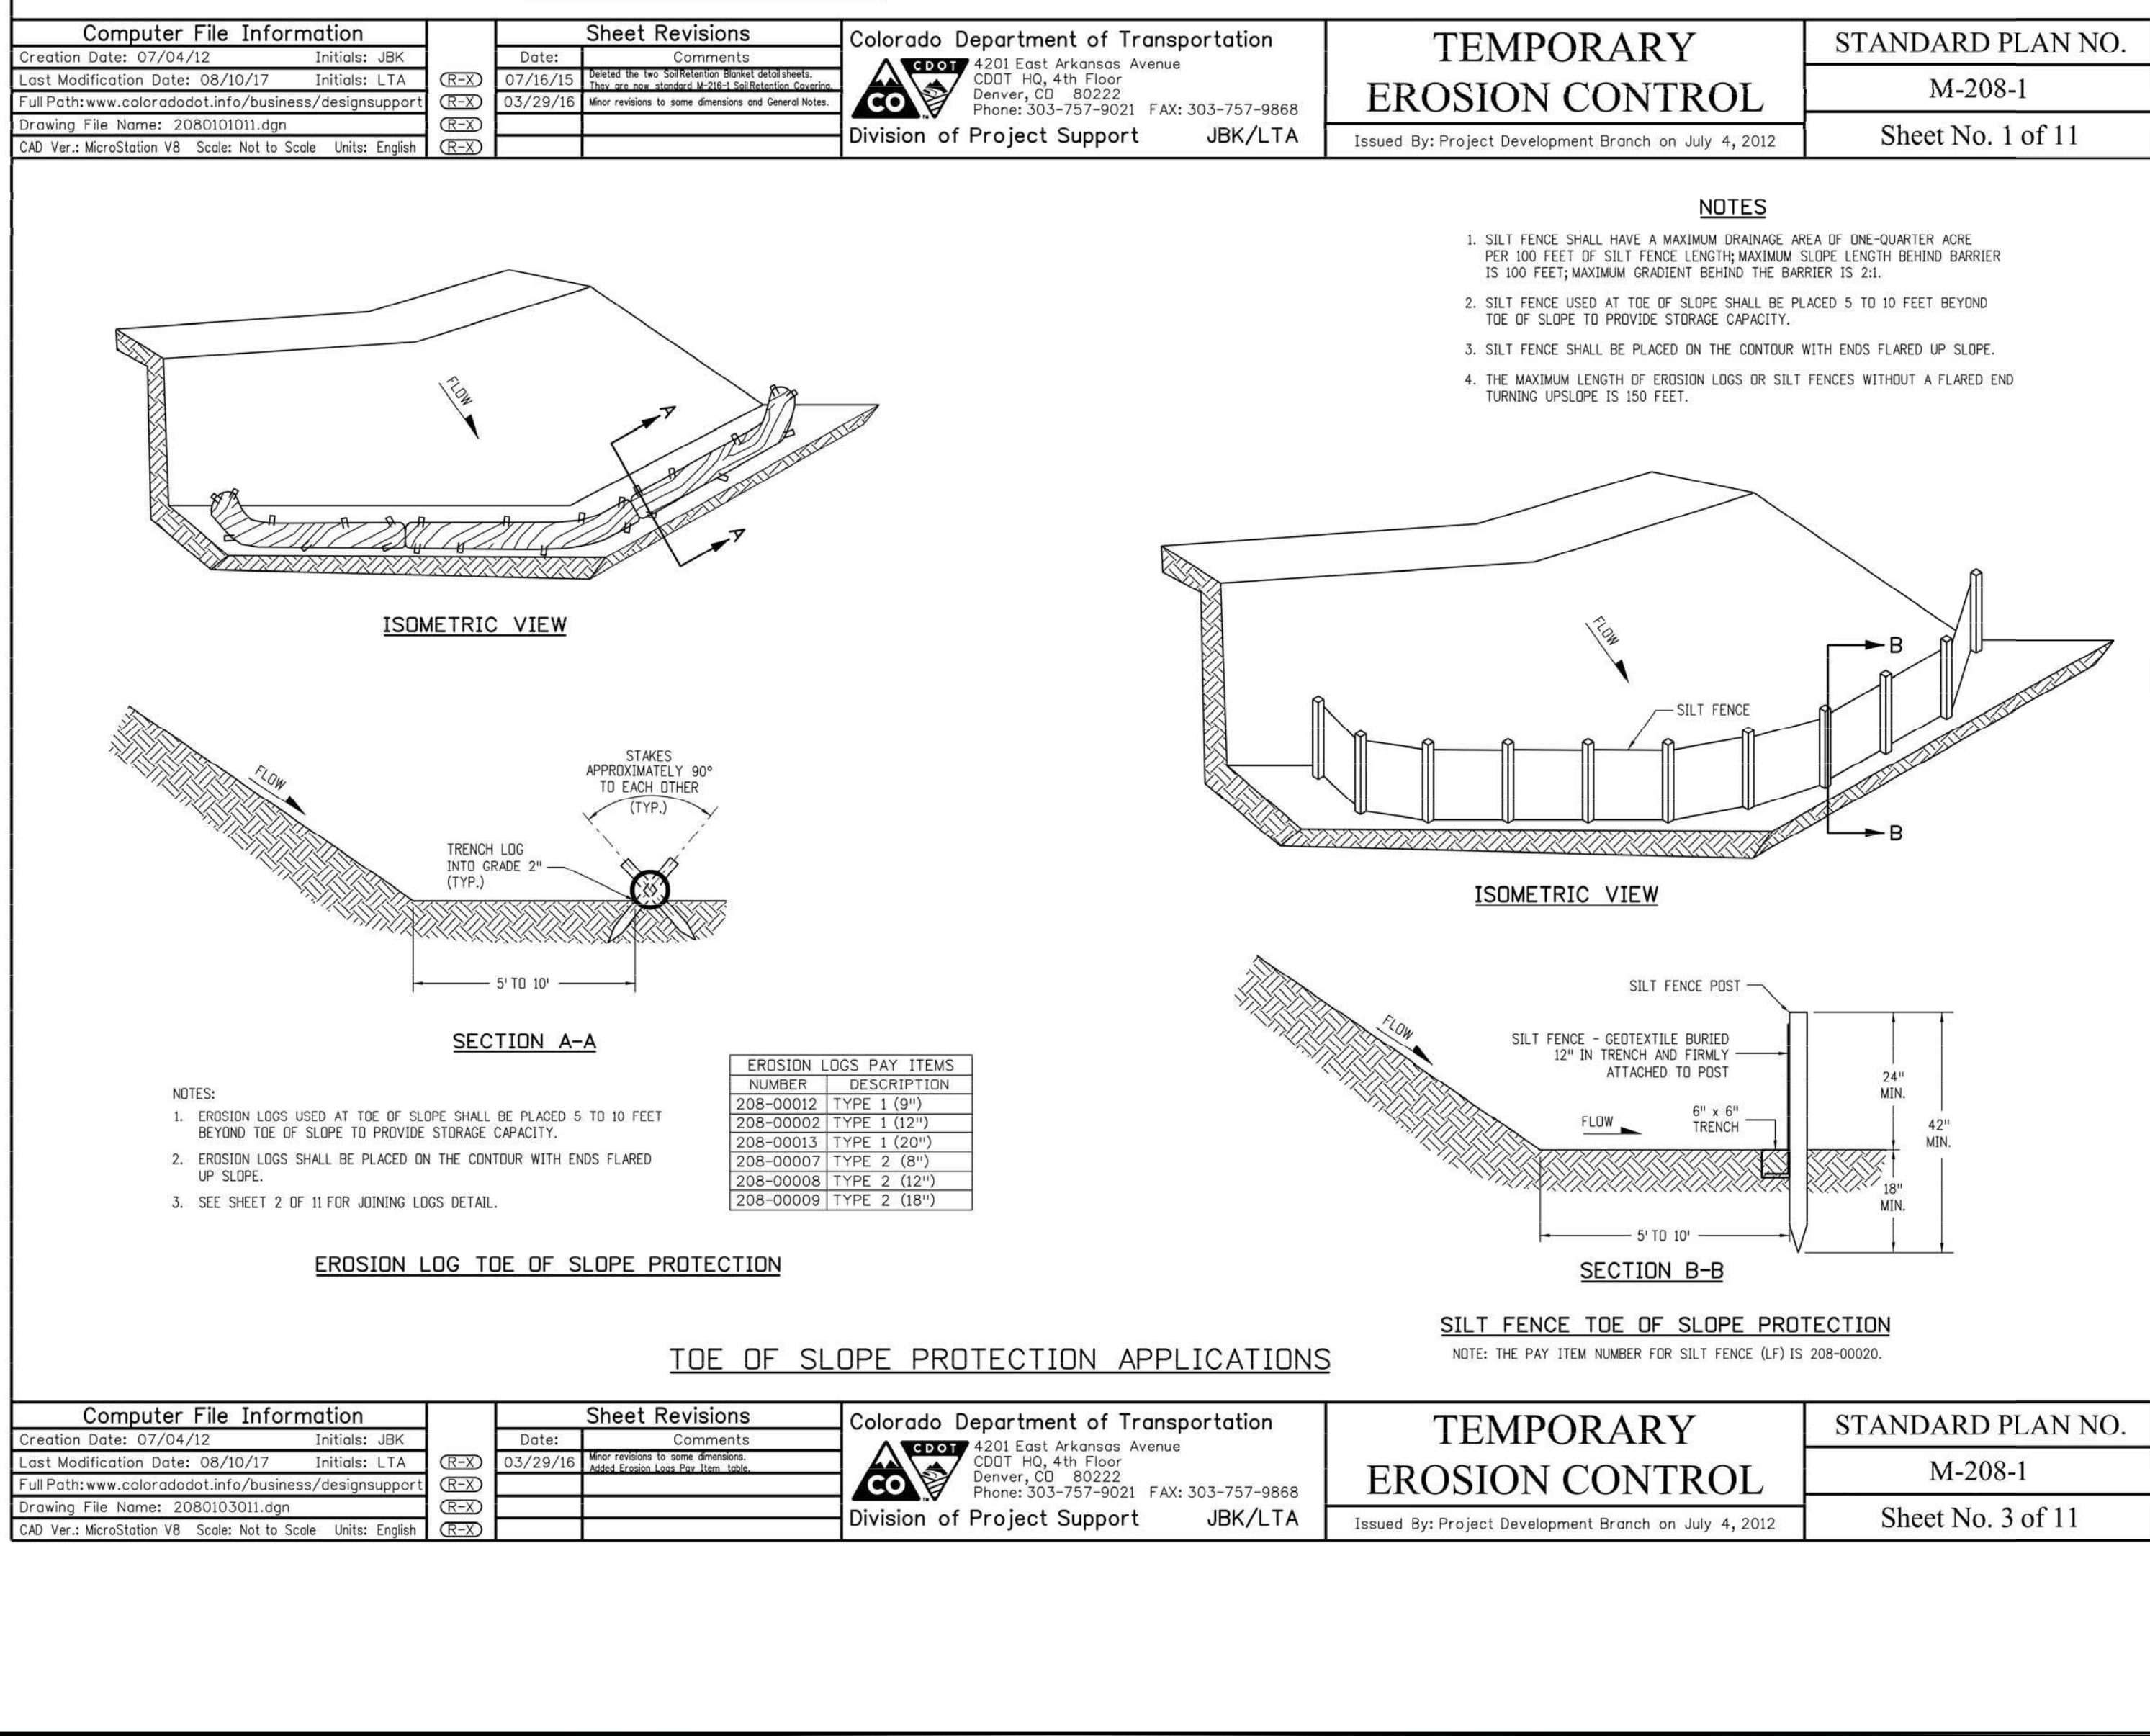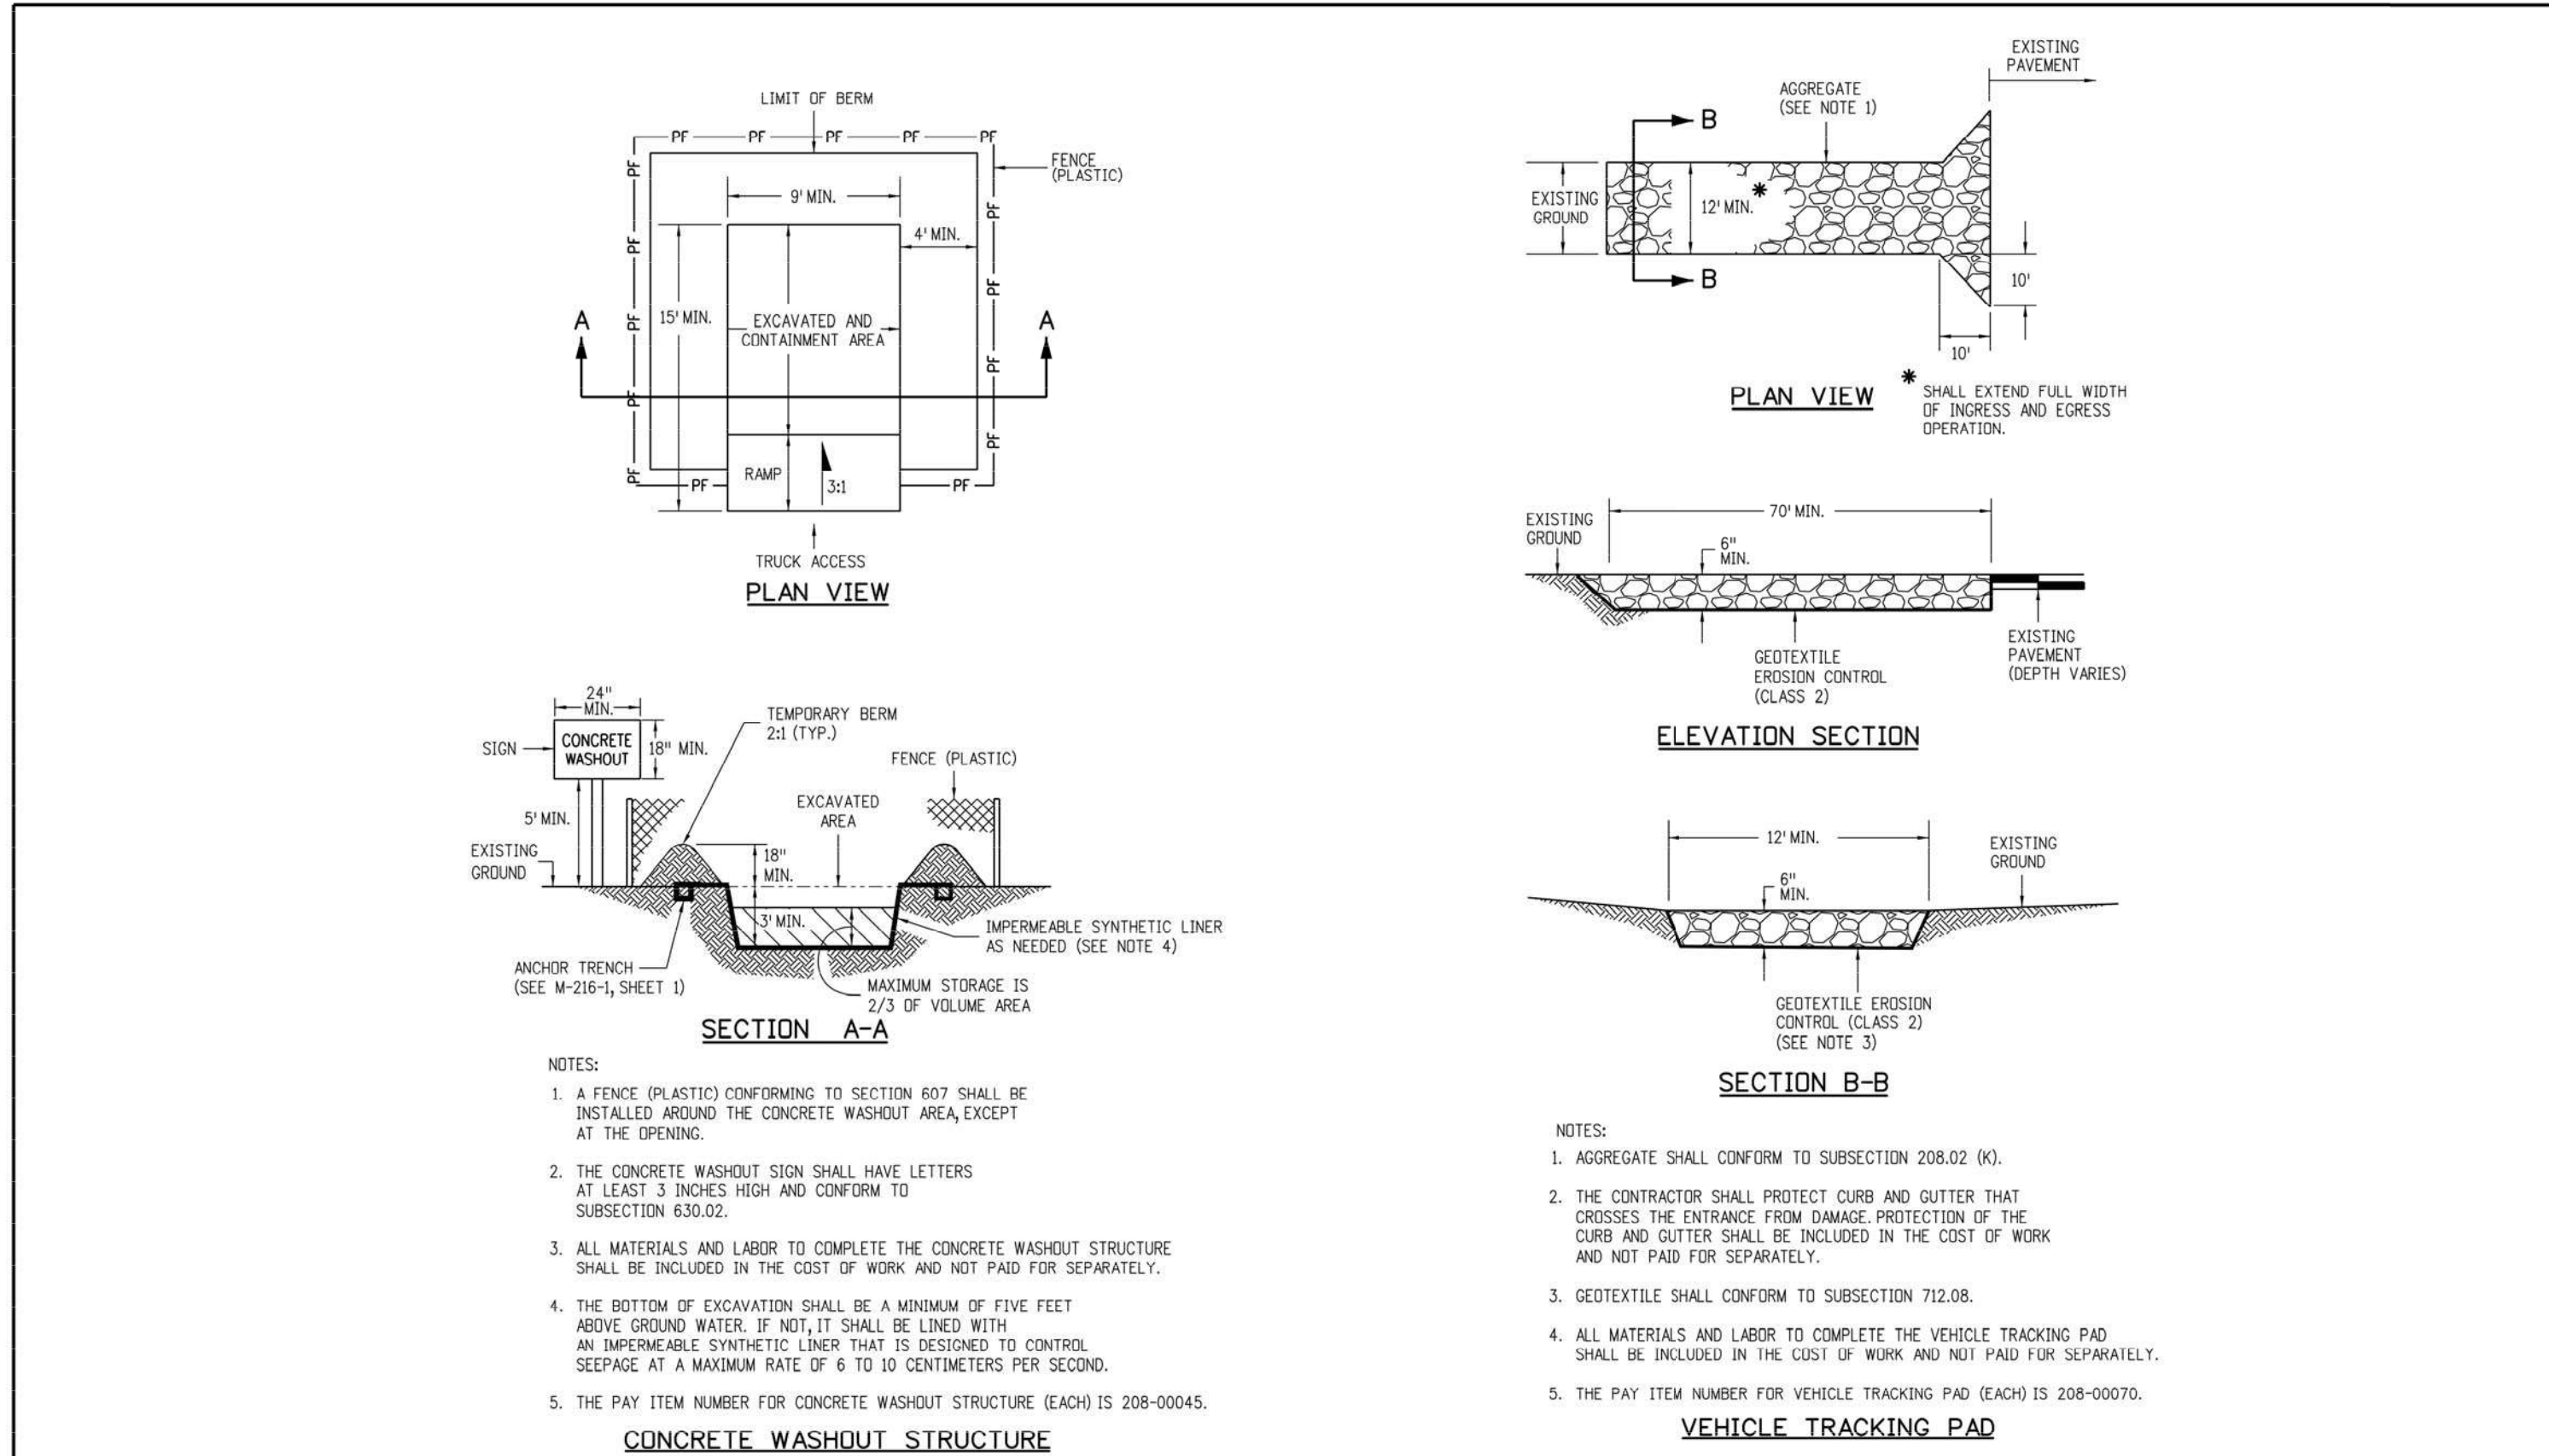

RCRBD  
RECORD SET

**BASELINE**


Engineering - Planning - Surveying  
419 OAK ST. • PO BOX 77062 • STEAMBOAT SPRINGS, CO 80477  
P. 970.979.925 • F. 303.940.9659 • www.baselineinc.com

DESIGNED BY	DATE	PREPARED BY	REVISION DESCRIPTION
SMB	5/3/18	CSR	DESIGN TEAM REVIEW/COORDINATION
DRAWN BY			
CHECKED BY			


CITY OF STEAMBOAT SPRINGS	ROUTT COUNTY
URAAC/SSRA ICONIC ENTRY MT. WERNER CIRCLE/MT. WERNER ROAD	
STEAMBOAT SPRINGS	
EROSION CONTROL DETAILS	
FOR AND ON BEHALF OF BASELINE CORPORATION	
PROFESSIONAL ENGINEER	
40319	
5/3/18	
INITIAL SUBMITTAL	4/25/17
DRAWING SIZE	24" x 36"
SURVEY FIRM	D&D, INC.
SURVEY DATE	10/11/14
JOB NO.	C020169
DRAWING NAME	C020169 CD COVER.dwg
SHEET	13 OF 13




LANDSCAPE PLAN

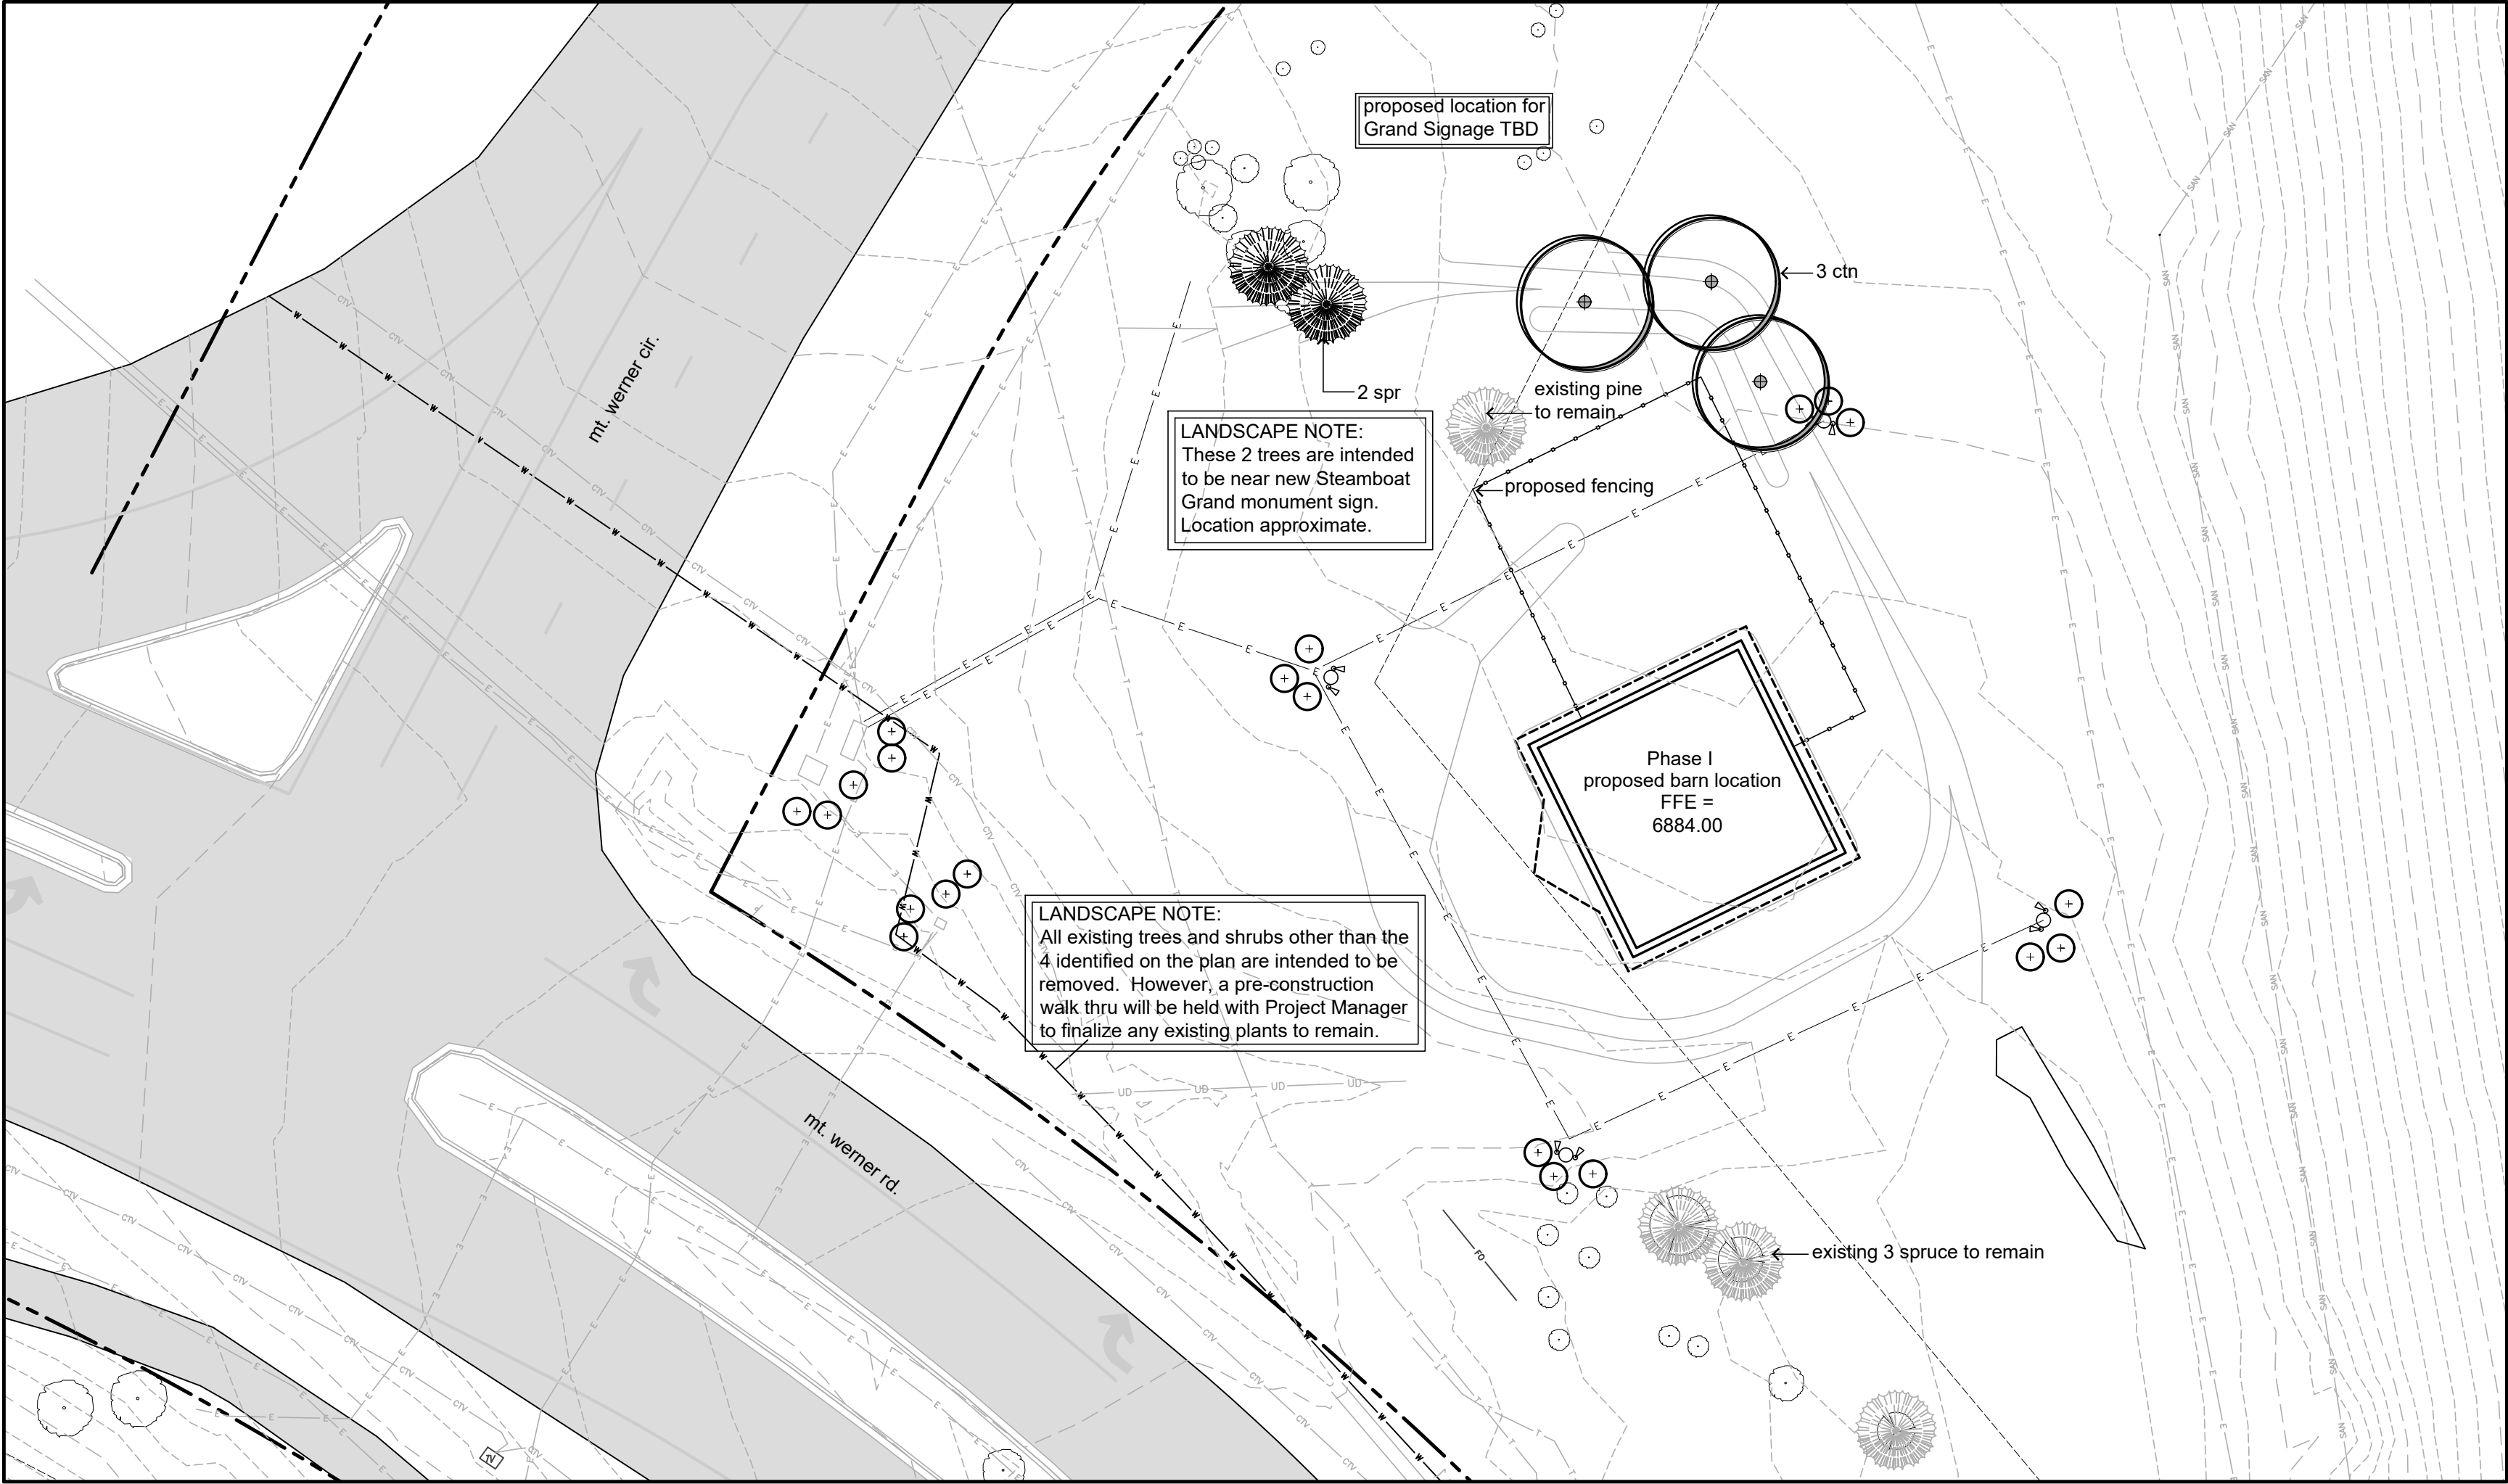

IRRIGATION PLAN

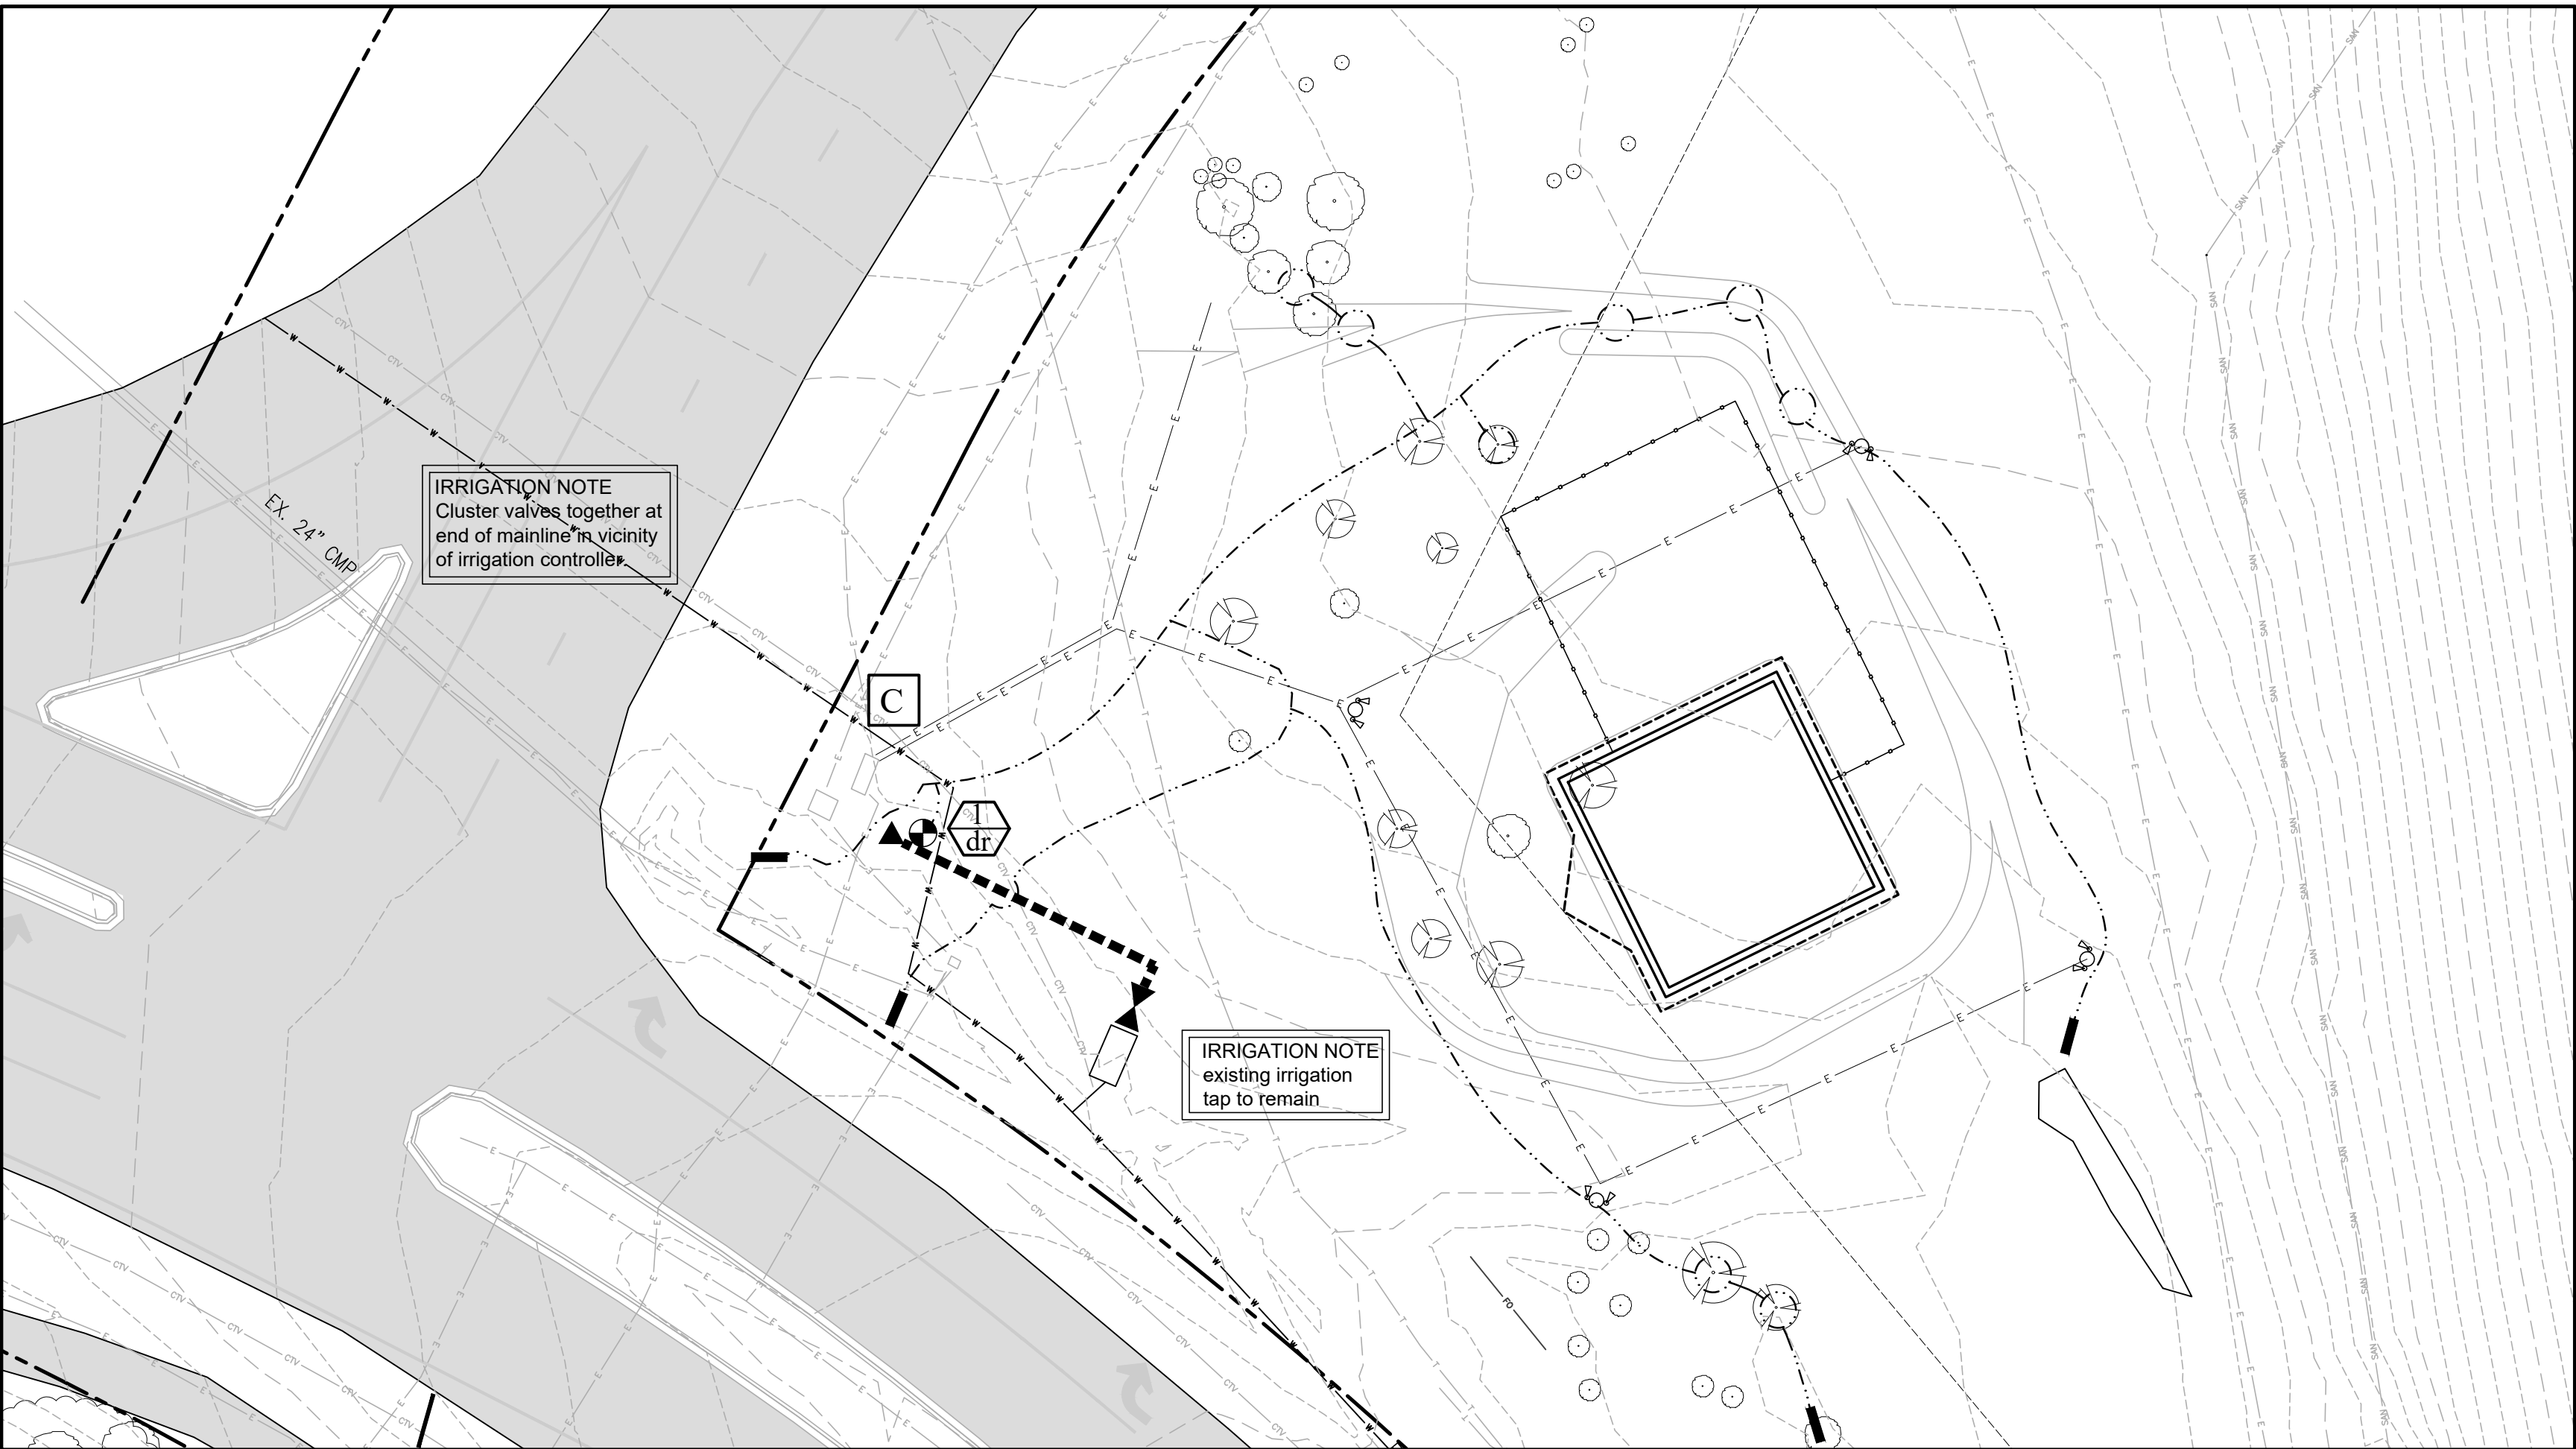

LANDSCAPE LEGEND

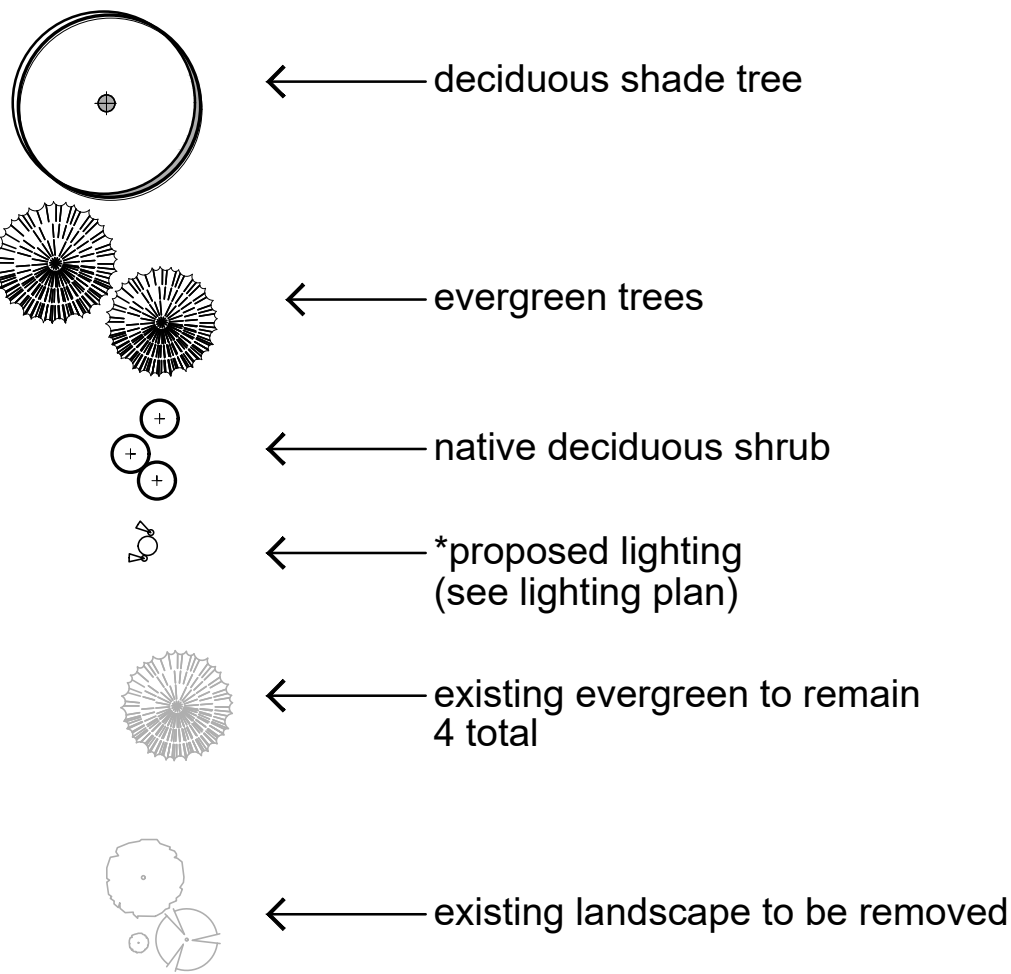

PLANT LIST

#	SYM	BOTANIC NAME	COMMON NAME	SIZE
2	spr	picea pungens	colorado spruce	9'-10' ht.
3	ctn	populus angustifolia	narrowleaf cottonwood	2.5" cal.
21	chk	prunus virginiana	native chokecherry	5 gal.

\* All plants, related irrigation and lighting will be installed in Phase I.

TREE COUNT


- 2 proposed colorado spruce
- 3 proposed narrowleaf cottonwood
- 7 proposed shrubs (21 shrubs = 7 trees)
- 3 existing colorado spruce to remain
- 1 ponderosa pine to remain

16 total

NOTES

- Existing conditions provided by Baseline Engineering.
- Site grading plan provided by Baseline Engineering.
- Prior to the start of any excavation for the project contractor shall notify utility locating company for location of all existing utilities.
- Project manager to approve layout of all proposed work prior to installation.

IRRIGATION LEGEND

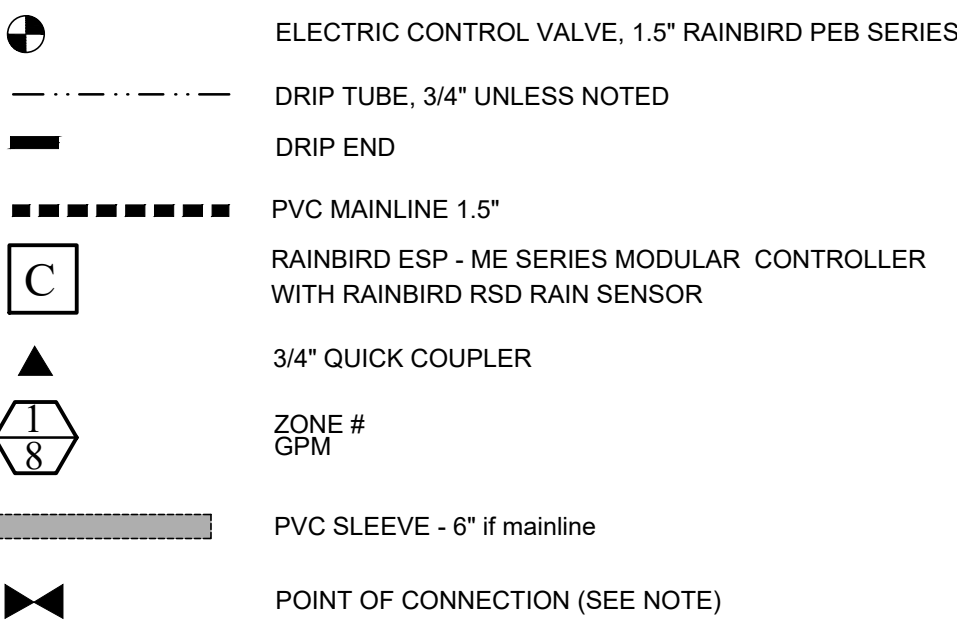

Operating System design parameters - up to 30gpm @ 45psi-Contractor to field verify prior to start of installation  
Point of Connection  
In Place - confirm  
• 1 1/2" backflow prevention device  
• 1 1/2" pressure reducing valve

Irrigation Controller  
• to be installed approximately where shown

GENERAL IRRIGATION NOTES

- Existing Conditions and Site layout plan provided by Baseline Engineering.
- Prior to the start of any excavation for the project the Irrigation Contractor shall notify all local utility locating services for the location of all existing utilities.
- Irrigation drawing is diagrammatic in nature. All heads, valves, mainline, laterals, driptube, sleeves, and related irrigation components are to be located outside of all Public ROW's shown on Civil Drawings. Irrigation Contractor to field locate all ROW's and utility easements to insure that irrigation components are not installed within these areas.
- Contractor shall maintain positive drainage away from all building foundations, structures and planting beds at all times.
- These plans and associated specifications for irrigation system installation begin on the downstream side of backflow prevention device. Specifications and installation of irrigation tap and backflow preventer by others.
- See sheet L.101 for irrigation details and specifications.


Landscape Plan

URACC / SSRA ICONIC ENTRY  
The Arnold Barn Re-Location  
Steamboat Springs, CO

MBC DESIGN, INC.  
LANDSCAPE ARCHITECTURE  
SITE DESIGN  
WATER USE in LANDSCAPE  
P.O. Box 773522  
Steamboat Springs, CO 80477  
(970) 879-7740

sheet #  
L.100




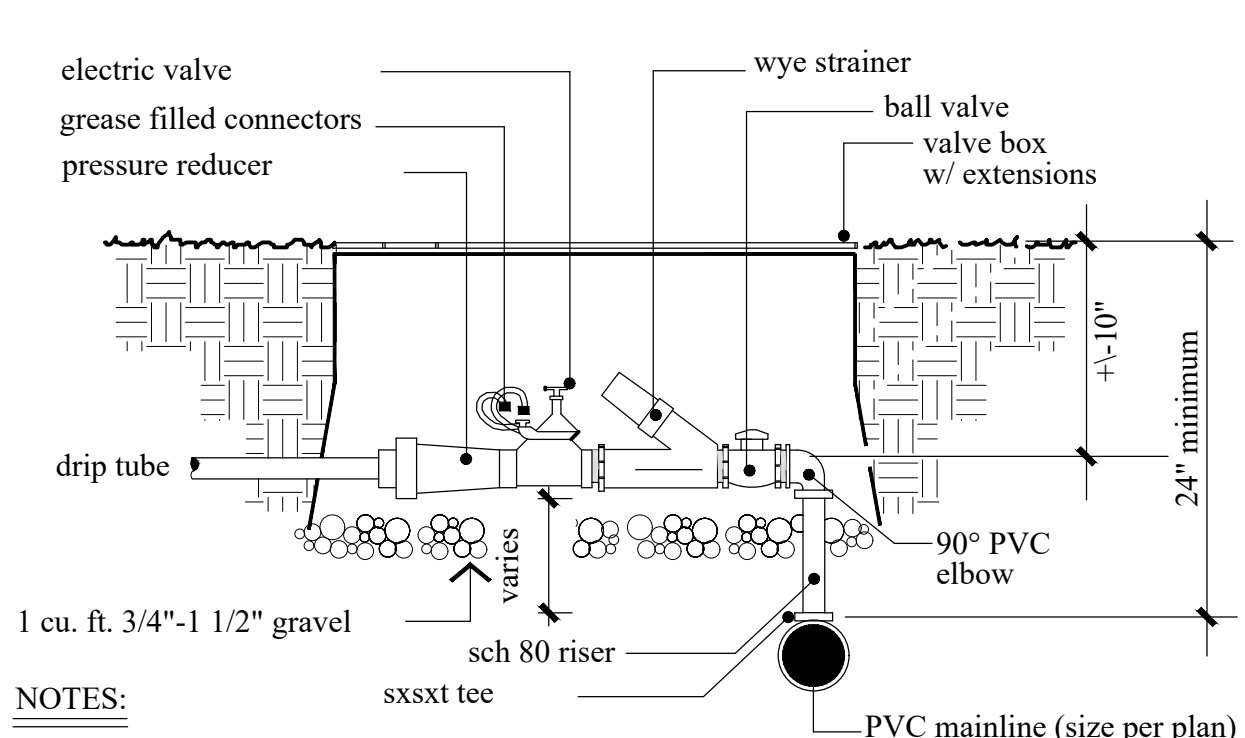


NOTES:

-one valve per large valve box, maximum


**1**  
L.101 DRIP VALVE ASSEMBLY  
no scale

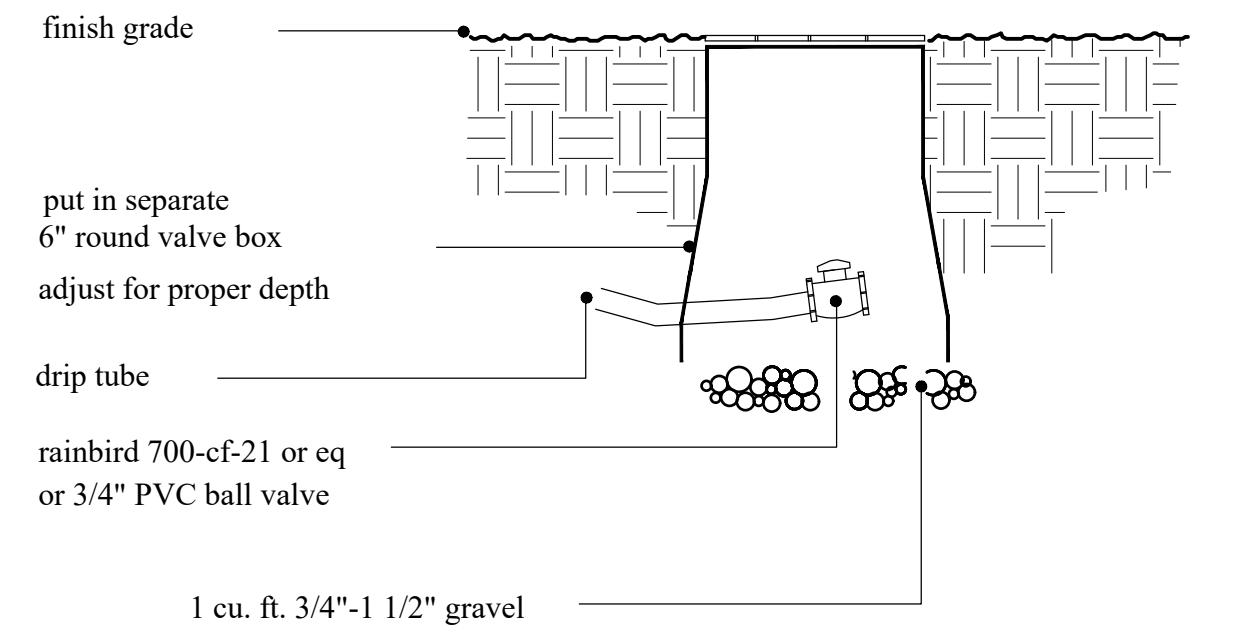


**4**  
L.101 DRIP TUBE END CLOSURE  
no scale

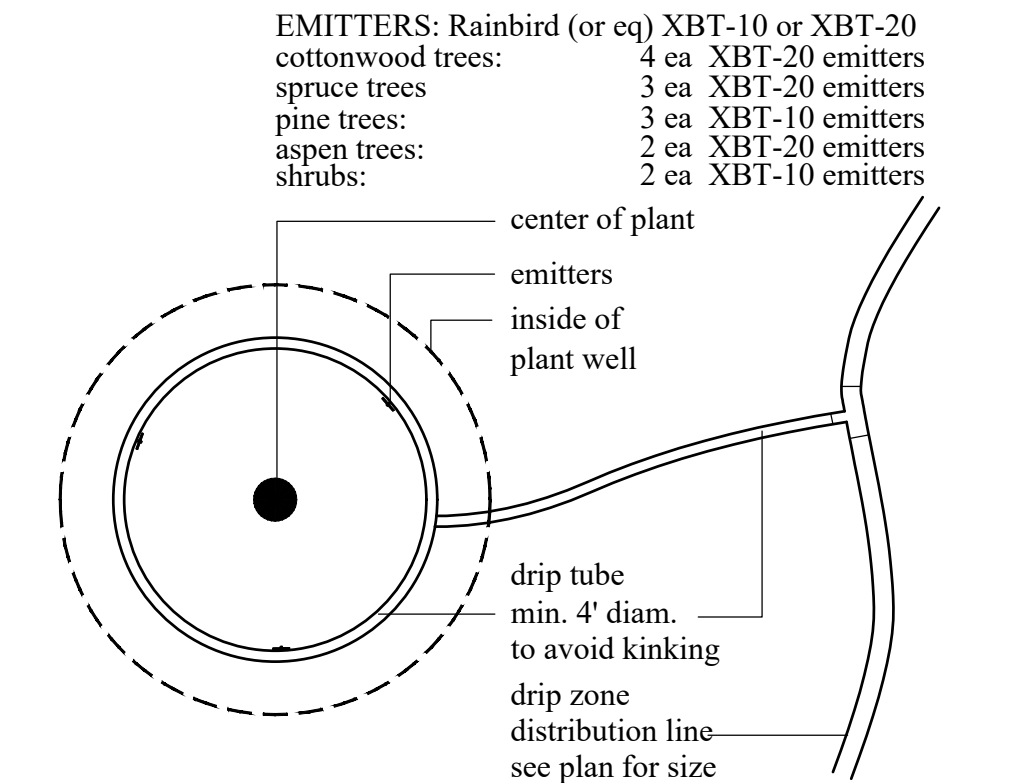

**2**  
L.101 TUBE & EMITTERS AT TREES  
no scale

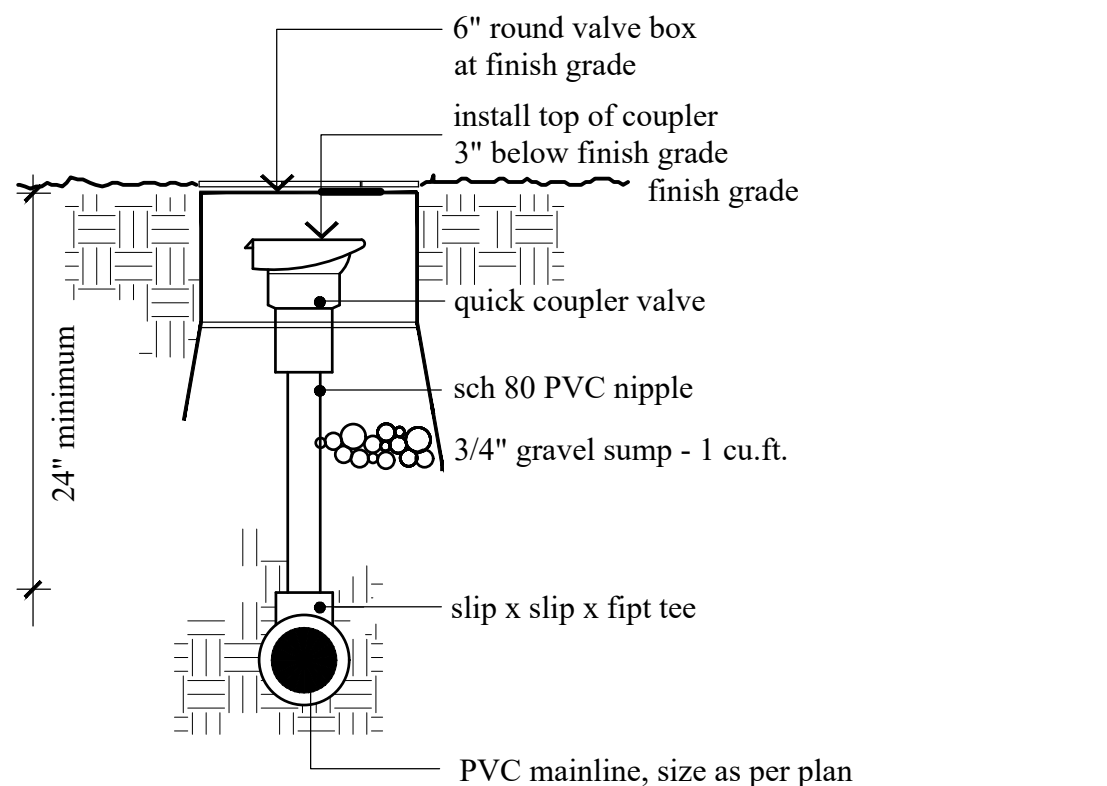


**5**  
L.101 QUICK COUPLER VALVE DETAIL  
no scale


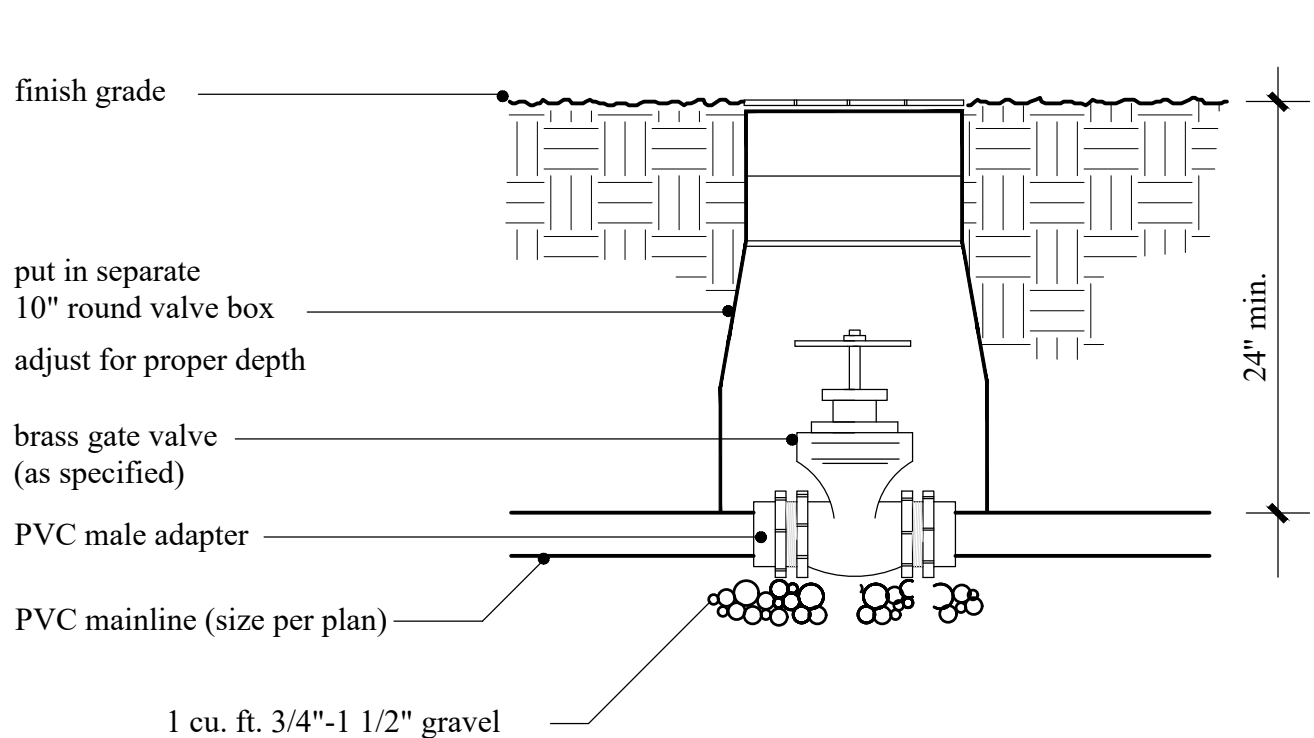


**3**  
L.101 GATE VALVE/ISOLATION VALVE  
no scale

## MAINLINE CONTROL WIRING & WIRING NOT IN MAINLINE TRENCH DRIPTUBE 4\"

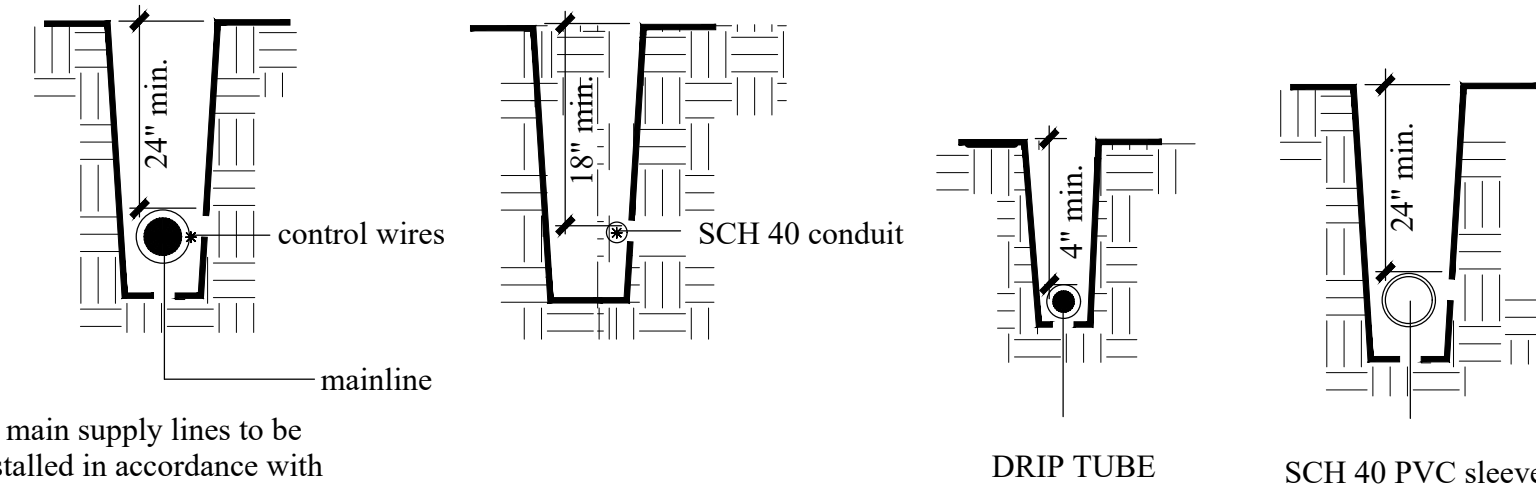

**6**  
L.101 TYPICAL TRENCHING DETAIL  
no scale

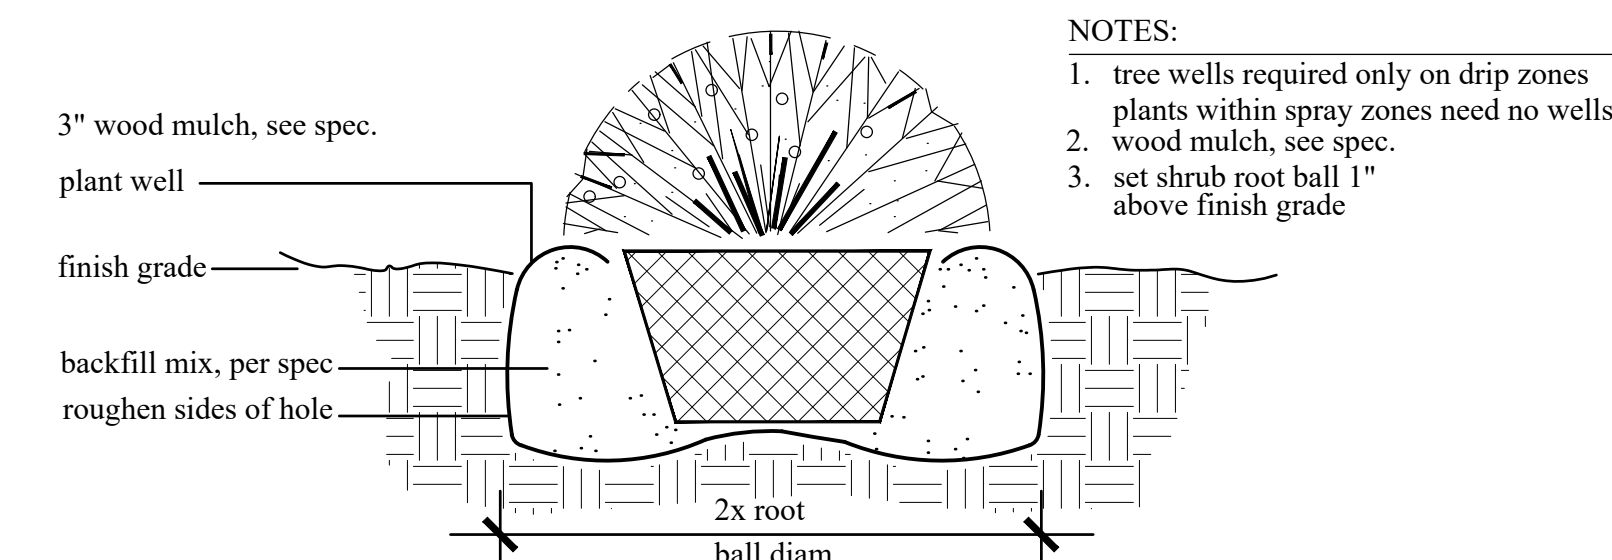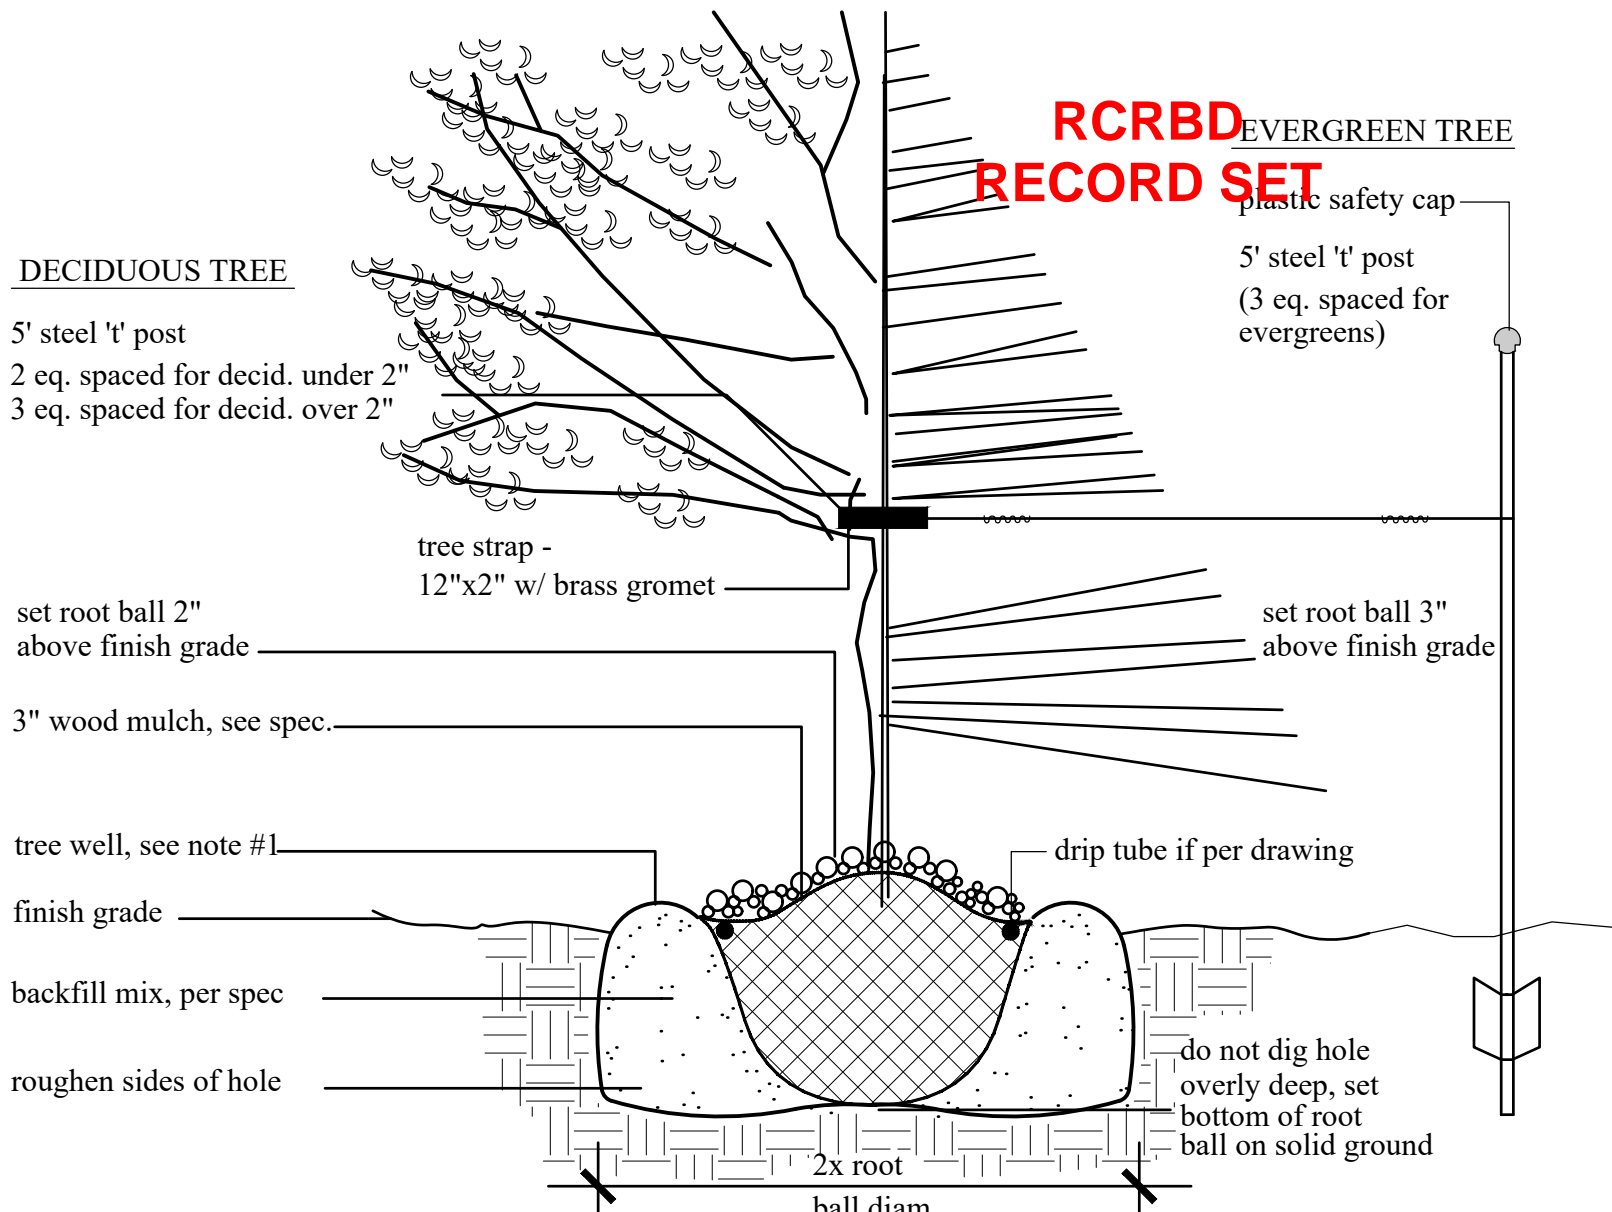

**7**  
L.101 PLANTING DETAILS  
no scale

## DESCRIPTION of WORK - IRRIGATION

- Work shall include all labor, materials and equipment and obtaining of all permits required to complete the sprinkler system as indicated on the irrigation plan and these specifications. The work shall comply with the requirements of all legally constituted authorities having jurisdiction.
- Work shall be performed in accordance with the best standards of practice relating to the various trades and under the continuous supervision of a competent foreman capable of interpreting Drawings and Specifications. The Contractor shall notify the Project Manager as soon as any discrepancies between Drawings and Specifications are discovered.
- Coordinate work of this section with site work, plumbing and other trades and schedule in a manner to avoid damage to other work.
- It is intended that the Drawings and Specifications specify an efficient and complete sprinkler irrigation system for use in accordance with the Manufacturer's recommendations and meeting the Project Manager's approval without further cost to the Owner.
- All plot and/or scale dimensions are approximate. Before beginning any phase of work, the Contractor shall check and verify all dimensions on the Drawings and shall notify the Project Manager of any discrepancies.
- The Contractor shall verify the authenticity of all finish grades within the project area for insurance of proper coverage of the sprinkler system. All finish grades shall be approved prior to installation of the irrigation sprinklers.
- All work specified on the Drawings by notes or details shall be furnished and installed whether or not specifically mentioned in the Specifications.
- Omissions from the Specifications or Drawings, or any misdescriptions of details or work which are absolutely necessary to carry out the intentions of the Drawings and Specifications shall not relieve the Contractor from performing such omitted details of work, but they shall be executed as if fully set forth and described in the Specifications and Drawings, at the Contractor's own expense.

### SUBMITTALS

#### A. Material List

All materials shall be new and the best quality of its kind. In addition to compliance with these Specifications and Drawings, all materials and equipment must be accepted by the Project Manager.

#### B. Record Drawings

The Contractor shall be furnished with three (3) sets of Drawings which indicate the work which is part of this contract. The Contractor shall record all changes in the work (including exact measurements of buried valves and locations) on two (2) sets, which will become the property of the Owner at the time of acceptance.

The Contractor shall dimension from two (2) reference points, (sidewalk or road intersection, etc.) the location of the following items:  
- Connection of existing water lines, routing of pressure supply lines, sleeve locations, sprinkler control valves.

The Contractor shall deliver, on or before the date of final inspection, the corrected and completed Drawings to the Owner or his representative. Additionally, the contractor shall arrange for a surveyor to add to the CAD base map file points for valves, sleeves and irrigation mainline. Delivery of the Record Drawings will not relieve the Contractor of the responsibility of furnishing the Owner with required location information during the one (1) year guarantee period.

#### C. Operation and Maintenance Data

Submit written operating instructions, watering schedule, and winterizing operations to the Owner prior to final acceptance.

### JOB CONDITIONS

#### A. Site Conditions

The Contractor shall coordinate his work with that of other trades wherever possible so as not to conflict. Before starting work, the Contractor shall inspect the site and check all grades to satisfy himself that he may safely proceed. Changes or alterations in the system to meet site conditions shall be made at the Contractor's expense.

#### B. Existing Utilities and Conditions

Before excavation, the Contractor shall call for location of all private and public cables, conduits, sewers, septic tanks, and other underground utilities, and shall be cautious enough as not to damage them. If such obstacles conflict with the proposed work, the Contractor shall immediately notify the Project Manager for arrangements for relocations.

In the event of damage, the Contractor shall repair or replace these lines to the satisfaction of the Owner of these lines.

#### C. Water Supply Source

The water supply source will be in place by others and shall be 1 1/2\"/>

Contractor to confirm design pressure and flow is available prior to the start of installation. Minor changes caused by actual site conditions shall be made by the Contractor at no expense to the Owner.

### WARRANTY

The entire sprinkler system work shall be guaranteed for the period of one (1) year from the date of acceptance of work.

Should any trouble develop within the time specified above, due to faulty workmanship or material, the defect shall be corrected by the Contractor without expense to the Owner. Any setting of backfilled trenches which may occur during the guarantee period shall be repaired without expense to the Owner, including complete restoration of all damaged property.

As part of contract, during the guarantee period the Contractor shall make adjustments to the system as necessary, winterize the system in the 1st Fall with compressed air, put it in operation in the 1st Spring and perform all other necessary service work without additional cost to the Owner.

### MEASUREMENT AND PAYMENT

Measurement of the sprinkler system shall be on the basis of the entire system furnished and installed complete and in place, including all pipe, fittings, sprinkler heads, valves, automatic controller, wiring and incidentals necessary to complete the item and provide the coverage of the areas to be landscaped. Payment will be made on a % complete basis of the lump sum bid. A 10% retainage will be held from each payment and be released upon final acceptance of system and delivery of all specified as built information.

### MAINTENANCE

A. Contractor to maintain irrigation system, controller programing, and valve adjustments within guidelines acceptable to Landscape Architect until final acceptance.

### MATERIALS

- Pipe
  - Mainline. Pipe shall be PVC Pipe Belled end for solvent welds, Class 200 (SDR-21) as manufactured by Continental Plastics Industries, Inc., or approved equal. All pipe shall be continuous, new and permanently marked with the manufacturer's name. All pipe shall conform to the United States Department of Commerce commercial standard ASTM D-2241, National Sanitation Foundation No. 14. Pipe shall be sized as per Drawings.
  - Sleeving. Irrigation sleeving shall be PVC Schedule 40 pipe sized as per Drawings. All pipe shall be continuous, new and permanently marked with the manufacturer's name. All pipe shall conform to the United States Department of Commerce commercial standard ASTM-D-2241 NSF approved.
  - Fittings and Connections. All PVC pipe fittings shall be ASTM D-2241 Schedule 80 molded fittings suitable for solvent weld or with nipples and swing joint assemblies, screwed connections.
- Valves And Keys
  - Electric Remote Control Valve. Valves shall be of type and size as indicated drawings.
  - Quick Coupling Valves (2-piece body). The quick coupling valves, where indicated in the Drawings, shall be of type and size as indicated on drawings. Sprinkler Quick-Coupling Valve Keys. The valve keys shall be of the same manufacturer as the quick coupling valves and shall be of proper size to fit the valves as previously specified. Top key shall have male and/or female thread, as specified, for the sprinkler connection.
  - Isolation/Gate Valve. All brass, size per plan.
  - Valve Boxes. All remote control valves, gate valves and quick coupler valves shall be installed in suitable thermoplastic valve access boxes of proper size as required for easy access to the valve.

D. Automatic Controller. Irrigation Contractor shall supply the controller to site electrician. The controller will be installed where convenient along with other electrical components such as meter and panel for barn lighting. See plan.

E. Irrigation Control Wiring. All wiring to be used for connecting the automatic controller to the electric remote control valves shall be the type UF-600V, #14, single wire direct burial UF irrigation control cable. All pilot or "hot" wires are to be of one color and all "common" wires are to be another color. Extra wire will be used in the case of wire failure. See drawings for notes on additional, future, and spare wiring.

### EXECUTION

#### INSTALLATION SCHEDULE, IMPLEMENTATION & SYSTEM TESTING

The irrigation work shall be scheduled by the Contractor in such a way that it is not interrupted for periods so long that plant materials and lawns are injured permanently. When Contractor is prepared for one of the required inspections, he shall give the Project Manager & Landscape Architect twenty-four (24) hours notice to visit the site and perform the inspection. This does not preclude the right of the Project Manager to make informal inspections at any time during the work of this section. The required inspections for which the Contractor must notify the Project Manager are as follows:

- Planting, Utility And Sprinkler Location Staking. The Landscape Architect shall inspect the staked locations of all utility lines, proposed trees and shrubs and sprinkler lines and heads for conformance to these Drawings and Specifications. The Landscape Architect reserves the right to move, shift or adjust any or all of the stakes to better achieve the design intentions as shown on the Drawings. No trenching shall be done until approval of inspection is complete.
- Mainline Pressure Test. In the presence of the Project Manager & Landscape Architect, the Contractor shall conduct a pressure test on the mainline pipe at the full applicable system design pressure to determine if there are any leaks in the pipe or joints. A minimum of twenty four (24) of soil will be placed over lines, with all joints exposed during testing, and all valves uncovered. Failure to execute testing in this manner will be corrected at the Contractor's expense.

#### CONTROL WIRING

Control and Common Wire Installation. Control, common and extra wires shall be installed beside the mainline (see Details). Wire shall then be placed as loose as possible and with as much slack as possible to allow for expansion and contraction of the wire. Where it is necessary to run wire in a separate trench, the wire shall have a minimum cover of twelve inches (18\") and shall be sleeved in Schedule 40 PVC electrical conduit. Verification of wire types and installation procedures should be checked to conform to local codes. Connecting and splicing of wire at the valve or in the field may be made by using Pen-lite wire connectors or grease filled wire nuts (as designated by the Details).

#### AUTOMATIC CONTROLLER

Controller shall be as specified. Irrigation contractor to provide controller to project electrician for mounting and connection to 110v power.

#### VALVES AND VALVE BOXES

Control Valves And Quick Coupler Valves. Quick Coupler valves shall be installed as per details on this sheet.

Valve Boxes. Control valve boxes shall be installed on a minimum of one (1) cubic foot base of gravel for proper foundation of box and easy leveling of box to proper grade and also to provide drainage of the access box.

#### TAP AND BACKFLOW PREVENTER

Backflow preventer and pressure reducing valve are in place per water district details and not a part of this contract. Contractor to confirm design pressure and flow is available prior to the start of installation. See Point of Connection note.

#### FLUSHING

After all new sprinkler piping is in place and connected for a given section, and all necessary work has been completed, prior to the installation of the sprinkler heads, all control valves shall be opened and a full head of water used to flush out the system.

#### PLASTIC PIPELINE, FITTINGS

All workmanship and materials shall be in conjunction with all applicable local codes and ordinances of legally constituted authorities: where the provisions of these Specifications exceed such requirements, these Specifications shall govern. All plastic pipe shall be installed in a manner so as to provide for expansion and contraction as recommended by the Manufacturer.

#### BACKFILLING

In no event shall trenches be backfilled until all required tests of the system have been completed and until the line has been approved by the Project Manager. Trenches shall be carefully backfilled with the excavated soil after all dirt clods and rocks larger than three inches (3\") in diameter have been either broken up or removed. The backfill shall then be equally distributed on both sides of the pipe in twelve inch (12\") layers and thoroughly compacted.

Pudding or jetting shall be used during backfilling operations. An excess of water shall be avoided in order to prevent disturbance of the ground around the periphery of the pipe and also to prevent unnecessary pressure on the pipe. When jetting is used, jets shall be of approved quality and sufficient length to reach the bottom of each layer.

Backfilling of trenches which cross future paths, as indicated on the Drawings, shall be thoroughly compacted to ninety-five percent (95%) relative compaction.

Any setting of backfilled trenches which may occur during the guarantee period shall be repaired without expense to the Owner, including complete restoration of all damaged property.

#### LINES UNDER PAVEMENT

Provide sleeves using Schedule 40 PVC pipe sized as per Drawings where mainline and wire cross under future paths. Have surveyor locate all sleeves under paving and include within as built information.

Backfill trenches under paving, asphaltic concrete or concrete, with sand six inches (6\") below and three inches (3\") above the pipe, compacted in six inch (6\") layers to ninety-five percent (95%) Standard Proctor density, using manual or mechanical tamping devices. Leave trenches flush with subgrade level to receive paving. Set in place, cap and pressure test all piping under paving prior to the paving work.

Provide a minimum cover of twenty inches (24\") between the top of the pipe and the bottom of the aggregate base for all piping installed under paving.

#### ADJUSTMENTS AND WINTERIZATION

During the guarantee period, the Contractor shall make adjustments to the system as necessary, drain the system in the Fall and put it in operation in the Spring and perform all other necessary service work without additional cost to the Owner.

The Contractor shall winterize the completed system at the conclusion of the first sprinkling season upon notification (within [3] days) to the Owner. All water shall be removed from the system by using compressed air. Contractor shall re-open, operate and adjust system malfunctions accordingly during the following year as requested by the Owner. The Contractor shall be responsible for properly draining the backflow preventer and making adjustments/replacements during the guarantee period.

#### PROTECTION AND REPAIRS

Protection of Property. It shall be the responsibility of the Contractor for the protection and preservation of all plant materials, structure, ground surfaces, etc., from damage during irrigation construction. If damage does occur, all damage shall be completely repaired or restored by the Contractor at his own expense to the satisfaction of the Project Manager.

#### CLEAN UP

A. Perform clean up as a continuous operation throughout the duration of the work.

#### FINAL INSPECTION

When the Contractor is satisfied that the system is operating properly, that it is balanced and adjusted, and that all work and clean up is completed, he shall notify the Project Manager that he is prepared for Final Inspection with date and time at least seventy-two (72) hours in advance. At the given time the sprinkler system shall be inspected by the Project Manager and Landscape Architect for the following:

Gate valves and control valves operating properly and not leaking.

All drip emitters operational  
Controllers operating properly and programmed.

Any inconsistencies to the Drawings or Specifications shall be noted in writing by the Project Manager and/or the Landscape Architect and given to the Contractor.

## DESCRIPTION of WORK - LANDSCAPE

The work included under this section consists of furnishing all fees and permits, all labor, tools, equipment, material, transportation and services required to furnish and properly install all planting and related items as required by the Contract Drawings. Sheet L-100 and these Specifications. The general extent of the planting is as noted, indicated and/or detailed on the Drawings and includes, but is not necessarily limited to the following:

- Excavating, planting, and backfilling for all plant materials.
- Walk through and replacement guarantee.
- Maintenance through construction period.

### PROJECT CONDITIONS

- Planting work shall be done under the direct supervision of a qualified superintendent working on the site with experienced laborers familiar with planting procedures.
- The Owner may schedule a pre-construction conference with Contractor at least 7 days before beginning work under this Section. Purpose of this conference is to review questions Contractor may have regarding the work, administrative procedures during construction and project work schedule.

### SUBMITTALS

Mulches - wood mulch

### WORK SCHEDULE

Proceed with the work as rapidly as the site becomes available, consistent with normal seasonal limitations for planting work.

### PRODUCT DELIVERY, STORAGE AND HANDLING

Labeling. Furnish standard products in manufacturer's standard containers bearing original labels legibly showing quantity, analysis, genus/species and name of manufacturer/grower.

### GUARANTEE

- Warrant that all plant materials are true to species and variety. Warrant that all trees and shrubs planted under this Contract will be healthy and in flourishing condition of active growth one year from date of Final Acceptance.

### REPLACEMENTS

- For a period of one (1) year after final acceptance of all work and at no additional cost to the Owner, the Contractor is to replace any plant material that is not healthy and flourishing and/or dead.

### PRODUCTS

#### PLANT MATERIALS

- Plant Material - All plant material shall be supplied in sizes as indicated in plant list.
- Substitutions are not permitted except on proof that plant materials specified are not available. Request for substitution must be made to the Owner. Cost of substitute plants shall be approved by the Owner. Larger plants than those specified in the plant list may be supplied in which case the root system shall be proportional to the size of the component parts of the plant in the opinion of the Project Manager.
- The Owner and Project Manager shall have the right to reject plants prior to and during progress of work for size, conditions of top structure, condition of root structure, defects or injuries, or non-conformity to specifications.

#### TREE STAKING AND GUYING

Tree brace straps shall be provided at connection of guy or pole support wires to tree trunk.  
Staking poles shall be standard "T" five (5) foot high steel fence posts, dark green or approved color.  
Guy wire shall be 14 gauge single strand pliable wire or equal.

#### MULCHING MATERIAL

- Western Cedar Mulch. To be used in maintained plant beds. Shredded Cedar of a brown color free of twigs, sticks, dirt, sawdust and stones to be approved by Landscape Architect prior to installation. Chipper mulch is not acceptable.

### EXECUTION

#### PLANTING

- Locations of all Material shall be flagged and approved by the Landscape Architect and Owners Representative before planting. 4' survey lath is to be used for tree layout. 5 gal. and less size plants will be placed for layout approval. Any materials placed in ground without location approval, will be subject to re-location at Contractor's expense. Do not install irrigation heads or piping prior to bed layout approval.
- In drip applications, build 3 inch berm around the edge of the rootball to form basin for holding water.

#### STAKING AND GUYING

All trees shall be staked and guyed as detailed.

#### MULCHES

- Mulching shall take place after all shrubs and trees have been planted and all drip systems have been inspected.
- Install a 3 inch deep layer of wood mulch in all shrub and tree rings.

#### GENERAL CLEAN-UP

During the process of the work, the site shall be kept in a condition which is clean, neat, and free from the accumulation of cans, surplus materials, and waste materials. All planting areas shall be neatly dressed and finished and all walks, paved areas, and the like flushed clean to the satisfaction of the Owner.

#### FINAL WALK-THROUGH

- The Contractor shall arrange for presence of the Owner Representative, Project Manager and Landscape Architect 72 hours in advance.
- The Owner shall be satisfied with all aspects of the entire project. Once all items have been resolved to the satisfaction of the Owner, the Owner shall notify the Contractor in writing of final acceptance and the one year warranty on all materials and labor shall begin.

date 9-12-17
city submittal #1
rev. 11-17-17
city submittal #2
rev. 12-6-17
lac comments
rev. 5-11-18
construction set

## Landscape & Irrigation Details and Specifications

## URACC / SSRA ICONIC ENTRY The Arnold Barn Re-Location Steamboat Springs, CO



sheet #  
**L.101**





MOUNTAIN ARCHITECTURE  
DESIGN GROUP P.C.  
Jan Michael Kaminski,  
President  
P.O. BOX 17000  
STEAMBOAT SPRINGS, COLORADO 80487  
(970) 861-1111  
jmk@mountainarch.com


AN ICONIC ENTRY FOR THE  
**ARNOLD BARN INTERPRETIVE DISPLAY**  
2305 MT. WERNER CIR.  
STEAMBOAT SPRINGS, CO. 80487-9023

TITLE  
**EXISTING FLOOR PLANS**


JOB NO. PROJECT NUMBER  
DRAWN BY LRR  
CHECKED BY JMK  
ISSUE DATE 5/25/2018

REVISIONS:  
1 DATE

DRAWING NUMBER  
**A2**

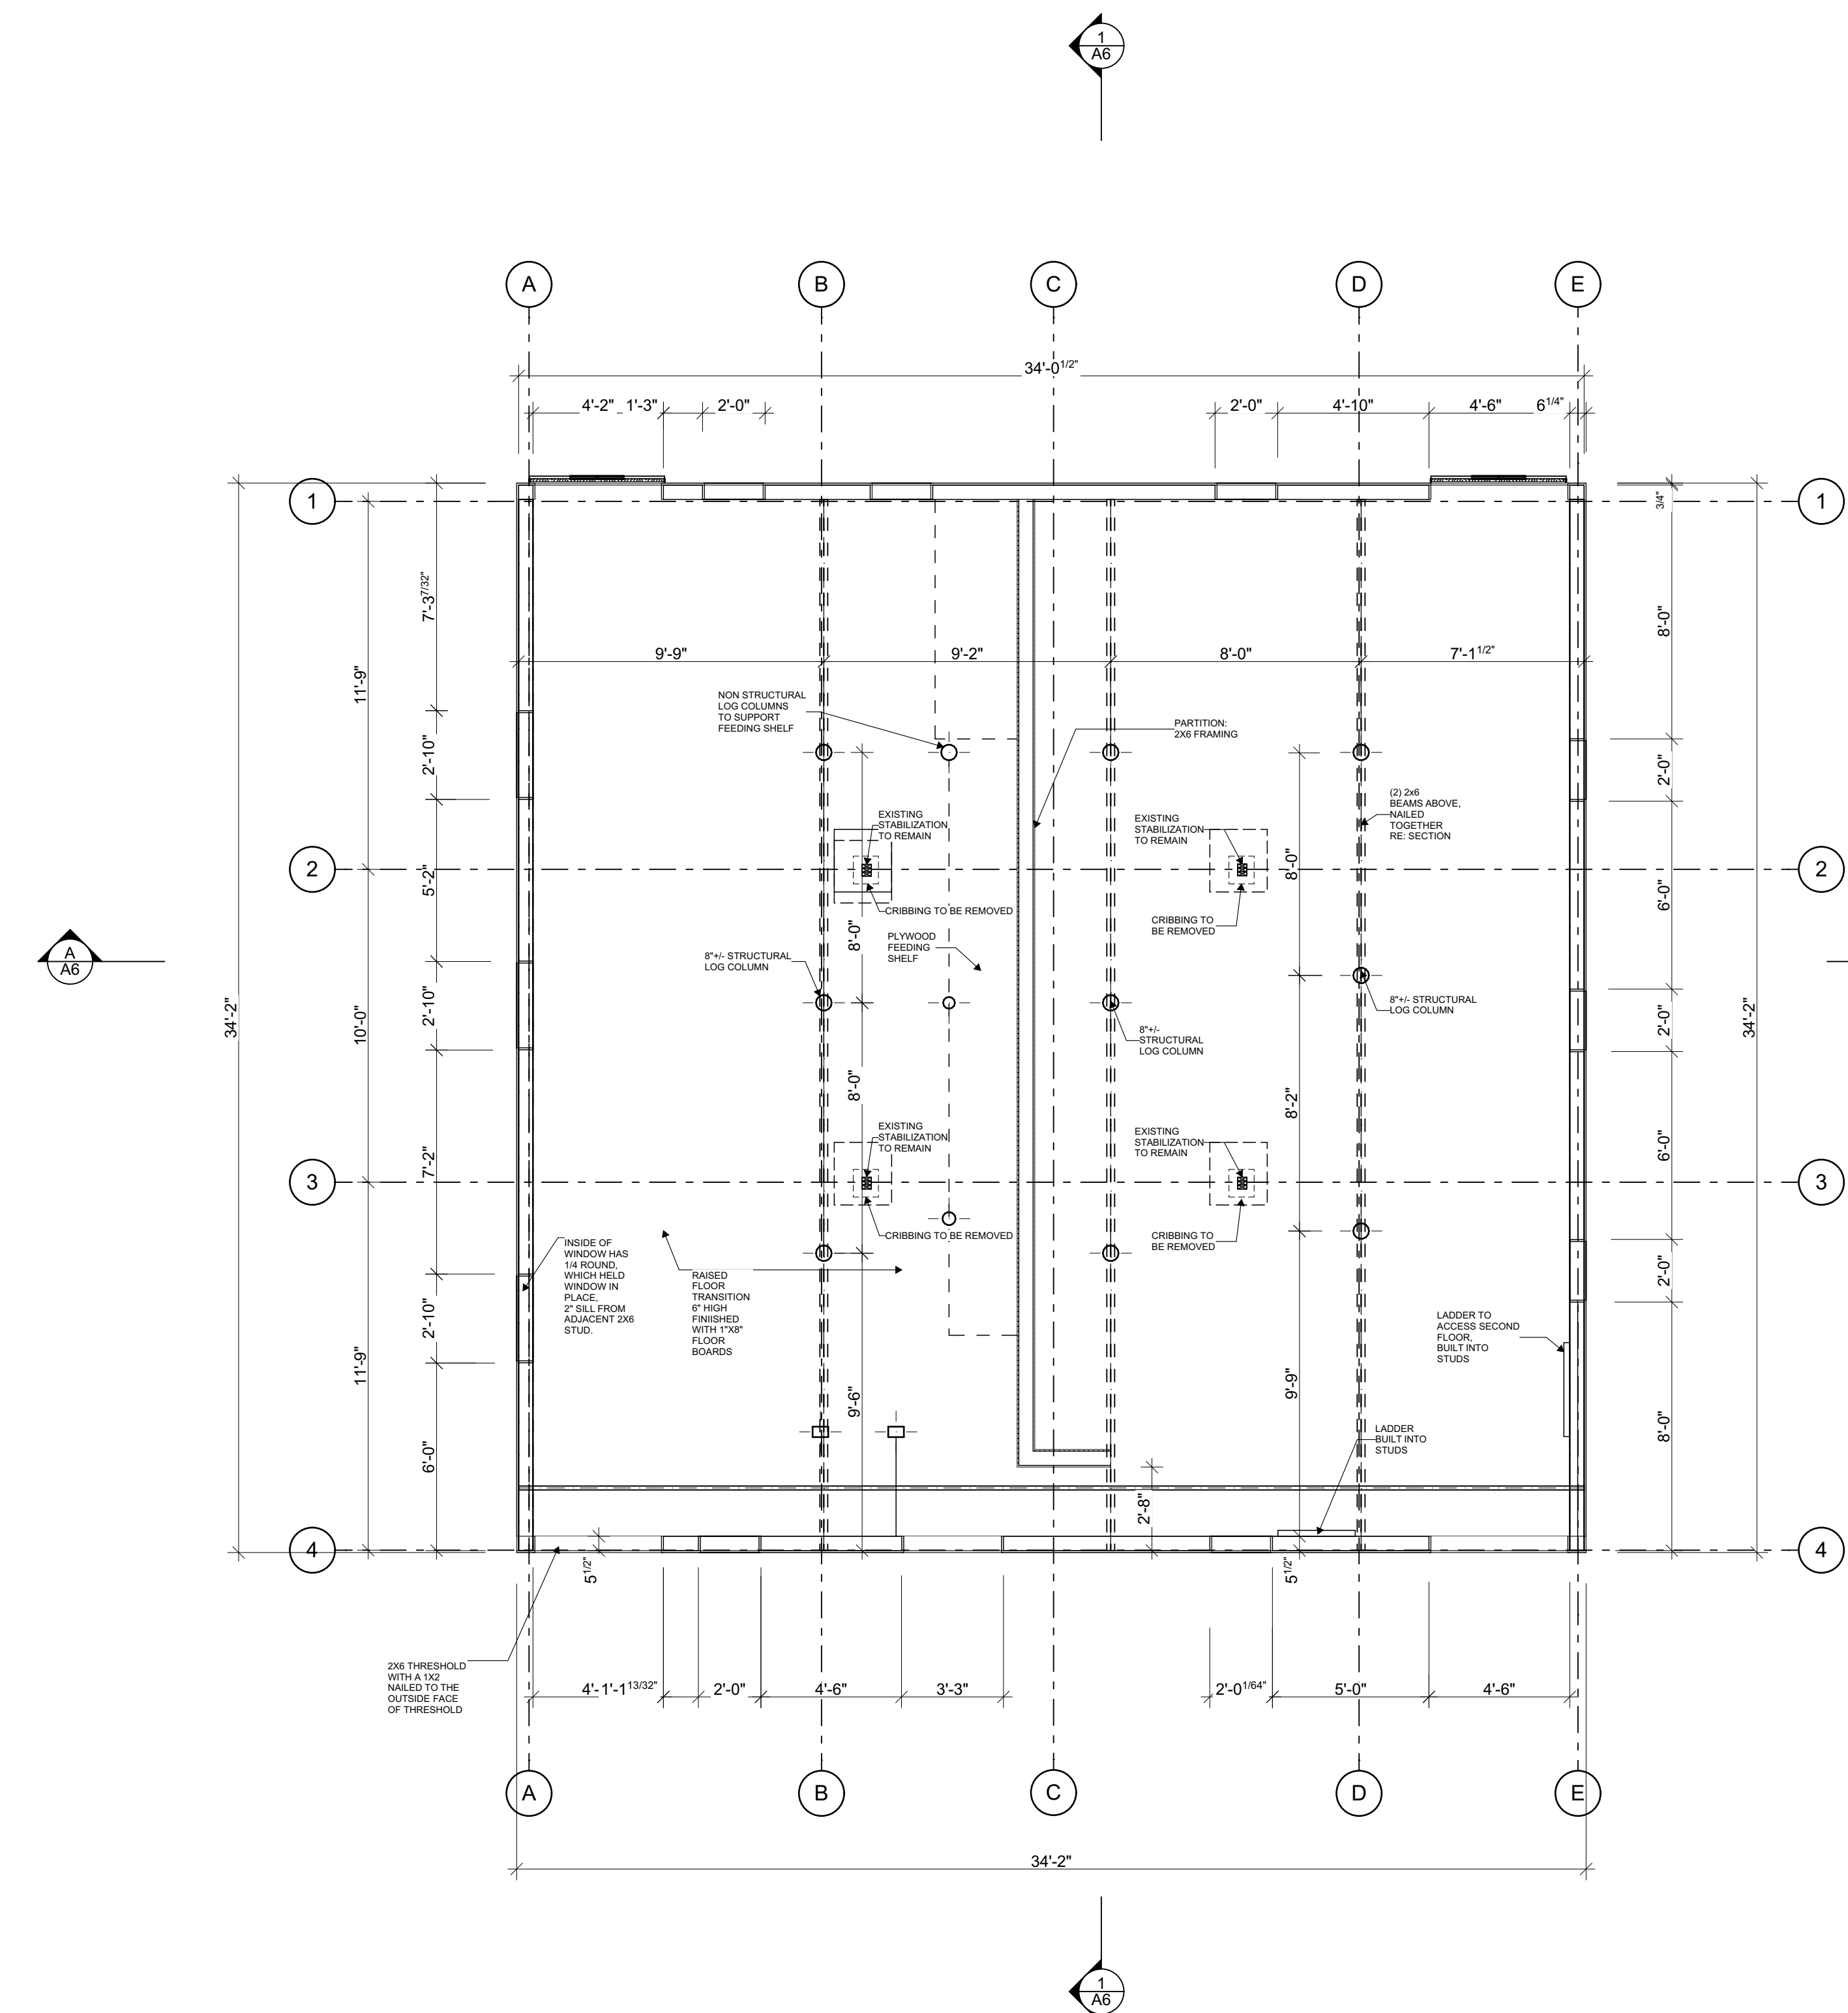

**1** EXISTING MAIN FLOOR PLAN  
SCALE: 1/4" = 1'-0"

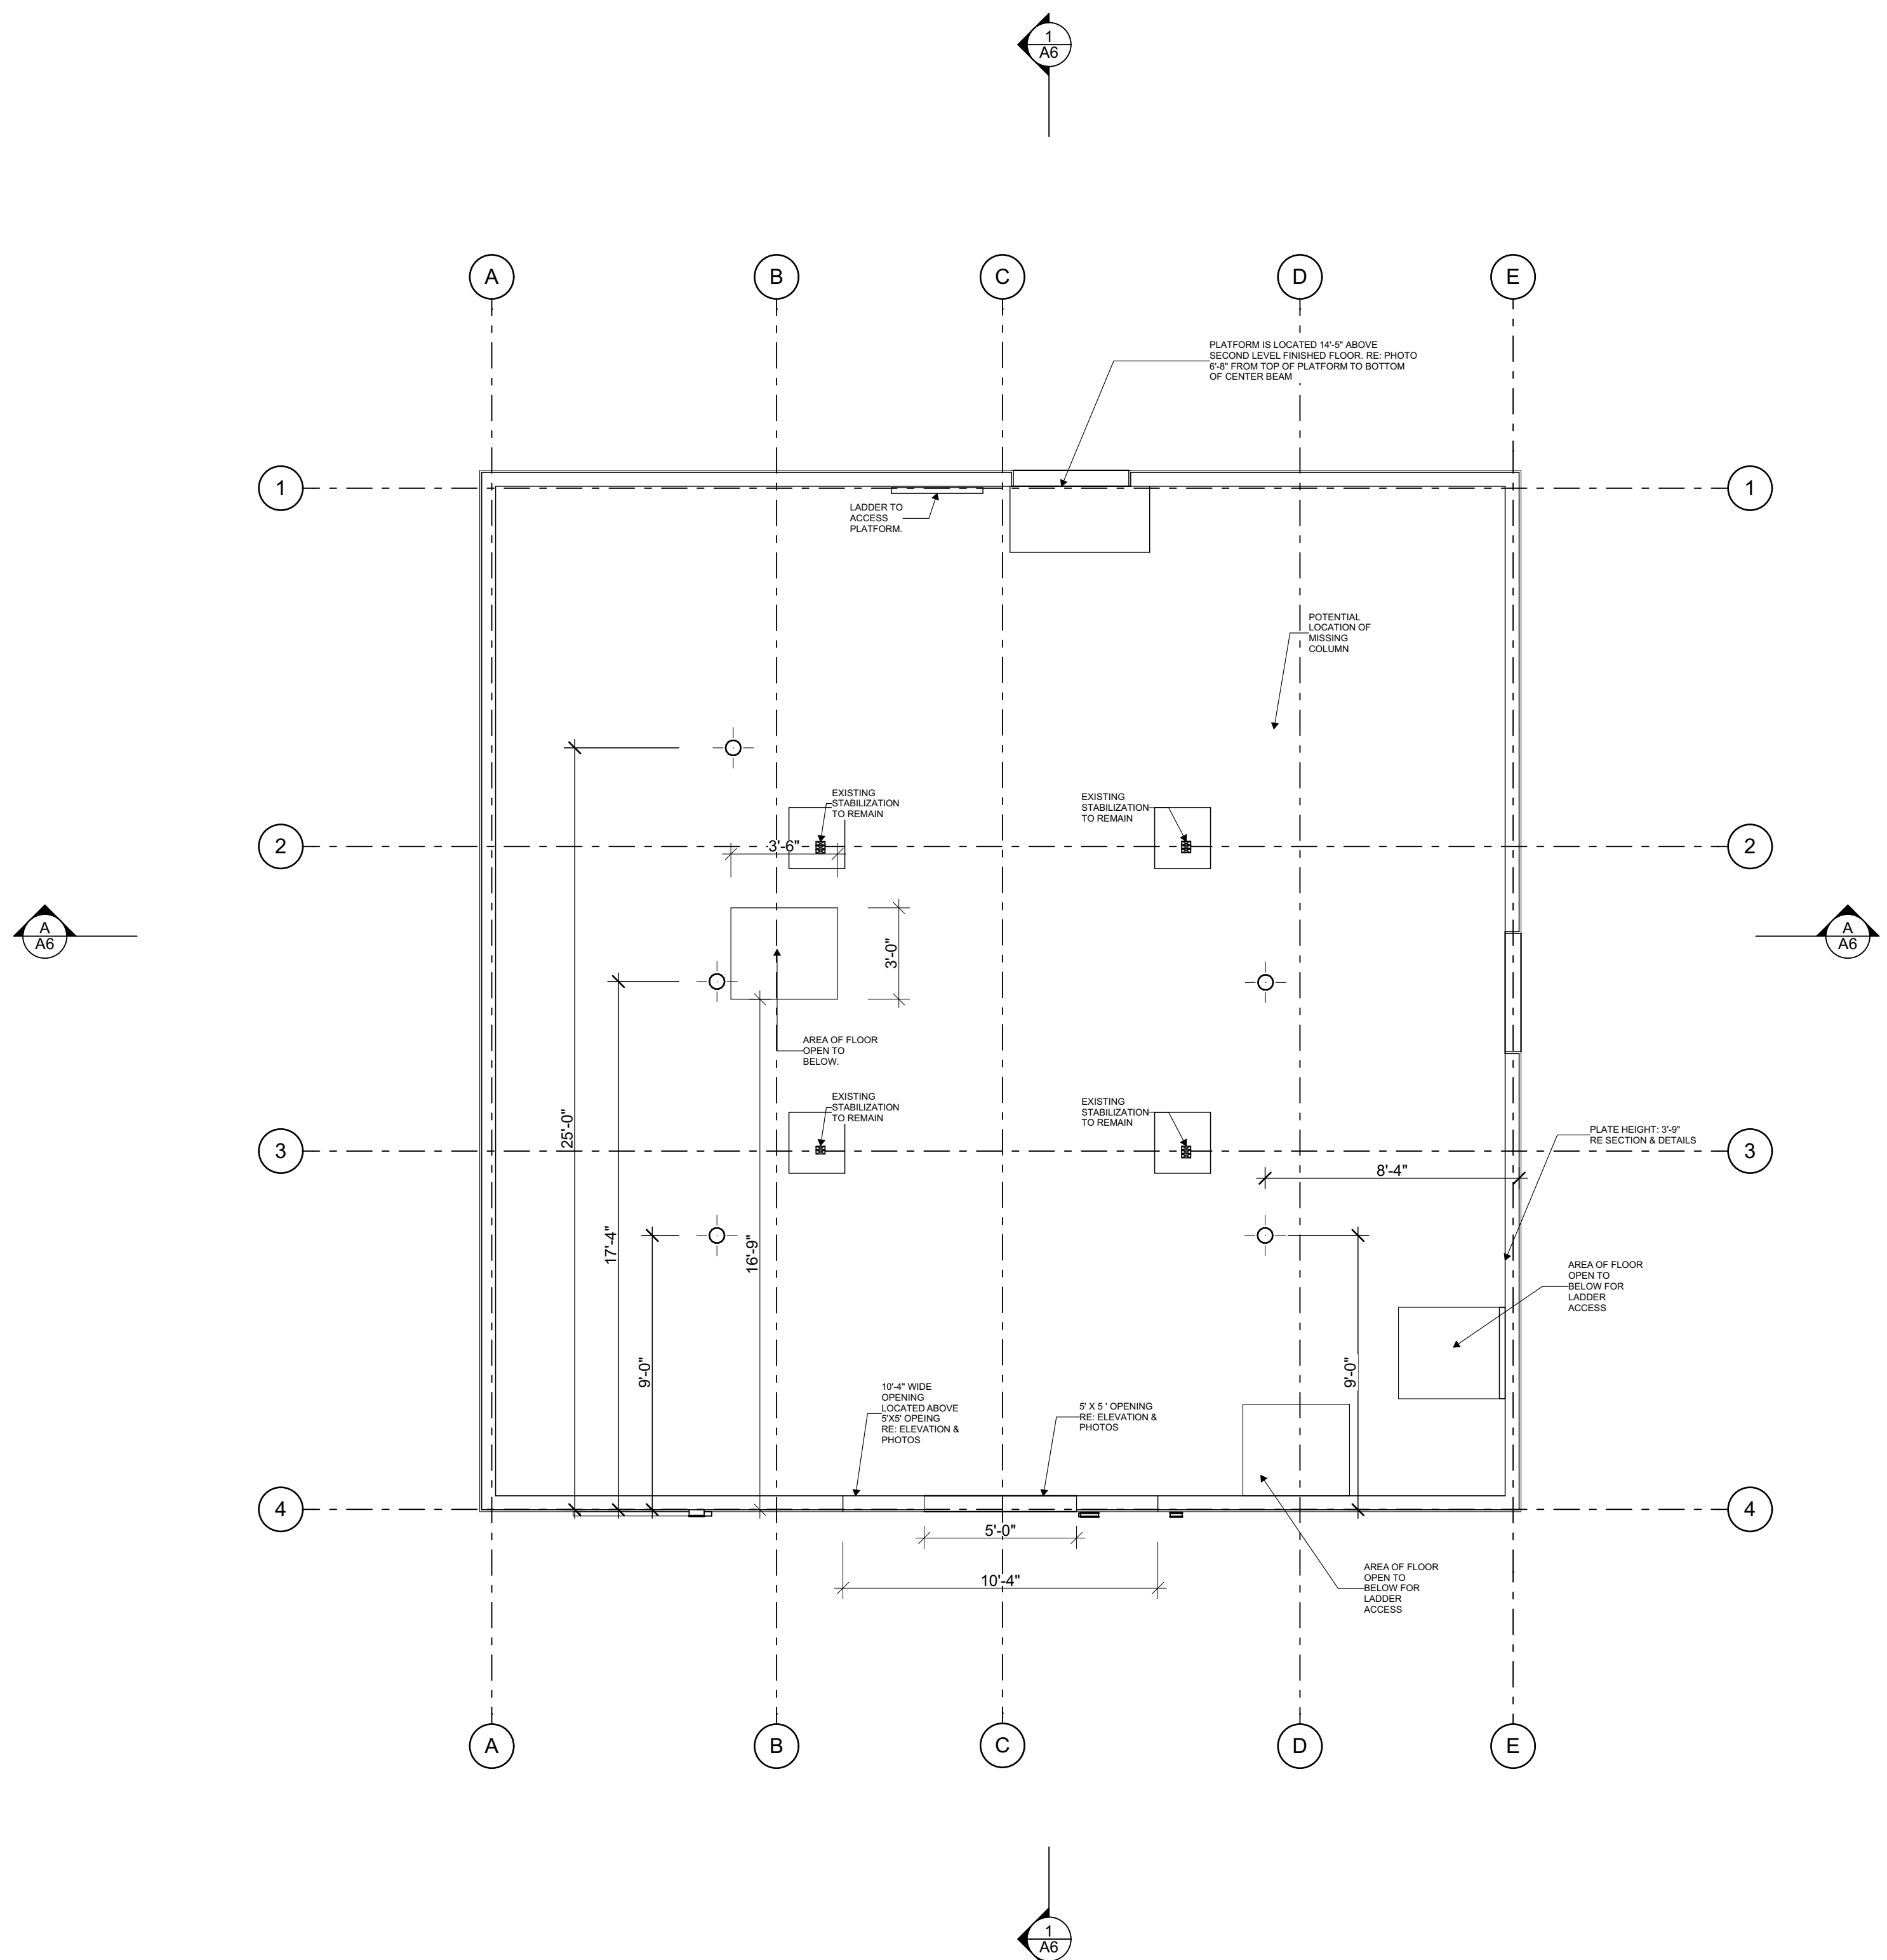


**2** LOFT FLOOR EXISTING PLAN  
SCALE: 1/4" = 1'-0"





MOUNTAIN ARCHITECTURE



DESIGN GROUP P.C.

Jan Michael Kaminski,  
President

P.O. BOX 17000  
STEAMBOAT SPRINGS, COLORADO 80487  
(970) 861-1100  
jmk@mtarch.com

AN ICONIC ENTRY FOR THE


ARNOLD BARN INTERPRETIVE DISPLAY

2305 MT. WERNER CIR.  
STEAMBOAT SPRINGS, CO. 80487-9023

TITLE	
EXISTING ROOF PLAN	
JOB NO.	PROJECT NUMBER
DRAWN BY LRR	
CHECKED BY JMK	
ISSUE DATE 5/25/2018	
REVISIONS:	
1	DATE

DRAWING NUMBER

A3

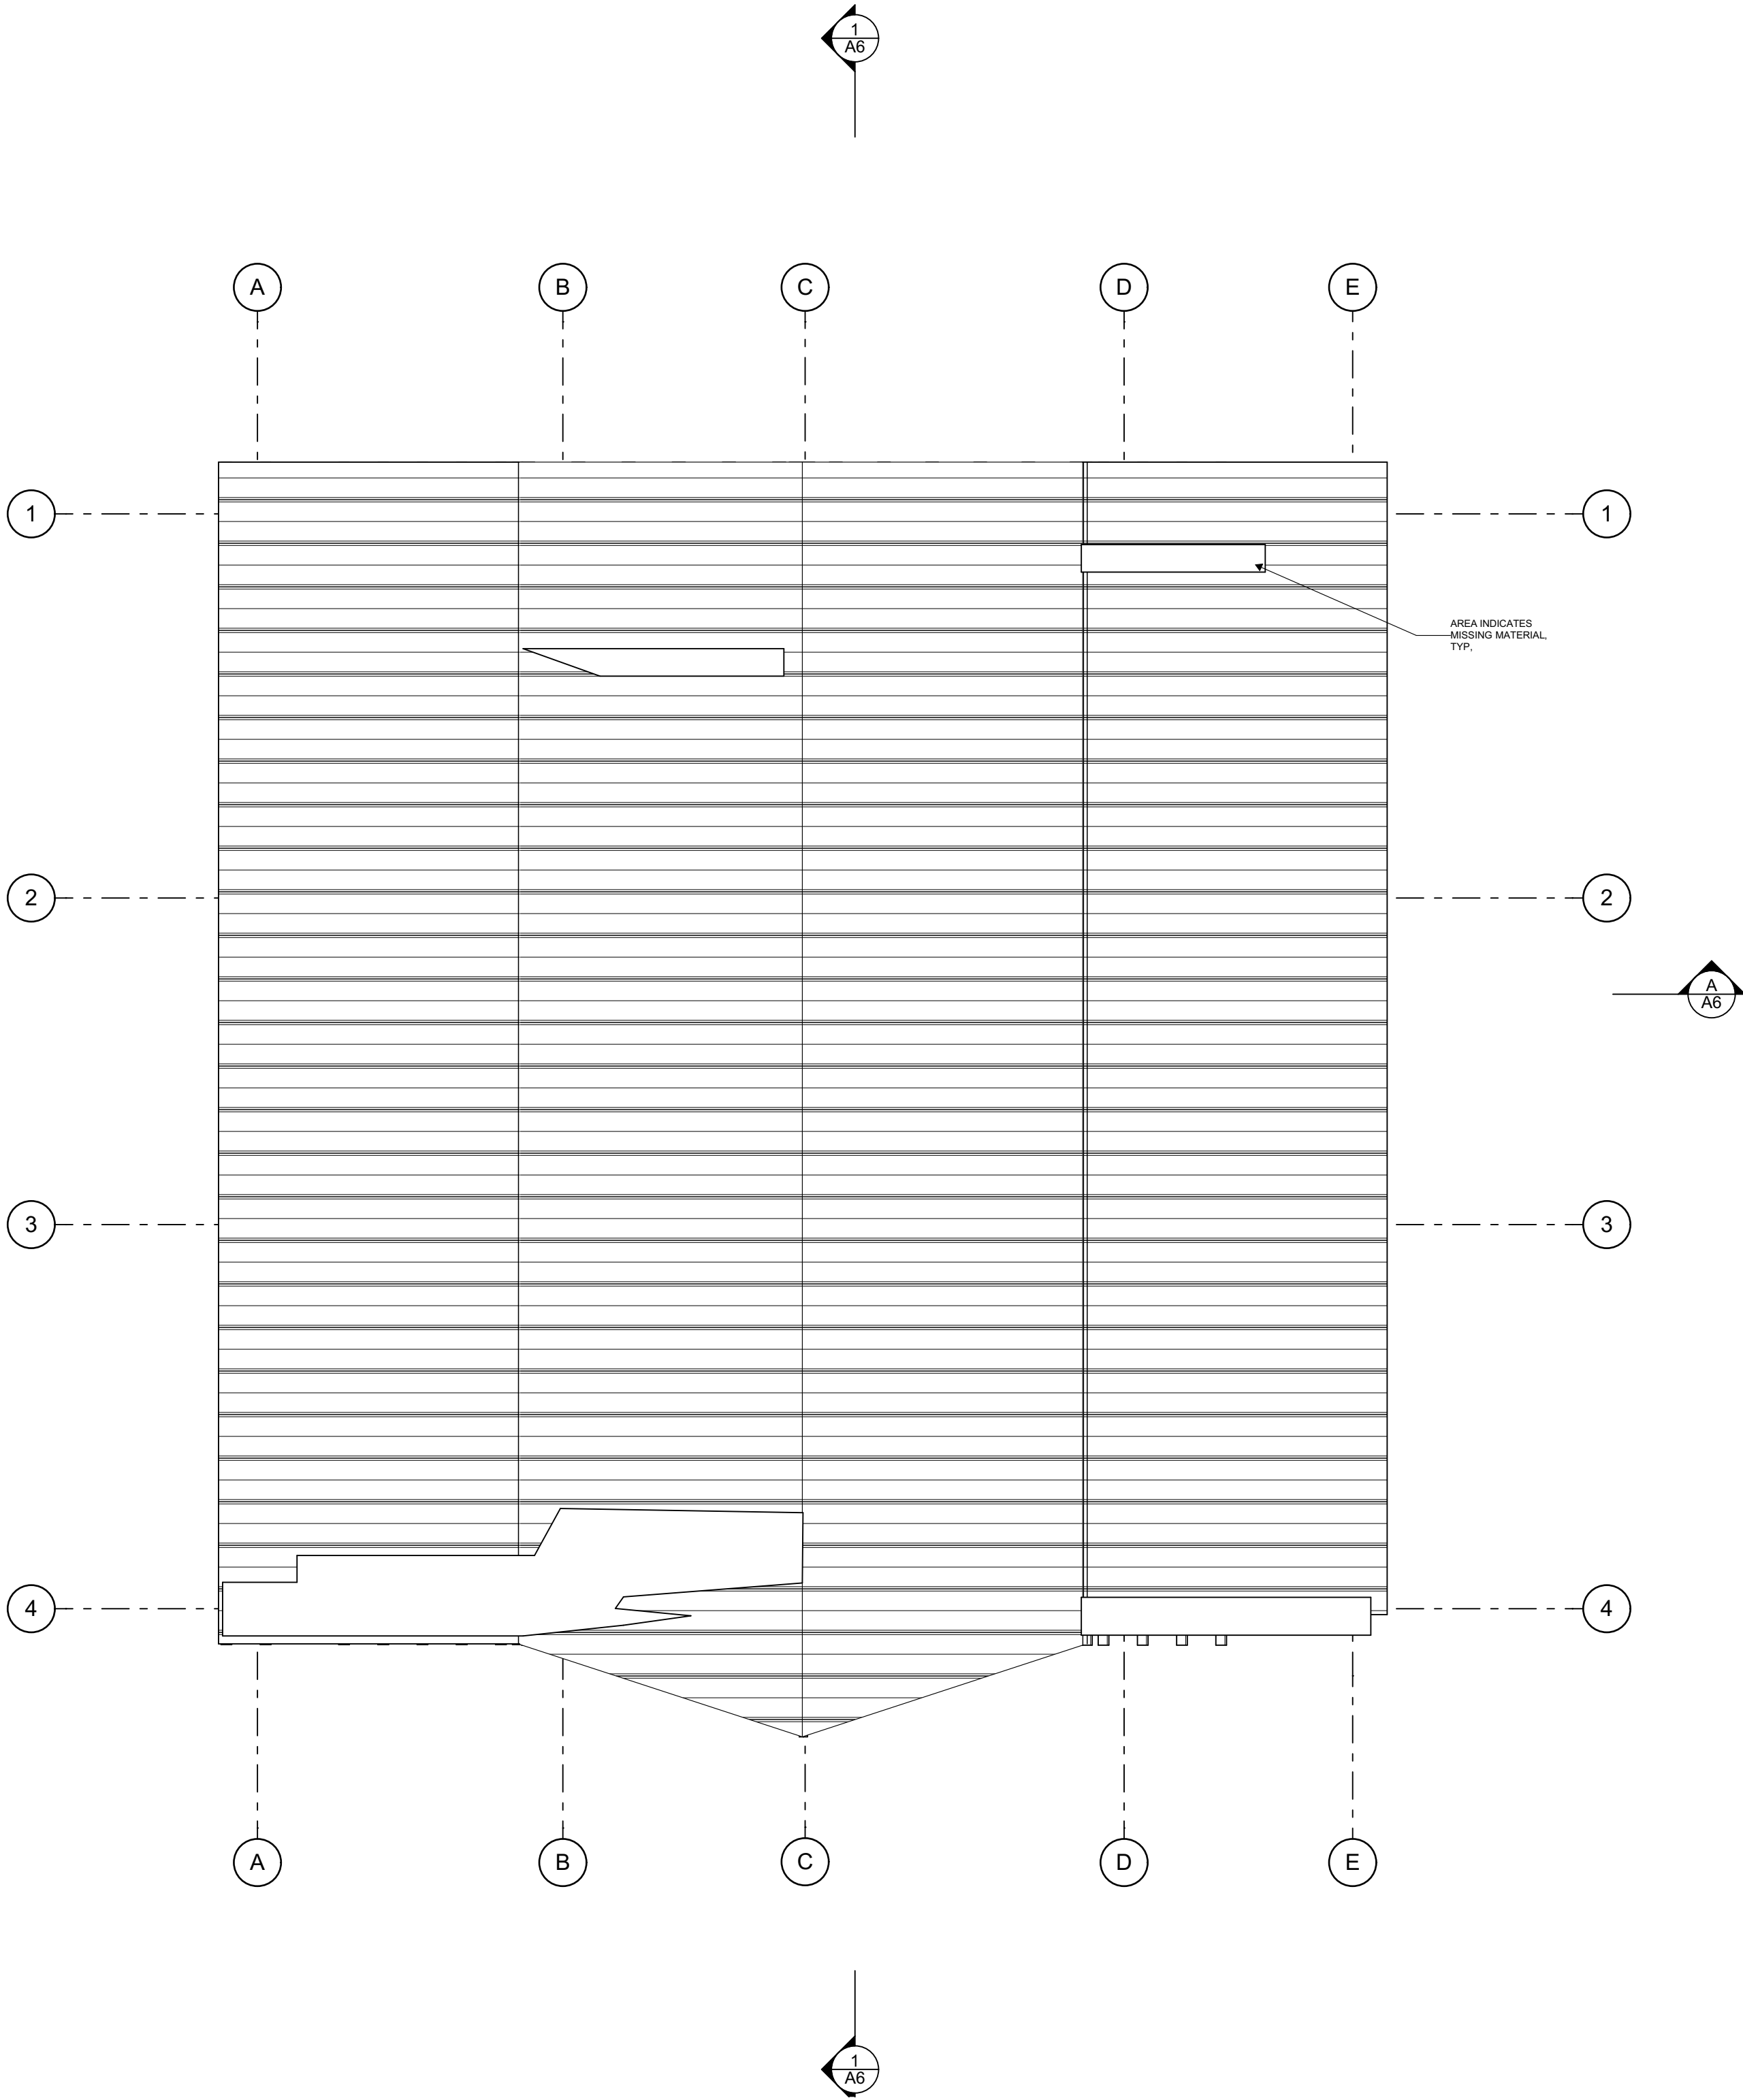


1


EXISTING ROOF PLAN

SCALE: 1/4" = 1'-0"



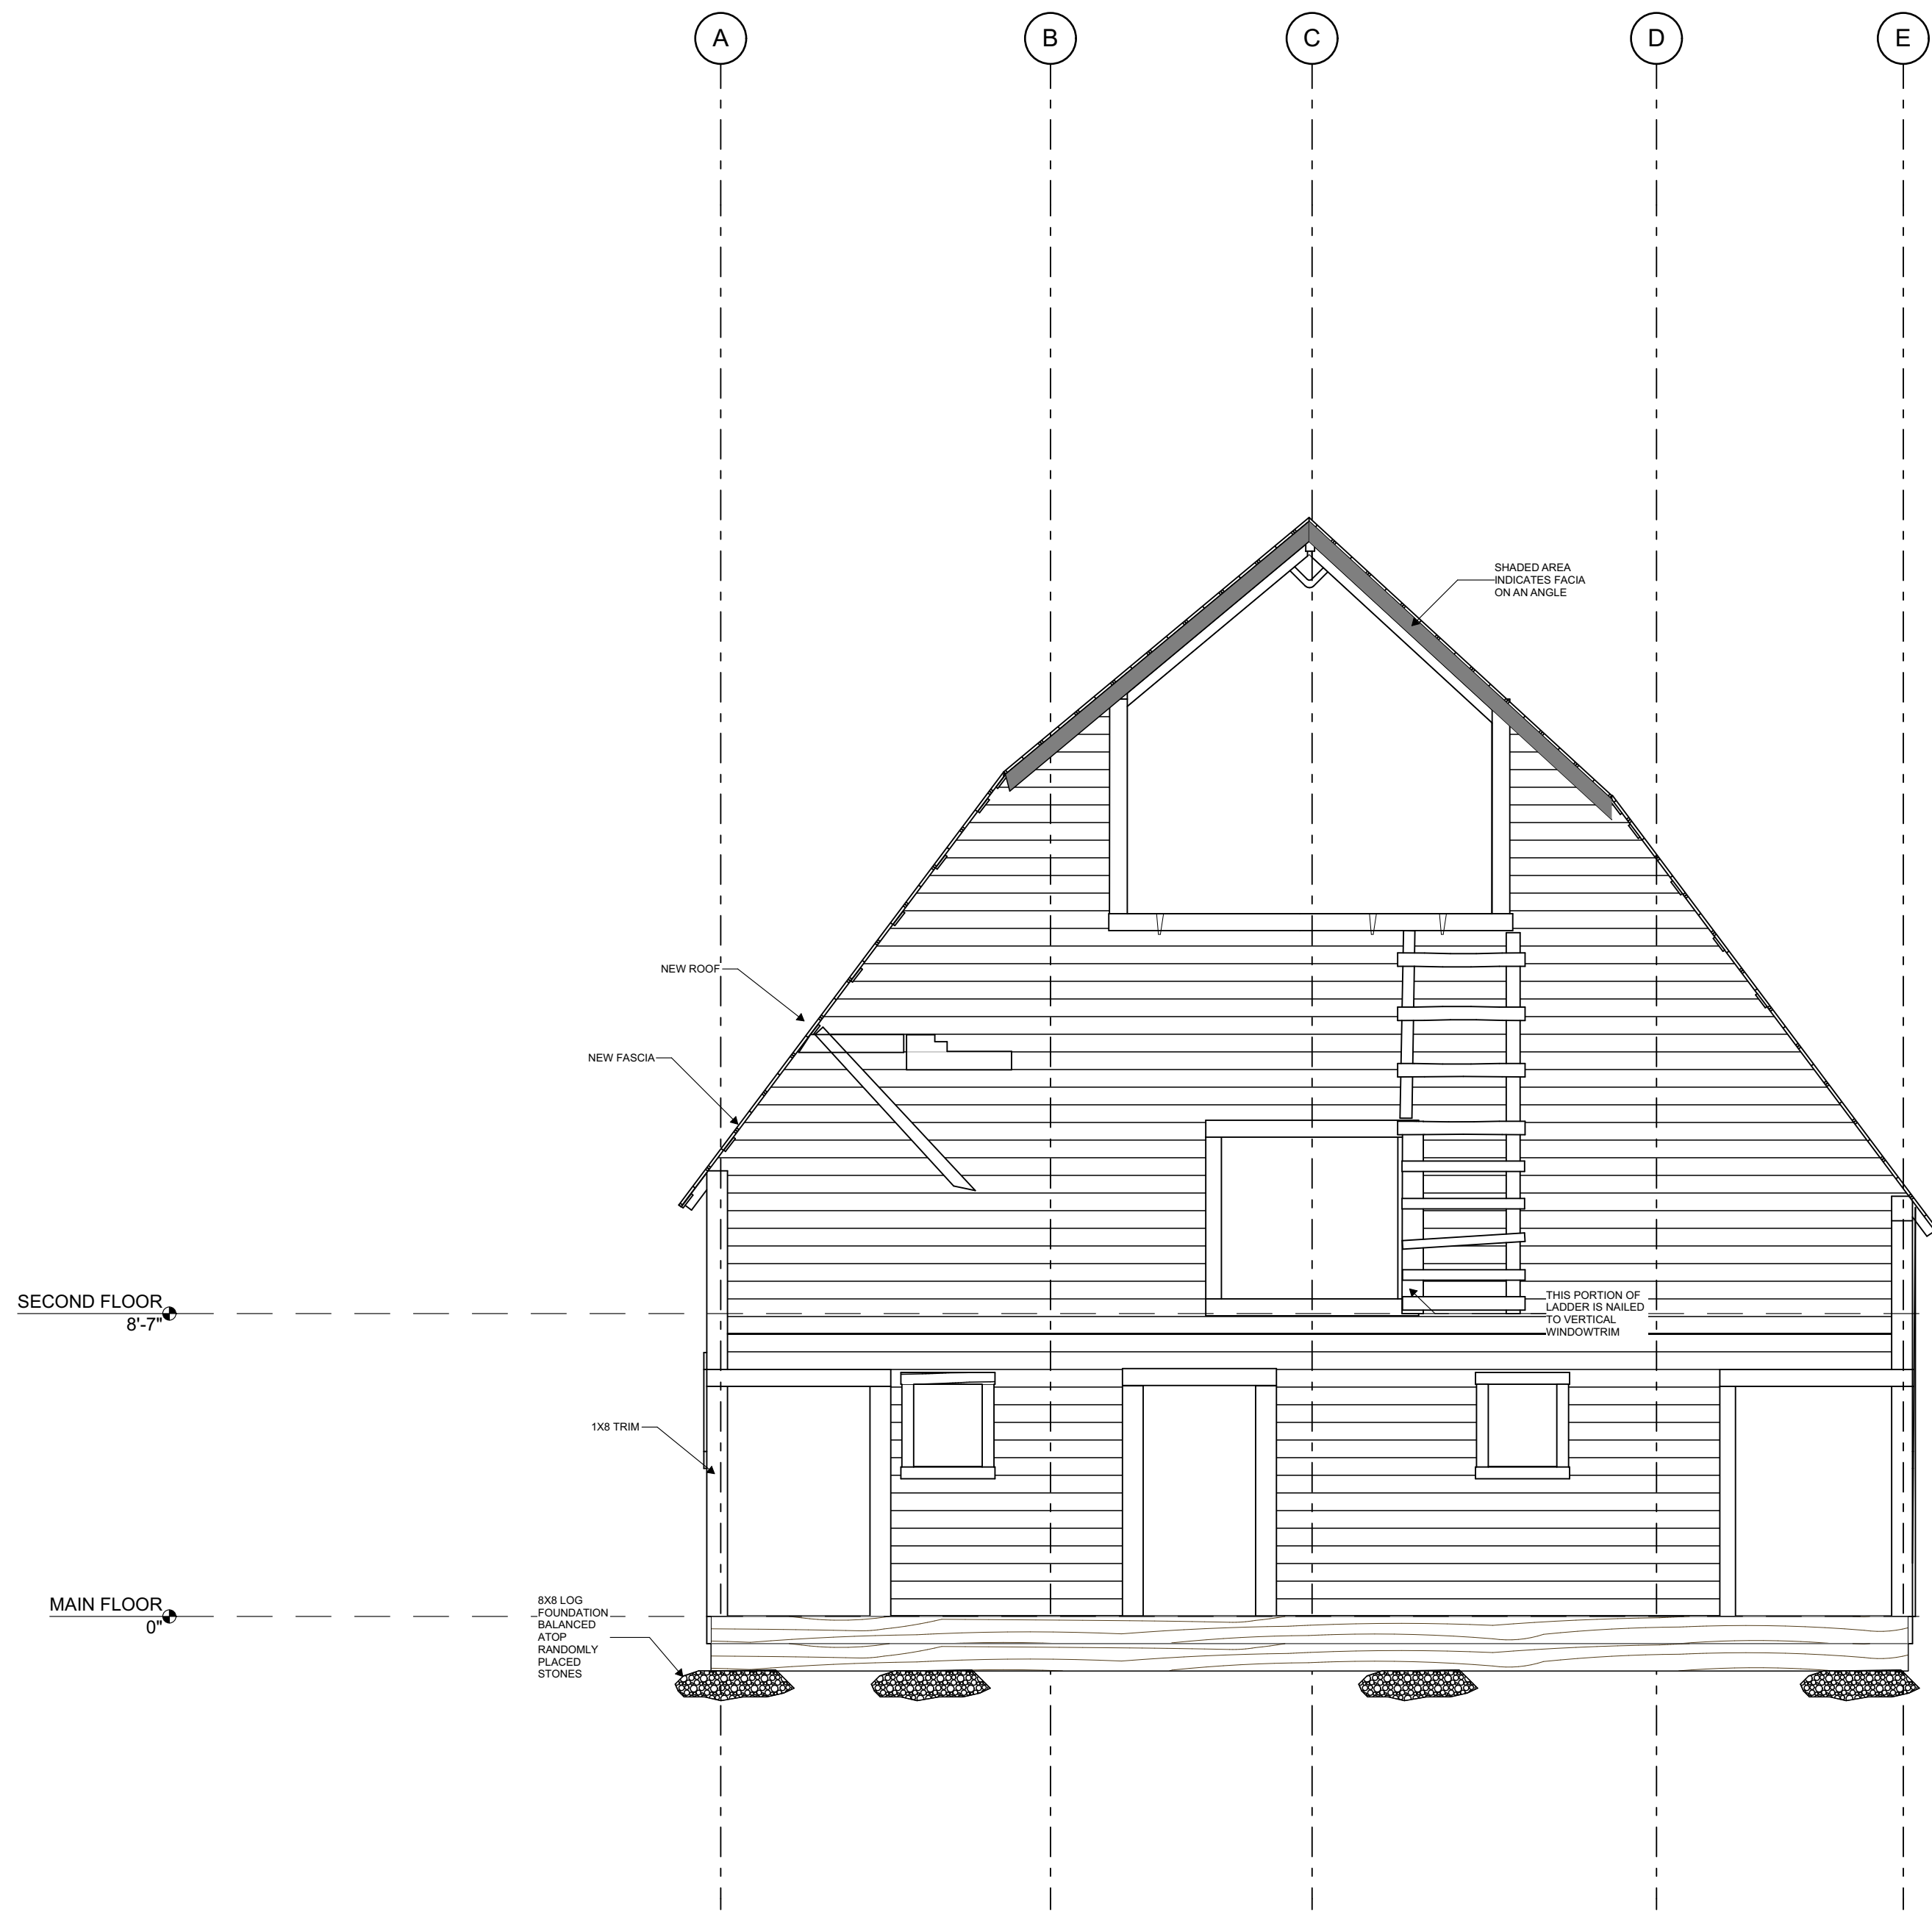

① EXISTING SOUTH ELEVATION  
SCALE: 1/4" = 1'-0"

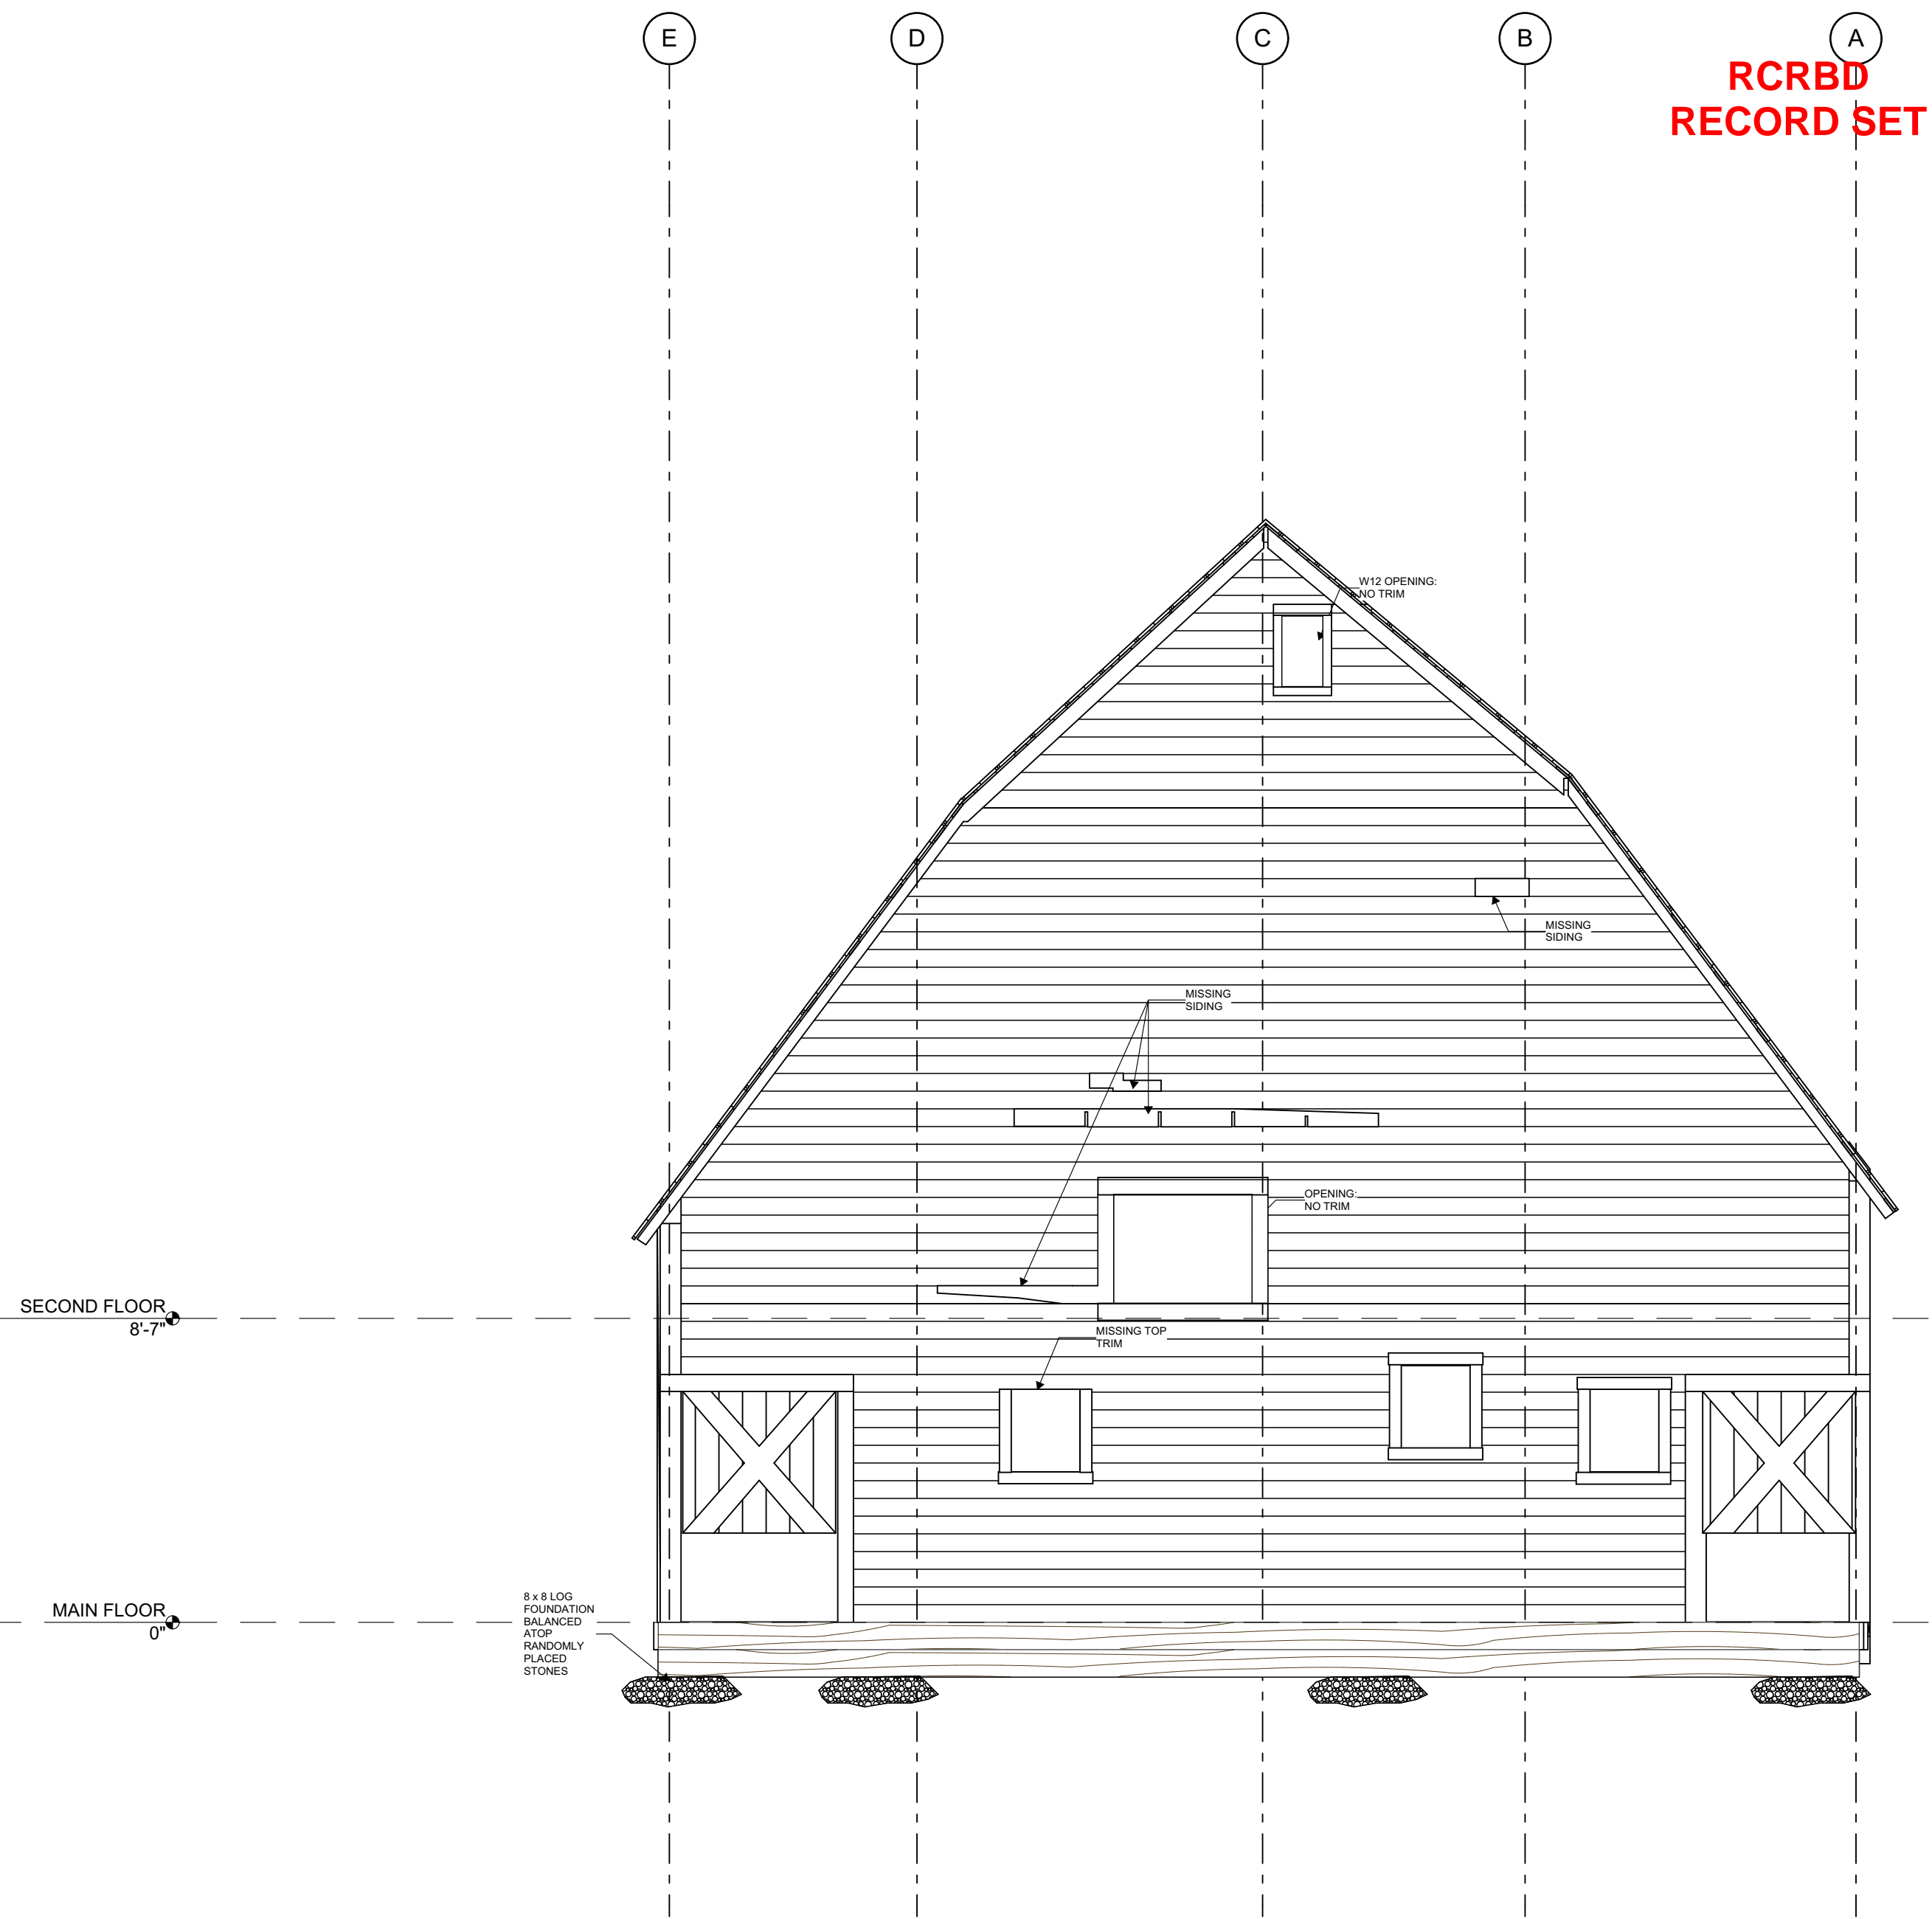

② EXISTING NORTH ELEVATION  
SCALE: 1/4" = 1'-0"



MOUNTAIN ARCHITECTURE  
DESIGN GROUP P.C.  
Jan Michael Kaminski,  
President  
P.O. BOX 1000  
STEAMBOAT SPRINGS, COLORADO 80487  
970.868.1000  
jmk@mtarch.com

AN ICONIC ENTRY FOR THE  
ARNOLD BARN INTERPRETIVE DISPLAY  
2305 MT. WERNER CIR.  
STEAMBOAT SPRINGS, CO. 80487-9023


TITLE  
EXISTING  
ELEVATIONS

JOB NO. PROJECT NUMBER  
DRAWN BY LRR  
CHECKED BY JMK  
ISSUE DATE 5/25/2018


REVISIONS:  
1 DATE

DRAWING NUMBER  
A4



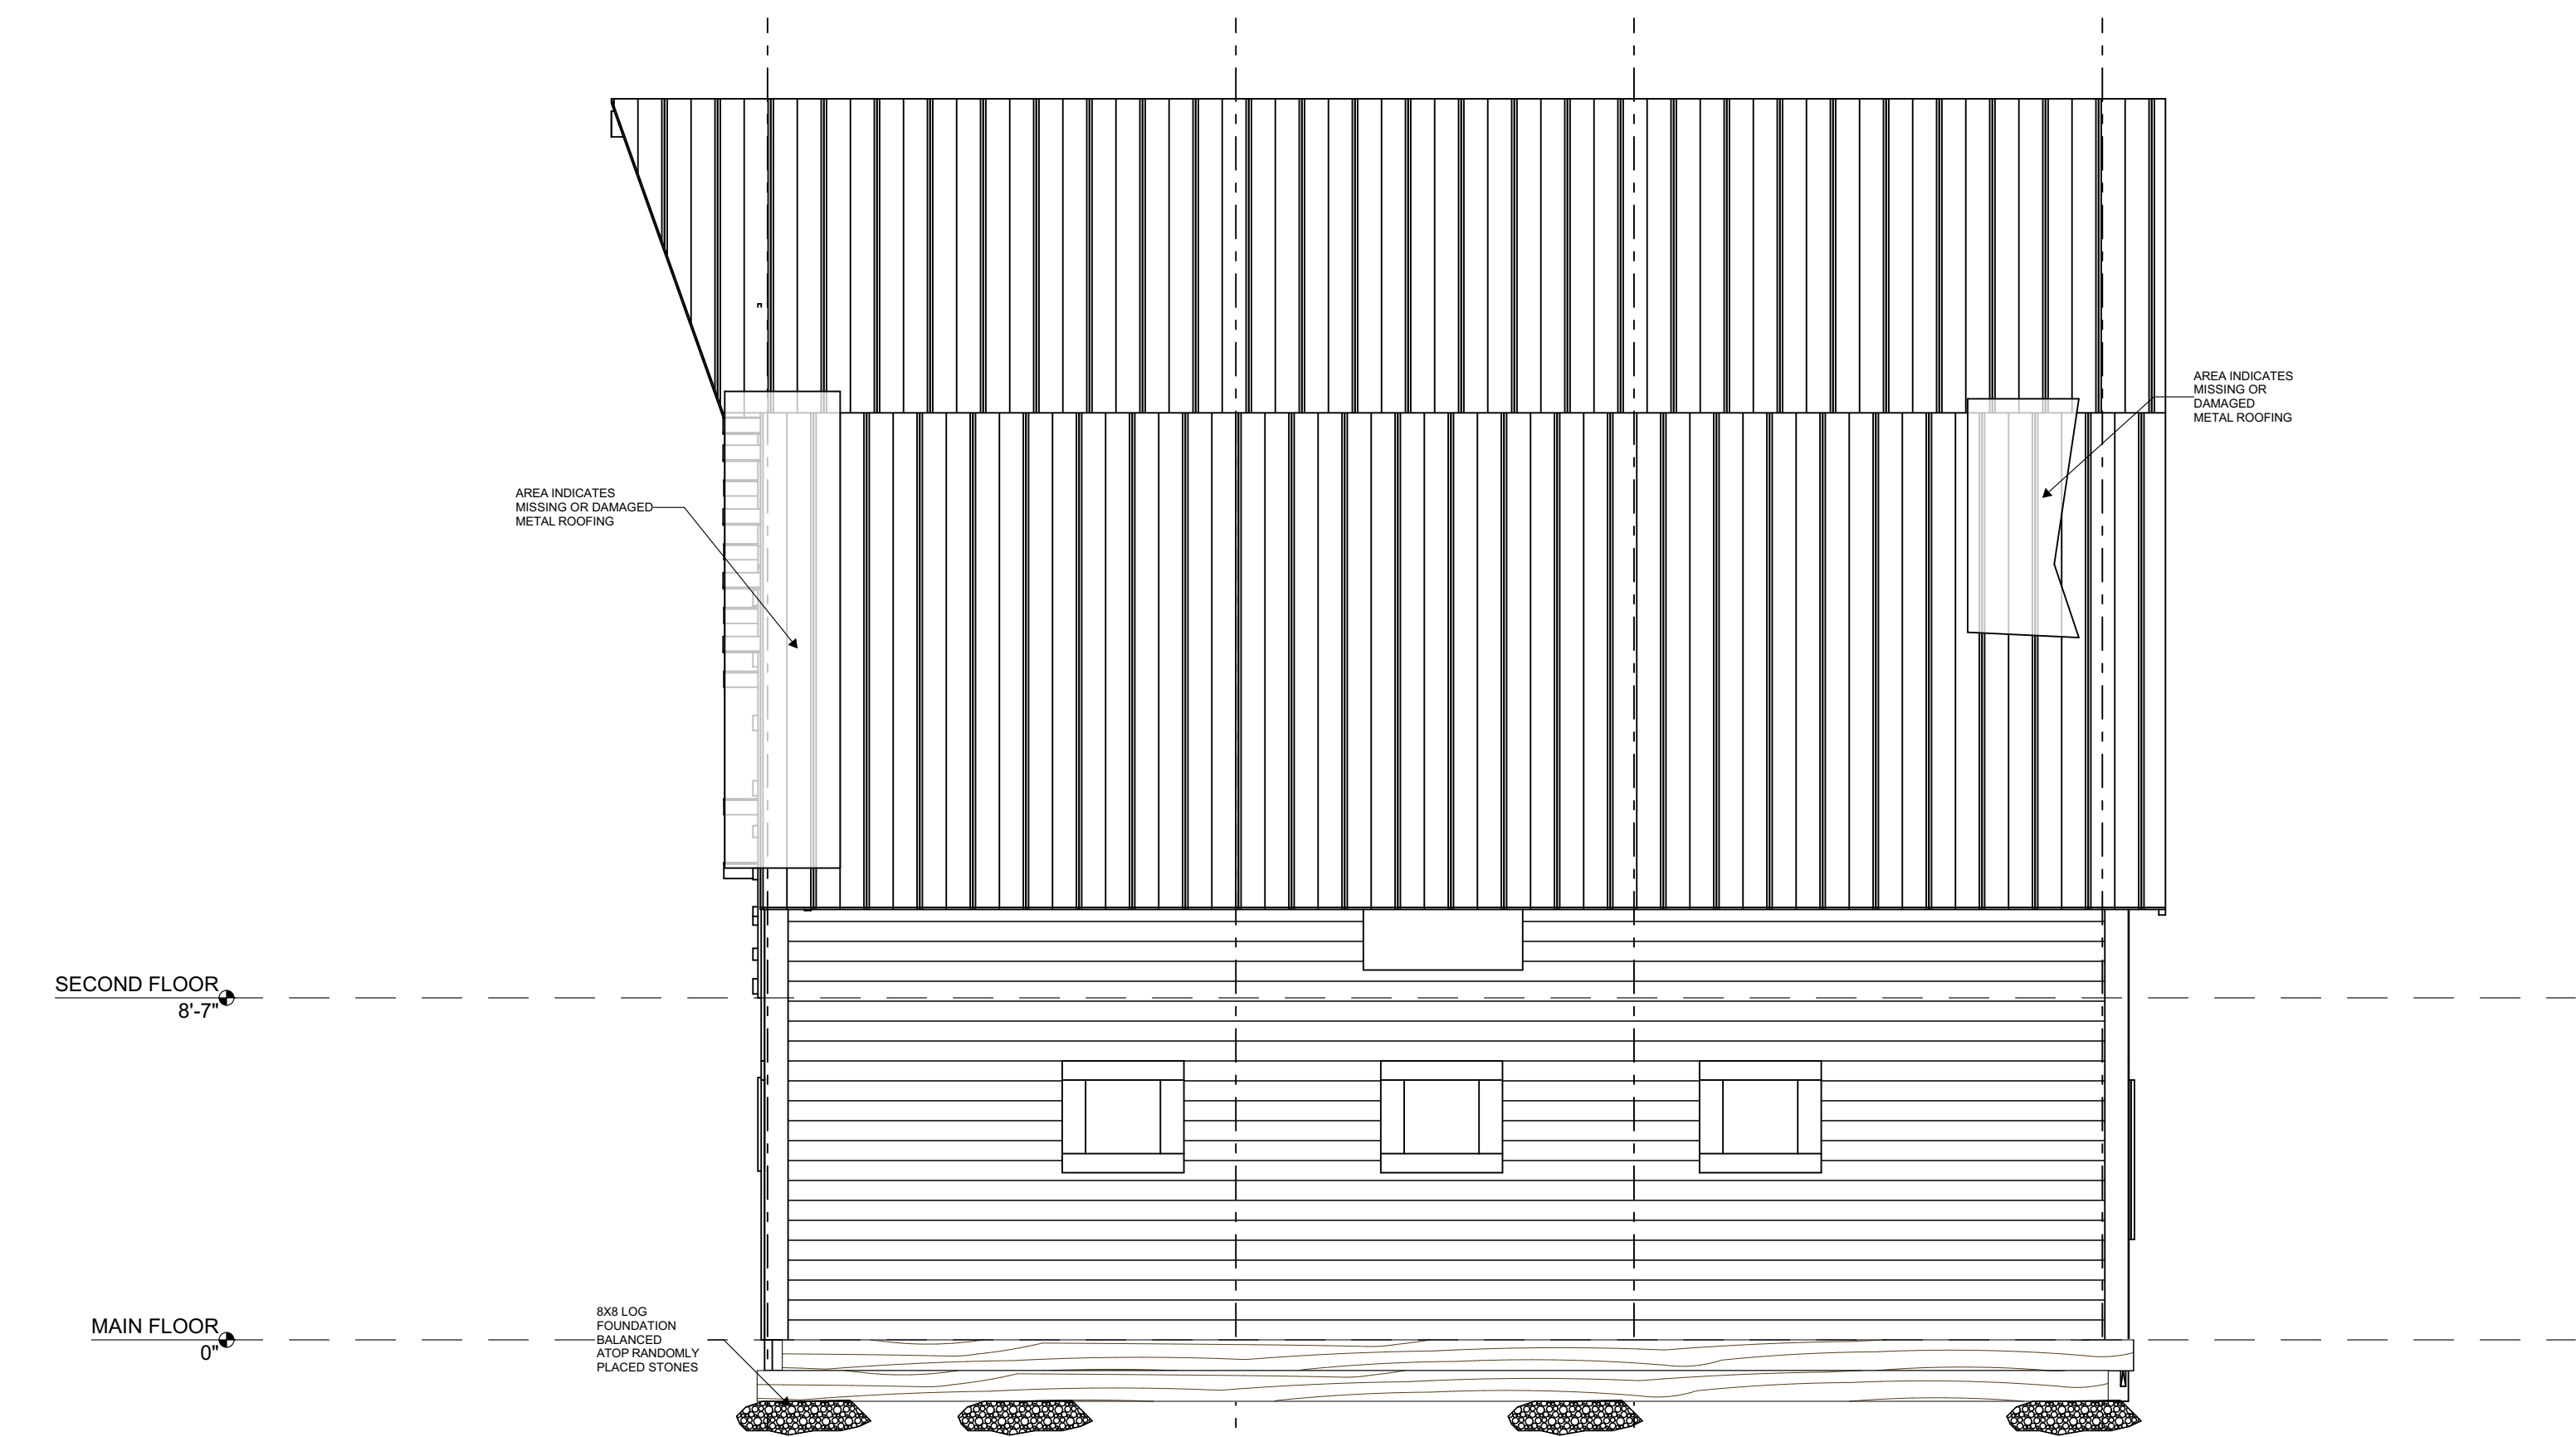

1 EXISTING EAST ELEVATION  
SCALE: 1/4" = 1'-0"

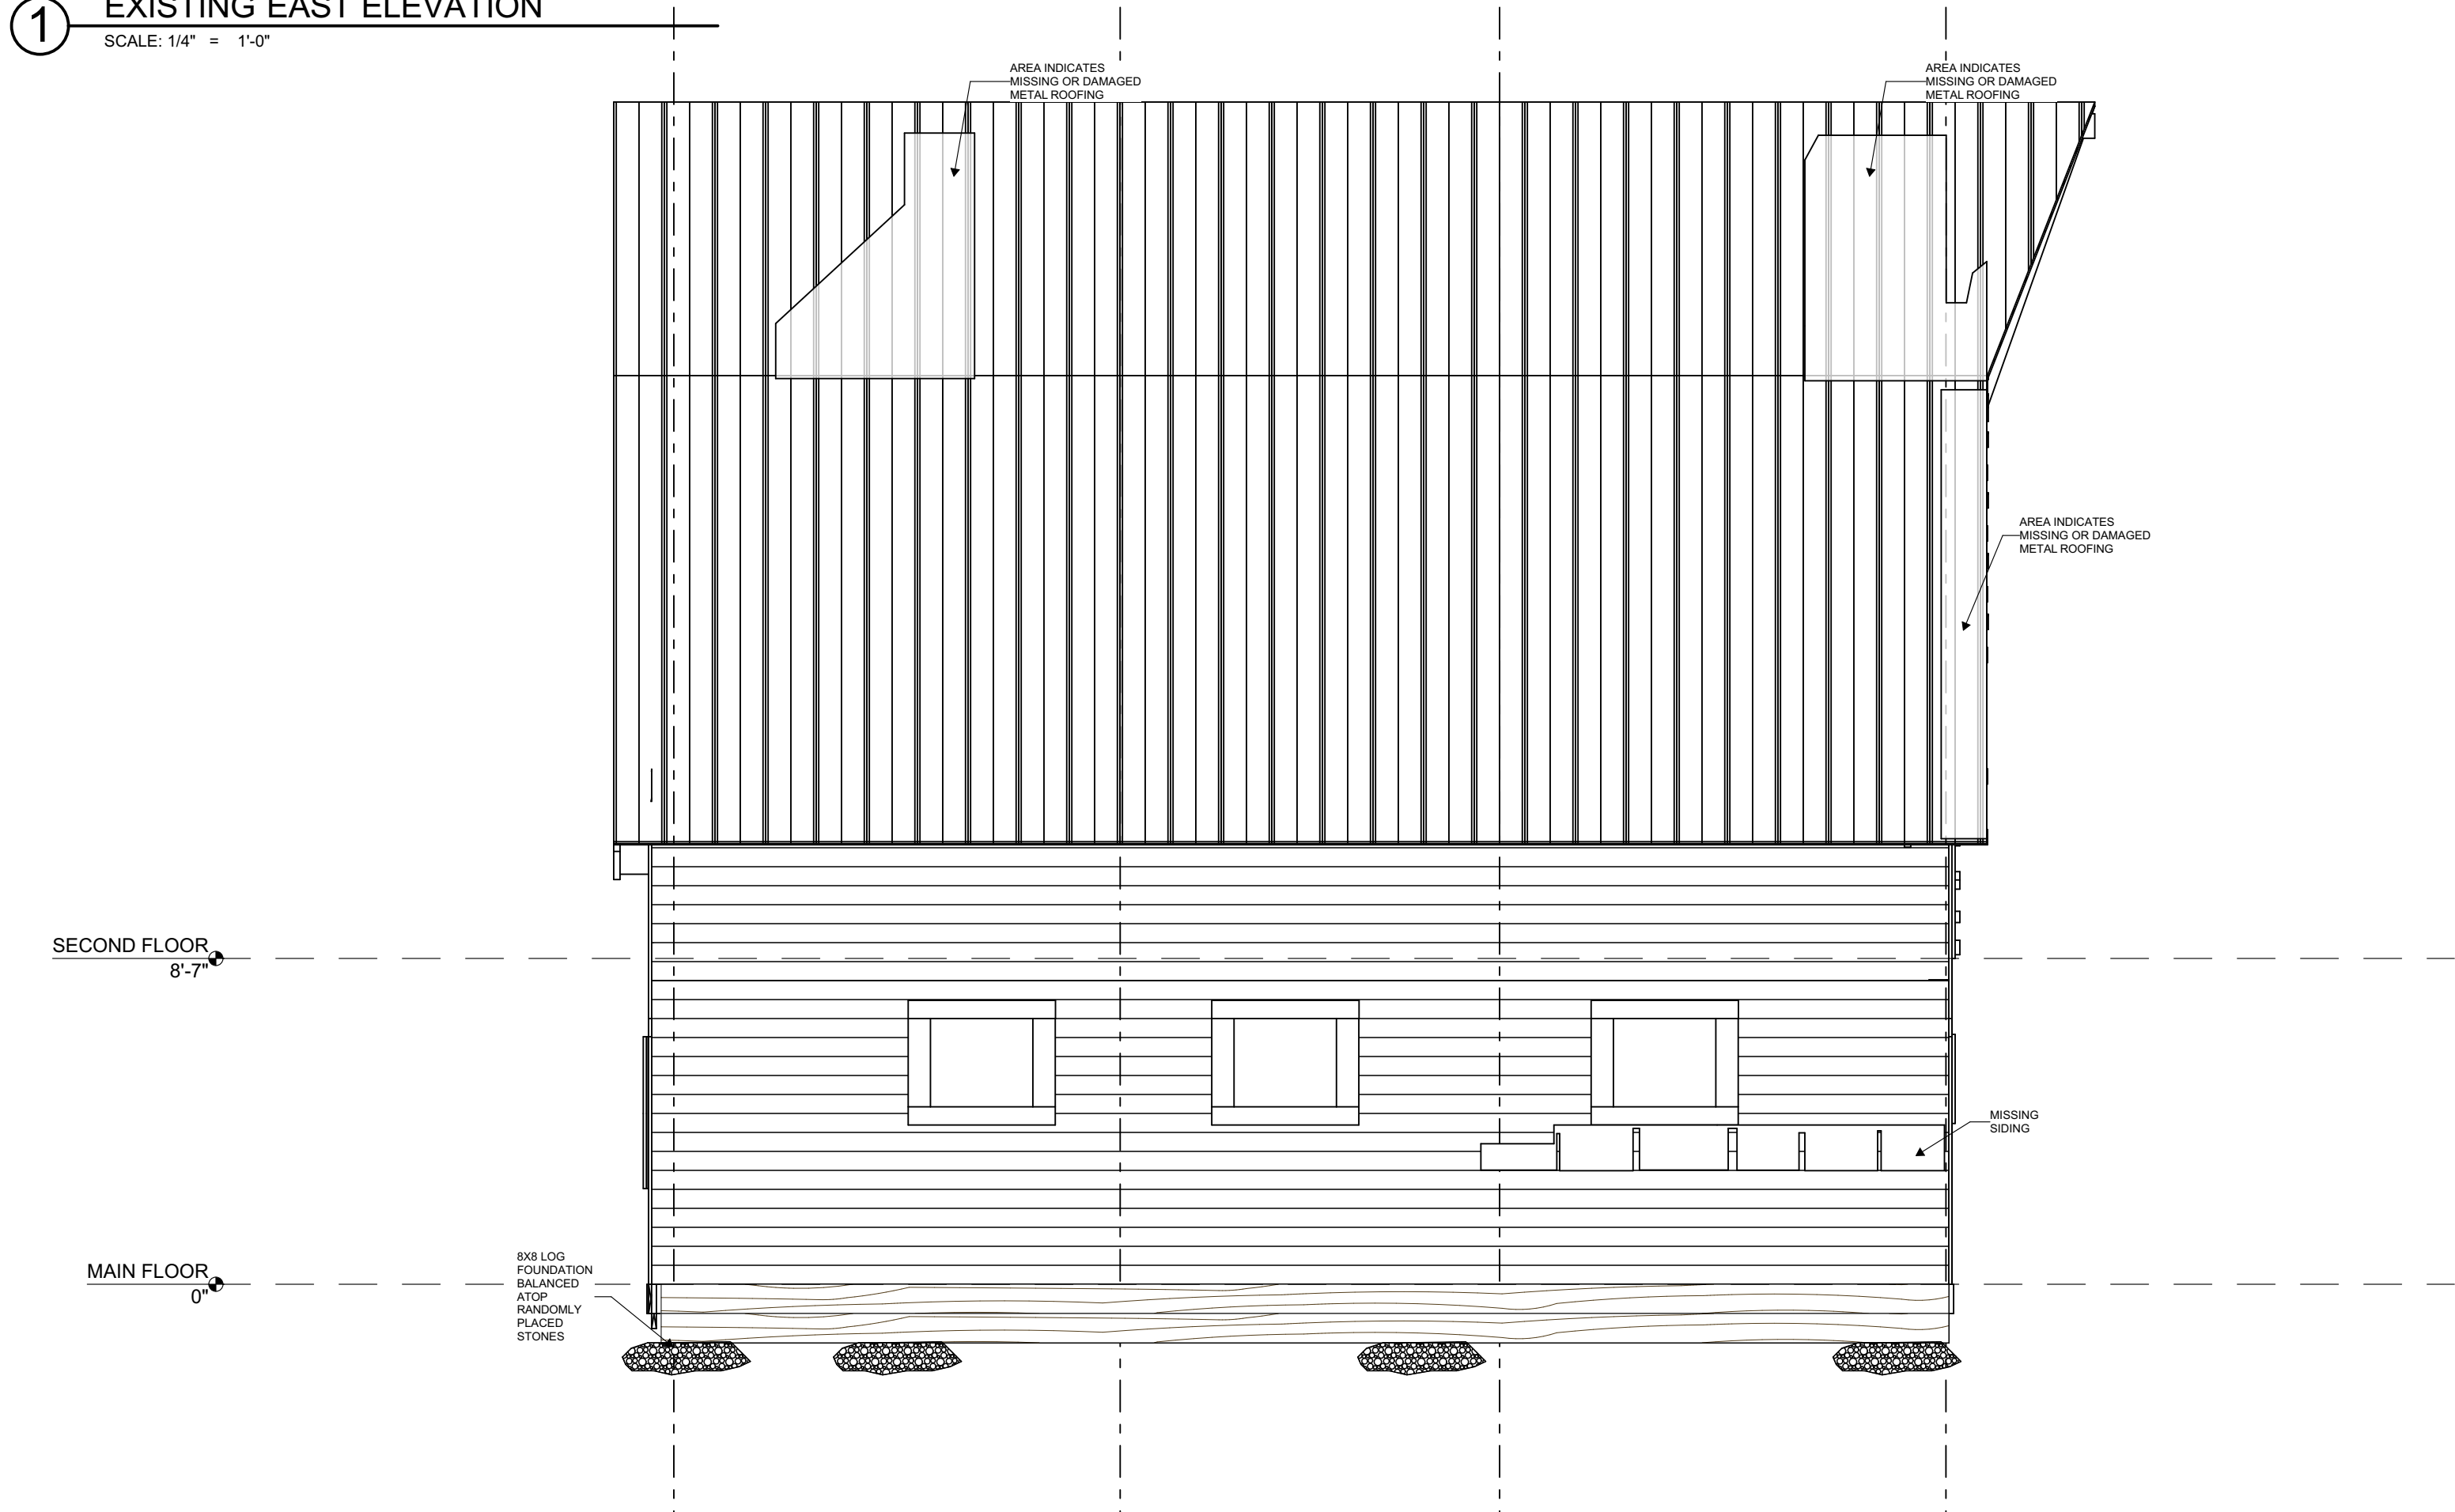

2 WEST EXISTING ELEVATION  
SCALE: 1/4" = 1'-0"



MOUNTAIN ARCHITECTURE  
DESIGN GROUP P.C.  
Jan Michael Kaminski,  
President  
P.O. BOX 1000  
STEAMBOAT SPRINGS, COLORADO 80487  
(970) 861-1111  
jmk@mtarch.com

AN ICONIC ENTRY FOR THE  
**ARNOLD BARN INTERPRETIVE DISPLAY**  
2305 MT. WERNER CIR.  
STEAMBOAT SPRINGS, CO. 80487-9023


TITLE  
**EXISTING  
ELEVATIONS**

JOB NO. PROJECT NUMBER  
DRAWN BY LRR  
CHECKED BY JMK  
ISSUE DATE 5/25/2018

REVISIONS:  
1 DATE

DRAWING NUMBER  
**A5**



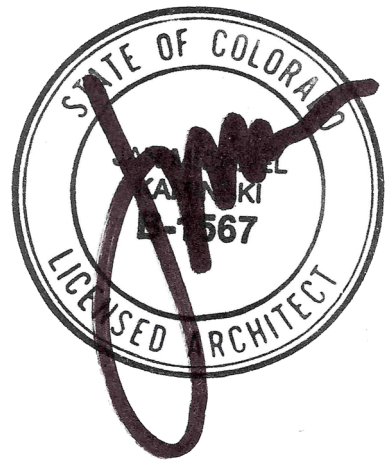

AN ICONIC ENTRY FOR THE  
**ARNOLD BARN INTERPRETIVE DISPLAY**  
2305 MT. WERNER CIR.  
STEAMBOAT SPRINGS, CO. 80487-9023

TITLE  
**EXISTING  
SECTION &  
DETAILS**

JOB NO. PROJECT NUMBER  
DRAWN BY LRR  
CHECKED BY JMK  
ISSUE DATE 5/25/2018

REVISIONS:
1 DATE

DRAWING NUMBER  
**A6**

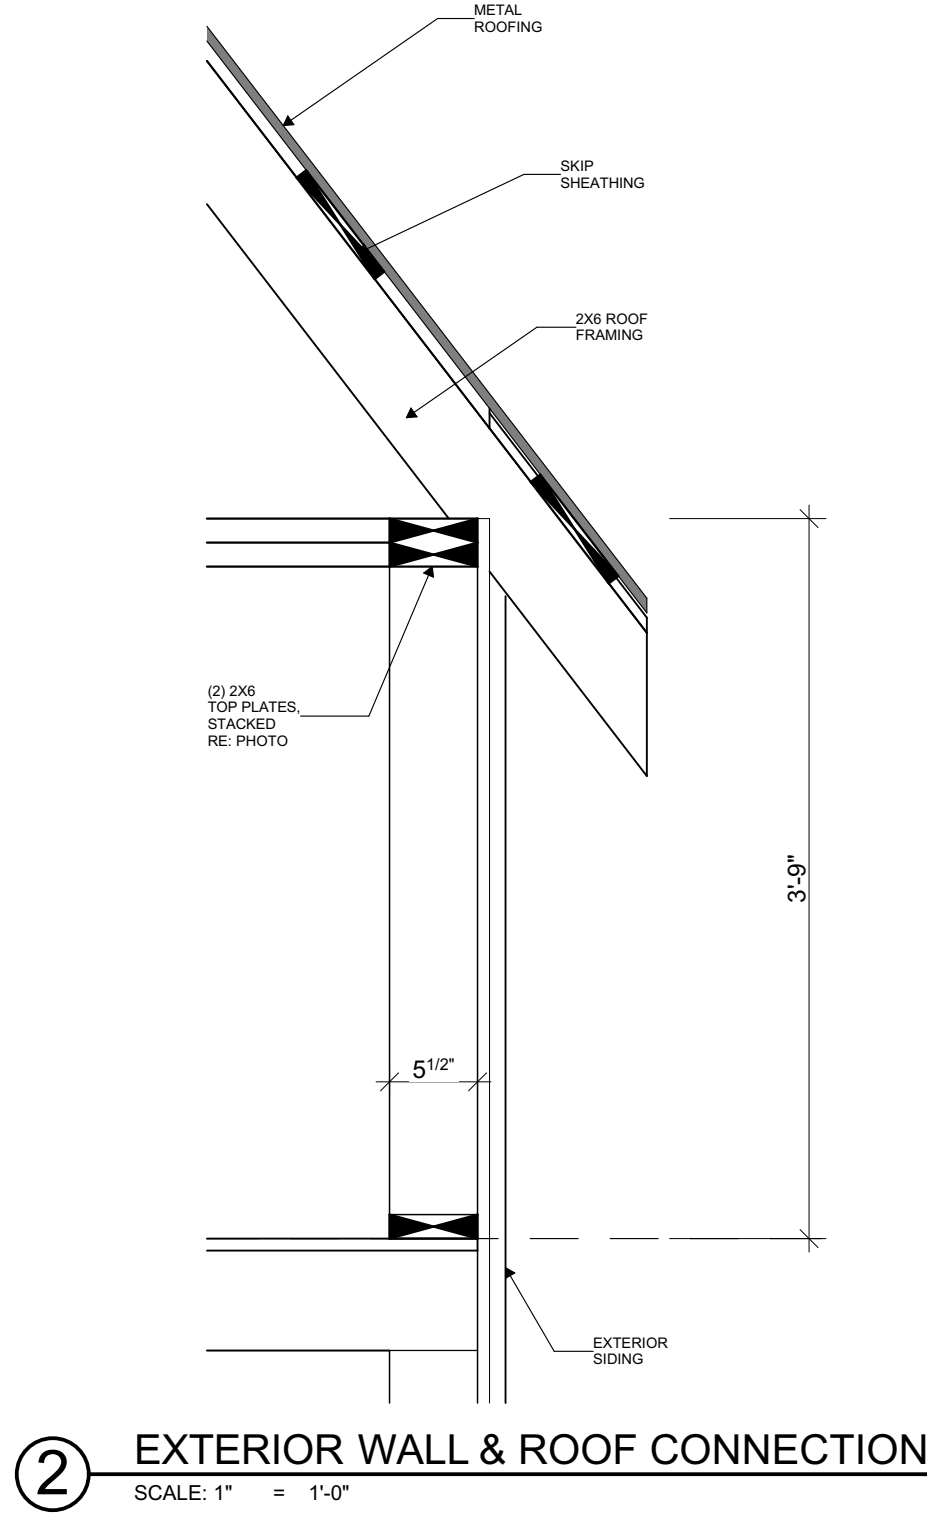


IMAGE DOCUMENTATION TO SUPPORT EXISTING CONDITIONS

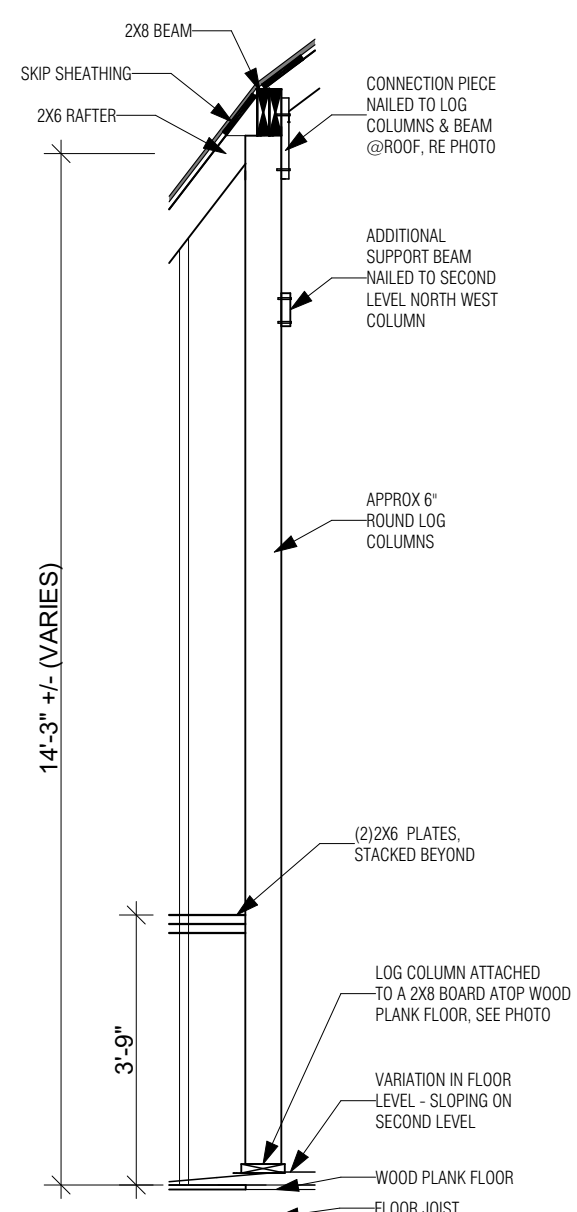


IMAGE DOCUMENTATION TO SUPPORT EXISTING CONDITIONS

**4** LOFT LEVEL LOG POST  
SCALE: 3/8" = 1'-0"


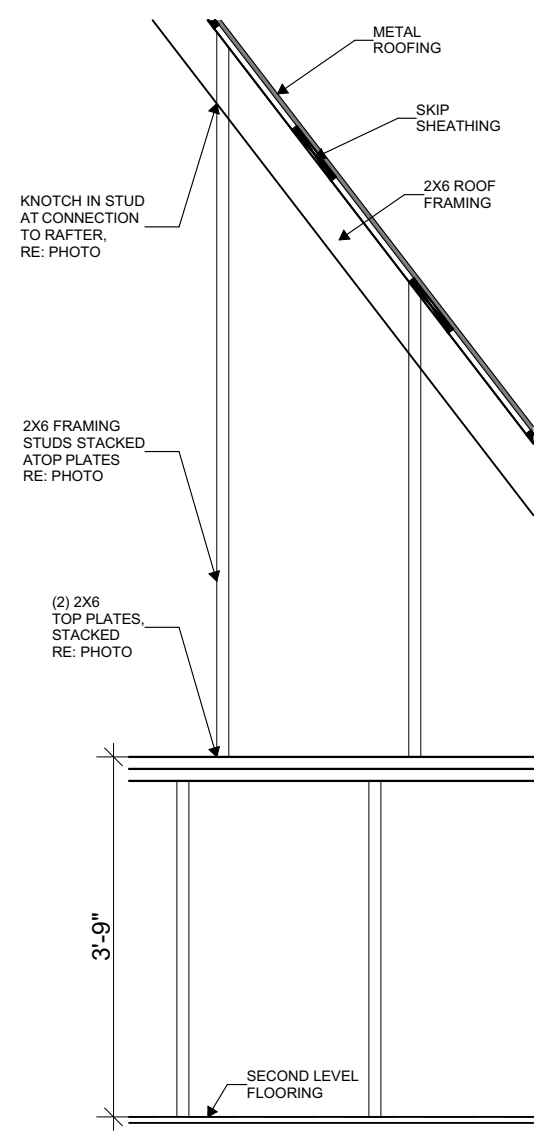



IMAGE DOCUMENTATION TO SUPPORT EXISTING CONDITIONS

**5** FRAMING CONNECTION @ 2ND LEVEL  
SCALE: 1/2" = 1'-0"




**1** BUILDING SECTION A  
SCALE: 1/4" = 1'-0"

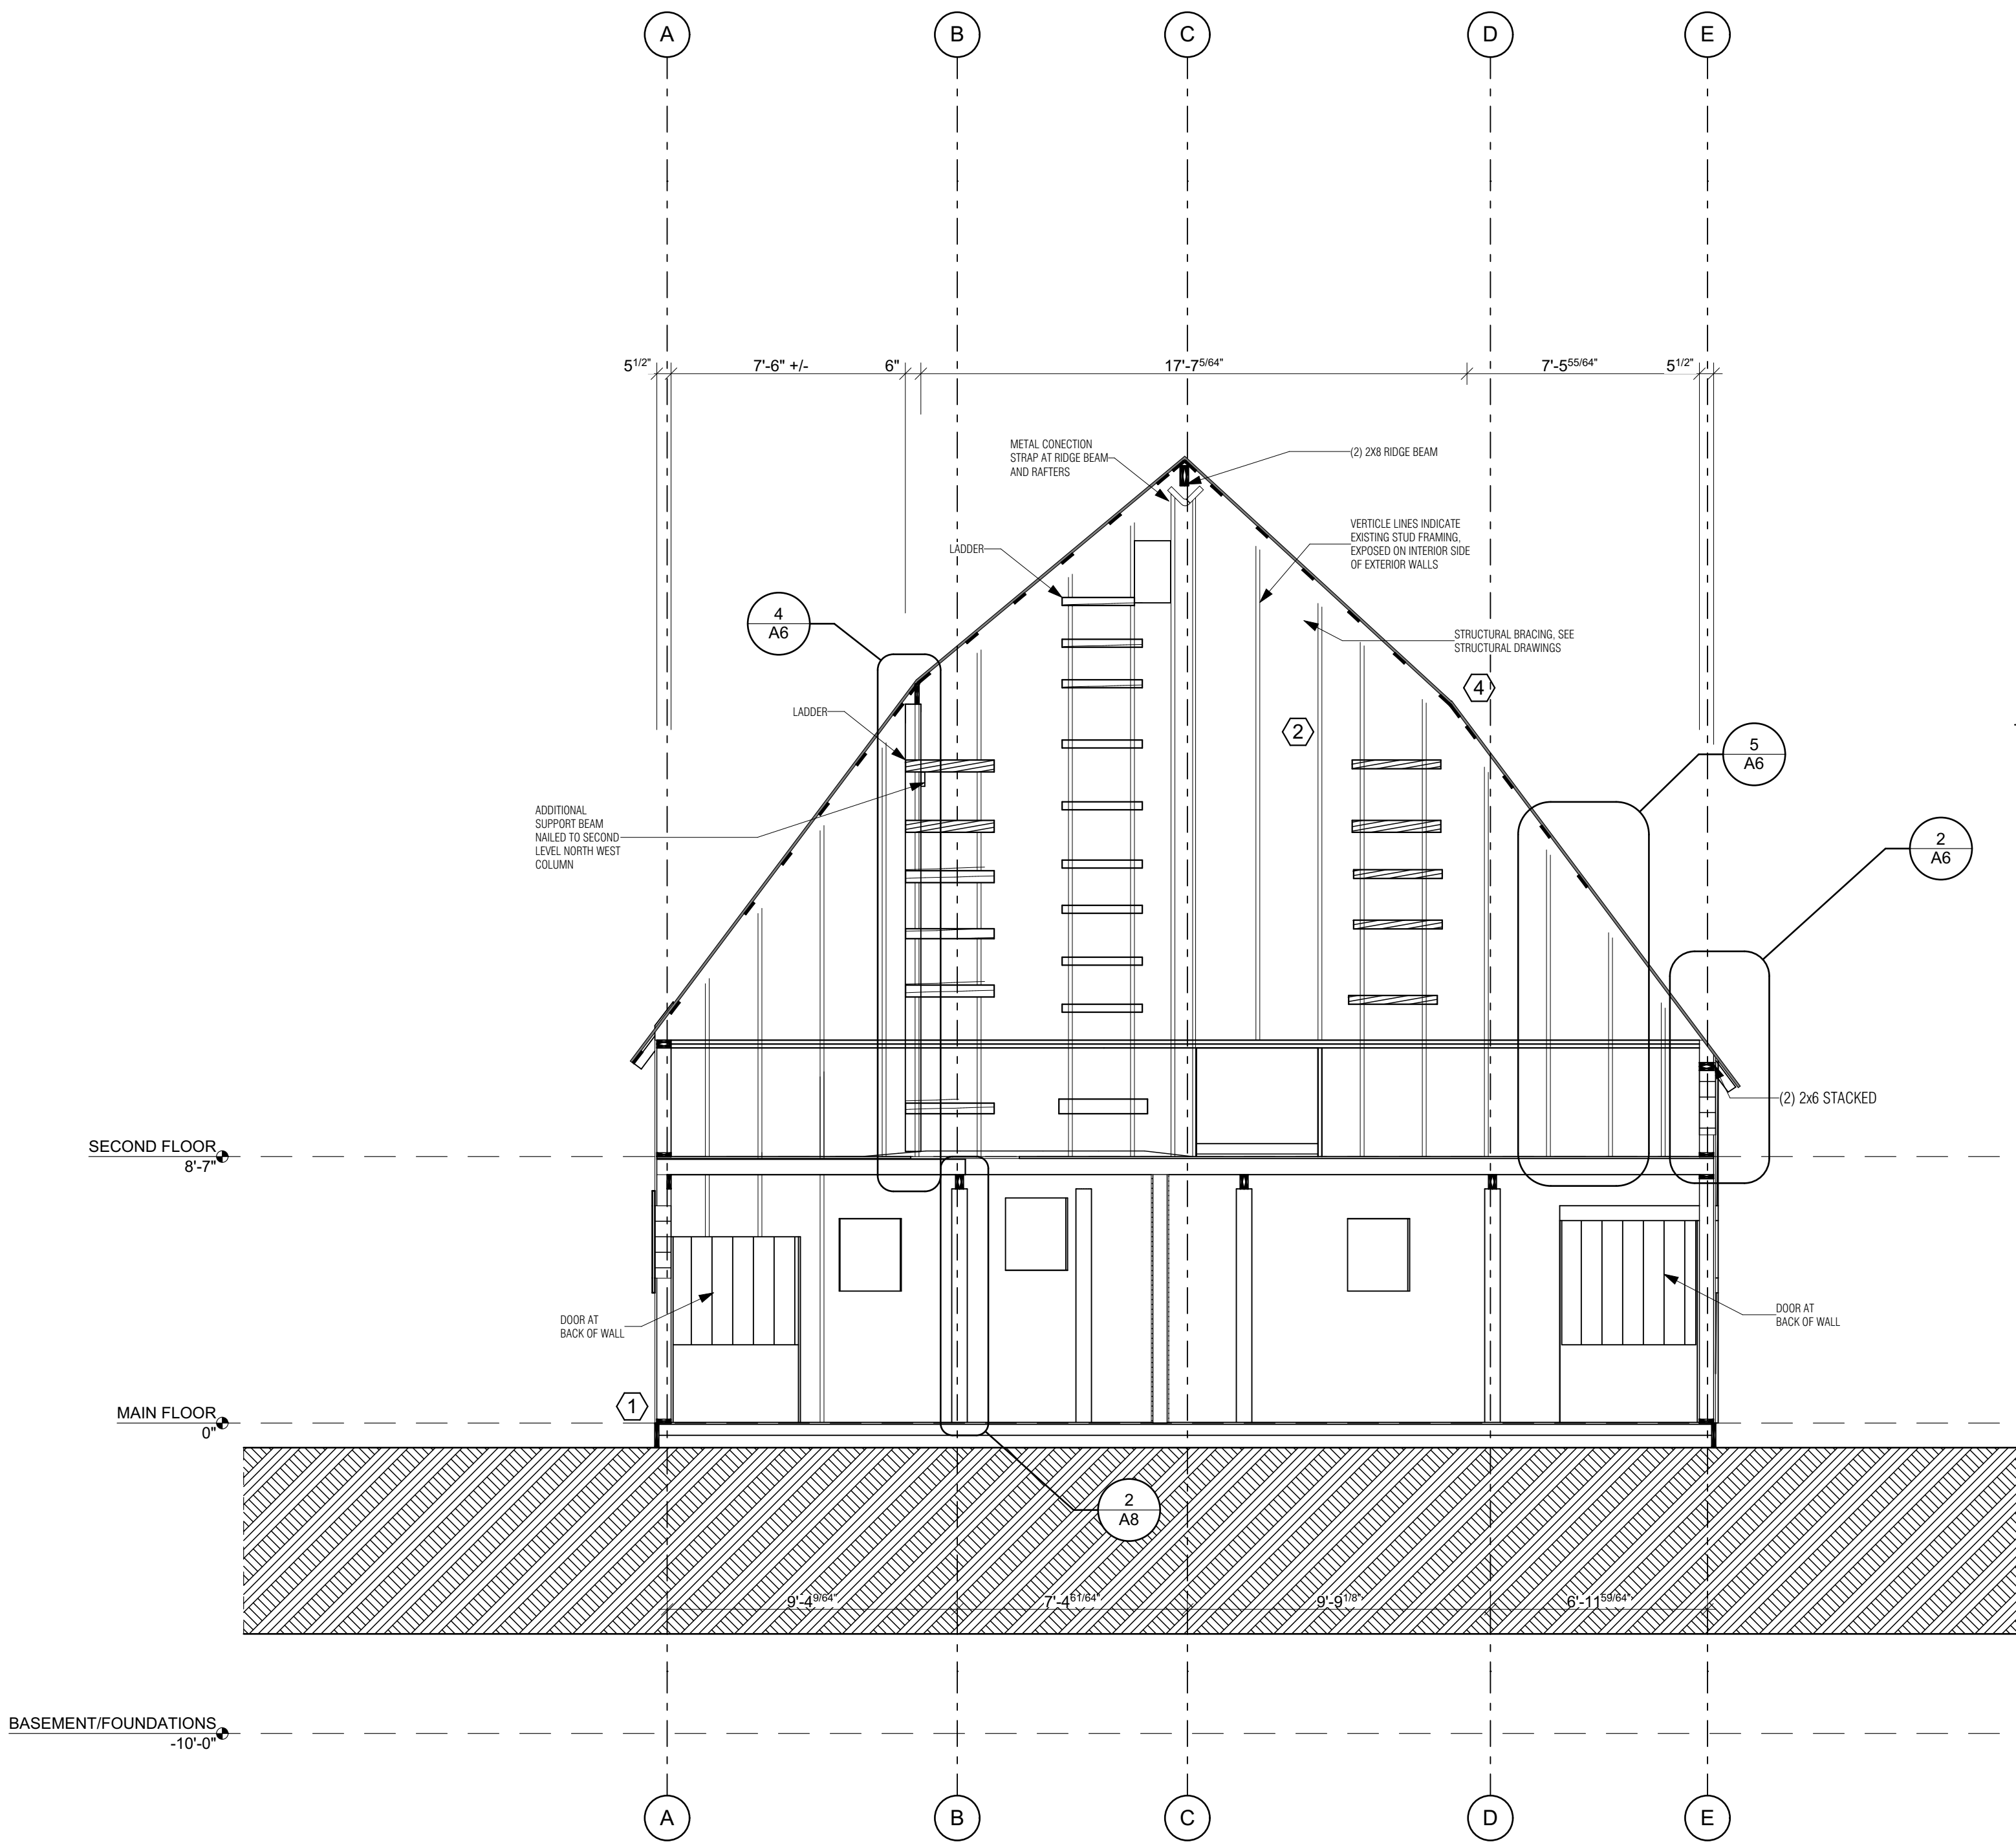

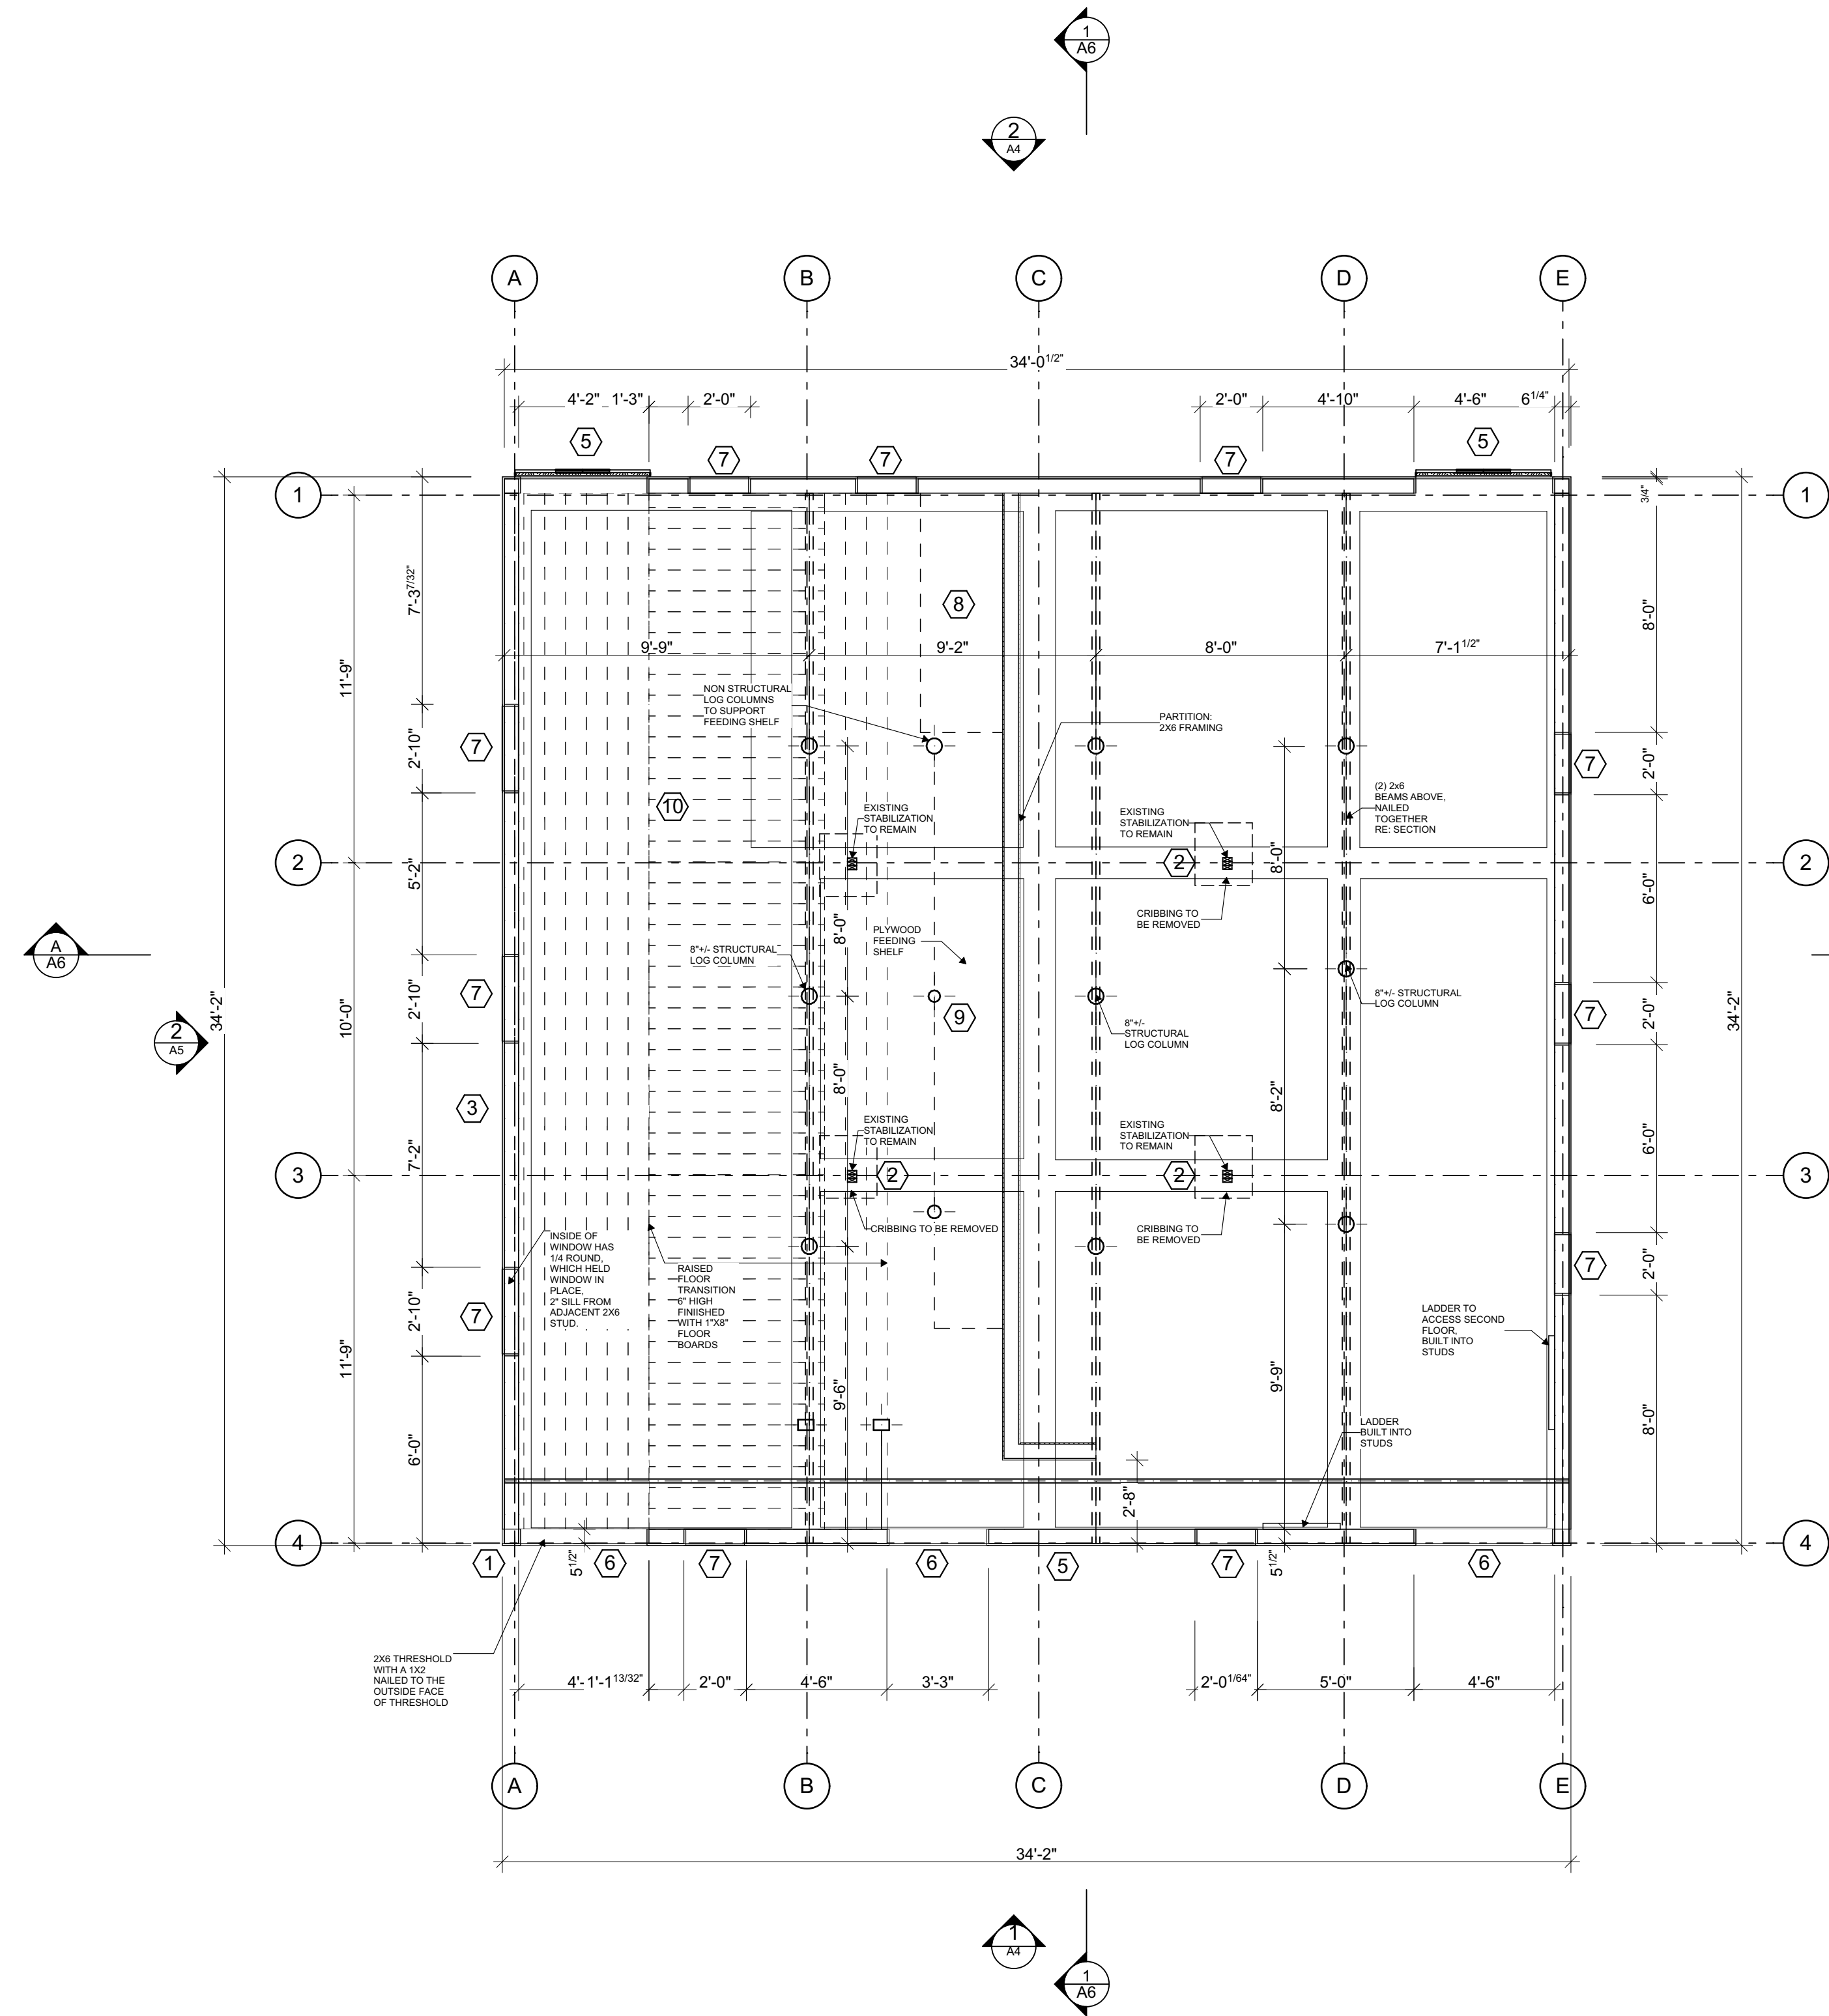

1 MAIN FLOOR PLAN  
SCALE: 1/4" = 1'-0"

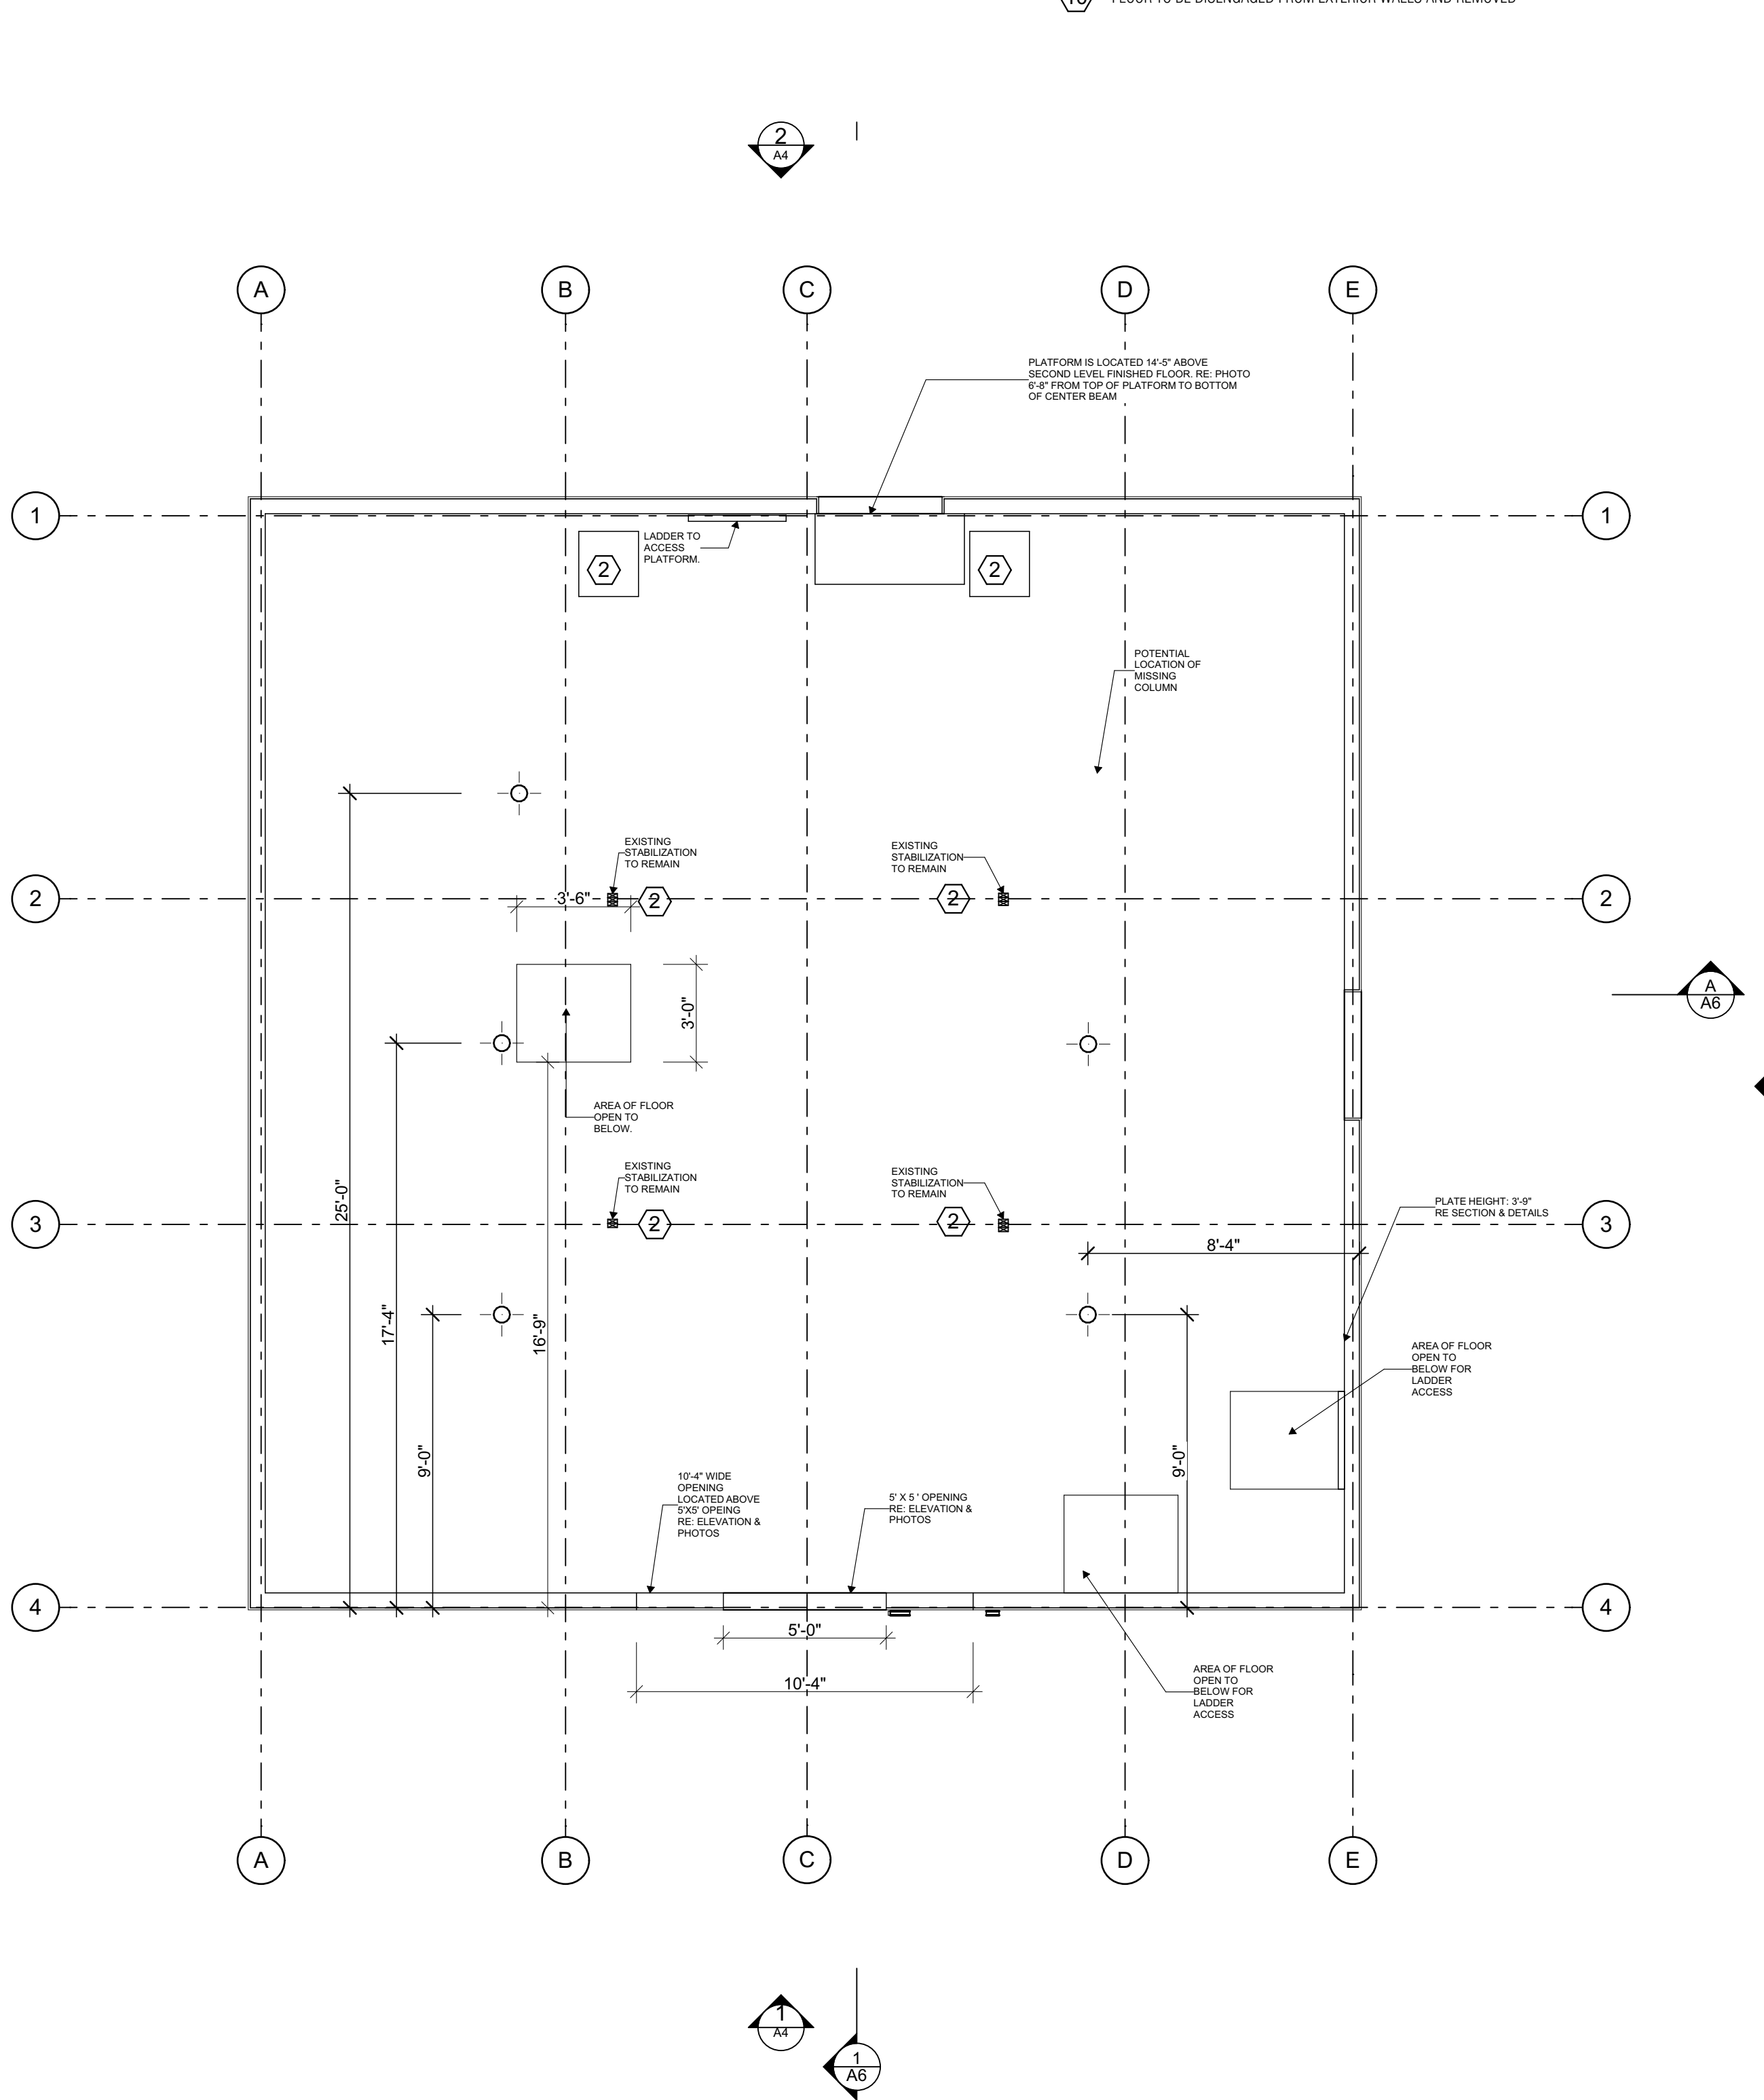

9 SECOND FLOOR PLAN  
SCALE: 1/4" = 1'-0"

- KEY NOTES
- 1 REPLACE 2 LOG BASE SOURCES IN KIND
  - 2 PROVIDE STRUCTURAL MEMBERS TO SUPPORT ROOF AND LOFT FLOOR, REFER TO STRUCTURAL DRAWINGS
  - 3 REMOVE SECOND GENERATION SIDING. PRESERVE SIDING UNLESS TOO DETERIORATED. IF TOO DETERIORATED, REPLACE IN KIND WITH RECYCLED WEATHER WORN BARN WOOD
  - 4 REPLACE ROOF IN KIND
  - 5 DOOR TO BE REHABILITATED
  - 6 DOOR TO BE PRESERVED IN KIND UTILIZING PHOTO DOCUMENTATION
  - 7 SINGLE GLAZED BARD SASH WINDOW TO BE REPLACED IN KIND UTILIZING PHOTO DOCUMENTATION
  - 8 GRAIN BIN TO BE PRESERVED
  - 9 FEEDING SHELF AND SUPPORTING MEMBERS TO BE REMOVED
  - 10 FLOOR TO BE DISENGAGED FROM EXTERIOR WALLS AND REMOVED

RCRBD  
RECORD SET




MOUNTAIN ARCHITECTURE  
DESIGN GROUP P.C.  
Jan Michael Kaminski,  
President  
P.O. BOX 1000  
STEAMBOAT SPRINGS, COLORADO 80487-9023  
(970) 867-1111  
jmk@mtarch.com

AN ICONIC ENTRY FOR THE  
**ARNOLD BARN INTERPRETIVE DISPLAY**  
2305 MT. WERNER CIR.  
STEAMBOAT SPRINGS, CO. 80487-9023


TITLE	MAIN FLOOR PLAN TREATMENTS
JOB NO.	PROJECT NUMBER
DRAWN BY	LRR
CHECKED BY	JMK
ISSUE DATE	5/25/2018
REVISIONS:	
1 DATE	
2 DATE	
3 DATE	
4 DATE	
5 DATE	
6 DATE	
7 DATE	
8 DATE	
9 DATE	
10 DATE	
DRAWING NUMBER	A7




- REPLACE 2 LOG BASE SOURCES IN KIND
- PROVIDE STRUCTURAL MEMBERS TO SUPPORT ROOF AND LOFT FLOOR, REFER TO STRUCTURAL DRAWINGS
- REMOVE SECOND GENERATION SIDING. PRESERVE SIDING UNLESS TOO DETERIORATED. IF TOO DETERIORATED, REPLACE IN KIND WITH RECYLCED WEATHER WORN BARN WOOD
- REPLACE ROOF IN KIND
- DOOR TO BE PRESERVED
- DOOR TO BE PRESERVED IN KIND UTILIZING PHOTO DOCUMENTATION
- SINGLE GLAZED BARD SASH WINDOW TO BE REPLACED IN KIND UTILIZING PHOTO DOCUMENTATION
- GRAIN BIN TO BE PRESERVED
- FEEDING SHELF AND SUPPORTING MEMBERS TO BE REMOVED

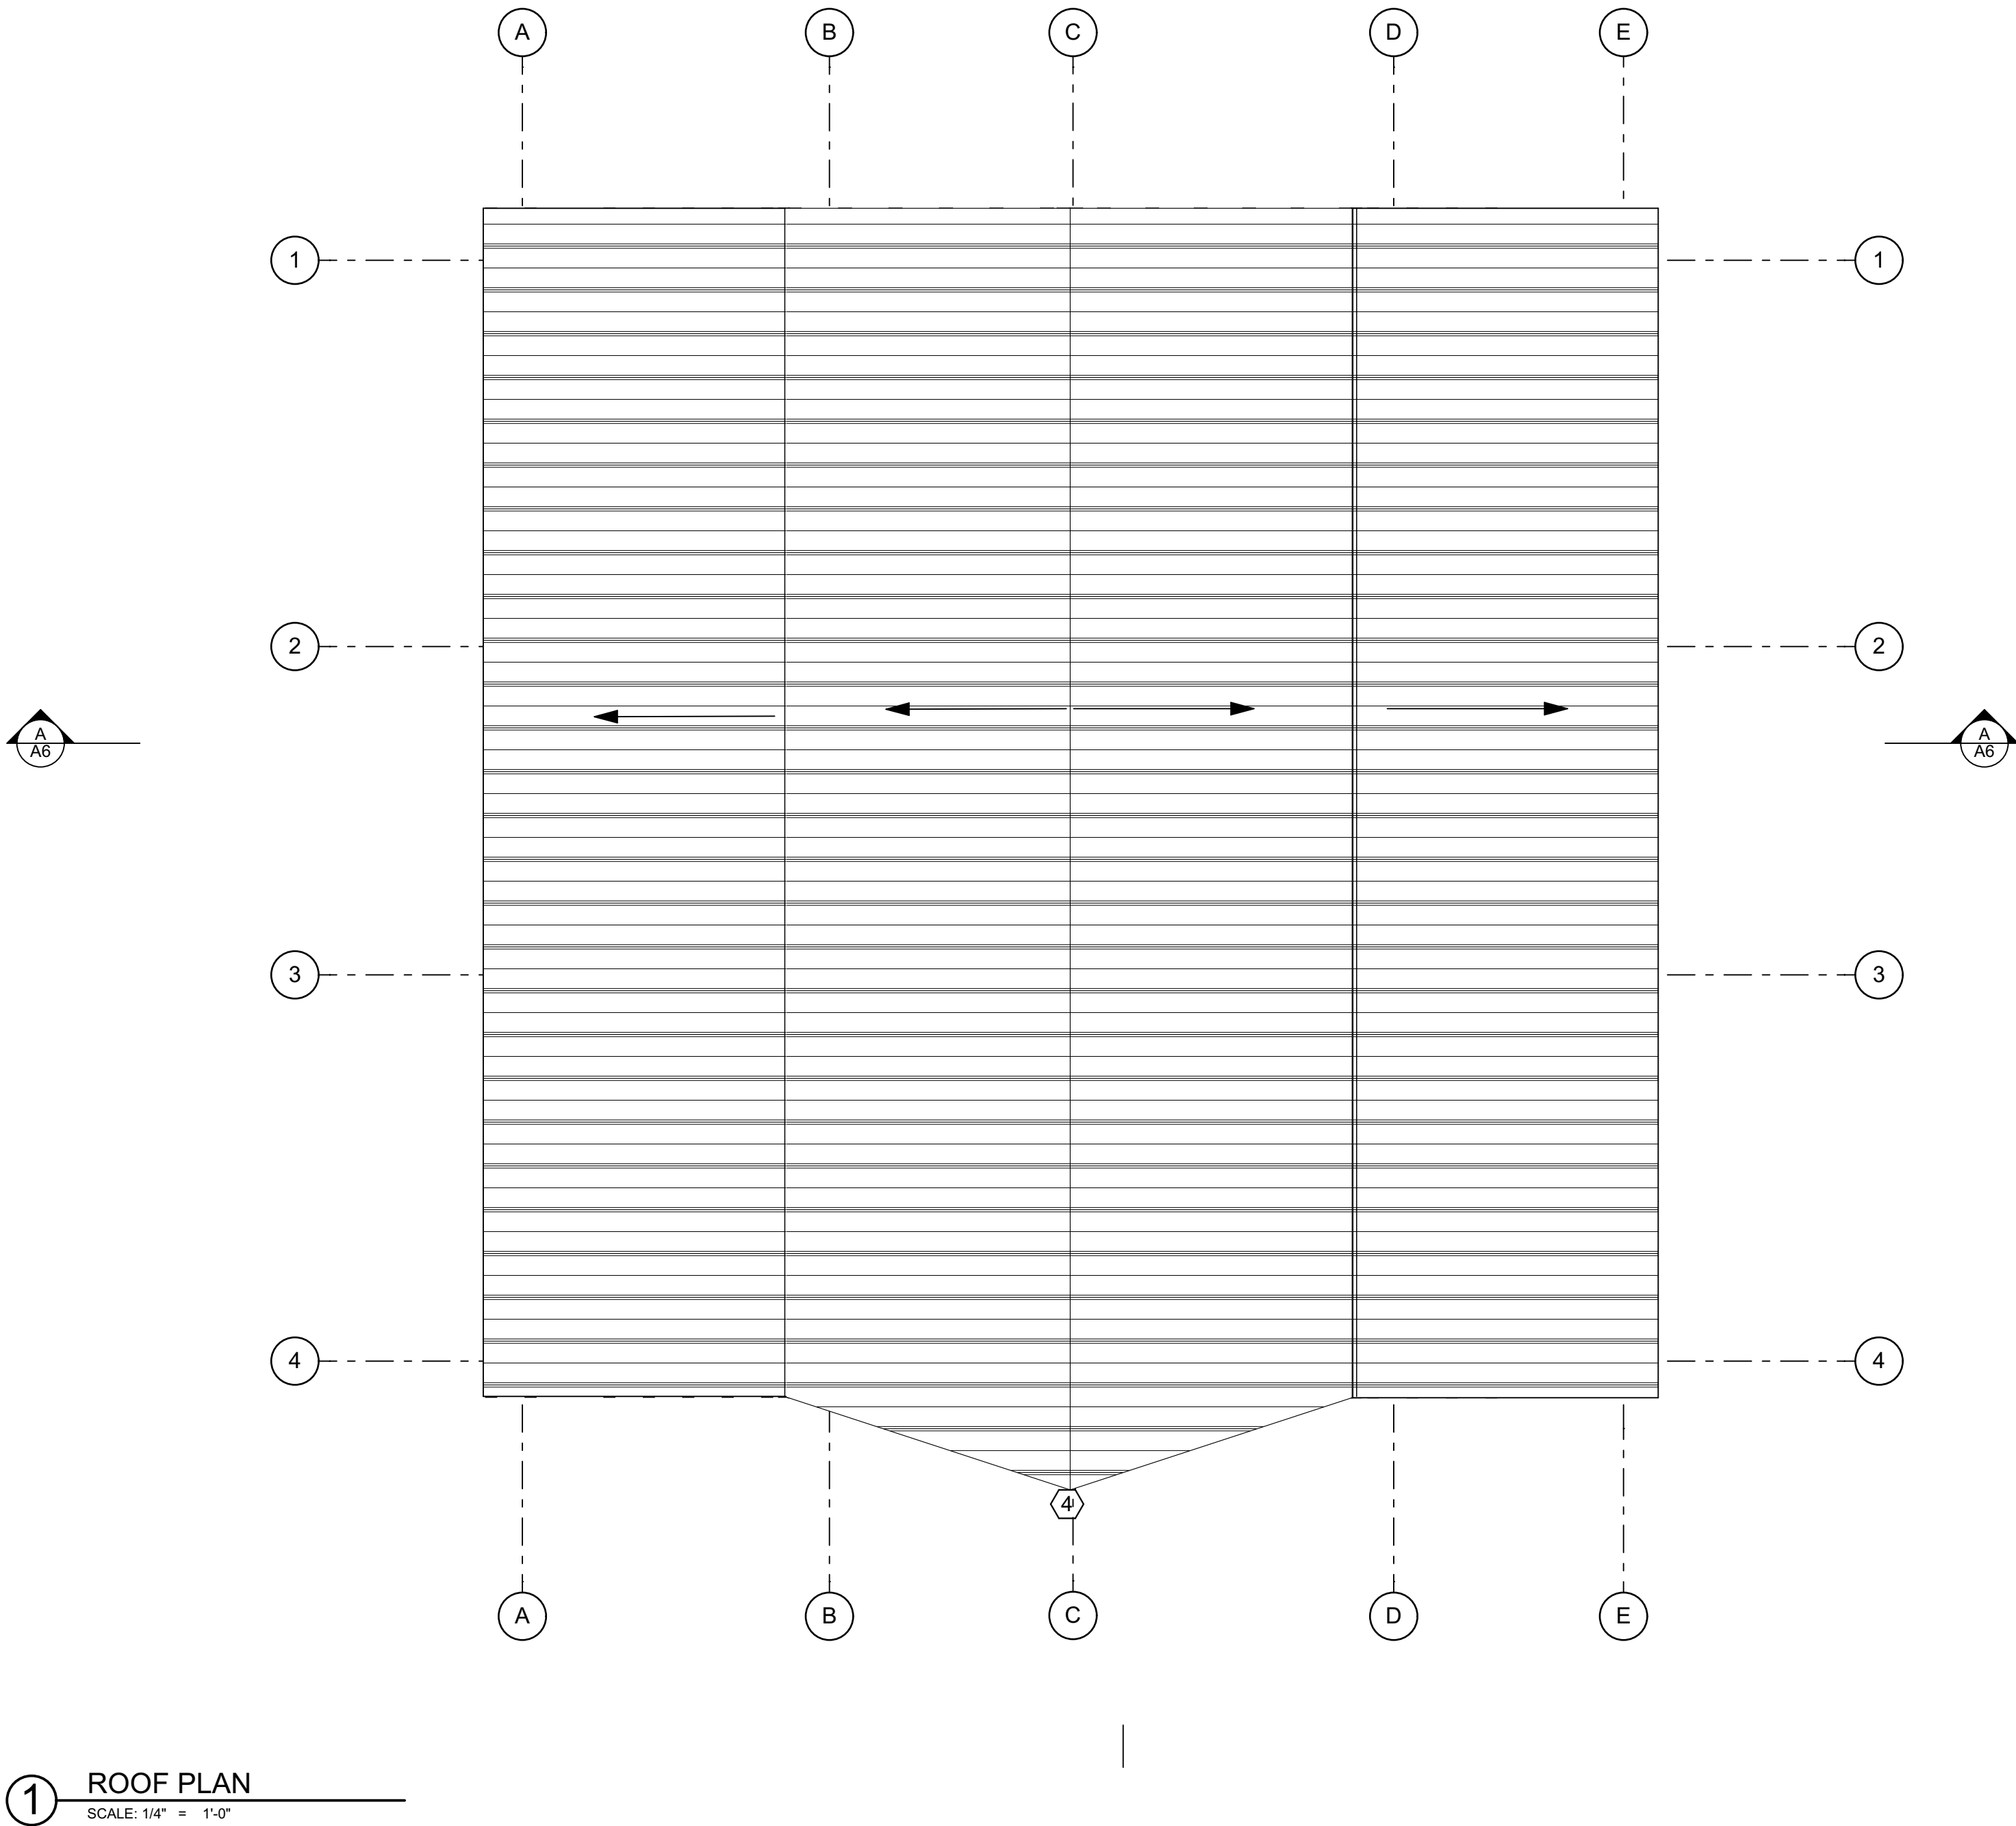

1 ROOF PLAN  
SCALE: 1/4" = 1'-0"

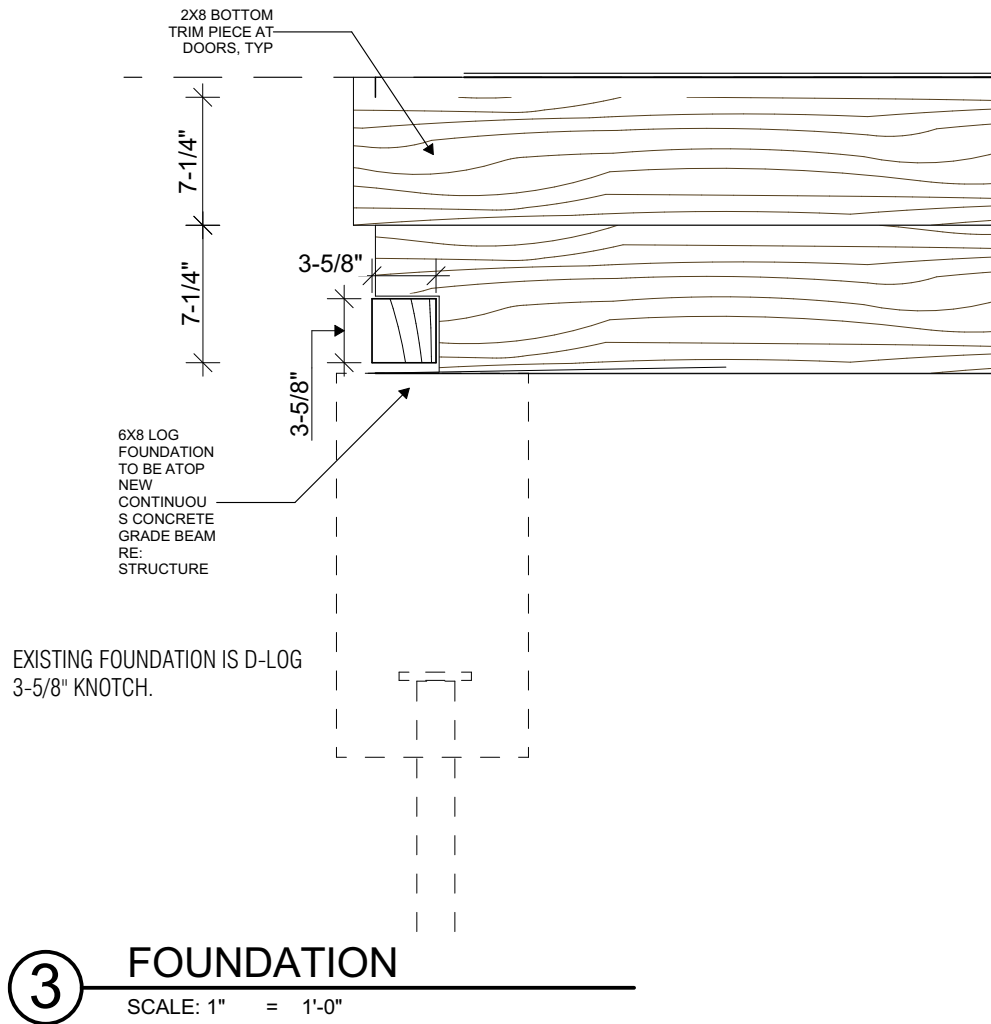

3 FOUNDATION  
SCALE: 1" = 1'-0"

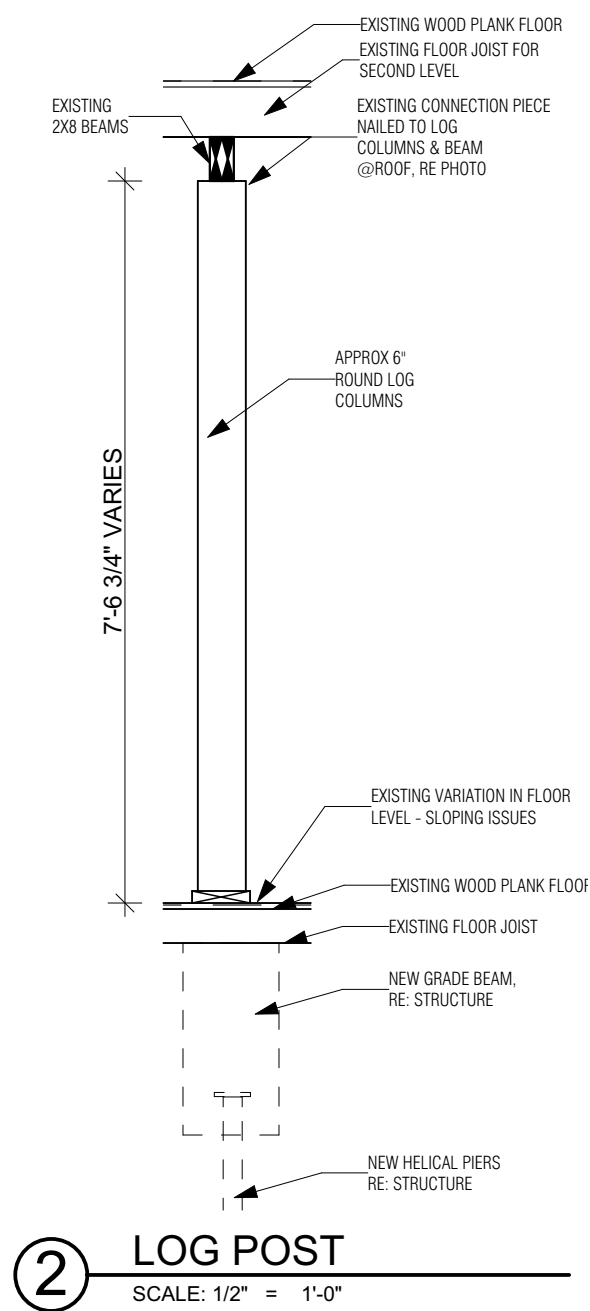

2 LOG POST  
SCALE: 1/2" = 1'-0"

IMAGE DOCUMENTED TO  
SUPPORT FOUNDATION DETAIL



ADDITIONAL EXISTING FOUNDATION IMAGES:



ADDITIONAL EXISTING FOUNDATION IMAGES:



IMAGE DOCUMENTATION TO SUPPORT EXISTING CONDITIONS



MOUNTAIN ARCHITECTURE  
DESIGN GROUP P.C.  
Jan Michael Kaminski,  
President  
P.O. BOX 10000  
STEAMBOAT SPRINGS, COLORADO 80487-9023  
(970) 861-1111  
jmk@mtarch.com

AN ICONIC ENTRY FOR THE  
ARNOLD BARN INTERPRETIVE DISPLAY  
2305 MT. WERNER CIR.  
STEAMBOAT SPRINGS, CO. 80487-9023

TITLE  
ROOF PLAN

ADDITIONAL EXISTING FOUNDATION IMAGES:  
JOB NO. PROJECT NUMBER  
DRAWN BY LRR  
CHECKED BY JMK  
ISSUE DATE 5/25/2018

REVISIONS:  
1 DATE

DRAWING NUMBER  
A8



- KEY NOTES
- REPLACE 2 LOG BASE SOURCES IN KIND
  - PROVIDE STRUCTURAL MEMBERS TO SUPPORT ROOF AND LOFT FLOOR, REFER TO STRUCTURAL DRAWINGS
  - REMOVE SECOND GENERATION SIDING. PRESERVE SIDING UNLESS TOO DETERIORATED. IF TOO DETERIORATED, REPLACE IN KIND WITH RECYCLED WEATHER WORN BARN WOOD
  - REPLACE ROOF IN KIND
  - DOOR TO BE REHABILITATED
  - DOOR TO BE PRESERVED IN KIND UTILIZING PHOTO DOCUMENTATION
  - SINGLE GLAZED BARD SASH WINDOW TO BE REPLACED IN KIND UTILIZING PHOTO DOCUMENTATION
  - GRAIN BIN TO BE PRESERVED
  - FEEDING SHELF AND SUPPORTING MEMBERS TO BE REMOVED



MOUNTAIN ARCHITECTURE  
DESIGN GROUP P.C.  
Jan Michael Kaminski,  
President  
P.O. BOX 1000  
STEAMBOAT SPRINGS, COLORADO 80487  
(970) 861-1111  
jmk@mtnarch.com


AN ICONIC ENTRY FOR THE  
**ARNOLD BARN INTERPRETIVE DISPLAY**  
2305 MT. WERNER CIR.  
STEAMBOAT SPRINGS, CO. 80487-9023

TITLE  
ELEVATIONS

JOB NO. PROJECT NUMBER  
DRAWN BY LRR  
CHECKED BY JMK  
ISSUE DATE 5/25/2018

REVISIONS:  
1 DATE



DRAWING NUMBER  
A9

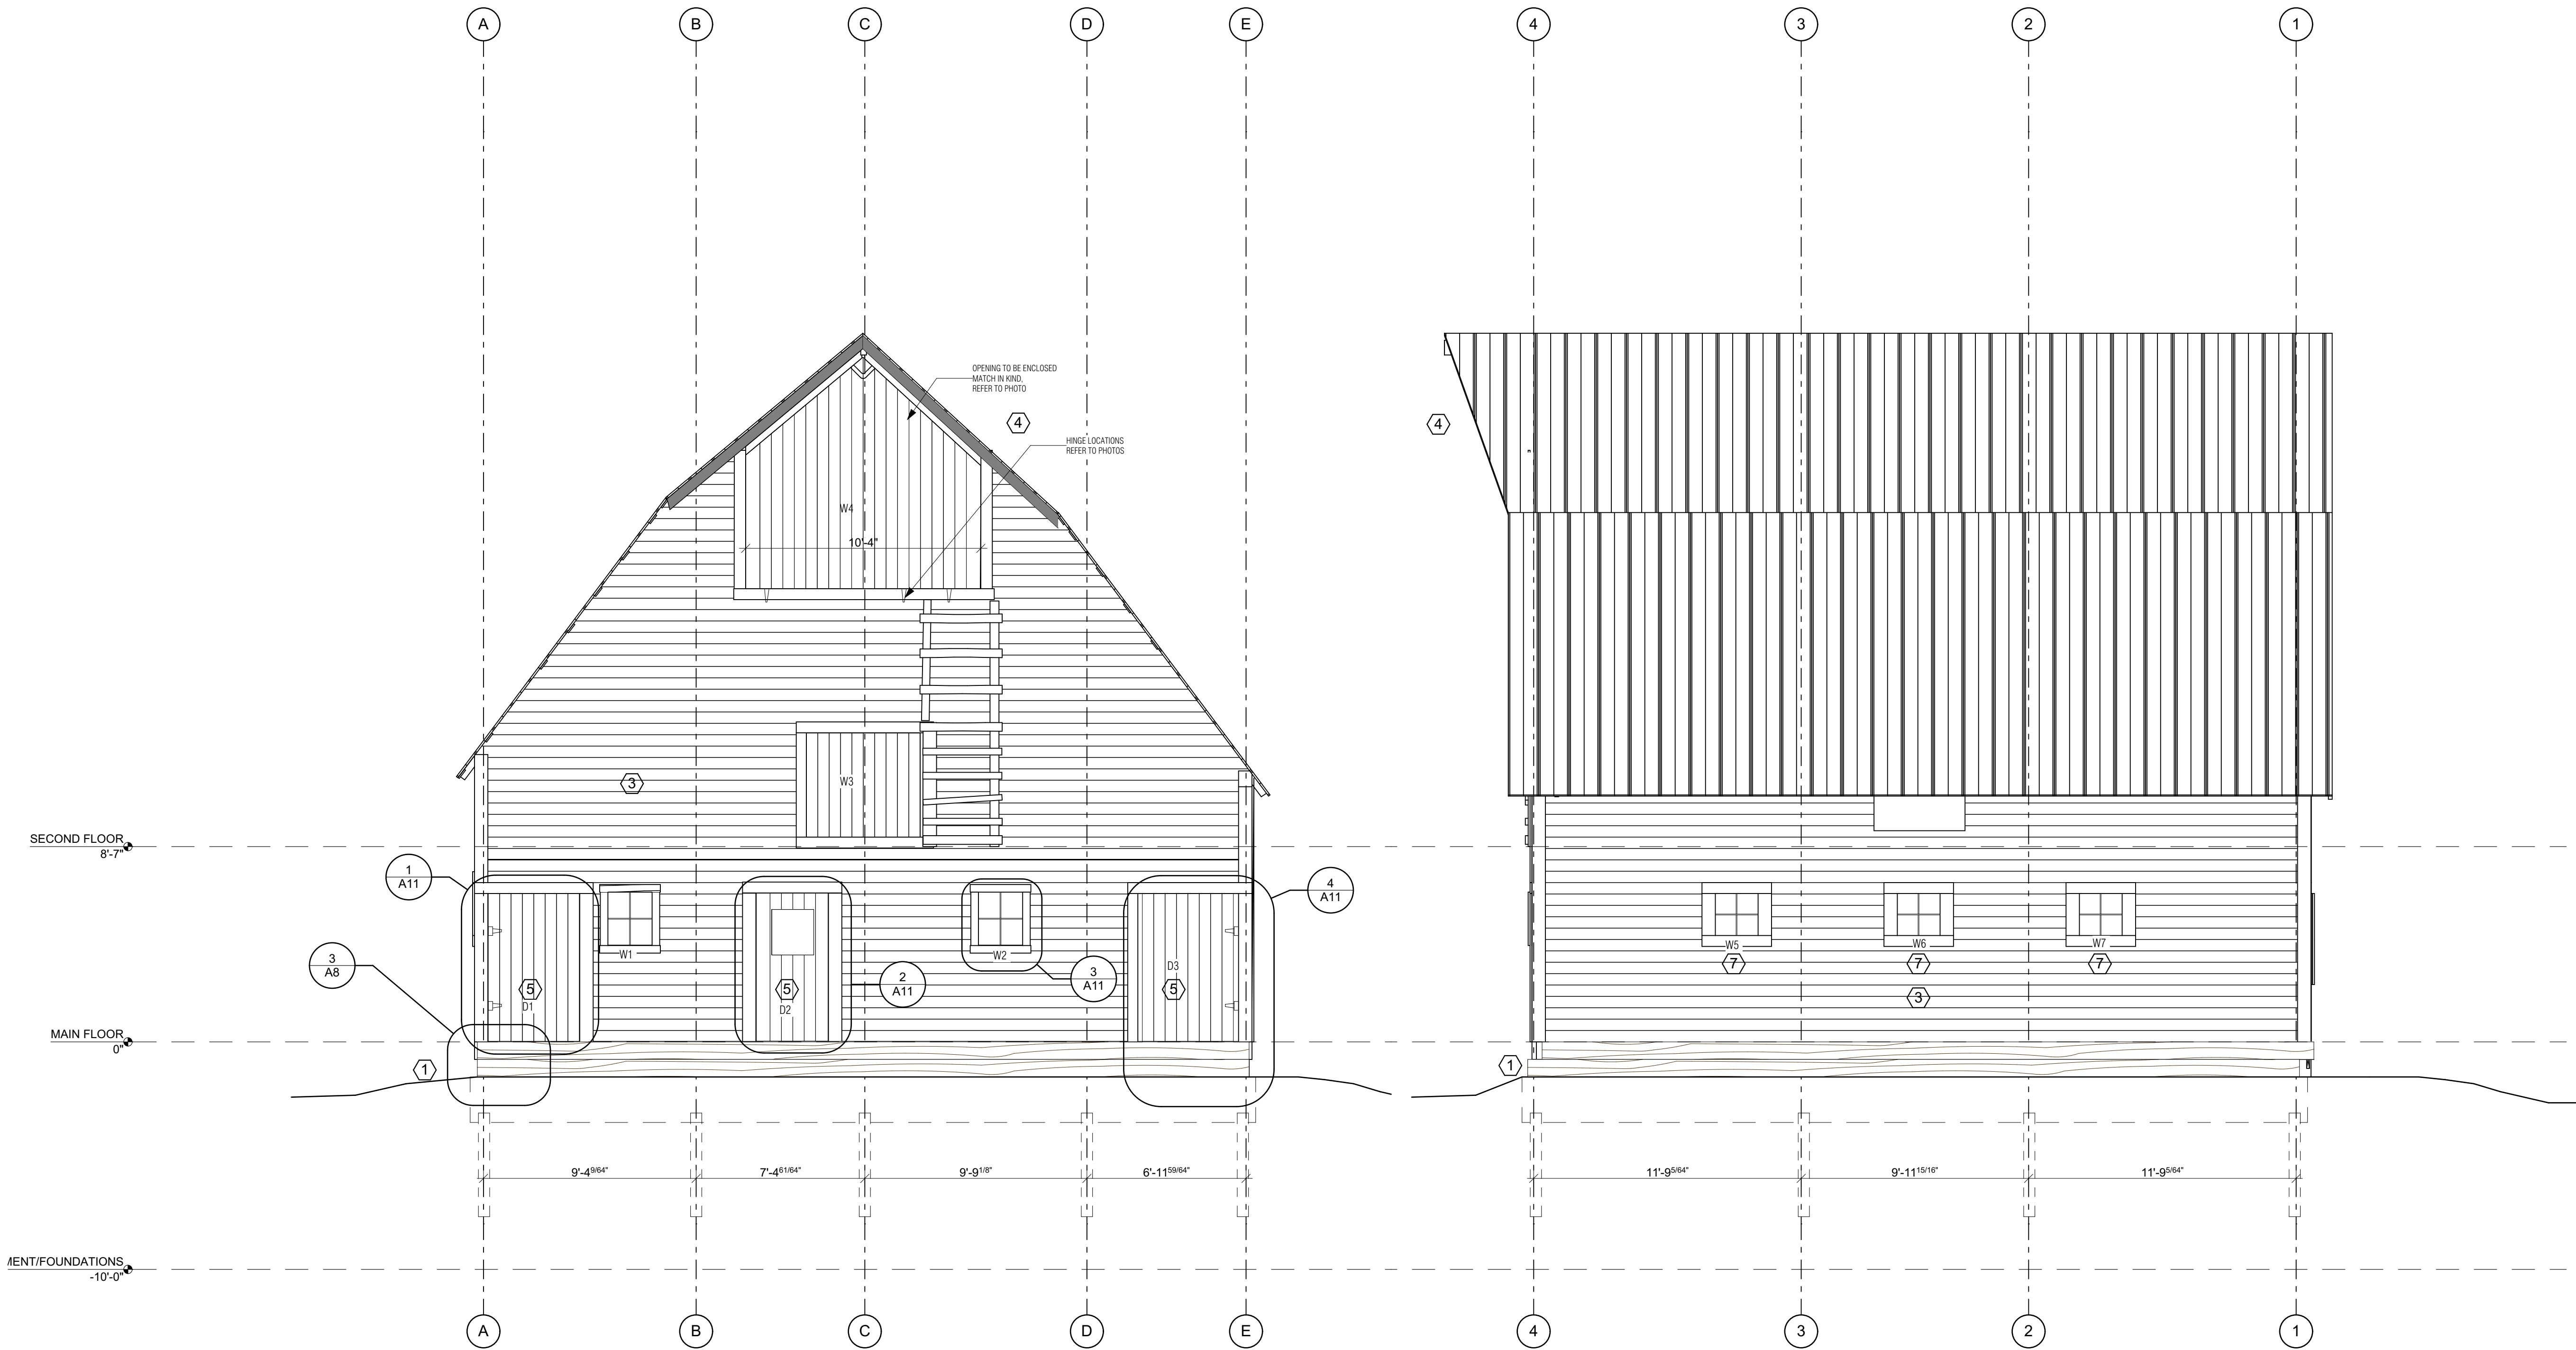

1 SOUTH ELEVATION  
SCALE: 1/4" = 1'-0"

2 EAST ELEVATION  
SCALE: 1/4" = 1'-0"



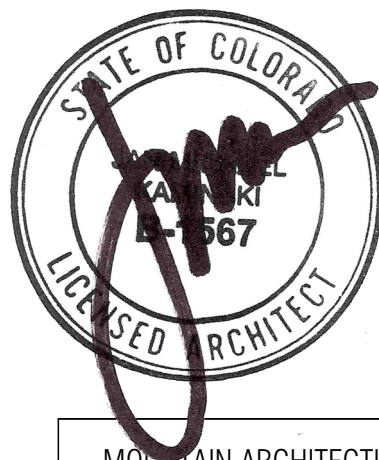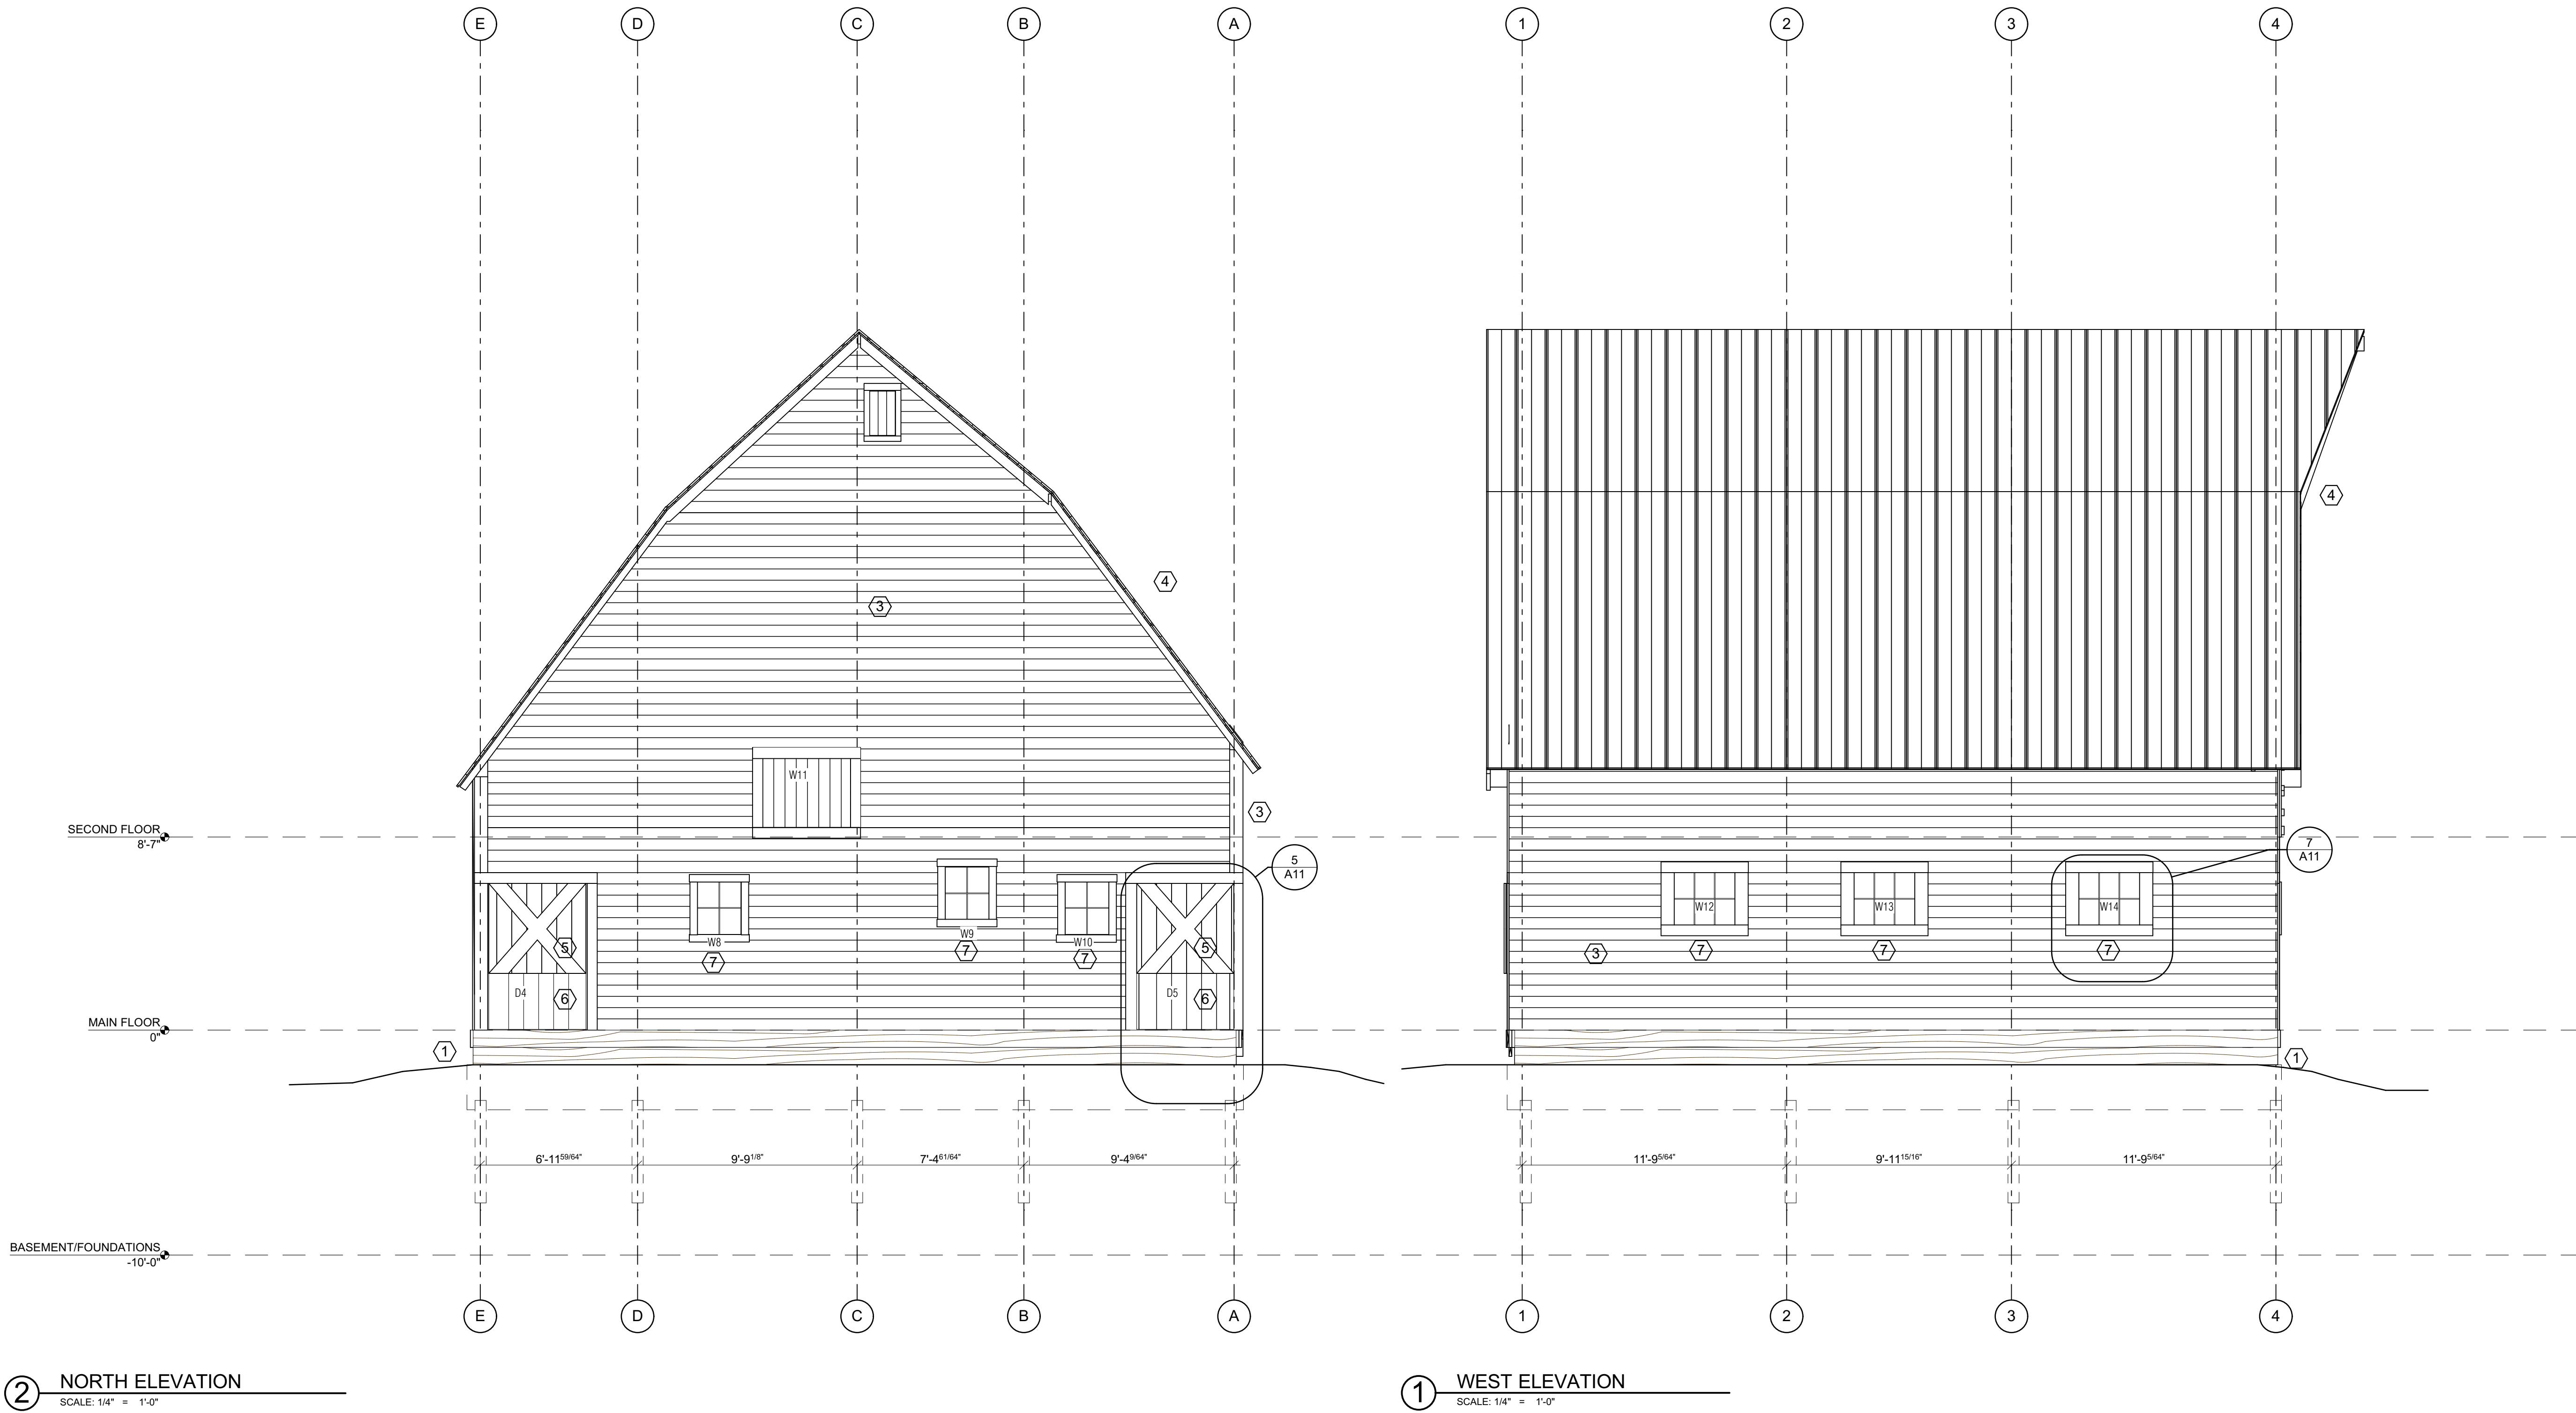

MOUNTAIN ARCHITECTURE  
DESIGN GROUP P.C.  
Jan Michael Kaminski,  
President  
P.O. BOX 17000  
STEAMBOAT SPRINGS, COLORADO 80487  
(970) 861-1111, (970) 861-1112  
jmk@mtarch.com

AN ICONIC ENTRY FOR THE  
**ARNOLD BARN INTERPRETIVE DISPLAY**  
2305 MT. WERNER CIR.  
STEAMBOAT SPRINGS, CO. 80487-9023

TITLE  
ELEVATIONS

JOB NO. PROJECT NUMBER  
DRAWN BY LRR  
CHECKED BY JMK  
ISSUE DATE 5/25/2018

REVISIONS:  
1 DATE

DRAWING NUMBER  
A10







RCRBD  
RECORD SET




MOUNTAIN ARCHITECTURE  
DESIGN GROUP P.C.  
Jan Michael Kaminski,  
President  
P.O. BOX 17000  
STANDARD SPRINGS, COLORADO 80487  
970.487.9023  
jmk@mtarch.com

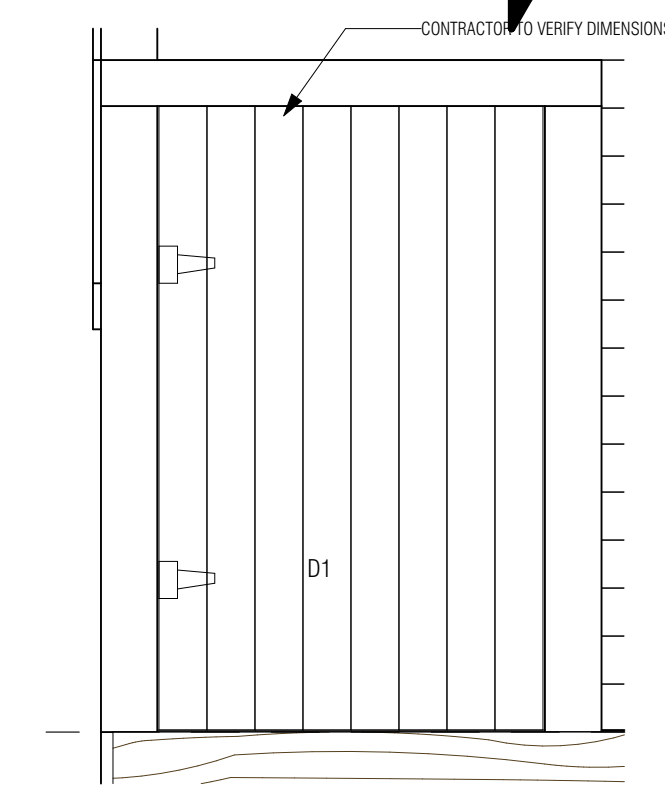


① SOUTH: D1  
SCALE: 1/2" = 1'-0"

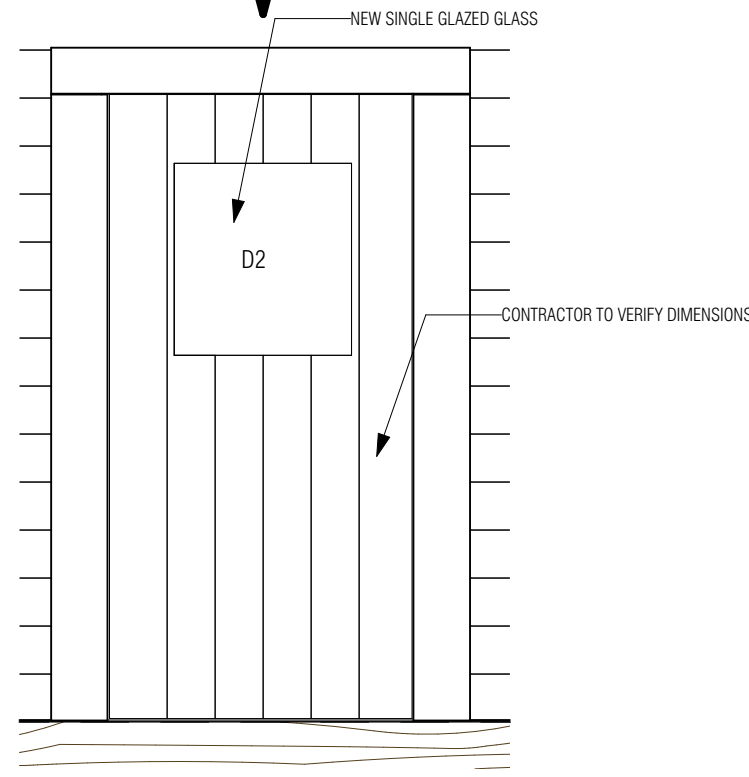


② SOUTH: D2  
SCALE: 1/2" = 1'-0"

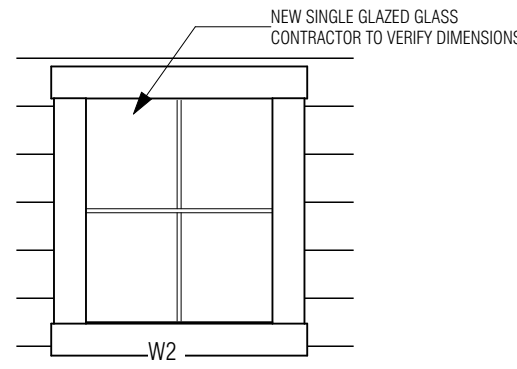


③ SOUTH: W2  
SCALE: 1/2" = 1'-0"

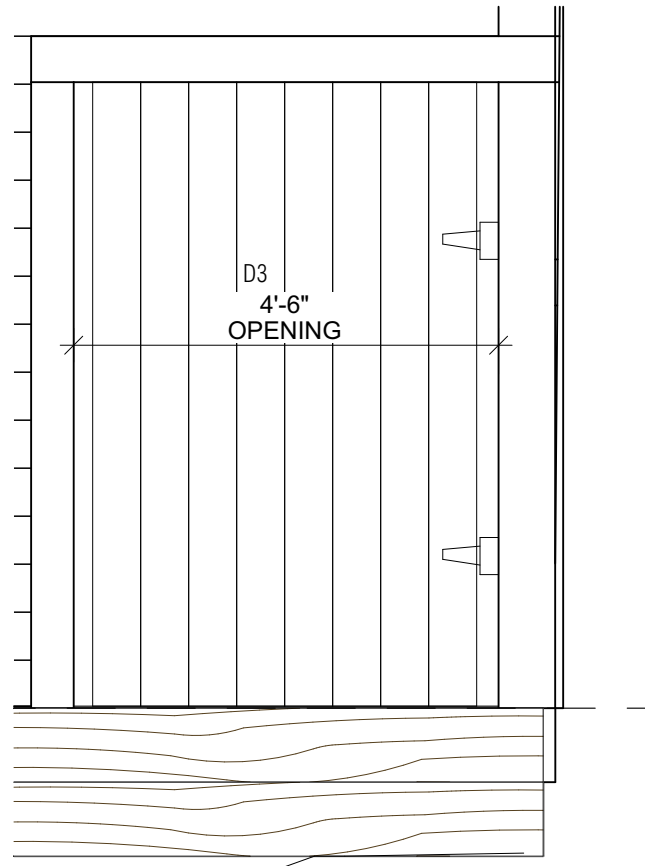


④ SOUTH: D3  
SCALE: 1/2" = 1'-0"

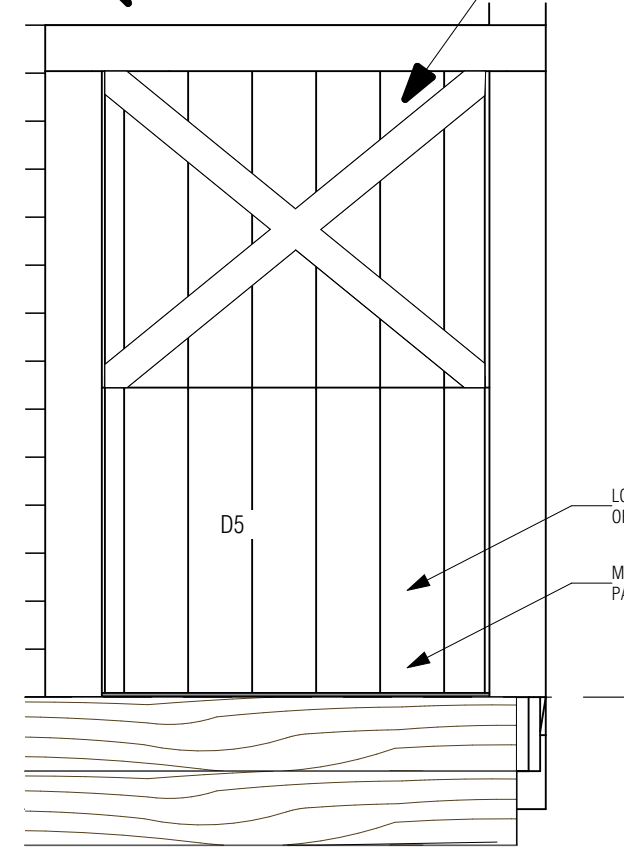

⑤ DOOR @ NORTH WEST CORNER  
SCALE: 1/2" = 1'-0"

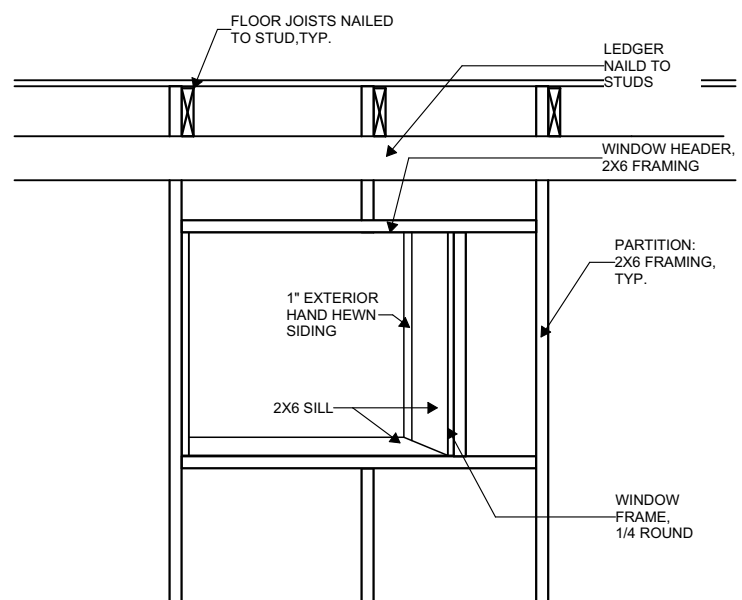

⑥ WINDOW DETAIL  
SCALE: 1/2" = 1'-0"

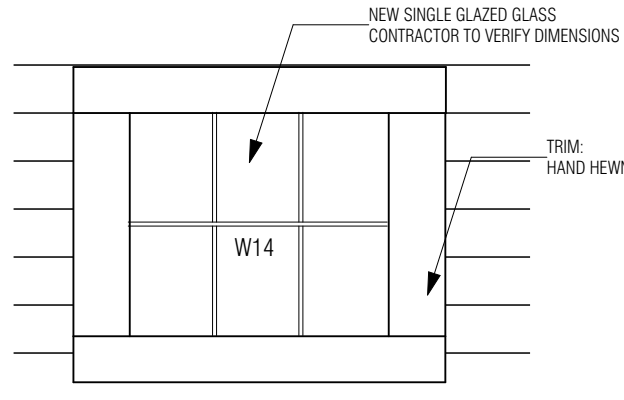

⑦ EXTERIOR WINDOW STYLE, TYP.  
SCALE: 1/2" = 1'-0"



AN ICONIC ENTRY FOR THE  
**ARNOLD BARN INTERPRETIVE DISPLAY**  
2305 MT. WERNER CIR.  
STEAMBOAT SPRINGS, CO. 80487-9023

TITLE  
**DOOR & WINDOW  
DETAILS**

JOB NO. PROJECT NUMBER  
DRAWN BY LRR  
CHECKED BY JMK  
ISSUE DATE 5/25/2018

REVISIONS:  
1 DATE

DRAWING NUMBER  
**A11**



STRUCTURAL NOTES

Applicable Codes and Standards:

- A. 2015 International Building Code (including all local adoptions)  
B. 2015 International Residential code (including all local adoptions)  
C. City of Steamboat Springs Community Development Code  
D. "Minimum Design Loads for Buildings and Other Structures" - ASCE 7-10  
E. "Building Code Requirements for Structural Concrete" - ACI318  
F. "Steel Construction Manual" - AISC fourteenth edition  
G. "National Design Specification for Wood Construction" - ANSI/APA-NDS 2005

Design Live Loads:

- A. Roofs: 20 psf  
B. Floors: 20 psf  
C. Wind: 120 mph, Exposure B  
D. Seismic Design: Category B, Soil Type D

Foundation Criteria:

- A. Design of continuous concrete grade beams with helical piles is based on the presence of expansive soils per the soils report No. 17-10873 by Northwest Colorado Consultants, Inc.  
B. The helical pile foundations and tiebacks are designed in accordance with the Practical Design and Inspection Guide for Helical Piles and Helical Tension Anchors Compiled and Prepared by John S. Pack, P.E. for I.M.R., Inc., Denver, Colorado, Revision 2, July 27, 2008.  
C. The helical piles and tension anchors shall be installed to the minimum torques and lengths specified herein.  
D. The installation of the helical piles and tension anchors shall be monitored and recorded by a representative of SEAD, Inc. or approved independent testing agency.

Reinforced Concrete:

- A. Structural concrete shall be Type I, and have a minimum 28 day strength of 3,000 psi. Exterior concrete slabs shall be Type I and have a minimum 28 day strength of 4,000 psi. All concrete shall have a min 6% (+/- 1.5%) entrained air for durability and a 4" (+/- 1") slump. The maximum aggregate size shall be 3/4". Concrete shall not be placed on frozen ground and shall be protected from freezing for a minimum of 7 days. During cold weather the methods and specifications set forth in ACI 306R-88 shall be followed to prevent frost damage.  
B. All concrete work shall conform to the requirements of ACI318 and 301, latest edition.  
C. All exposed edges shall have a 3/4" chamfer.  
D. Reinforcing bars shall conform to ASTM spec. A615-79 and shall be Grade 60.  
E. At splices, lap bars a minimum of 38 diameters. At corners and intersections, make horizontal continuous or provide matching corner bars. Around openings in walls and slabs, provide (2) #5 bars extending a minimum of 2 feet beyond the edge of the opening. Continuous top bars in walls shall be spliced at mid-span. Continuous bottom bars in walls shall be spliced at supports.  
F. Concrete cover shall conform to ACI 318-08, 7.7. Unless a greater cover is required, concrete cast against earth shall have 3in. min. cover, concrete exposed to earth or weather shall have 2in. min. cover for No. 6 bars & greater, & 1 1/2in. min. cover for No. 5 bars & smaller. Concrete not exposed to weather shall have 3/4" min. cover for No. 11 bars & smaller.  
G. Welded wire fabric shall conform to ASTM 185 and shall be lapped one full mesh at splices and tied together.  
H. Concrete shall be adequately consolidated/vibrated during placement to ensure it is thoroughly placed around all reinforcing steel and embedded fixtures.  
I. Unless noted otherwise, slabs, footings and walls shall not have any horizontal 'cold joints'. All construction joints shall be detailed or reviewed by the Engineer of Record.  
J. Interior concrete slab finish shall be steel towel finished and exterior concrete slabs shall be boom finished.

Structural Steel:

- A. Structural steel shall be detailed and fabricated in accordance with the latest version of the AISC Manual of Steel Construction.  
B. All bolts, including anchor bolts, shall conform to ASTM spec. A307.  
C. Structural steel rolled shapes, including plates and angles, shall be ASTM A36.  
D. Expansion bolts called for on the drawings shall be Simpson "Weg-All", "Strong-Bolt 2" or approved wedge type anchors with the following minimum embedments: 3/4" diameter bolts - 3 3/8", 5/8" diameter bolts - 2 3/4", 1/2" diameter bolts - 2 1/4".  
E. All epoxy shall be Simpson "Set-XP" and shall be installed per the "Anchoring and Fastening Systems For Concrete and Masonry" Simpson catalog #C-SAS-2012 by a qualified personnel.  
F. Field welded connections must be inspected by the Engineer of Record.  
G. Fillet welds indicated on the plans shall be of E70xx electrodes and shall be the minimum size specified in the AISC Manual of Steel Construction, Table J2.4.  
H. All welds shall be performed by a certified welder.

Structural Wood Framing:


- A. Unless noted otherwise, all 2" lumber shall be Douglas Fir S4S No. 2 and better. All solid timber beams and posts shall be DF-L No. 1 or better.  
B. Unless noted otherwise, minimum nailing shall be provided as specified in Table No. 2304.9.1, "Fastening Schedule", of the 2009 IBC or Table No. R602.3(1), "Fastener Schedule For Structural Members", of the 2009 IRC.  
C. Wall and floor sheathing shall be APA rated with exterior glue and graded in accordance with APA standards. Panel identification and thickness shall be as noted on the drawings.  
D. Where light gauge framing anchors are shown or required, they shall be Simpson "Strong Tie" (or equal approved by ICBO). They shall be installed with the number and type of fasteners recommended by the manufacturer to develop the rated capacity.  
E. Laminated Veneer Lumber shall be of such stress grade to provide an allowable bending stress of 2,600 psi, allowable shear stress parallel to the glue line of 285 psi and a modulus of elasticity of 1,900,000 psi.  
F. Glue laminated timber shall be stress grade marked 24F-V4 for simple spans & 24F-V8 for multiple spans.  
G. Roof trusses shall be designed by a Colorado Registered Professional Engineer to support the full live load and dead loads of the roof, ceiling, and any other superimposed loads. Calculations and shop drawings, including member sizes, lumber species, and grade and substantiating data for connector capacities and truss bearing, shall be submitted to the Architect or Engineer for review and approval prior to fabrication.  
H. Floor joists shall be plant fabricated I series with LVL or solid wood flanges and plywood or OSB webs, and shall carry ICBO approval for a complete section. Joists shall be designed to carry full live and dead loads of the roof(s), floor(s), and any superimposed loads.  
I. Roof overframing shall be 2x6 rafters @ 24" O.C. w/ 2x6 studs @ 24" O.C. to stack over rafters or purlins below.

Field Verification:

- A. The contractor shall thoroughly inspect and survey the existing structure to verify dimensions, elevations, framing, etc., which may affect the work shown on the drawings and report any variations or discrepancies to the Engineer.

HELICAL PILE SCHEDULE		
PILE I.D.	MINIMUM LENGTH Feet	MINIMUM TORQUE Ft. - Lbs.
PILE I.D. (A)	7 Ft. w/ 2 Ft. Bedrock Penetration	3,000 Ft. -Lbs.
PILE I.D. (B)	7 Ft. w/ 3 Ft. Bedrock Penetration	4,000 Ft. -Lbs.
MINIMUM TORQUE INCLUDES F.S. = 2 FOR HELICAL PILES		
ALL PILES SHALL BE 'HELI-PILE' 1.5 INCH MODULAR HPC15 OR APPROVED EQUAL		

RCRBD  
RECORD SET

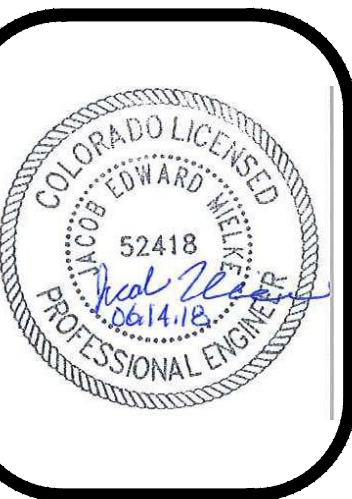

ICONIC ENTRY / ARNOLD BARN  
MOUNT WERNER CIRCLE  
STEAMBOAT SPRINGS, COLORADO  
FOUNDATION & SHORING FOR:  
MOUNTAIN ARCHITECTURE DESIGN GROUP, P.C.

ISSUE DATES



PRICING  
10 . 20 . 17  
PERMIT  
05 . 14 . 18

DRAWN BY:  
SJM/JEM  
PROJECT # 17057

FOUNDATION  
PLAN & SECTIONS

S - 1

SHEET 1 of 2

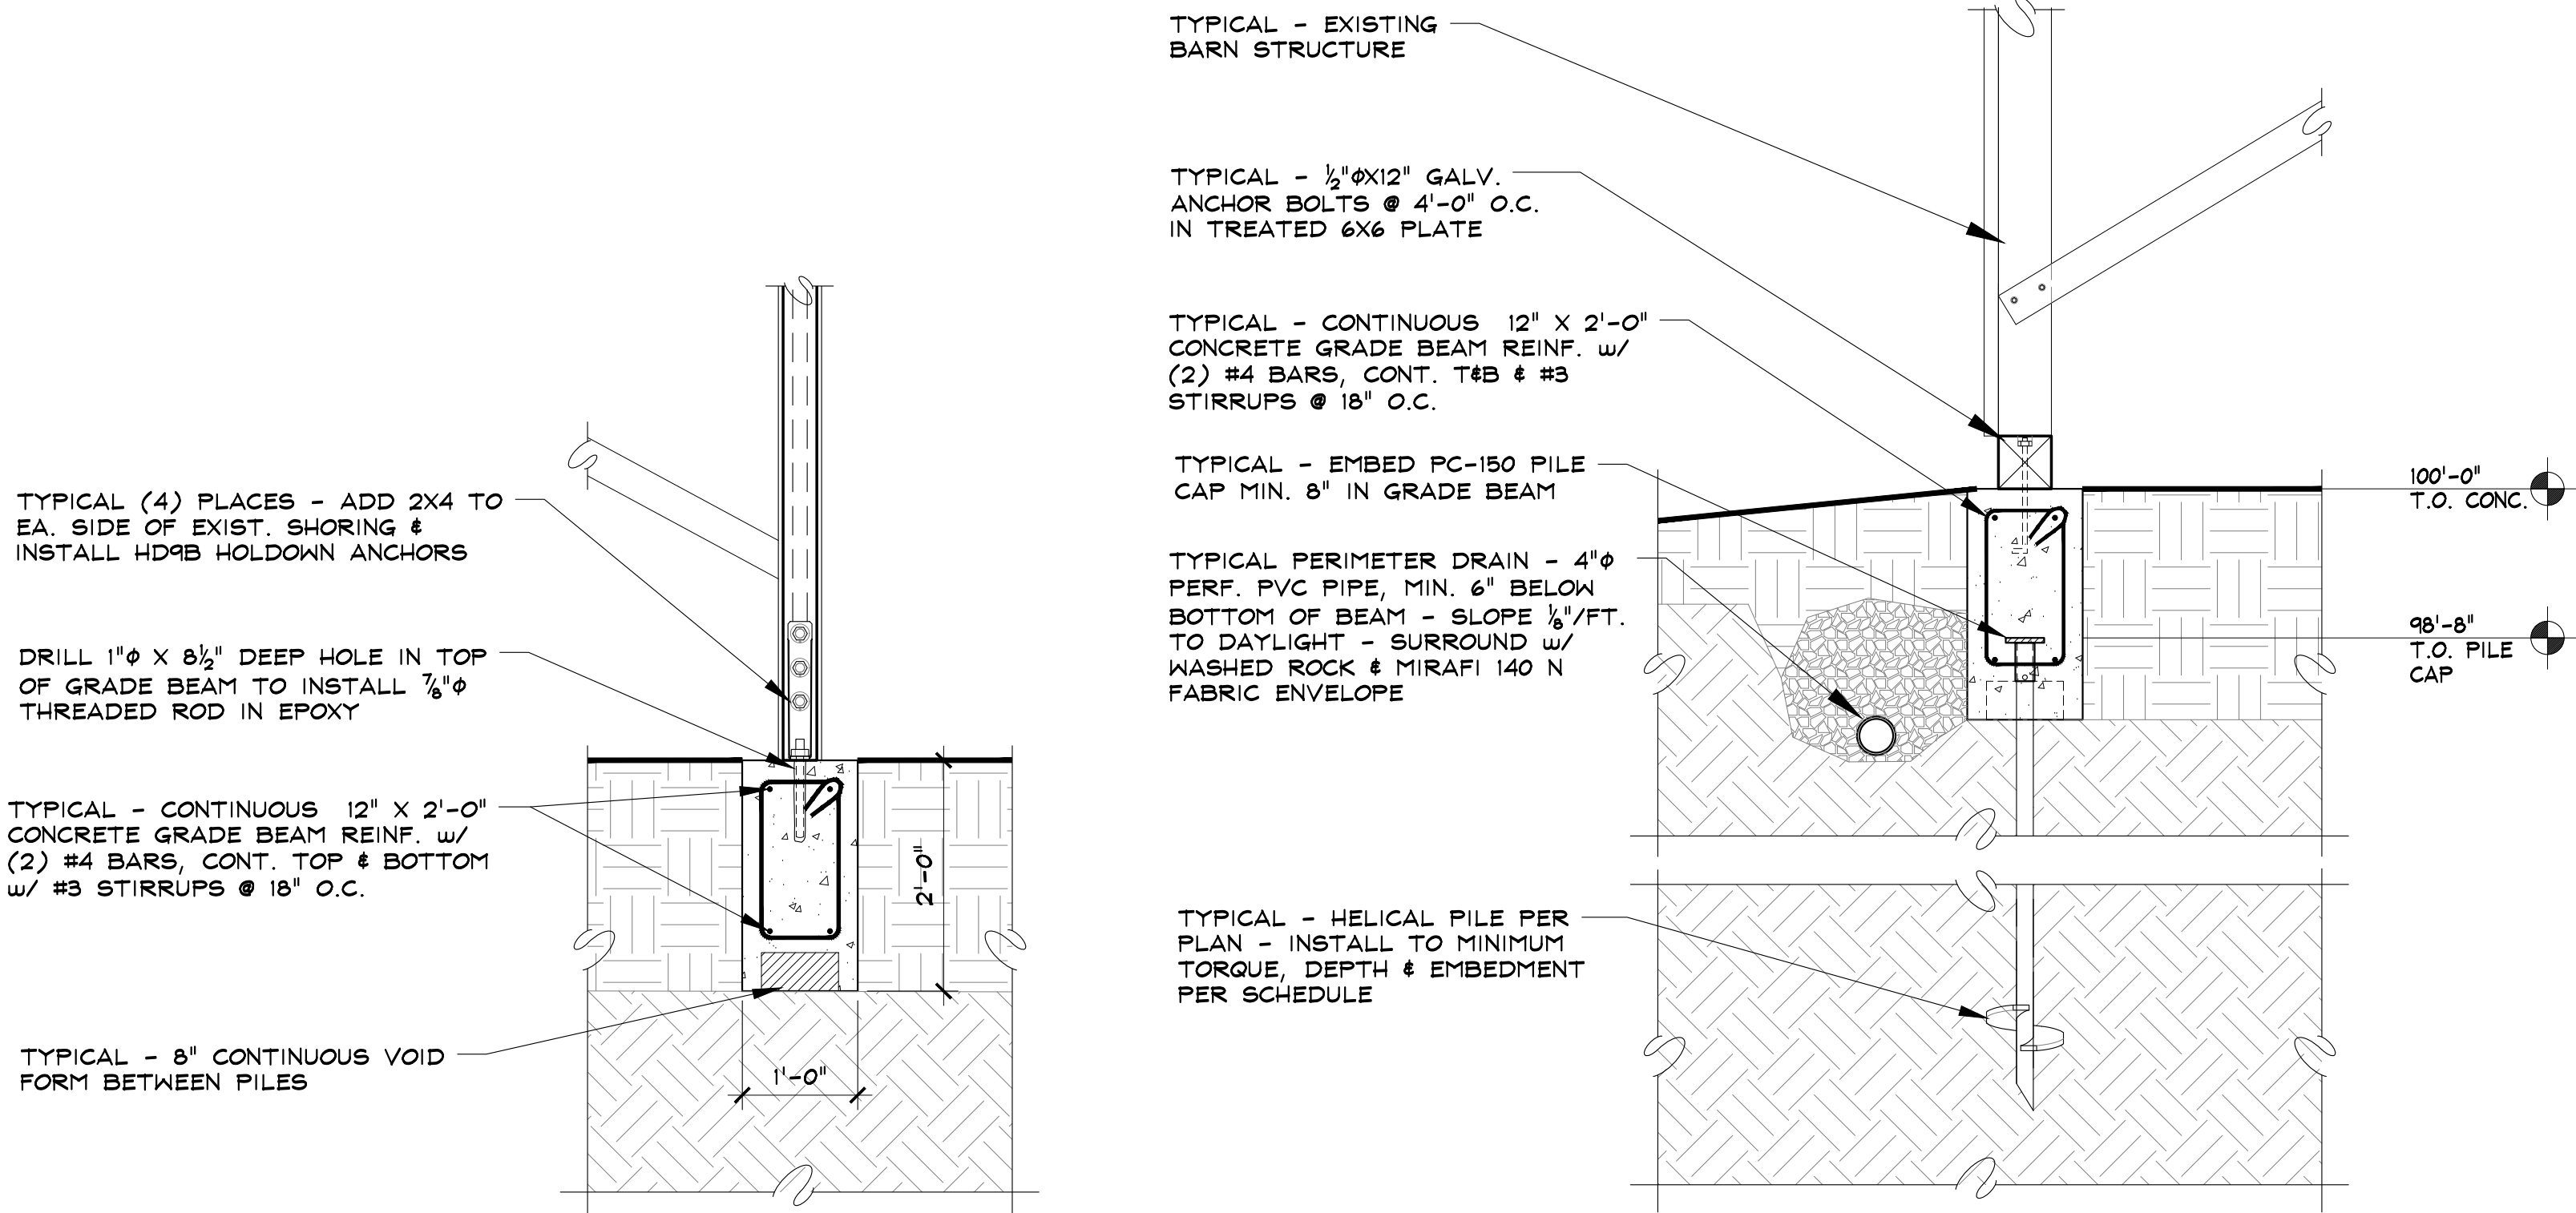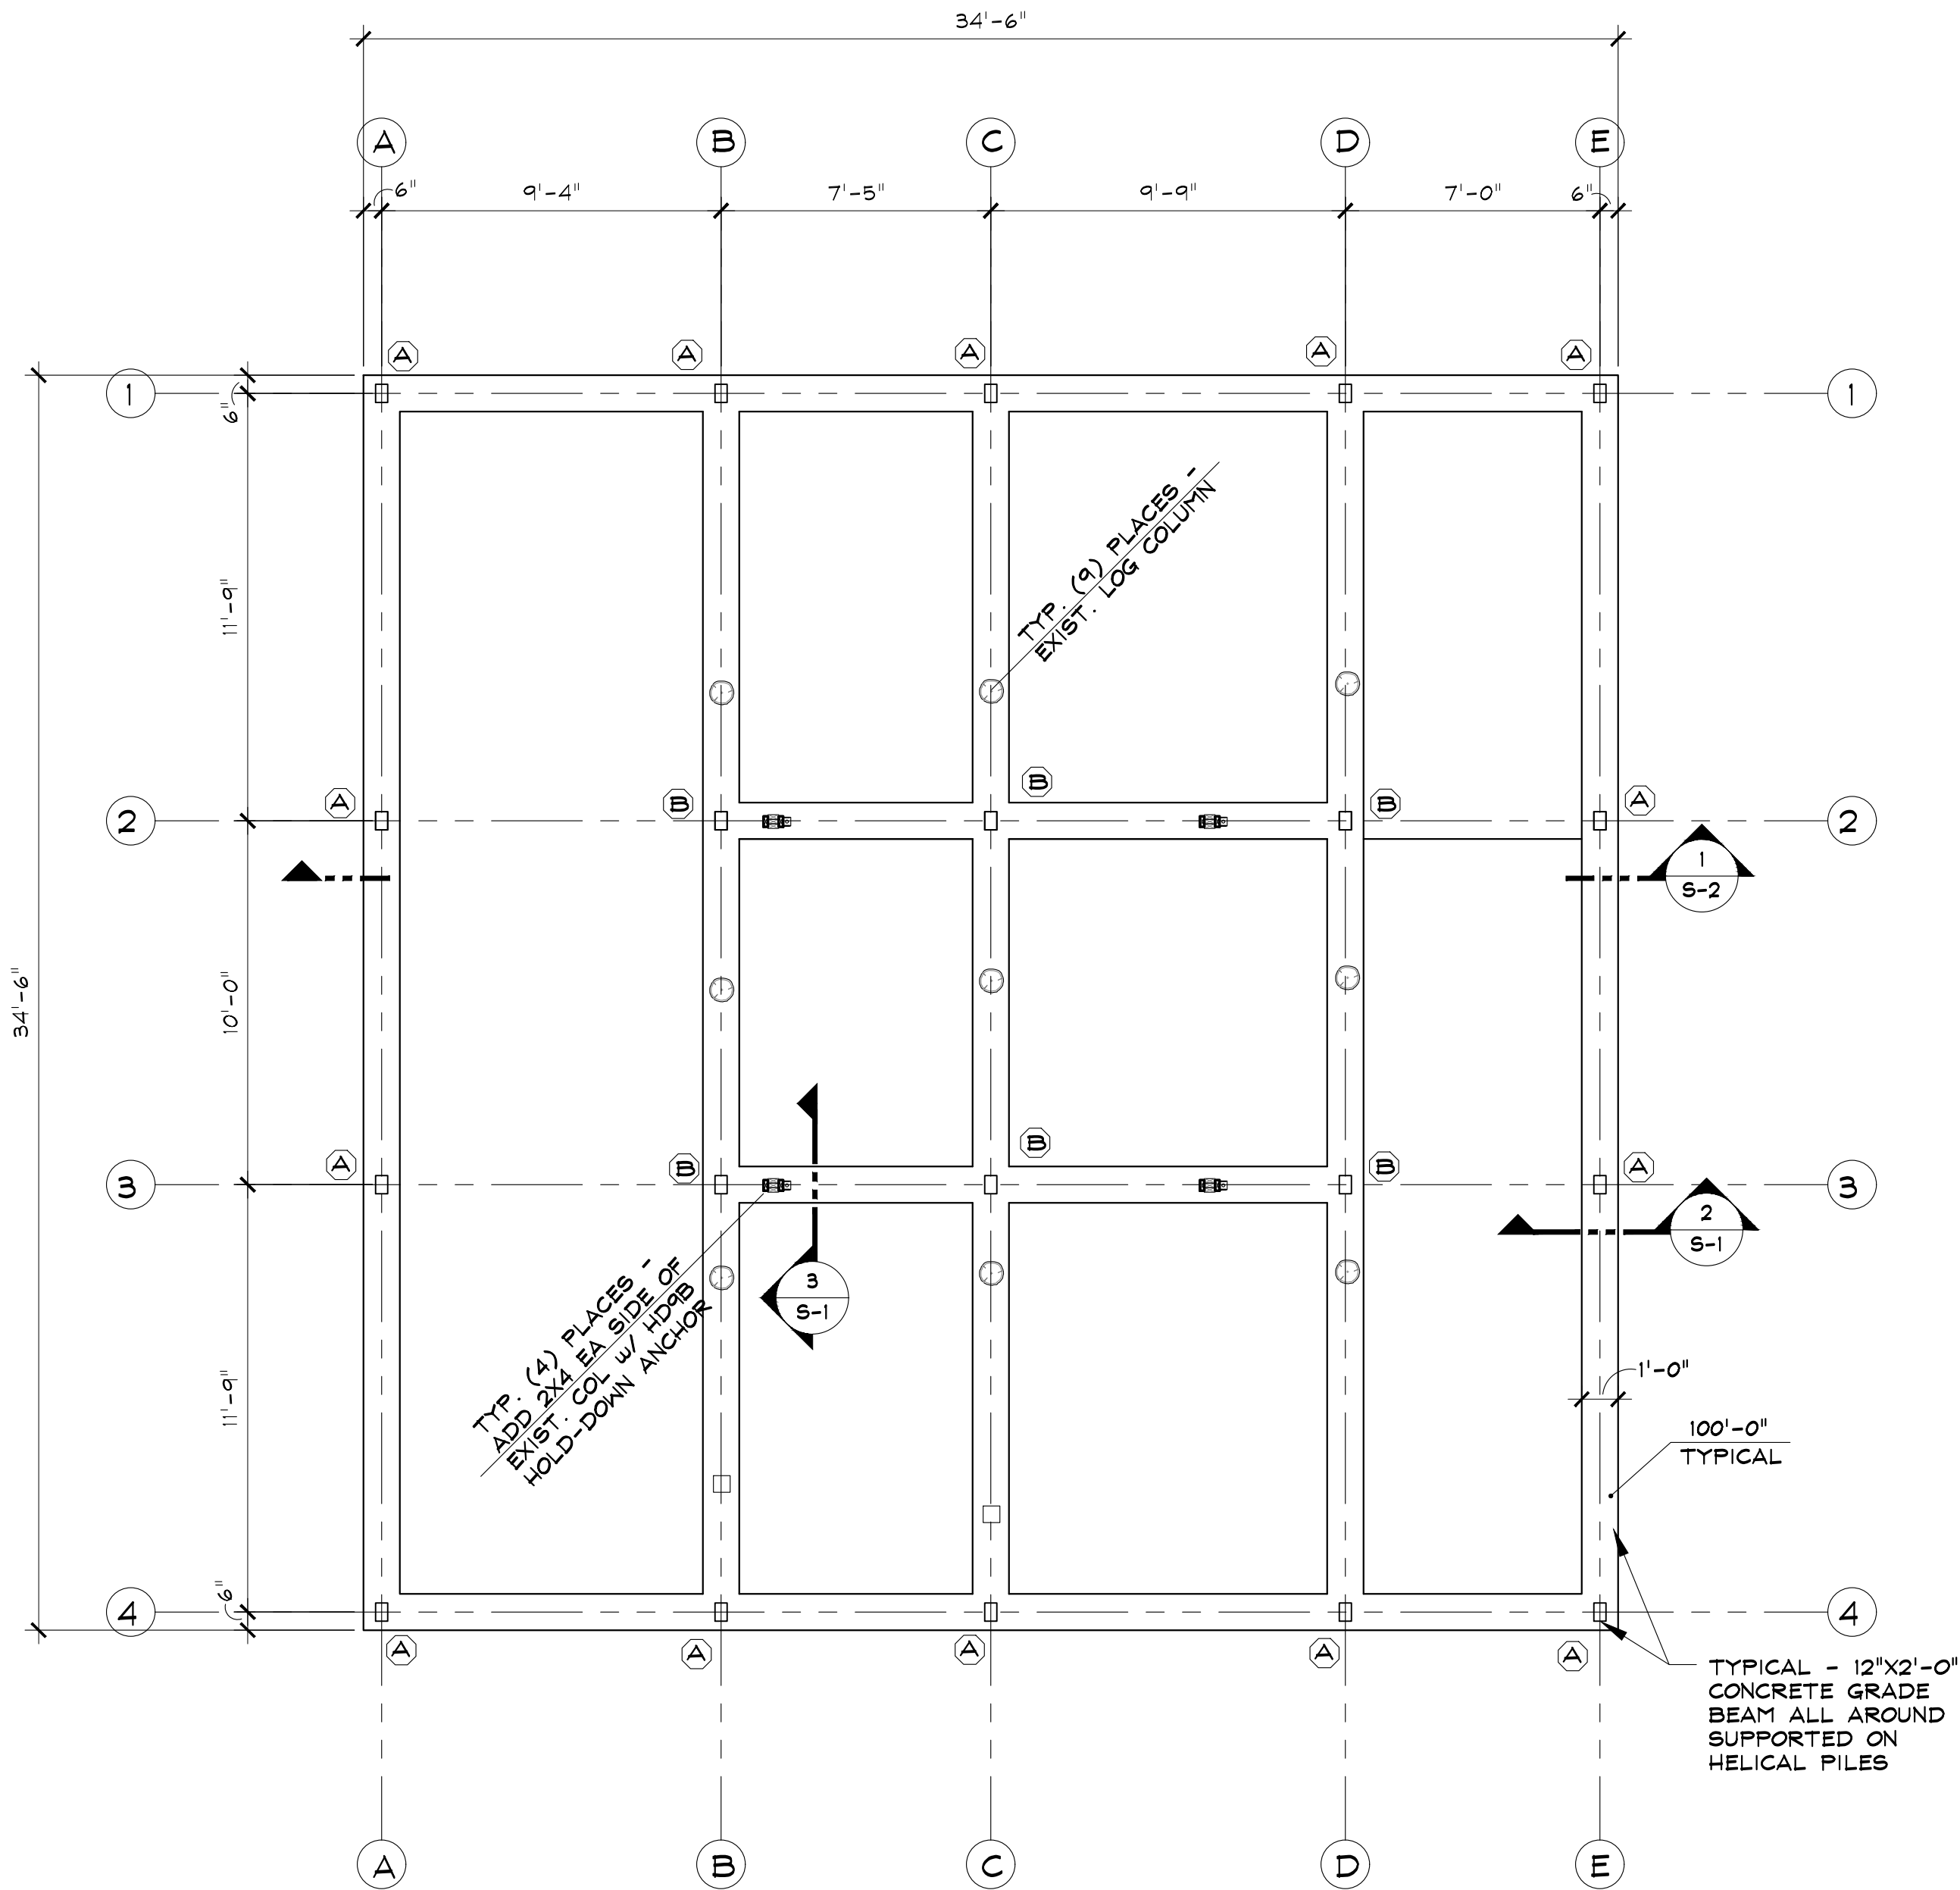

3 FOUNDATION SECTION


SCALE: 3/4" = 1'-0"

2 TYPICAL PERIMETER SECTION

SCALE: 3/4" = 1'-0"

1 FOUNDATION PLAN

NOTE: DIMENSIONS ARE TO CENTERLINES OF HELICAL PILES AND CONCRETE GRADE BEAMS

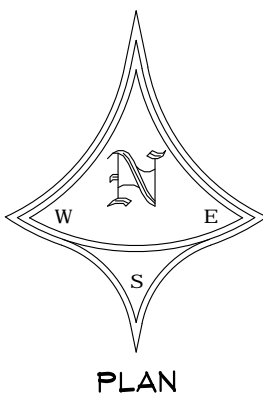

SCALE: 1/4" = 1'-0"





ICONIC ENTRY / ARNOLD BARN  
MOUNT WERNER CIRCLE  
STEAMBOAT SPRINGS, COLORADO  
FOUNDATION & SHORING FOR:  
MOUNTAIN ARCHITECTURE DESIGN GROUP, P.C.


ISSUE DATES  
PRICING  
10 . 20 . 17  
PERMIT  
05 . 14 . 18

DRAWN BY:  
SJM/JEM  
PROJECT # 17057

BUILDING  
SECTION

S - 2

SHEET 2 of 2

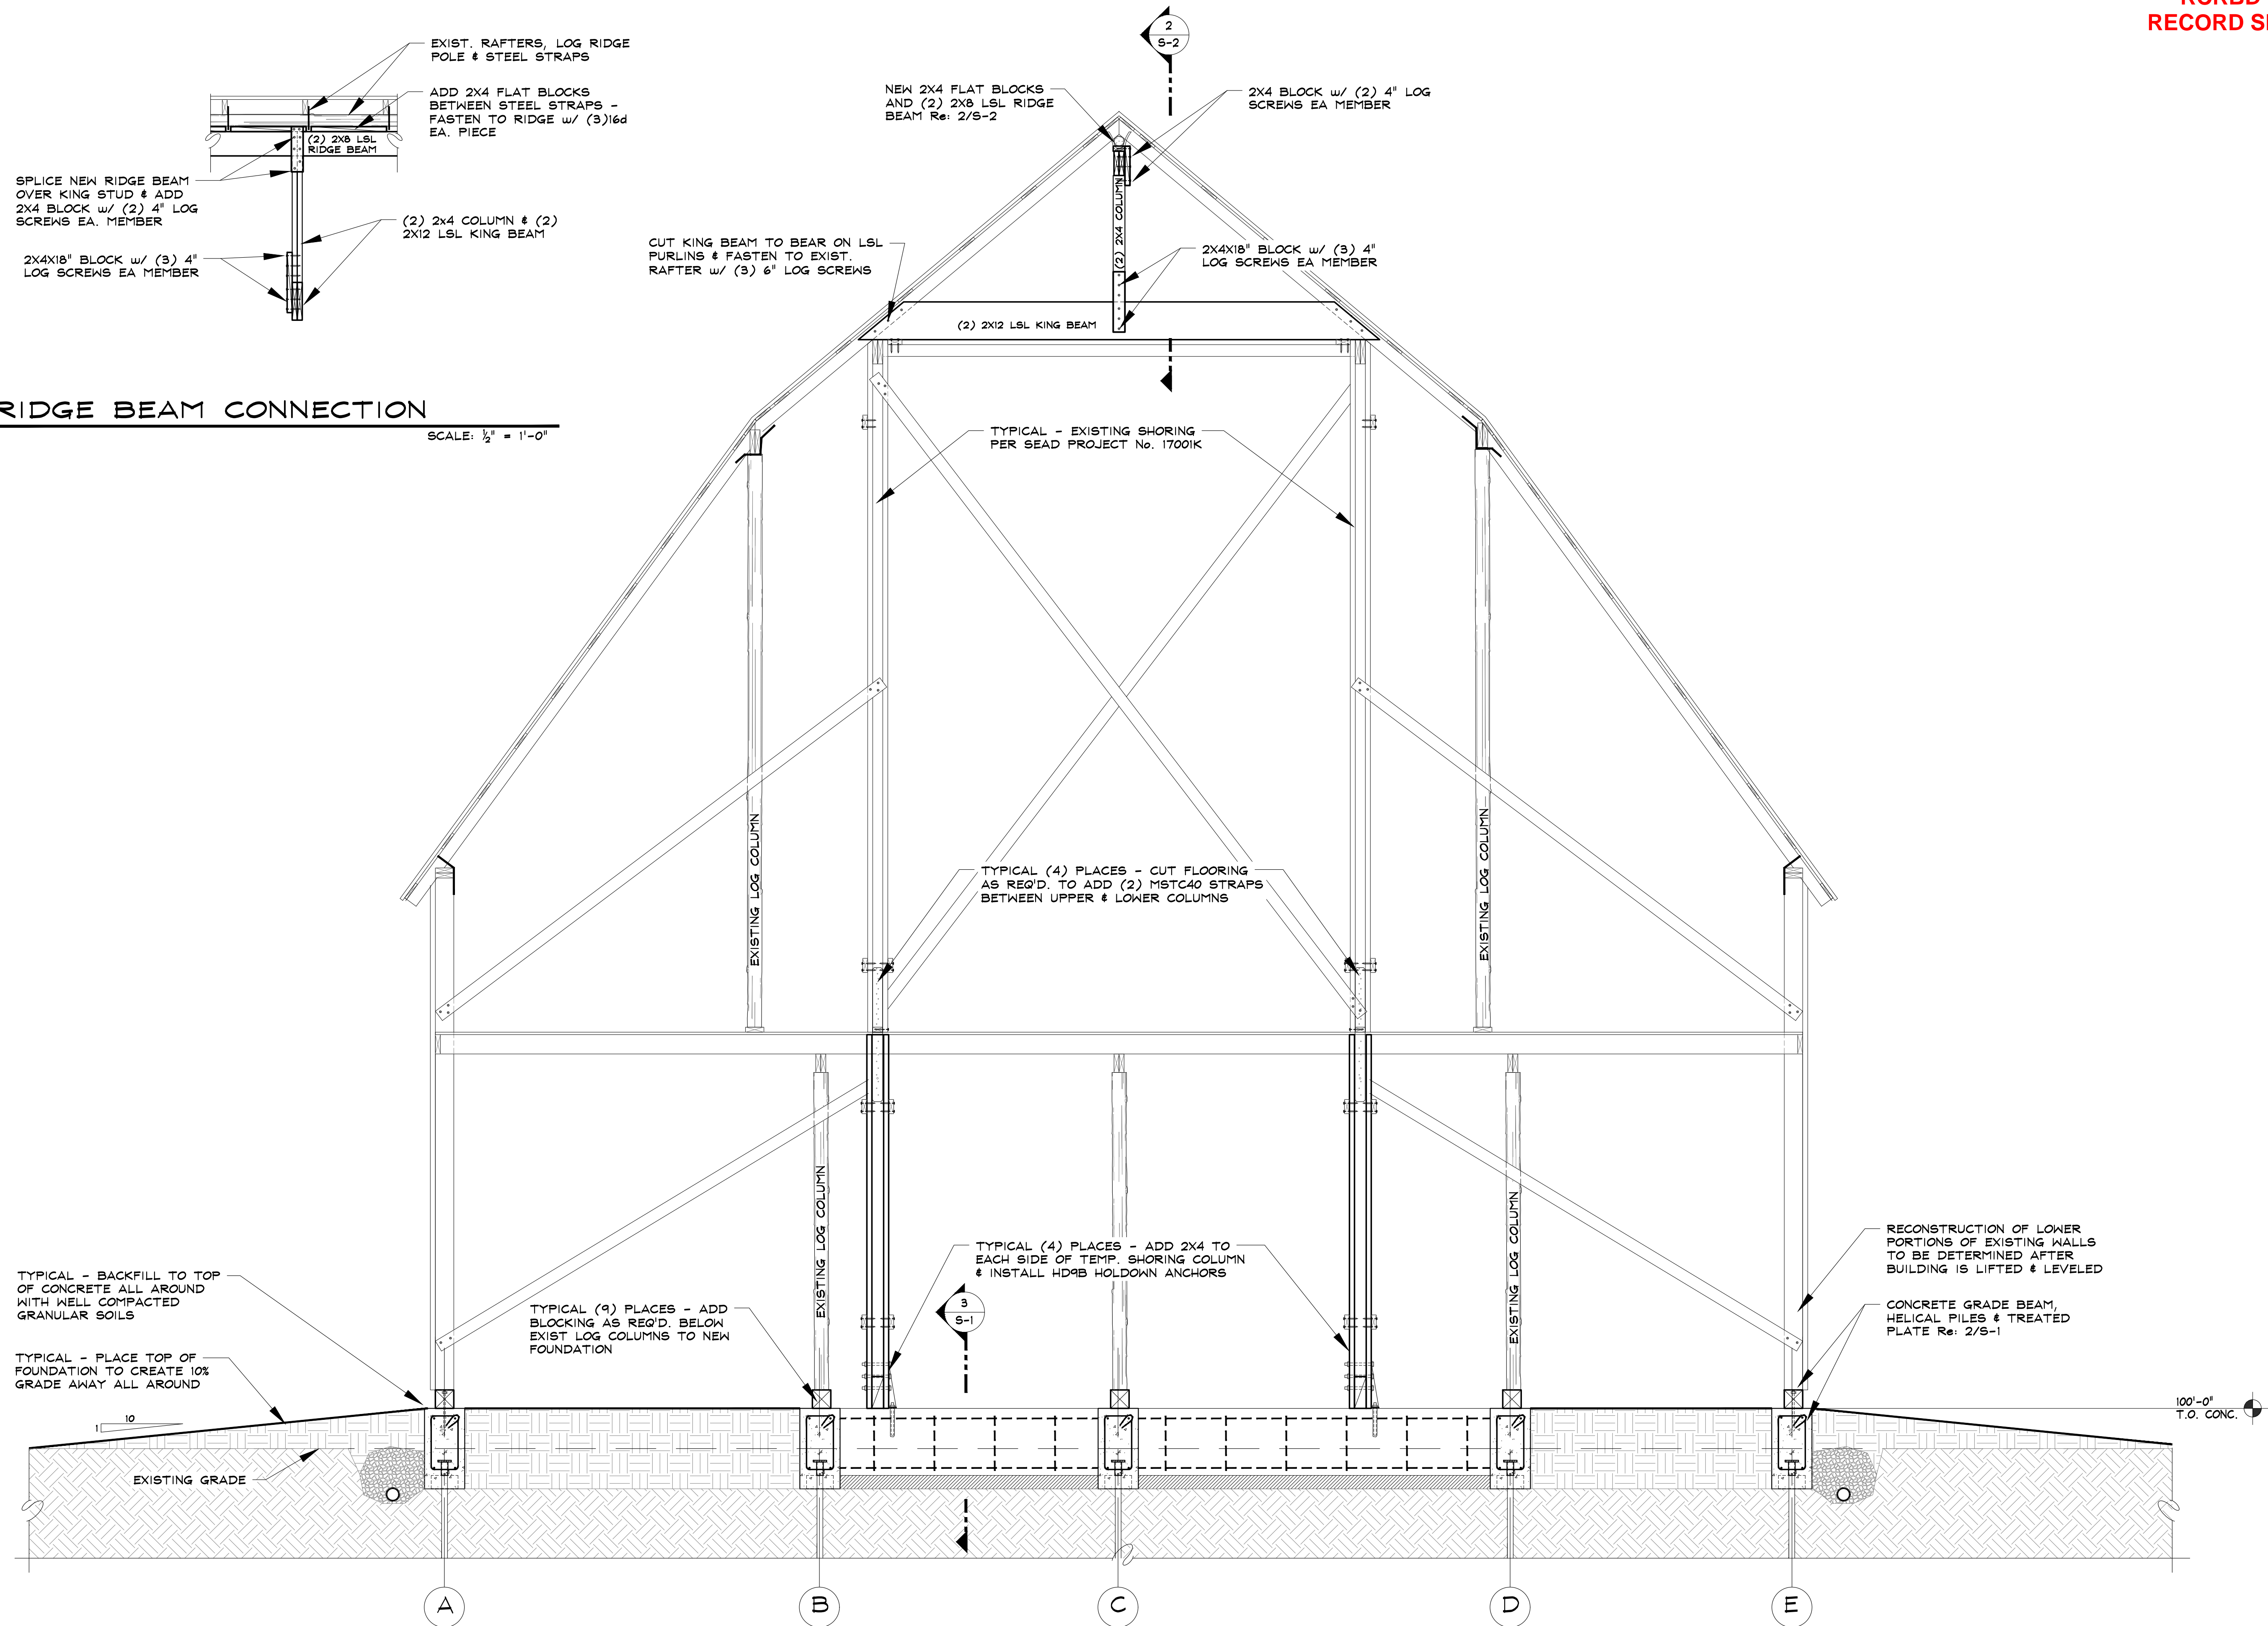

2 RIDGE BEAM CONNECTION  
SCALE: 1/2" = 1'-0"

1 TRANSVERSE BUILDING SECTION AT COLUMN LINES 2 & 3  
Re: 1/S-1



SCALE: 1/2" = 1'-0"



**SKETCH: SK-001**  
**PROJECT: ARNOLD BARN**  
**DATE: 11/13/2017**  
**SCALE: N.T.S.**  
**DRAWING BY: BJW**

# RCRBD RECORD SET

10 ft. tall pole with two (2)  
 Type SA fixtures attached to  
 each pole. Typical of four (4)  
 poles.

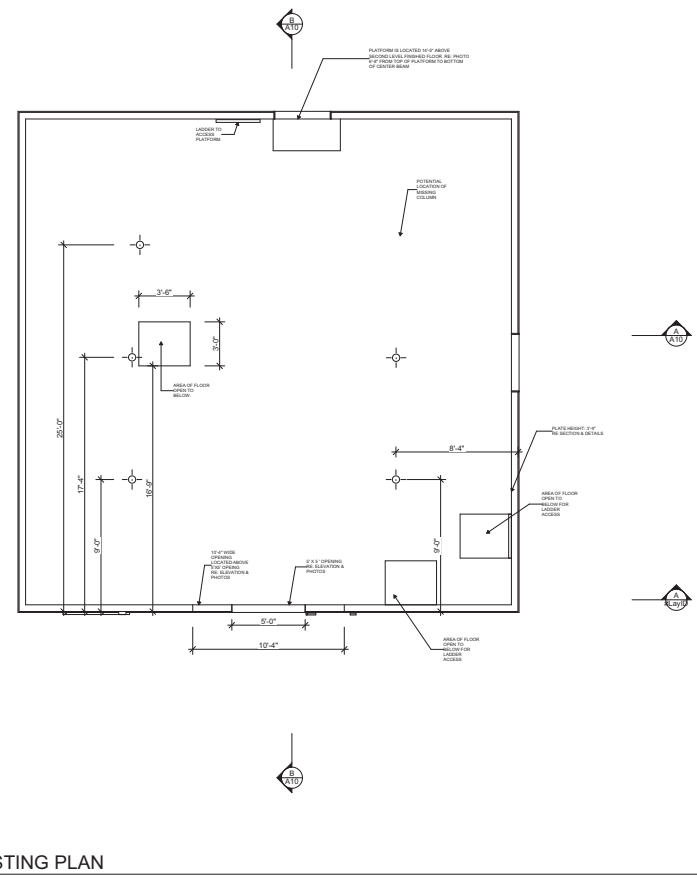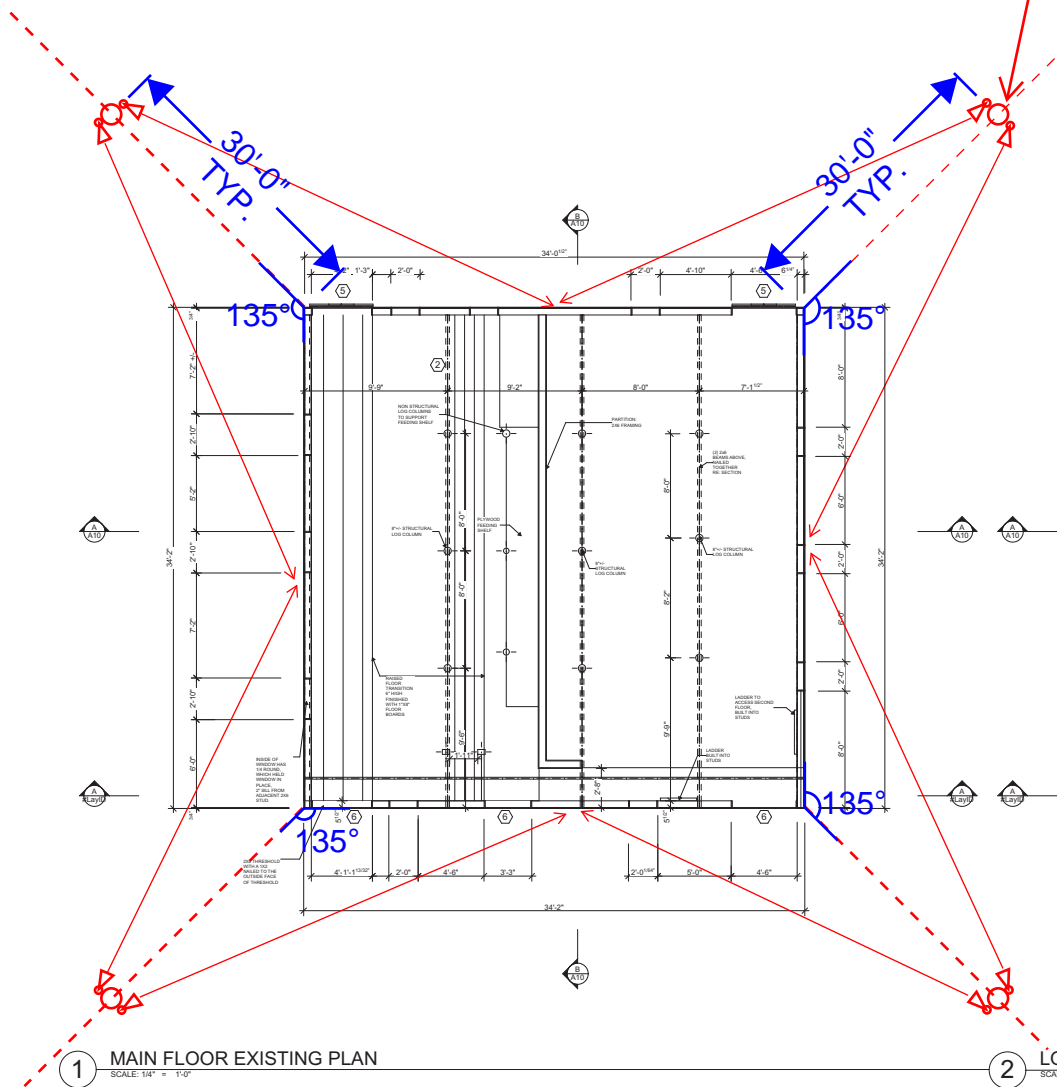

AN ICONIC ENTRY FOR THE  
**ARNOLD BARN INTERPRETIVE DISPLAY**  
 2305 MT. WERNER CR.  
 STEAMBOAT SPRINGS, CO. 80467-9023

TITLE  
**LIGHTING PLAN**

JOB NO. PROJECT NUMBER  
 DRAWN BY LJR  
 CHECKED BY JMK  
 ISSUE DATE 9/12/2017

REVISIONS:  
 DATE



DRAWING NUMBER  
**LP 1**



SKETCH: **SK-001**  
PROJECT: **ARNOLD BARN**  
DATE: 11/13/2017  
SCALE: **N.T.S.**  
DRAWING BY: **BJW**


**RCRBD  
RECORD SET**

10 ft. tall pole with two (2)  
Type SA fixtures attached to  
each pole. Typical of four (4)  
poles.

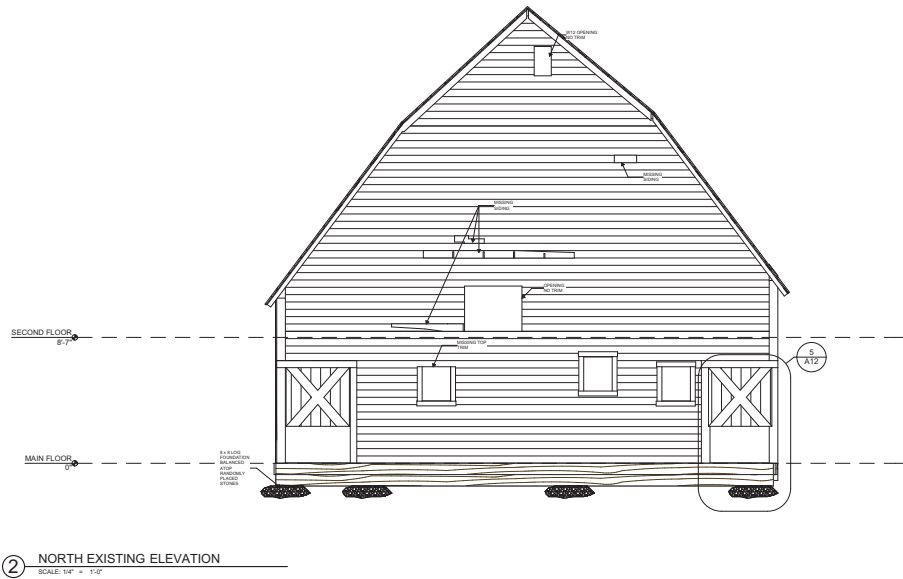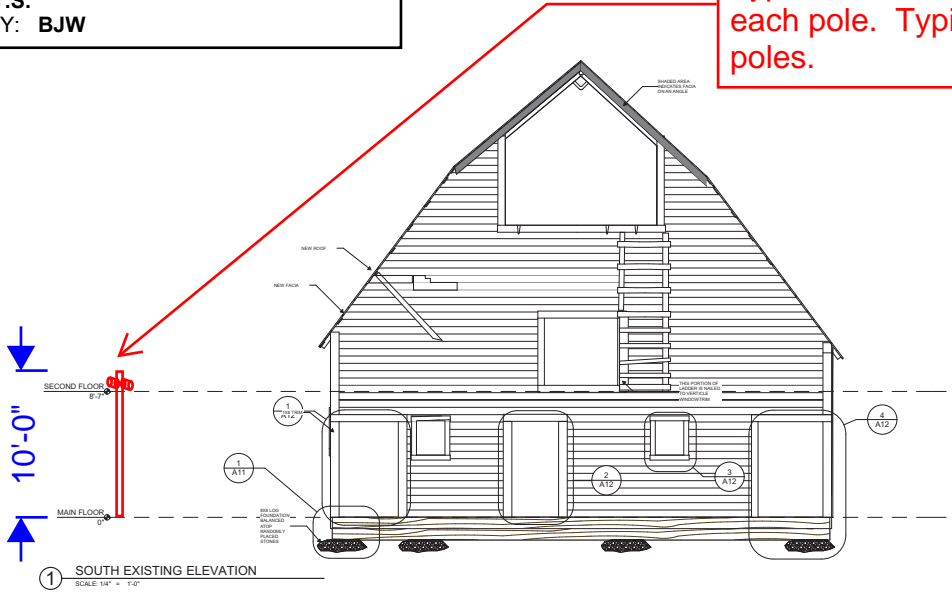



O:\C020169 Iconic Entry\Drawings\C020169 BARN ROUTE.dwg, 7/3/2018 3:43:37 PM, Chris Rundall

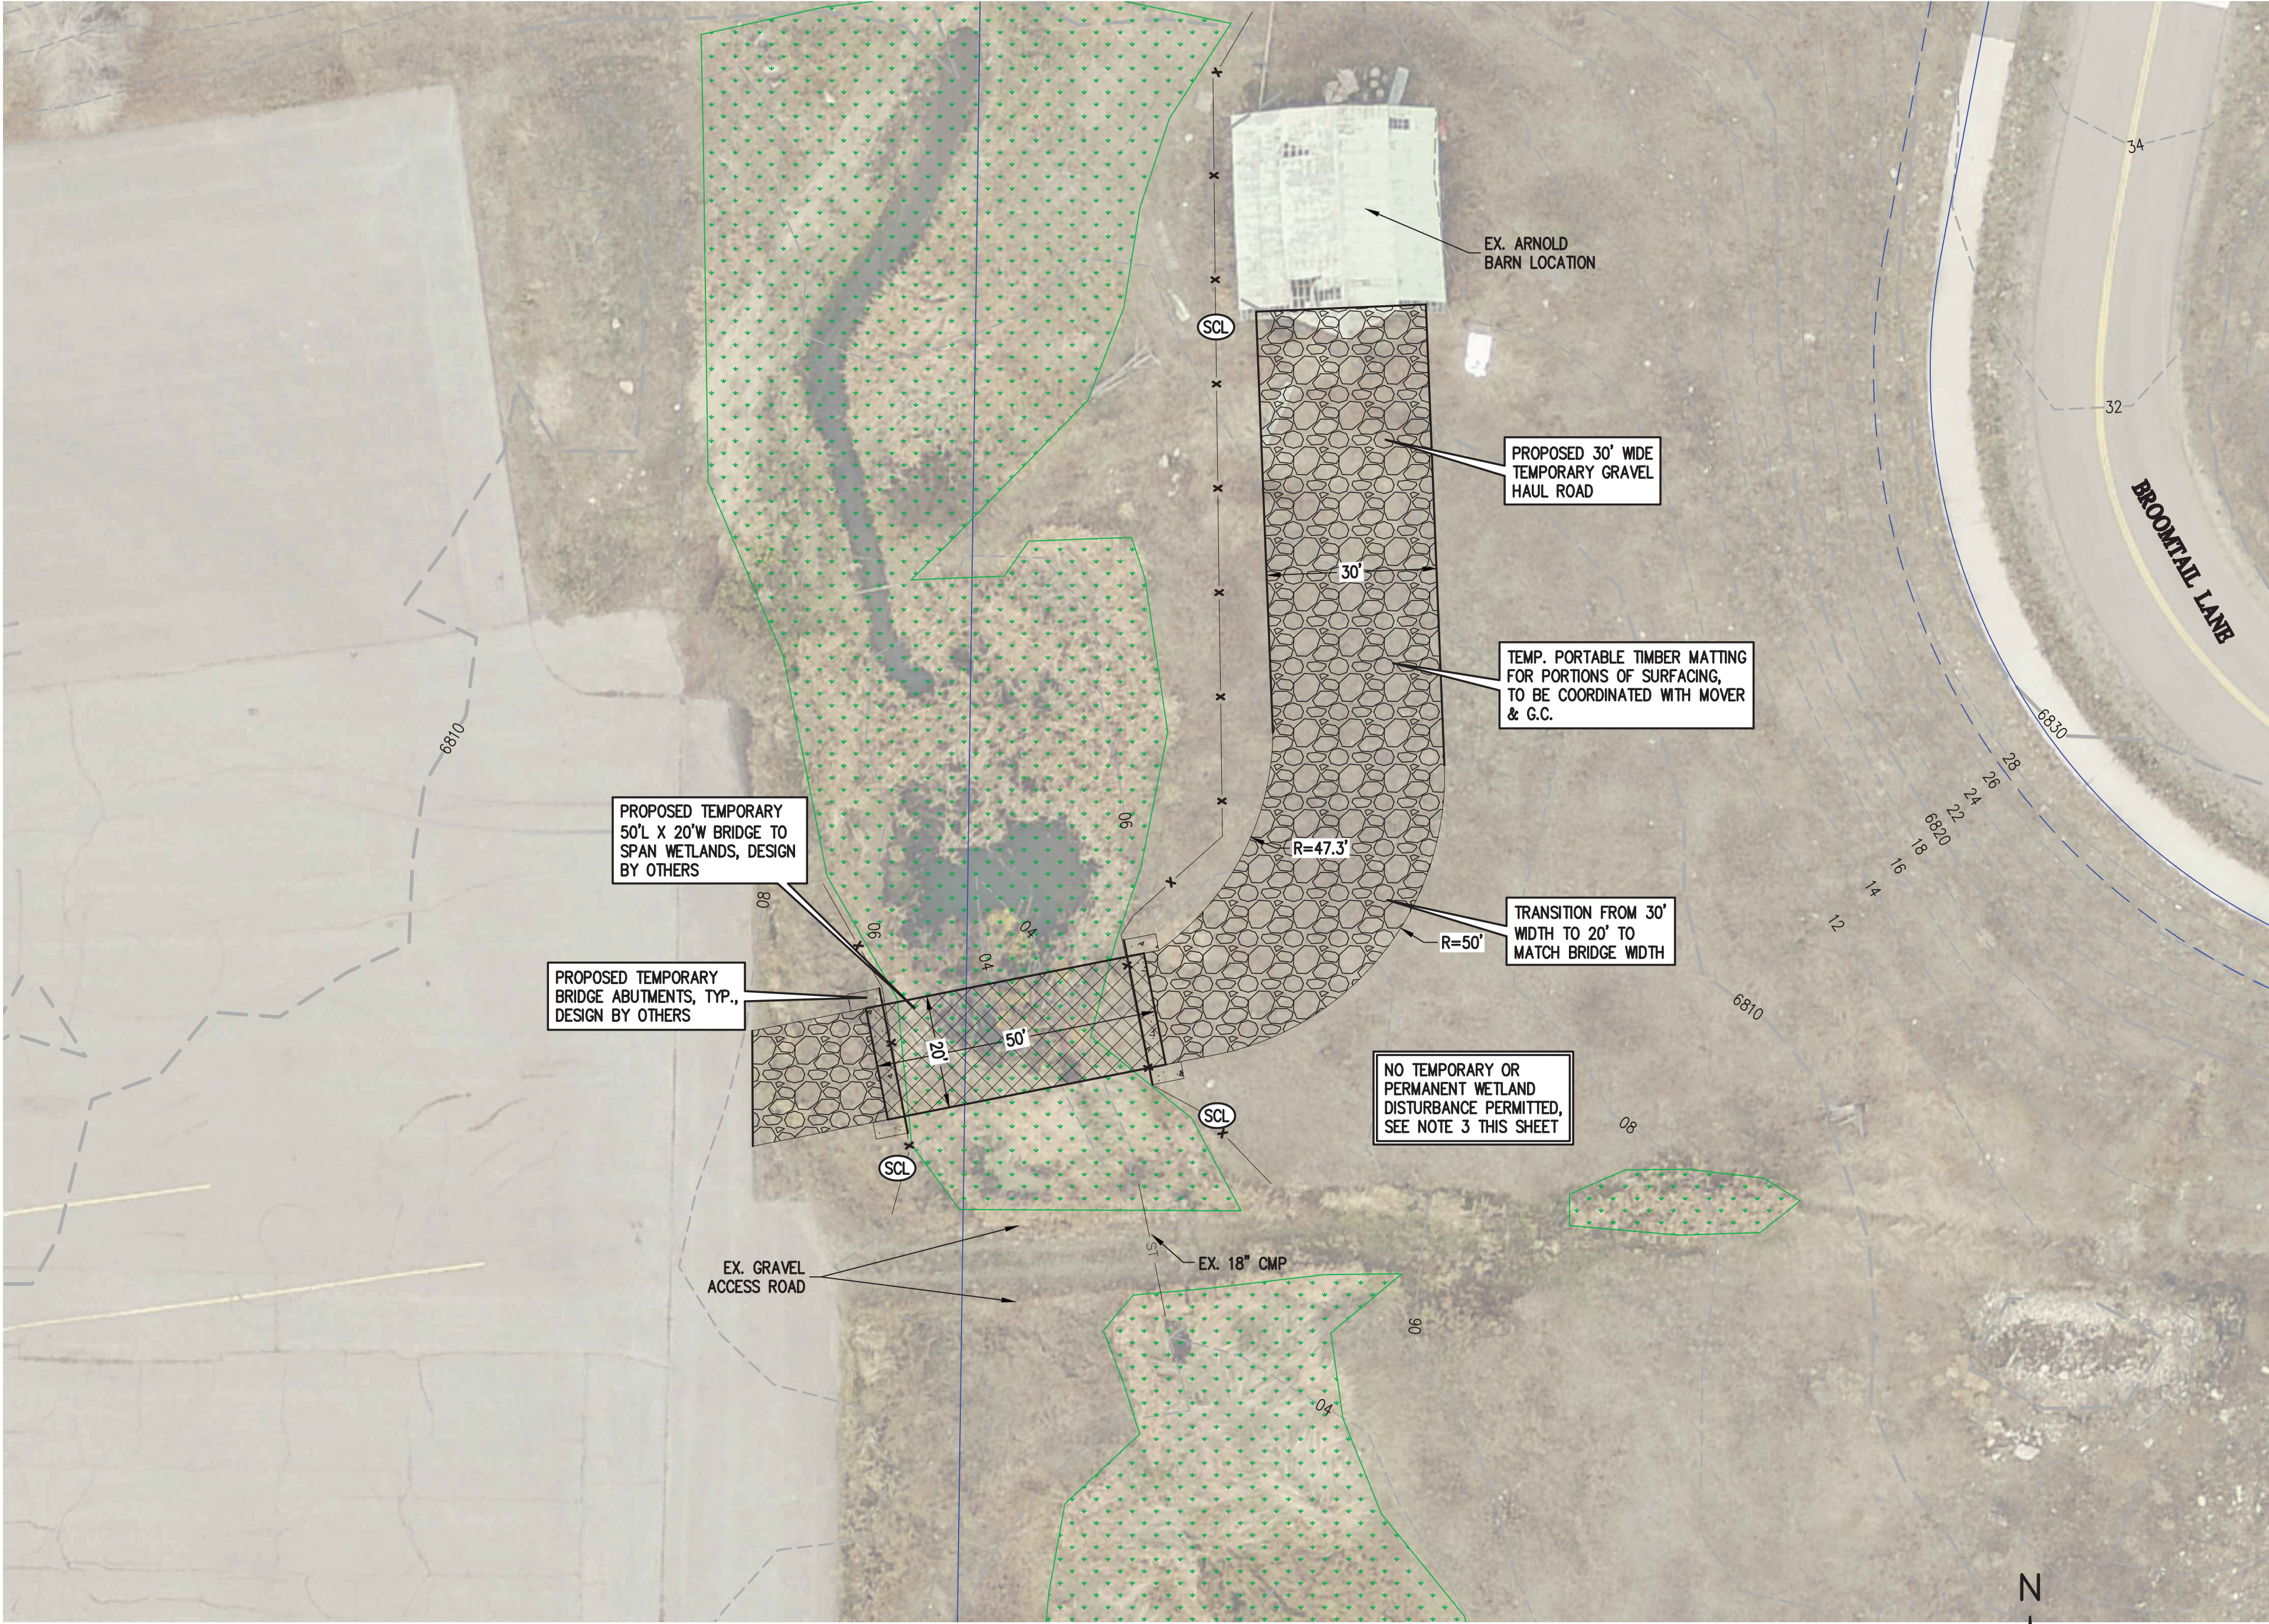




Description of Work:

- Relocation of the Arnold Barn from its existing location shown on this drawing (sheet C1 dated 6/7/18), to its new proposed location shown on Sheet C4 dated 5/3/18.
- Relocation to be performed by Bailey House Movers.
- Structure will be moved in single piece, in two stages: Stage I - From existing location to Meadows Parking Lot via haul road detailed on this sheet. Stage II - From Meadows Parking Lot to new proposed location at Mt. Werner Road & Mt. Werner Circle intersection per sheet C4.

Phasing:

- The Iconic Entry located at the new proposed location shown on sheet C4, is being proposed in two phases per the phasing designated in the civil drawings.
- Phase I - Relocation of the barn including grading/drainage and landscape improvements.
- Phase II - Addition of interpretive trails, sidewalk from Steamboat Grand, storm sewer improvements, water quality feature, and associated crosswalks & parking at Mt Werner Circle.

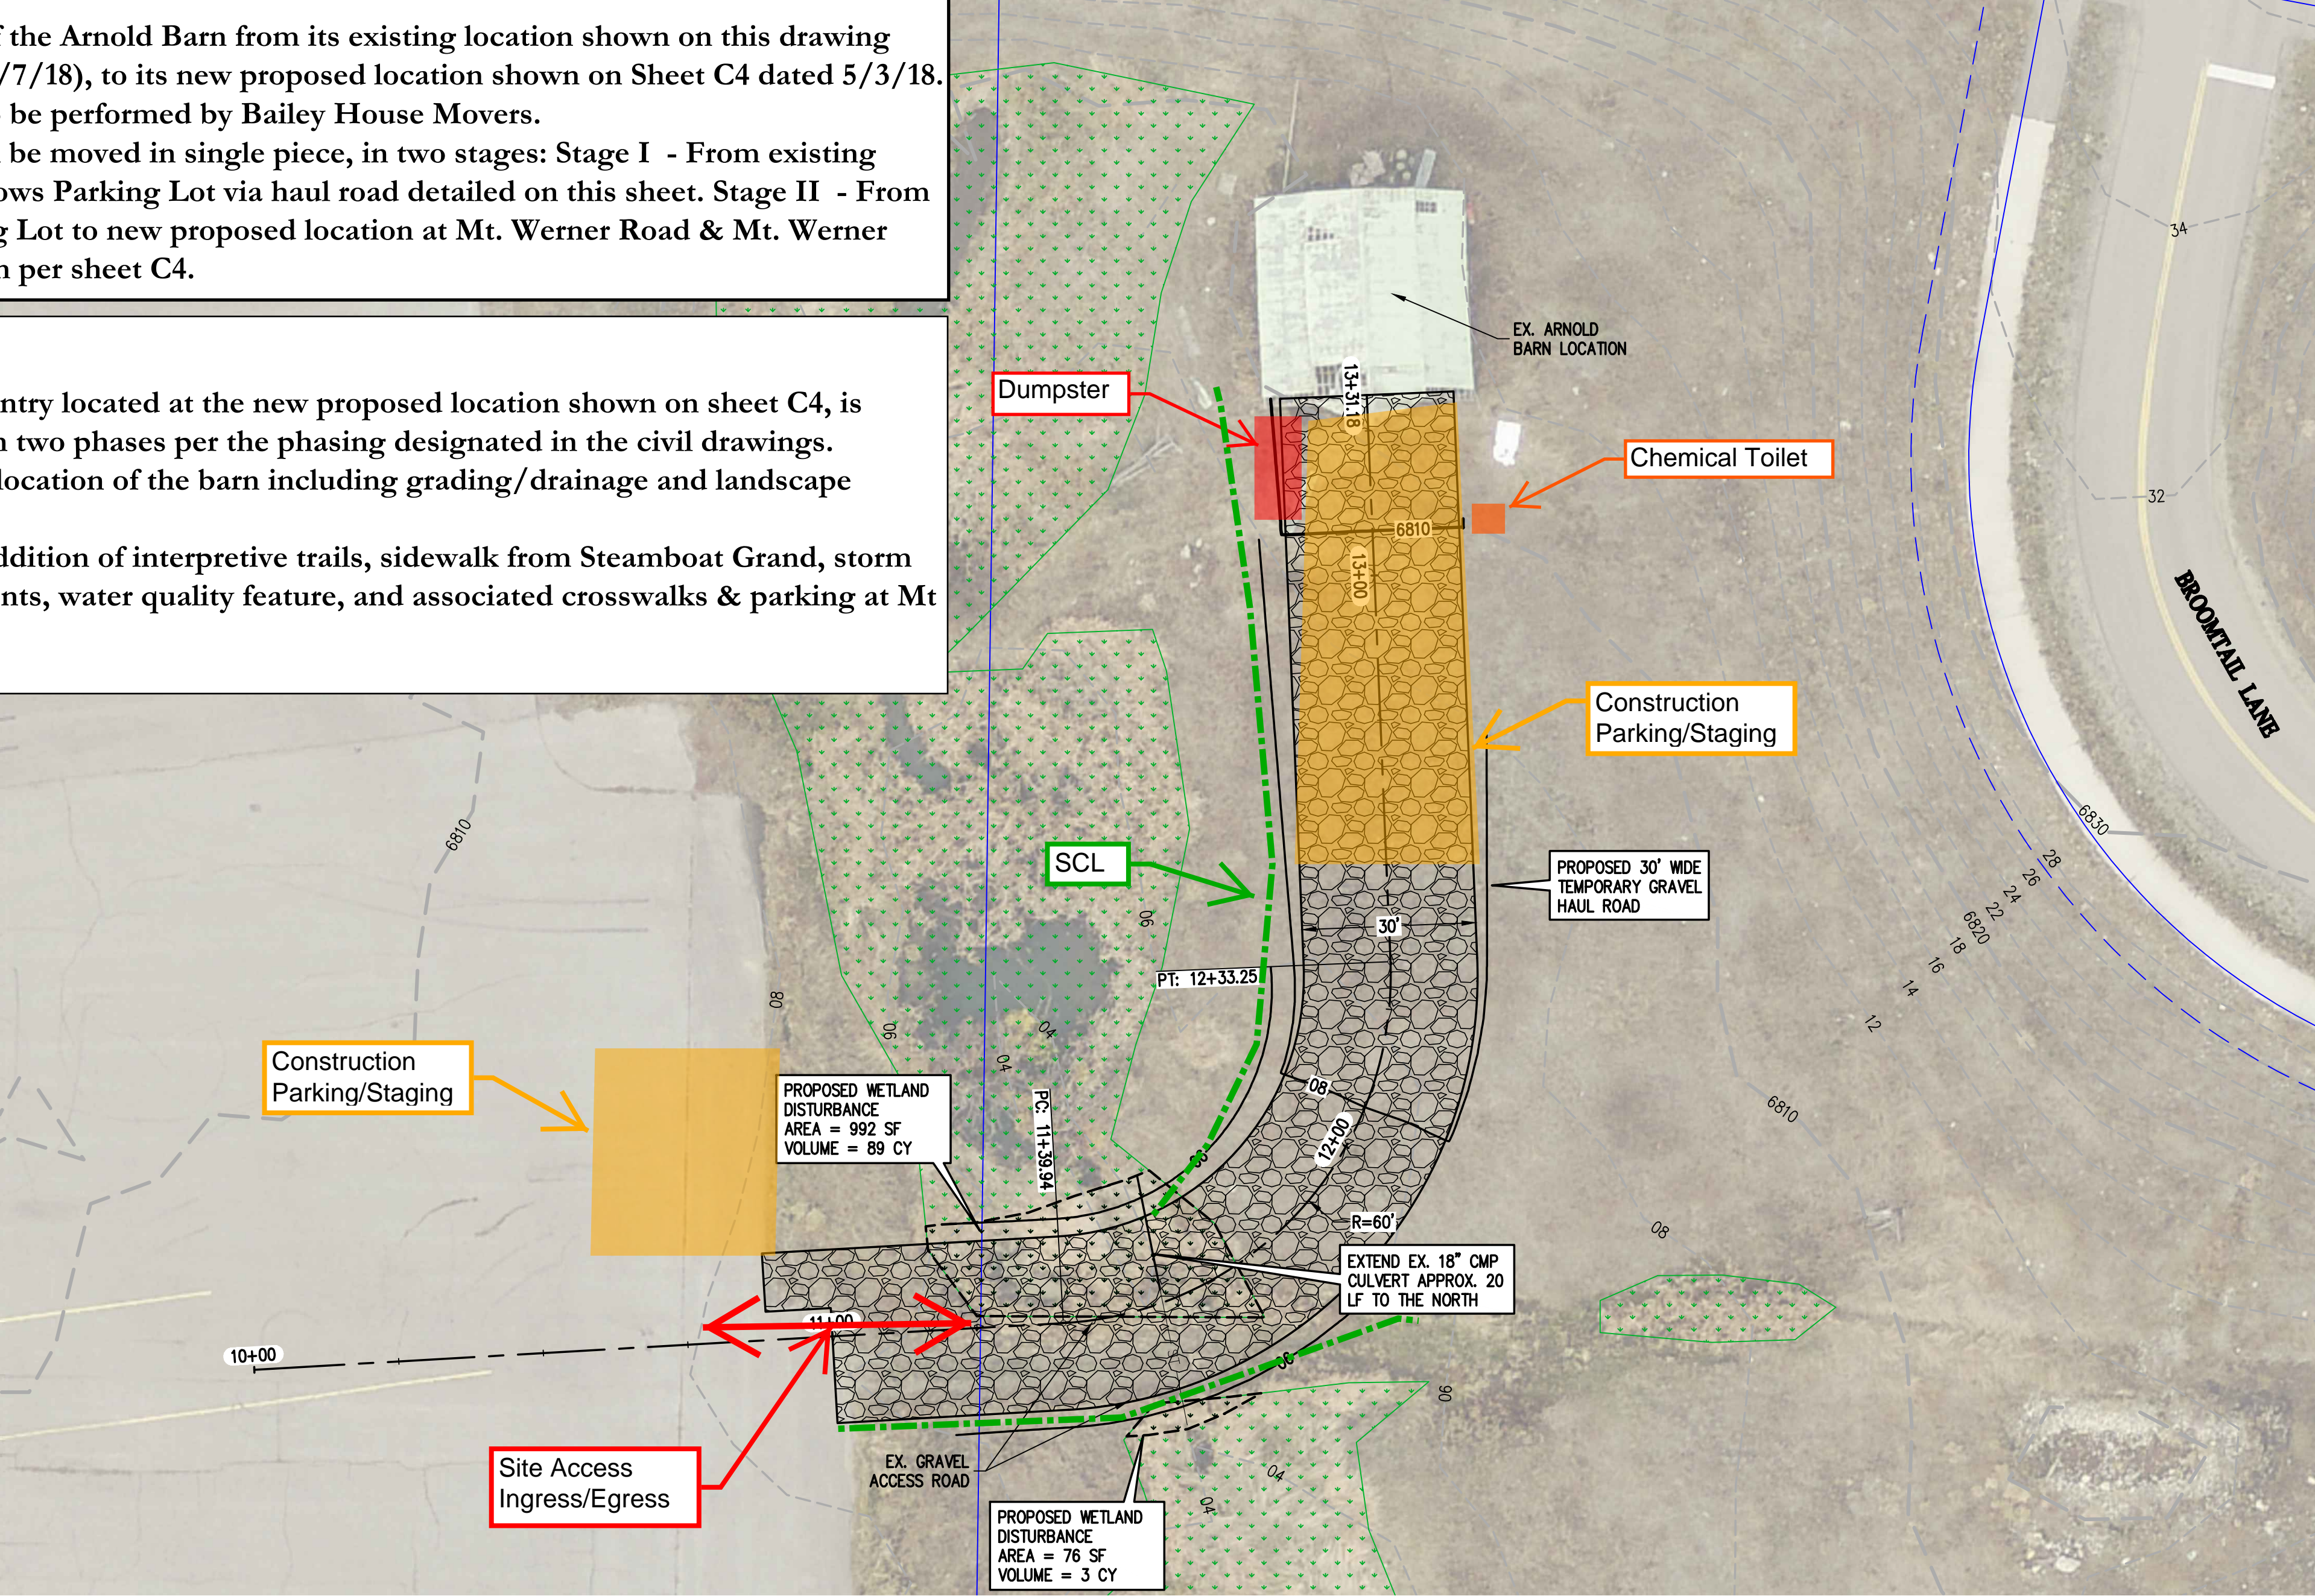


LEGEND


EXISTING LINETYPES	PROPOSED LINETYPES	
81	81	MINOR CONTOUR (1' INTERVAL)
5280	5280	MAJOR CONTOUR (5' INTERVAL)

EXISTING SYMBOLS

PROPOSED SYMBOLS

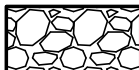

GRAVEL PAVING

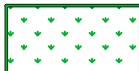

EXISTING WETLANDS



TEMPORARY WETLANDS IMPACT AREA



NOTES:

1. EXISTING CONDITIONS SHOWN ARE A COMPILATION OF CITY OF STEAMBOAT SPRINGS GIS INFORMATION AND FIELD SURVEY DATA. THE FIELD SURVEY INCLUDES WETLANDS DELINEATION FLAGGING AND PROPERTY/RIGHT-OF-WAY LINEWORK.
2. ELEVATIONS AND SURFACE FEATURES ARE APPROXIMATE IN NATURE AND SHOWN TO DEPICT INTENT OF TEMPORARY HAUL ROAD. CONTRACTOR TO COORDINATE WITH OWNER'S REPRESENTATIVE ON EXACT LAYOUT AND ELEVATIONS OF PROPOSED HAUL ROAD IN THE FIELD.
3. ALL TEMPORARY WETLANDS IMPACTS ARE TO BE CONFINED TO THE LIMITS SHOWN ON THIS PLAN. WETLANDS SOILS AREA TO BE REMOVED AND STOCKPILED ON SITE TO BE RE-USED AT THE TIME OF HAUL ROAD RECLAMATION. A SOIL SEPARATION FABRIC AND STABILIZATION FABRIC ARE TO BE PLACED AND THEN FILLS/GRAVELS PLACED IN COMPACTED LIFTS.
4. TEMPORARY CULVERT EXTENSION, FILLS/GRAVELS, AND FABRICS ARE TO BE REMOVED UPON COMPLETION OF BARN RELOCATION. WETLANDS ARE TO BE RESTORED UNDER THE DIRECTION OF ENVIRONMENTAL CONSULTANT.

Construction Site Management Plan  
Phase One

Standard Notes for Construction Site Management Plans:

1. This plan shall be kept on site at all times and updated to reflect any changes.
2. Concrete waste and washout water from mixing trucks shall be contained on site, removed from the site, and properly disposed. Materials should not enter state waters.
3. Contractor is responsible for installing and maintaining temporary erosion and sediment control during construction and establishing any required permanent Best Management Practices (BMPs).
4. Contractor is responsible for complying with all local, state, and federal laws. In addition contractor must obtain required permits.
5. Clearing or grading shall not begin until all sediment control devices have been installed.
6. The contractor shall promptly remove all sediment, mud, and construction debris that may accumulate in the right of way, private property, or water ways as a result of the construction activities.
7. All ingress, egress points and vehicle access points onto disturbed site must be stabilized with a vehicle tracking control pad. Access shall only be via approved locations as shown on approved CSMP.
8. Soil stabilization measures shall be in place and areas are to be revegetated:(1) for stockpiles, if inactive for more than 30 days (2) for areas of land disturbance within one growing season.
9. Inlet protection shall be installed in conjunction with storm drain inlets where drainage area is not vegetated.
10. BMPs shall be used, modified, and maintained whenever necessary to reflect current conditions. BMPs shall be inspected weekly and after every precipitation event. Accumulated sediment shall be removed from BMPs when the sediment level reaches ½ the height of the bmp.
11. Emergency access must be kept obstacle free and passable at all times.

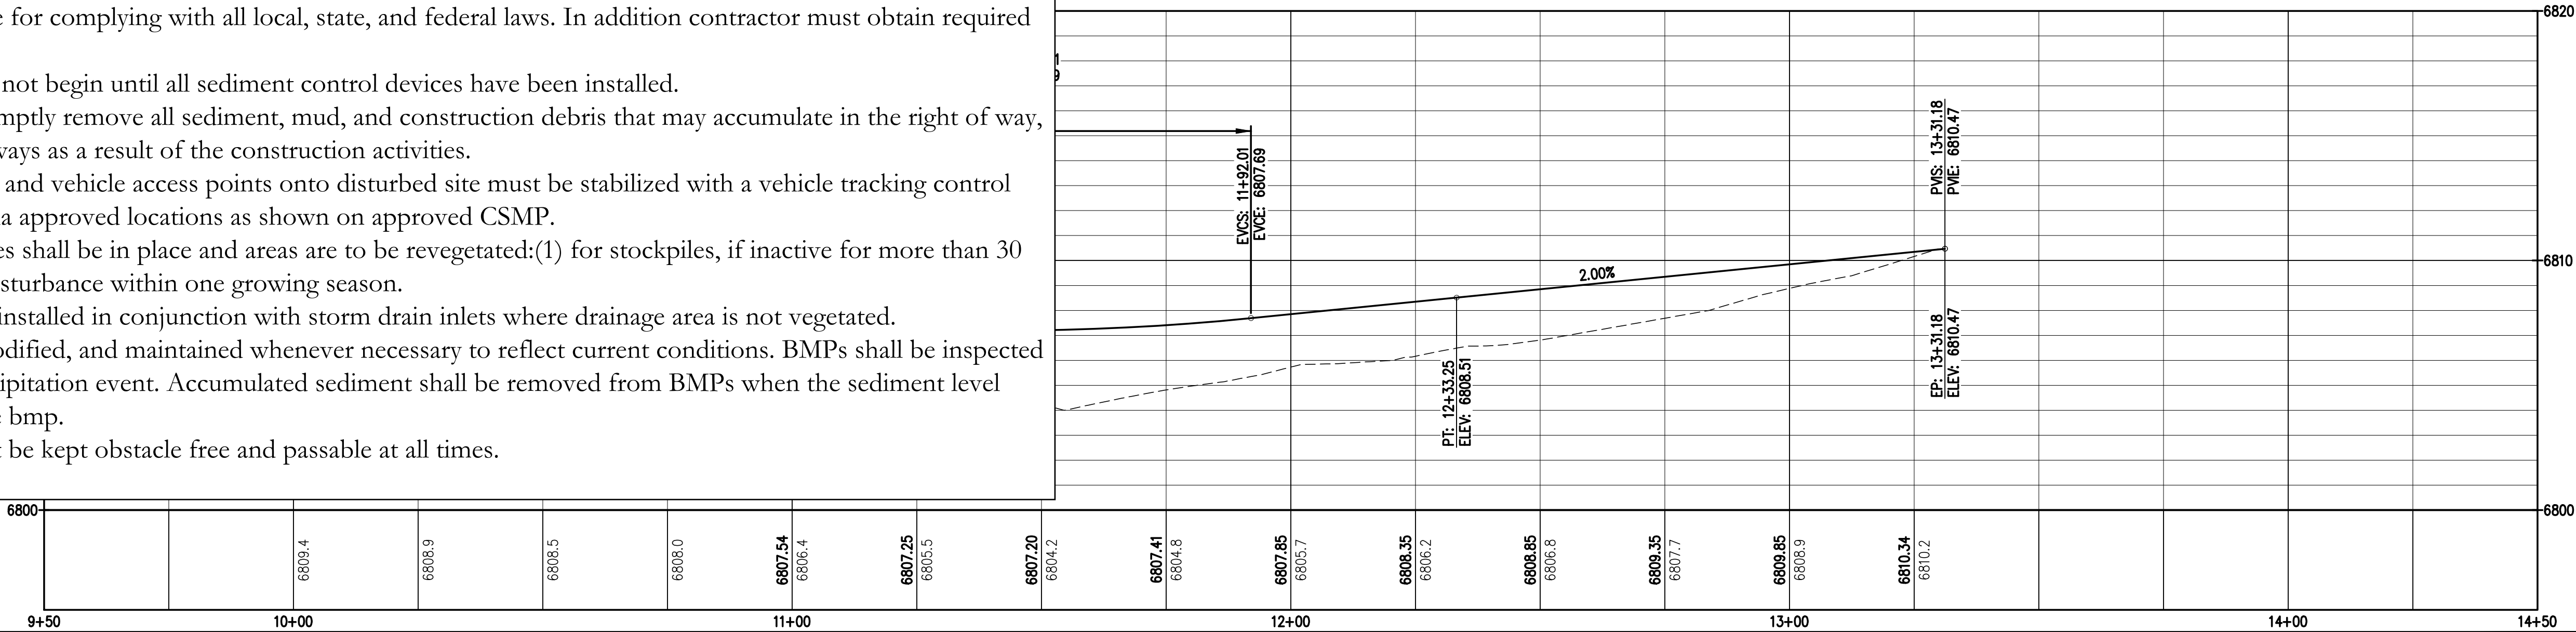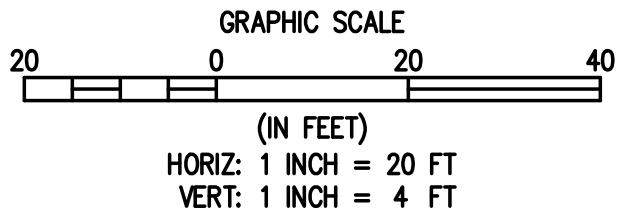

S.S. REDEVELOPMENT AUTHORITY

ROUTT COUNTY

ICONIC ENTRY

STEAMBOAT SPRINGS

ARNOLD BARN TEMPORARY HAUL ROAD PLAN

PREPARED UNDER THE DIRECT SUPERVISION OF

PRELIMINARY  
NOT FOR  
CONSTRUCTION

FOR AND ON BEHALF OF

BASELINE CORPORATION

INITIAL SUBMITTAL 6/7/18

DRAWING SIZE 24" X 36"

SURVEY FIRM SURVEY DATE

JOB NO. C020169

DRAWING NAME C020169 BARN ROUTE.dwg

SHEET C1 OF 1

C1

BASELINE  
Engineering • Planning • Surveying

1169 HILLTOP PKWY, SUITE 204 • STEAMBOAT SPRINGS, CO 80477  
P. 970.679.025 • F. 303.940.9559 • www.baselinecorp.com


DESIGNED BY SMB  
DRAWN BY SMB  
CHECKED BY CSR

DATE  
PREPARED BY

REVISION DESCRIPTION



O:\C020169 Iconic Entry Drawings\C020169 CIVIL CDs.dwg, 5/3/2018 3:45:57 PM, Chris Rundell

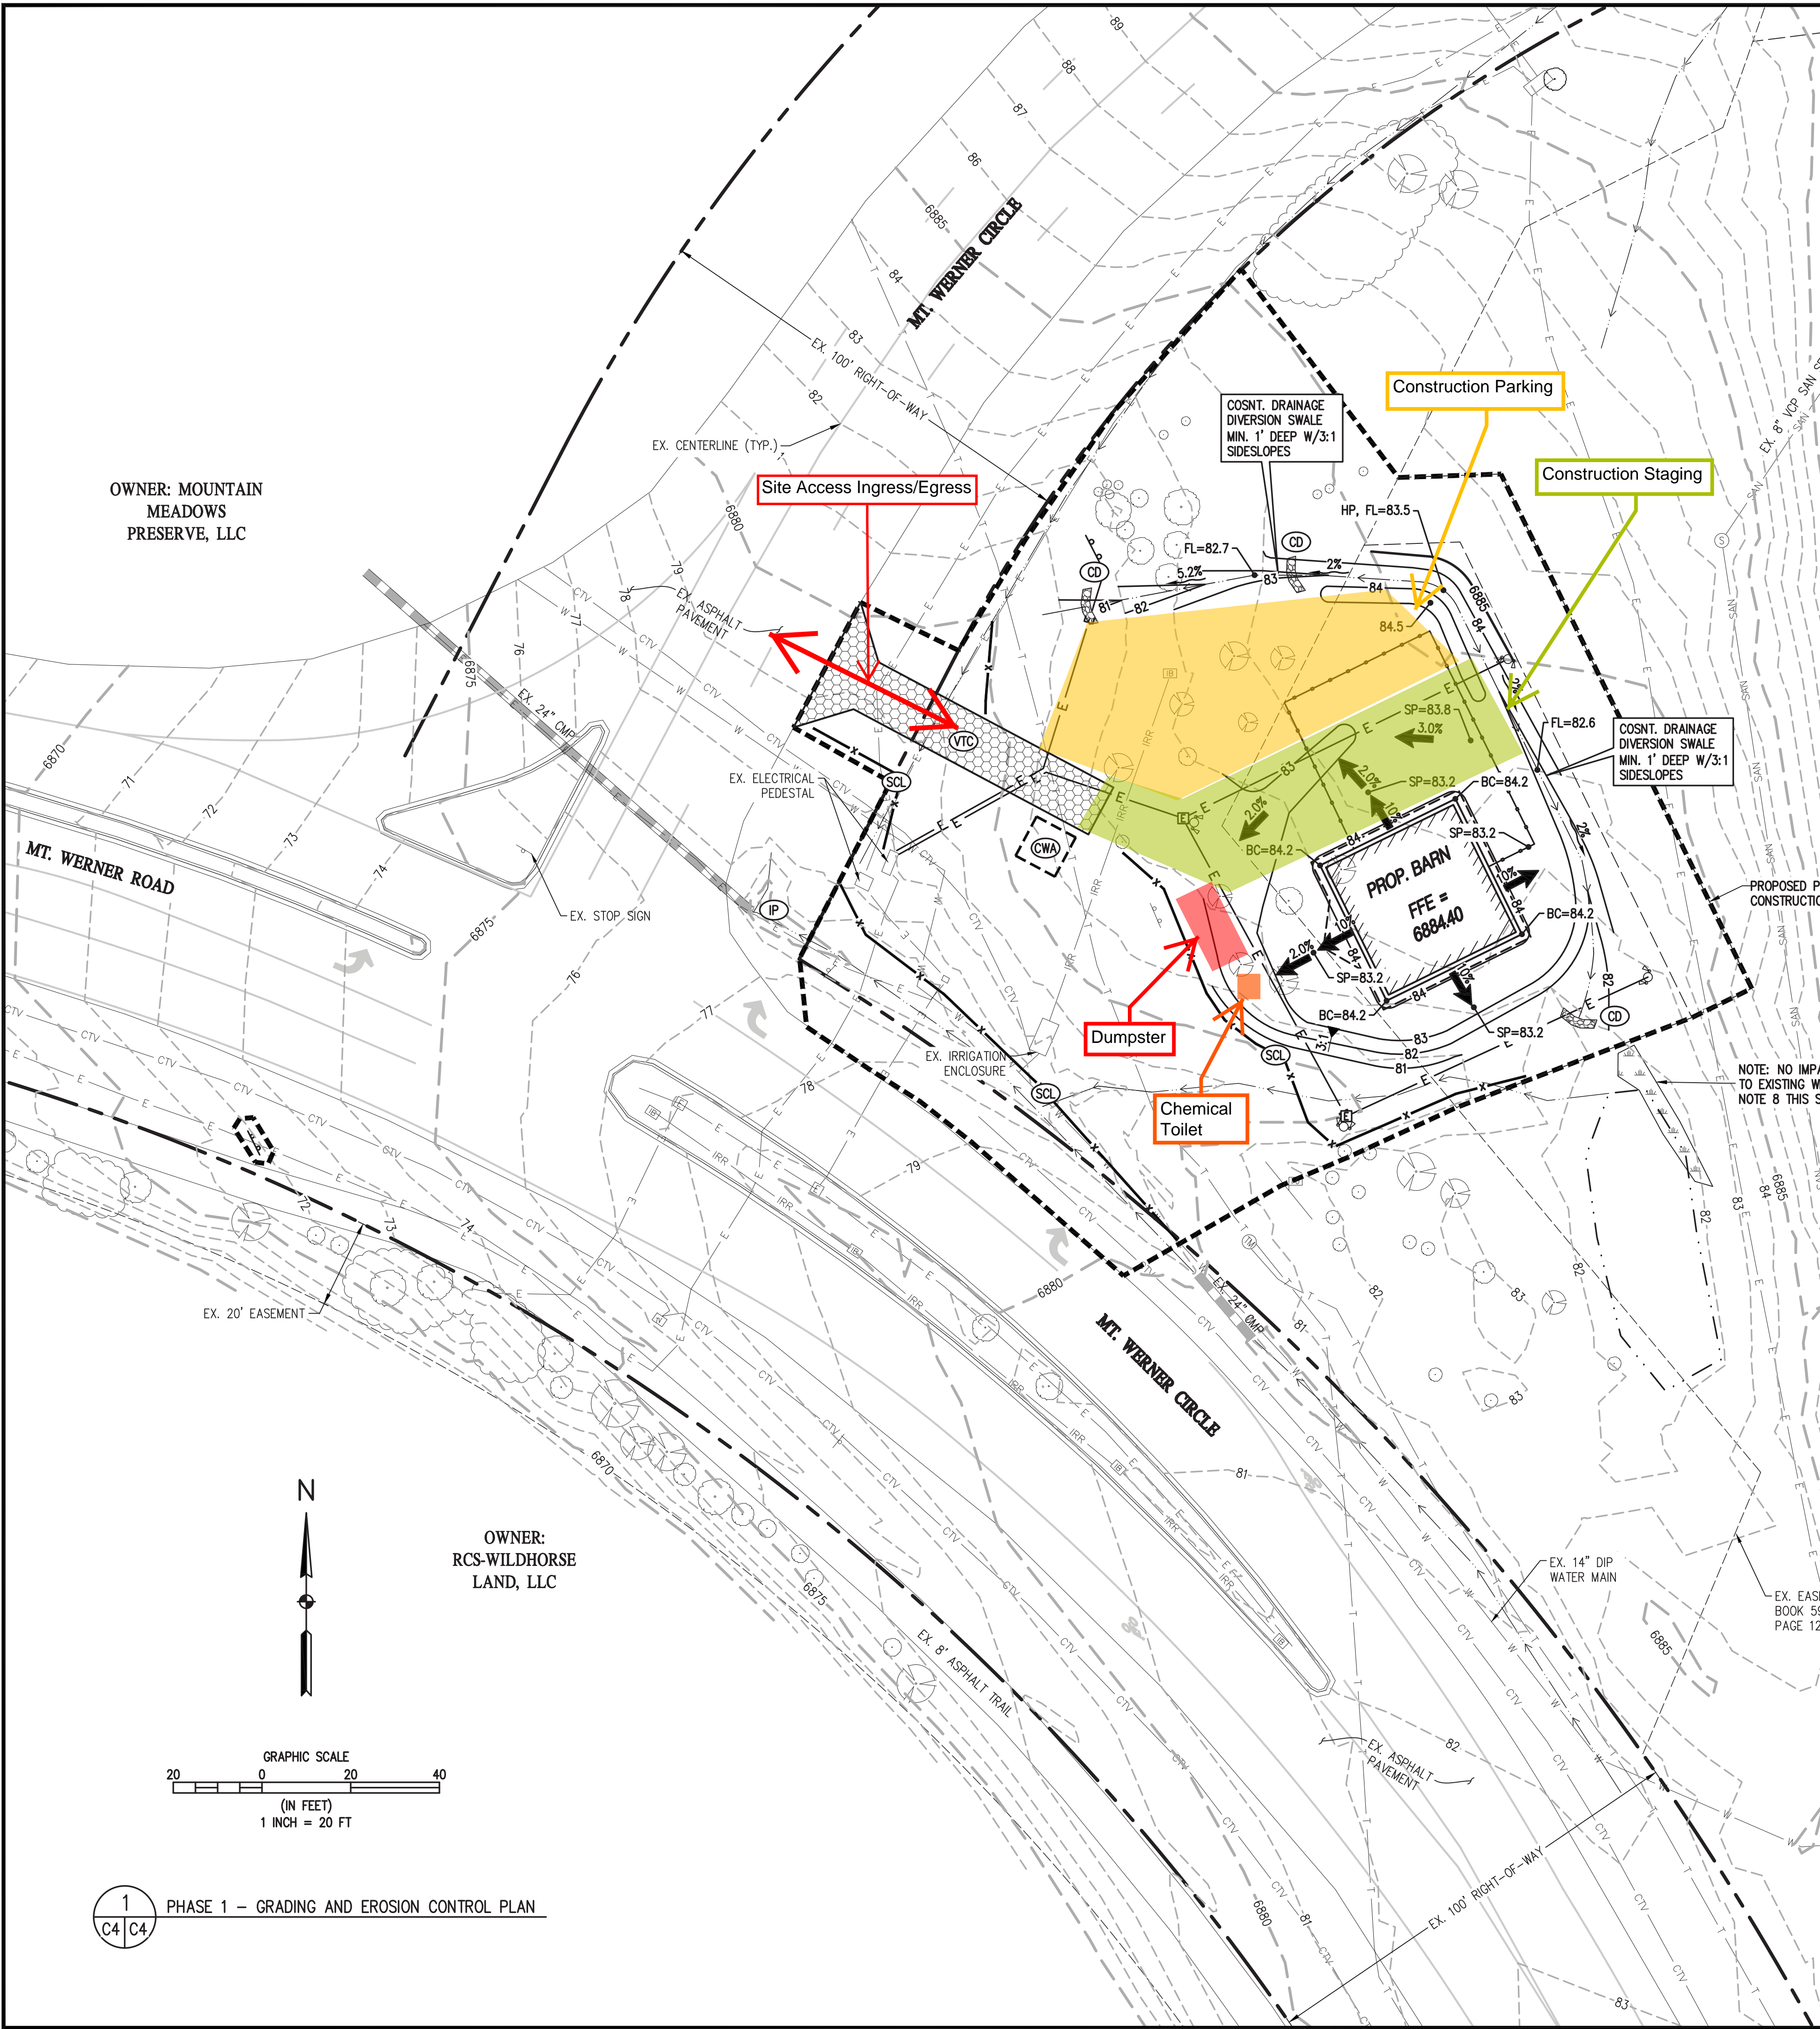

**EROSION AND SEDIMENT CONTROL LEGEND**

- IP INLET PROTECTION
- OP OUTLET PROTECTION
- RS ROCK SOCK
- VTC VEHICLE TRACKING CONTROL
- LOD LIMITS OF DISTURBANCE
- CWA CONCRETE WASHOUT AREA
- SP STOCKPILE
- SSA STABILIZED STORAGE AREA
- SCL SEDIMENT CONTROL LOG
- ECB EROSION CONTROL BLANKET
- CD ROCK CHECK DAM

**EROSION CONTROL NOTES:**

1. CONTRACTOR IS RESPONSIBLE TO LOCATE CONCRETE WASHOUT AREA, STOCKPILE LOCATION, AND STABILIZED STORAGE AREA WHERE IT WILL NOT INTERFERE WITH TRAFFIC AND ADJACENT PROPERTY OWNERS AND UPDATE THE PLAN ACCORDINGLY.
2. ANY STOCKPILES SHALL HAVE A SEDIMENT CONTROL LOG OR SILT FENCE AROUND THE PERIMETER OF THE STOCKPILE.
3. CONTRACTOR TO PLACE VEHICLE TRACKING CONTROL (VTC) AT ALL LOCATIONS WHERE THERE IS THE POTENTIAL TO TRACK MUD ON THE EXISTING PAVEMENT. VTC LOCATION TO BE COORDINATED WITH THE BUILDING MOVER.
4. ROCK CHECK DAMS ARE TO REMAIN IN PLACE AS PERMANENT BMP.
5. SILT FENCE MAY BE USED IN LIEU OF SEDIMENT CONTROL LOG.
6. REFER TO LANDSCAPE PLANS FOR REVEGETATION AND PLANTINGS.
7. CONTRACTOR TO COORDINATE ON EXACT LOCATION OF VEHICLE TRACKING CONTROL PAD WITH HOUSE MOVER AND OWNER'S REP. A TEMPORARY CULVERT MAY NECESSARY DEPENDING ON THE LOCATION. CONTRACTOR TO COORDINATE WITH ENGINEER.
8. CONTRACTOR TO INSTALL TEMPORARY ORANGE CONSTRUCTION FENCING ALONG TEMPORARY CONSTRUCTION EASEMENT LINE IN THE AREA ADJACENT TO THE EXISTING WETLANDS TO DELINEATE DISTURBANCE AREA AND AVOID INADVERTENT IMPACTS TO WETLANDS.

**Standard Notes for Construction Site Management Plans:**

1. This plan shall be kept on site at all times and updated to reflect any changes.
2. Concrete waste and washout water from mixing trucks shall be contained on site, removed from the site, and properly disposed. Materials should not enter state waters.
3. Contractor is responsible for installing and maintaining temporary erosion and sediment control during construction and establishing any required permanent Best Management Practices (BMPs).
4. Contractor is responsible for complying with all local, state, and federal laws. In addition contractor must obtain required permits.
5. Clearing or grading shall not begin until all sediment control devices have been installed.
6. The contractor shall promptly remove all sediment, mud, and construction debris that may accumulate in the right of way, private property, or water ways as a result of the construction activities.
7. All ingress, egress points and vehicle access points onto disturbed site must be stabilized with a vehicle tracking control pad. Access shall only be via approved locations as shown on approved CSMP.
8. Soil stabilization measures shall be in place and areas are to be revegetated:(1) for stockpiles, if inactive for more than 30 days (2) for areas of land disturbance within one growing season.
9. Inlet protection shall be installed in conjunction with storm drain inlets where drainage area is not vegetated.
10. BMPs shall be used, modified, and maintained whenever necessary to reflect current conditions. BMPs shall be inspected weekly and after every precipitation event. Accumulated sediment shall be removed from BMPs when the sediment level reaches 1/2 the height of the bmp.
11. Emergency access must be kept obstacle free and passable at all times.

**Construction Site Management Plan  
Phase One**

**BASELINE**  
Engineering - Planning - Surveying

419 OAK ST. • PO BOX 77052 • STEAMBOAT SPRINGS, CO 80477  
P. 970.679.025 • F. 303.940.9569 • www.baselinecorp.com

DESIGNED BY: SMB  
DRAWN BY: SMB  
CHECKED BY: CSR

DATE: 5/3/18  
PREPARED BY: CSR

REVISION DESCRIPTION  
DESIGN TEAM REVIEW/COORDINATION

ROUTE COUNTY

**CITY OF STEAMBOAT SPRINGS**  
URAAC/SSRA ICONIC ENTRY  
MT. WERNER CIRCLE/MT. WERNER ROAD  
PHASE 1 - GRADING AND EROSION CONTROL PLAN

STEAMBOAT SPRINGS


PREPARED UNDER THE DIRECT SUPERVISION OF  
COLORADO LICENSED PROFESSIONAL ENGINEER  
40319  
5/3/18

FOR AND ON BEHALF OF  
BASELINE CORPORATION  
INITIAL SUBMITTAL 4/25/17  
DRAWING SIZE 24" X 36"  
SURVEY FIRM SURVEY DATE  
D&D, INC. 10/11/14  
JOB NO. C020169  
DRAWING NAME  
C020169 CIVIL CDs.dwg  
SHEET 4 OF 13

C4



O:\C020169 Iconic Entry Drawings\C020169 CIVIL CDs.dwg, 5/3/2018 3:47:48 PM, Chris Rundall

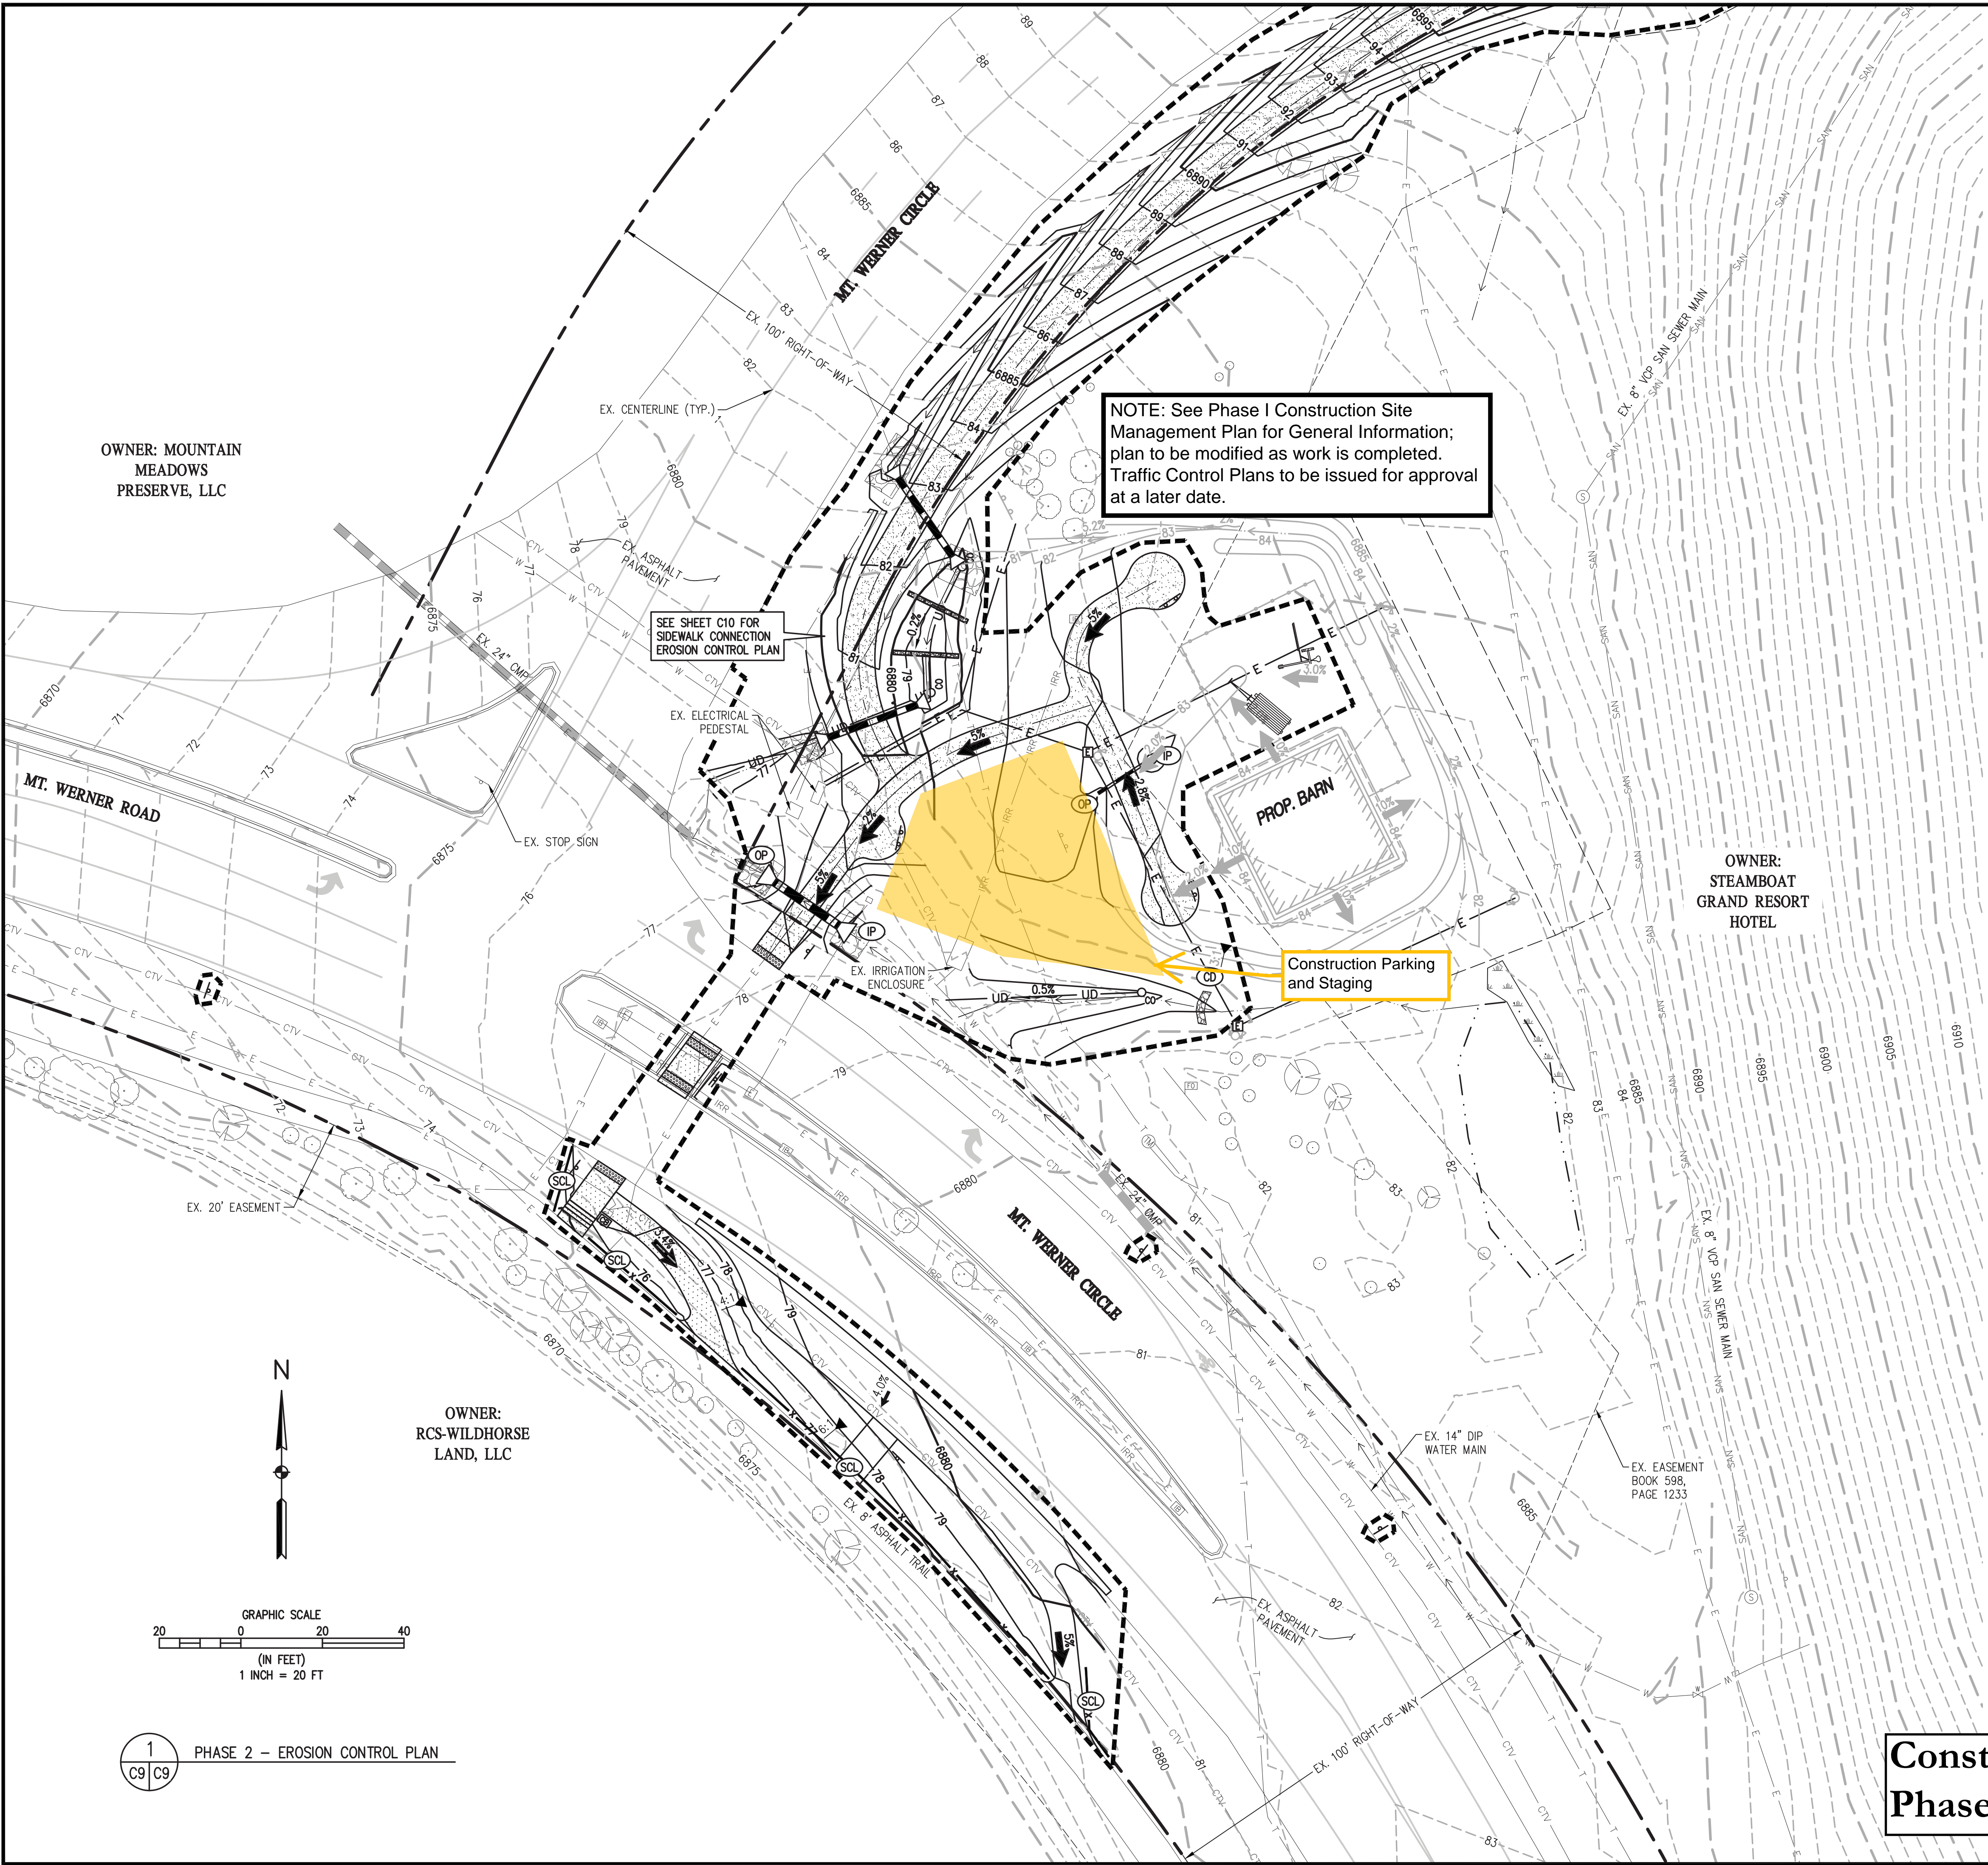

EROSION AND SEDIMENT CONTROL LEGEND

- IP INLET PROTECTION
- OP OUTLET PROTECTION
- RS ROCK SOCK
- VTC VEHICLE TRACKING CONTROL
- LOD LIMITS OF DISTURBANCE
- CWA CONCRETE WASHOUT AREA
- SP STOCKPILE
- SSA STABILIZED STORAGE AREA
- SCL SEDIMENT CONTROL LOG
- ECB EROSION CONTROL BLANKET
- CD ROCK CHECK DAM

EROSION CONTROL NOTES:

1. CONTRACTOR IS RESPONSIBLE TO LOCATE CONCRETE WASHOUT AREA, STOCKPILE LOCATION, AND STABILIZED STORAGE AREA WHERE IT WILL NOT INTERFERE WITH TRAFFIC AND ADJACENT PROPERTY OWNERS AND UPDATE THE PLAN ACCORDINGLY.
2. ANY STOCKPILES SHALL HAVE A SEDIMENT CONTROL LOG OR SILT FENCE AROUND THE PERIMETER OF THE STOCKPILE.
3. CONTRACTOR TO PLACE VEHICLE TRACKING CONTROL (VTC) AT ALL LOCATIONS WHERE THERE IS THE POTENTIAL TO TRACK MUD ON THE EXISTING PAVEMENT. VTC LOCATION TO BE COORDINATED WITH THE BUILDING MOVER.
4. ROCK CHECK DAMS ARE TO REMAIN IN PLACE AS PERMANENT BMP.
5. SILT FENCE MAY BE USED IN LIEU OF SEDIMENT CONTROL LOG.
6. REFER TO LANDSCAPE PLANS FOR REVEGETATION AND PLANTINGS.

**BASELINE**

Engineering - Planning - Surveying  
419 OAK ST. • PO BOX 77052 • STEAMBOAT SPRINGS, CO 80477  
P. 970.679.025 • F. 303.340.9569 • www.baselinecorp.com

DESIGNED BY: SMB  
DRAWN BY: SMB  
CHECKED BY: CSR

DATE: 5/3/18  
PREPARED BY: CSR

REVISION DESCRIPTION  
DESIGN TEAM REVIEW/COORDINATION

CITY OF STEAMBOAT SPRINGS  
STEAMBOAT SPRINGS  
ROUTE COUNTY  
URAAC/SSRA ICONIC ENTRY  
MT. WERNER CIRCLE/MT. WERNER ROAD  
PHASE 2 - EROSION CONTROL PLAN

PREPARED UNDER THE DIRECT SUPERVISION OF



FOR AND ON BEHALF OF  
BASELINE CORPORATION  
INITIAL SUBMITTAL 4/25/17  
DRAWING SIZE 24" x 36"  
SURVEY FIRM D&D, INC. SURVEY DATE 10/11/14  
JOB NO. C020169  
DRAWING NAME C020169 CIVIL CDs.dwg  
SHEET 9 OF 13

C9

Construction Site Management Plan  
Phase Two




N:\C020166 Ski Time Square Mt Werner Intersection\Drawings\20169 TRAIL EC PLAN.dwg, 5/3/2018 3:48:07 PM, Chris Rundall

EROSION AND SEDIMENT CONTROL LEGEND



- IP INLET PROTECTION
- OP OUTLET PROTECTION
- RS ROCK SOCK
- VTC VEHICLE TRACKING CONTROL
- LOD LIMITS OF DISTURBANCE
- CWA CONCRETE WASHOUT AREA
- SP STOCKPILE
- SSA STABILIZED STORAGE AREA
- SCL SEDIMENT CONTROL LOG
- ECB EROSION CONTROL BLANKET
- CD ROCK CHECK DAM

EROSION CONTROL NOTES:


1. CONTRACTOR IS RESPONSIBLE TO LOCATE CONCRETE WASHOUT AREA, STOCKPILE LOCATION, AND STABILIZED STORAGE AREA WHERE IT WILL NOT INTERFERE WITH TRAFFIC AND ADJACENT PROPERTY OWNERS AND UPDATE THE PLAN ACCORDINGLY.
2. ANY STOCKPILES SHALL HAVE A SEDIMENT CONTROL LOG OR SILT FENCE AROUND THE PERIMETER OF THE STOCKPILE.
3. CONTRACTOR TO PLACE VEHICLE TRACKING CONTROL (VTC) AT ALL LOCATION WHERE THERE IS THE POTENTIAL TO TRACK MUD ON THE EXISTING PAVEMENT.
4. ROCK CHECK DAMS ARE TO REMAIN IN PLACE AS PERMANENT BMP.
5. SILT FENCE MAY BE USED IN LIEU OF SEDIMENT CONTROL LOG.

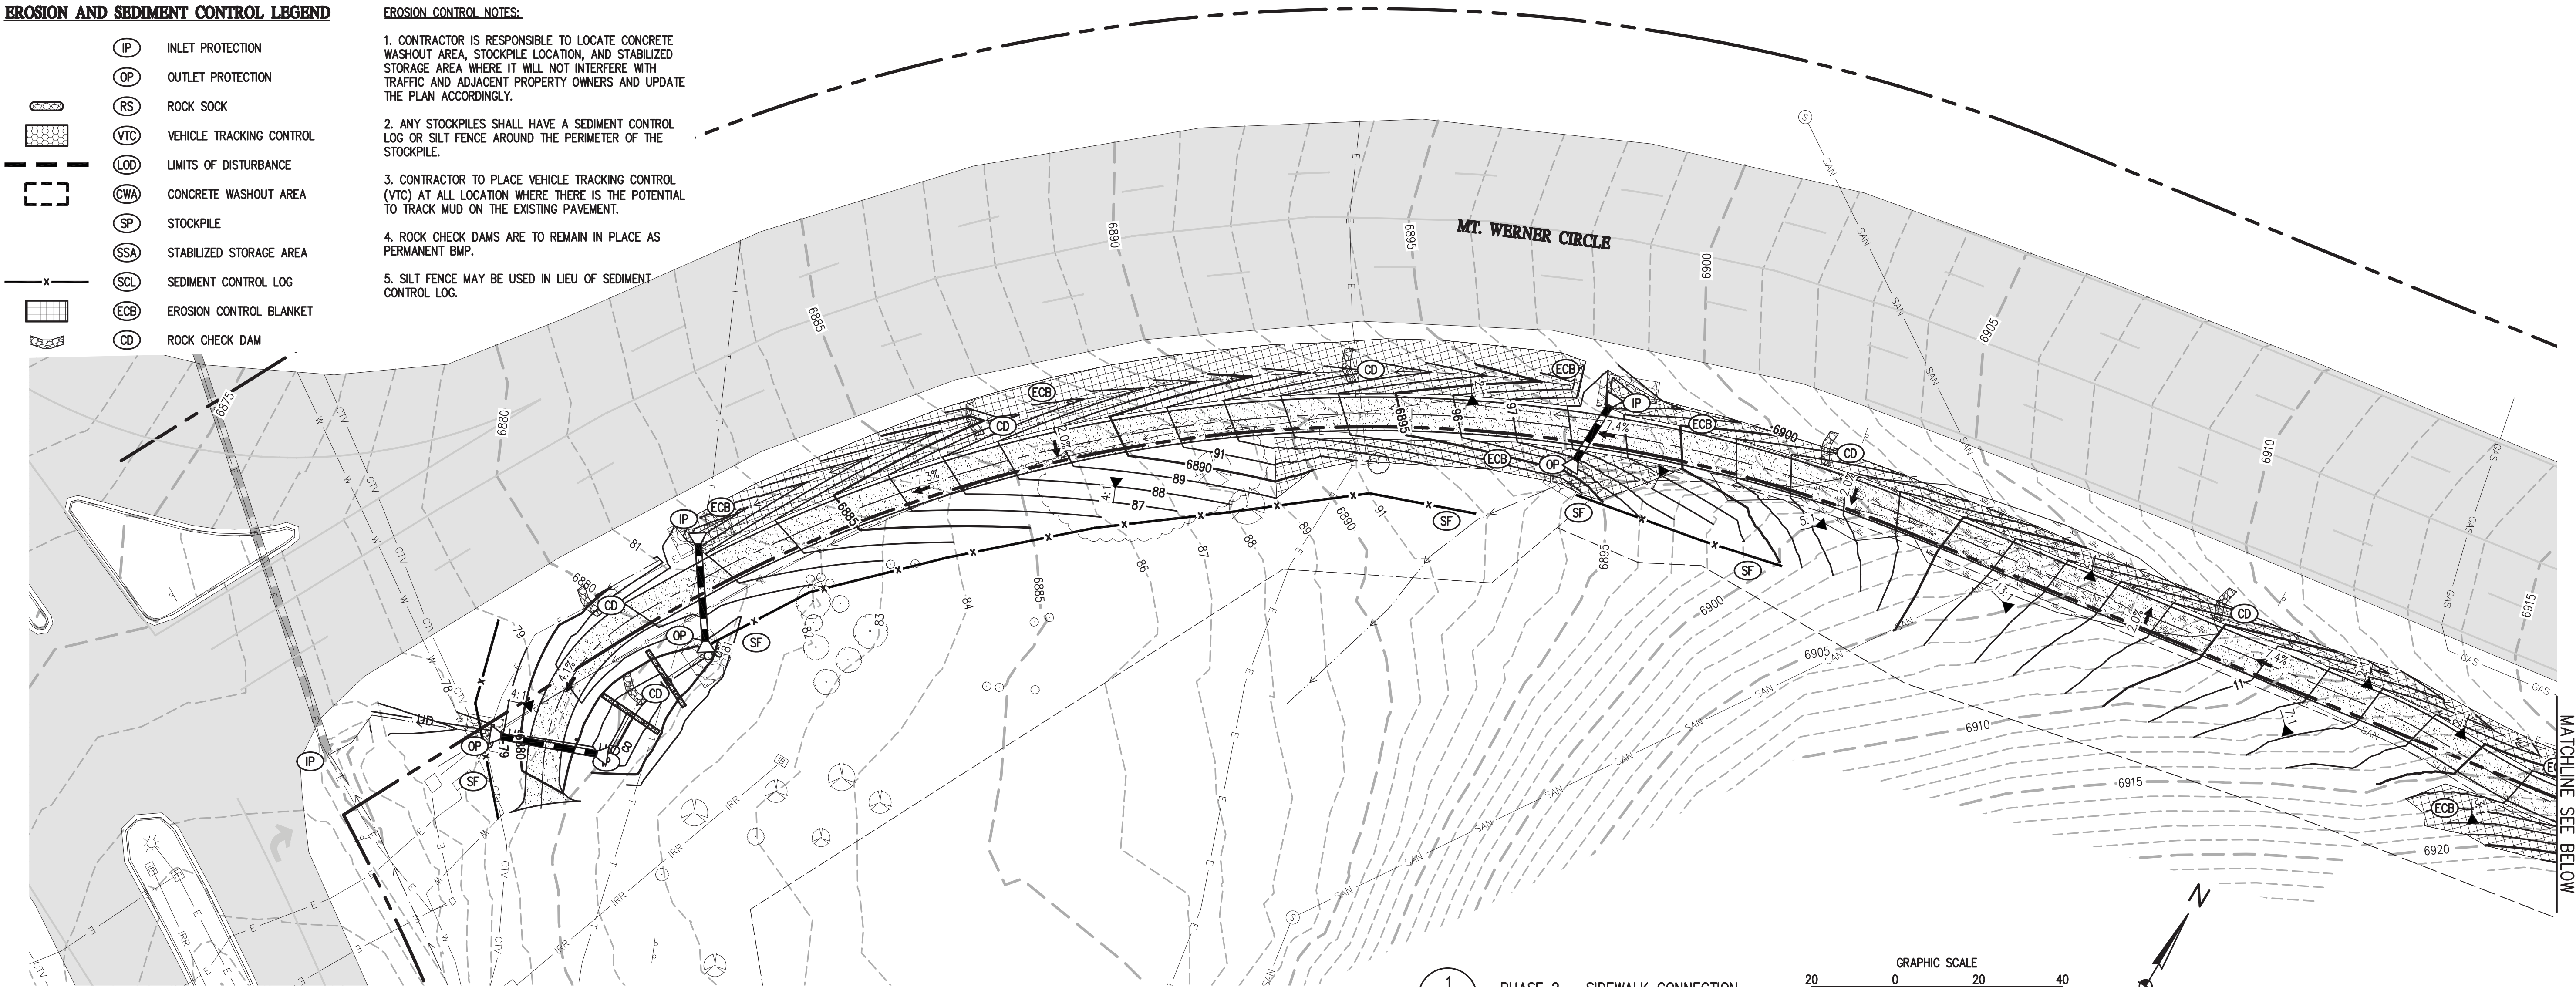

1 PHASE 2 - SIDEWALK CONNECTION  
C10 C10 EROSION CONTROL PLAN

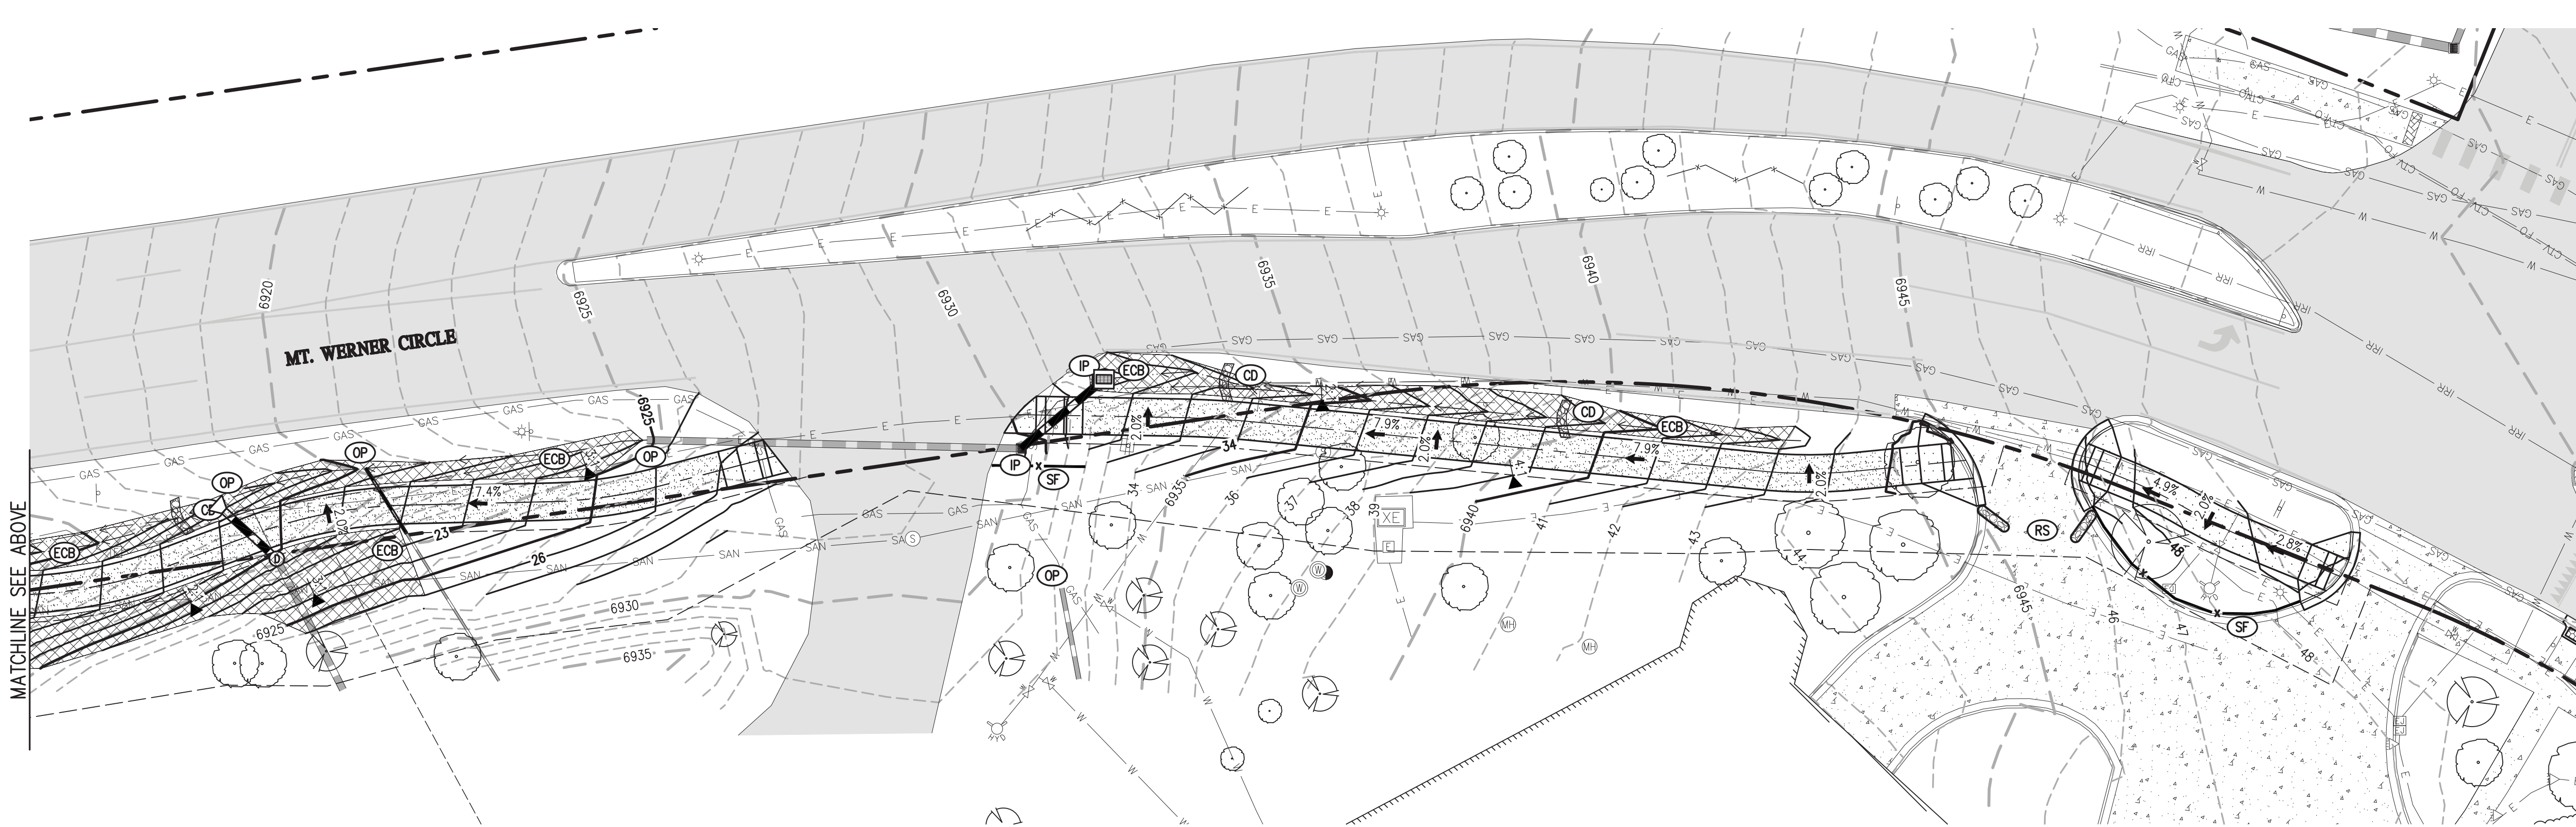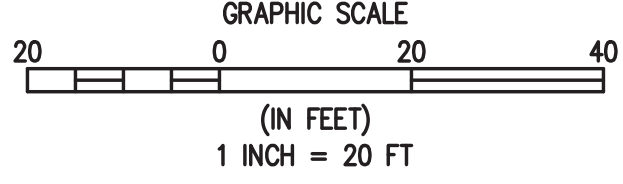

- LEGEND
- EXIST. ASPHALT PAVING
  - CONCRETE SIDEWALK PAVING
  - SOFT SURFACE SIDEWALK
  - EXIST. CONCRETE
  - EXIST. WETLANDS

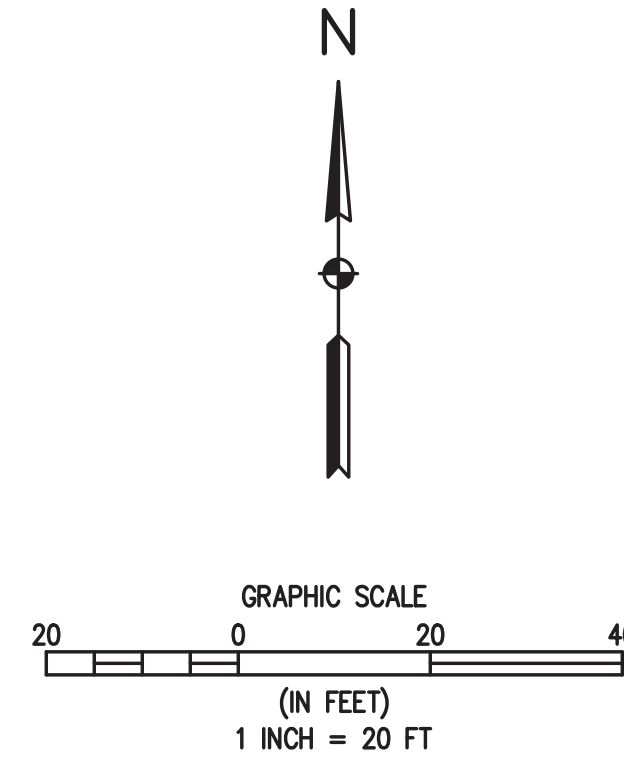

Construction Site Management Plan  
Phase Two

2 PHASE 2 - SIDEWALK CONNECTION  
C10 C10 EROSION CONTROL PLAN

BASELINE

Engineering - Planning - Surveying

419 OAK ST. • PO BOX 77052 • STEAMBOAT SPRINGS, CO 80477

P. 970.878.025 • F. 303.340.9569 • www.baselinecorp.com

DESIGNED BY

SMB

DRAWN BY

SMB

CHECKED BY

CSR

REVISION DESCRIPTION

DESIGN TEAM REVIEW/COORDINATION

DATE

5/3/18

PREPARED BY

CSR

CITY OF STEAMBOAT SPRINGS

ROUTT COUNTY

URAAC/SSRA ICONIC ENTRY

MT. WERNER CIRCLE/MT. WERNER ROAD

PHASE 2 - SIDEWALK CONNECTION EROSION CONTROL PLAN

PREPARED UNDER THE DIRECT SUPERVISION OF

COLORADO LICENSED

40319

5/3/18

PROFESSIONAL ENGINEER

FOR AND ON BEHALF OF

BASELINE CORPORATION

INITIAL SUBMITTAL

4/25/17

DRAWING SIZE

24" X 36"

SURVEY FIRM

D&D, INC.

SURVEY DATE

10/11/14

JOB NO.

C020169

DRAWING NAME

20169 TRAIL EC PLAN.dwg

SHEET

10 OF 13

C10



