

| DIRECTORY OF PAGES |                     |
|--------------------|---------------------|
| PV-1               | PROJECT SUMMARY     |
| PV-2               | SITE PLAN           |
| APPENDIX           | MODULE DATASHEET    |
|                    | OPTIMIZER DATASHEET |
|                    | INVERTER DATASHEET  |


| PROJECT DETAILS                  |  |
|----------------------------------|--|
| PROPERTY OWNER                   |  |
| PROPERTY ADDRESS                 | 3367 APRES SKI WAY, STEAMBOAT SPRINGS, CO 80487 US |
| APN                              |  |
| ZONING                           | RESIDENTIAL  |
| USE AND OCCUPANCY CLASSIFICATION | ONE- OR TWO-FAMILY DWELLING GROUP (GROUP R3)       |
| AHJ                              |  |
| UTILITY COMPANY                  | YAMPA VALLEY ELECTRIC ASSN INC                     |
| ELECTRICAL CODE                  | 2017 NEC (NFPA 70)                                 |
| FIRE CODE                        | 2015 IFC   |

| CONTRACTOR INFORMATION |  |
|------------------------|--|
| COMPANY                | SUNWISE SOLAR, LLC                       |
| LICENSE NUMBER         | 010556 (NABCEP PV INSTALLATION PROF.)    |
| ADDRESS                | 1143 OAK ST, STEAMBOAT SPRINGS, CO 80487 |
| PHONE NUMBER           | (970) 819-0840                           |
| CONTRACTOR SIGNATURE   |  |



1 PLOT  
PV-1 SCALE: NTS

RCRBD  
Record Set

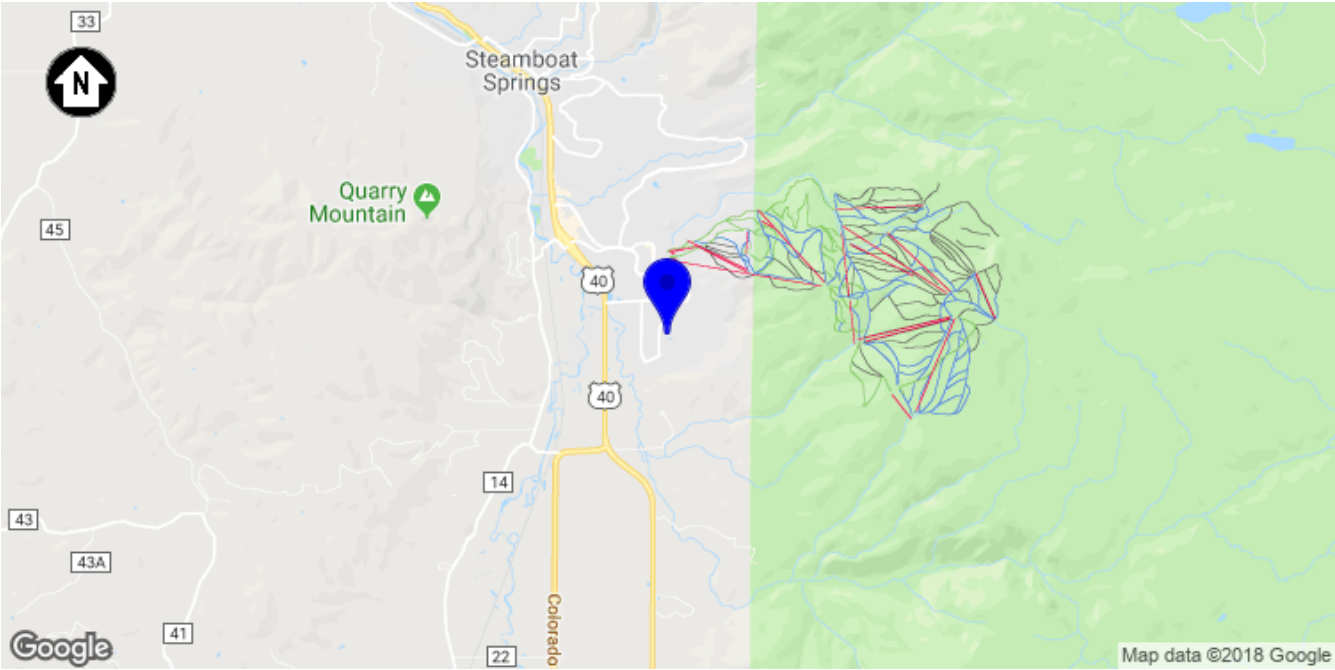

2 LOCALE  
PV-1 SCALE: NTS

RCRBD  
ELECTRICAL  
RECORD SET

| SCOPE OF WORK  |
|--|
| THIS PROJECT INVOLVES THE INSTALLATION OF SOLAR PANELS. THE SOLAR PANELS WILL BE RACKED USING A PREENGINEERED RACKING SYSTEM. THE RACKED MODULES WILL BE ELECTRICALLY CONNECTED WITH DC TO AC POWER INVERTERS AND INTERCONNECTED TO THE LOCAL UTILITY USING MEANS AND METHODS CONSISTENT WITH THE RULES ENFORCED BY THE LOCAL UTILITY AND PERMITTING JURISDICTION. |


THIS DOCUMENT HAS BEEN PREPARED FOR THE PURPOSE OF DESCRIBING THE DESIGN OF A PROPOSED PV SYSTEM WITH ENOUGH DETAIL TO DEMONSTRATE COMPLIANCE WITH APPLICABLE CODES AND REGULATIONS. THE DOCUMENT SHALL NOT BE RELIED UPON AS A SUBSTITUTE FOR FOLLOWING MANUFACTURER INSTALLATION INSTRUCTIONS. THE SYSTEM SHALL COMPLY WITH ALL MANUFACTURERS LISTING AND INSTALLATION INSTRUCTIONS, AS WELL AS ALL APPLICABLE CODES. NOTHING IN THIS DOCUMENT SHALL BE INTERPRETED IN A WAY THAT OVERRIDES THEM. CONTRACTOR IS RESPONSIBLE FOR VERIFICATION OF ALL CONDITIONS, DIMENSIONS, AND DETAILS IN THIS DOCUMENT.

| SYSTEM DETAILS      |  |
|---------------------|--|
| DESCRIPTION         | NEW GRID-INTERACTIVE PHOTOVOLTAIC SYSTEM WITH NO BATTERY STORAGE |
| DC RATING OF SYSTEM | 6,555W   |
| AC RATING OF SYSTEM | 10,000W  |
| AC OUTPUT CURRENT   | 42.0A  |
| INVERTER(S)         | 1 X SOLAR EDGE SE10000H-US                                       |
| MODULE              | SOLARIA POWERXT-345R-BD  |
| ARRAY WIRING        | (1) STRING OF 9<br>(1) STRING OF 10                              |

| INTERCONNECTION DETAILS |   |
|-------------------------|---|
| POINT OF CONNECTION     | NEW LOAD SIDE AC CONNECTION PER NEC 705.12(A) |
| UTILITY SERVICE         | 120/240V 1Φ                                   |
|                         |   |

| SITE DETAILS           |                            |
|------------------------|----------------------------|
| ASHRAE EXTREME LOW     | -25°C (-13°F)              |
| ASHRAE 2% HIGH         | 30°C (86°F)                |
| CLIMATE DATA SOURCE    | HAYDEN/YAMPA (AWOS) (KHND) |
| WIND SPEED             |                            |
| RISK CATEGORY          | II                         |
| WIND EXPOSURE CATEGORY |                            |
| GROUND SNOW LOAD       |                            |

P-102515



GRID-TIED SOLAR POWER SYSTEM


3367 APRES SKI WAY  
STEAMBOAT SPRINGS, CO 80487

PROJECT SUMMARY

DOC ID: 102515-128868-1  
DATE: 12/11/18  
CREATOR: C.M.  
REVIEWER:

REVISIONS

PV-1

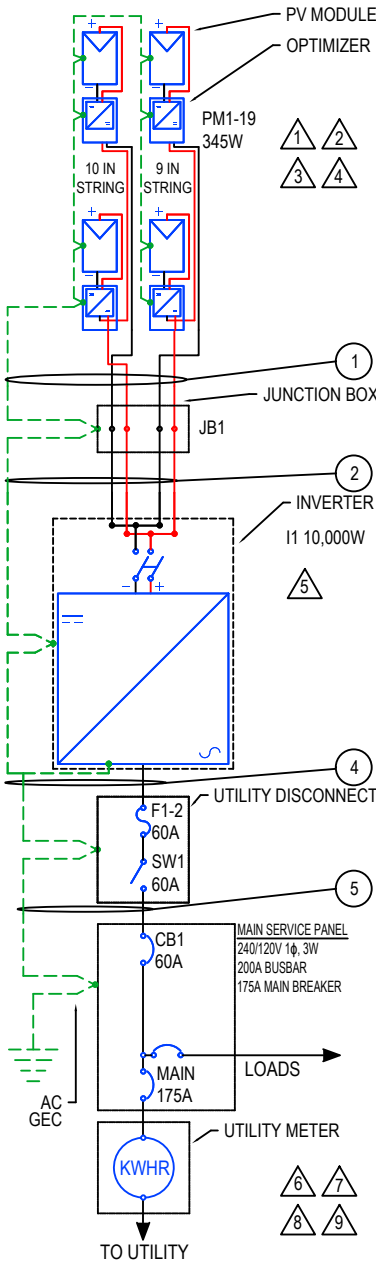

| MODULES |      |                         |      |      |       |       |       |       |                        |             |
|---------|------|-------------------------|------|------|-------|-------|-------|-------|------------------------|-------------|
| REF.    | QTY. | MAKE AND MODEL          | PMAX | PTC  | ISC   | IMP   | VOC   | VMP   | TEMP. COEFF. OF VOC    | FUSE RATING |
| PM1-19  | 19   | SOLARIA POWERXT-345R-BD | 345W | 319W | 9.40A | 8.88A | 47.1V | 38.9V | -0.137V/°C (-0.29%/°C) | 15A         |

| INVERTERS |      |                        |            |                      |                 |             |                    |                   |                   |                         |
|-----------|------|------------------------|------------|----------------------|-----------------|-------------|--------------------|-------------------|-------------------|-------------------------|
| REF.      | QTY. | MAKE AND MODEL         | AC VOLTAGE | GROUND               | MAX OCPD RATING | RATED POWER | MAX OUTPUT CURRENT | MAX INPUT CURRENT | MAX INPUT VOLTAGE | CEC WEIGHTED EFFICIENCY |
| I1        | 1    | SOLAR EDGE SE10000H-US | 240V       | NOT SOLIDLY GROUNDED | 60A             | 10,000W     | 42.0A              | 27.0A             | 480V              | 99.0%                   |

| POWER OPTIMIZERS |      |                 |                   |                    |               |                |
|------------------|------|-----------------|-------------------|--------------------|---------------|----------------|
| REF.             | QTY. | MODEL           | RATED INPUT POWER | MAX OUTPUT CURRENT | MAX INPUT ISC | MAX DC VOLTAGE |
| PO1-19           | 19   | SOLAR EDGE P370 | 370W              | 15A                | 11.0A         | 60V            |

| DISCONNECTS |      |                          |               |
|-------------|------|--------------------------|---------------|
| REF.        | QTY. | MAKE AND MODEL           | RATED CURRENT |
| SW1         | 1    | EATON DG222NRB OR EQUIV. | 60A           |

| OCPDS |      |               |             |
|-------|------|---------------|-------------|
| REF.  | QTY. | RATED CURRENT | MAX VOLTAGE |
| F1-2  | 2    | 60A           | 240VAC      |
| CB1   | 1    | 60A           | 240VAC      |

| SYSTEM SUMMARY                |          |          |
|-------------------------------|----------|----------|
|                               | STRING 1 | STRING 2 |
| OPTIMIZERS MAX OUTPUT CURRENT | 15A      | 15A      |
| OPTIMIZERS IN SERIES          | 10       | 9        |
| NOMINAL STRING VOLTAGE        | 400V     | 400V     |
| ARRAY OPERATING CURRENT       | 8.6A     | 7.8A     |
| ARRAY STC POWER               | 6,555W   |          |
| ARRAY PTC POWER               | 6,053W   |          |
| MAX AC CURRENT                | 42A      |          |
| MAX AC POWER                  | 10,000W  |          |
| DERATED (CEC) AC POWER        | 5,921W   |          |

- ### NOTES
- ⚠️ OPTIMIZERS PROVIDE RAPID SHUTDOWN FUNCTIONALITY REQUIRED BY NEC 690.12.
  - ⚠️ THE SPECIFIED OPTIMIZER CAN BE SUBSTITUTED WITH A P400, P405, OR P505. THESE OPTIMIZERS HAVE AN INPUT VOLTAGE WINDOW WIDE ENOUGH TO ACCOMMODATE THE OUTPUT VOLTAGE RANGE OF THE MODULE AT THE DESIGN TEMPERATURES, HAVE A MAX INPUT CURRENT RATING THAT IS ABOVE THE MAX OUTPUT CURRENT OF THE MODULE, AND A MAX POWER INPUT THAT IS ABOVE THE RATED POWER OUTPUT OF THE MODULE.
  - ⚠️ DC PV CONDUCTORS ARE NOT SOLIDLY GROUNDED. NO DC PV CONDUCTOR SHALL BE WHITE- OR GRAY-COLORED
  - ⚠️ MAX DC VOLTAGE OF ARRAY FIXED BY THE INVERTER AT 400V REGARDLESS OF TEMPERATURE. THE MAX DC VOLTAGE OF THE MODULE AT -25°C IS EXPECTED TO BE 53.9V. (-25°C - 25°C) X -0.137V/°C + 47.1V = 53.9V).
  - ⚠️ INVERTER IS NON-ISOLATED. NO CONDUCTOR IS SOLIDLY GROUNDED AND THEREFORE NO DC GEC IS REQUIRED.
  - ⚠️ (E) 200A MAIN BREAKER DERATED TO (N) 175A
  - ⚠️ POINT-OF-CONNECTION IS ON LOAD SIDE OF SERVICE DISCONNECT, IN COMPLIANCE WITH NEC 705.12(B). OUTPUT IS BACKFED THROUGH BREAKER IN MAIN PANEL.
  - ⚠️ THE PV BREAKER SHALL NOT BE MARKED FOR "LINE" AND "LOAD".
  - ⚠️ THE PV BREAKER SHALL BE LOCATED AT THE OPPOSITE END OF THE BUSBAR FROM THE MAIN BREAKER.

| CONDUCTOR AND CONDUIT SCHEDULE W/ELECTRICAL CALCULATIONS |         |                        |                |  |      |                       |                    |                     |               |                     |           |              |                    |                           |        |              |
|--|---------|------------------------|----------------|--|------|-----------------------|--------------------|---------------------|---------------|---------------------|-----------|--------------|--------------------|---------------------------|--------|--------------|
| ID   | TYPICAL | CONDUCTOR              | CONDUIT        | CURRENT-CARRYING CONDUCTORS IN CONDUIT | OCPD | EGC                   | TEMP. CORR. FACTOR | CONDUIT FILL FACTOR | CONT. CURRENT | MAX. CURRENT (125%) | BASE AMP. | DERATED AMP. | TERM. TEMP. RATING | AMP. @ TERM. TEMP. RATING | LENGTH | VOLTAGE DROP |
| 1  | 1       | 10 AWG PV WIRE, COPPER | FREE AIR       | N/A                                    | N/A  | 6 AWG BARE, COPPER    | 0.76 (52°C)        | 1.0                 | 15A           | 18.75A              | 55A       | 41.8A        | 75°C               | 50A                       | 66FT   | 0.62%        |
| 2  | 1       | 10 AWG THWN-2, COPPER  | 0.75" DIA. EMT | 4                                      | N/A  | 10 AWG THWN-2, COPPER | 1.0 (30°C)         | 0.8                 | 15A           | 18.75A              | 40A       | 32A          | 60°C               | 30A                       | 19FT   | 0.18%        |
| 3  | 1       | 10 AWG PV WIRE, COPPER | FREE AIR       | N/A                                    | N/A  | 6 AWG BARE, COPPER    | 0.76 (52°C)        | 1.0                 | 15A           | 18.75A              | 55A       | 41.8A        | 75°C               | 50A                       | 59FT   | 0.55%        |
| 4  | 1       | 6 AWG THWN-2, COPPER   | 0.75" DIA. EMT | 2                                      | 60A  | 10 AWG THWN-2, COPPER | 1.0 (30°C)         | 1.0                 | 42A           | 52.5A               | 75A       | 75A          | 60°C               | 55A                       | 19FT   | 0.33%        |
| 5  | 1       | 6 AWG THWN-2, COPPER   | 0.75" DIA. EMT | 2                                      | 60A  | 10 AWG THWN-2, COPPER | 1.0 (30°C)         | 1.0                 | 42A           | 52.5A               | 75A       | 75A          | 75°C               | 65A                       | 10FT   | 0.17%        |

- ### GENERAL ELECTRICAL NOTES
- UTILITY HAS 24-HR UNRESTRICTED ACCESS TO ALL PHOTOVOLTAIC SYSTEM COMPONENTS LOCATED AT THE SERVICE ENTRANCE.
  - MODULES CONFORM TO AND ARE LISTED UNDER UL 1703.
  - CONDUCTORS EXPOSED TO SUNLIGHT SHALL BE LISTED AS SUNLIGHT RESISTANT PER NEC ARTICLE 300.6 (C) (1) AND ARTICLE 310.8 (D).
  - CONDUCTORS EXPOSED TO WET LOCATIONS SHALL BE SUITABLE FOR USE IN WET LOCATIONS PER NEC ARTICLE 310.8 (C).

- ### GROUNDING NOTES
- ALL EQUIPMENT SHALL BE PROPERLY GROUNDED PER THE REQUIREMENTS OF NEC ARTICLES 250 & 690
  - PV MODULES SHALL BE GROUNDED TO MOUNTING RAILS USING MODULE LUGS OR RACKING INTEGRATED
  - GROUNDING CLAMPS AS ALLOWED BY LOCAL JURISDICTION. ALL OTHER EXPOSED METAL PARTS SHALL BE GROUNDED USING UL-LISTED LAY-IN LUGS.
  - INSTALLER SHALL CONFIRM THAT MOUNTING SYSTEM HAS BEEN EVALUATED FOR COMPLIANCE WITH UL 2703 "GROUNDING AND BONDING" WHEN USED WITH PROPOSED PV MODULE.
  - ALL GROUNDING SYSTEM COMPONENTS SHALL BE LISTED FOR THEIR PURPOSE
  - IF THE EXISTING MAIN SERVICE PANEL DOES NOT HAVE A VERIFIABLE GROUNDING ELECTRODE, IT IS THE CONTRACTOR'S RESPONSIBILITY TO INSTALL A SUPPLEMENTAL GROUNDING ELECTRODE.
  - AC SYSTEM GROUNDING ELECTRODE CONDUCTOR (GEC) SHALL BE A MINIMUM SIZE #8AWG WHEN INSULATED, #6AWG IF BARE WIRE.
  - EQUIPMENT GROUNDING CONDUCTORS SHALL BE SIZED ACCORDING TO NEC ARTICLE 690.45, AND BE A MINIMUM OF #10AWG WHEN NOT EXPOSED TO DAMAGE, AND #6AWG SHALL BE USED WHEN EXPOSED TO DAMAGE
  - GROUNDING AND BONDING CONDUCTORS, IF INSULATED, SHALL BE COLOR CODED GREEN, OR MARKED GREEN IF #4AWG OR LARGER



GRID-TIED SOLAR POWER SYSTEM

3367 APRES SKI WAY  
STEAMBOAT SPRINGS, CO 80487

SINGLE-LINE  
DIAGRAM

PROJECT ID: 102515

DATE: 12/11/18

CREATED BY: C.M.


CHECKED BY:

REVISIONS

|  |  |
|--|--|
|  |  |
|  |  |
|  |  |

PV-3



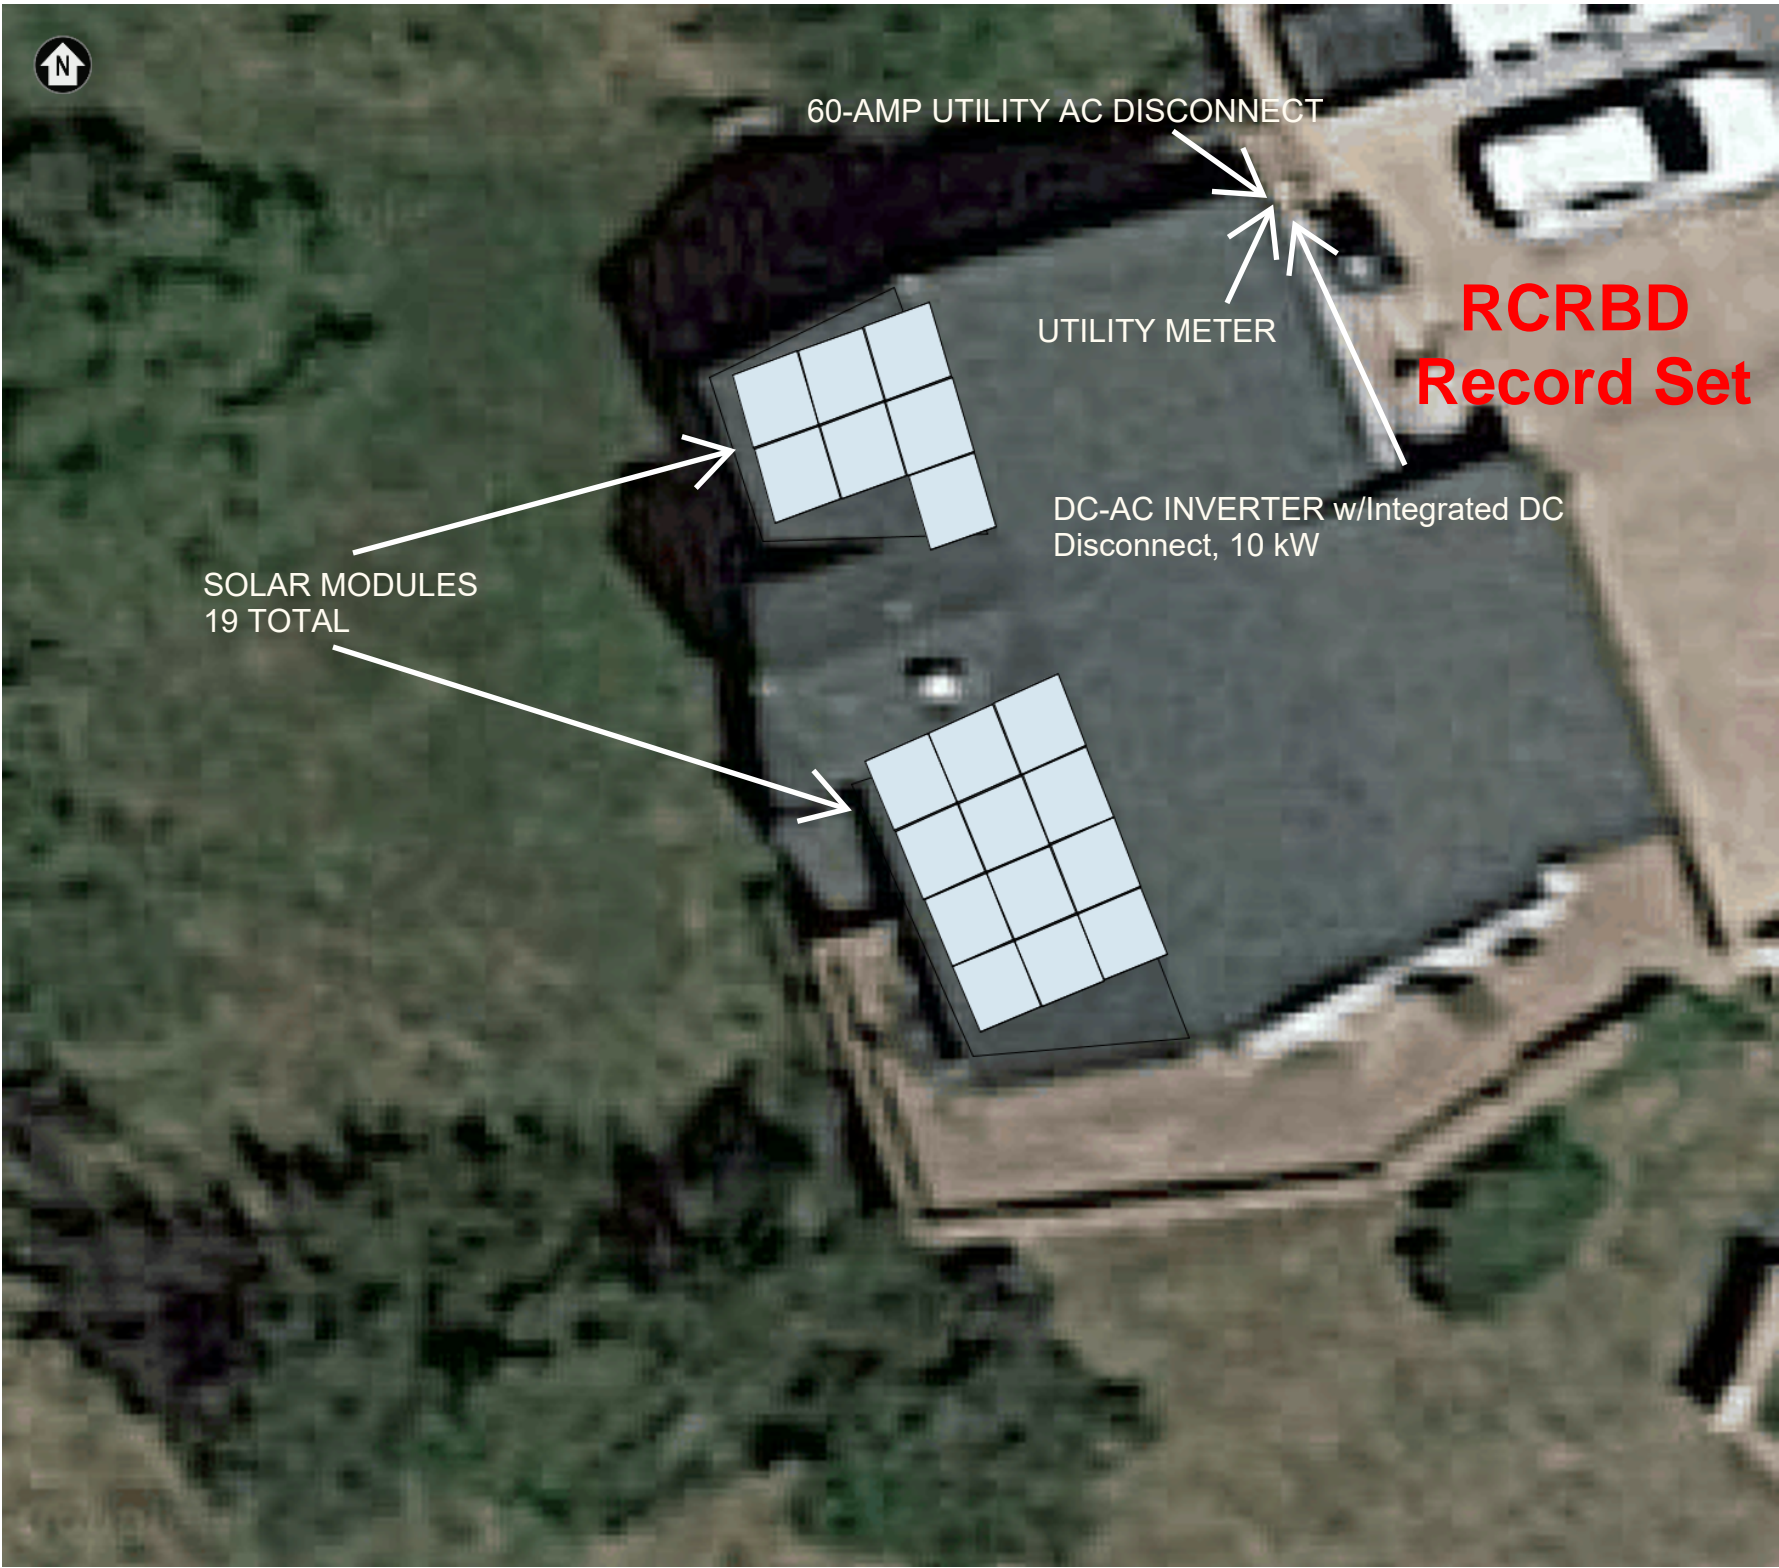


1 SITE PLAN (AERIAL VIEW)  
PV-2 SCALE: 1" = 10'

| GENERAL NOTES |   |
|---------------|---|
| 1             | EQUIPMENT LIKELY TO BE WORKED UPON WHILE ENERGIZED SHALL BE INSTALLED IN LOCATIONS THAT SATISFY MINIMUM WORKING CLEARANCES PER NEC 110.26.  |
| 2             | CONTRACTOR SHALL USE ONLY COMPONENTS LISTED BY A NATIONALLY RECOGNIZED TESTING LABORATORY FOR THE INTENDED USE.   |
| 3             | CONTRACTOR IS RESPONSIBLE FOR FURNISHING ALL EQUIPMENT, CABLES, ADDITIONAL CONDUITS, RACEWAYS, AND OTHER ACCESSORIES NECESSARY FOR A COMPLETE AND OPERATIONAL PV SYSTEM.  |
| 4             | WHERE DC PV SOURCE OR DC PV OUTPUT CIRCUITS ARE RUN INSIDE THE BUILDING, THEY SHALL BE CONTAINED IN METAL RACEWAYS, TYPE MC METAL-CLAD CABLE, OR METAL ENCLOSURES FROM THE POINT OF PENETRATION INTO THE BUILDING TO THE FIRST READILY ACCESSIBLE DISCONNECTING MEANS, PER NEC 690.31(G). |

P-102515



GRID-TIED SOLAR POWER SYSTEM

3367 APRES SKI WAY  
STEAMBOAT SPRINGS, CO 80487

SITE PLAN

DOC ID: 102515-128868-1  
DATE: 12/11/18  
CREATOR: C.M.  
REVIEWER:


REVISIONS

|  |  |
|--|--|
|  |  |
|  |  |
|  |  |




PV-2

# RCRBD Record Set

## ROOF ATTACHMENT PLAN - 19 MODULE SOLAR-ELECTRIC INSTALLATION

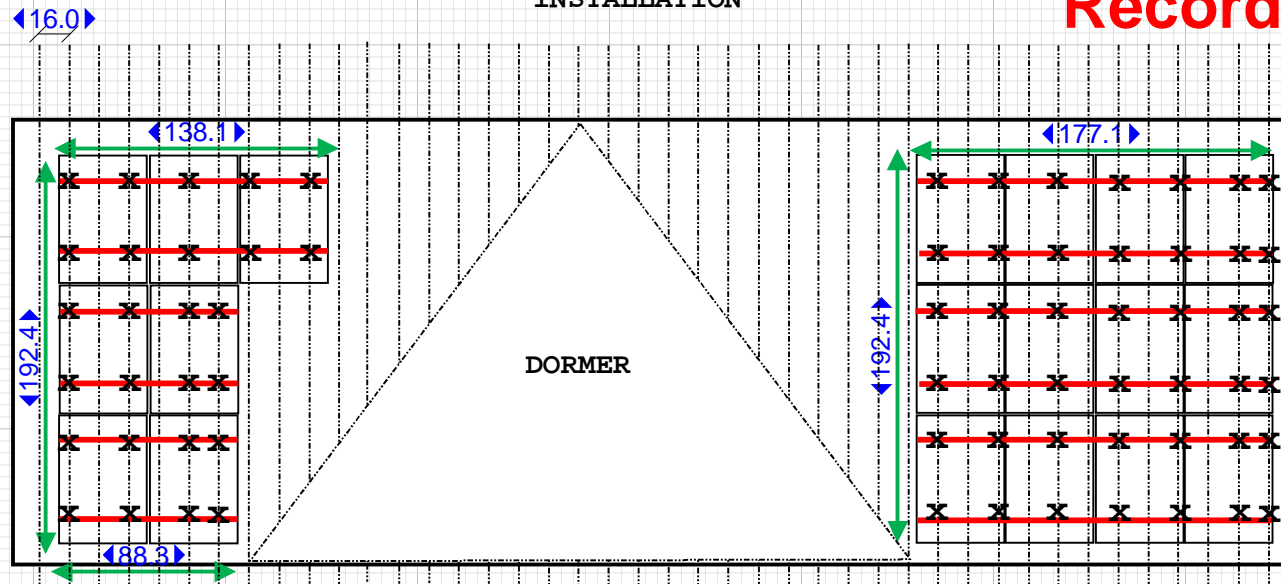

### LEGEND

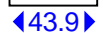 -  = SOLARIA POWERXT  
345-WATT SOLAR MODULE
-  = SNAPNRACK  
ALUMINUM RAILS
-  = 5/16" SS LAG BOLT

|        |   |                     |                 |                       |  |  |
|--------|---|---------------------|-----------------|-----------------------|--|--|
| SITE:  | 3367 Apres Ski Way, Steamboat Springs, CO 80487 | DRAWING: 801551     | PROJECT: 000097 | DRAWN: Colin McCauley | NOTES: South Facing Roofspace, 38 Degree Slope | Sunwise Solar, LLC<br>Steamboat Springs, CO - 80487<br>(970)-819-0840<br>Colin@Sunwise-Solar.com |
| TITLE: | 19 Module Solar-Electric Array<br>6.55 kW       | SCALE: 1/4" = 1'-0" | DATE: 11/5/2018 | REV: B                |  |  |

# RCRBD Record Set

December 11, 2018

Michael Ehrlich Structural Engineering Inc  
PO Box 772393  
Steamboat Springs, CO 80477

To: Sunwise Solar

Re: Solar Panel Addition  
3367 Apres Ski Way  
Steamboat Springs, CO

Per your request we have evaluated the structural adequacy of the existing roof for the proposed solar panel installation and find it acceptable.

There will be nineteen Solaria 345 Modules on the southernmost facing 38 degree sloped roof, installed with the Snaprack TDS standard rail system. It is our understanding that you will install three rows of module racks on either side of the dormer as shown in the attached diagram.

Each module group is 63.8" long x 43.9" wide. There will be two rails space about 40" inches apart running horizontal on the roof to attach the modules to. The rails attach to the flash L-feet. The modules attach to the rails with the mid clamps. The Snap n Rack's corrugated straddle block will be used to connect the L-Feet to the roof structure over the peaks, or hexagonal blocks when the rafter to lag into is over a flat valley. These will be sealed using a EPDM ring around the base/top depending on clip used, so will be water-tight to the composite shingle roof.

It is our understanding that the existing roof trusses are 2" x 12" spaced at 16" oc. There will be 68 attachments as shown. The standard 5/16" diameter x 4" lag bolts will be used. The rack is rated for spans up to 40". The lag bolts should be at every other rafter so that the longest spacing between supports is 32". All cantilevers should be less than 16.5".

Plans for the existing house could not be located. The existing trusses should be field verified for load stamp.

Please contact me if you have any questions.


*Michael Ehrlich*

Michael Ehrlich, president




|  |                      |   |
|--|----------------------|---|
| DESCRIPTION:<br><br>SNAPNRACK, STANDARD RAIL   | DRAWN BY:<br>P. Ryan | <div>SnapNrack™<br/>Solar Mounting Solutions</div><br><div>595 MARKET STREET, 29TH FLOOR • SAN FRANCISCO, CA 94105 USA<br/>PHONE (415) 580-6900 • FAX (415) 580-6902</div><br><div>THE INFORMATION IN THIS DRAWING IS CONFIDENTIAL AND PROPRIETARY. ANY REPRODUCTION, DISCLOSURE, OR USE THEREOF IS PROHIBITED WITHOUT THE WRITTEN CONSENT OF SUNRUN SOUTH LLC.</div> |
| PART NUMBER(S):<br><br>232-01067, 232-01068, 232-01069, 232-01070,<br>232-02112, 232-02113 | REVISION:<br><br>A   |   |

RCRBD  
Record Set

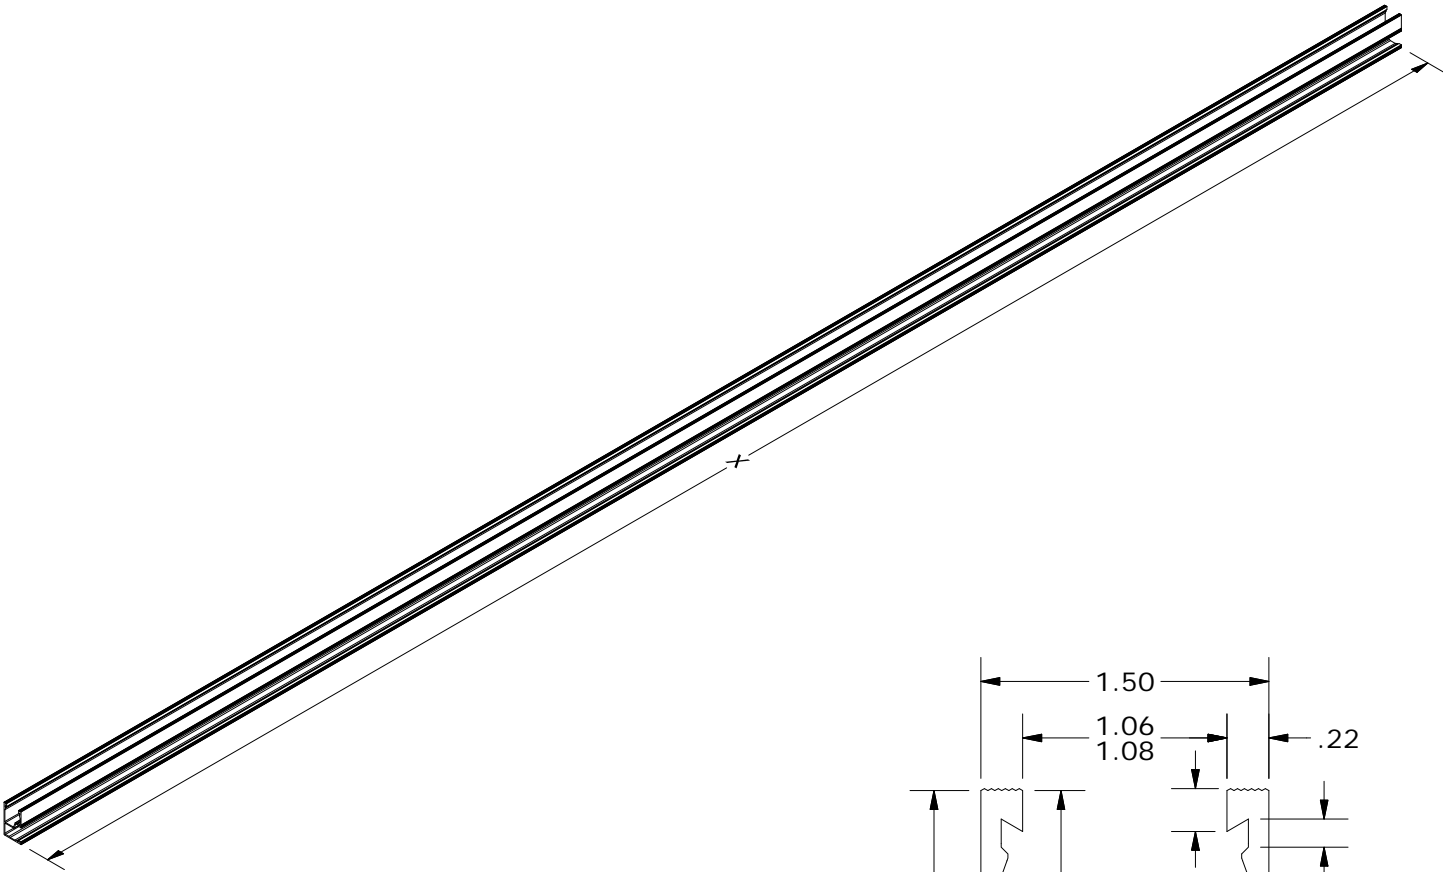

| STANDARD RAIL PROPERTIES |                 |        |
|--------------------------|-----------------|--------|
| SKU                      | RAIL LENGTH (X) | FINISH |
| 232-01067                | 122"            | BLACK  |
| 232-01068                | 122"            | CLEAR  |
| 232-01069                | 162"            | BLACK  |
| 232-01070                | 162"            | CLEAR  |
| 232-02112                | 122"            | MILL   |
| 232-02113                | 162"            | MILL   |

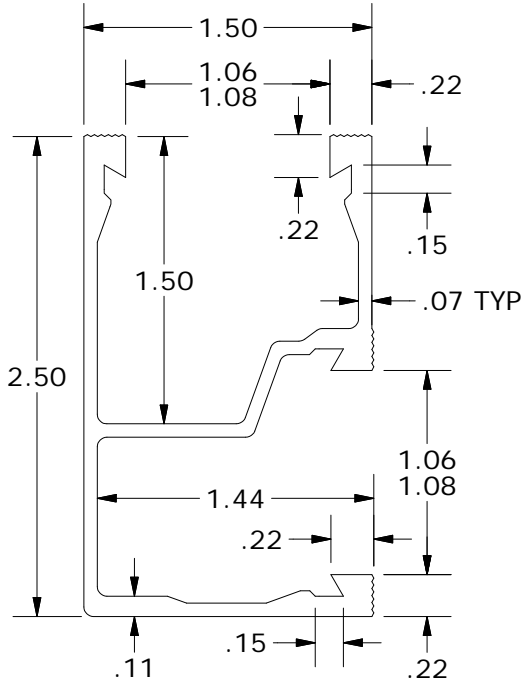


ALL DIMENSIONS IN INCHES

|                       |                       |                        |
|-----------------------|-----------------------|------------------------|
| MATERIALS:            | 6000 SERIES ALUMINUM  | OPTIONS:               |
| DESIGN LOAD (LBS):    | N/A                   | CLEAR / BLACK ANODIZED |
| ULTIMATE LOAD (LBS):  | N/A                   | MILL FINISH            |
| TORQUE SPECIFICATION: | N/A LB-FT             | 122" / 162" LENGTHS    |
| CERTIFICATION:        | UL 2703, FILE E359313 | BOXES OF 2 / 6         |
| WEIGHT (LBS):         | 7.65 - 10.16          | BUNDLES OF 112         |



|   |                        |   |
|---|------------------------|---|
| DESCRIPTION:<br><br>SNAPNRACK, FLASHED L FOOT                     | DRAWN BY:<br>M Matkins | <div>SnapNrack™<br/>Solar Mounting Solutions</div> <div>595 MARKET STREET, 29TH FLOOR • SAN FRANCISCO, CA 94105 USA<br/>PHONE (415) 580-6900 • FAX (415) 580-6902</div> <div>THE INFORMATION IN THIS DRAWING IS CONFIDENTIAL AND PROPRIETARY. ANY REPRODUCTION, DISCLOSURE, OR USE THEREOF IS PROHIBITED WITHOUT THE WRITTEN CONSENT OF SUNRUN SOUTH LLC.</div> |
| PART NUMBER(S):<br><br>242-92047, 242-92048, 242-92050, 242-92051 | REVISION:<br>A         |   |

RCRBD  
Record Set

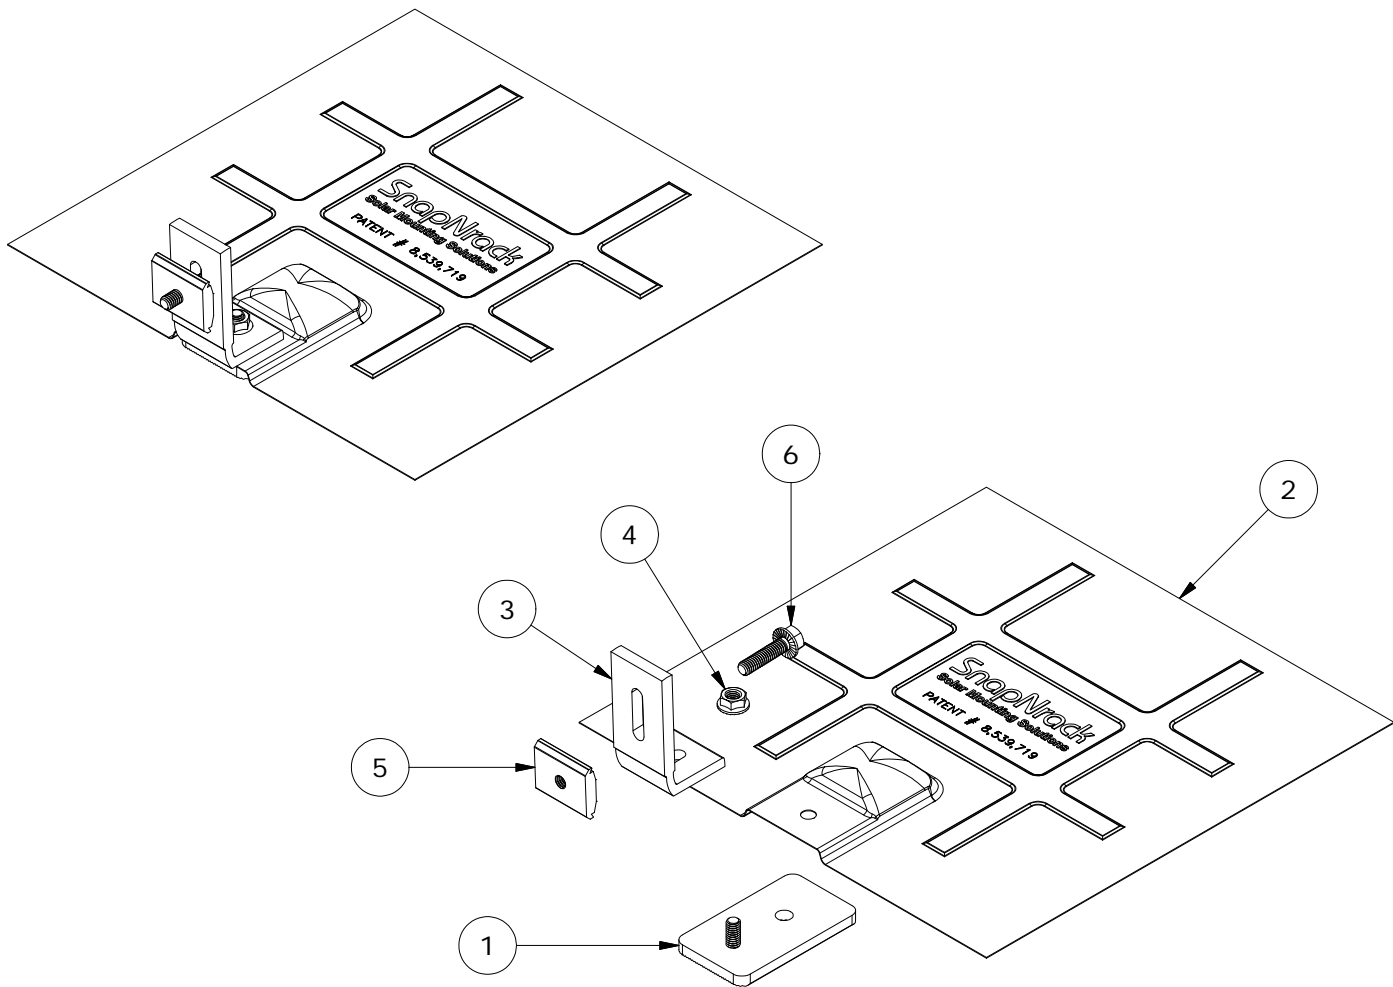

| PARTS LIST |     |   |
|------------|-----|---|
| ITEM       | QTY | DESCRIPTION   |
| 1          | 1   | SNAPNRACK, L FOOT BASE, MILL                        |
| 2          | 1   | SNAPNRACK, L FOOT FLASHING, 12IN X 12IN, BLACK GALV |
| 3          | 1   | SNAPNRACK L FOOT, COMPOSITION 92DEG, CLEAR / BLACK  |
| 4          | 1   | NUT, FLANGE, SERRATED, 5/16IN-18, SS                |
| 5          | 1   | SNAPNRACK CHANNEL NUT 5/16IN-18                     |
| 6          | 1   | BOLT, FLANGED HEX, 5/16IN-18 X 1-1/4IN, SS          |

|                       |                                       |                            |
|-----------------------|---------------------------------------|----------------------------|
| MATERIALS:            | 6000 SERIES ALUMINUM, STAINLESS STEEL | OPTIONS:                   |
| DESIGN LOAD (LBS):    | 309 UP, 1469 DOWN, 251 SIDE           | CLEAR / BLACK ANODIZED     |
| ULTIMATE LOAD (LBS):  | 928 UP, 4406 DOWN, 754 SIDE           | GALV STEEL / ALUM FLASHING |
| TORQUE SPECIFICATION: | 10+ LB-FT                             |                            |
| CERTIFICATION:        | UL 2703, FILE E359313                 |                            |
| WEIGHT (LBS):         | 0.90 - 1.25                           |                            |

DESCRIPTION:

## SNAPNRACK, FLASHED L FOOT

DRAWN BY:

RD Watkins

REVISION:

A




PART NUMBER(S):

242-92047, 242-92048, 242-92050, 242-92051

SnapNrack™  
Solar Mounting Solutions

595 MARKET STREET, 29TH FLOOR • SAN FRANCISCO, CA 94105 USA  
PHONE (415) 580-6900 • FAX (415) 580-6902


THE INFORMATION IN THIS DRAWING IS CONFIDENTIAL AND PROPRIETARY. ANY REPRODUCTION, DISCLOSURE, OR USE THEREOF IS PROHIBITED WITHOUT THE WRITTEN CONSENT OF SUNRUN SOUTH LLC

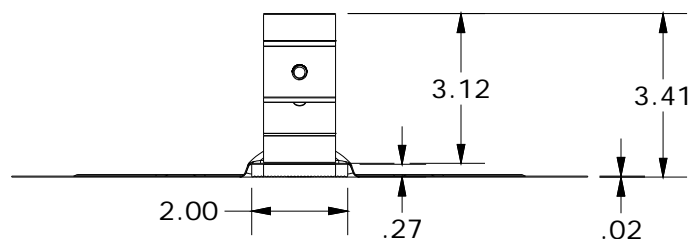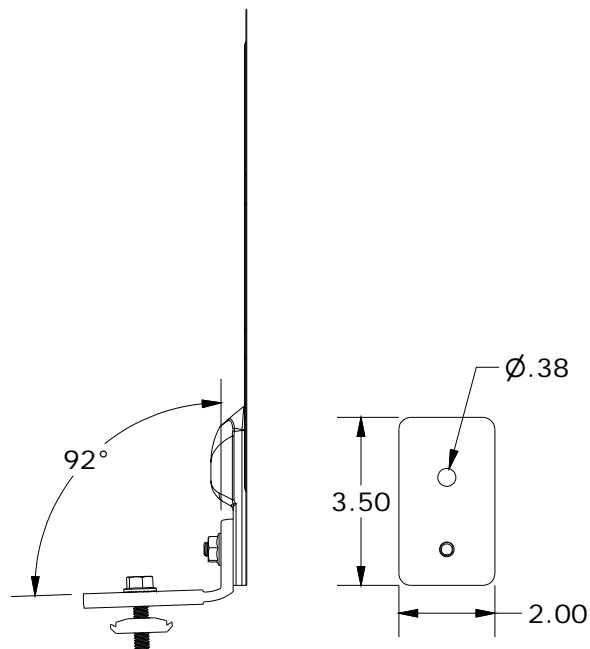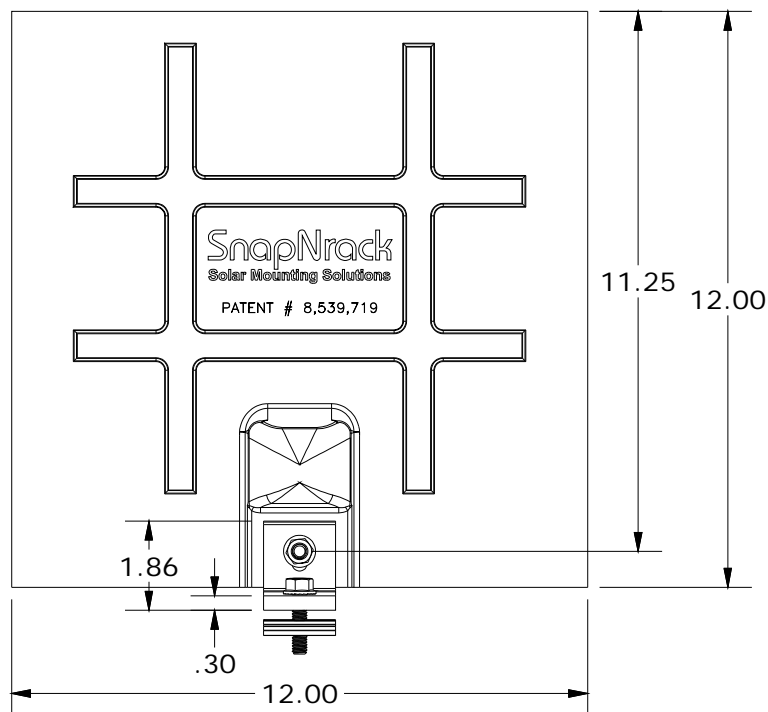



| FLASHED L FOOT PROPERTIES |                   |               |
|---------------------------|-------------------|---------------|
| SKU                       | FLASHING MATERIAL | L FOOT FINISH |
| 242-92047                 | SILVER ALUMINUM   | CLEAR         |
| 242-92048                 | BLACK ALUMINUM    | BLACK         |
| 242-92050                 | BLACK GALV STEEL  | CLEAR         |
| 242-92051                 | BLACK GALV STEEL  | BLACK         |

ALL DIMENSIONS IN INCHES



|   |           |   |
|---|-----------|---|
| DESCRIPTION:  | DRAWN BY: |   |
| SNAPNRACK, BONDING MID CLAMP  | D. Ryan   |   |
| PART NUMBER(S):   | REVISION: | 595 MARKET STREET, 29TH FLOOR • SAN FRANCISCO, CA 94105 USA<br>PHONE (415) 580-6900 • FAX (415) 580-6902<br><br><small>THE INFORMATION IN THIS DRAWING IS CONFIDENTIAL AND PROPRIETARY. ANY REPRODUCTION, DISCLOSURE, OR USE THEREOF IS PROHIBITED WITHOUT THE WRITTEN CONSENT OF SUNRUN SOUTH LLC.</small> |
| 242-02050, 242-02051, 242-02052, 242-02053,<br>242-02054, 242-02055, 242-02056, 242-02057 |           |   |

RCRBD  
Record Set  
A

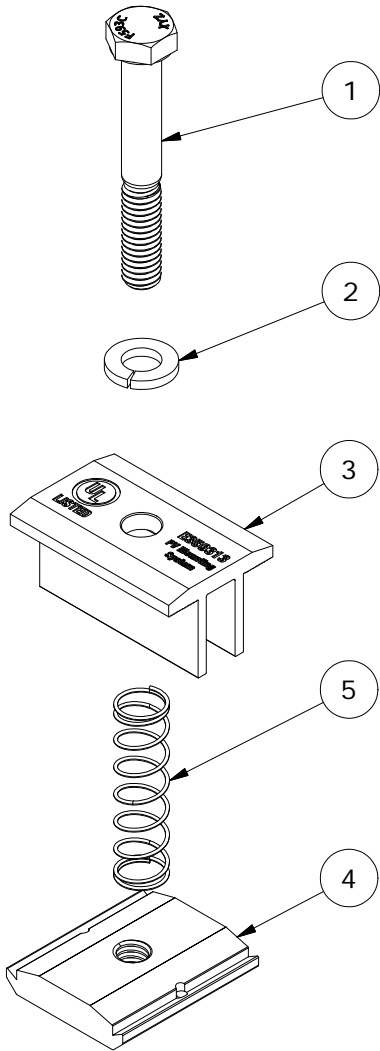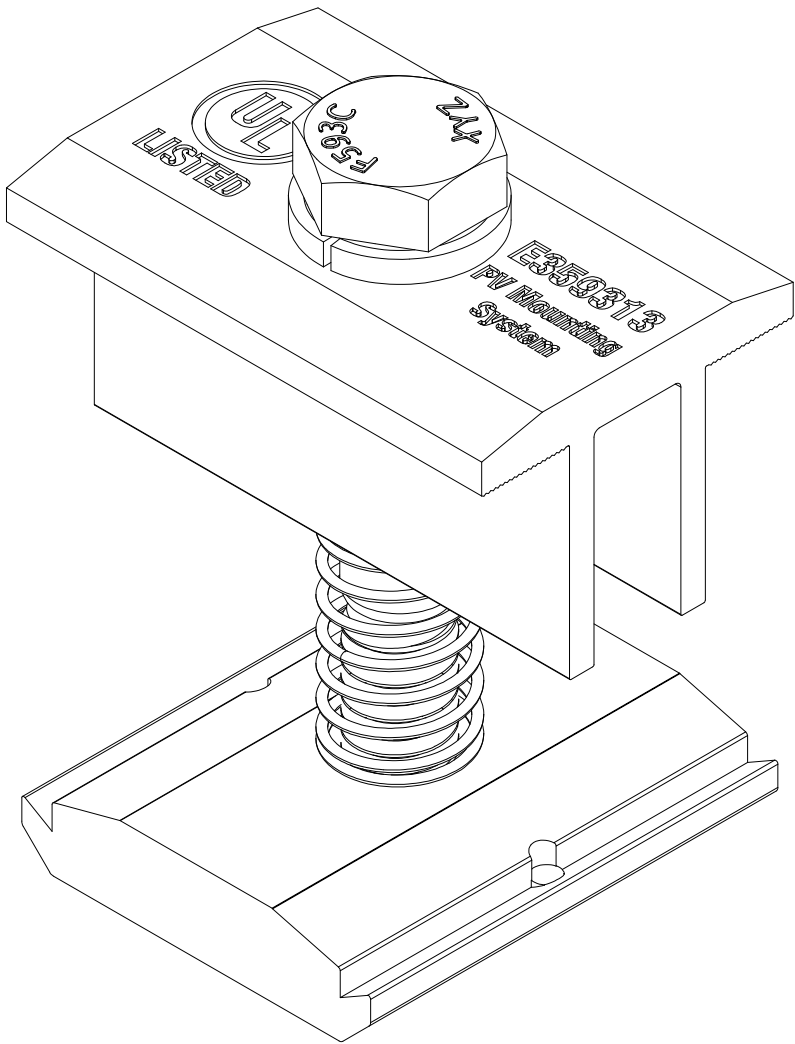


| PARTS LIST |     |   |
|------------|-----|---|
| ITEM       | QTY | DESCRIPTION   |
| 1          | 1   | 5/16IN-18 SS HCS BOLT, LENGTH VARIES, CLEAR / BLACK |
| 2          | 1   | 5/16IN SS SPLIT LOCK WASHER, CLEAR / BLACK          |
| 3          | 1   | SNAPNRACK, BONDING MID CLAMP, CLEAR / BLACK         |
| 4          | 1   | SNAPNRACK, BONDING CHANNEL NUT                      |
| 5          | 1   | SNAPNRACK, MID CLAMP SPRING, SS                     |



|                       |                                       |                        |
|-----------------------|---------------------------------------|------------------------|
| MATERIALS:            | 6000 SERIES ALUMINUM, STAINLESS STEEL | OPTIONS:               |
| DESIGN LOAD (LBS):    | 800                                   | CLEAR / BLACK ANODIZED |
| ULTIMATE LOAD (LBS):  | 2400                                  |                        |
| TORQUE SPECIFICATION: | 10+ LB-FT                             |                        |
| CERTIFICATION:        | UL 2703, FILE E359313                 |                        |
| WEIGHT (LBS):         | 0.16 - 0.18                           |                        |

|  |                      |   |
|--|----------------------|---|
| DESCRIPTION:<br><br>SNAPNRACK, BONDING MID CLAMP   | DRAWN BY:<br>D. Ryan | <div>SnapNrack™<br/>Solar Mounting Solutions</div><br><div>595 MARKET STREET, 29TH FLOOR • SAN FRANCISCO, CA 94105 USA<br/>PHONE (415) 580-6900 • FAX (415) 580-6902</div><br><div>THE INFORMATION IN THIS DRAWING IS CONFIDENTIAL AND PROPRIETARY. ANY<br/>REPRODUCTION, DISCLOSURE, OR USE THEREOF IS PROHIBITED WITHOUT THE<br/>WRITTEN CONSENT OF SUNRUN SOUTH LLC.</div> |
| PART NUMBER(S):<br><br>242-02050, 242-02051, 242-02052, 242-02053,<br>242-02054, 242-02055, 242-02056, 242-02057 | REVISION:<br>A       |   |

RCRBD  
Record Set

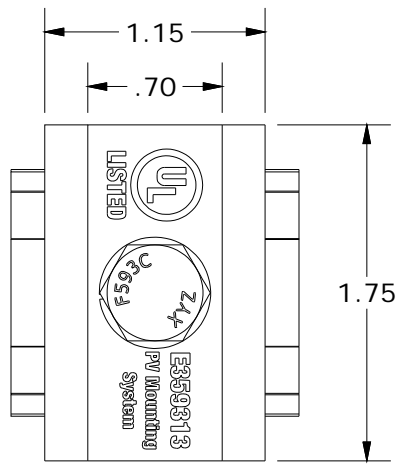

| MID CLAMP PROPERTIES |                 |        |
|----------------------|-----------------|--------|
| SKU                  | BOLT LENGTH (X) | FINISH |
| 242-02050            | 2.25"           | CLEAR  |
| 242-02051            | 2.50"           | CLEAR  |
| 242-02052            | 2.75"           | CLEAR  |
| 242-02053            | 2.25"           | BLACK  |
| 242-02054            | 2.50"           | BLACK  |
| 242-02055            | 2.75"           | BLACK  |
| 242-02056            | 3.00"           | CLEAR  |
| 242-02057            | 3.00"           | BLACK  |

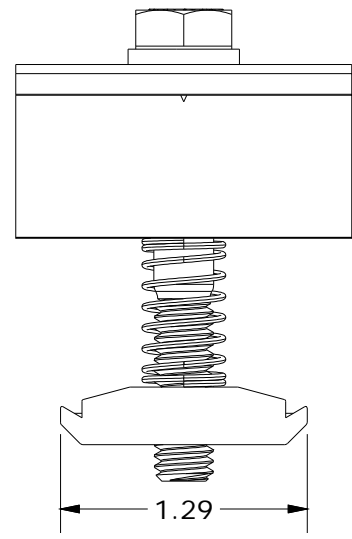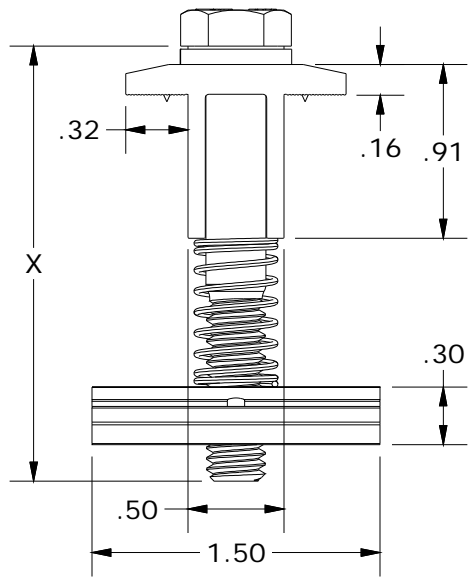



Solaria PowerXT® | Residential



Solaria PowerXT®-350R-PD | Solaria PowerXT®-345R-BD

Achieving up to 19.4% efficiency, Solaria PowerXT solar modules are one of the highest power modules in the residential solar market. Compared to conventional modules, Solaria PowerXT modules have fewer gaps between the solar cells; this leads to higher power and superior aesthetics. Solaria PowerXT residential modules are manufactured with black backsheet and frames, giving them a striking appearance.

Developed in California, Solaria's patented cell cutting and module assembly takes processed solar wafers and turns them into PowerXT solar modules. The process starts by creating a highly reliable PowerXT cell where busbars and ribbon interconnections are eliminated. Solaria then packages the cells into the PowerXT solar module, reducing inactive space between the cells. All of the above leads to an exceptionally efficient solar module produced in a cost effective manner.

Higher Efficiency, Higher Power

Solaria PowerXT modules achieve up to 19.4% efficiency; conventional modules achieve 15% – 17% efficiency. Solaria PowerXT modules are one of the highest power modules available.

Lower System Costs

Solaria PowerXT modules produce more power per square meter area. This reduces installation costs due to fewer balance of system components.

Improved Shading Tolerance

Sub-strings are interconnected in parallel, within each of the four module quadrants, which dramatically lowers the shading losses and boosts energy yield.

Improved Aesthetics

Compared to conventional modules, Solaria PowerXT modules have a more uniform appearance and superior aesthetics.

Durability and Reliability

Solder-less cell interconnections are highly reliable and designed to far exceed the industry leading 25 year warranty.



About Solaria

Established in 2000, The Solaria Corporation has created one of the industry's most respected IP portfolios, with over 100 patents encompassing materials, processes, applications, products, manufacturing automation and equipment. Headquartered in Fremont, California, Solaria has developed a technology platform that unlocks the potential of solar energy allowing it to be ubiquitous and universally accessed.




Solaria PowerXT®-350R-PD  
Solaria PowerXT®-345R-BD

| Performance at STC (1000W/m², 25° C, AM 1.5) |     |         |         |         |         |
|--|-----|---------|---------|---------|---------|
| Solaria PowerXT-                             |     | 340R-BD | 345R-BD | 345R-PD | 350R-PD |
| Max Power (P <sub>max</sub> )                | [W] | 340     | 345     | 345     | 350     |
| Efficiency                                   | [%] | 18.8    | 19.1    | 19.1    | 19.4    |
| Open Circuit Voltage (V <sub>oc</sub> )      | [V] | 46.9    | 47.1    | 46.9    | 47.1    |
| Short Circuit Current (I <sub>sc</sub> )     | [A] | 9.36    | 9.40    | 9.46    | 9.49    |
| Max Power Voltage (V <sub>mp</sub> )         | [V] | 38.6    | 38.9    | 38.5    | 38.8    |
| Max Power Current (I <sub>mp</sub> )         | [A] | 8.79    | 8.88    | 8.93    | 9.02    |
| Power Tolerance                              | [%] | -0/+3   | -0/+3   | -0/+3   | -0/+3   |


| Performance at NOCT (800W/m², 20°C Amb, Wind 1 m/s, AM 1.5) |     |      |      |      |      |
|---|-----|------|------|------|------|
| Max Power (P <sub>max</sub> )                               | [W] | 252  | 255  | 255  | 259  |
| Open Circuit Voltage (V <sub>oc</sub> )                     | [V] | 44.1 | 44.3 | 44.1 | 44.3 |
| Short Circuit Current (I <sub>sc</sub> )                    | [A] | 7.58 | 7.61 | 7.66 | 7.69 |
| Max Power Voltage (V <sub>mp</sub> )                        | [V] | 35.5 | 35.8 | 35.4 | 35.7 |
| Max Power Current (I <sub>mp</sub> )                        | [A] | 7.03 | 7.10 | 7.15 | 7.22 |

| Temperature Characteristics      |          |         |
|----------------------------------|----------|---------|
| NOCT                             | [°C]     | 45 +/-2 |
| Temp. Coeff. of P <sub>max</sub> | [% / °C] | -0.39   |
| Temp. Coeff. of V <sub>oc</sub>  | [% / °C] | -0.29   |
| Temp. Coeff. of I <sub>sc</sub>  | [% / °C] | 0.04    |

| Design Parameters     |      |            |
|-----------------------|------|------------|
| Operating temperature | [°C] | -40 to +85 |
| Max System Voltage    | [V]  | 1000       |
| Max Fuse Rating       | [A]  | 15         |
| Bypass Diodes         | [#]  | 4          |

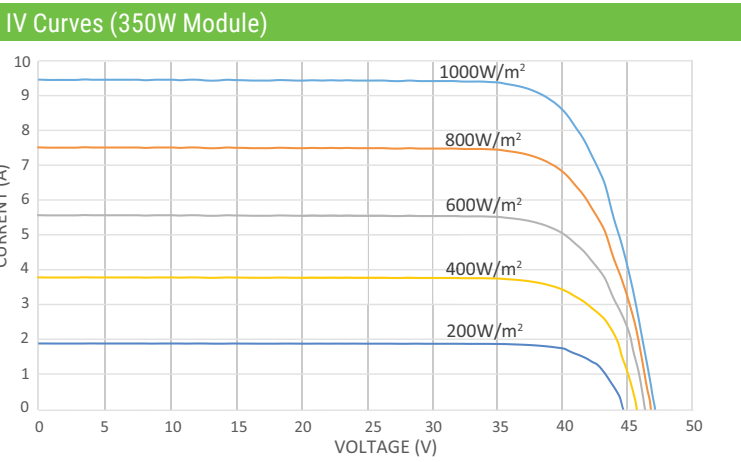

Authorized Dealer

 


| Mechanical Characteristics |                              |
|----------------------------|------------------------------|
| Cell Type                  | Monocrystalline Silicon      |
| Dimensions (L x W x H)     | 1621mm x 1116mm x 40mm       |
| Weight                     | 21 kg / 46 lbs               |
| Glass Type / Thickness     | AR Coated, Tempered / 3.2mm  |
| Frame Type                 | Anodized Aluminum            |
| Cable Type / Length        | 12 AWG PV Wire (UL) / 1000mm |
| Connector Type             | Amphenol H4 (MC4 compatible) |
| Junction Box               | IP67 / 4 diodes              |
| Front Load (UL 1703)       | 5400 Pa / 113 psf            |
| Rear Load (UL 1703)        | 3600 Pa / 75 psf             |

| Certifications / Warranty |                                 |
|---------------------------|---------------------------------|
| Certifications            | UL 1703/IEC 61215/IEC 61730/CEC |
| Fire Type (UL 1703)       | 1                               |
| Power & Product Warranty  | 25 years*                       |

\* Warranty details at [www.solaria.com](http://www.solaria.com)

| Packaging                 |                         |
|---------------------------|-------------------------|
| Stacking Method           | Horizontal / Palletized |
| Pcs / Pallet              | 25                      |
| Pallet Dims (L x W x H)   | 1685 x 1150 x 1230 mm   |
| Pallet Weight             | 590 kg / 1300 lbs       |
| Pallets / 40-ft Container | 28                      |
| Pcs / 40-ft Container     | 700                     |

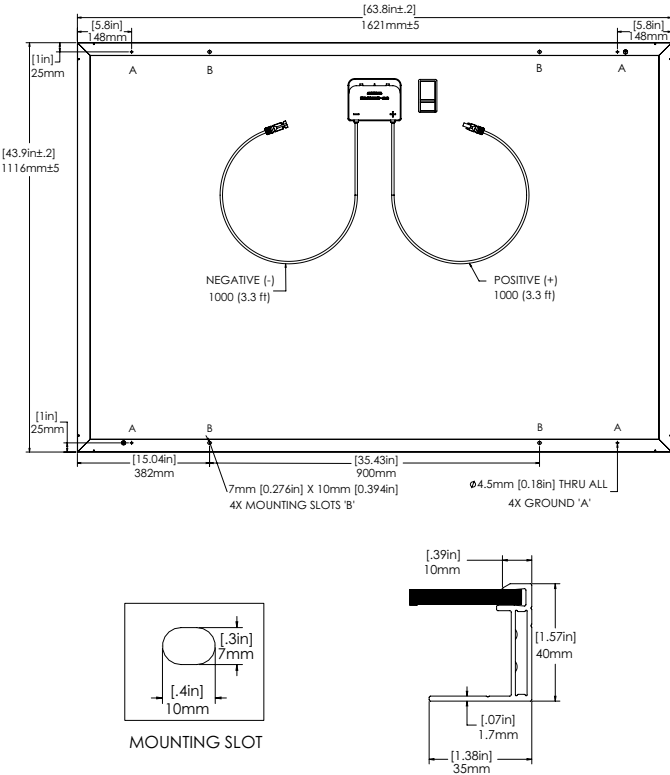



# SolarEdge Power Optimizer

## Module Add-On For North America

P320 / P370 / P400 / P405 / P505



POWER OPTIMIZER

### PV power optimization at the module-level

- Specifically designed to work with SolarEdge inverters
- Up to 25% more energy
- Superior efficiency (99.5%)
- Mitigates all types of module mismatch losses, from manufacturing tolerance to partial shading
- Flexible system design for maximum space utilization
- Fast installation with a single bolt
- Next generation maintenance with module-level monitoring
- Compliant with arc fault protection and rapid shutdown NEC requirements (when installed as part of the SolarEdge system)
- Module-level voltage shutdown for installer and firefighter safety



# SolarEdge Power Optimizer

## Module Add-On for North America

P320 / P370 / P400 / P405 / P505

| OPTIMIZER MODEL<br>(typical module compatibility)  | P320<br>(for high-power<br>60-cell modules)          | P370<br>(for higher-power<br>60 and 72-cell<br>modules) | P400<br>(for 72 & 96-cell<br>modules) | P405<br>(for thin film<br>modules) | P505<br>(for higher<br>current modules) |         |
|--|--|---|---------------------------------------|------------------------------------|---|---------|
| INPUT  |  |   |                                       |                                    |   |         |
| Rated Input DC Power <sup>(1)</sup>  | 320  | 370   | 400                                   | 405                                | 505                                     | W       |
| Absolute Maximum Input Voltage<br>(Voc at lowest temperature)  | 48   | 60  | 80                                    | 125                                | 83                                      | Vdc     |
| MPPT Operating Range   | 8 - 48   | 8 - 60  | 8 - 80                                | 12.5 - 105                         | 12.5 - 83                               | Vdc     |
| Maximum Short Circuit Current (Isc)  | 11   |   | 10.1                                  |                                    | 14                                      | Adc     |
| Maximum DC Input Current   | 13.75  |   | 12.63                                 |                                    | 17.5                                    | Adc     |
| Maximum Efficiency   | 99.5   |   |                                       |                                    |   | %       |
| Weighted Efficiency  | 98.8   |   |                                       | 98.6                               |   | %       |
| Overvoltage Category   | II   |   |                                       |                                    |   |         |
| OUTPUT DURING OPERATION (POWER OPTIMIZER CONNECTED TO OPERATING SOLAREEDGE INVERTER)                     |  |   |                                       |                                    |   |         |
| Maximum Output Current   | 15   |   |                                       |                                    |   | Adc     |
| Maximum Output Voltage   | 60   |   |                                       | 85                                 |   | Vdc     |
| OUTPUT DURING STANDBY (POWER OPTIMIZER DISCONNECTED FROM SOLAREEDGE INVERTER OR SOLAREEDGE INVERTER OFF) |  |   |                                       |                                    |   |         |
| Safety Output Voltage per Power Optimizer  | 1 ± 0.1  |   |                                       |                                    |   | Vdc     |
| STANDARD COMPLIANCE  |  |   |                                       |                                    |   |         |
| EMC  | FCC Part15 Class B, IEC61000-6-2, IEC61000-6-3       |   |                                       |                                    |   |         |
| Safety   | IEC62109-1 (class II safety), UL1741                 |   |                                       |                                    |   |         |
| RoHS   | Yes  |   |                                       |                                    |   |         |
| INSTALLATION SPECIFICATIONS  |  |   |                                       |                                    |   |         |
| Maximum Allowed System Voltage   | 1000   |   |                                       |                                    |   | Vdc     |
| Compatible inverters   | All SolarEdge Single Phase and Three Phase inverters |   |                                       |                                    |   |         |
| Dimensions (W x L x H)   | 128 x 152 x 28 / 5 x 5.97 x 1.1                      | 128 x 152 x 36 / 5 x 5.97 x 1.42                        | 128 x 152 x 50 / 5 x 5.97 x 1.96      | 128 x 152 x 59 / 5 x 5.97 x 2.32   |   | mm / in |
| Weight (including cables)  | 630 / 1.4  | 750 / 1.7   | 845 / 1.9                             | 1064 / 2.3                         |   | gr / lb |
| Input Connector  | MC4 <sup>(2)</sup>                                   |   |                                       |                                    |   |         |
| Output Wire Type / Connector   | Double Insulated; MC4                                |   |                                       |                                    |   |         |
| Output Wire Length   | 0.95 / 3.0   | 1.2 / 3.9   |                                       |                                    |   | m / ft  |
| Operating Temperature Range  | -40 - +85 / -40 - +185                               |   |                                       |                                    |   | °C / °F |
| Protection Rating  | IP68 / NEMA6P  |   |                                       |                                    |   |         |
| Relative Humidity  | 0 - 100  |   |                                       |                                    |   | %       |

<sup>(1)</sup> Rated STC power of the module. Module of up to +5% power tolerance allowed.  
<sup>(2)</sup> For other connector types please contact SolarEdge

| PV SYSTEM DESIGN USING<br>A SOLAREEDGE INVERTER <sup>(3)(4)</sup> |                  | SINGLE PHASE<br>HD-WAVE                        | SINGLE PHASE | THREE PHASE 208V | THREE PHASE 480V  |   |
|---|------------------|--|--------------|------------------|-------------------|---|
| Minimum String Length<br>(Power Optimizers)                       | P320, P370, P400 | 8  |              | 10               | 18                |   |
|   | P405 / P505      | 6  |              | 8                | 14                |   |
| Maximum String Length<br>(Power Optimizers)                       |                  | 25   |              | 25               | 50 <sup>(5)</sup> |   |
| Maximum Power per String  |                  | 5700 (6000 with<br>SE7600H-US,<br>SE10000H-US) | 5250         | 6000             | 12750             | W |
| Parallel Strings of Different Lengths<br>or Orientations          |                  | Yes  |              |                  |                   |   |

<sup>(3)</sup> For detailed string sizing information refer to: [http://www.solaredge.com/sites/default/files/string\\_sizing\\_na.pdf](http://www.solaredge.com/sites/default/files/string_sizing_na.pdf).  
<sup>(4)</sup> It is not allowed to mix P405/P505 with P320/P370/P400/P600/P700/P800 in one string.  
<sup>(5)</sup> A string with more than 30 optimizers does not meet NEC rapid shutdown requirements; safety voltage will be above the 30V requirement







SolarEdge Single Phase Inverters for North America

SE3000H-US / SE3800H-US / SE5000H-US / SE6000H-US / SE7600H-US / SE10000H-US / SE11400H-US



Optimized installation with HD-Wave technology

- Specifically designed to work with power optimizers
- Record-breaking efficiency
- Fixed voltage inverter for longer strings
- Integrated arc fault protection and rapid shutdown for NEC 2014 and 2017, per article 690.11 and 690.12
- UL1741 SA certified, for CPUC Rule 21 grid compliance
- Extremely small
- High reliability without any electrolytic capacitors
- Built-in module-level monitoring
- Outdoor and indoor installation
- Optional: Revenue grade data, ANSI C12.20 Class 0.5 (0.5% accuracy)
- Simple configuration and commissioning with smartphone app and built in Wi-Fi (SE10000H-US, SE11400H-US)



INVERTERS



Single Phase Inverters for North America

SE3000H-US / SE3800H-US / SE5000H-US / SE6000H-US/ SE7600H-US / SE10000H-US / SE11400H-US

|   | SE3000H-US  | SE3800H-US               | SE5000H-US  | SE6000H-US  | SE7600H-US  | SE10000H-US                               | SE11400H-US                               |           |
|---|---|--------------------------|-------------|-------------|---|---|---|-----------|
| OUTPUT  |   |                          |             |             |   |   |   |           |
| Rated AC Power Output   | 3000  | 3800 @240V<br>3300 @208V | 5000        | 6000        | 7600  | 10000                                     | 11400                                     | VA        |
| Max. AC Power Output  | 3000  | 3800 @240V<br>3300 @208V | 5000        | 6000        | 7600  | 10000                                     | 11400                                     | VA        |
| AC Output Voltage Min.-Nom.-<br>Max. (183 - 208 - 229)                          | -   | ✓                        | ✓           | -           | -   | -   | -   | Vac       |
| AC Output Voltage Min.-Nom.-<br>Max. (211 - 240 - 264)                          | ✓   | ✓                        | ✓           | ✓           | ✓   | ✓   | ✓   | Vac       |
| AC Frequency (Nominal)  | 59.3 - 60 - 60.5 <sup>(1)</sup>   |                          |             |             |   |   |   | Hz        |
| Maximum Continuous Output<br>Current 208V                                       | -   | 16                       | 24          | -           | -   | -   | -   | A         |
| Maximum Continuous Output<br>Current 240V                                       | 12.5  | 16                       | 21          | 25          | 32  | 42  | 47.5                                      | A         |
| GFDI Threshold  | 1   |                          |             |             |   |   |   | A         |
| Utility Monitoring, Islanding<br>Protection, Country Configurable<br>Thresholds | Yes   |                          |             |             |   |   |   |           |
| INPUT   |   |                          |             |             |   |   |   |           |
| Maximum DC Power  | 4650  | 5900                     | 7750        | 9300        | 11800   | 15500                                     | 17670                                     | W         |
| Transformer-less, Ungrounded  | Yes   |                          |             |             |   |   |   |           |
| Maximum Input Voltage   | 480   |                          |             |             |   |   |   | Vdc       |
| Nominal DC Input Voltage  | 380   |                          |             |             |   |   |   | Vdc       |
| Maximum Input Current 208V  | -   | 9                        | 13.5        | -           | -   | 400                                       | -   | Adc       |
| Maximum Input Current 240V  | 8.5   | 10.5                     | 13.5        | 16.5        | 20  | 27  | 30.5                                      | Adc       |
| Max. Input Short Circuit Current  | 45  |                          |             |             |   |   |   | Adc       |
| Reverse-Polarity Protection   | Yes   |                          |             |             |   |   |   |           |
| Ground-Fault Isolation Detection  | 600k $\Omega$ Sensitivity   |                          |             |             |   |   |   |           |
| Maximum Inverter Efficiency   | 99  | 99.2                     |             |             |   |   |   | %         |
| CEC Weighted Efficiency   | 99  |                          |             |             |   |   |   | %         |
| Nighttime Power Consumption   | < 2.5   |                          |             |             |   |   |   | W         |
| ADDITIONAL FEATURES   |   |                          |             |             |   |   |   |           |
| Supported Communication<br>Interfaces   | RS485, Ethernet, ZigBee (optional), Cellular (optional)                         |                          |             |             |   |   |   |           |
| Revenue Grade Data, ANSI C12.20   | Optional <sup>(2)</sup>   |                          |             |             |   |   |   |           |
| Rapid Shutdown - NEC 2014 and<br>2017 690.12                                    | Automatic Rapid Shutdown upon AC Grid Disconnect                                |                          |             |             |   |   |   |           |
| STANDARD COMPLIANCE   |   |                          |             |             |   |   |   |           |
| Safety  | UL1741, UL1741 SA, UL1699B, CSA C22.2, Canadian AFCI according to T.I.L. M-07   |                          |             |             |   |   |   |           |
| Grid Connection Standards   | IEEE1547, Rule 21, Rule 14 (Hi)   |                          |             |             |   |   |   |           |
| Emissions   | FCC Part 15 Class B   |                          |             |             |   |   |   |           |
| INSTALLATION SPECIFICATIONS   |   |                          |             |             |   |   |   |           |
| AC Output Conduit Size / AWG<br>Range   | 3/4" minimum / 20-4 AWG   |                          |             |             |   |   |   |           |
| DC Input Conduit Size / # of Strings<br>/ AWG Range                             | 3/4" minimum / 1-2 strings / 14-6 AWG   |                          |             |             |   | 3/4" minimum / 1-3 strings /<br>14-6 AWG  |   |           |
| Dimensions with Safety Switch<br>(HxWxD)  | 17.7 x 14.6 x 6.8 / 450 x 370 x 174   |                          |             |             |   | 21.3 x 14.6<br>x 7.7 / 540 x<br>370 x 195 | 21.3 x 14.6<br>x 7.3 / 540 x<br>370 x 185 | in / mm   |
| Weight with Safety Switch   | 22 / 10   | 25.1 / 11.4              | 26.2 / 11.9 | 38.8 / 17.6 | 40.1 / 18.2   |   |   | lb / kg   |
| Noise   | < 25  |                          |             |             | < 50  |   |   | dBA       |
| Cooling   | Natural Convection  |                          |             |             | Natural convection and internal fan (user<br>replaceable) |   |   |           |
| Operating Temperature Range   | -13 to +140 / -25 to +60 <sup>(4)</sup> (-40° F / -40° C option) <sup>(5)</sup> |                          |             |             |   |   |   | ° F / ° C |
| Protection Rating   | NEMA 3R (Inverter with Safety Switch)   |                          |             |             |   |   |   |           |

<sup>(1)</sup> For other regional settings please contact SolarEdge support  
<sup>(2)</sup> Revenue grade inverter P/N: SExxxH-US000NNC2  
<sup>(4)</sup> For power de-rating information refer to: <https://www.solaredge.com/sites/default/files/se-temperature-derating-note-na.pdf>  
<sup>(5)</sup> -40 version P/N: SExxxH-US000NNU4

