




Copyright VERTICAL ARTS, INC.

This document, and the ideas and designs incorporated herein, as an instrument of professional service, is the property of Vertical Arts Inc. and is not to be used, in whole or in part, for any other project without the written authorization from a principal of Vertical Arts Inc.

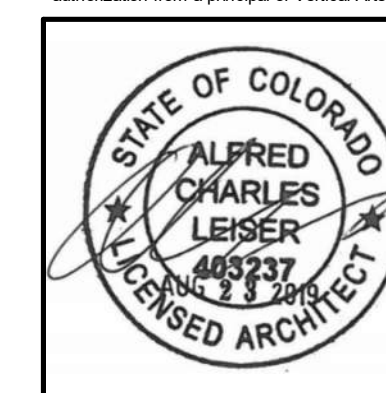

CAMPBELL RESIDENCE
LOT #5 - EAGLES VISTA
STEAMBOAT SPRINGS, CO.
#1907



VE REVISIONS 10.14.2019


| ISSUE NAME | DATE |
|---------------------|------------|
| PRICING SET | 05.21.2011 |
| REVISED PRICING SET | 06.14.2011 |
| 50% DD | 07.03.2011 |
| BUILDING PERMIT | 08.23.2011 |
| VE REVISIONS | 10.14.2011 |

COVER SHEET

A0.0

WE REVISIONS - OCTOBER 14 2019

10/14/2010 7:36:06 AM

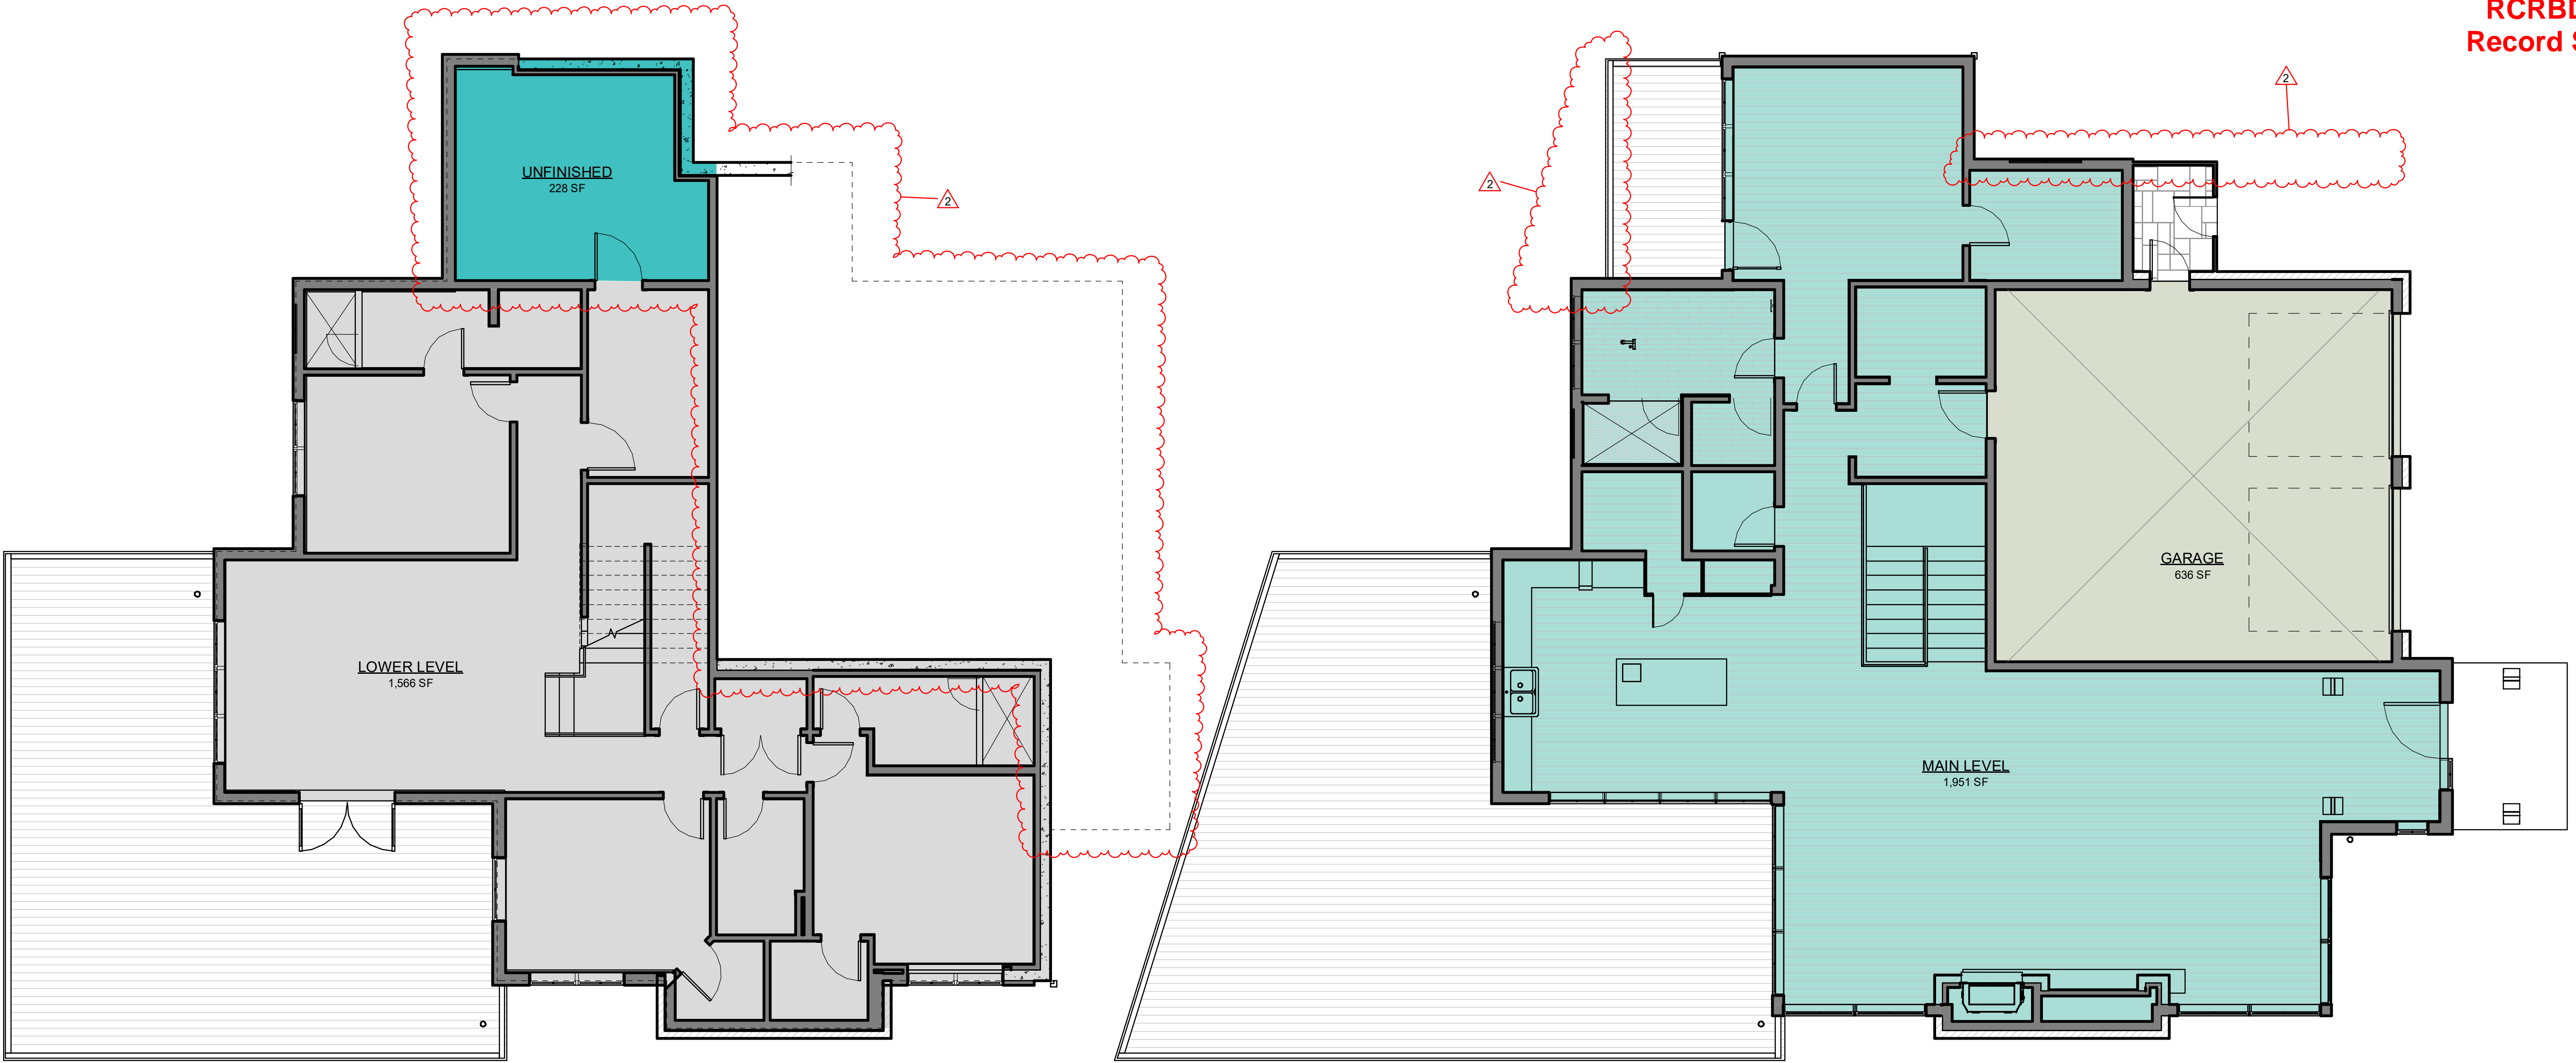


RCRBD
Record Set



ARCHITECTURE
PLANNING
LANDSCAPE
INTERIORS

Copyright VERTICAL ARTS, INC.
All Rights Reserved
This document, and the ideas and designs
incorporated herein, are an instrument of
professional services, is the property of Vertical
Arts Inc. and is not to be used, in whole or in part,
for any other project without the written
authorization from a principal of Vertical Arts, Inc.

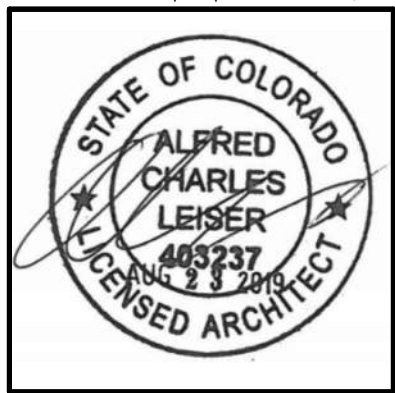

CAMPBELL RESIDENCE
LOT #5 - EAGLES VISTA
STEAMBOAT SPRINGS, CO.
#1907

② GROSS AREA LOWER LEVEL
3/16" = 1'-0"



① GROSS AREA MAIN LEVEL
3/16" = 1'-0"



| NAME | AREA |
|-------------|----------|
| LOWER LEVEL | 1,566 SF |
| MAIN LEVEL | 1,951 SF |
| TOTAL | 3,517 SF |
| GARAGE | 636 SF |
| TOTAL | 636 SF |
| UNFINISHED | 228 SF |
| TOTAL | 228 SF |
| GRAND TOTAL | 4,381 SF |

- GARAGE
- LOWER LEVEL
- MAIN LEVEL
- UNFINISHED

| ISSUE NAME | DATE |
|---------------------|------------|
| PRICING SET | 05.21.2019 |
| REVISED PRICING SET | 06.14.2019 |
| 50% DD | 07.03.2019 |
| MINOR ADJUSTMENT | 07.12.2019 |
| BUILDING PERMIT | 08.23.2019 |
| 10% REVISIONS | 10.14.2019 |

DRAWING TITLE

AREA PLANS

SHEET NO.

A0.7


10/14/2019 7:36:07 AM

| PROPOSED PLANT LIST | | | | |
|---------------------|------|---------------------------------------|------------------------|--------------------|
| No. | Sym. | Common Name/ Biological Name | Planting Size/ Remarks | Mature Size |
| Deciduous Trees: | | | | |
| ASP | | Aspen/ Populus tremuloides | 10' Tall/ Clump/ B&B | 50' Ht. & 40' Spd. |
| SSC | | Spring Snow Crab | 2" Caliper/ B&B | 15' Ht. & 15' Spd. |
| Deciduous Shrubs: | | | | |
| GCU | | Golden Currant/ Ribes aureum | 18"-24" Spread/ #5 | 4' Ht. & 4' Spd. |
| CHC | | Native Chokecherry/ Prunus virginiana | 18"-24" Spread/ #5 | 5' Ht. & 5' Spd. |
| SRB | | Serviceberry/ Amelanchier alnifolia | 18"-24" Spread/ #5 | 6' Ht. & 6' Spd. |
| Spruce Trees: | | | | |
| CBS | | Colorado Blue Spruce/ Picea pungens | 8' Tall/ B&B | 50' Ht. 25' Spd. |


*LANDSCAPE CONTRACTOR TO SUBMIT FINAL PLANT LIST AND PERENNIAL SELECTIONS FOR OWNER APPROVAL.

LANDSCAPE AND IRRIGATION NOTES

1. PLANTING BEDS ARE TO HAVE 3" OF WESTERN RED CEDAR MULCH OR LANDSCAPE ROCK OVER LANDSCAPE FABRIC.
2. AN UNDERGROUND, PRESSURIZED IRRIGATION SYSTEM WILL BE PROVIDED. ALL PLANTING BEDS ARE TO BE IRRIGATED WITH AN AUTOMATIC DRIP SYSTEM AND ALL TURF AND NATIVE SEED AREAS ARE TO BE IRRIGATED WITH A POP-UP SPRAY SYSTEM.
3. CUT STONE EDGING IS TO BE INSTALLED ALONG THE EDGE OF THE PLANTING BEDS.
4. CONTRACTOR WILL MAKE EVERY EFFORT TO MINIMIZE DISRUPTION TO THE EXISTING VEGETATION OUTSIDE THE IMMEDIATE CONSTRUCTION AREA.
5. LOCATE ALL UTILITIES PRIOR TO CONSTRUCTION. ALL DISTURBED AREAS ARE TO BE RE-VEGETATED.

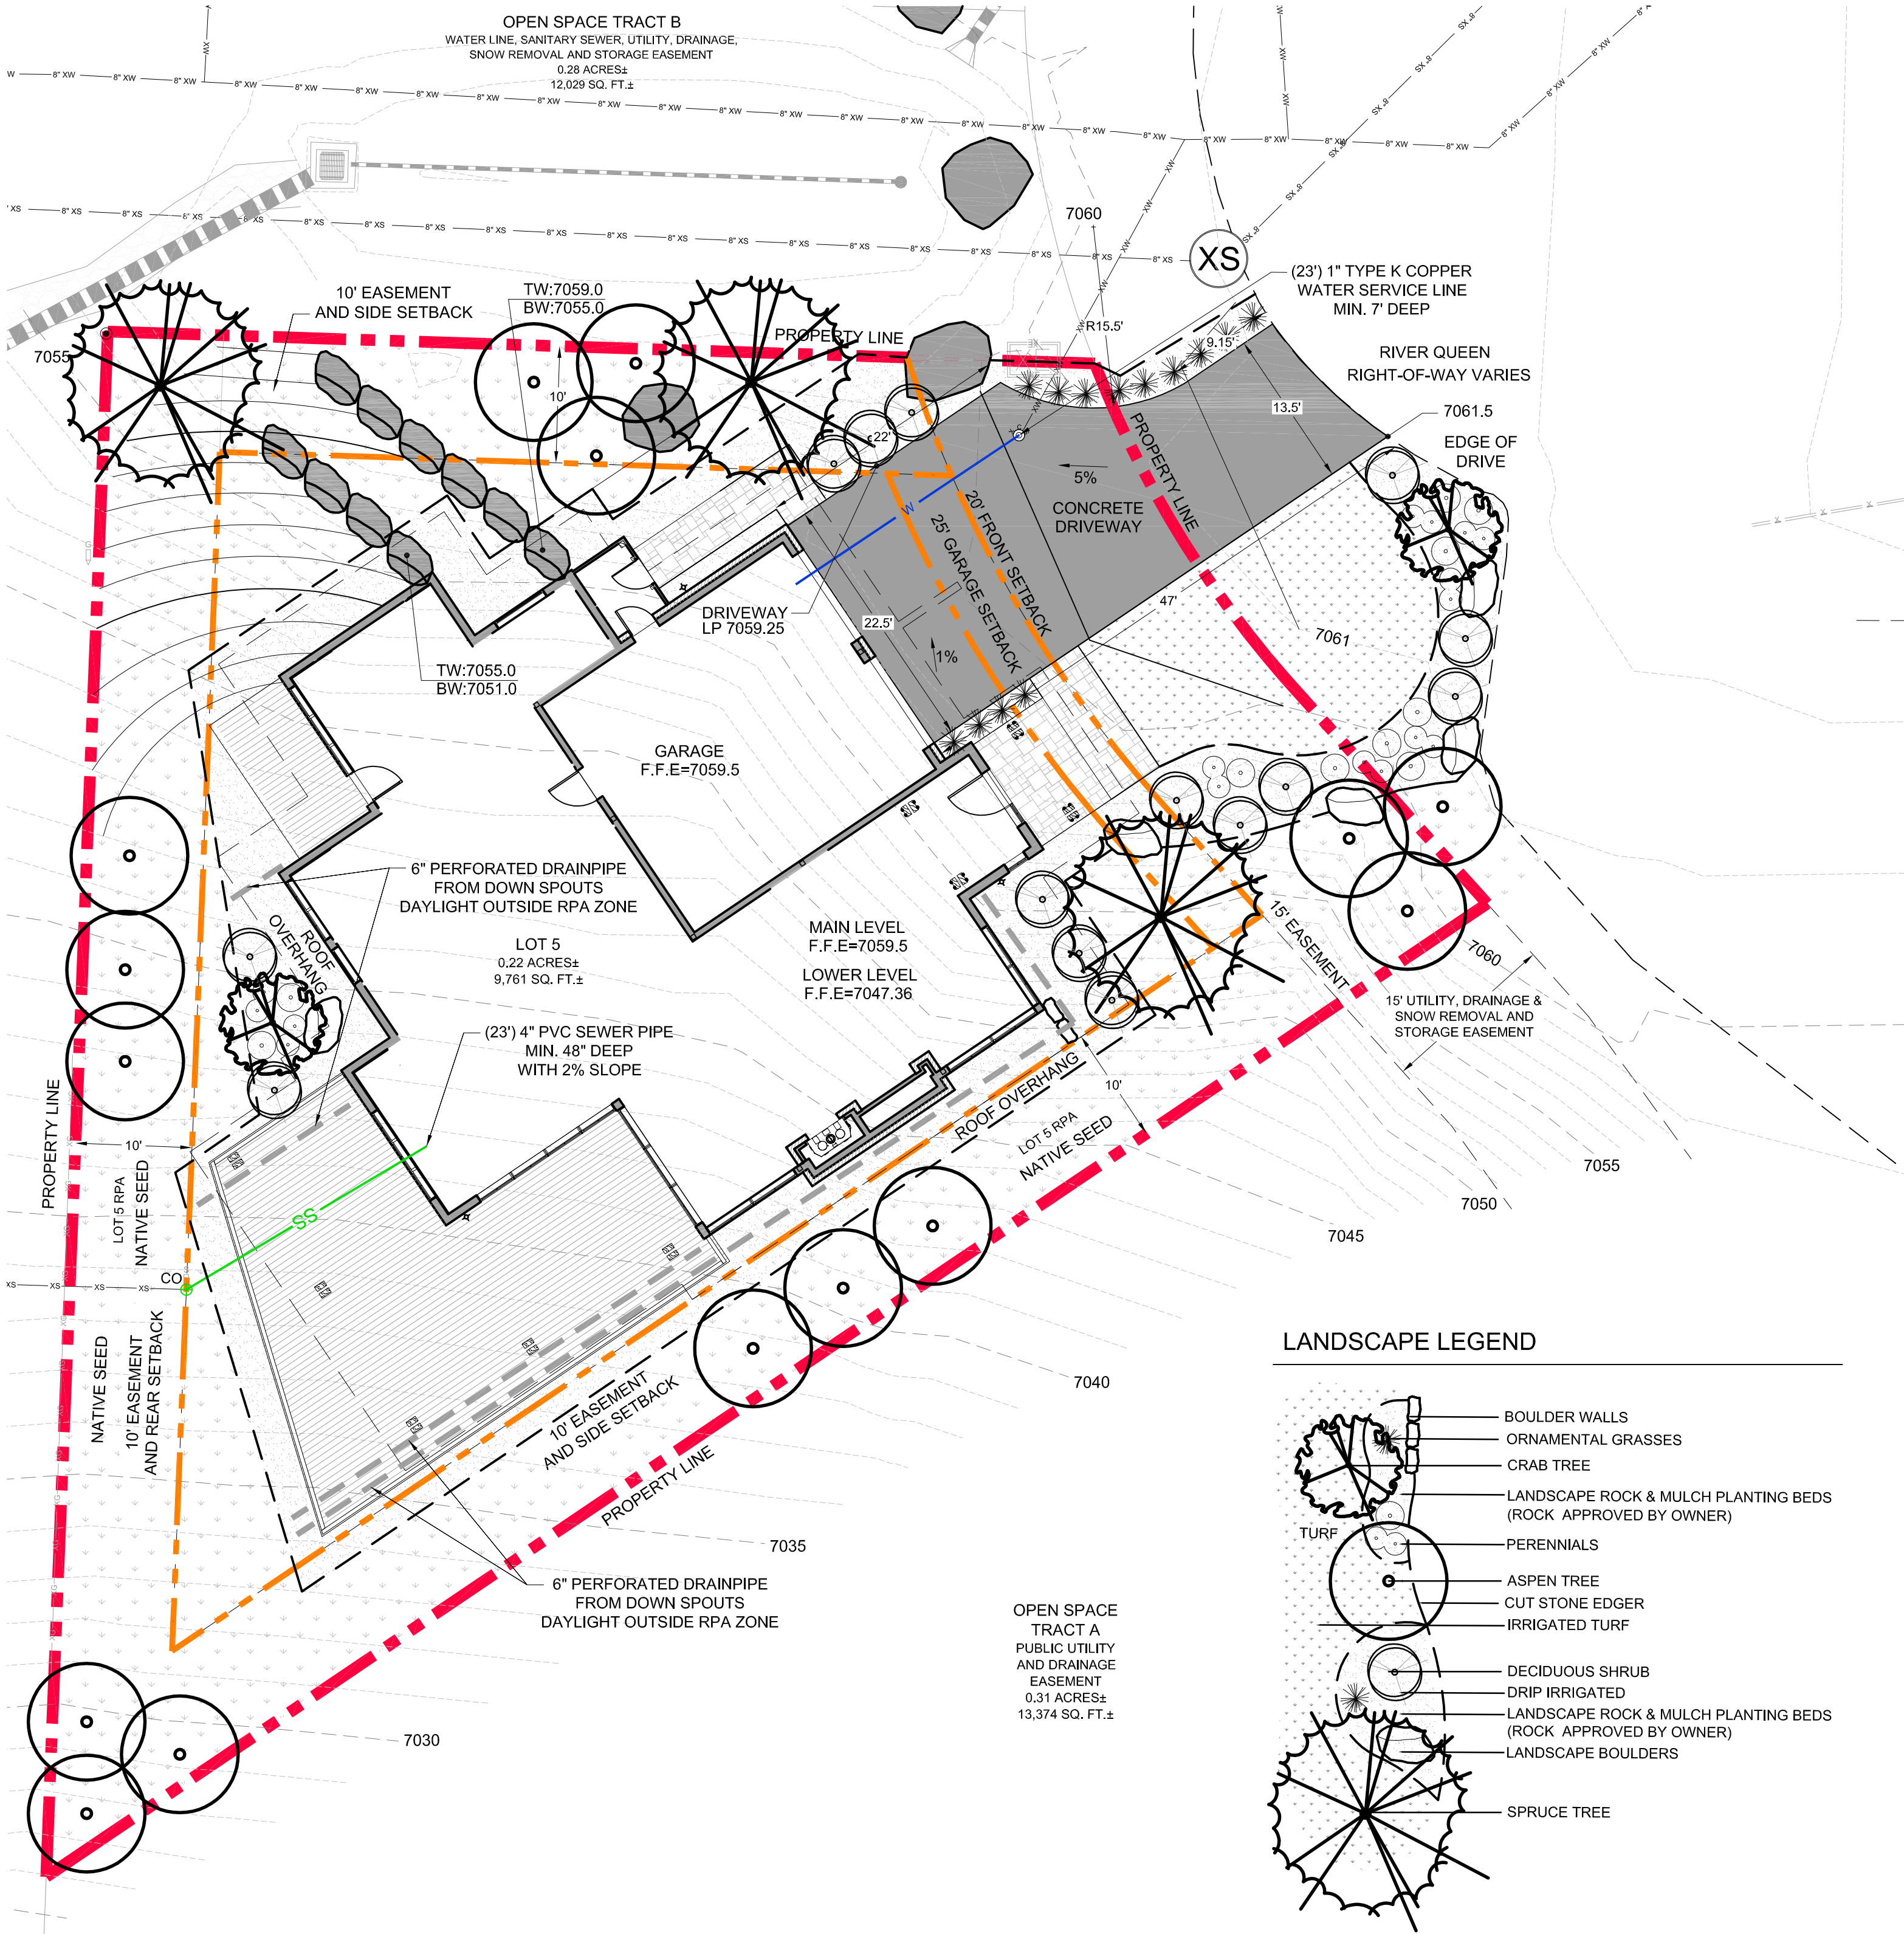

2 LANDSCAPE PLAN
SCALE: 1" = 10'-0"

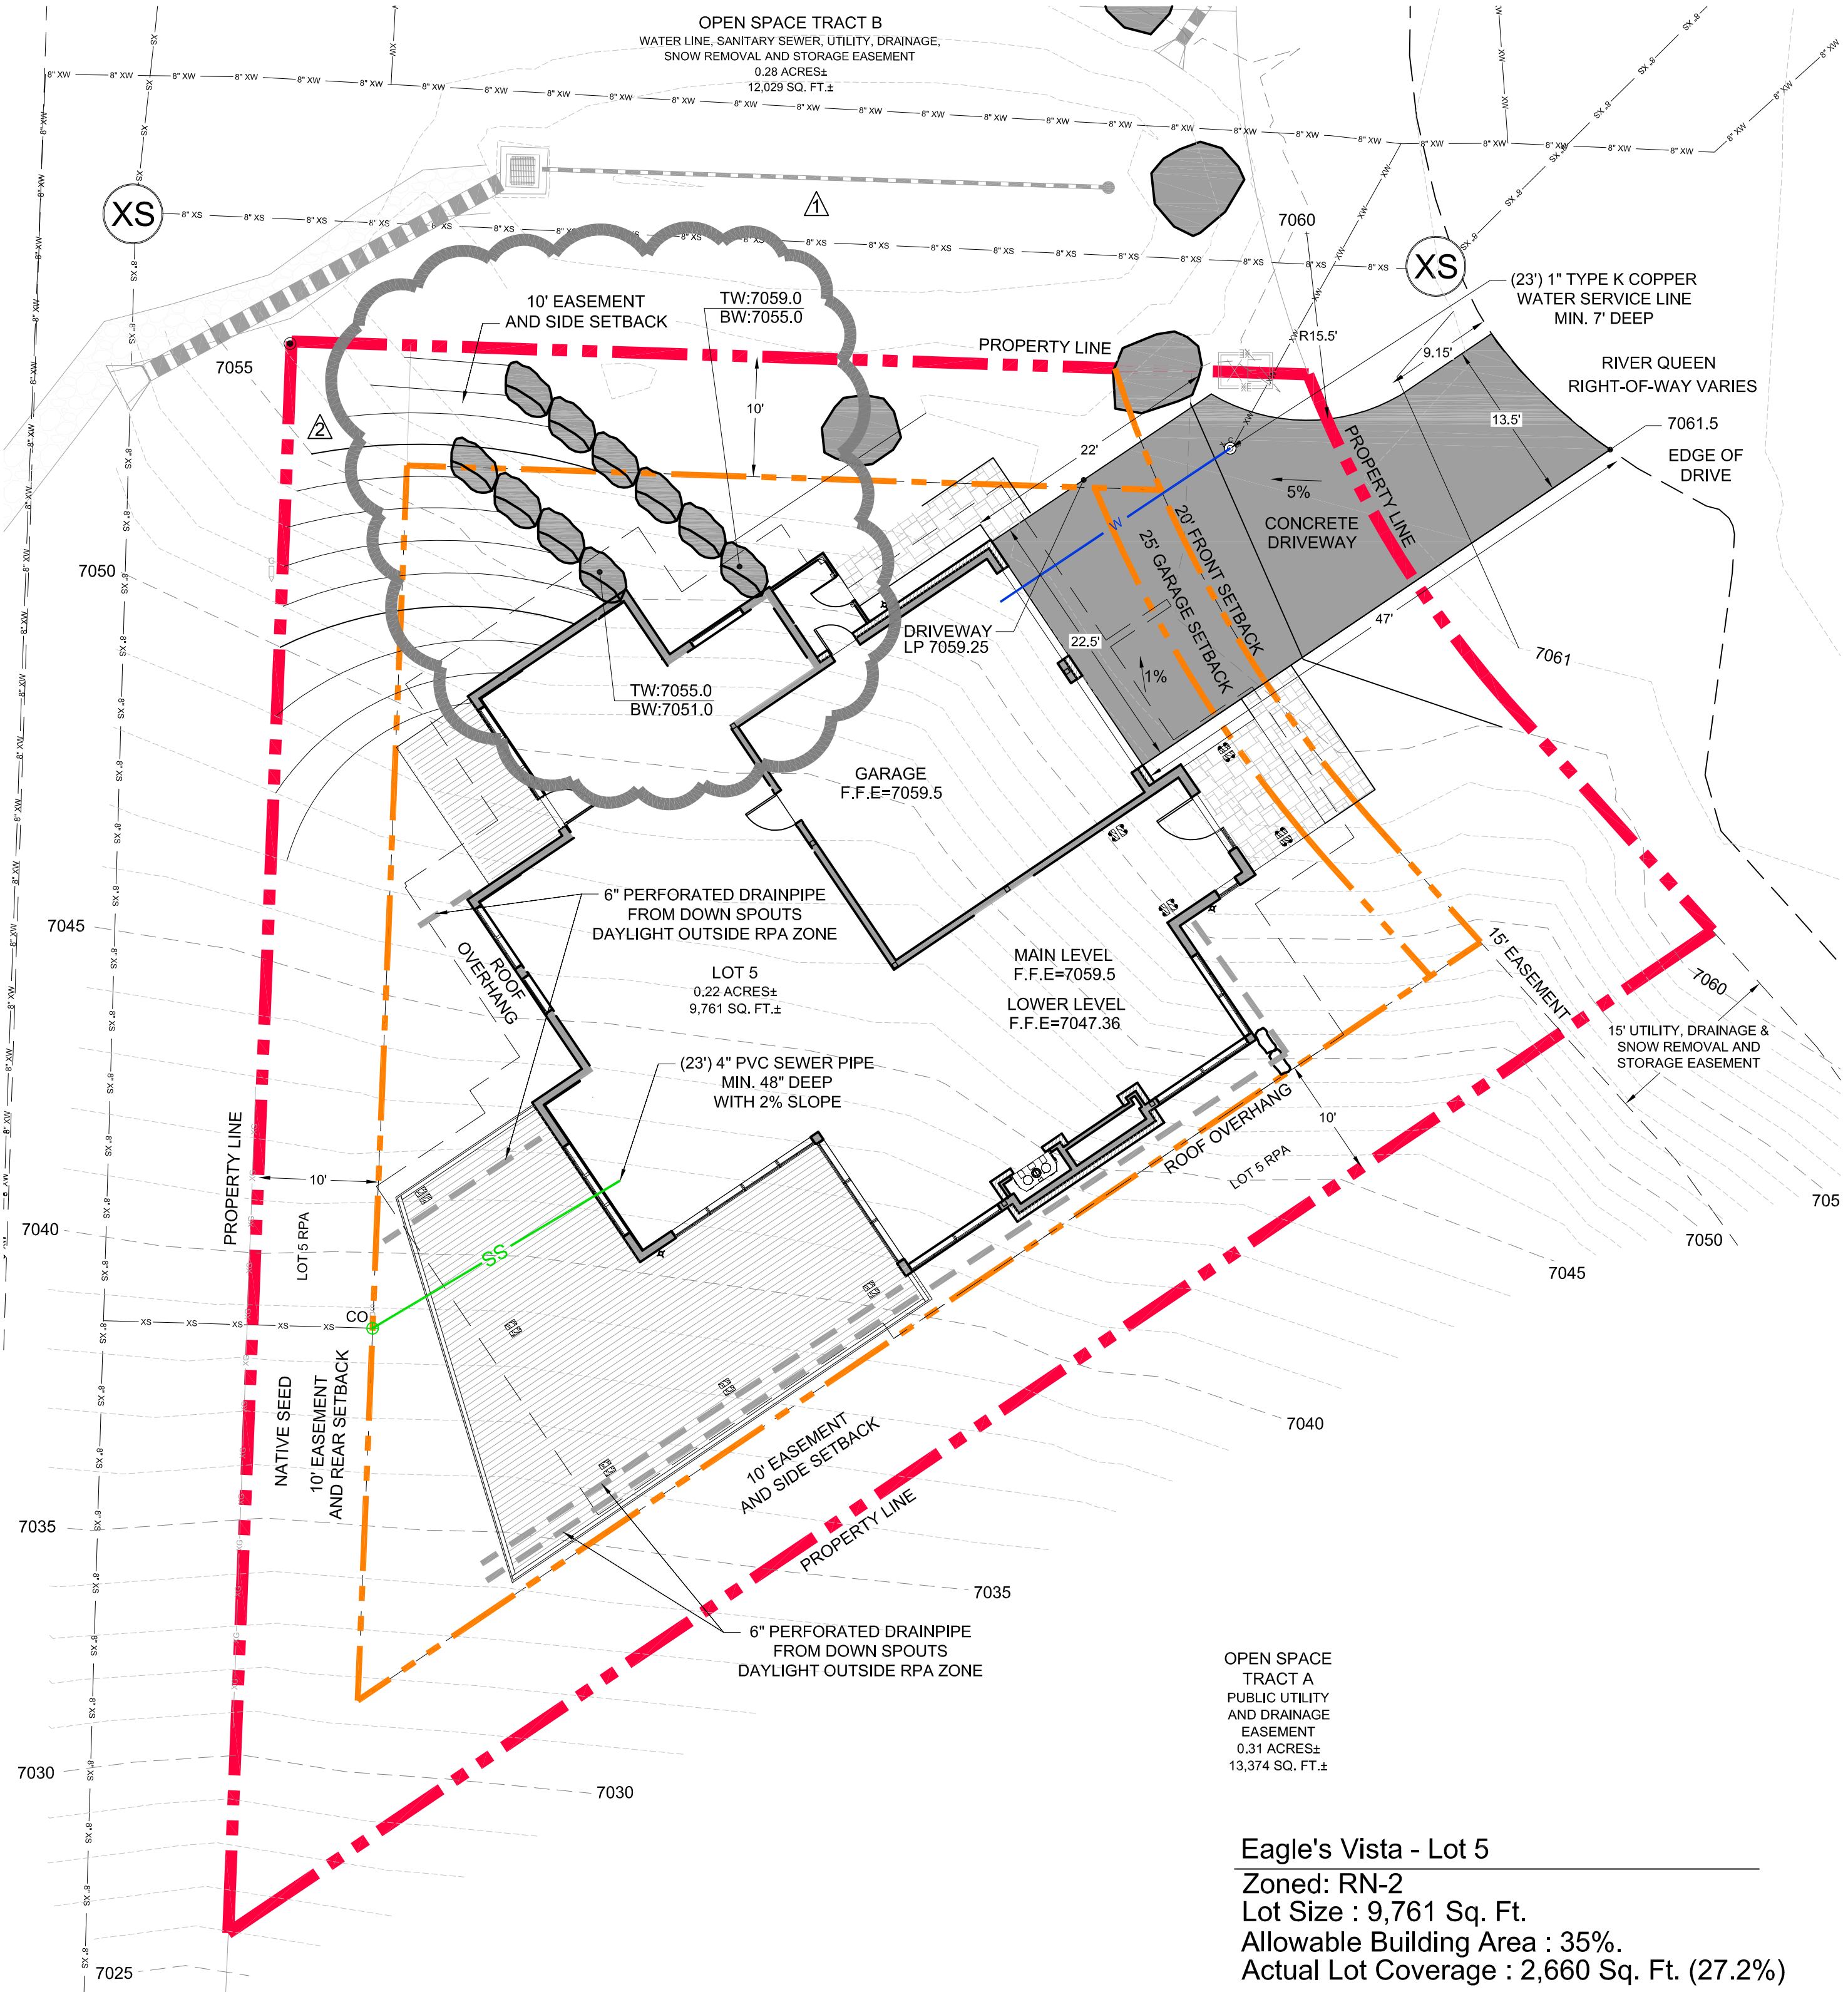

1 SITE PLAN
SCALE: 1" = 10'-0"

RCRBD
Record Set



ARCHITECTURE

Design | Planning | Interiors

Copyright VERTICAL ARTS, INC.
All Rights Reserved

This document, and the ideas and designs incorporated herein, as an instrument of professional service, is the property of Vertical Arts Inc. and is not to be used, in whole or in part, for any other project without the written authorization from a principal of Vertical Arts, Inc.

Campbell Residence
Lot 5 - Eagle's Vista
Steamboat Springs, Colorado

| ISSUE NAME | DATE |
|------------|----------|
| PERMIT SET | 08.23.19 |
| PERMIT SET | 09.24.19 |
| CD SET | 09.30.19 |

DRAWING TITLE
Site Plan
and
Landscape Plan

SHEET NO.


SP-1



ARCHITECTURE
PLANNING
LANDSCAPE
INTERIORS

Copyright VERTICAL ARTS, INC.
All Rights Reserved

This document, and the ideas and designs
incorporated herein, are an instrument of
professional services, is the property of Vertical
Arts Inc. and is not to be used, in whole or in part,
for any other project without the written
authorization from a principal of Vertical Arts, Inc.

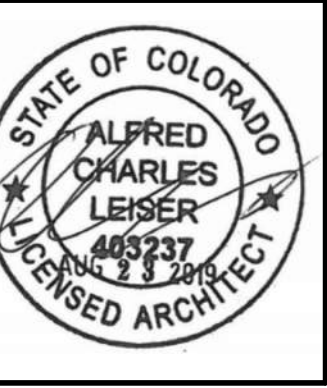

CAMPBELL RESIDENCE
LOT #5 - EAGLES VISTA
STEAMBOAT SPRINGS, CO.
#1907

| ISSUE NAME | DATE |
|---------------------|------------|
| PRICING SET | 05/21/2019 |
| REVISED PRICING SET | 06/14/2019 |
| 50% DD | 07/03/2019 |
| MINOR ADJUSTMENT | 07/12/2019 |
| BUILDING PERMIT | 08/23/2019 |
| REVISIONS | 10/14/2019 |


DRAWING TITLE

LOWER LEVEL FLOOR PLAN

SHEET NO.

A2.1

10/14/2019 7:36:08 AM

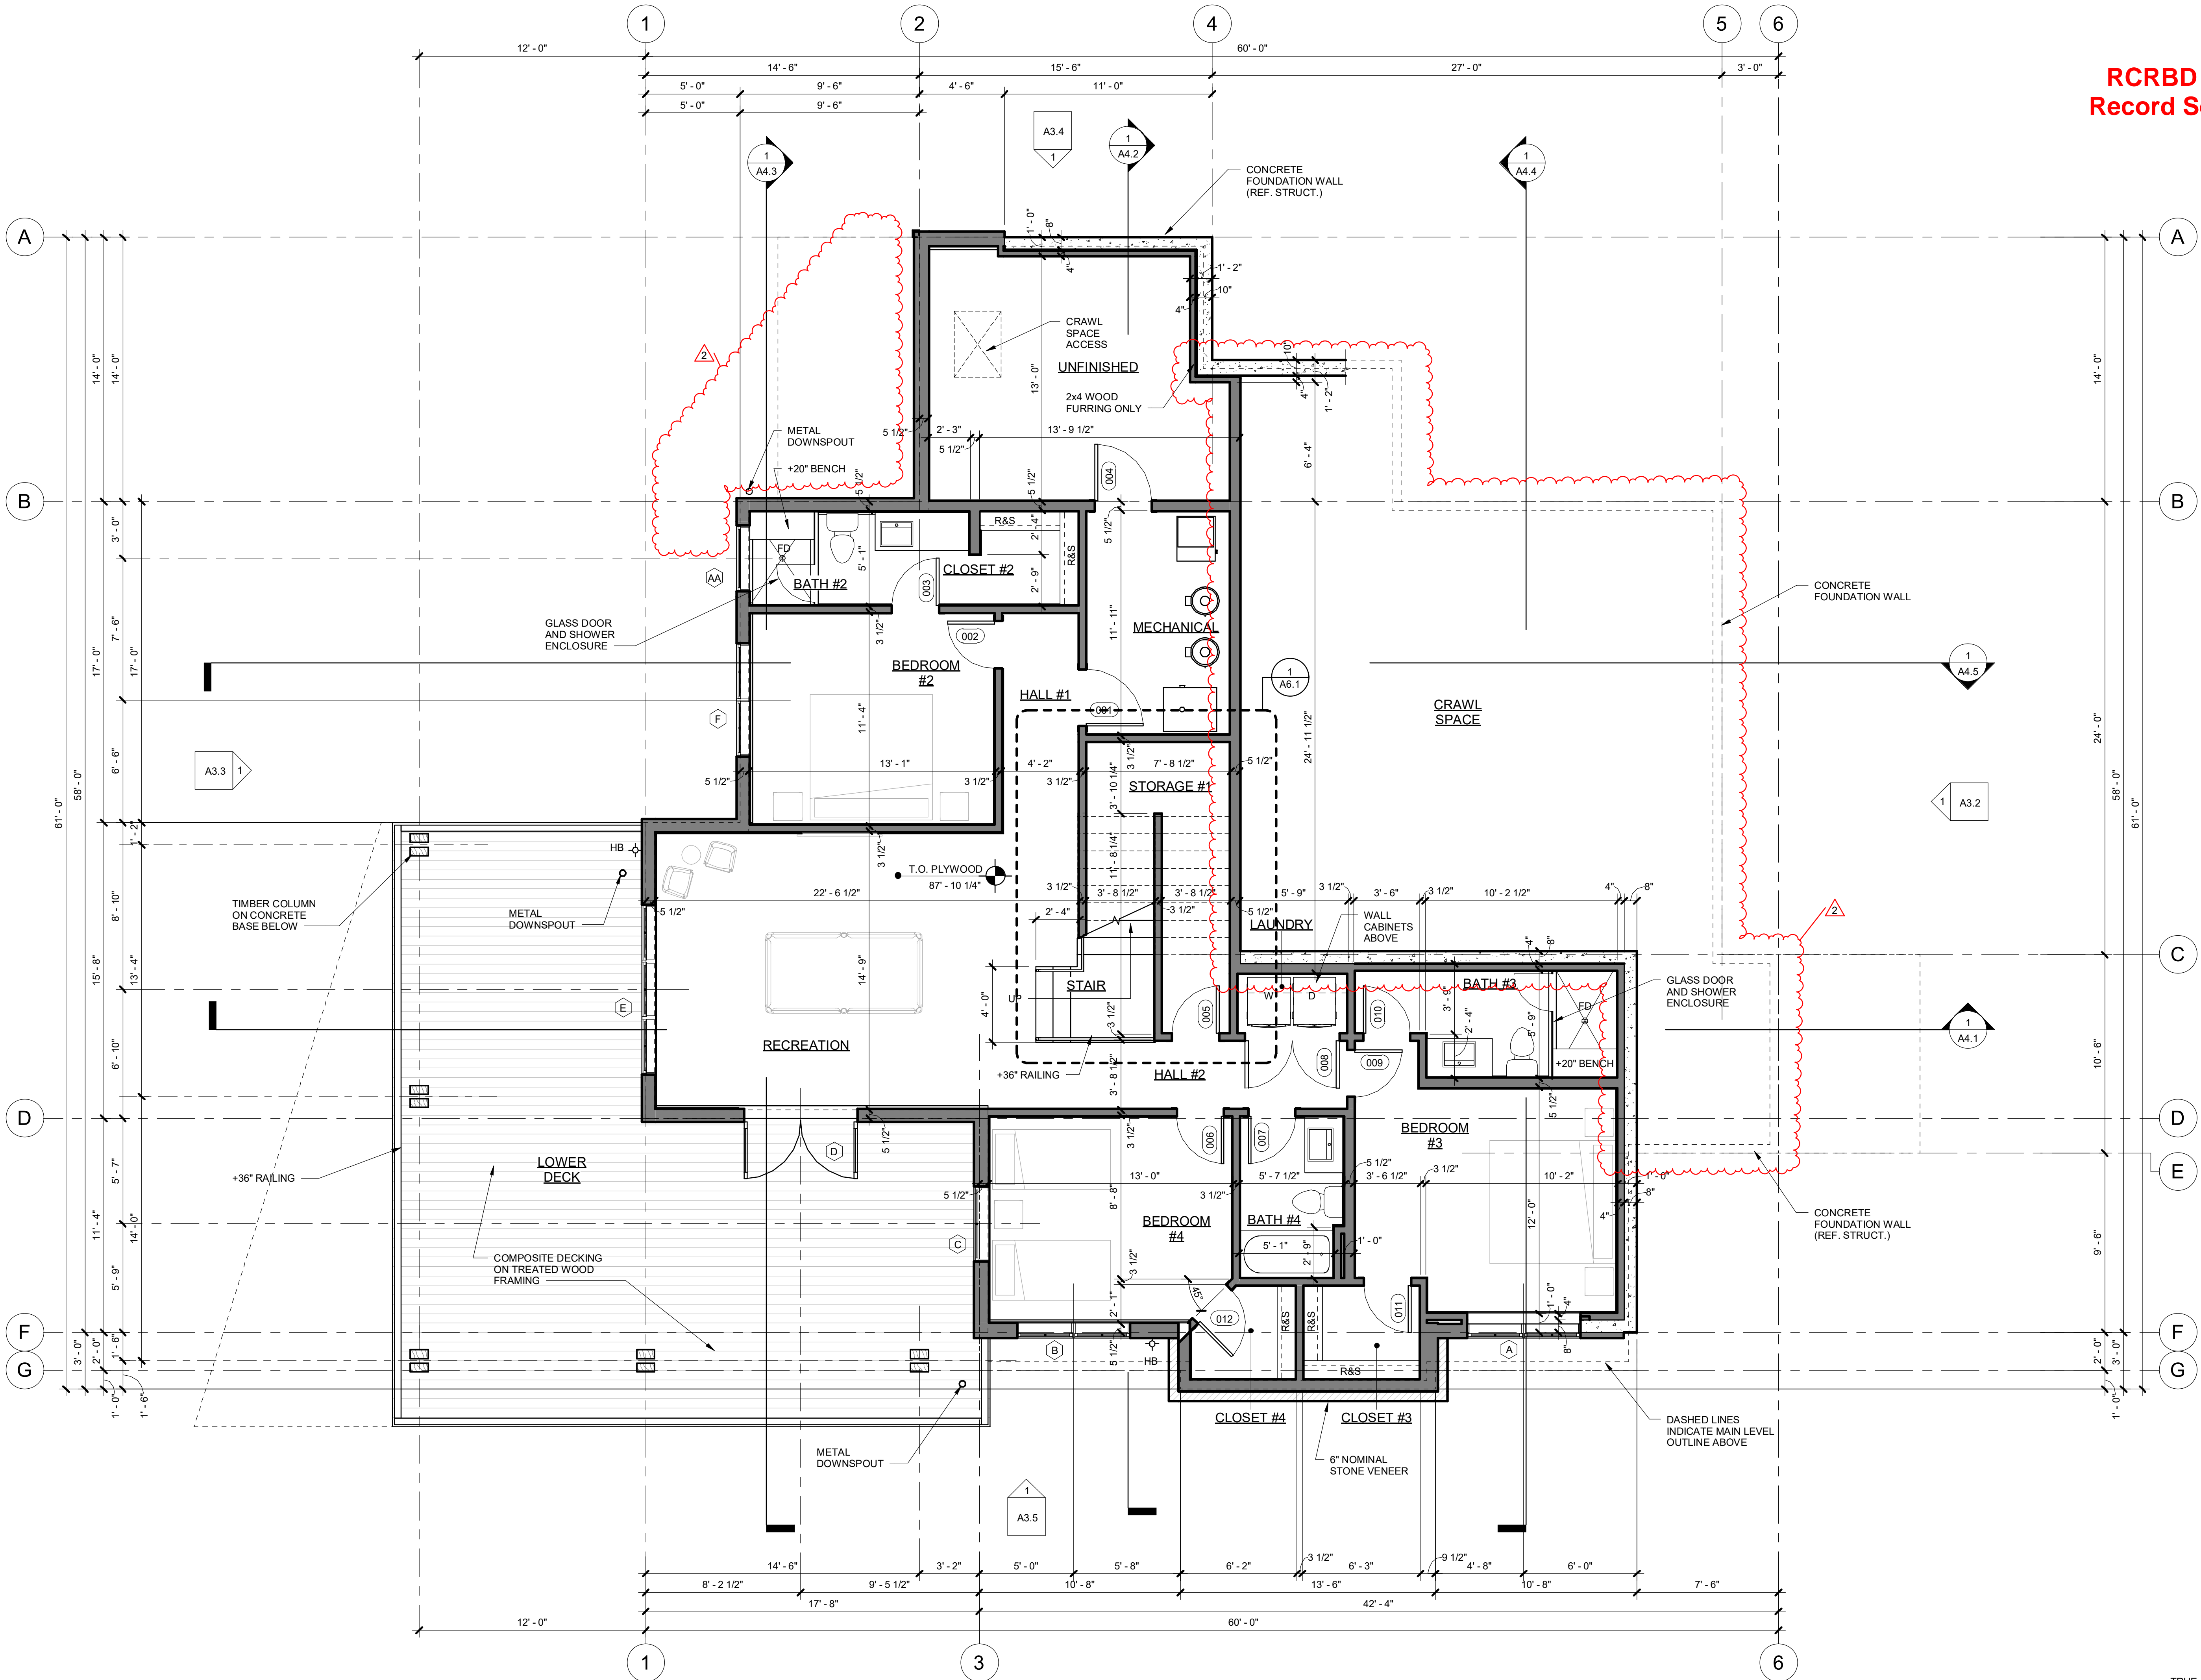

1 LOWER LEVEL FLOOR PLAN
1/4" = 1'-0"



RCRBD
Record Set



This document, and the ideas and designs incorporated herein, as an instrument of professional service, is the property of Vertical Arts Inc. and is not to be used, in whole or in part, for any other project without the written authorization from a principal of Vertical Arts Inc.





| ISSUE NAME | DATE |
|---------------------|------------|
| PRICING SET | 05.21.2017 |
| REVISED PRICING SET | 06.14.2017 |
| 50% DD | 07.03.2017 |
| MINOR ADJUSTMENT | 07.12.2017 |
| BUILDING PERMIT | 08.23.2017 |
| VE REVISIONS | 10.14.2017 |

MAIN LEVEL FLOOR
PLAN

A2.2

10/11/2010 7:26:00 AM

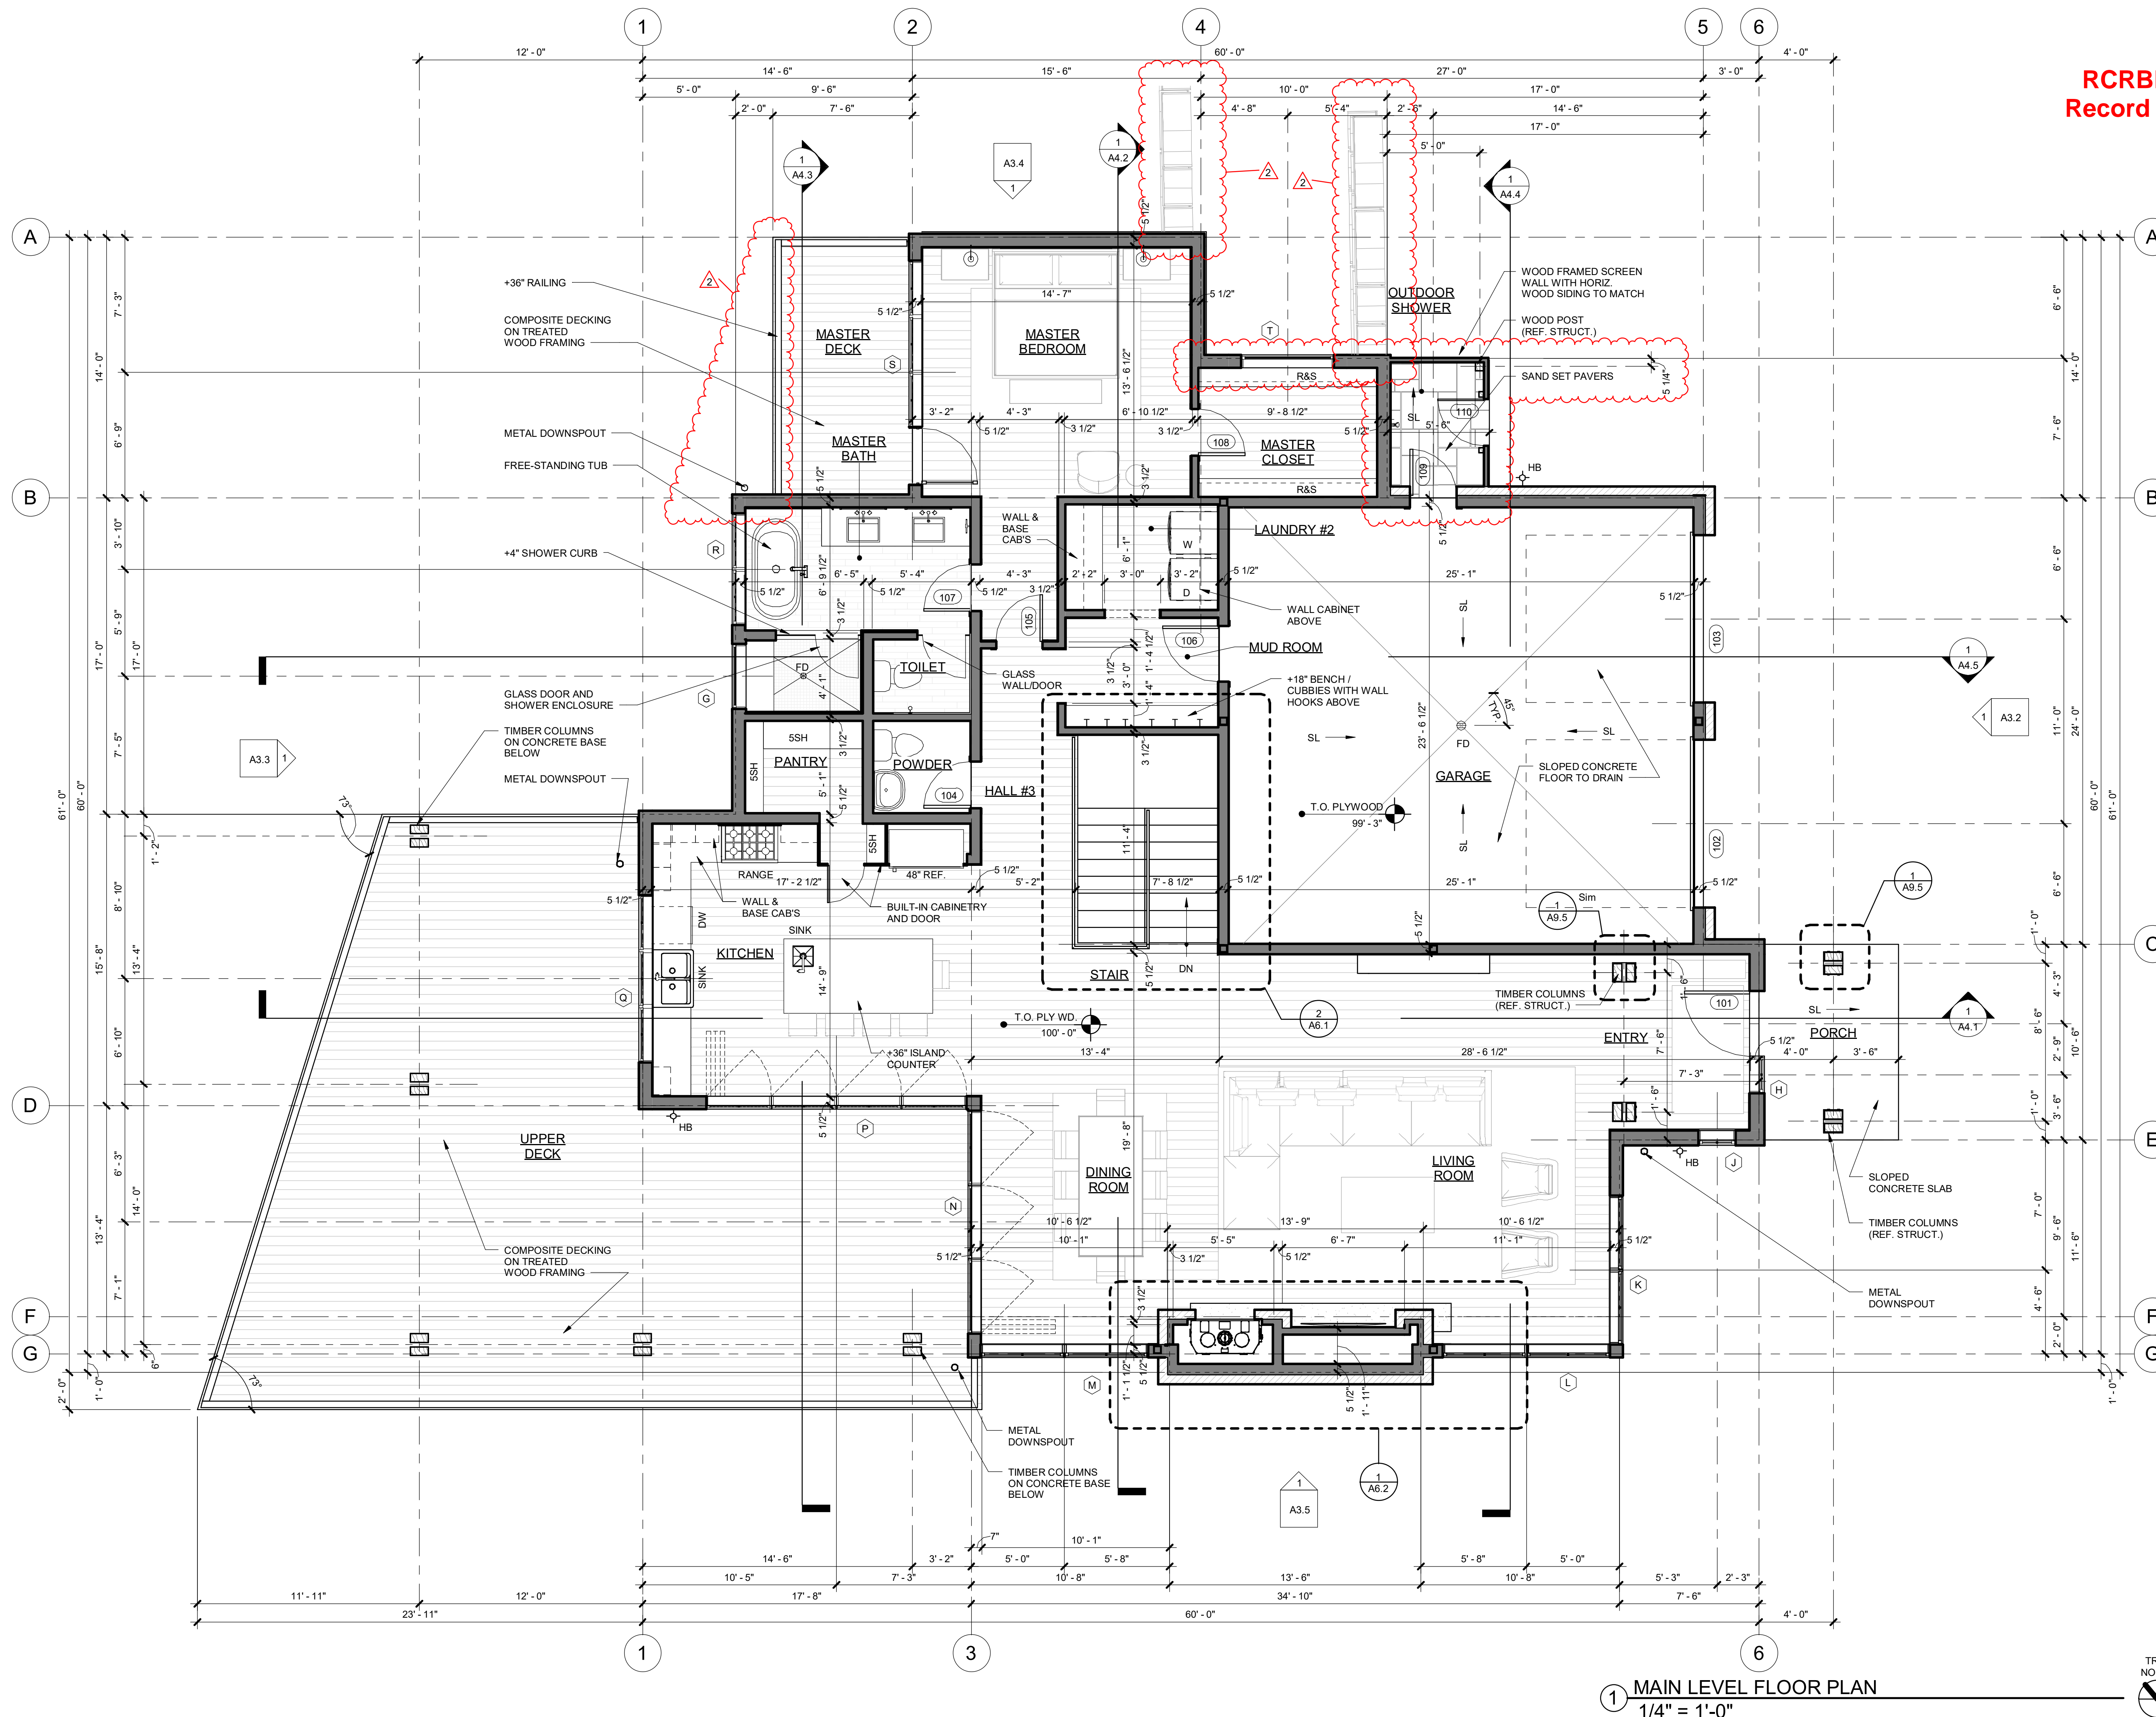

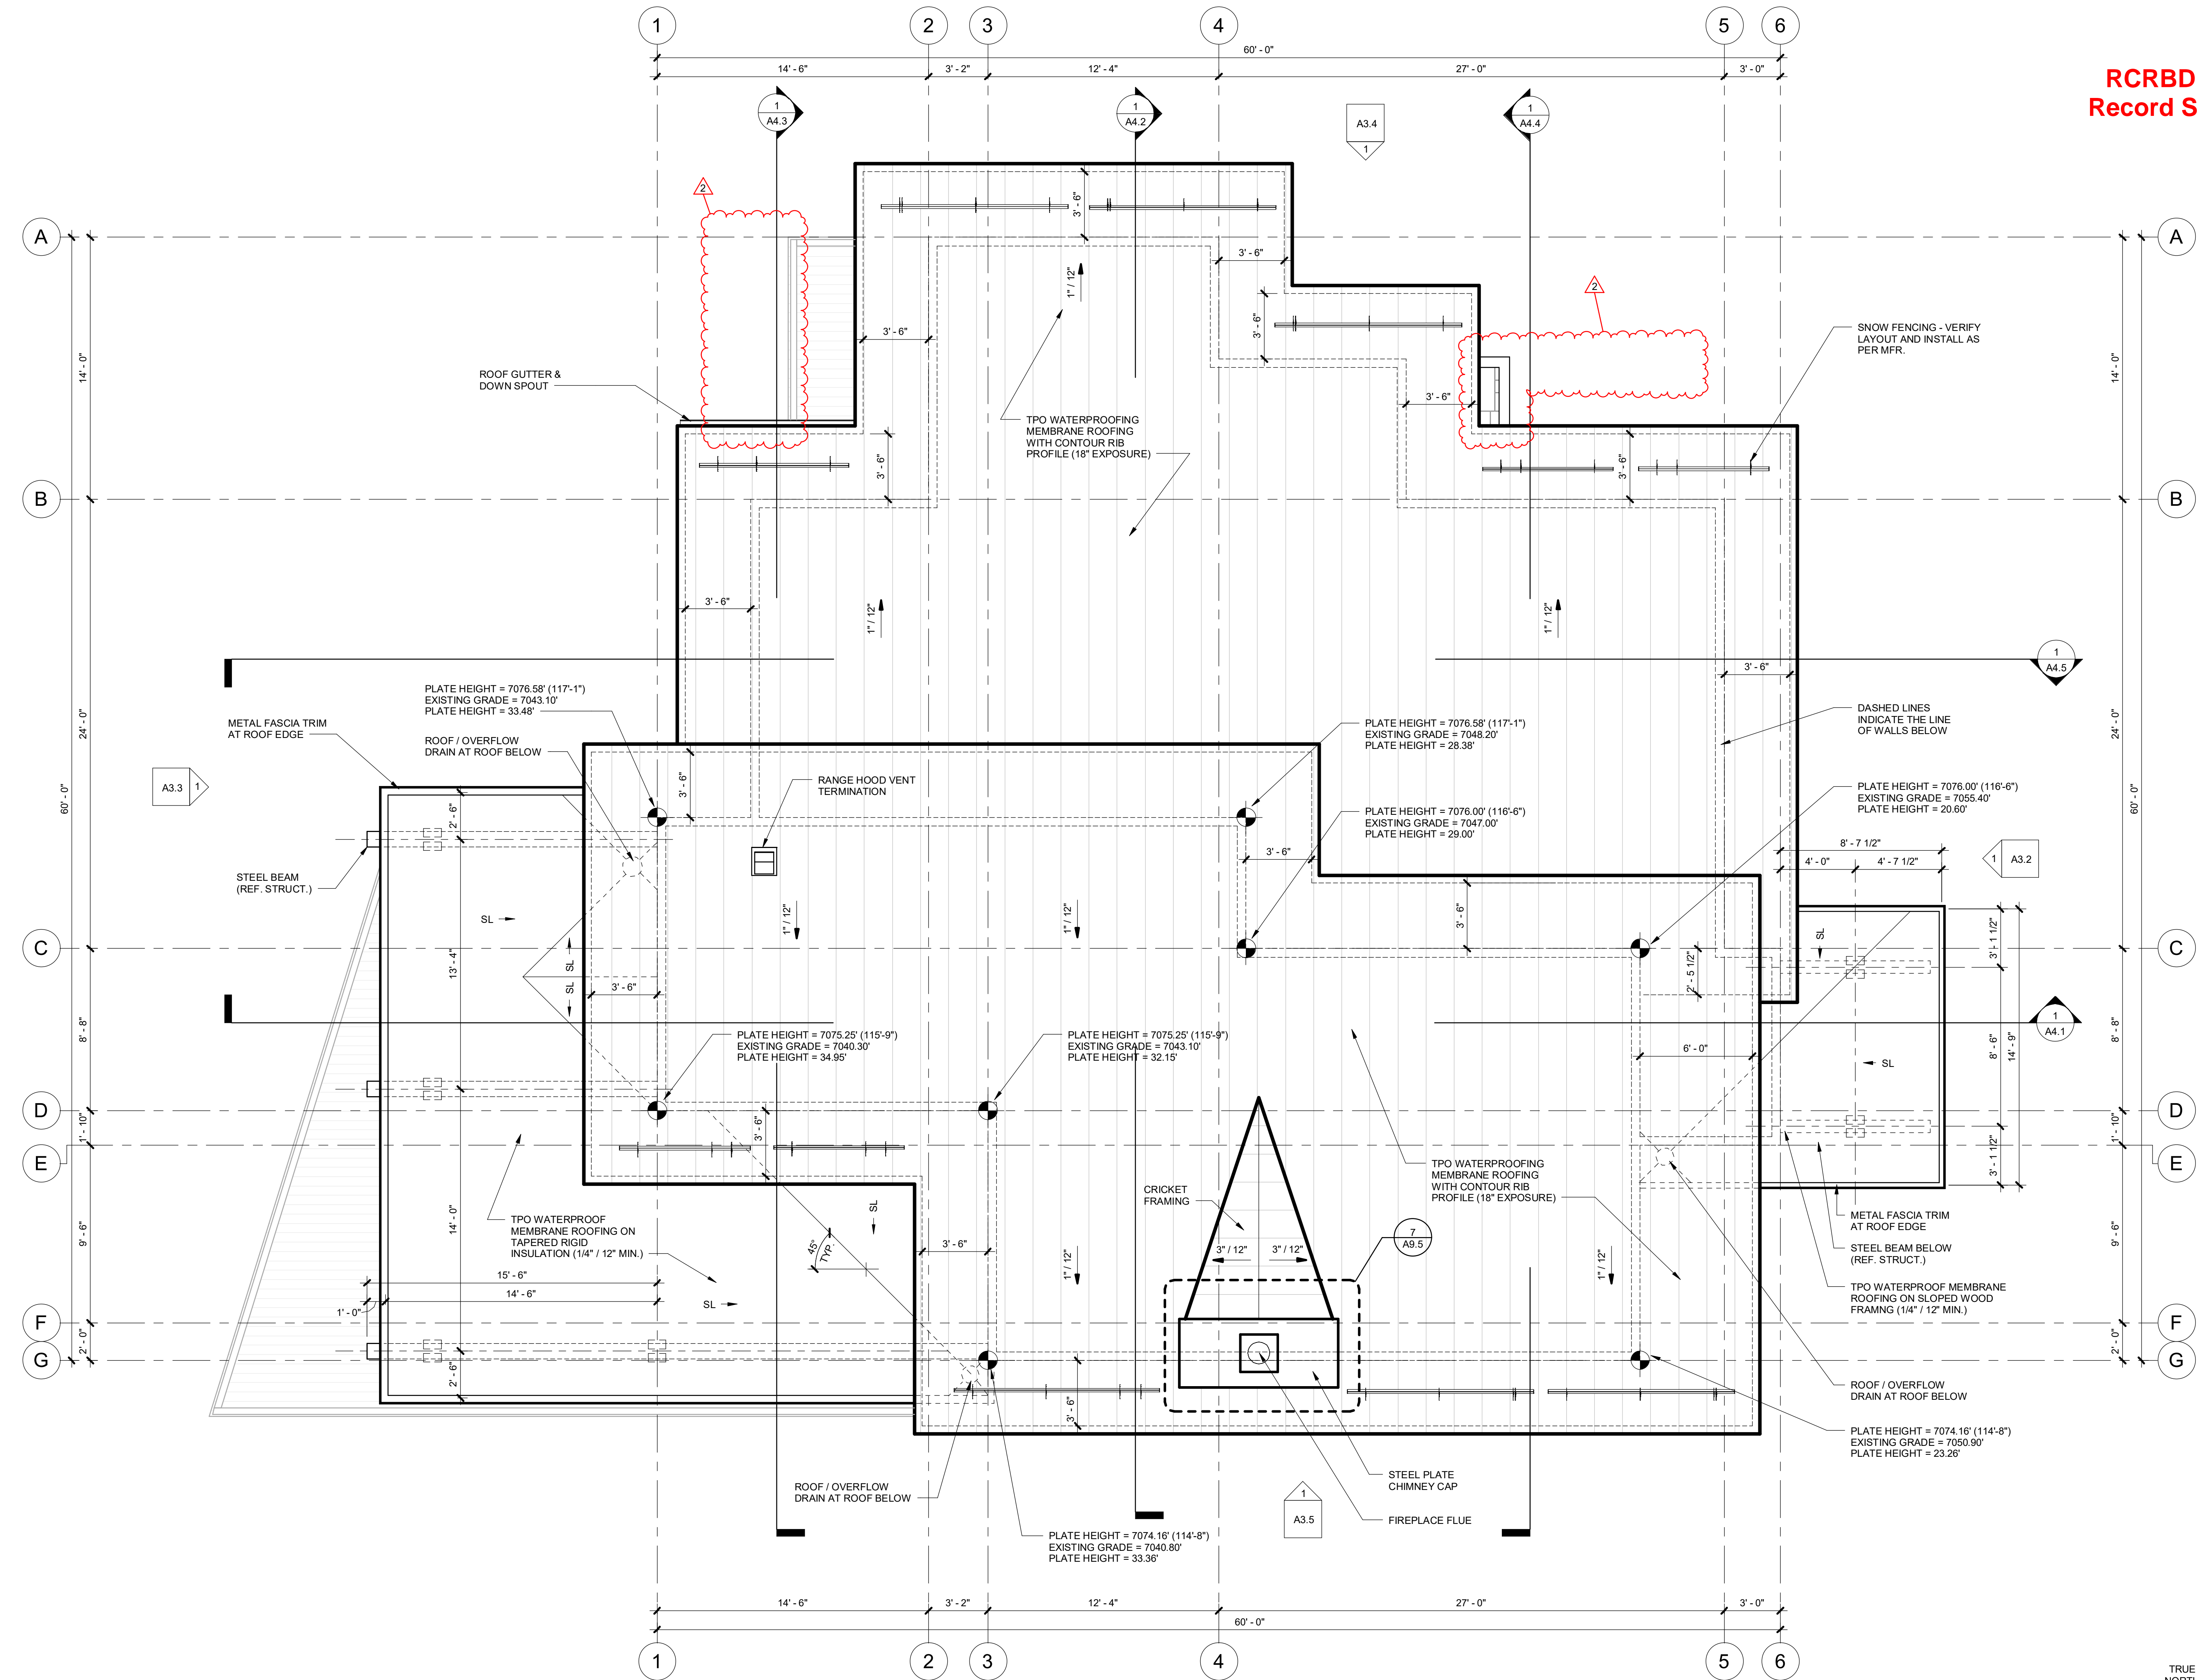


RCRBD
Record Set



ARCHITECTURE
PLANNING
LANDSCAPE
INTERIORS

Copyright VERTICAL ARTS, INC.
All Rights Reserved

This document, and the ideas and designs
incorporated herein, are an instrument of
professional services, is the property of Vertical
Arts Inc. and is not to be used, in whole or in part,
for any other project without the written
authorization from a principal of Vertical Arts, Inc.

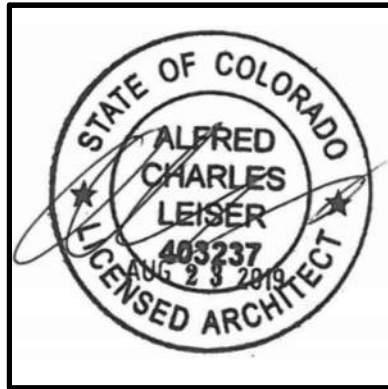

CAMPBELL RESIDENCE
LOT #5 - EAGLES VISTA
STEAMBOAT SPRINGS, CO.
#1907

| ISSUE NAME | DATE |
|---------------------|------------|
| PRICING SET | 05/21/2019 |
| REVISED PRICING SET | 06/14/2019 |
| 50% DD | 07/03/2019 |
| MINOR ADJUSTMENT | 07/12/2019 |
| BUILDING PERMIT | 08/23/2019 |
| REVISIONS | 10/14/2019 |

DRAWING TITLE

ROOF PLAN


SHEET NO.

A2.3

1 ROOF PLAN
1/4" = 1'-0"



10/14/2019 7:36:10 AM

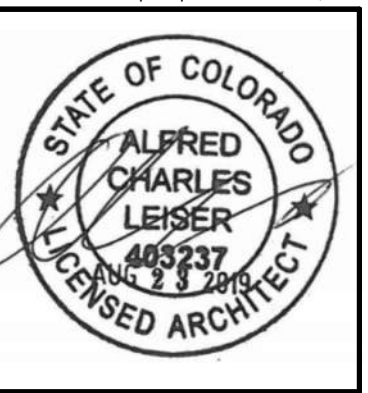


CAMPBELL RESIDENCE
LOT #5 - EAGLES VISTA
STEAMBOAT SPRINGS, CO.
#1907

| ISSUE NAME | DATE |
|------------------|------------|
| 9% DD | 07.03.2019 |
| MINOR ADJUSTMENT | 07.12.2019 |
| BUILDING PERMIT | 08.23.2019 |
| REVISIONS | 10.14.2019 |


PERSPECTIVES

A3.1


10/14/2019 7:36:29 AM

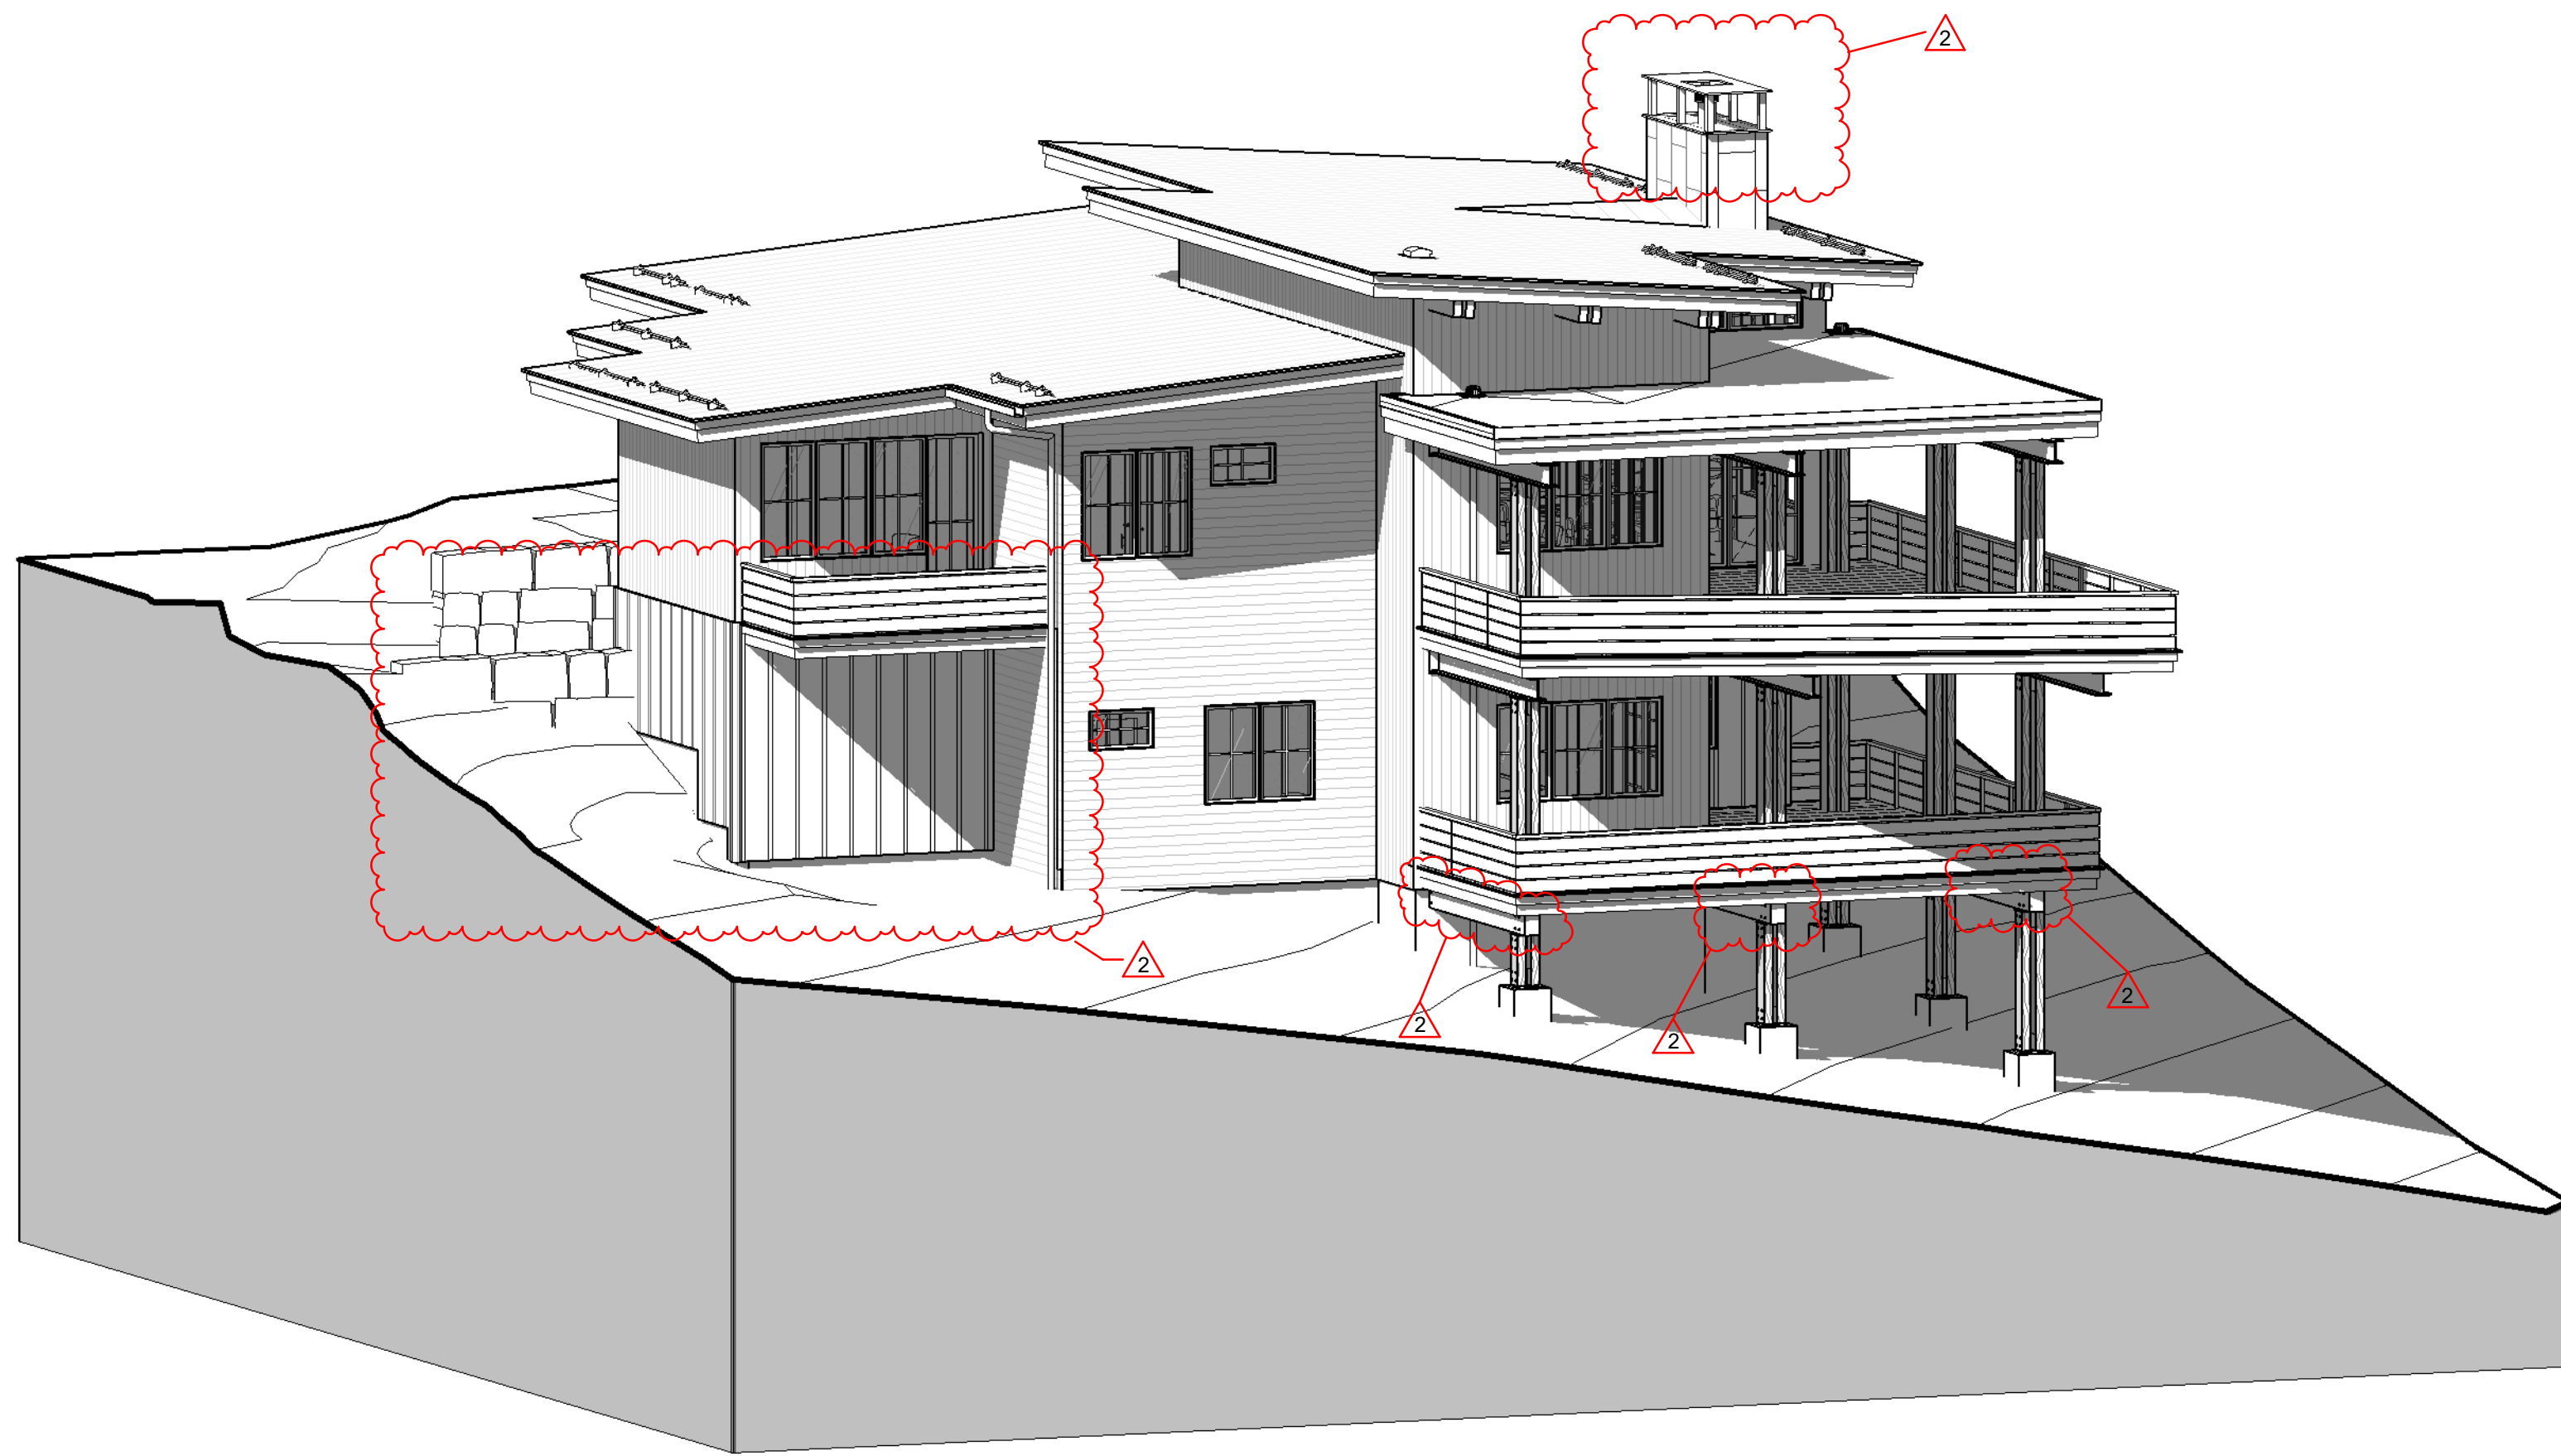


4 PERSPECTIVE #4

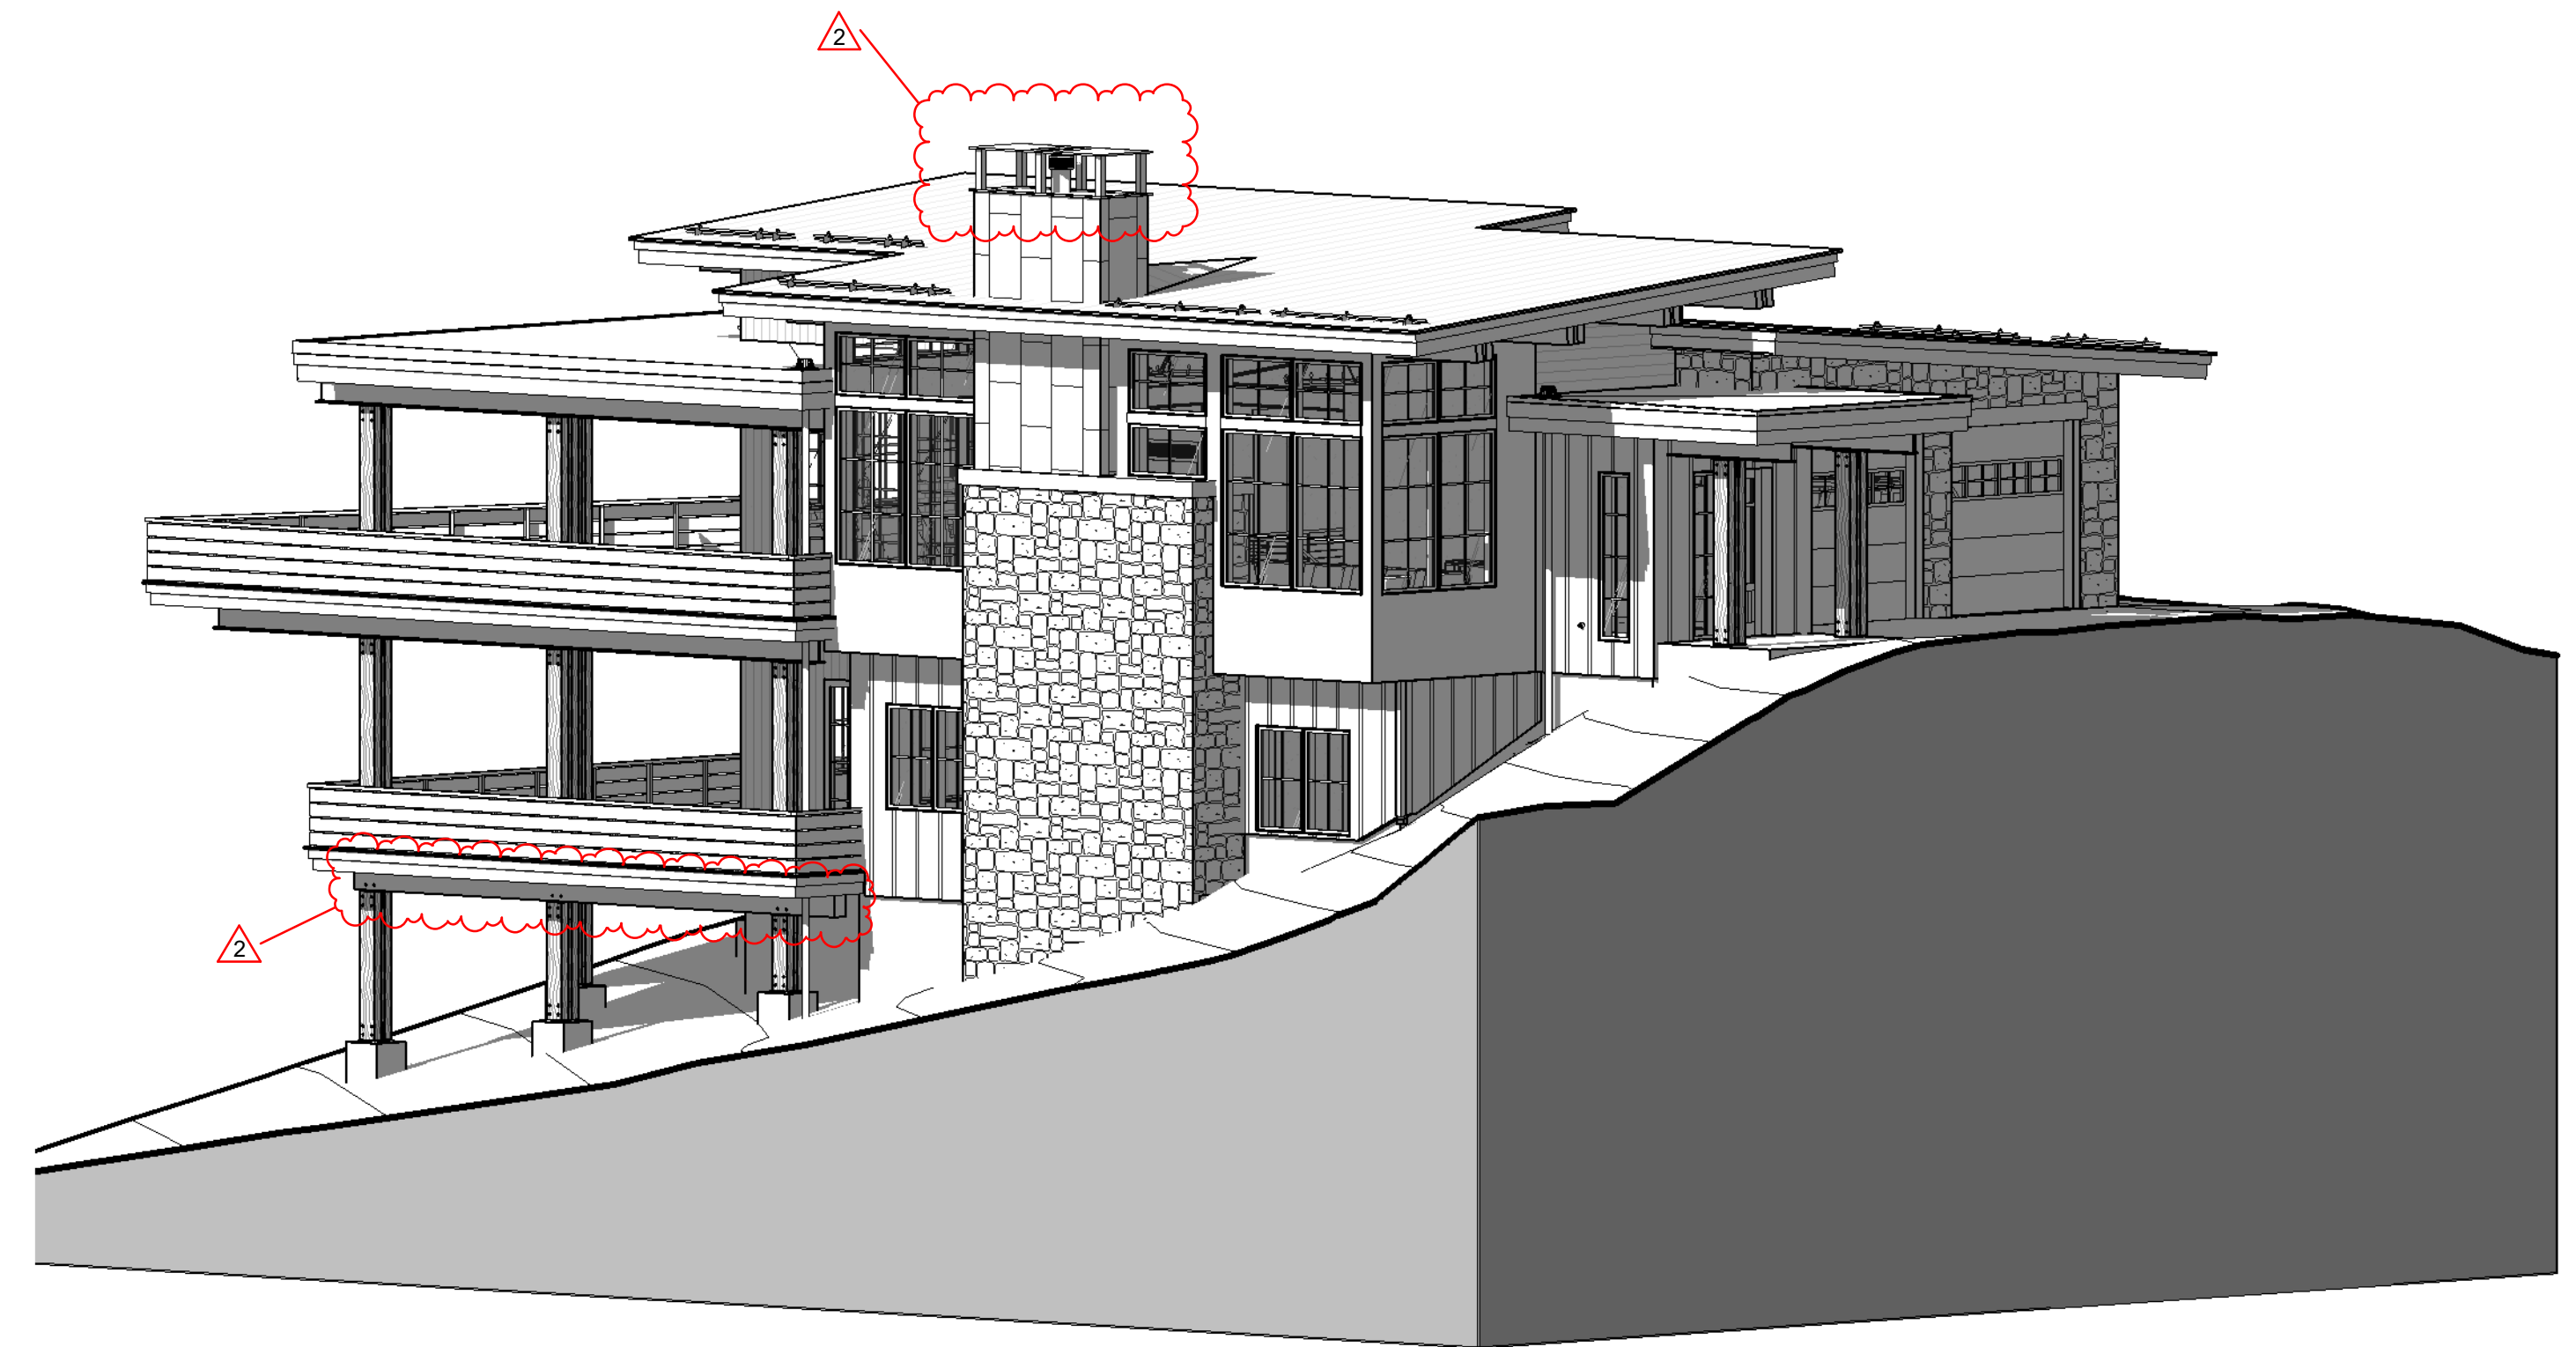

② PERSPECTIVE #2

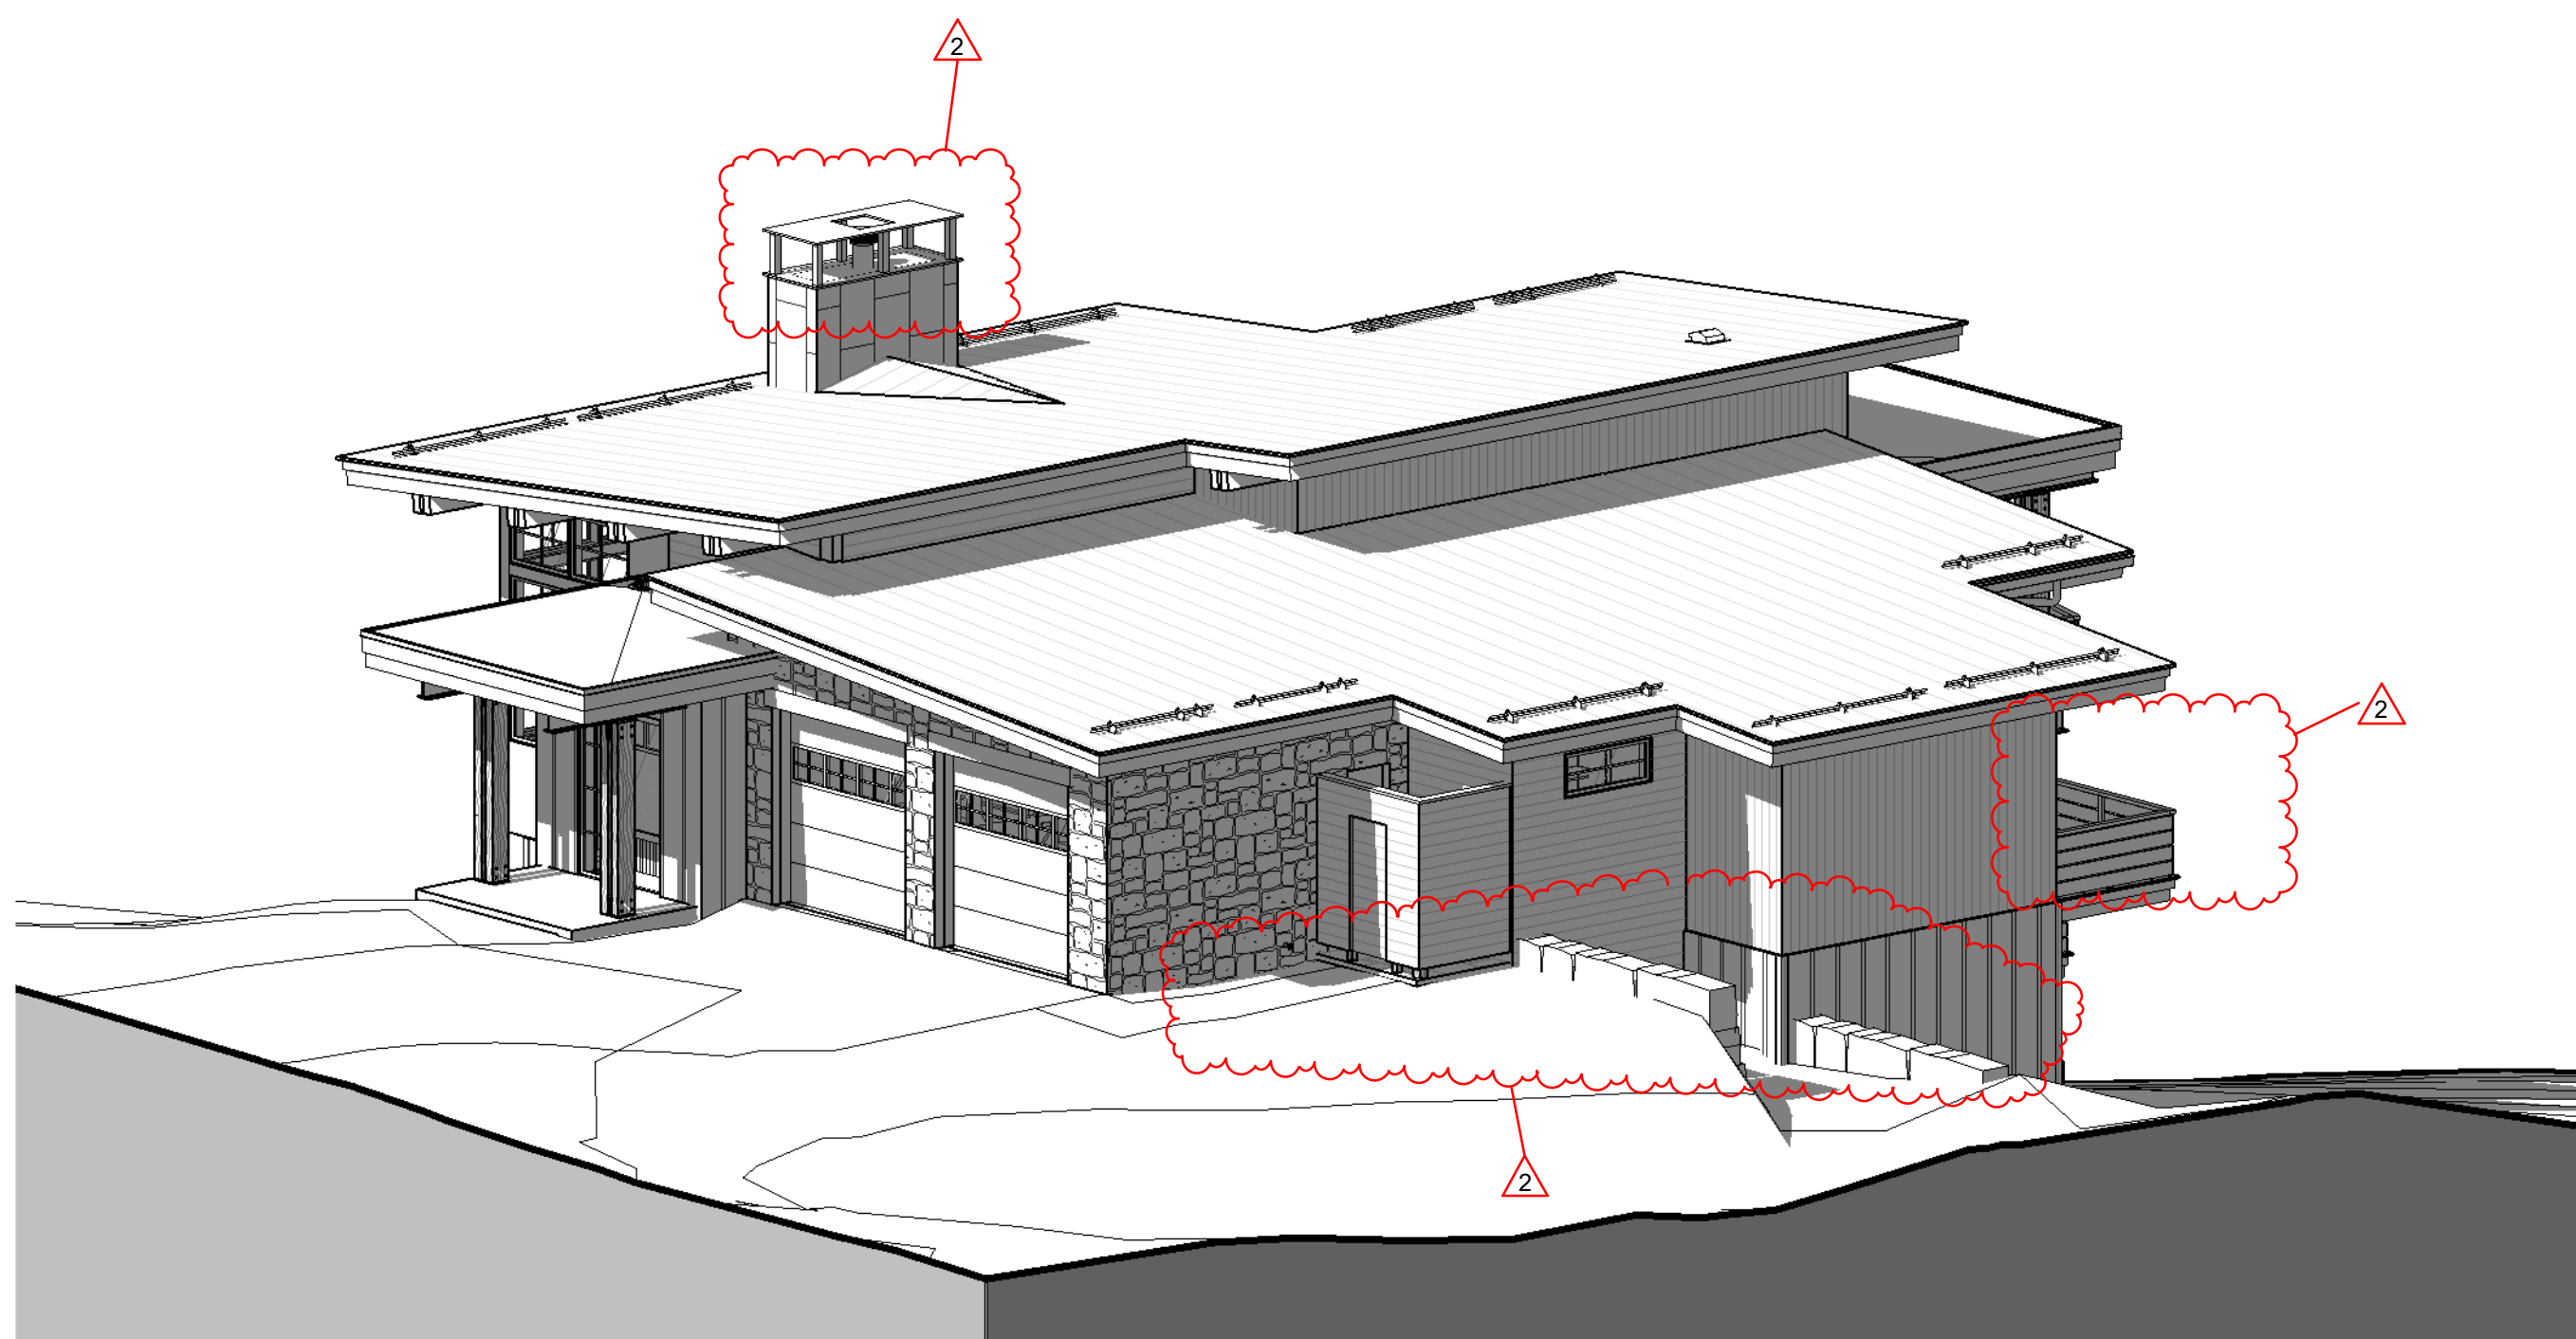

③ PERSPECTIVE #3

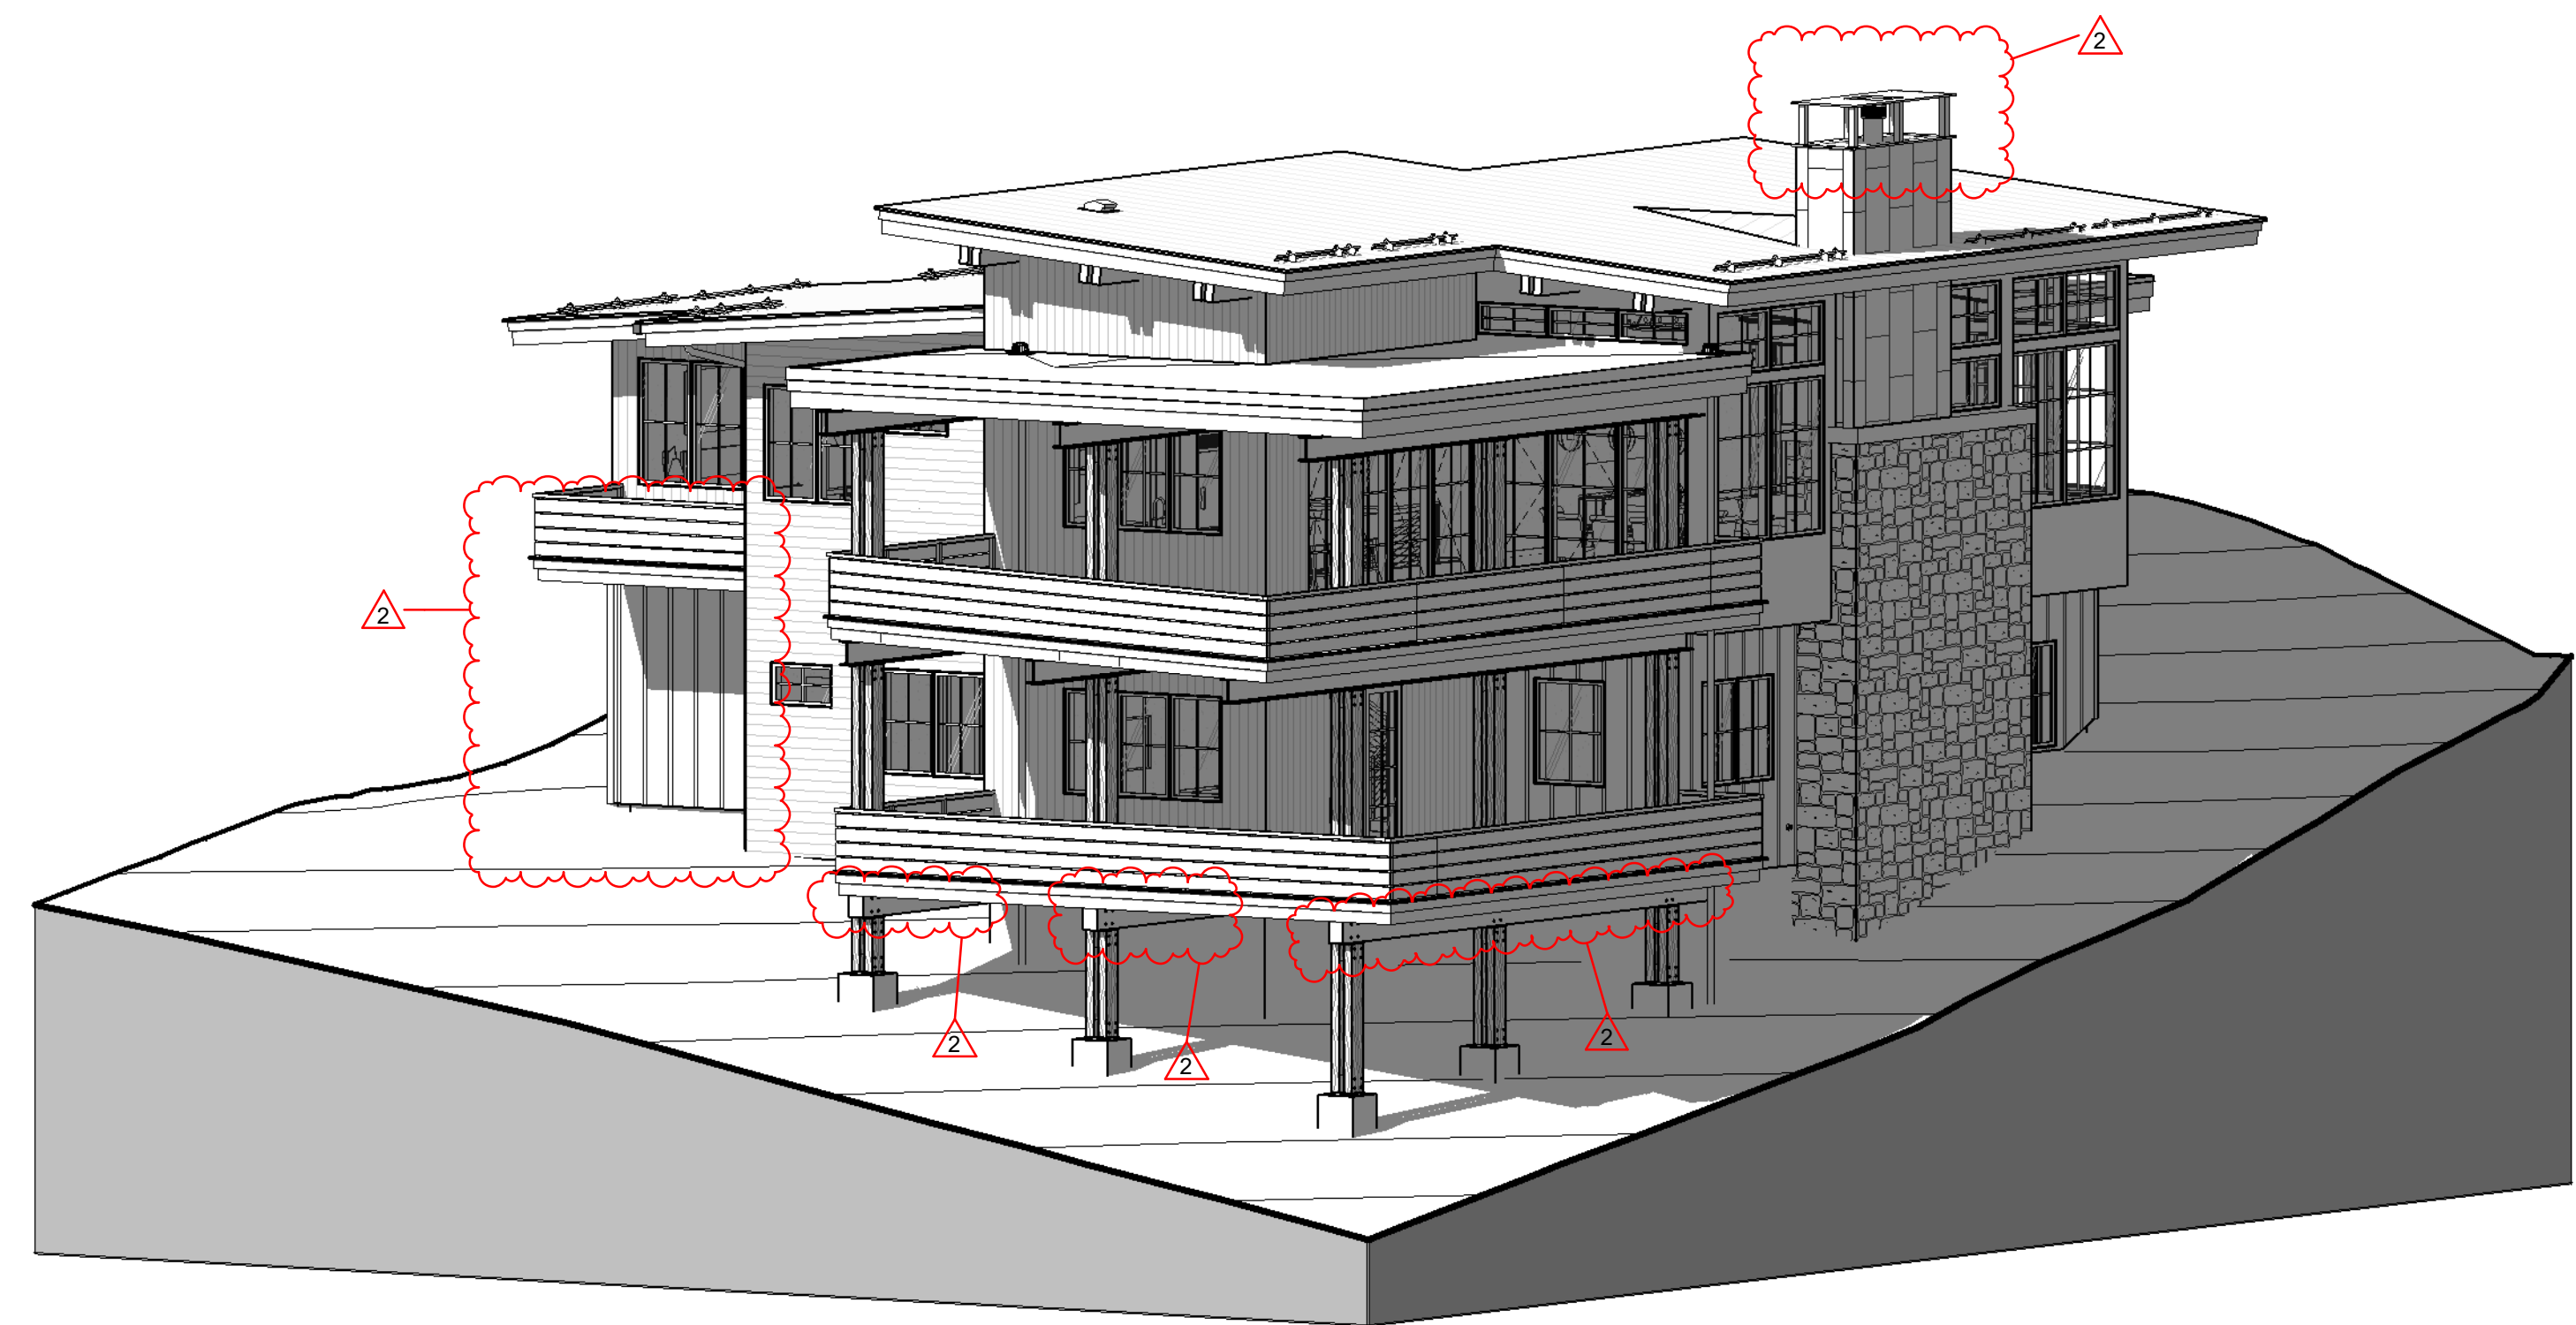

1 PERSPECTIVE #1



VERTICAL
ARTS

Copyright VERTICAL ARTS, INC.
All Rights Reserved

STATE OF COLORADO
ALFRED
CHARLES
LEISER
405237
AUG 23 2019
LICENSED ARCHITECT


#1907

DRAWING TITLE

BUILDING
ELEVATIONS

A3.2

10/14/2019 7:36:35 AM

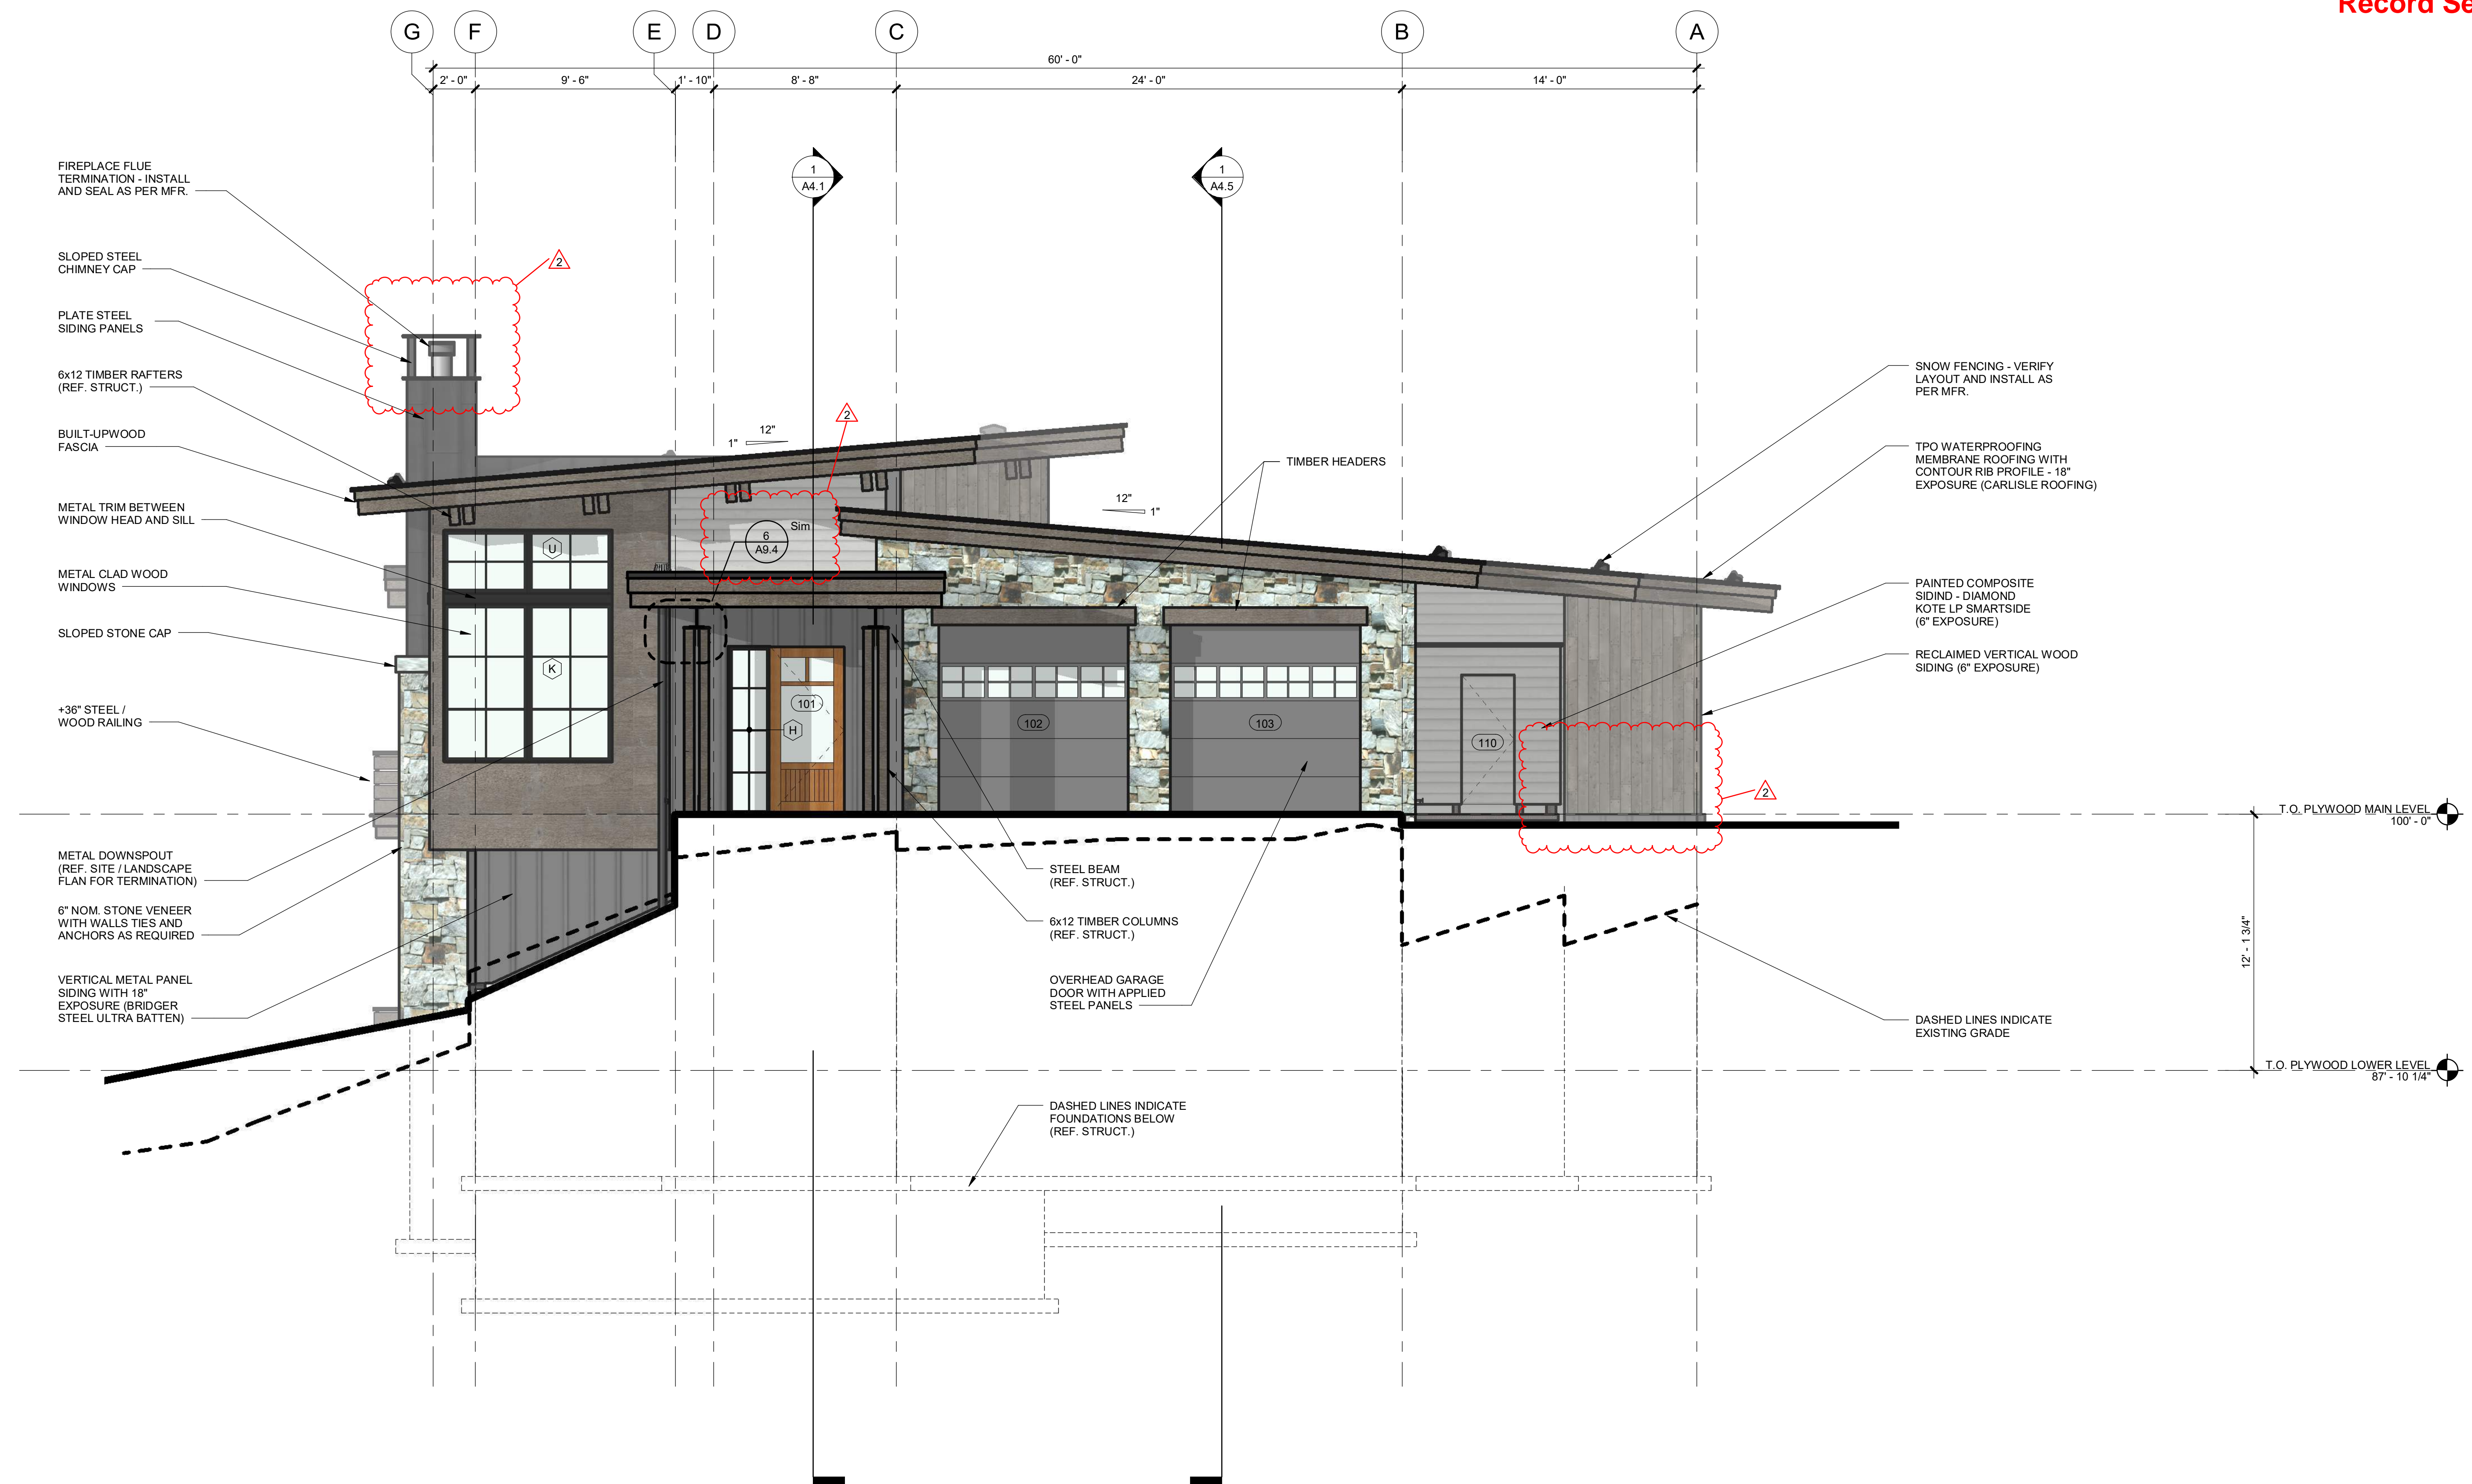

① BUILDING ELEVATION - EAST
1/4" = 1'-0"



ARCHITECTURE
PLANNING
LANDSCAPE
INTERIORS

Copyright VERTICAL ARTS, INC.
All Rights Reserved
This document, and the ideas and designs
incorporated herein, are an instrument of
professional service, is the property of Vertical
Arts Inc. and is not to be used, in whole or in part,
for any other project without the written
authorization from a principal of Vertical Arts, Inc.



CAMPBELL RESIDENCE
LOT #5 - EAGLES VISTA
STEAMBOAT SPRINGS, CO.
#1907

| ISSUE NAME | DATE |
|---------------------|------------|
| PRICING SET | 05/21/2019 |
| REVISED PRICING SET | 06/14/2019 |
| 50% DD | 07/03/2019 |
| MINOR ADJUSTMENT | 07/12/2019 |
| BUILDING PERMIT | 08/23/2019 |
| REVISIONS | 10/14/2019 |

DRAWING TITLE

BUILDING
ELEVATIONS

SHEET NO.

A3.3

10/14/2019 7:36:41 AM




1 BUILDING ELEVATION - WEST
1/4" = 1'-0"



ARCHITECTURE
PLANNING
LANDSCAPE
INTERIORS

Copyright VERTICAL ARTS, INC.
All Rights Reserved
This document, and the ideas and designs
incorporated herein, are an instrument of
professional service, is the property of Vertical
Arts Inc. and is not to be used, in whole or in part,
for any other project without the written
authorization from a principal of Vertical Arts, Inc.

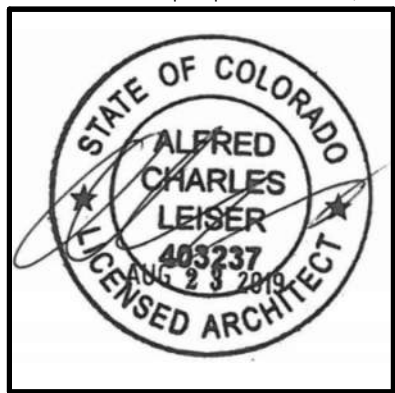

CAMPBELL RESIDENCE
LOT #5 - EAGLES VISTA
STEAMBOAT SPRINGS, CO.
#1907

| ISSUE NAME | DATE |
|---------------------|------------|
| PRICING SET | 05/21/2019 |
| REVISED PRICING SET | 06/14/2019 |
| 50% DD | 07/03/2019 |
| MINOR ADJUSTMENT | 07/12/2019 |
| BUILDING PERMIT | 08/23/2019 |
| NE REVISIONS | 10/14/2019 |


DRAWING TITLE

BUILDING
ELEVATIONS

SHEET NO.

A3.4

10/14/2019 7:36:47 AM

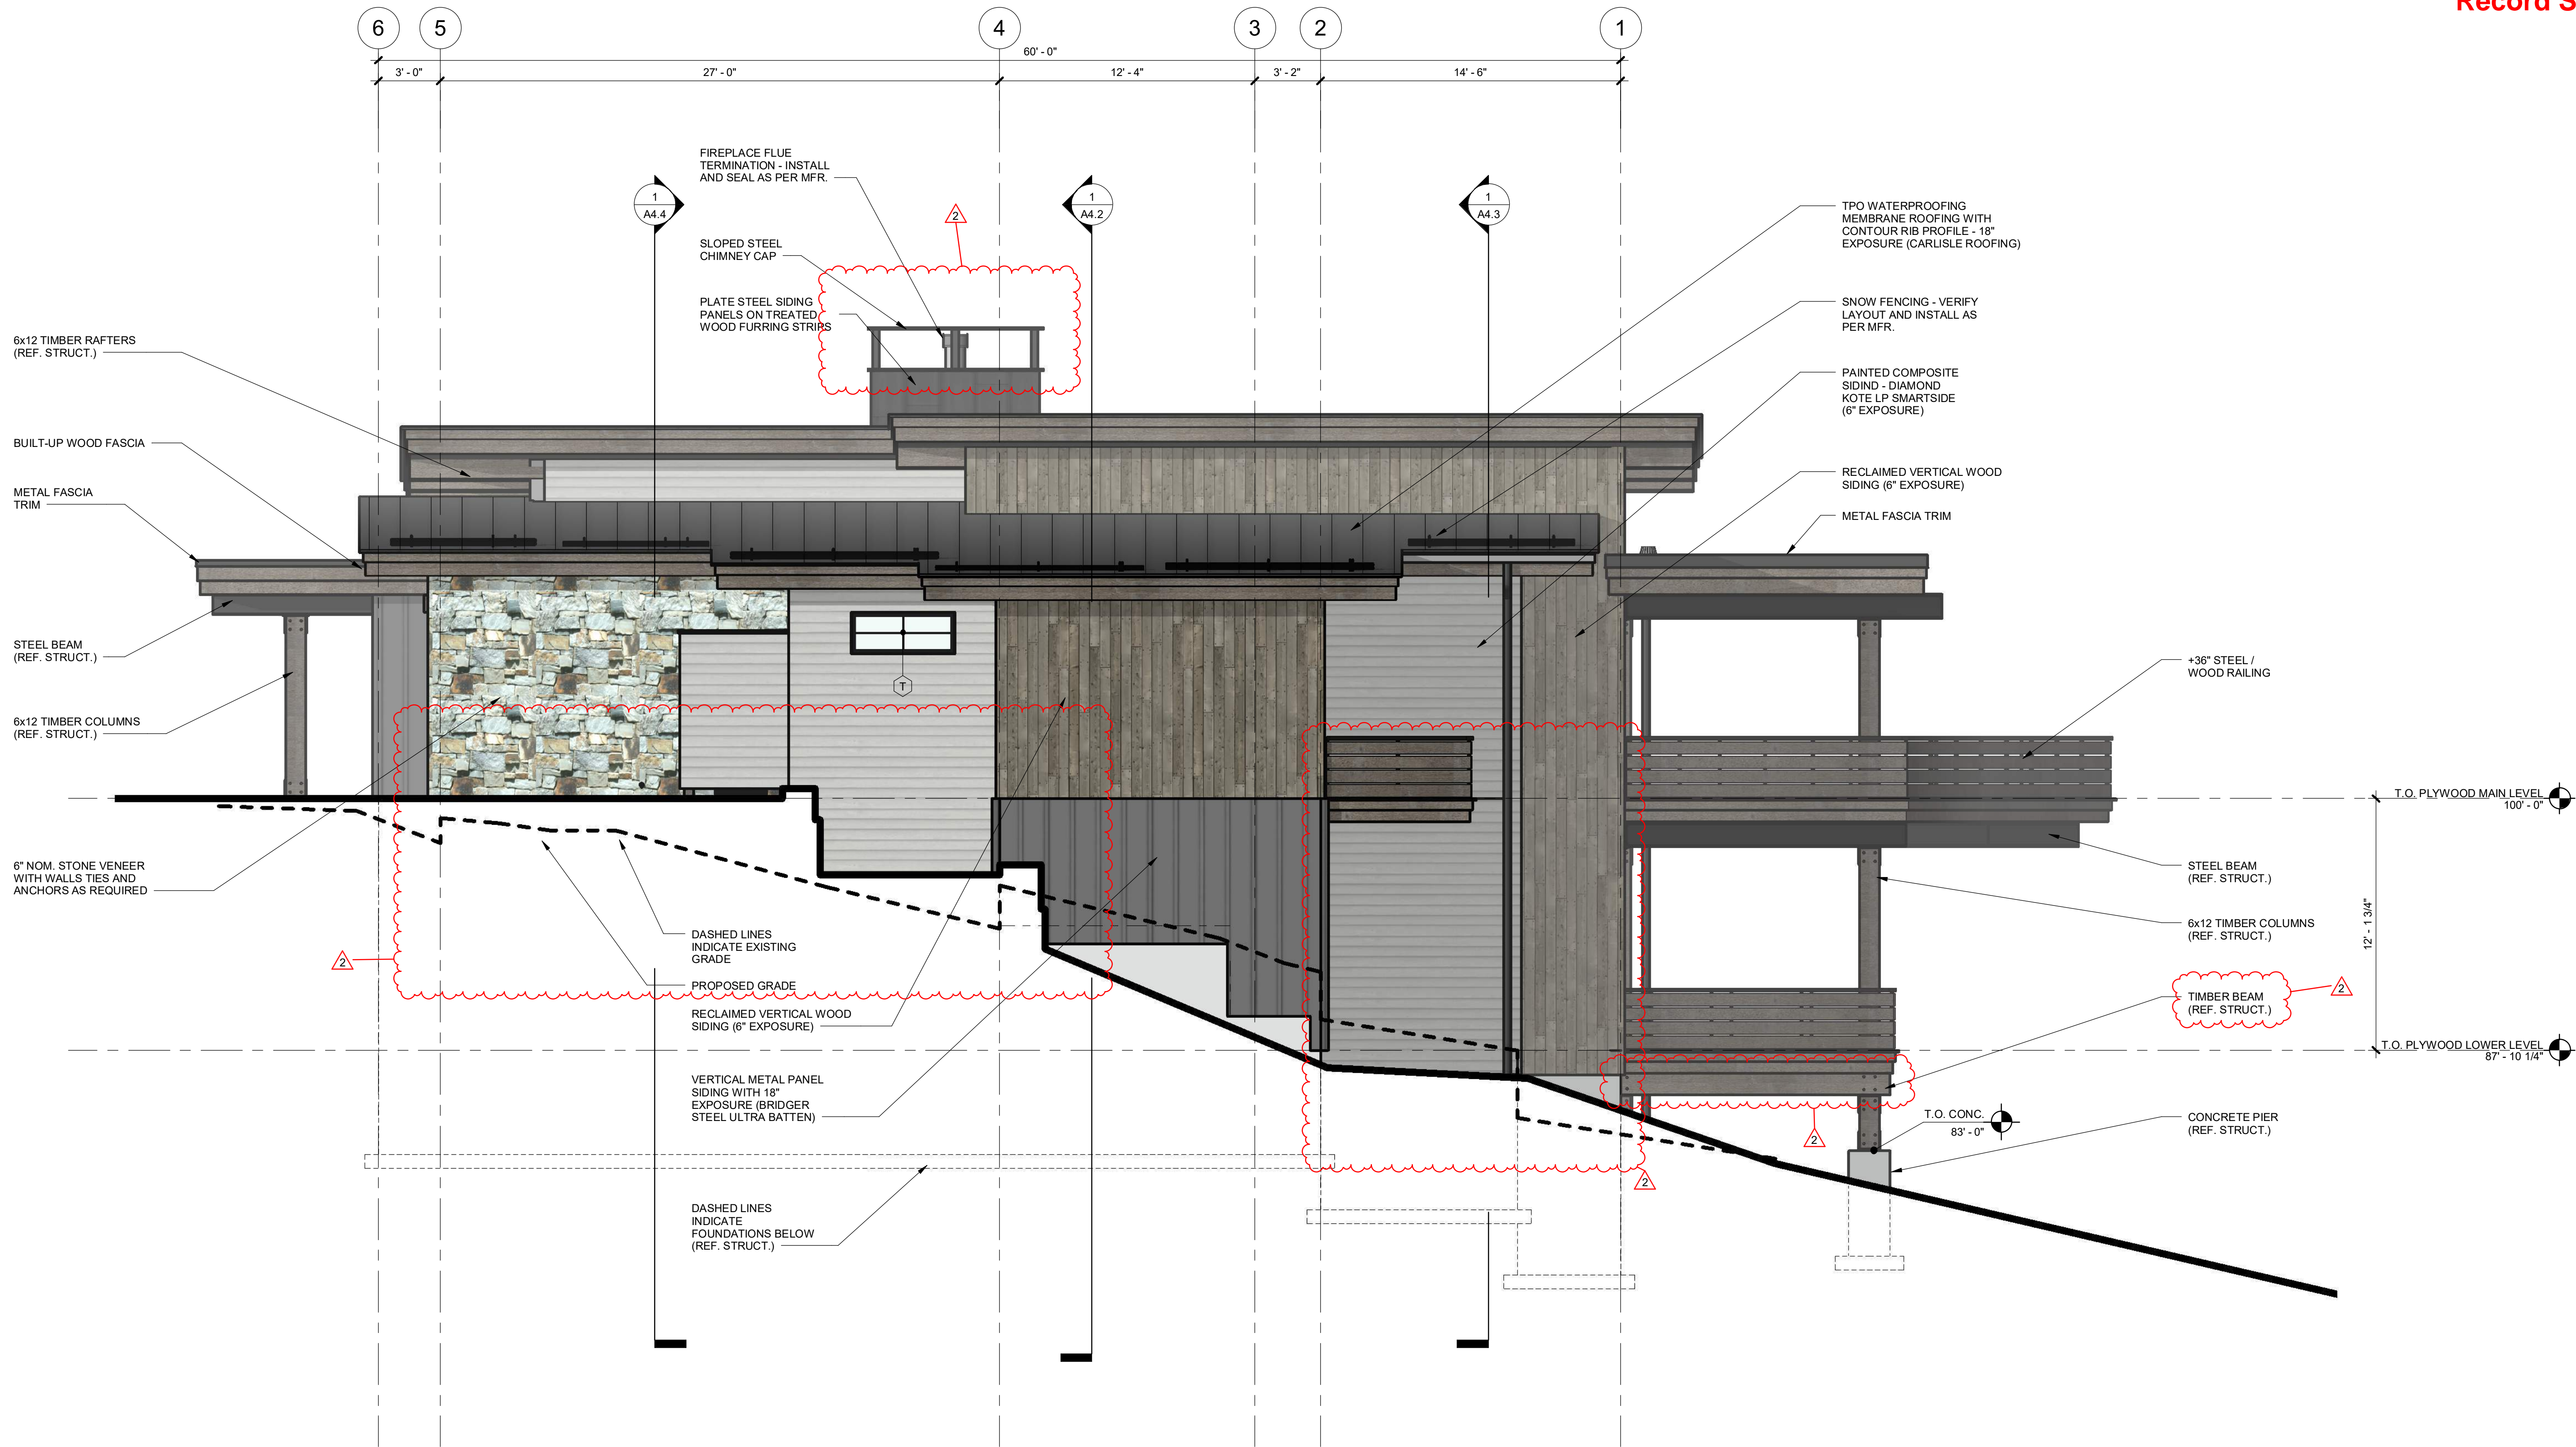

1 NORTH ELEVATION
1/4" = 1'-0"




VERTICAL
ARTS

Copyright VERTICAL ARTS, INC.
All Rights Reserved

[illegible]

SHEET NO.

10/14/2019 7:36:53 AM

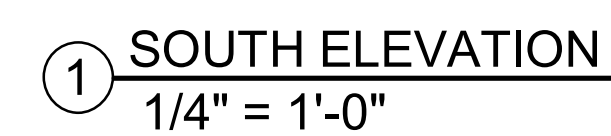



ARCHITECTURE
PLANNING
LANDSCAPE
INTERIORS

Copyright VERTICAL ARTS, INC.
All Rights Reserved

This document, and the ideas and designs
incorporated herein, are an instrument of
professional services, is the property of Vertical
Arts Inc. and is not to be used, in whole or in part,
for any other project without the written
authorization from a principal of Vertical Arts, Inc.



CAMPBELL RESIDENCE
LOT #5 - EAGLES VISTA
STEAMBOAT SPRINGS, CO.
#1907

| ISSUE NAME | DATE |
|---------------------|------------|
| 50% DD | 07/03/2019 |
| MINOR ADJUSTMENT | 07/12/2019 |
| BUILDING PERMIT | 08/23/2019 |
| PERMIT RE-SUBMITTAL | 09/25/2019 |
| VE REVISIONS | 10/14/2019 |


DRAWING TITLE

BUILDING SECTIONS

SHEET NO.

A4.1

10/14/2019 7:36:56 AM

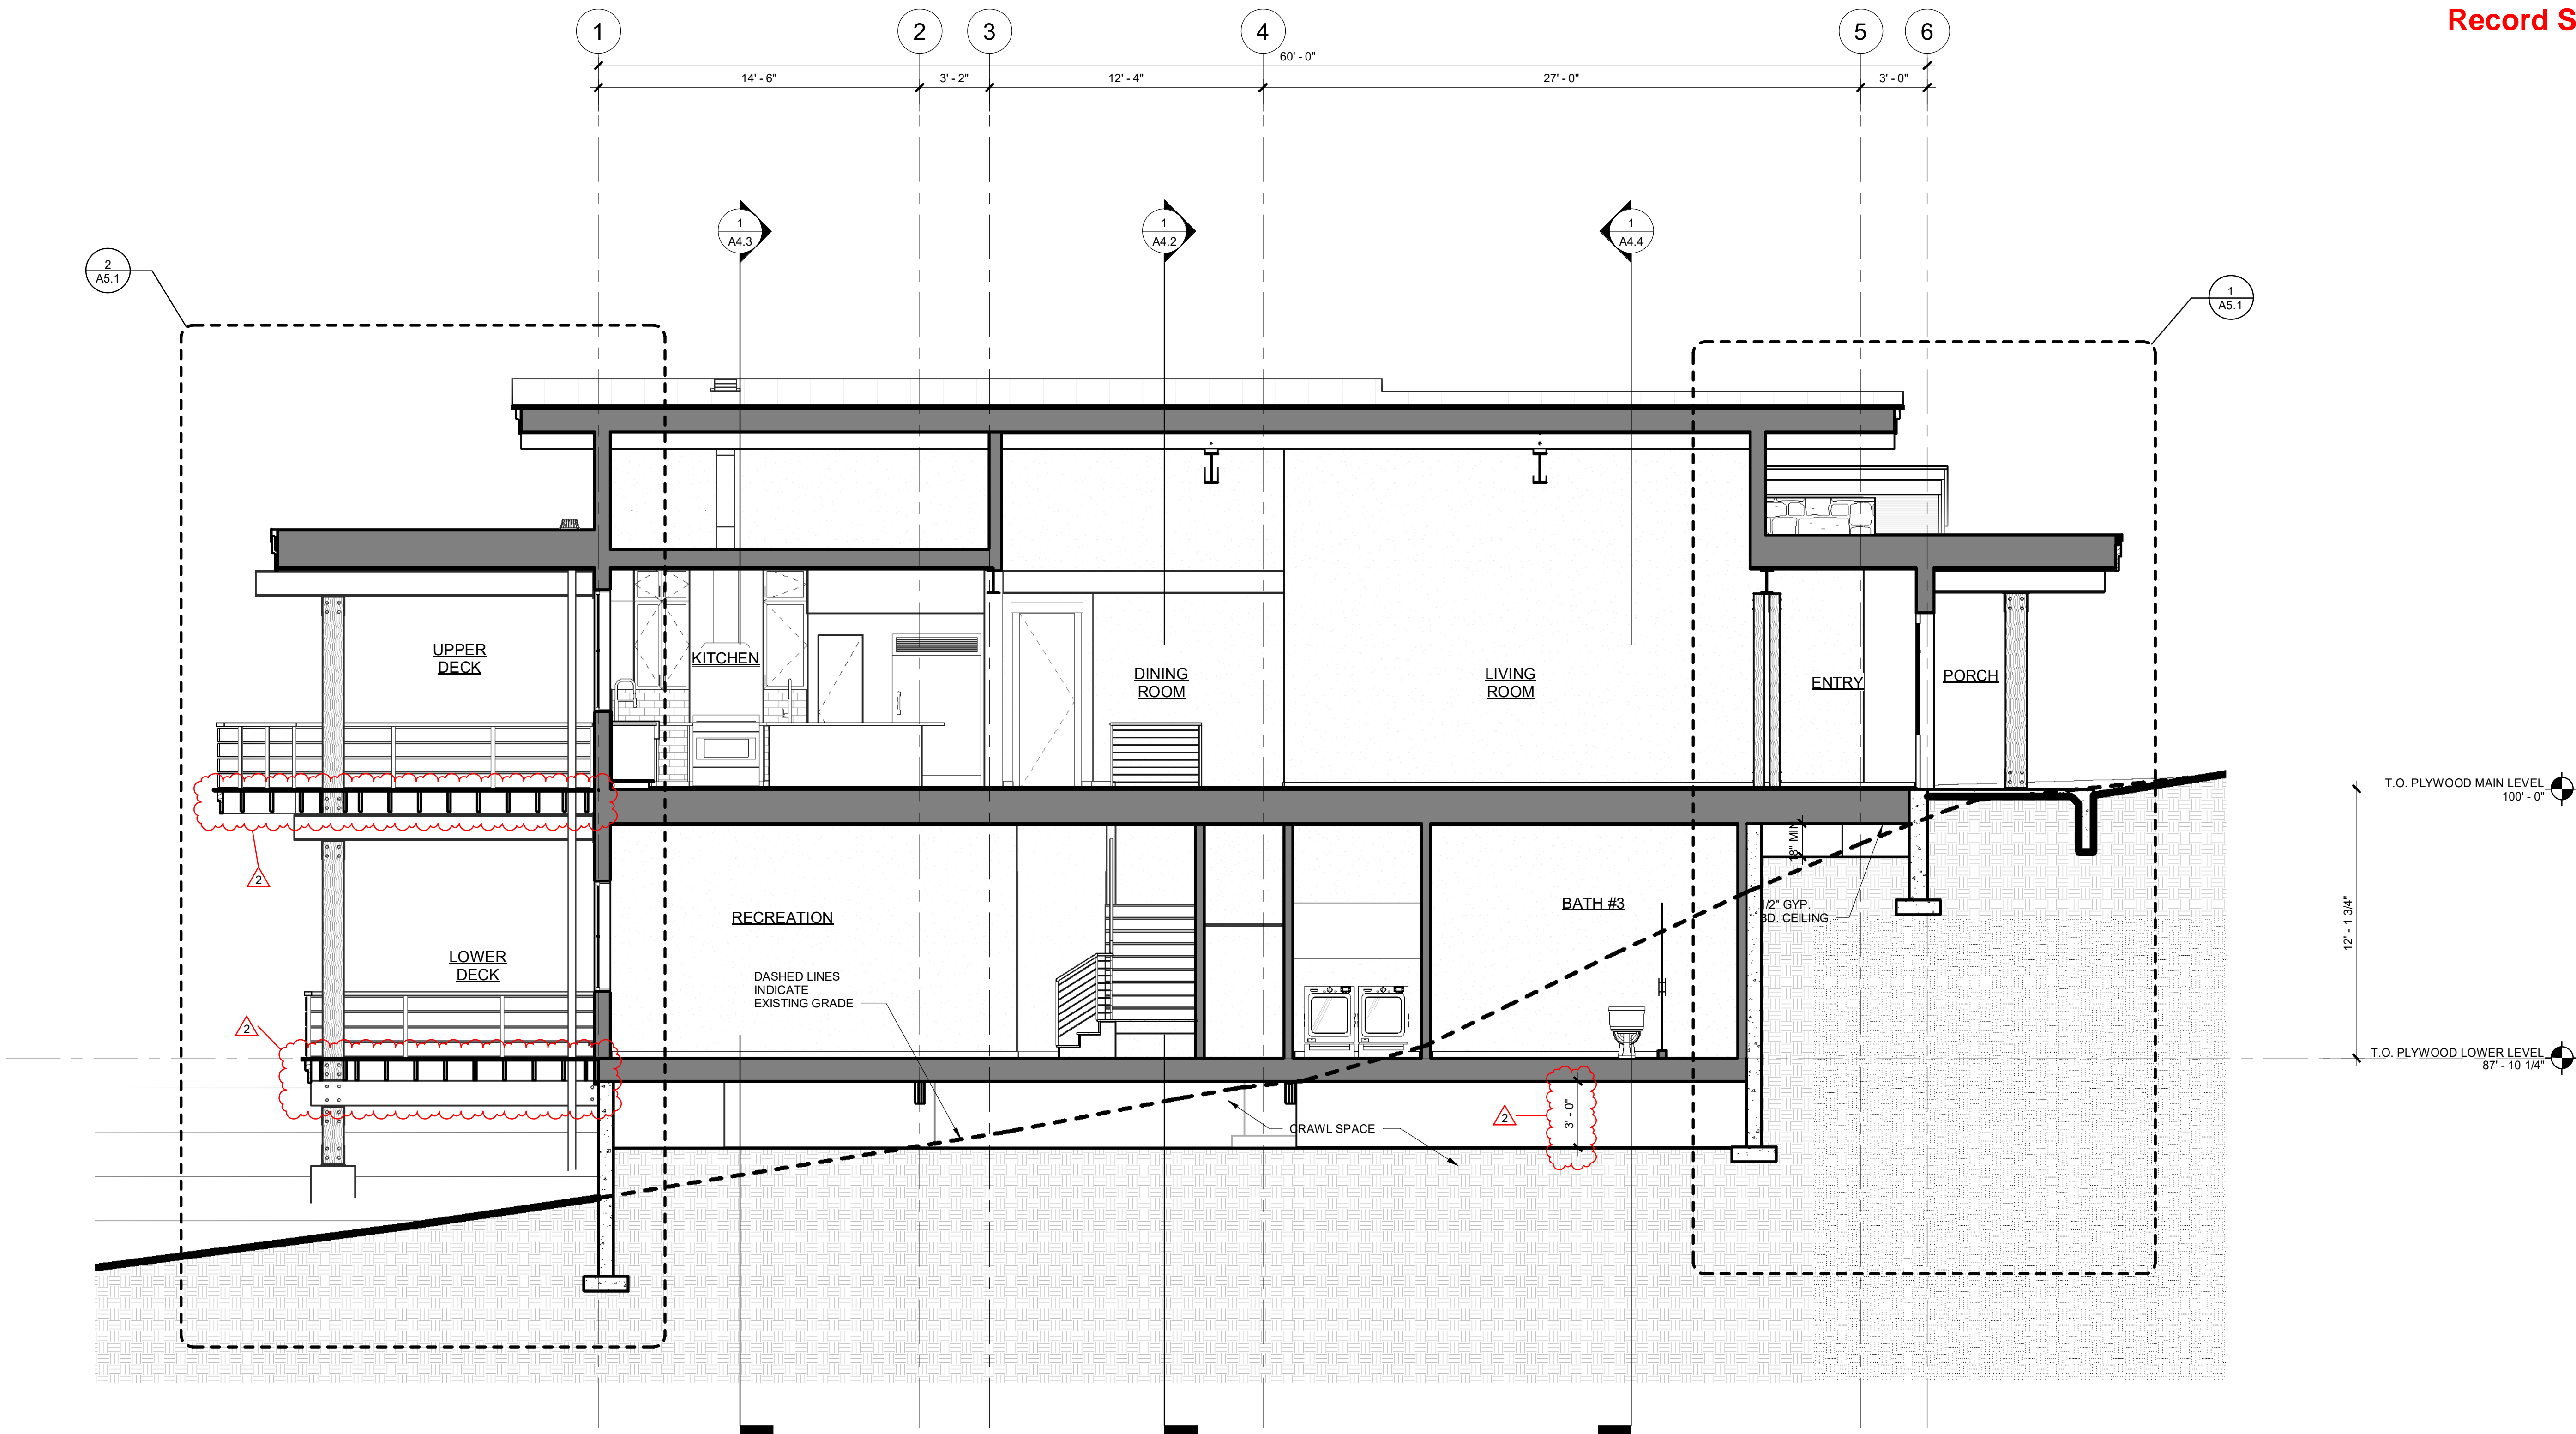


1 BUILDING SECTION
1/4" = 1'-0"



ARCHITECTURE
PLANNING
LANDSCAPE
INTERIORS

Copyright VERTICAL ARTS, INC.
All Rights Reserved

This document, and the ideas and designs
incorporated herein, are an instrument of
professional service, is the property of Vertical
Arts Inc. and is not to be used, in whole or in part,
for any other project without the written
authorization from a principal of Vertical Arts, Inc.

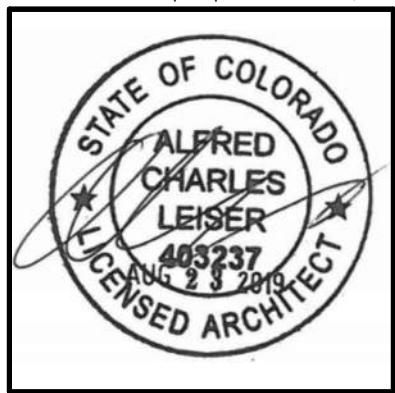

CAMPBELL RESIDENCE
LOT #5 - EAGLES VISTA
STEAMBOAT SPRINGS, CO.
#1907

| ISSUE NAME | DATE |
|---------------------|------------|
| 50% DD | 07/03/2019 |
| MINOR ADJUSTMENT | 07/12/2019 |
| BUILDING PERMIT | 08/23/2019 |
| PERMIT RE-SUBMITTAL | 09/25/2019 |
| VE REVISIONS | 10/14/2019 |


DRAWING TITLE

BUILDING SECTIONS


SHEET NO.

A4.2

10/14/2019 7:37:00 AM

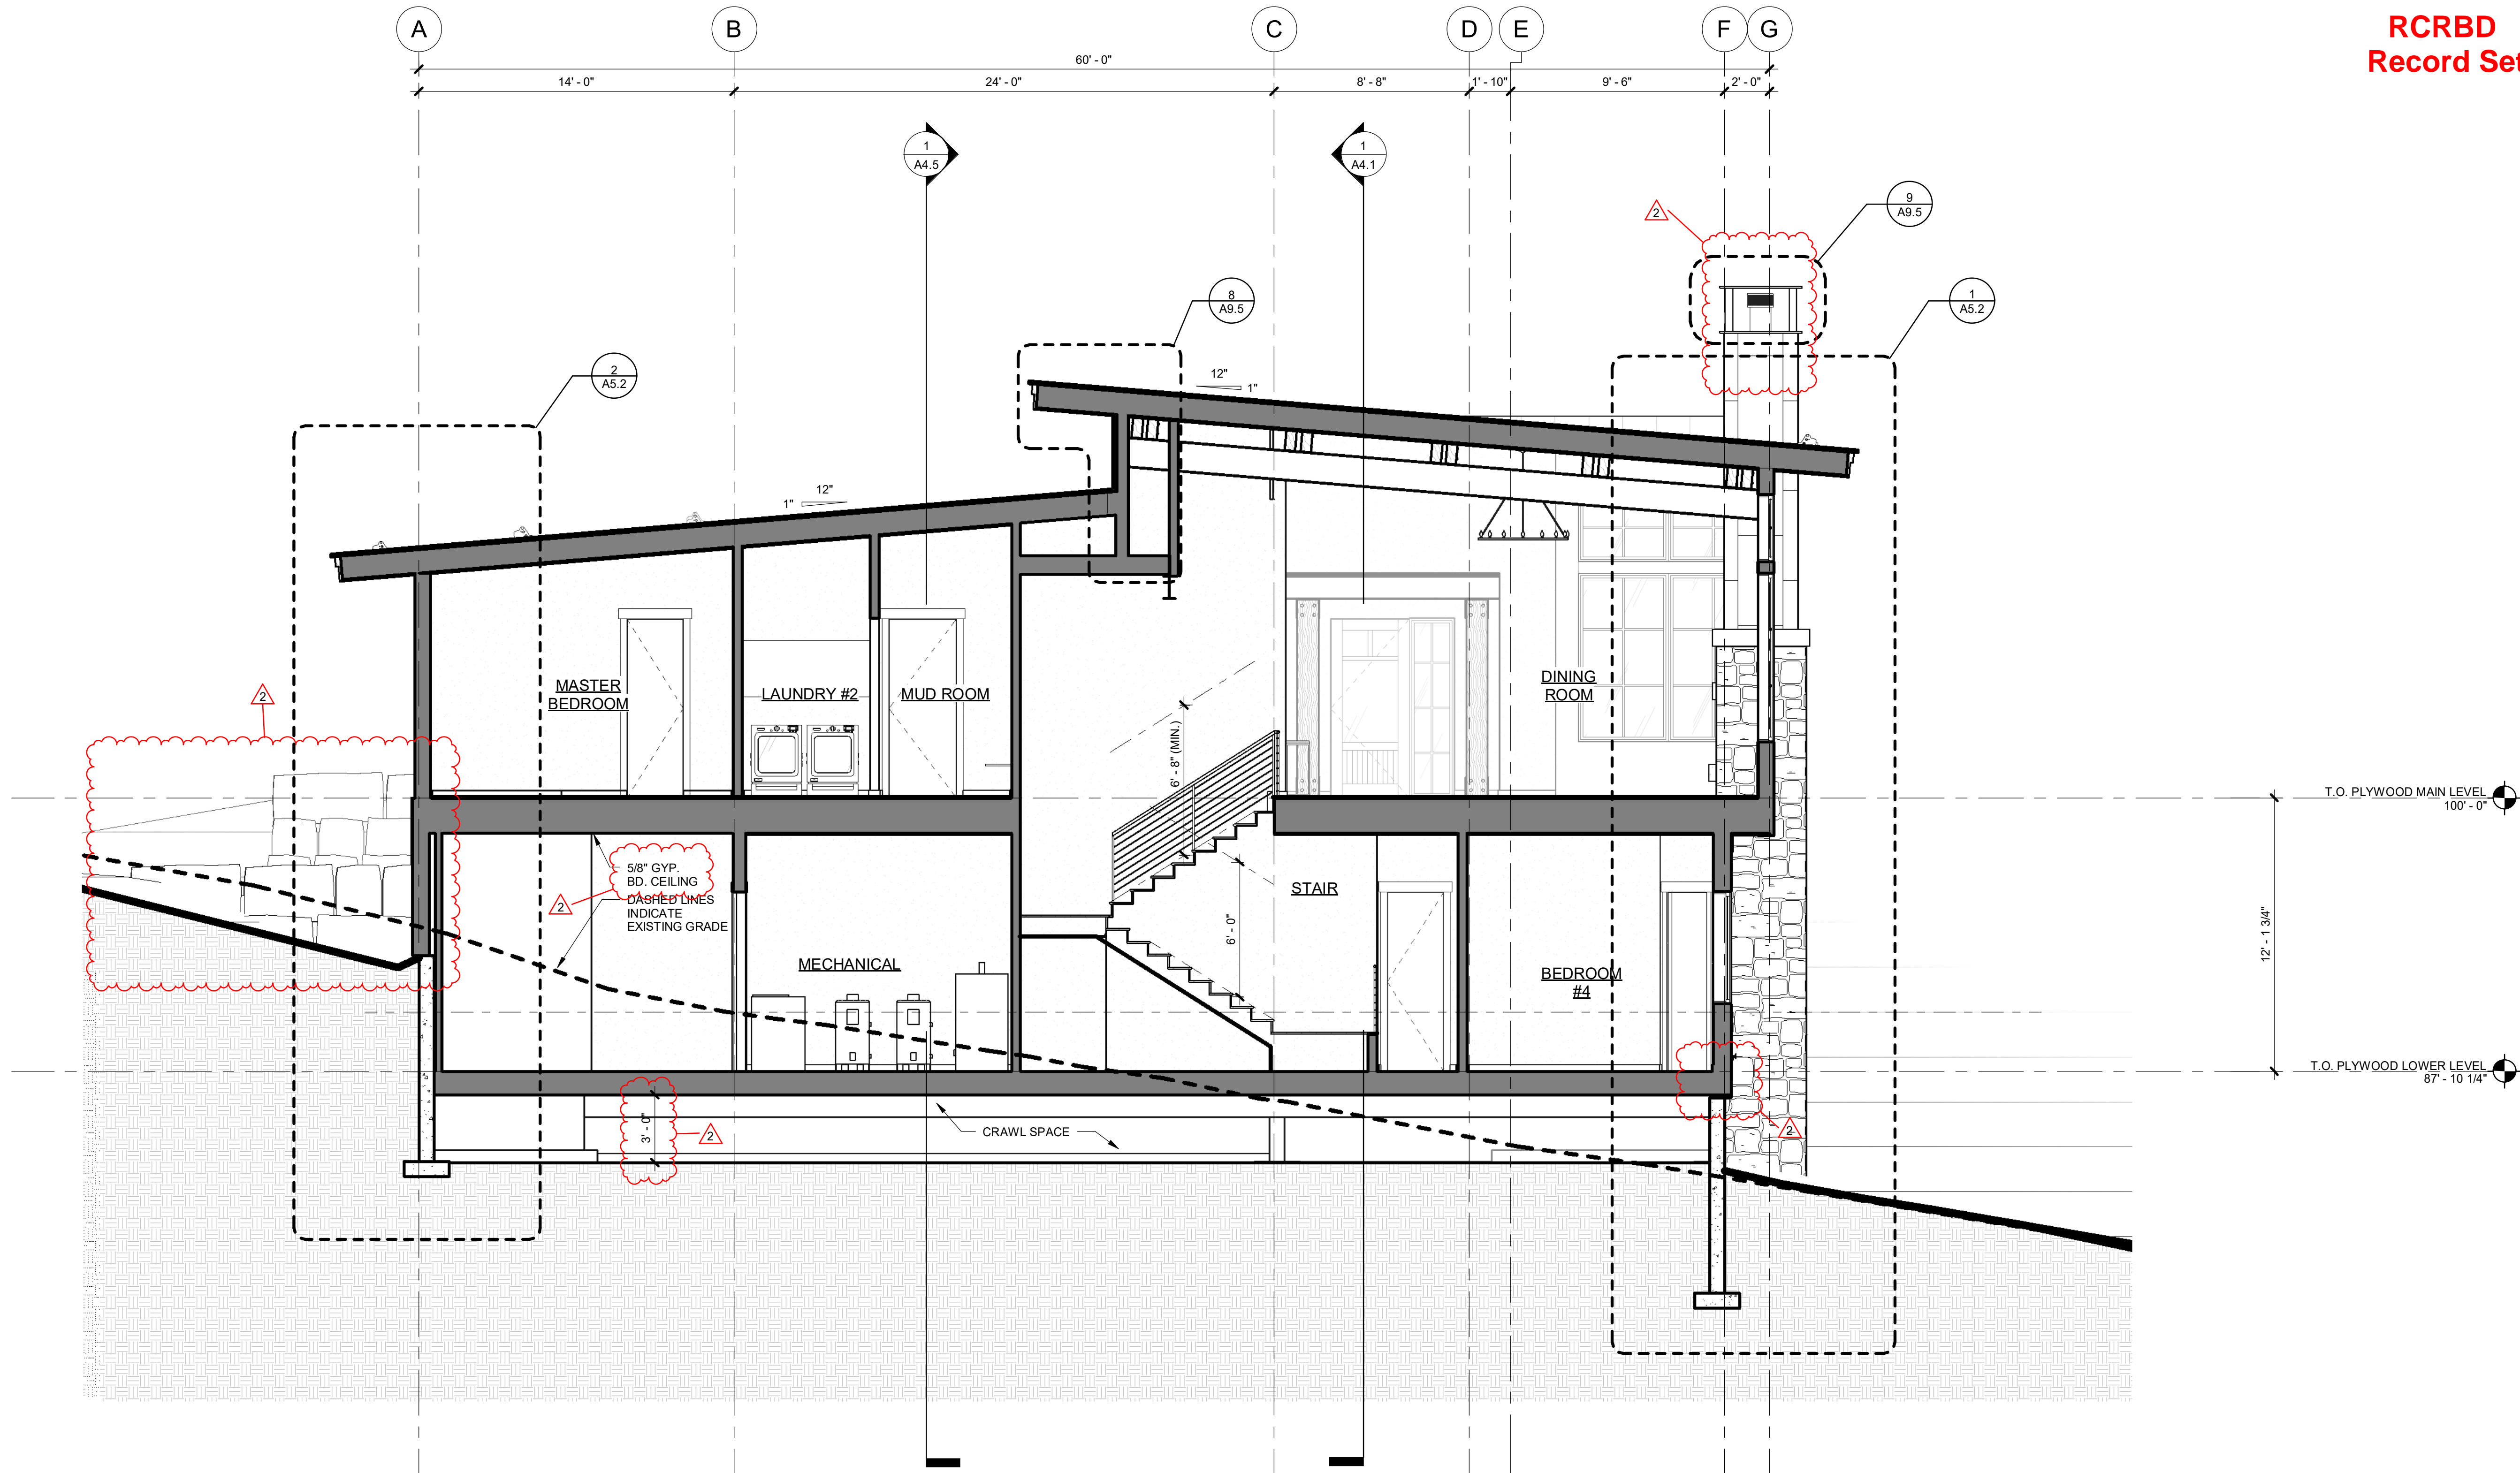

1 BUILDING SECTION
1/4" = 1'-0"

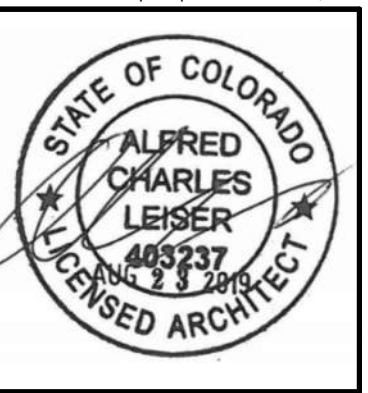


CAMPBELL RESIDENCE
LOT #5 - EAGLES VISTA
STEAMBOAT SPRINGS, CO.
#1907

[illegible]

BUILDING SECTIONS

A4.3

10/14/2019 7:37:03 AM

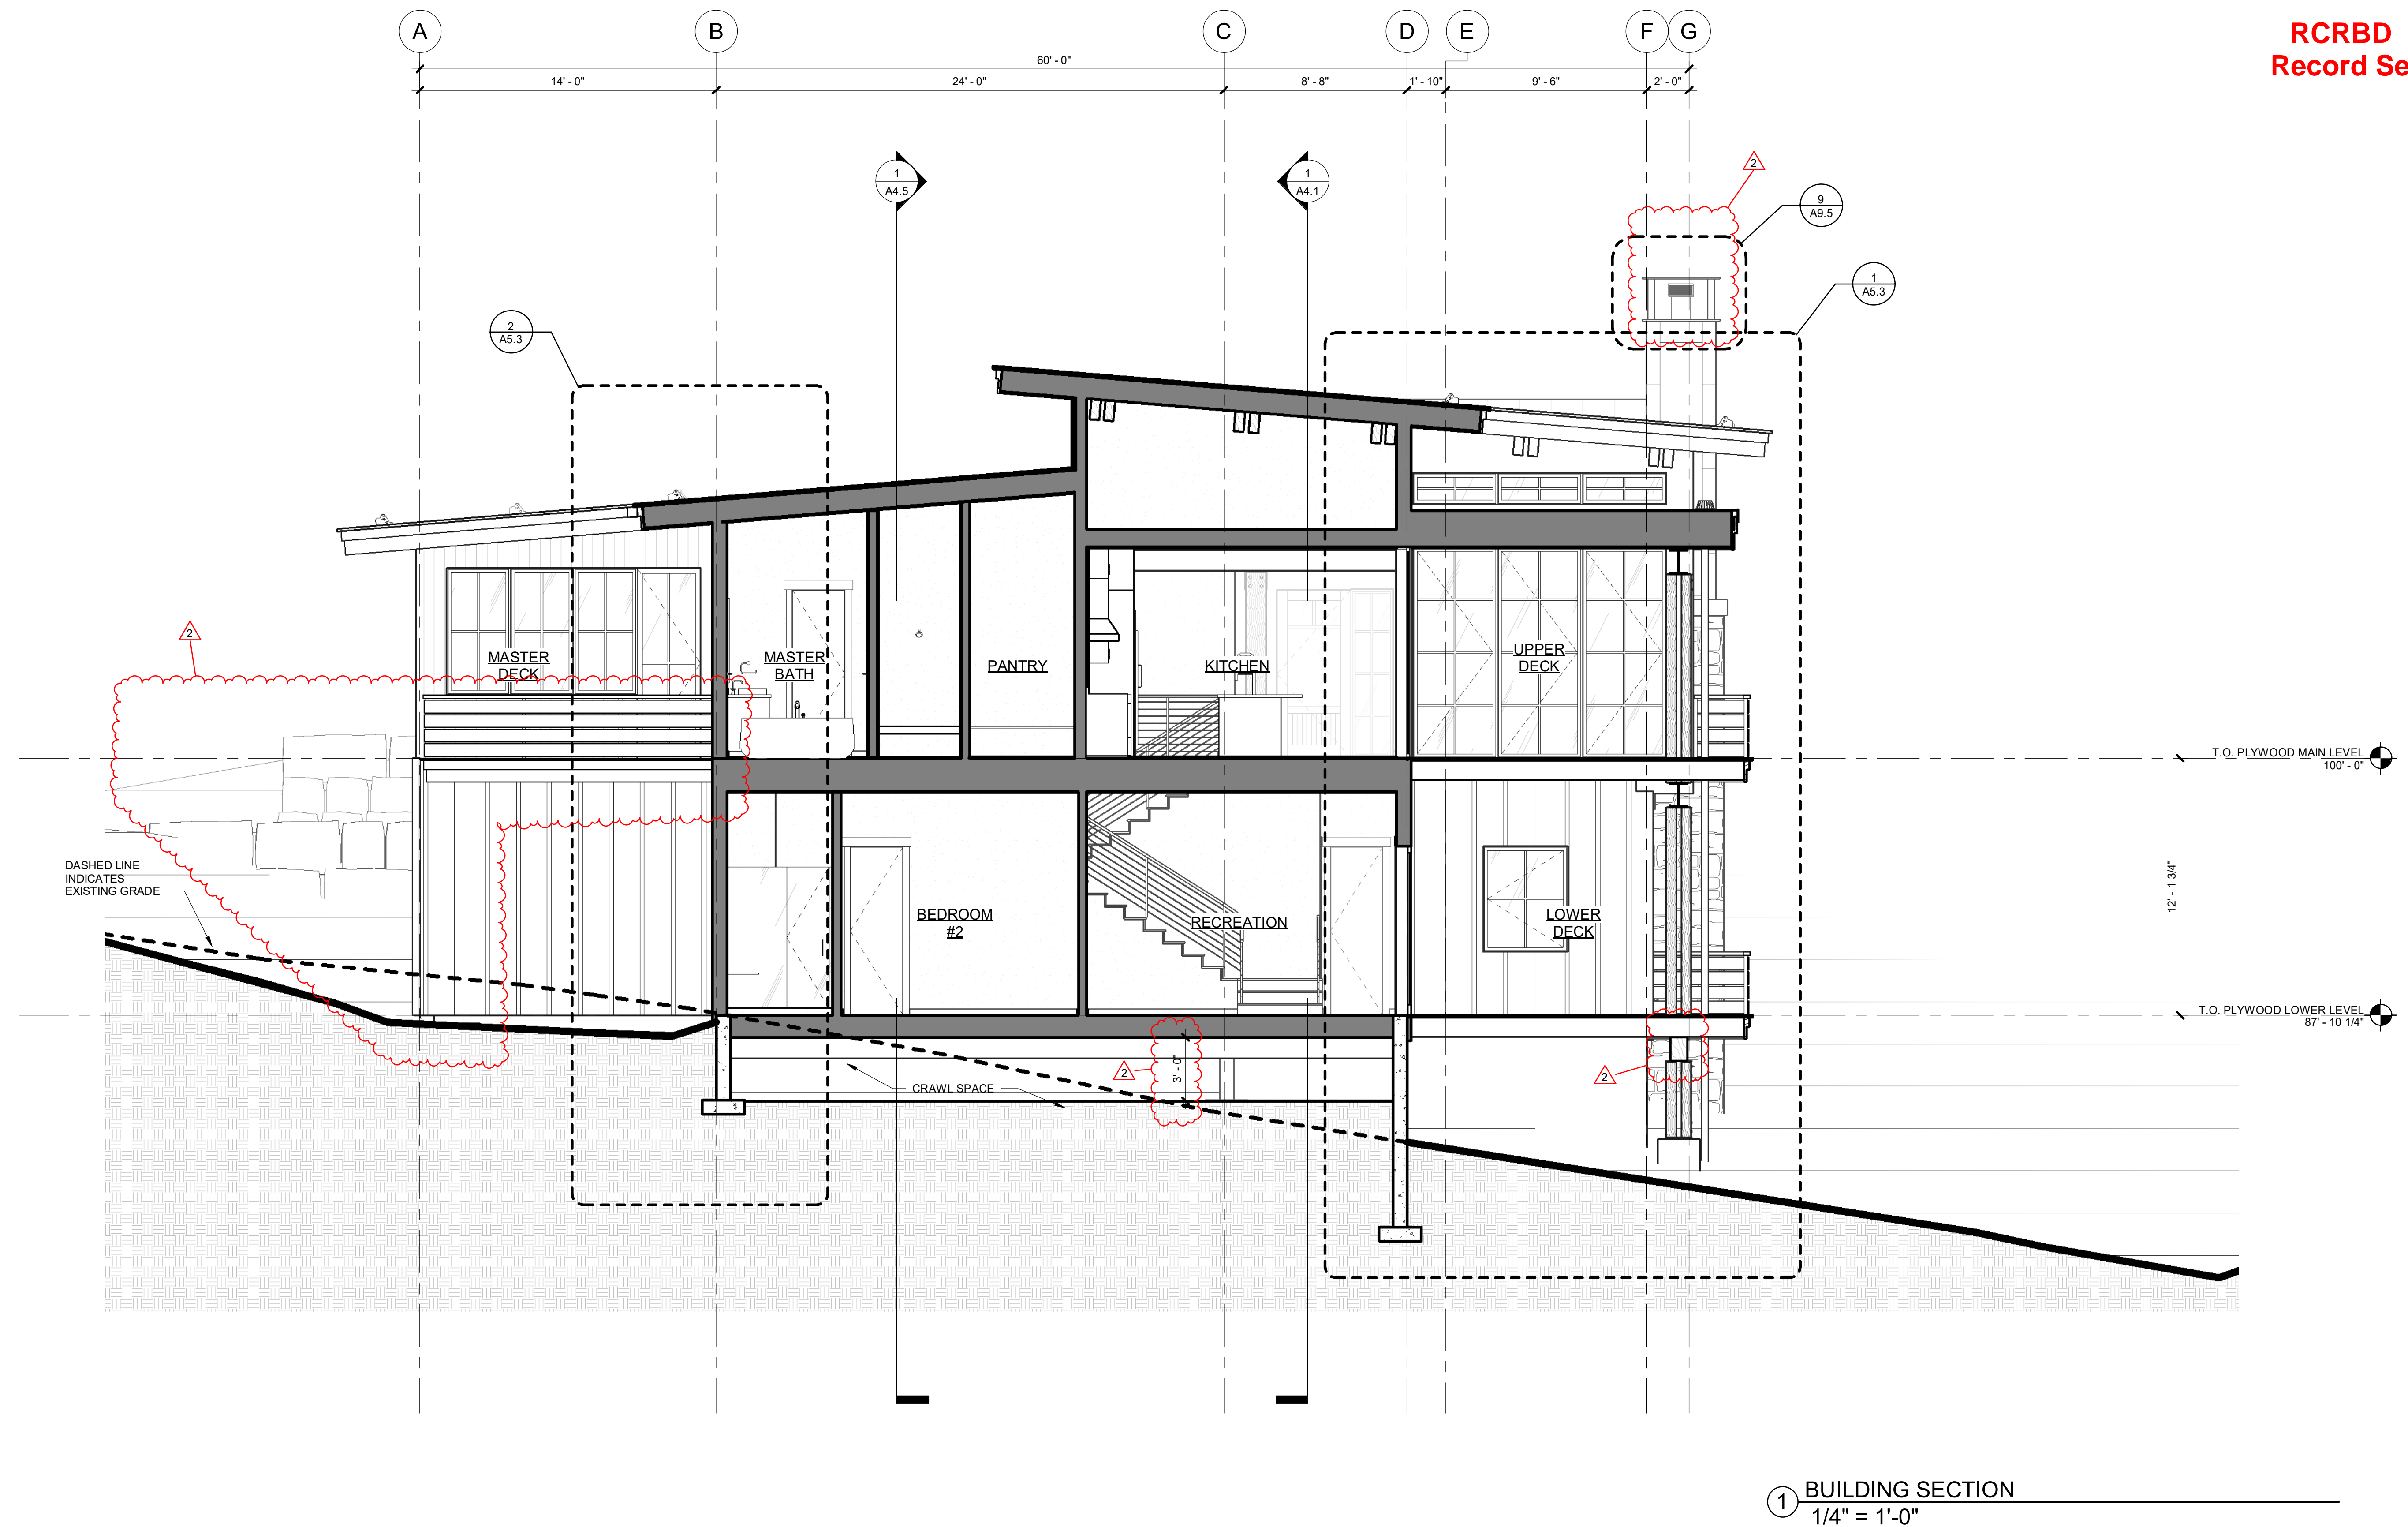



ARCHITECTURE
PLANNING
LANDSCAPE
INTERIORS

Copyright VERTICAL ARTS, INC.
All Rights Reserved
This document, and the ideas and designs
incorporated herein, are the property of Vertical
Arts Inc. and is not to be used, in whole or in part,
for any other project without the written
authorization from a principal of Vertical Arts, Inc.



CAMPBELL RESIDENCE
LOT #5 - EAGLES VISTA
STEAMBOAT SPRINGS, CO.
#1907

| ISSUE NAME | DATE |
|---------------------|------------|
| BUILDING PERMIT | 08/23/2019 |
| PERMIT RE-SUBMITTAL | 09/25/2019 |
| REVISIONS | 10/14/2019 |


DRAWING TITLE

BUILDING SECTIONS

SHEET NO.

A4.4

10/14/2019 7:37:06 AM

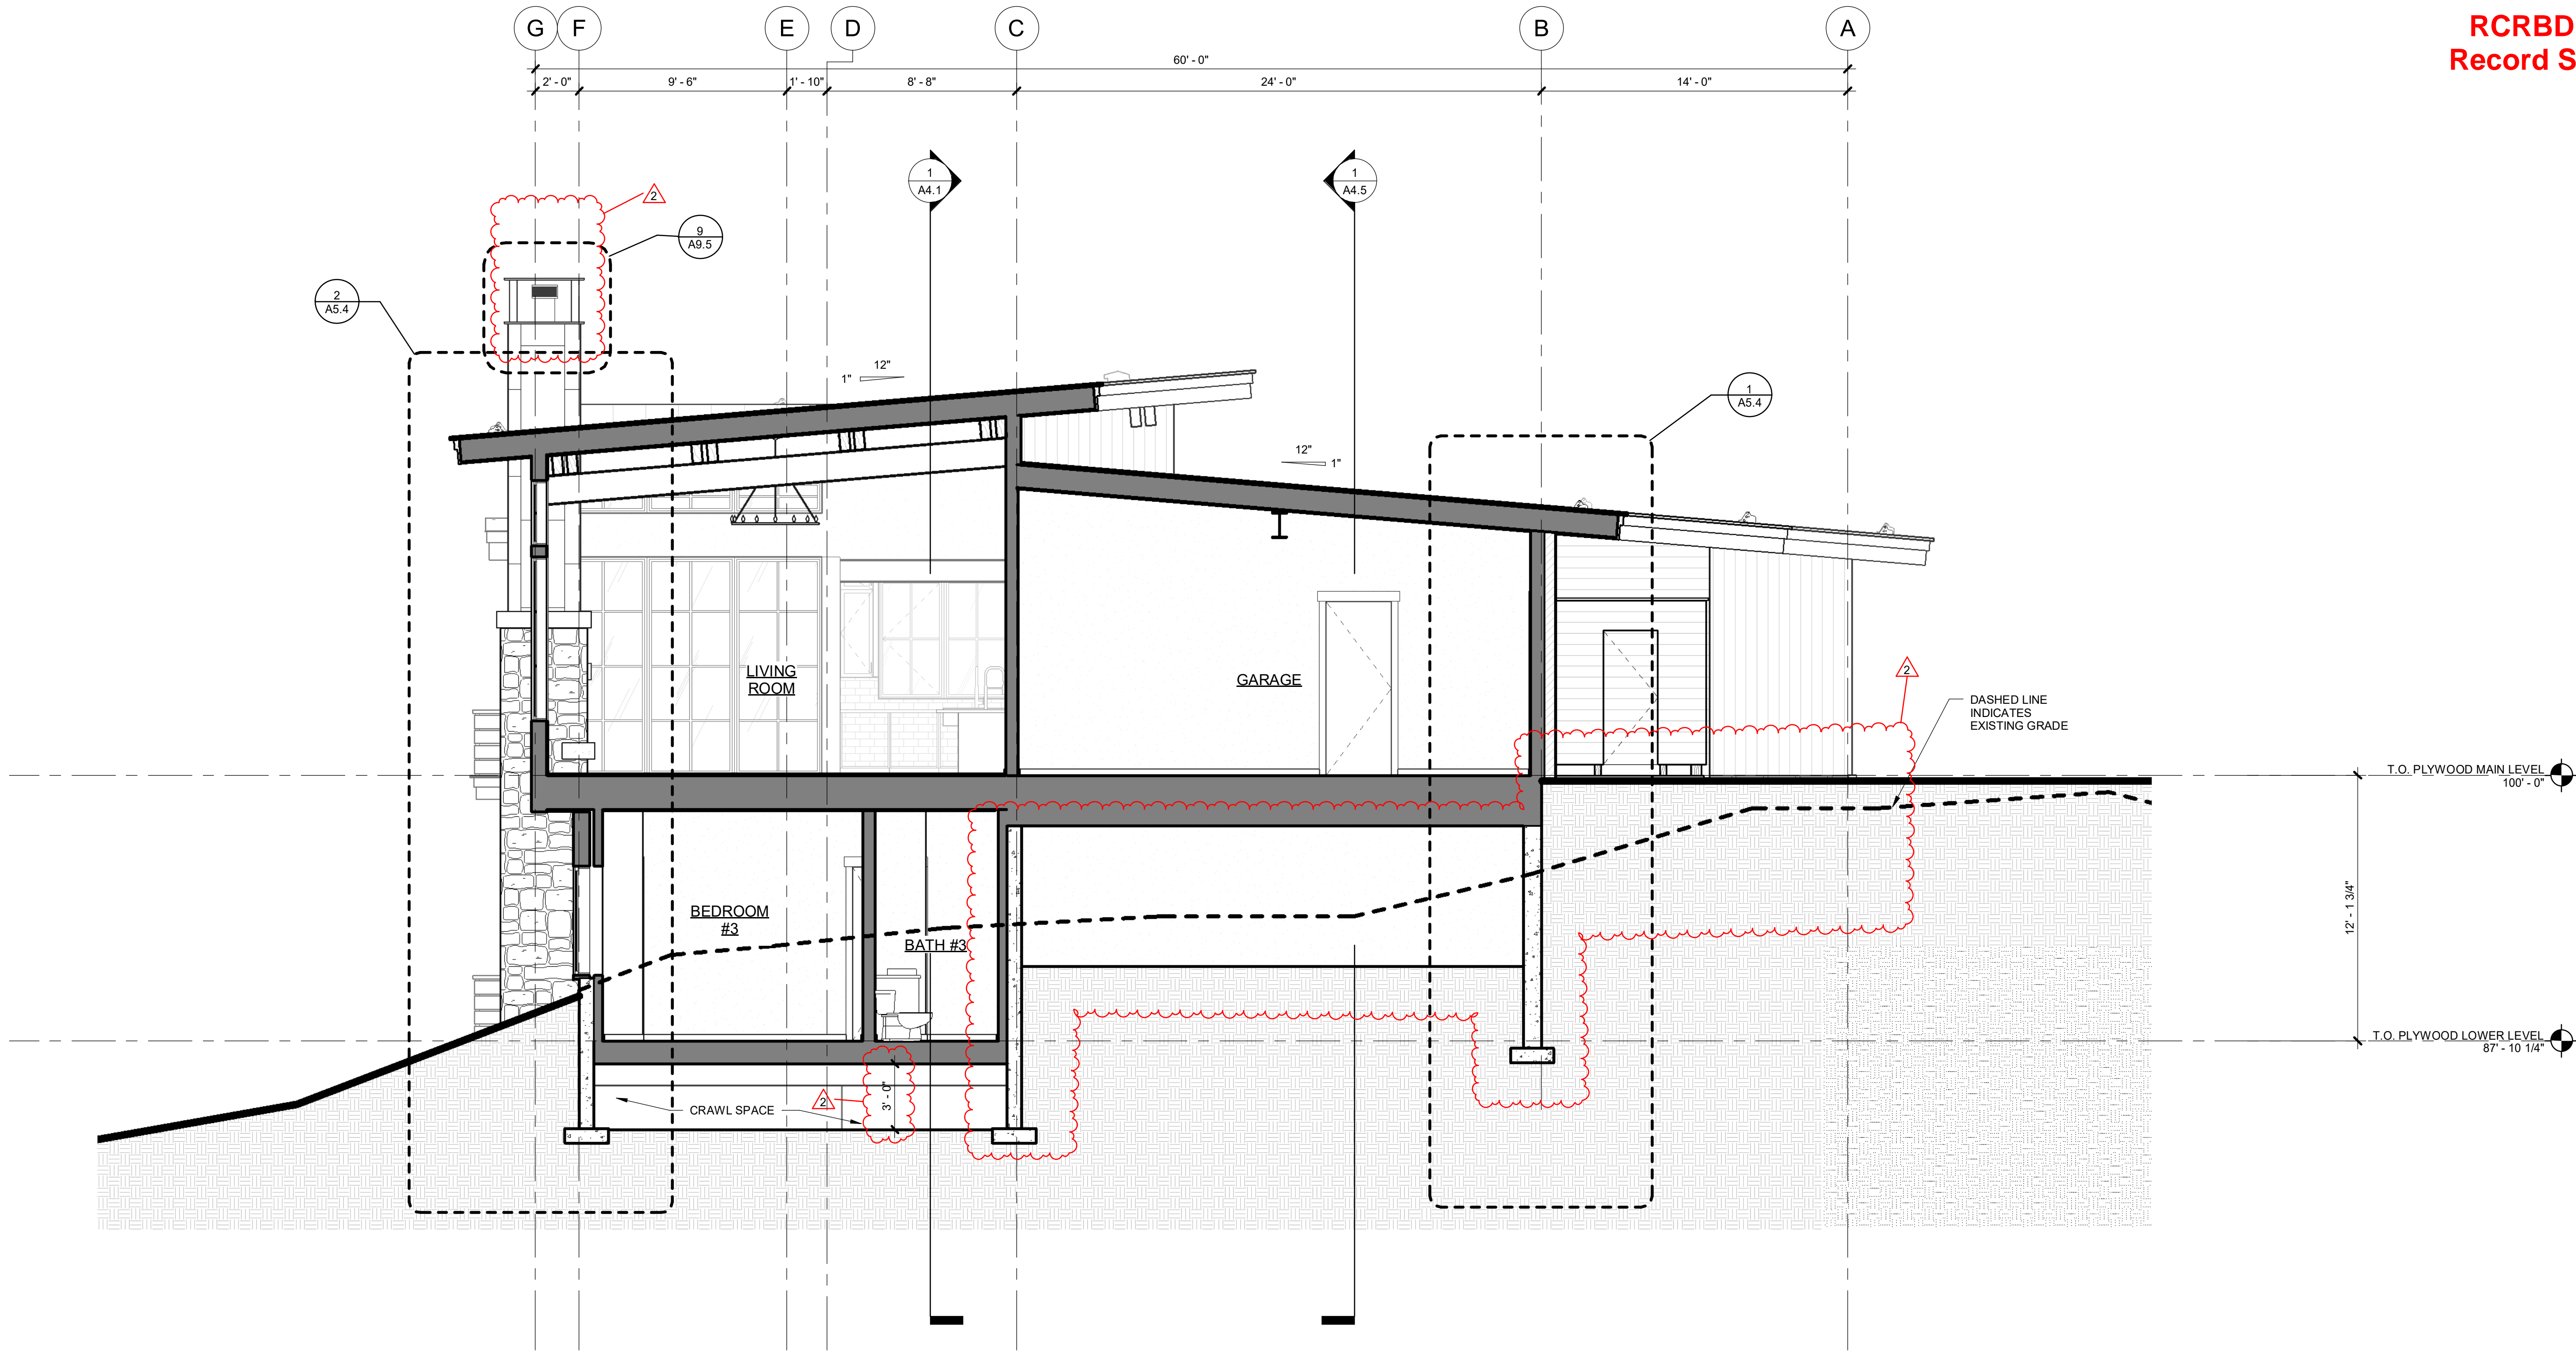

① BUILDING SECTION
1/4" = 1'-0"


#1907

[illegible]

BUILDING SECTIONS

A4.5

10/14/2019 7:37:10 AM

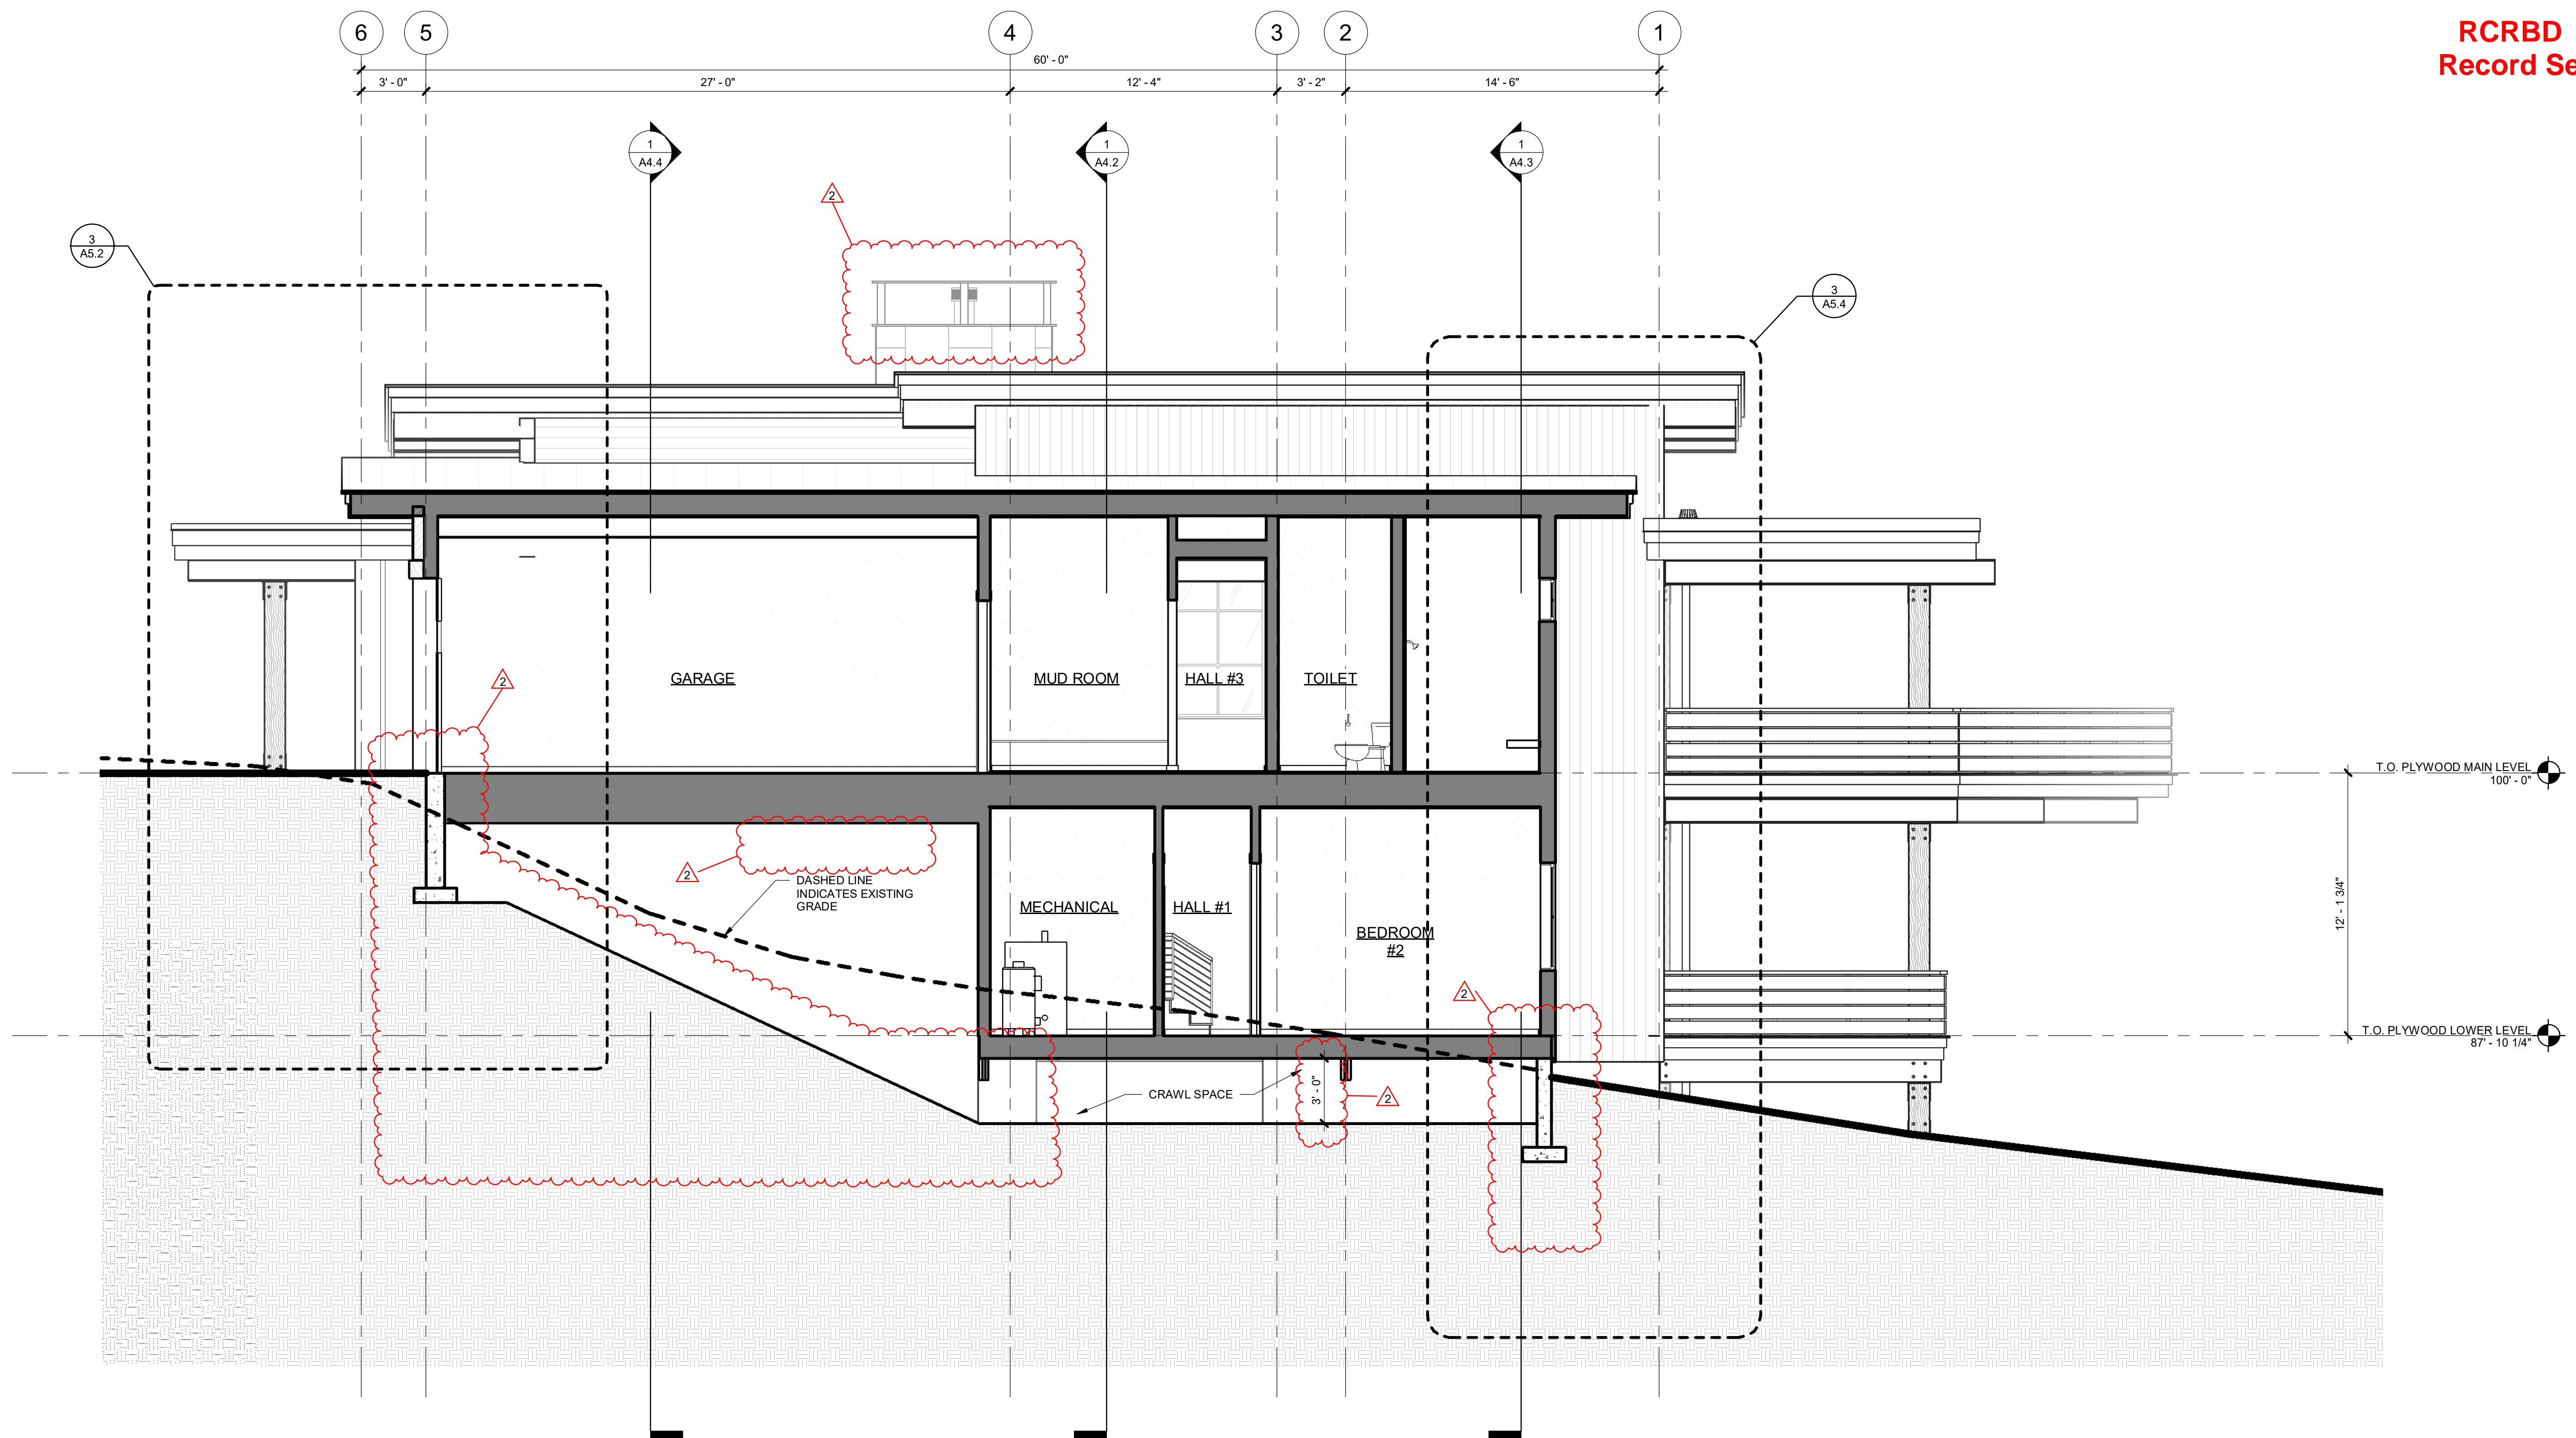



① BUILDING SECTION
1/4" = 1'-0"



- CLASS I VAPOR RETARDER
 - a. OVERLAP ALL JOINTS 6" MIN., SEAL AND TAPE
 - b. EXTEND EDGES 6" MIN. UP STEM WALL AND ATTACH
- RIGID INSULATION
 - a. R-15 MIN. AS PER I.E.C.C.
 - b. EXTEND HORIZONTALLY 2'-0" AT GRADE












A5.1

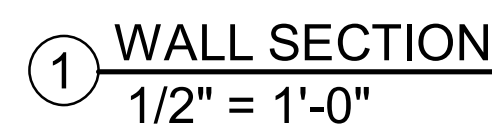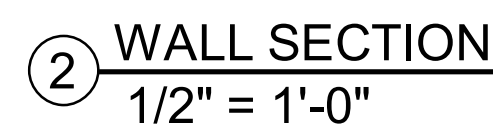


| | | |
|-----------|-------------------------------------|---|
| R1 | ROOF ASSEMBLY - 2 | <ul style="list-style-type: none"> FLEECEBACK TPO WATERPROOFING MEMBRANE ROOFING (CARLISLE ROOFING) <ul style="list-style-type: none"> PROVIDE CONTOUR RIB PROFILE - 18" EXPOSURE ICE AND WATERSHIELD ROOF FRAMING (REF. STRUCT.) INSULATION <ul style="list-style-type: none"> 4" CLOSED CELL SPRAY FOAM INSULATION FILL REMAINING FRAMING CAVITIES WITH BLOWN IN BATT INSULATION (BIBBS) OVERALL INSULATION VALUE: R-49 MIN. AS PER 2015 I.E.C.C. FINISH CEILING |
| R2 | ROOF ASSEMBLY - 2 | <ul style="list-style-type: none"> TPO WATERPROOFING MEMBRANE ROOFING TAPERED RIGID INSULATION PLYWOOD SHEATHING (REF. STRUCT.) ROOF FRAMING (REF. STRUCT.) INSULATION <ul style="list-style-type: none"> 4" CLOSED CELL SPRAY FOAM INSULATION FILL REMAINING FRAMING CAVITIES WITH BLOWN IN BATT INSULATION (BIBBS) OVERALL INSULATION VALUE: R-49 MIN. AS PER 2015 I.E.C.C. FINISH CEILING |
| R3 | ROOF ASSEMBLY - 3 | <ul style="list-style-type: none"> TPO WATERPROOFING MEMBRANE ROOFING TAPERED RIGID INSULATION PLYWOOD SHEATHING (REF. STRUCT.) ROOF FRAMING (REF. STRUCT.) FINISHED SOFFIT |
| W1 | EXTERIOR WALL ASSEMBLY - 1 | <ul style="list-style-type: none"> EXTERIOR FINISH MATERIAL <ul style="list-style-type: none"> REFER ELEVATIONS FOR MATERIAL TYPES AND LOCATIONS INSULATED SHEATHING SYSTEM (1 1/2" THICK) <ul style="list-style-type: none"> INTEGRAL WEATHER BARRIER R-5 MIN. AS PER I.E.C.C. WOOD FRAMING (REF. STRUCT.) <ul style="list-style-type: none"> FIREBLOCKING AS REQUIRED 2x4 WOOD FURRING AS APPLICABLE AT LOWER LEVEL BLOW-IN BLANKET INSULATION (BIBS) <ul style="list-style-type: none"> R-21 MIN. AS PER I.E.C.C. VAPOR BARRIER INTERIOR FINISH |
| W2 | EXTERIOR WALL ASSEMBLY - 2 | <ol style="list-style-type: none"> SPRAY APPLIED WATERPROOFING <ul style="list-style-type: none"> AT BELOW GRADE LOCATIONS CONCRETE FOUNDATION WALL (REF. STRUCT.) RIGID INSULATION <ul style="list-style-type: none"> R-15 MIN. AS PER 1.E.C.C. |
| W3 | FOUNDATION WALL ASSEMBLY - 3 | <ul style="list-style-type: none"> DRAINAGE / PROTECTION BOARD SPRAY APPLIED WATERPROOFING CONCRETE FOUNDATION WALL (REF. STRUCT.) RIGID INSULATION <ul style="list-style-type: none"> R-15 (AT CRAWL SPACE LOCATIONS) |
| W4 | EXTERIOR WALL ASSEMBLY - 4 | <ul style="list-style-type: none"> 1 1/2" INSULATED DRAINAGE / PROTECTION BOARD <ul style="list-style-type: none"> 10'-0" DEPTH MIN. OR TO LOWER LEVEL FLOOR R-5 MIN. AS PER I.E.C.C. SPRAY APPLIED WATERPROOFING CONCRETE FOUNDATION WALL (REF. STRUCT.) WOOD FRAMING (REF. STRUCT.) <ul style="list-style-type: none"> FIREBLOCKING AS REQUIRED BATT INSULATION <ul style="list-style-type: none"> R-13 MIN. AS PER I.E.C.C. INTEGRAL VAPOR BARRIER AT INTERIOR SIDE 5/8" GYP BOARD (AS APPLICABLE) |
| F1 | FLOOR ASSEMBLY - 1 | <ul style="list-style-type: none"> PLYWOOD SHEATHING (REF. STRUCT.) WOOD FLOOR FRAMING (REF. STRUCT.) UNDER FLOOR STAPLE UP RADIANT HEAT SYSTEM <ul style="list-style-type: none"> ALUMINUM REFLECTIVE BARRIER BATT INSULATION (R-19) FINISHED CEILING |
| F2 | FLOOR ASSEMBLY - 2 | <ul style="list-style-type: none"> PLYWOOD SHEATHING (REF. STRUCT.) WOOD FLOOR FRAMING (REF. STRUCT.) UNDER FLOOR STAPLE UP RADIANT HEAT SYSTEM <ul style="list-style-type: none"> ALUMINUM REFLECTIVE BARRIER BATT INSULATION <ul style="list-style-type: none"> R-19 MIN. AS PER I.E.C.C. |
| F3 | FLOOR ASSEMBLY - 3 | <ul style="list-style-type: none"> 4" CONCRETE SLAB DRAINAGE BOARD EPDM WATERPROOFING MEMBRANE 3/4" PLYWOOD SHEATHING TAPERED WOOD SLEEPERS <ul style="list-style-type: none"> 1/4" - 12" SLOPE MIN. PLYWOOD SHEATHING (REF. STRUCT.) WOOD FLOOR FRAMING (REF. STRUCT.) UNDER FLOOR STAPLE UP RADIANT HEAT SYSTEM <ul style="list-style-type: none"> ALUMINUM REFLECTIVE BARRIER BATT INSULATION (R-19) 5/8" GYP. BOARD (AS APPLICABLE) |
| F4 | FLOOR ASSEMBLY - 4 | <ul style="list-style-type: none"> PRE-FABRICATED COMPOSITE DECKING WOOD FRAMING (REF. STRUCT.) |
| F5 | FLOOR ASSEMBLY - 5 | <ul style="list-style-type: none"> CLASS I VAPOR RETARDER <ul style="list-style-type: none"> OVERLAP ALL JOINTS 6" MIN., SEAL AND TAPE EXTEND EDGES 6" MIN. UP STEM WALL AND ATTACH RIGID INSULATION <ul style="list-style-type: none"> R-15 MIN. AS PER I.E.C.C. EXTEND HORIZONTALLY 2'-0" AT GRADE |

[illegible]

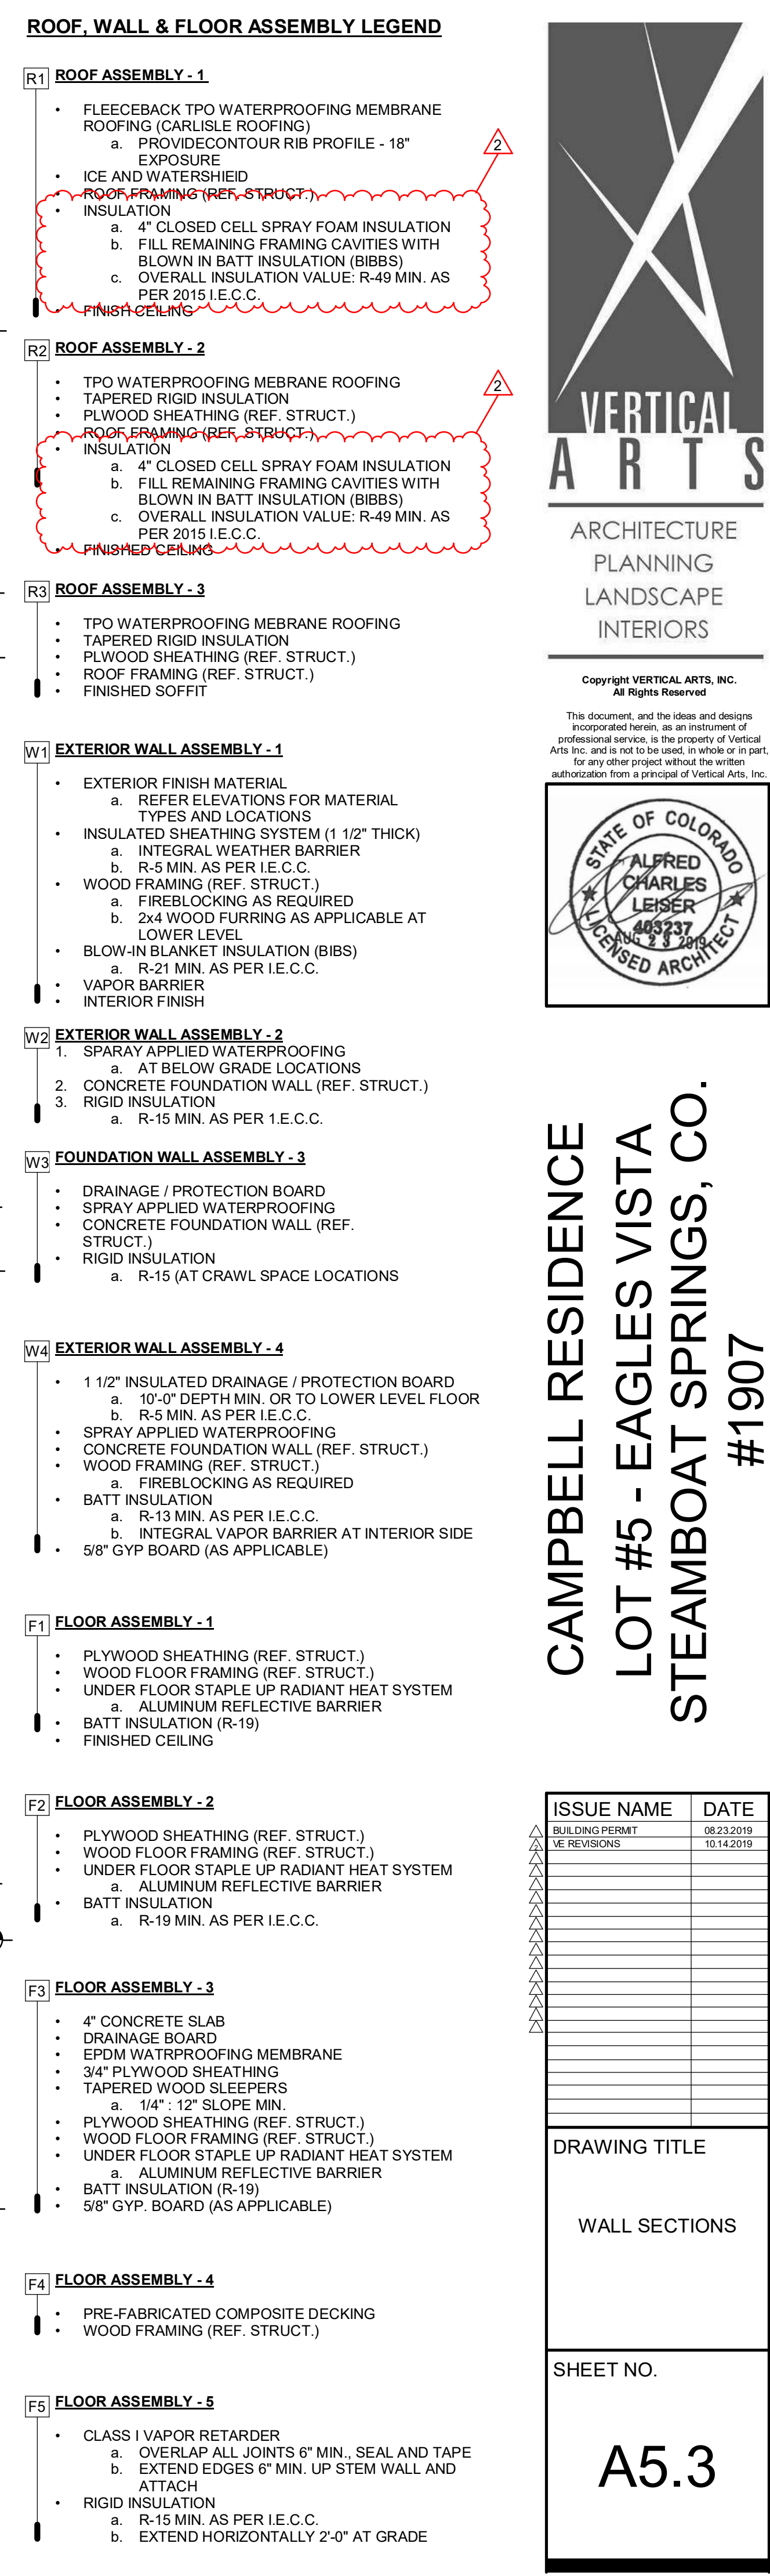

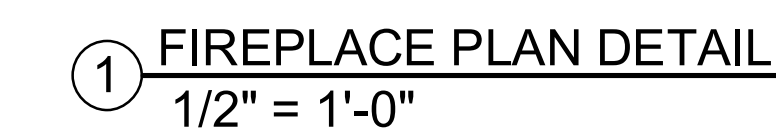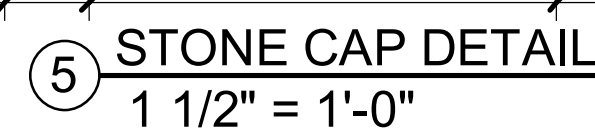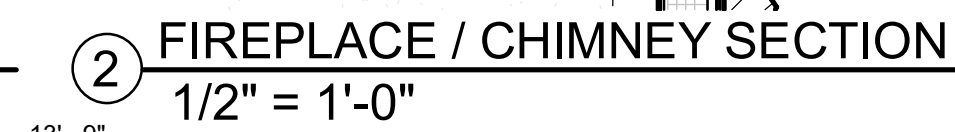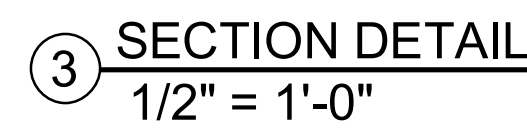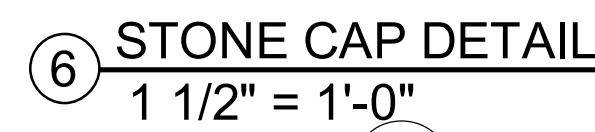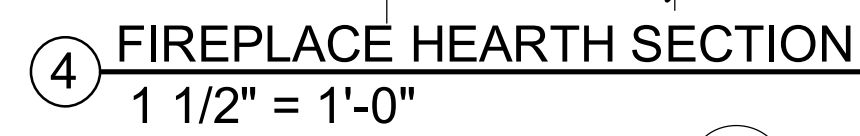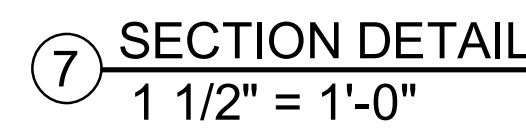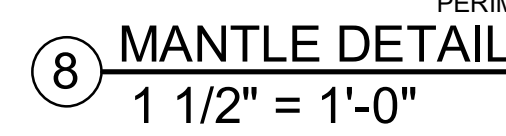[illegible]

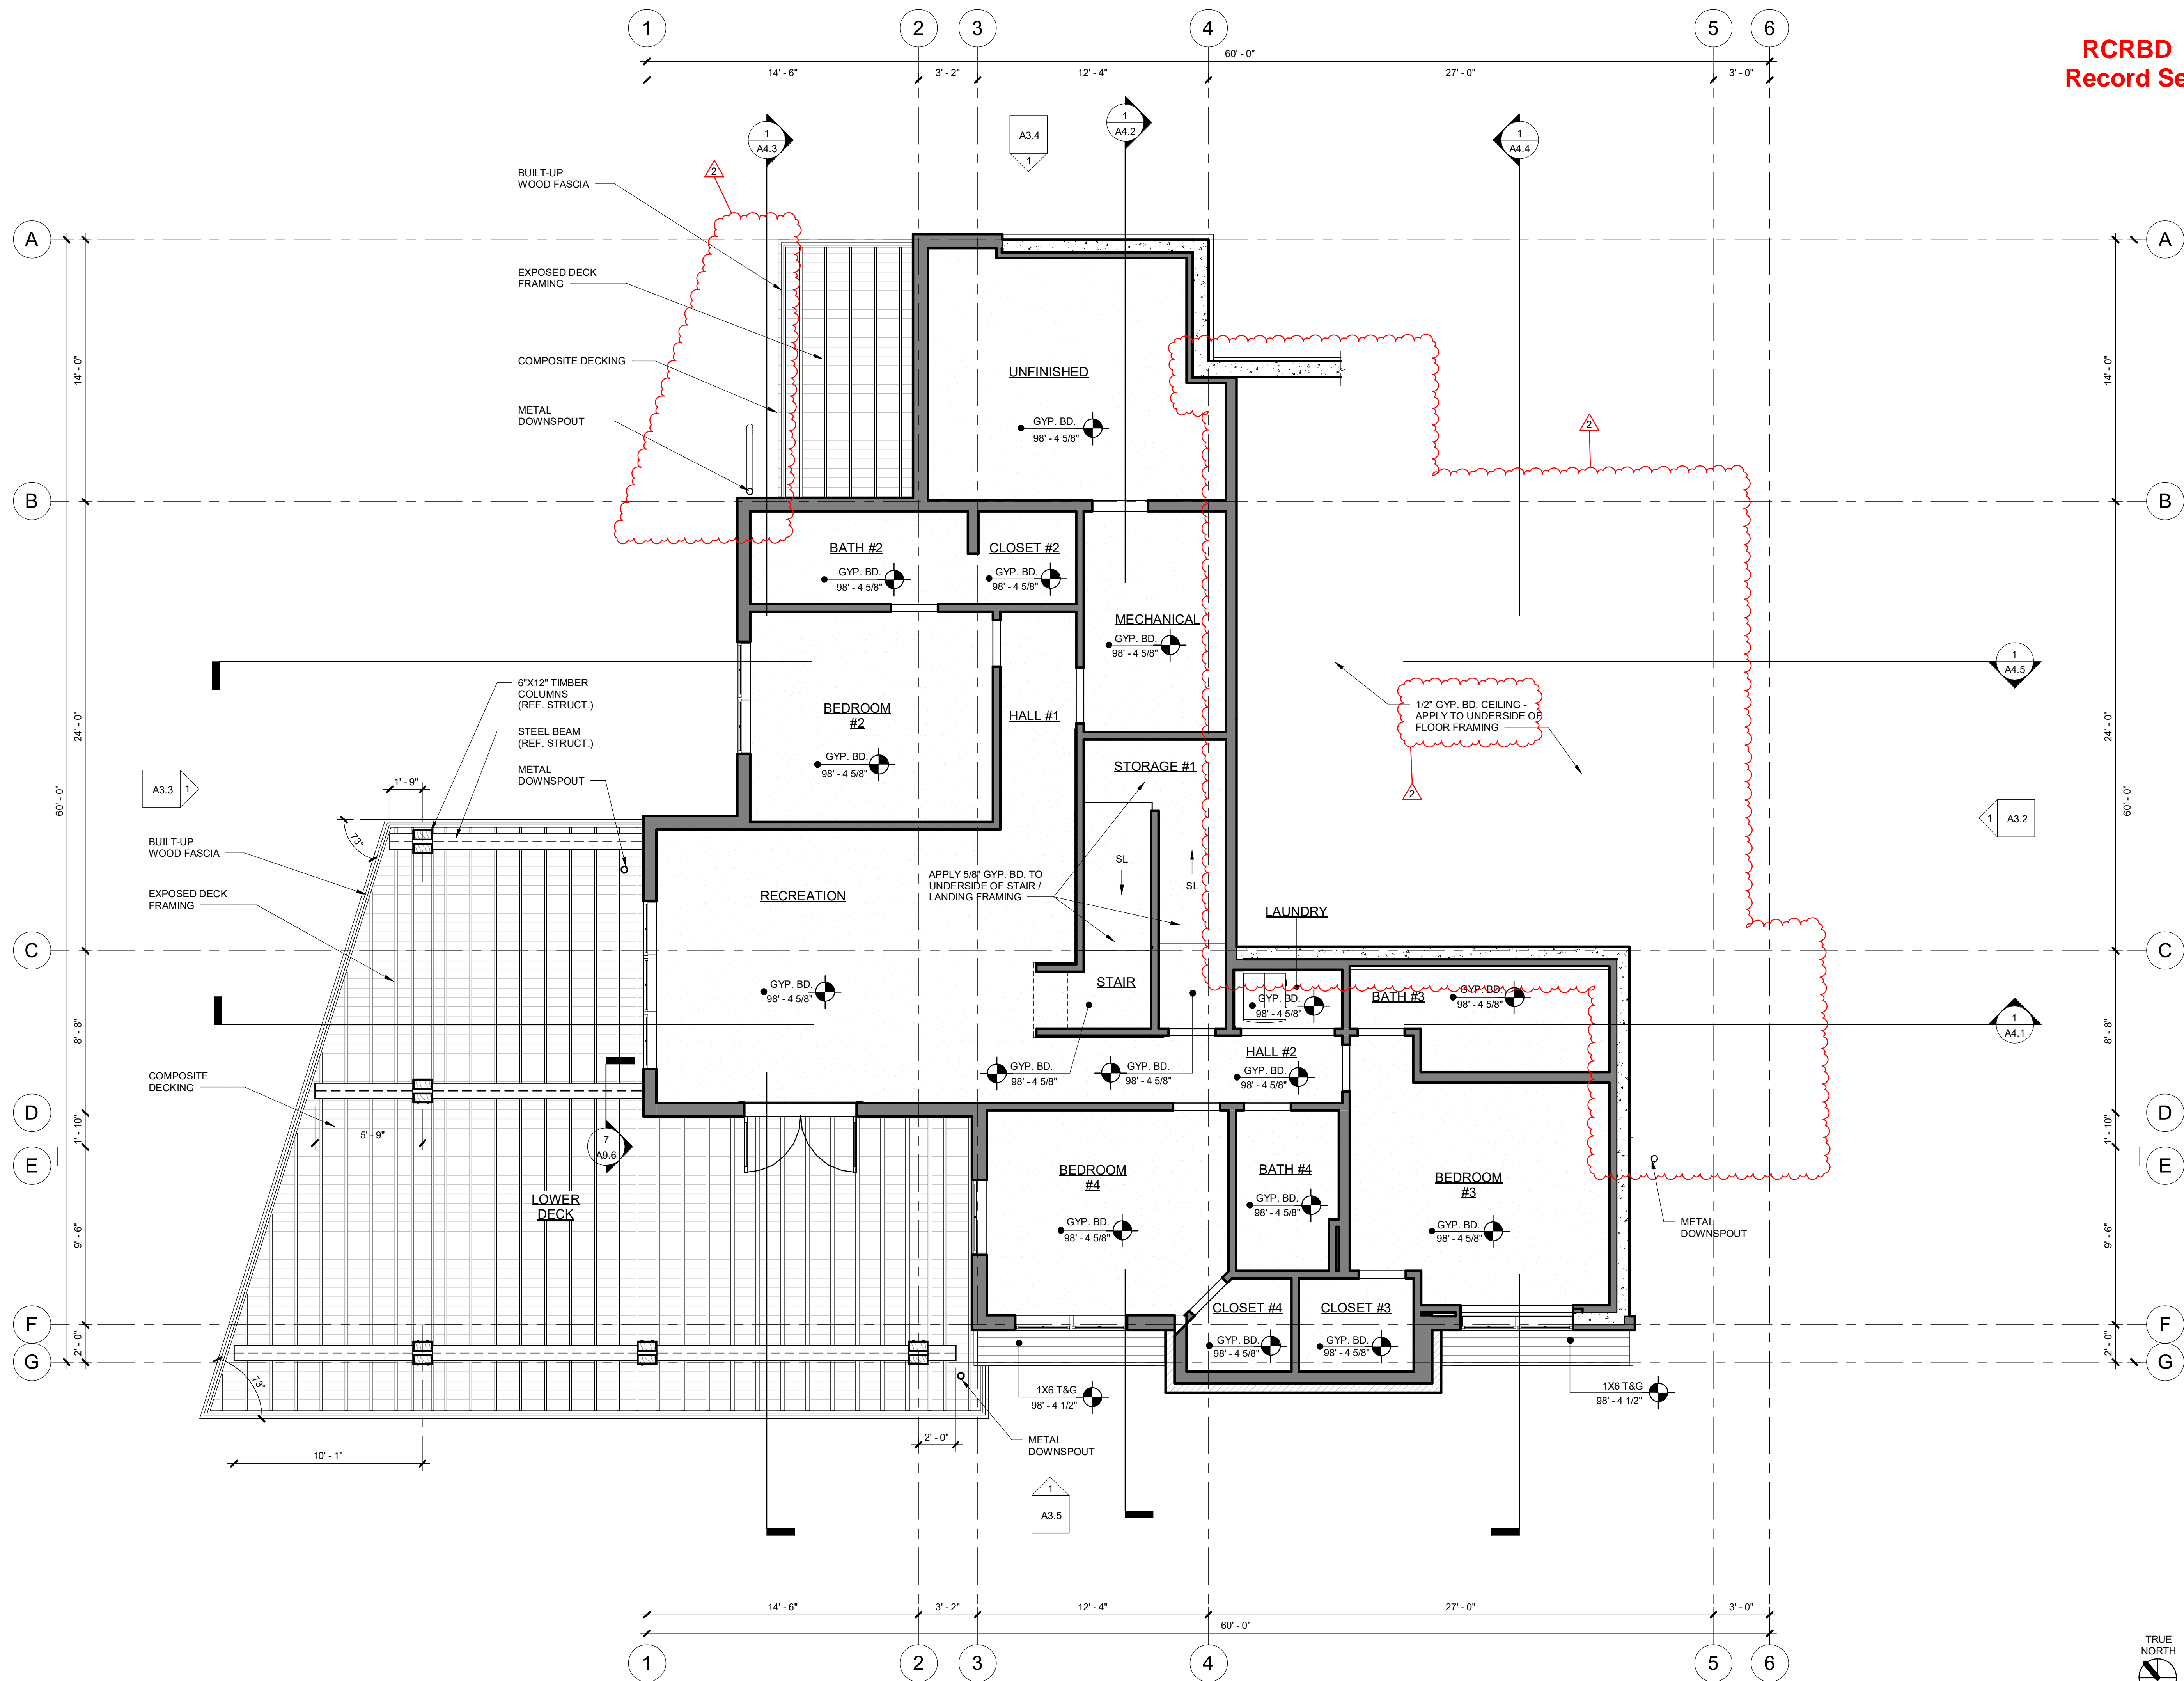


RCRBD
Record Set



ARCHITECTURE
PLANNING
LANDSCAPE
INTERIORS

Copyright VERTICAL ARTS, INC.
All Rights Reserved
This document, and the ideas and designs
incorporated herein, are an instrument of
professional services, is the property of Vertical
Arts Inc. and is not to be used, in whole or in part,
for any other project without the written
authorization from a principal of Vertical Arts, Inc.

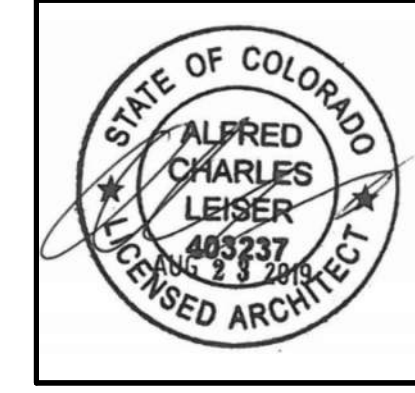

CAMPBELL RESIDENCE
LOT #5 - EAGLES VISTA
STEAMBOAT SPRINGS, CO.
#1907

| ISSUE NAME | DATE |
|---------------------|------------|
| 50% DD | 07/03/2019 |
| MINOR ADJUSTMENT | 07/12/2019 |
| BUILDING PERMIT | 08/23/2019 |
| PERMIT RE-SUBMITTAL | 09/25/2019 |
| VE REVISIONS | 10/14/2019 |

DRAWING TITLE

LOWER LEVEL
REFLECTED CEILING
PLAN






SHEET NO.











A7.1

① LOWER LEVEL REFLECTED CEILING PLAN
1/4" = 1'-0"









10/14/2019 7:37:27 AM

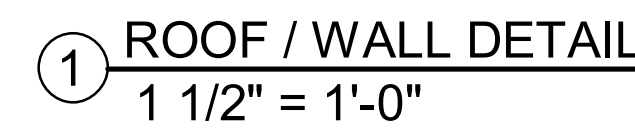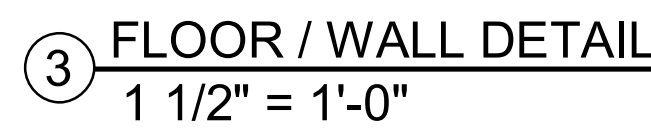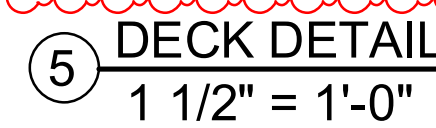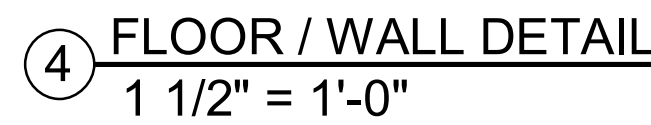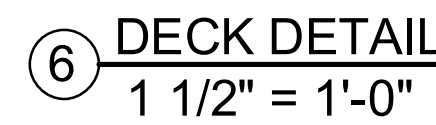[illegible]

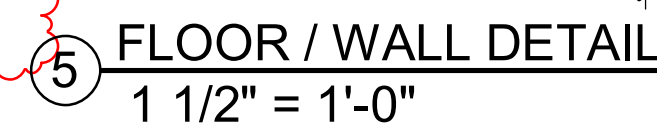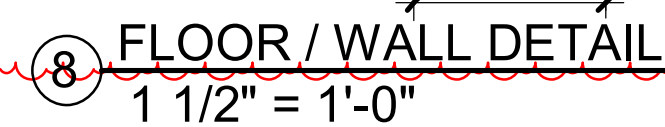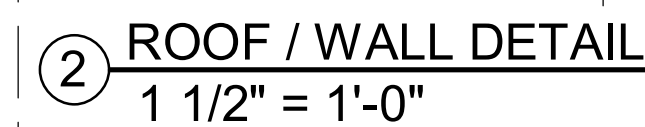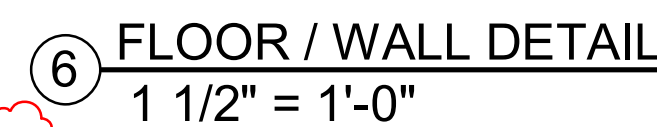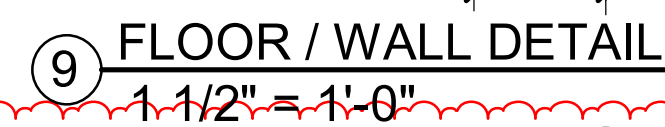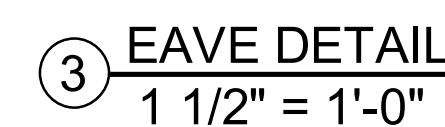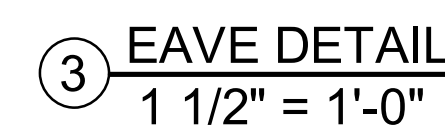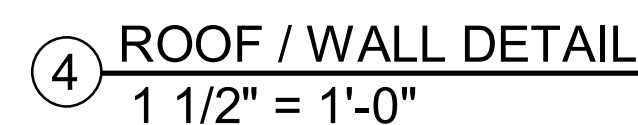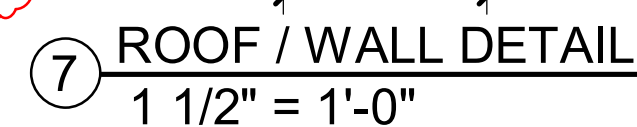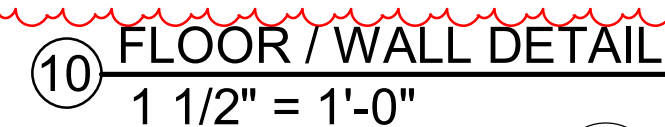

A9.2

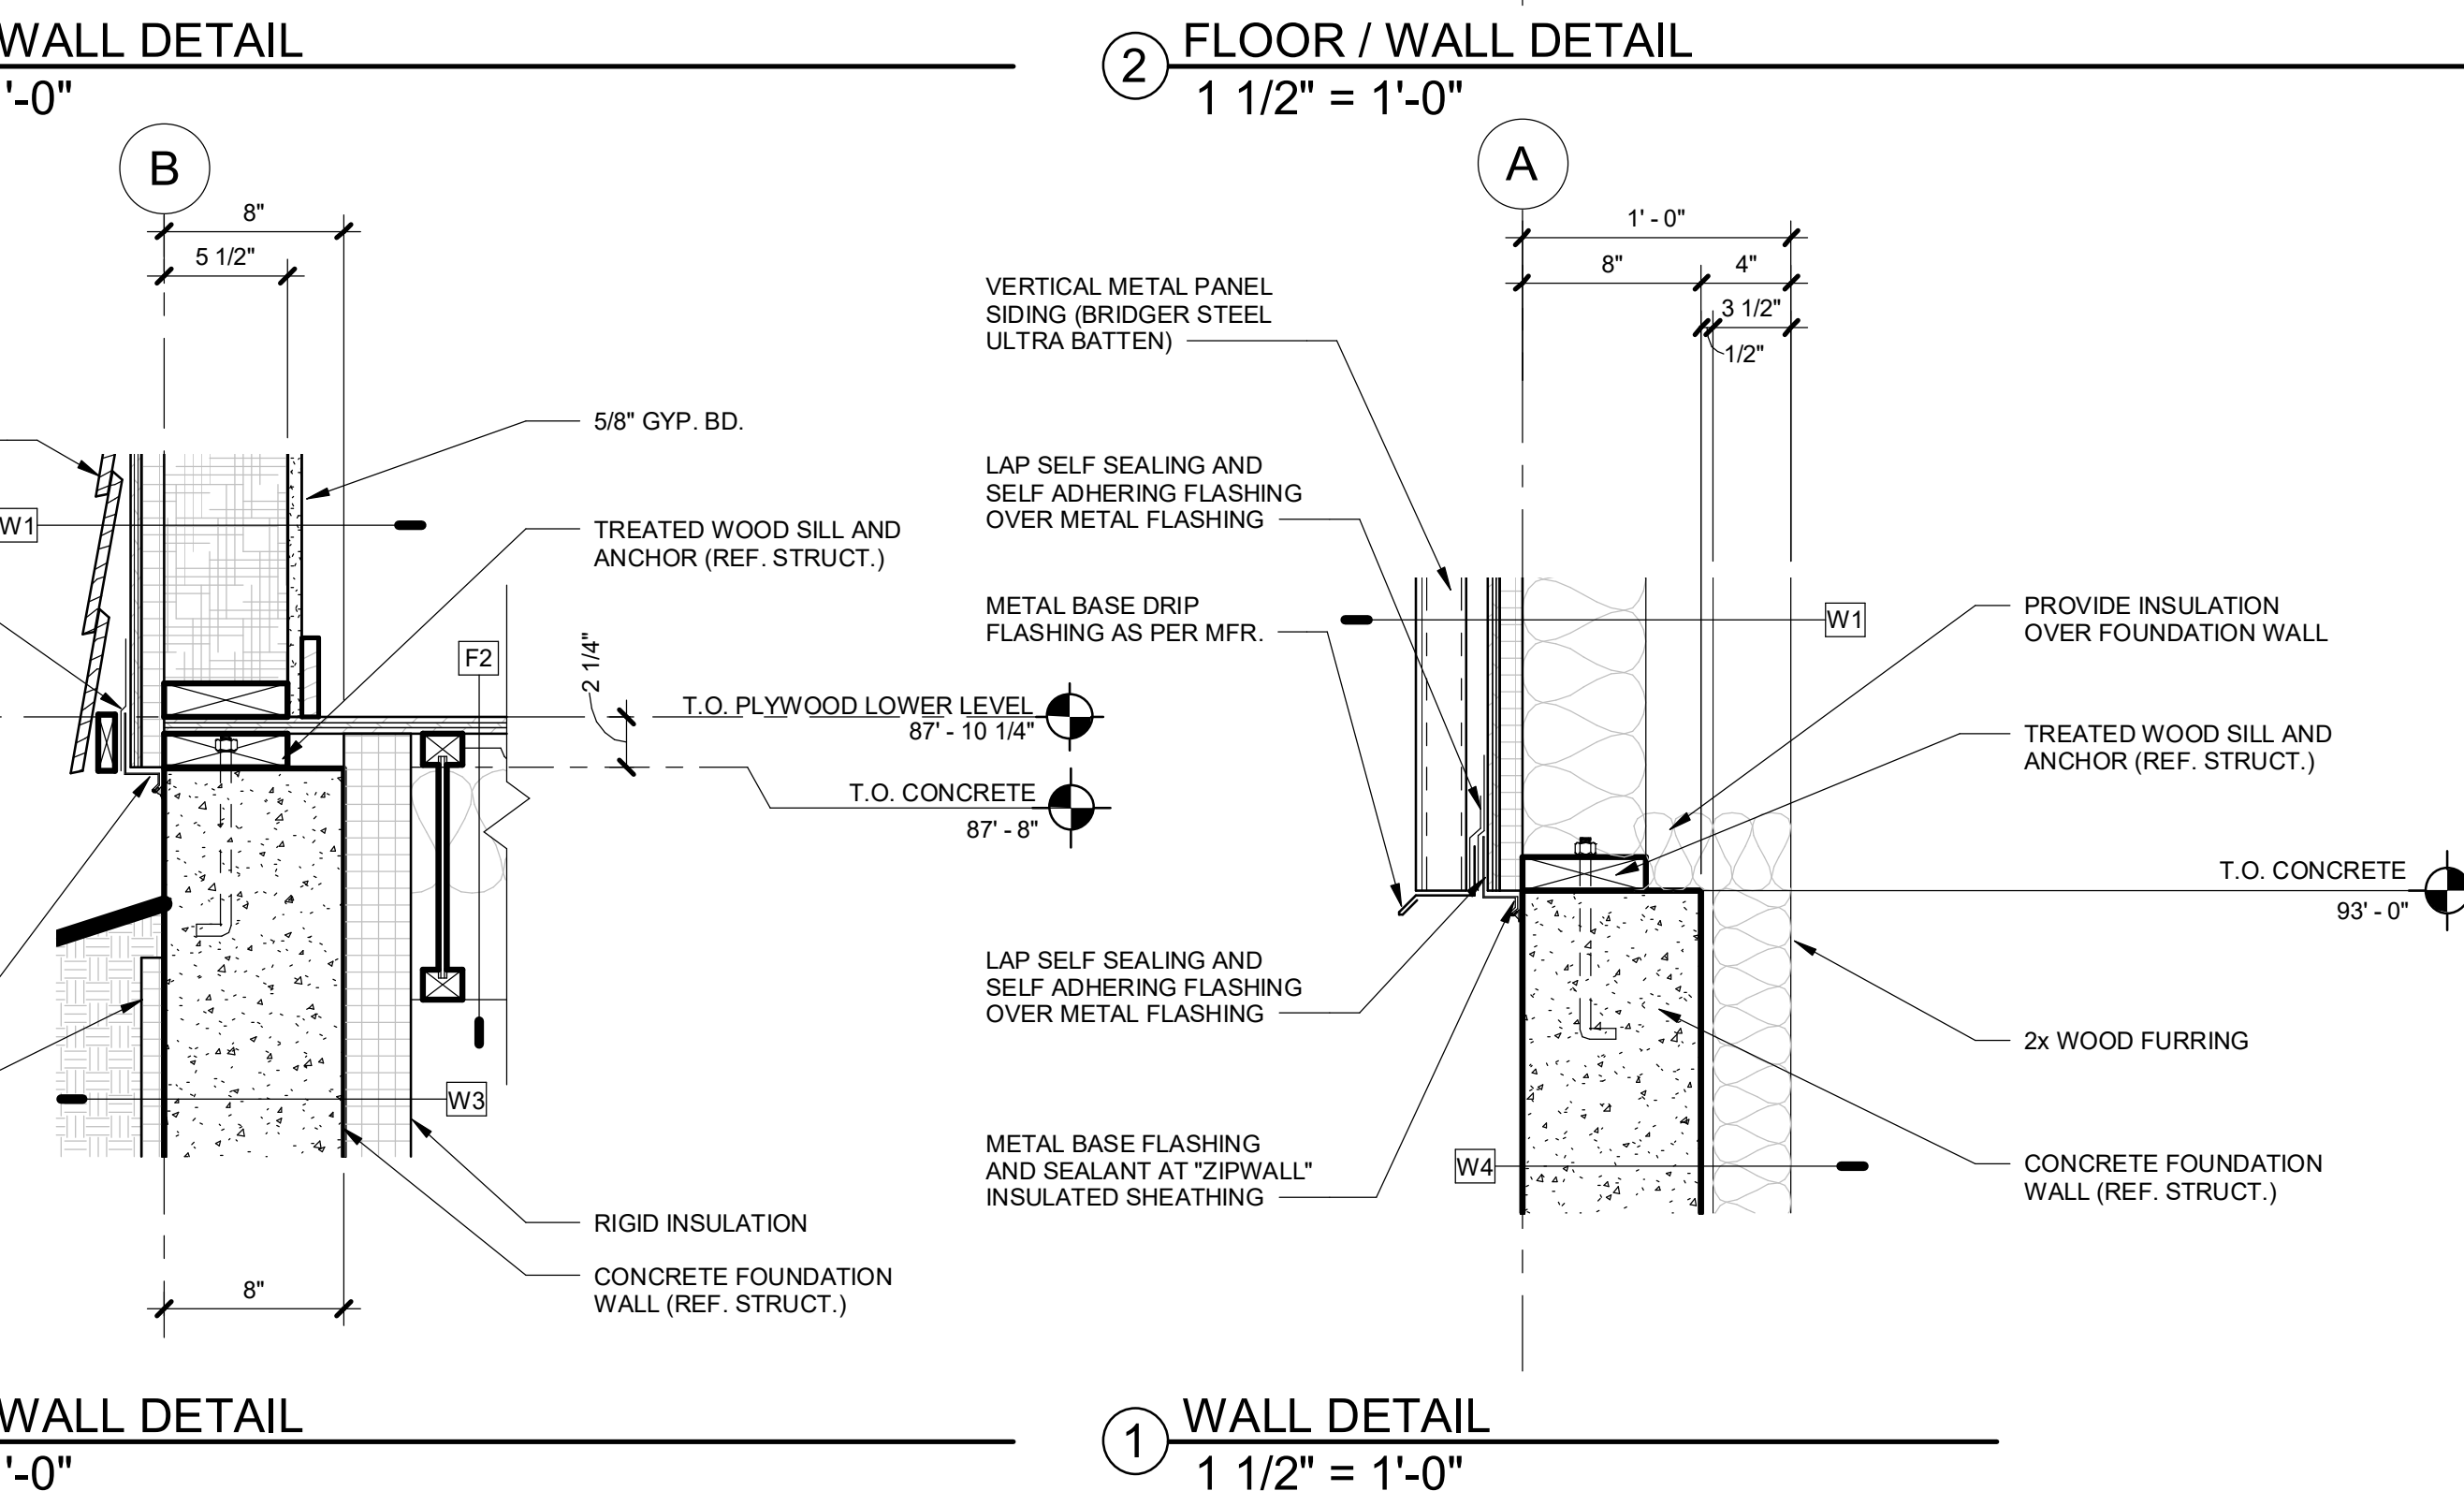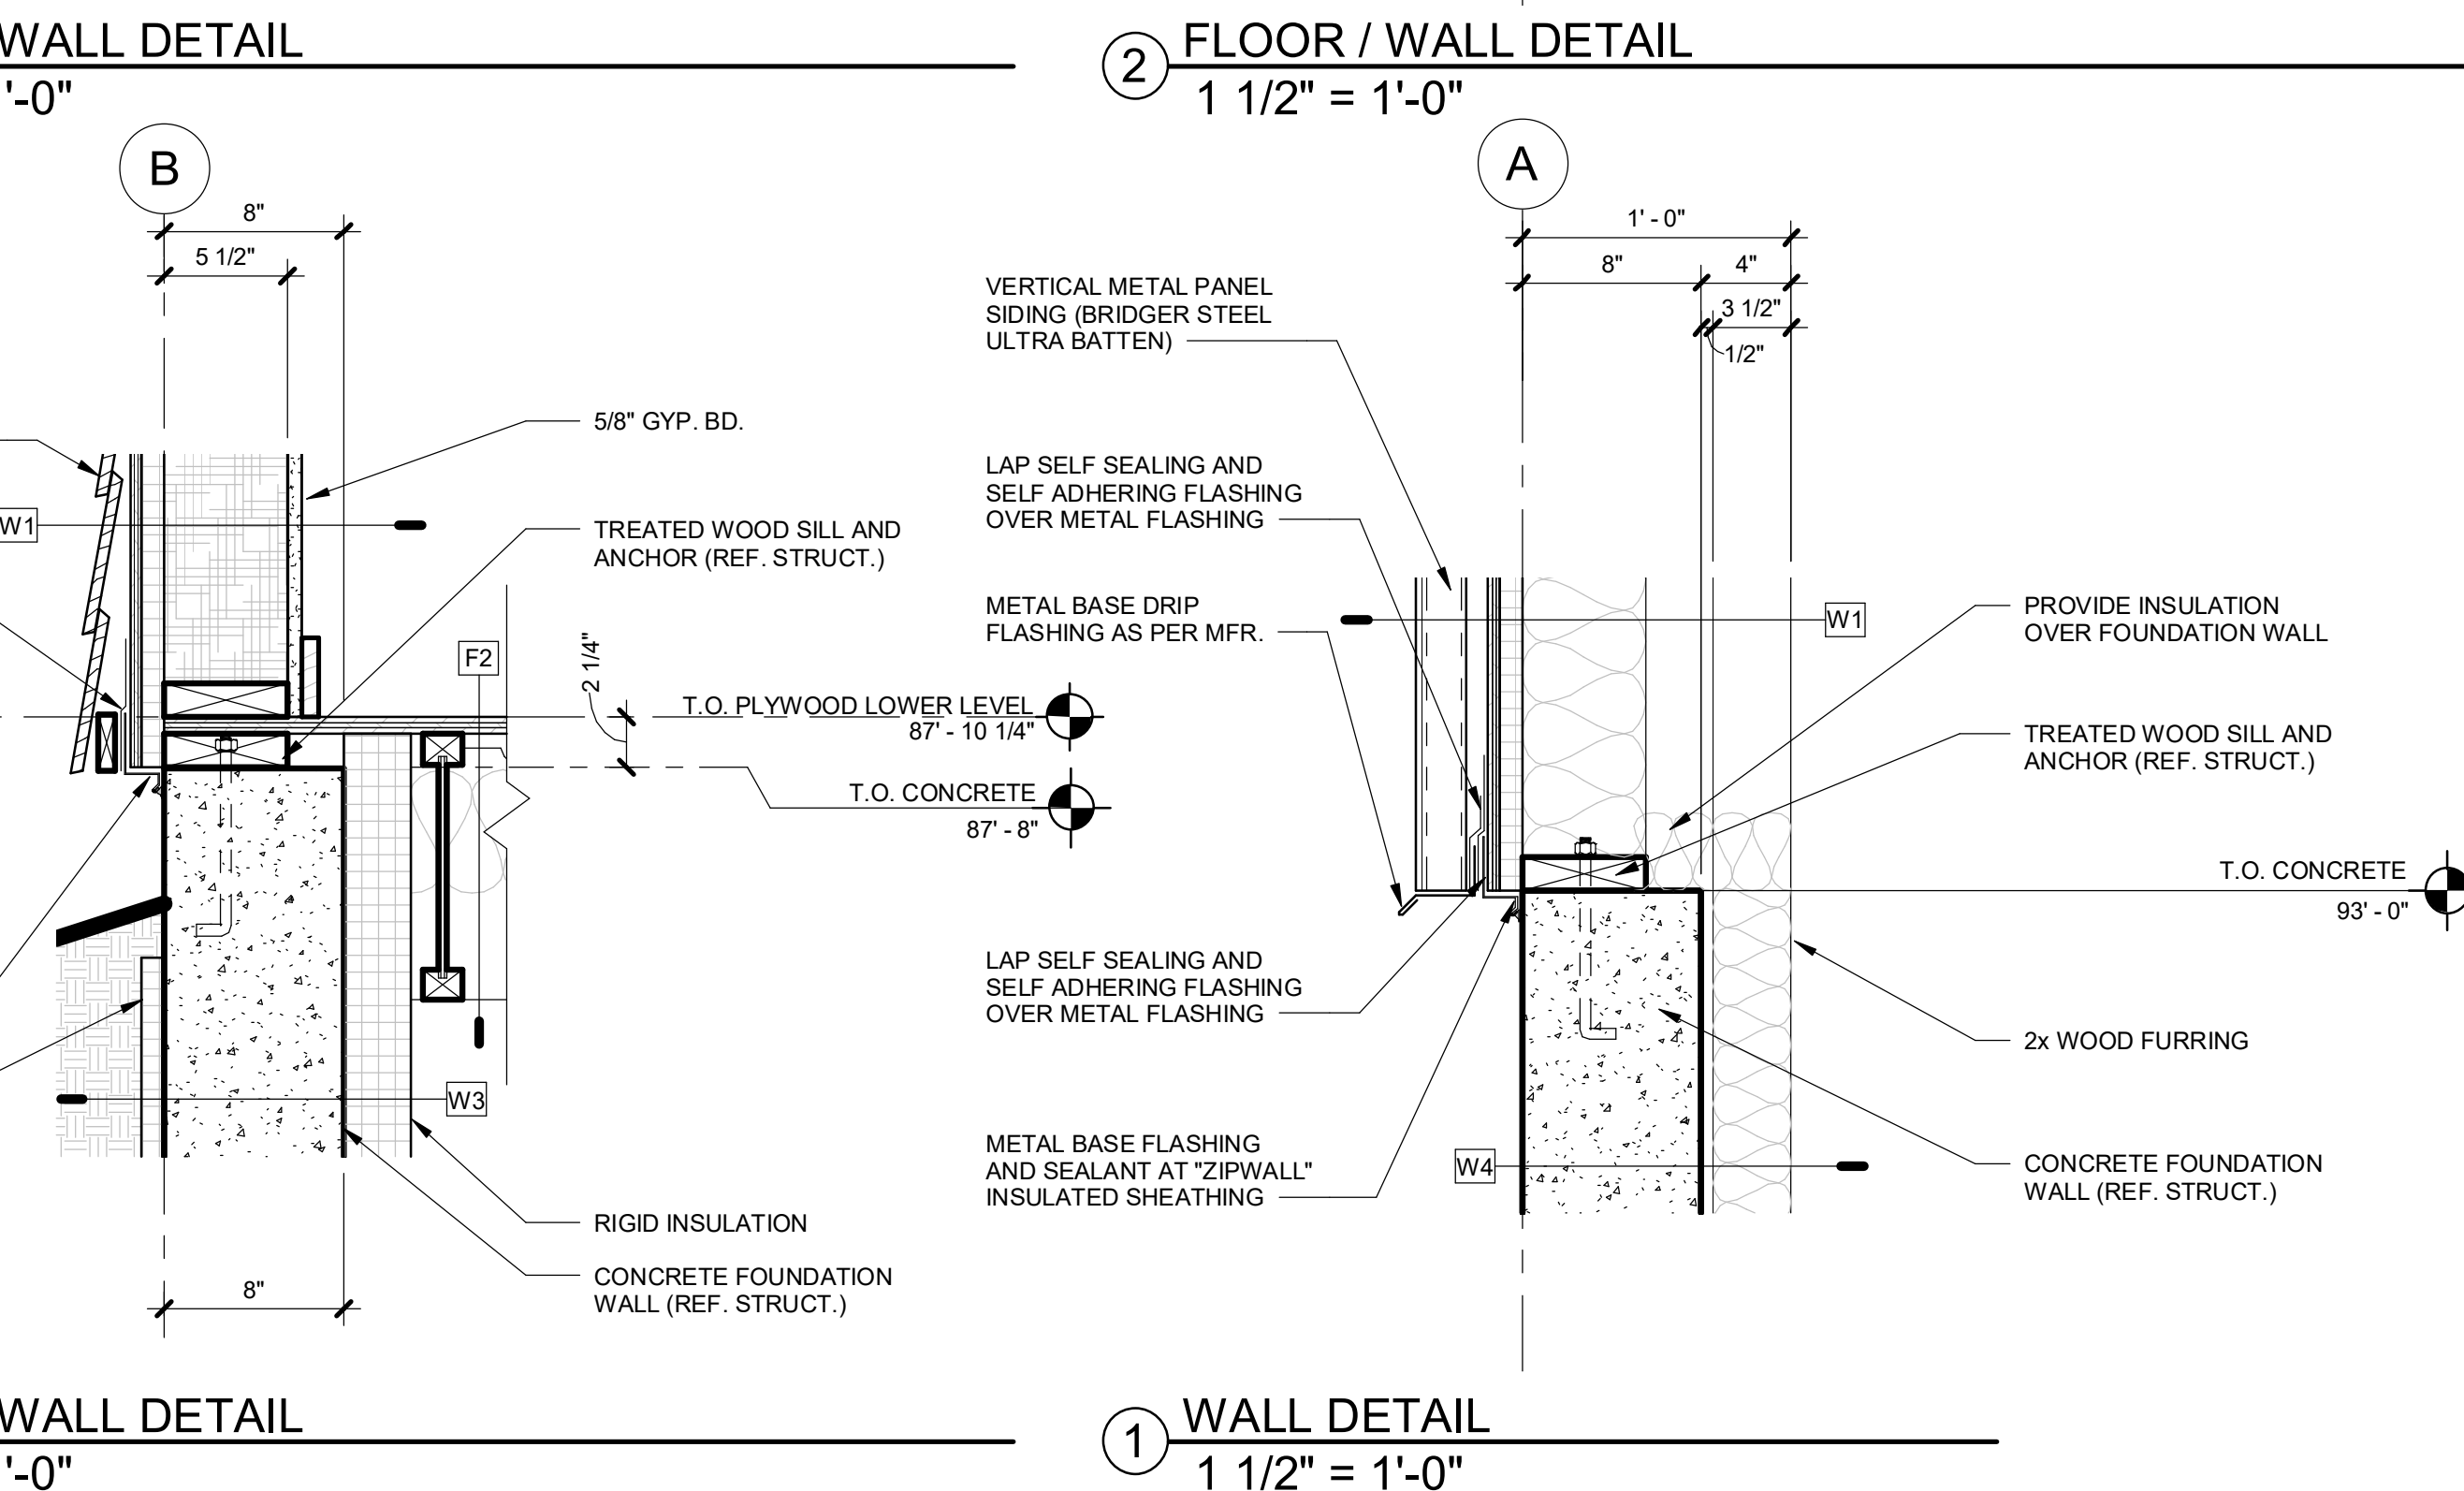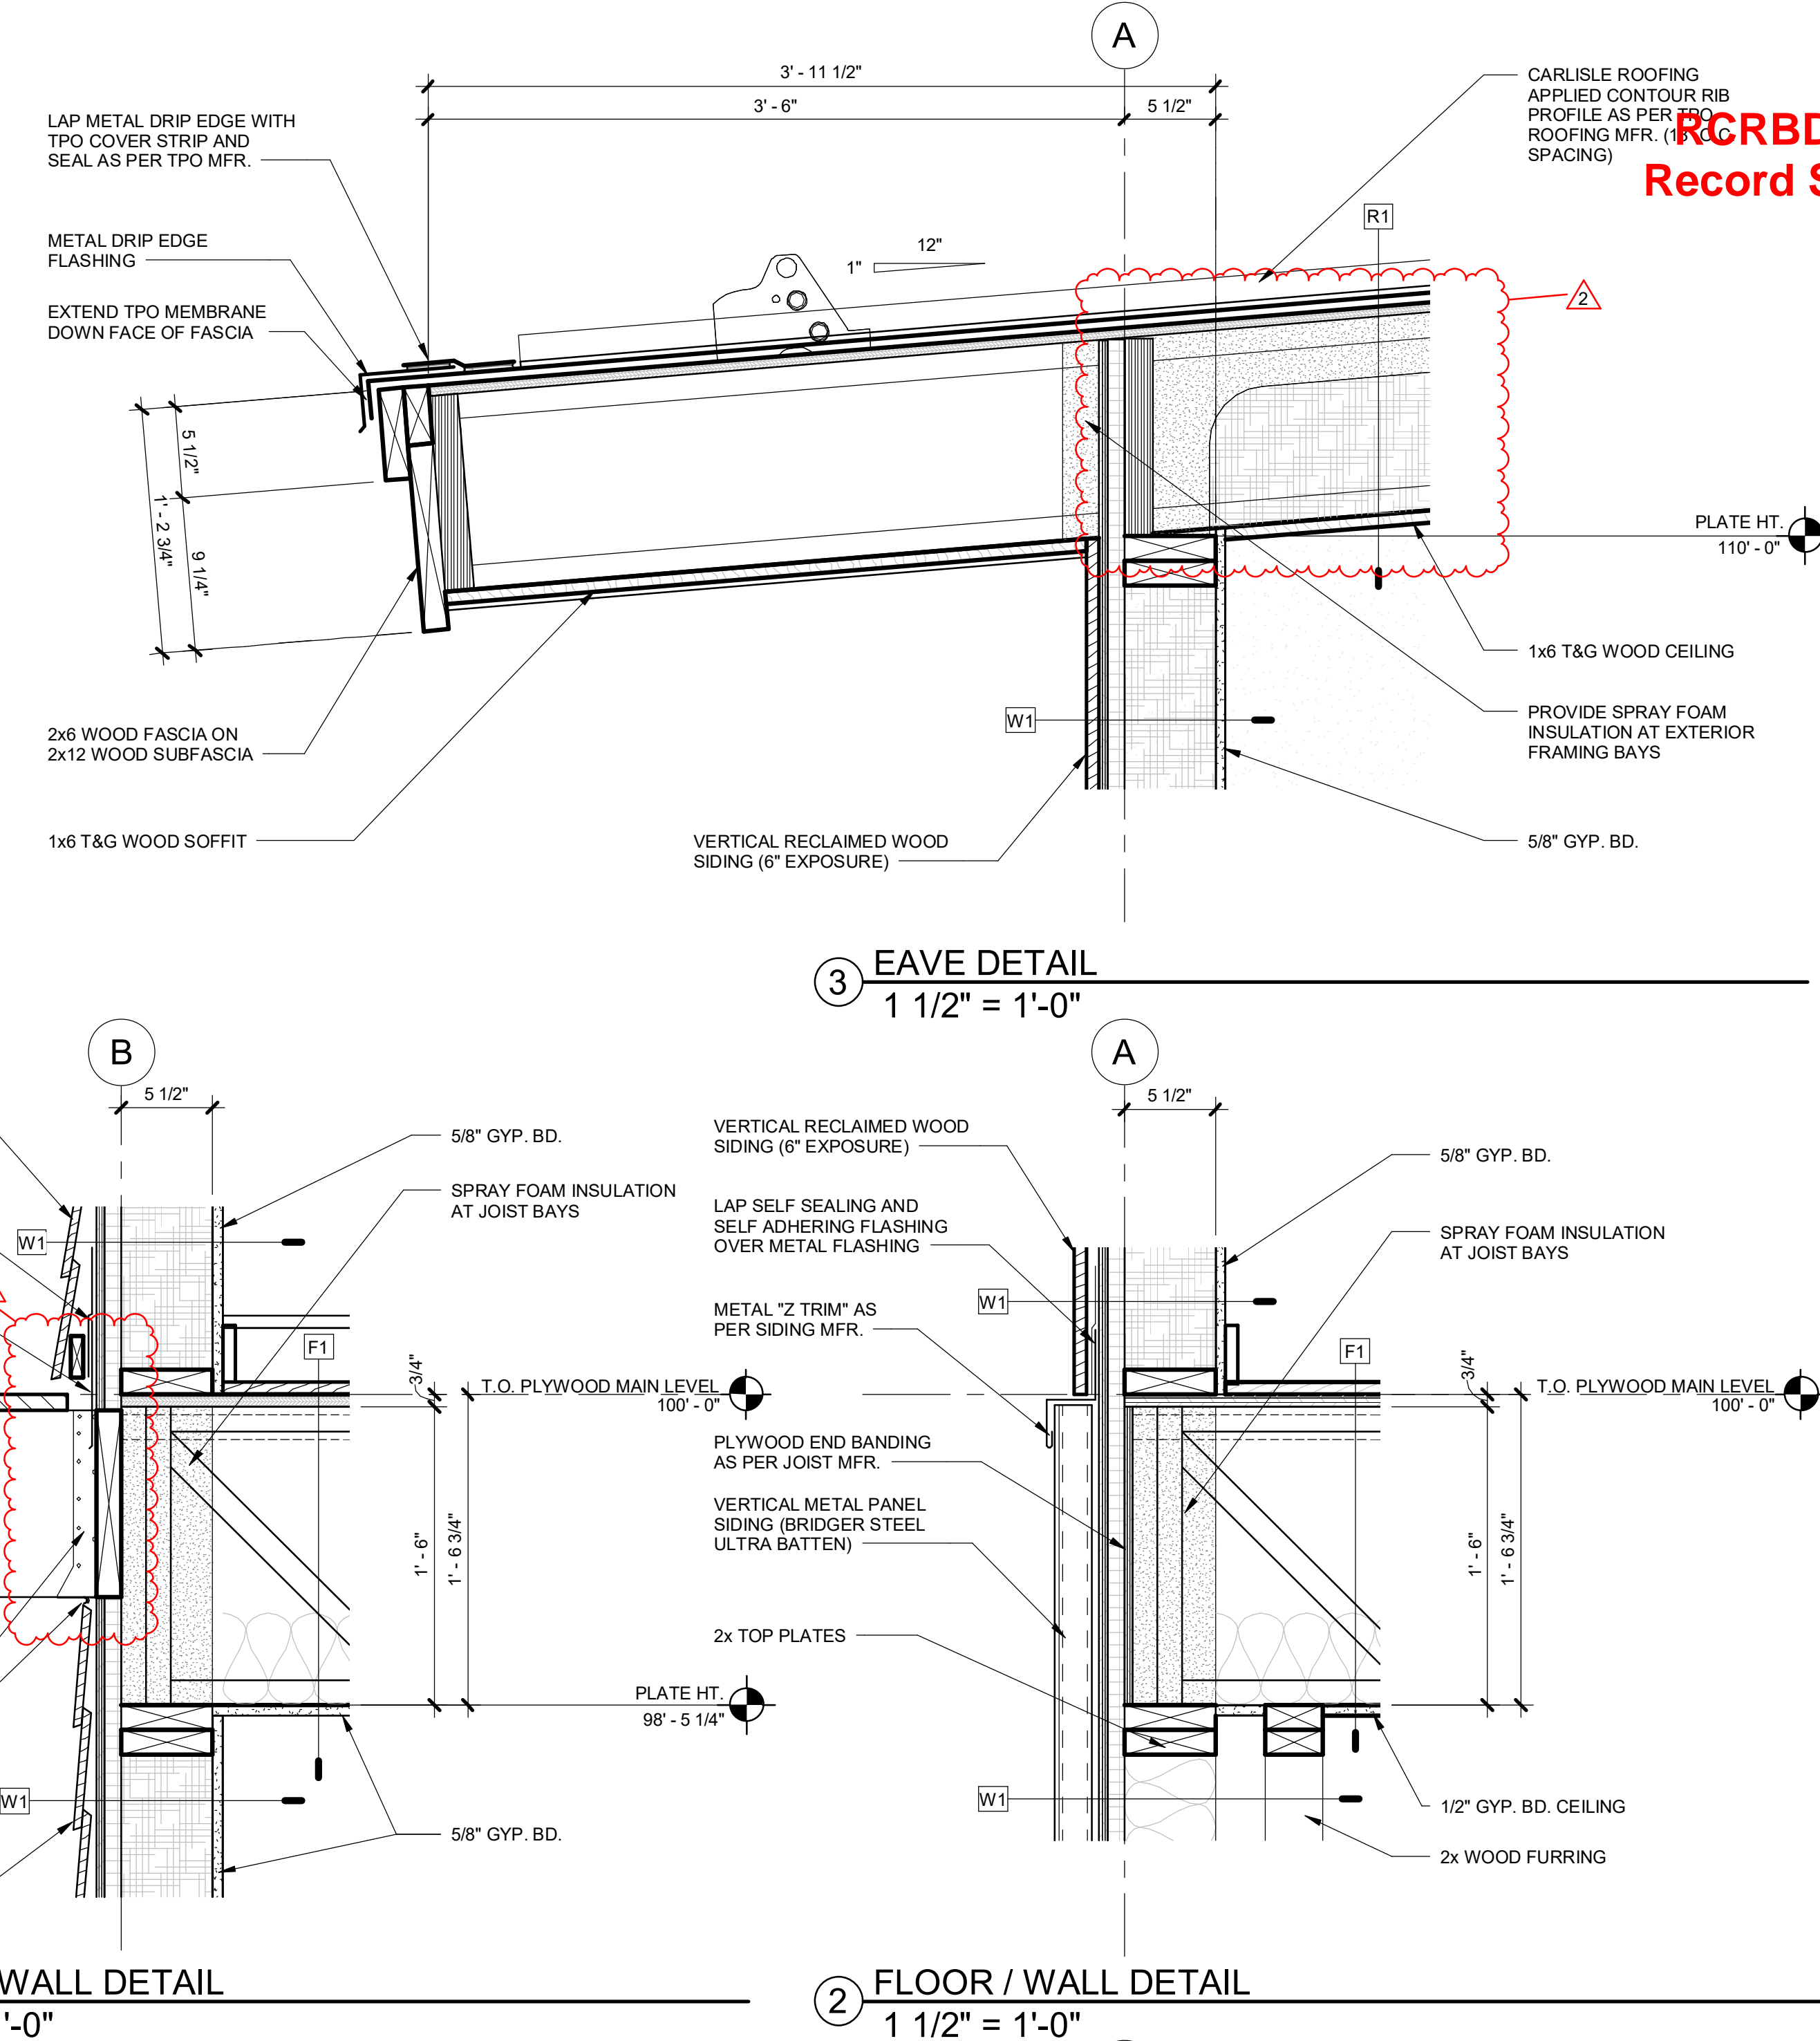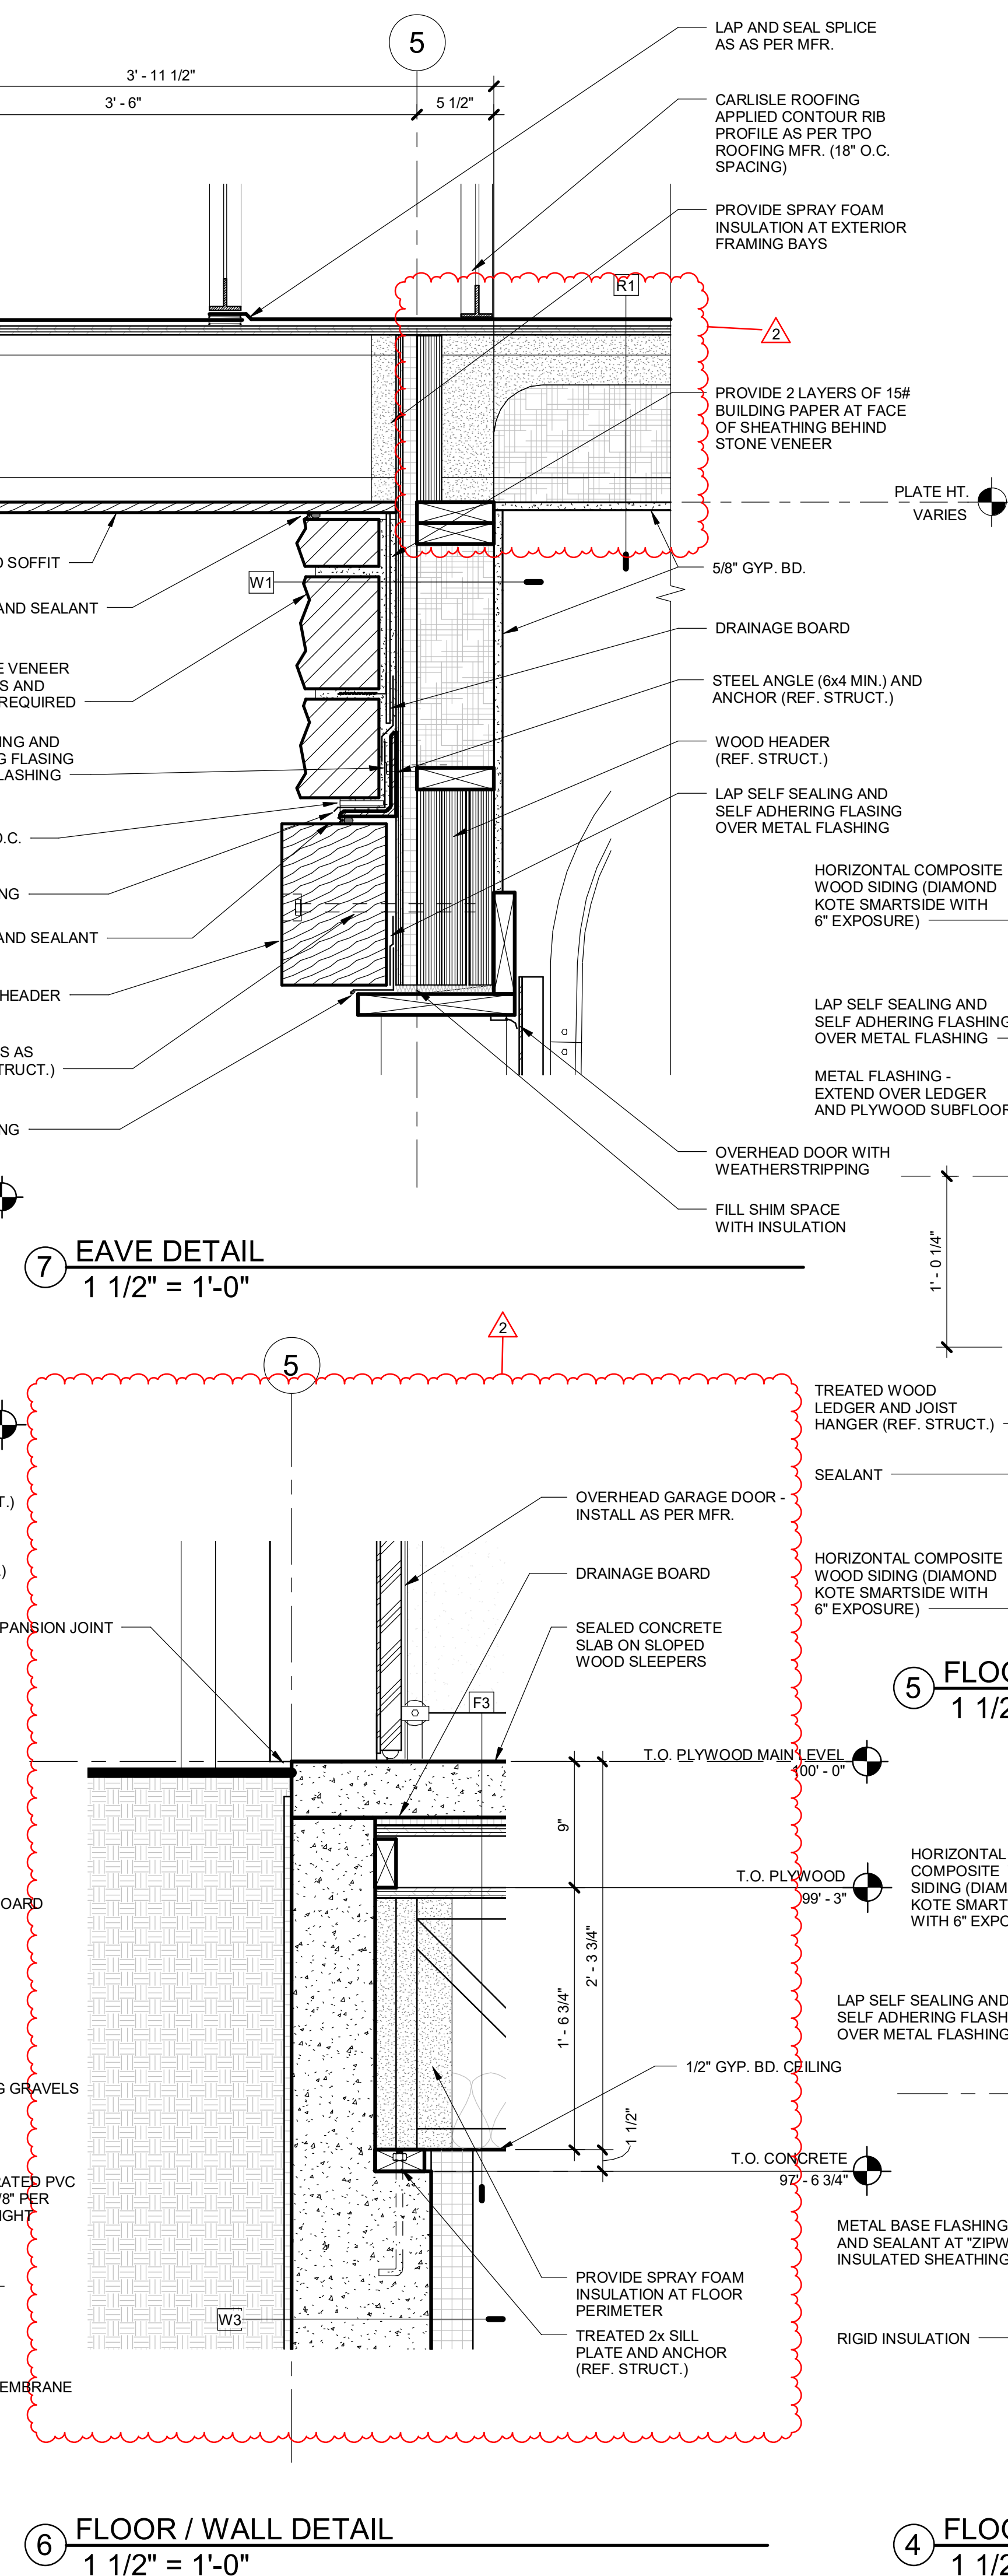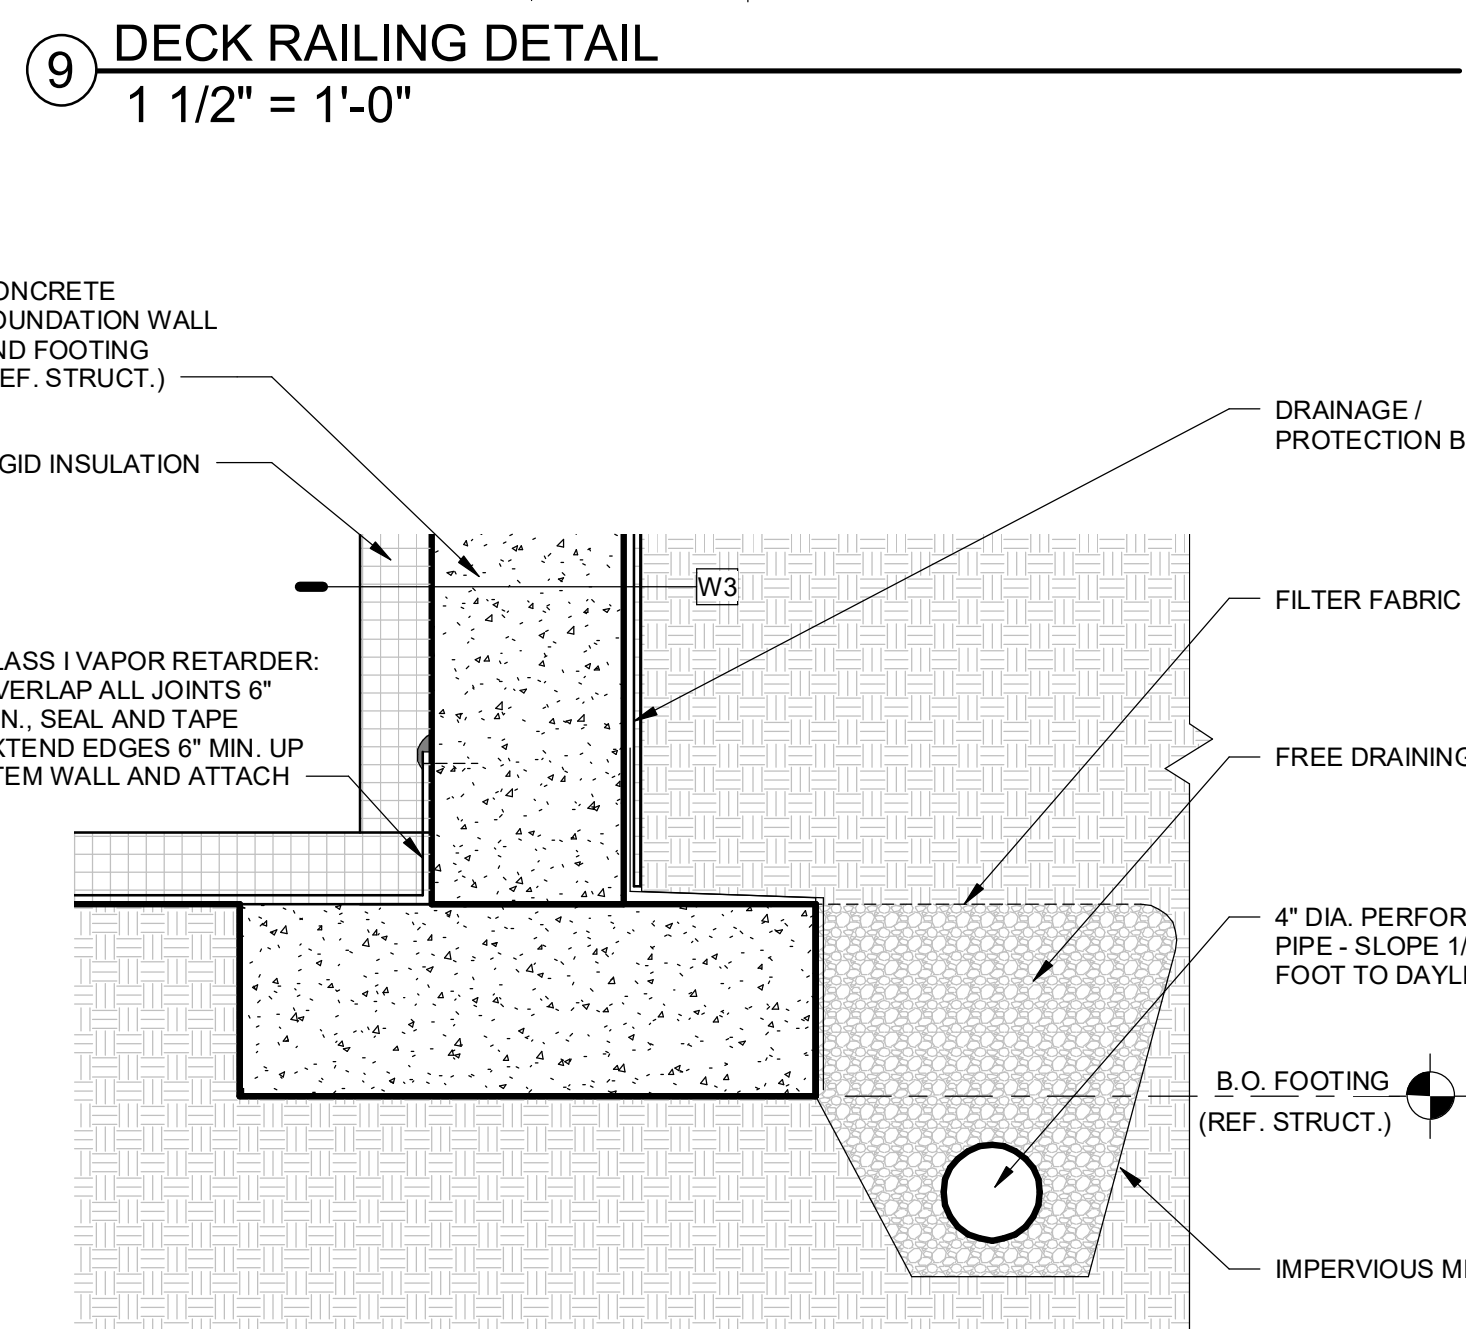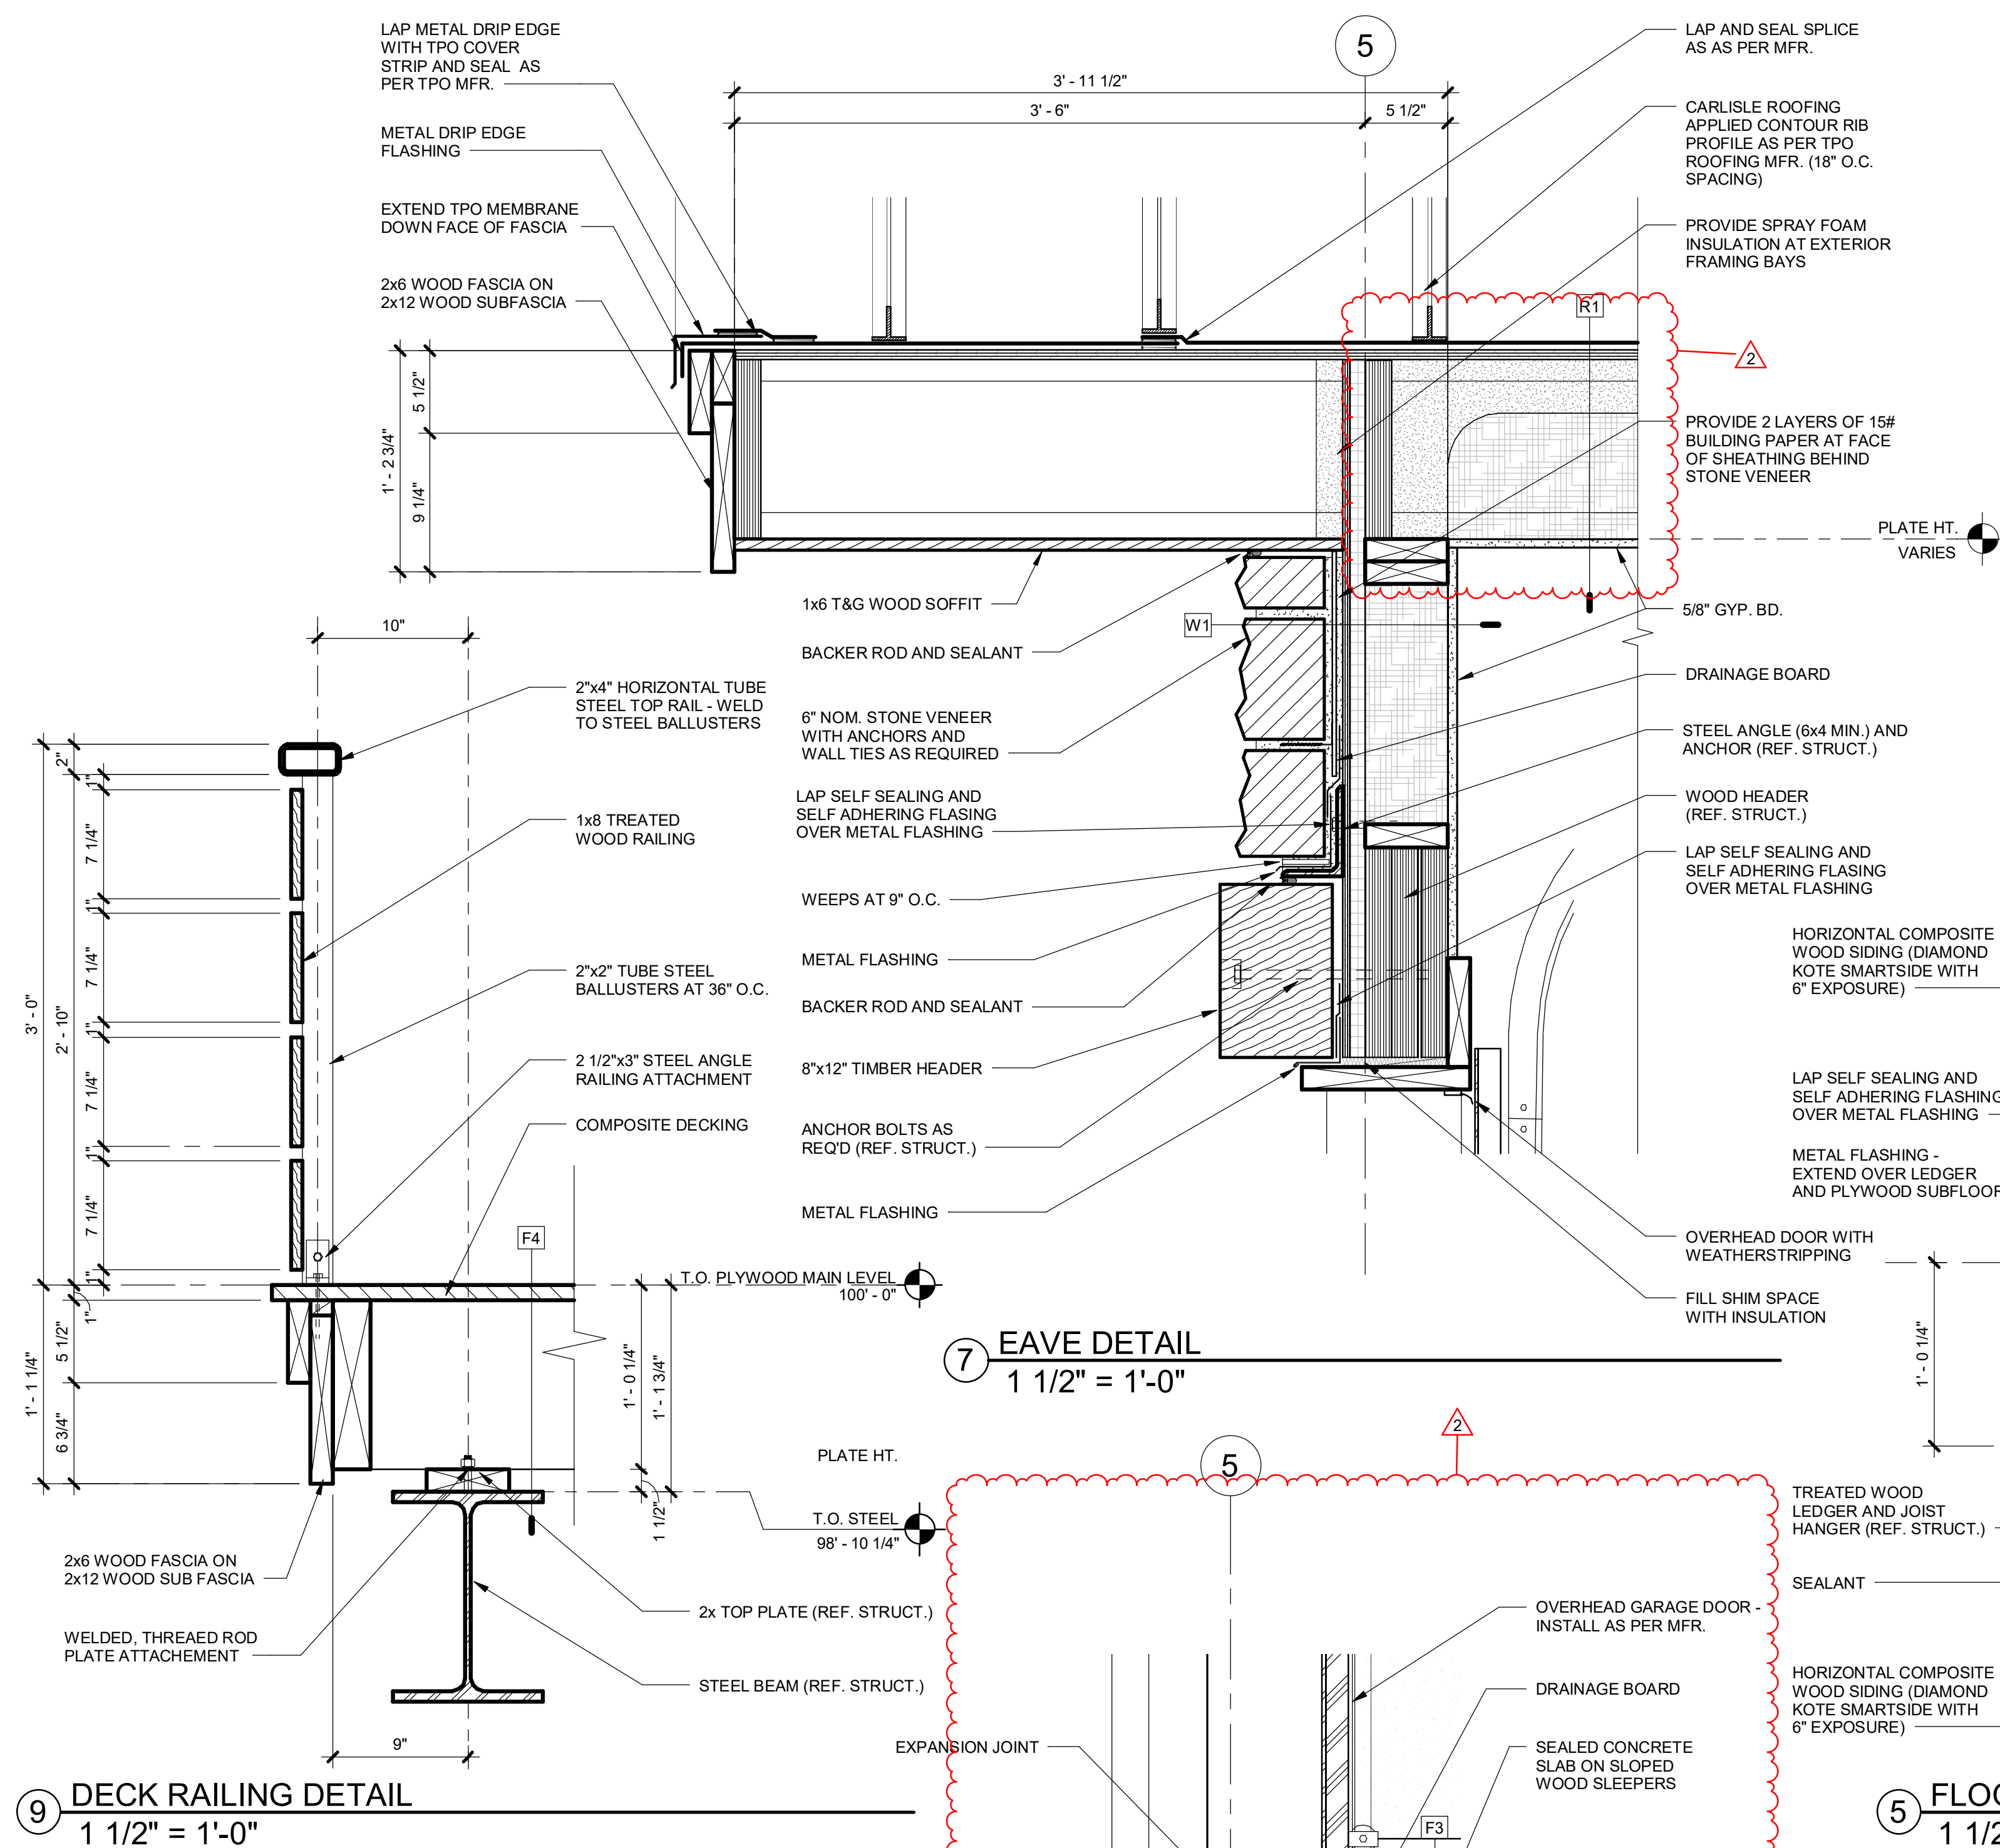


RCRBD
Record Set




CAMPBELL RESIDENCE
LOT #5 - EAGLES VISTA
STEAMBOAT SPRINGS, CO.
#1007


[illegible]

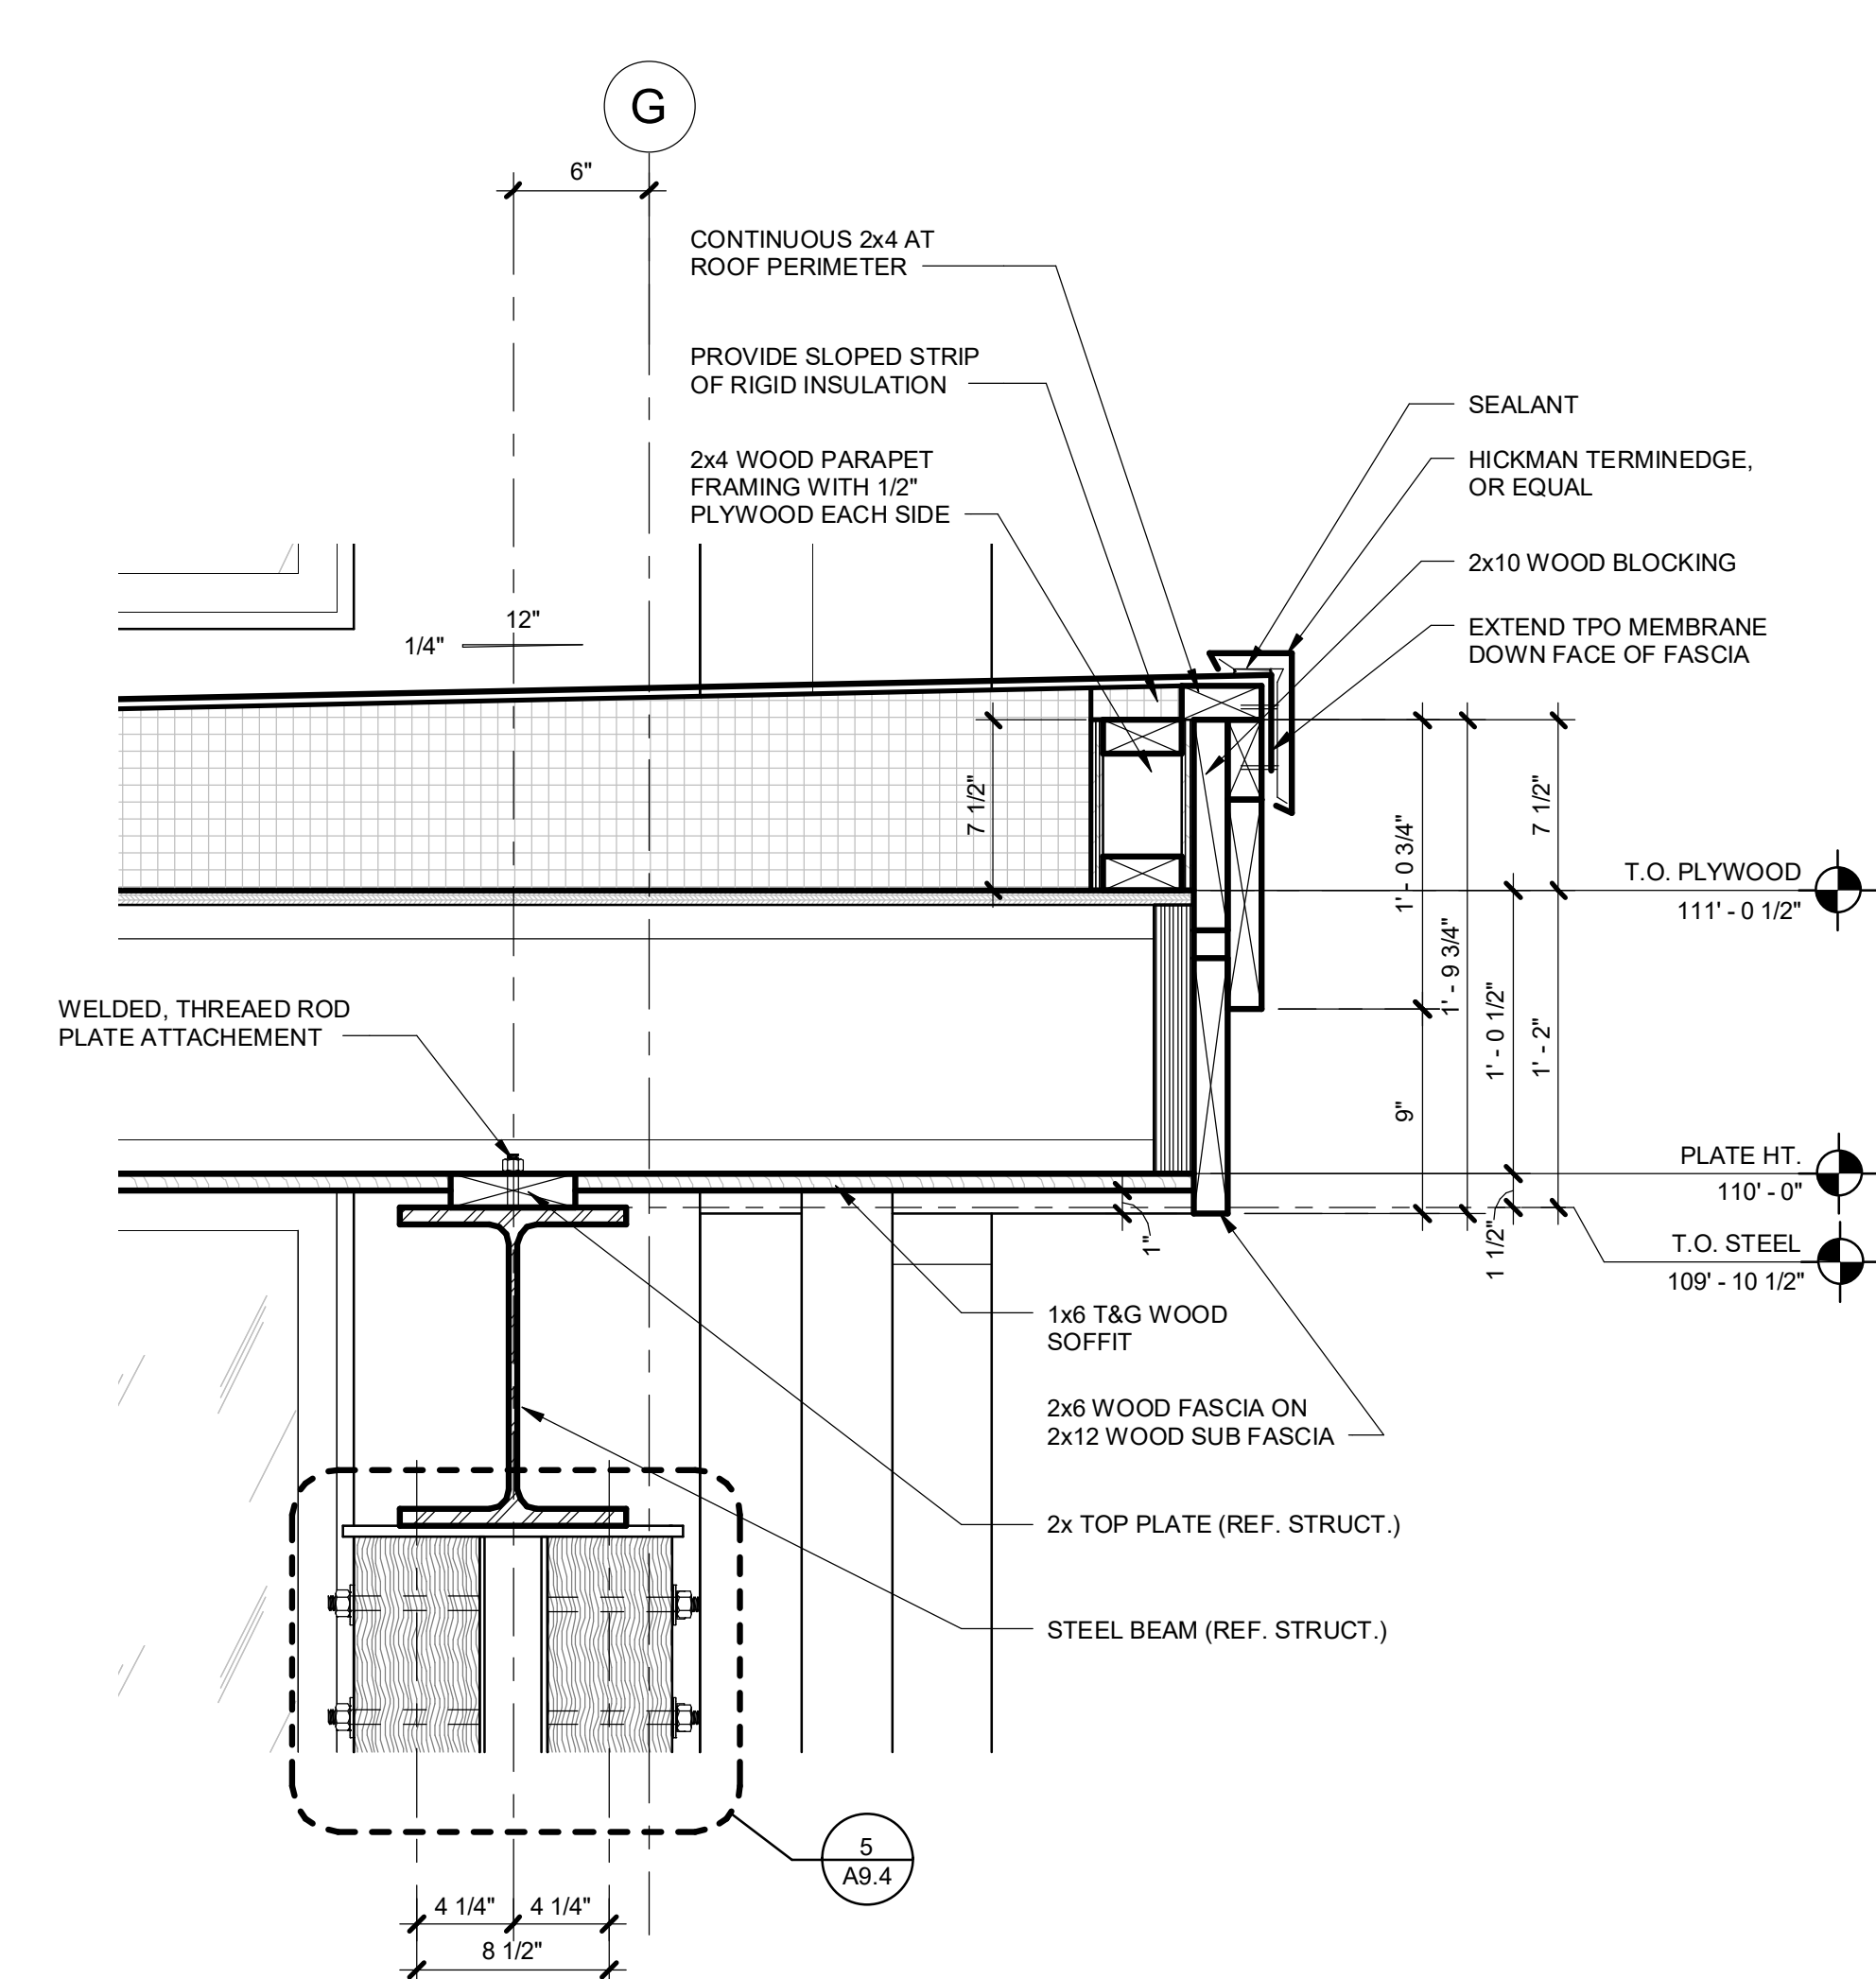


6 EAVE DETAIL
1 1/2" = 1'-0"

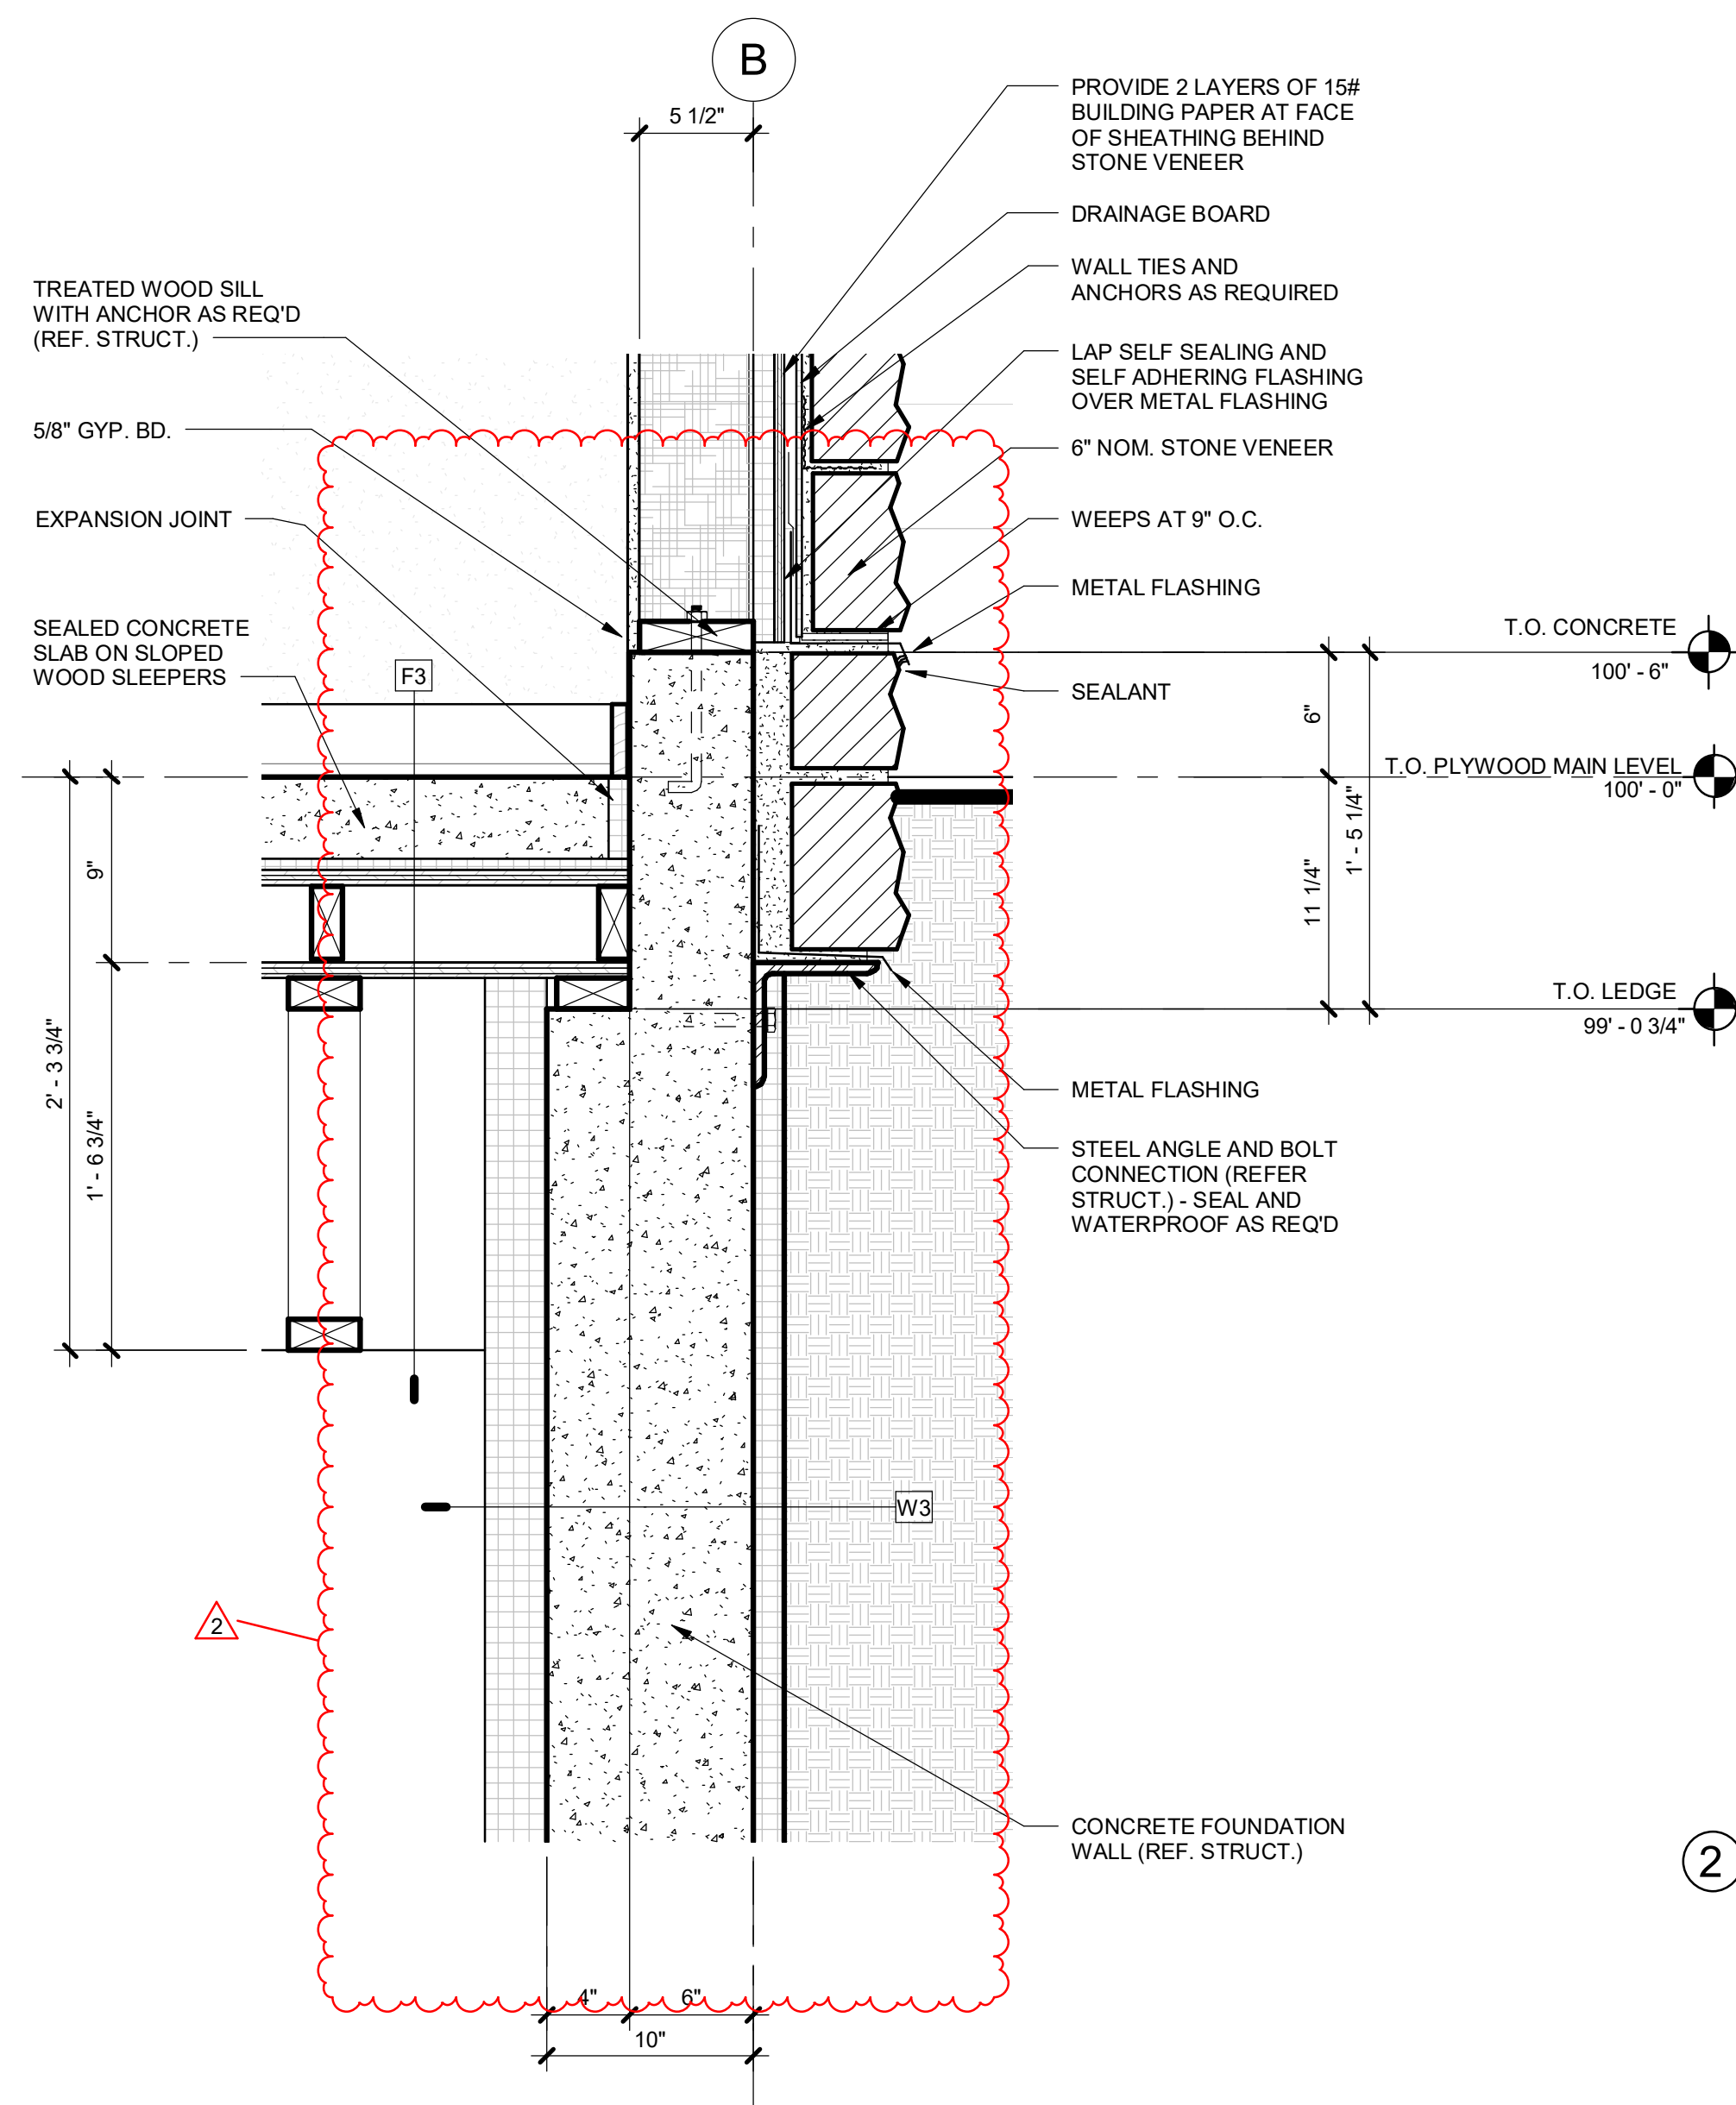


4 FLOOR / WALL DETAIL
1 1/2" = 1'-0"

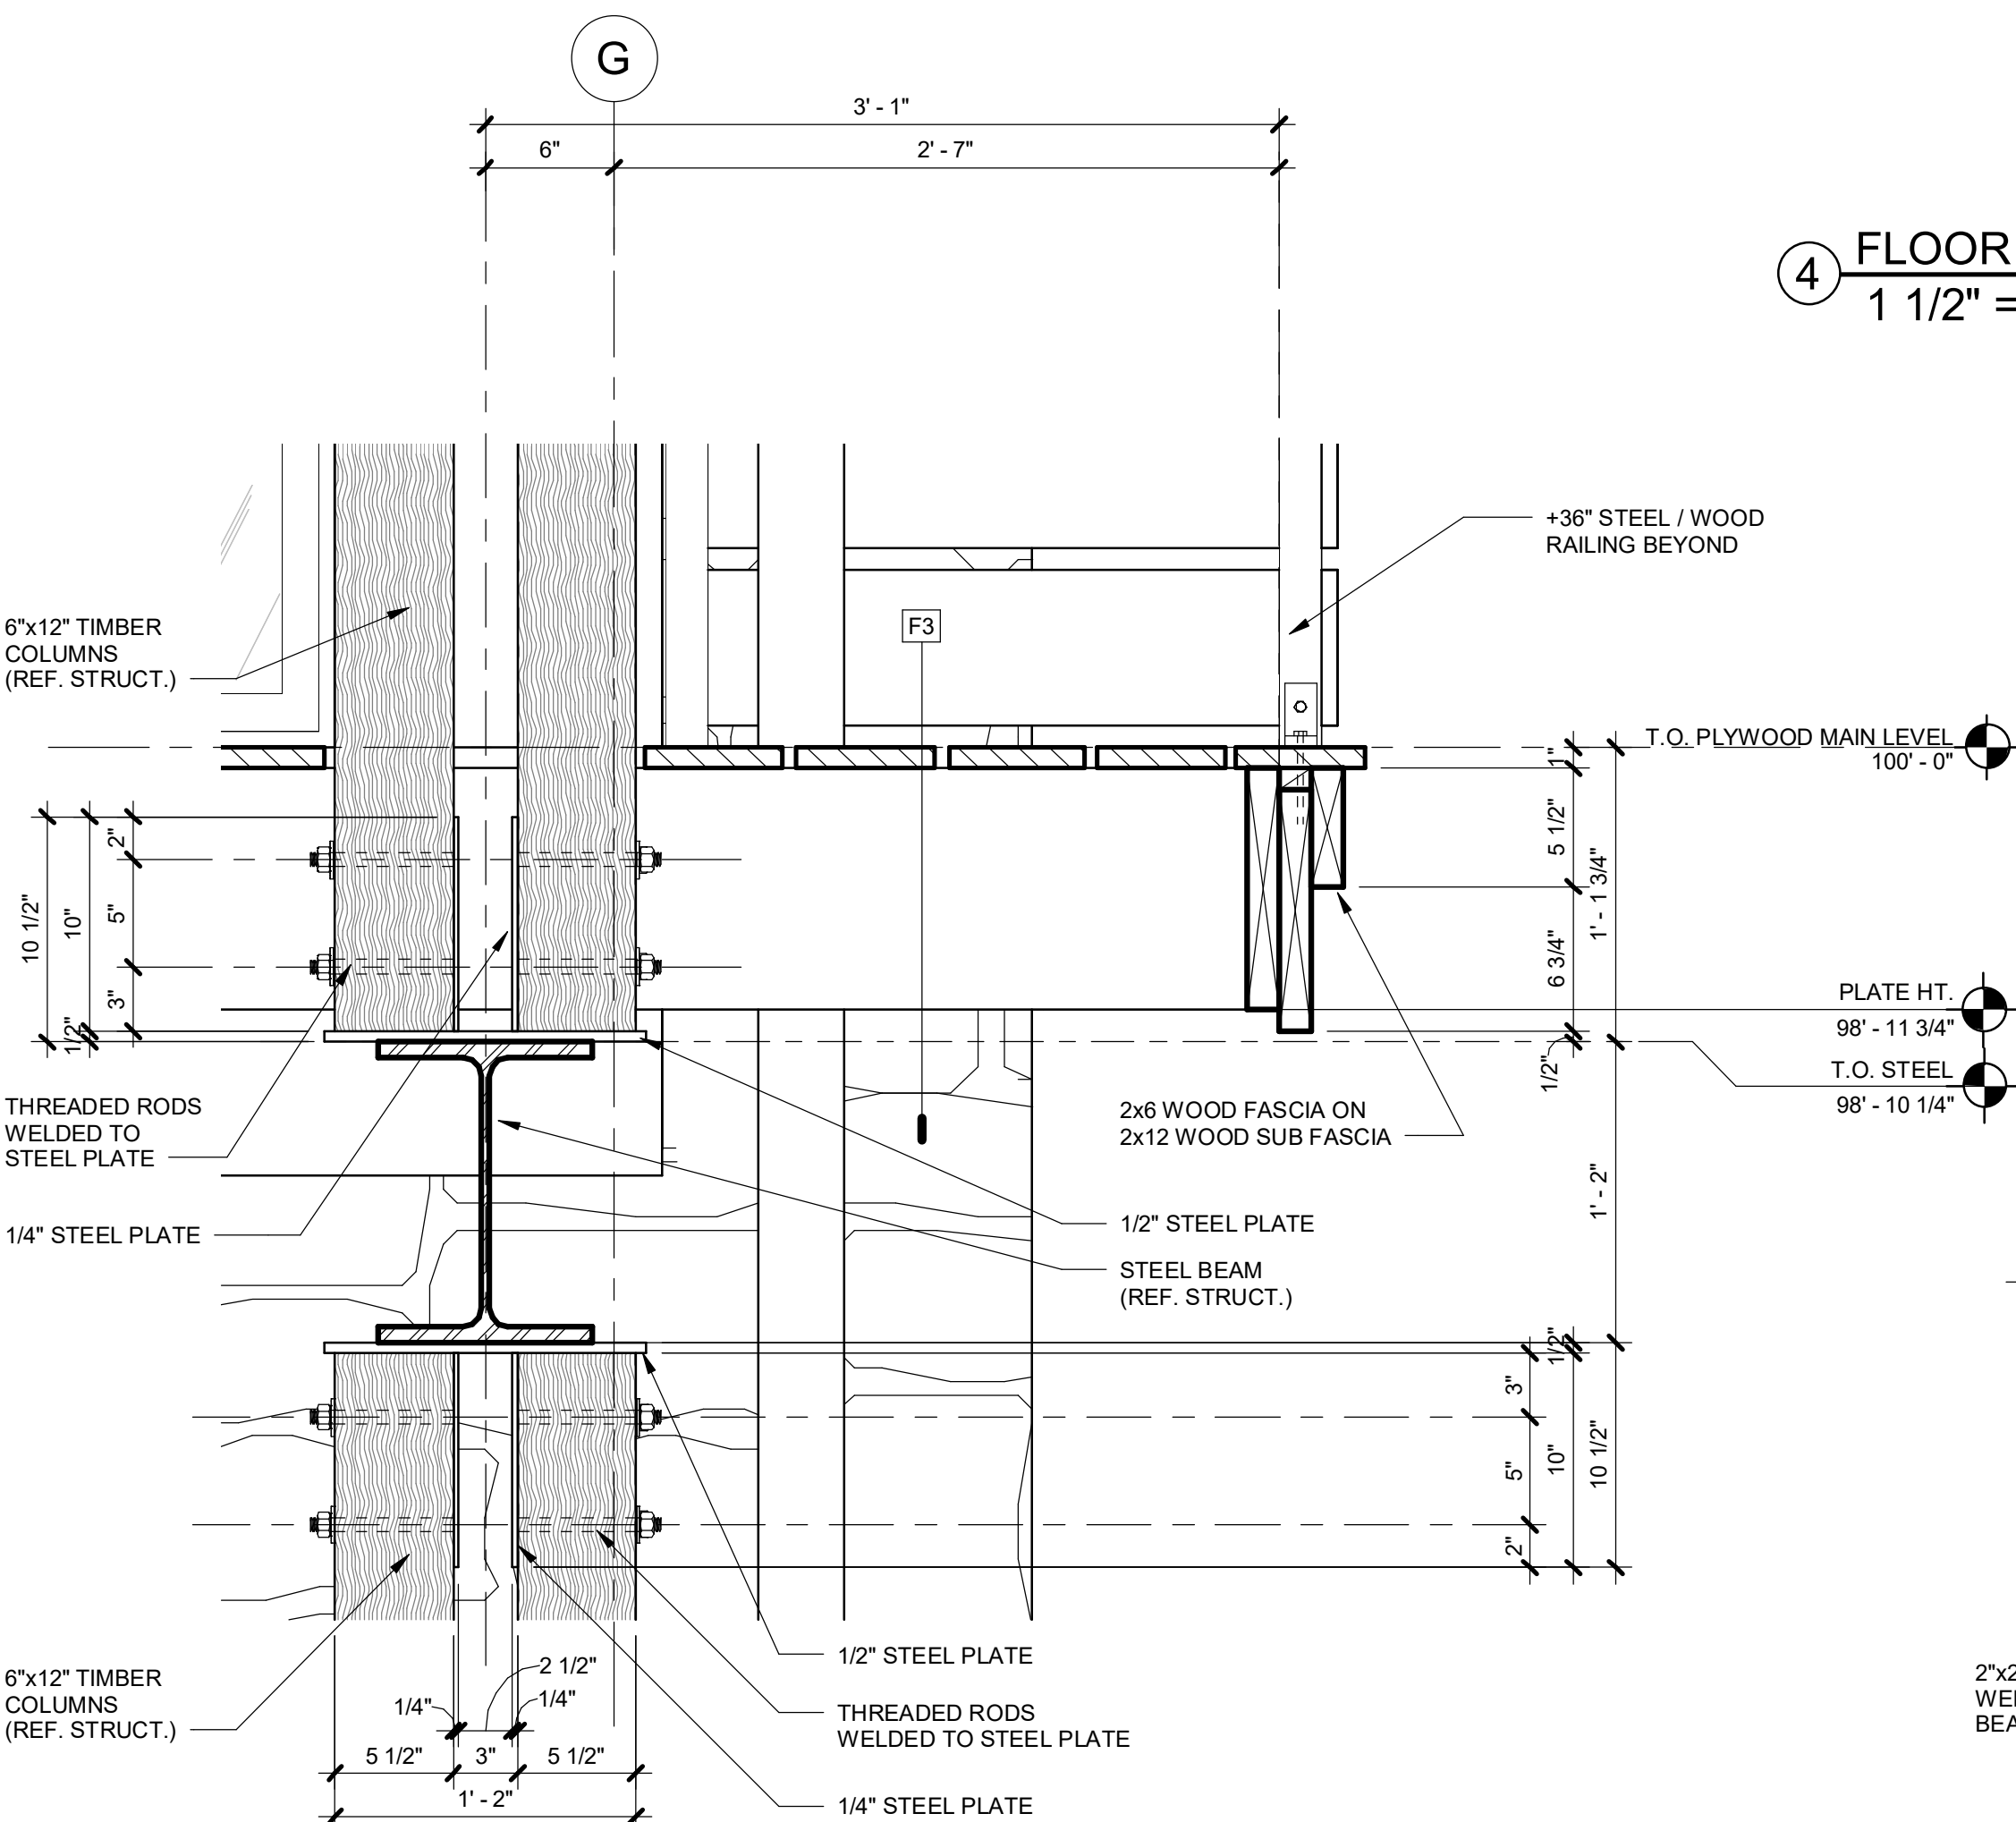


5 DECK FRAMING DETAIL
1 1/2" = 1'-0"

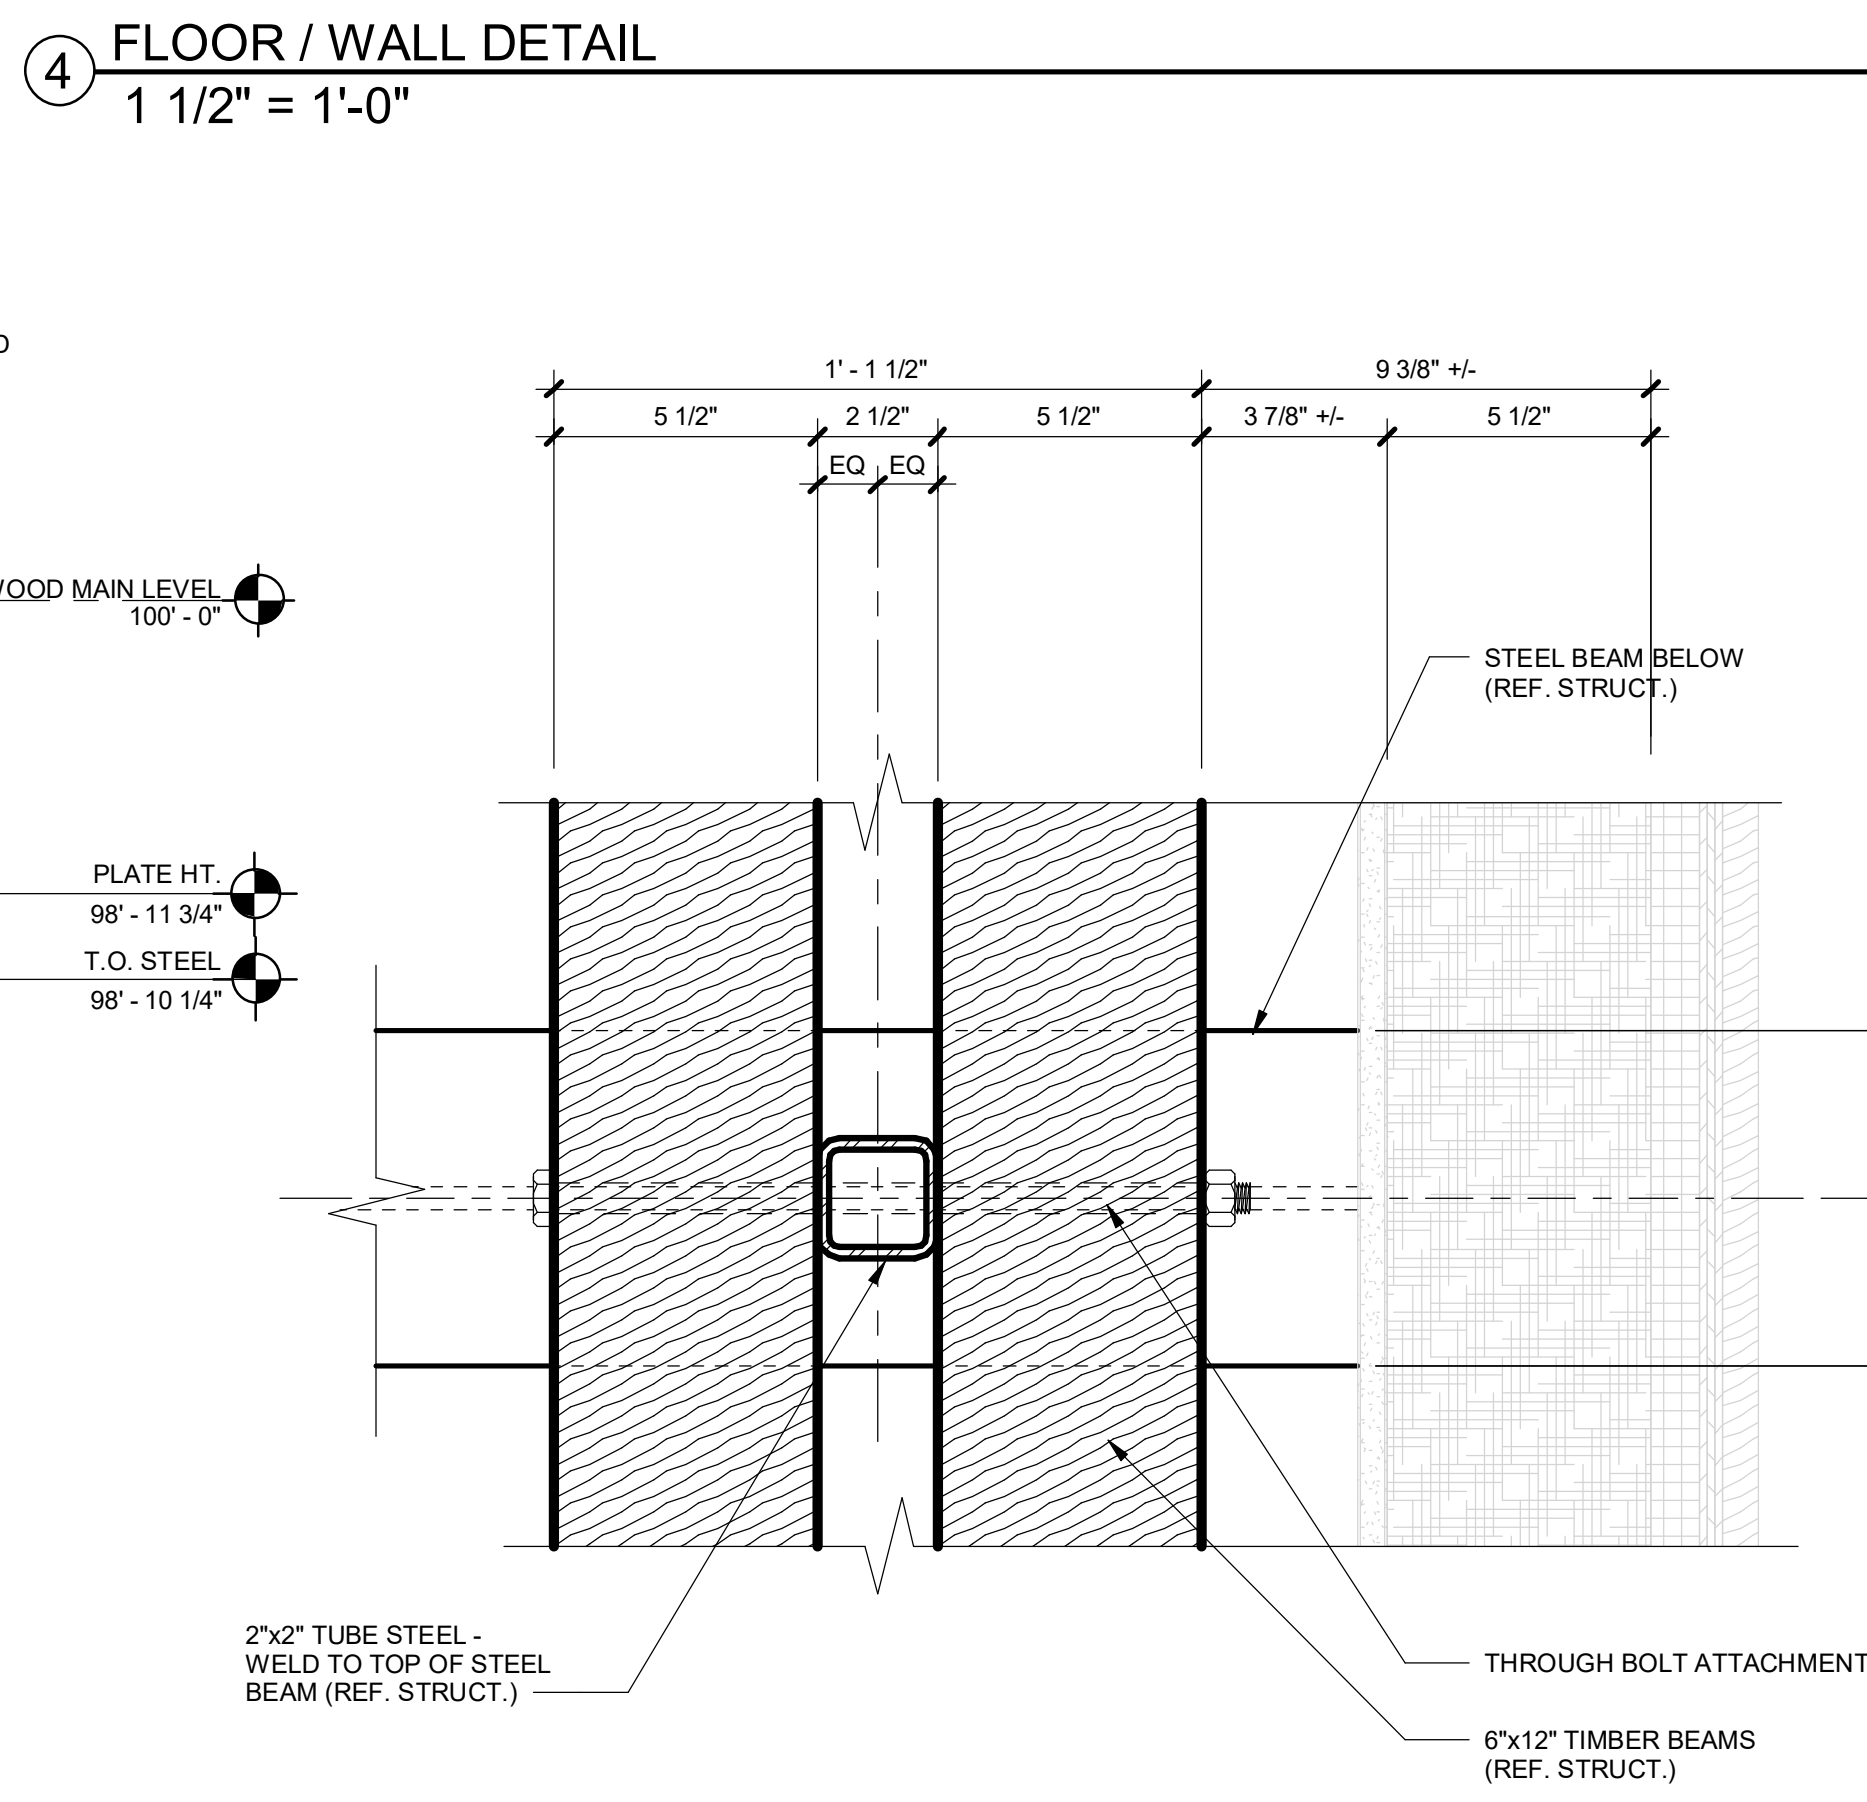

3 BEAM CONNECTION DETAIL
3" = 1'-0"

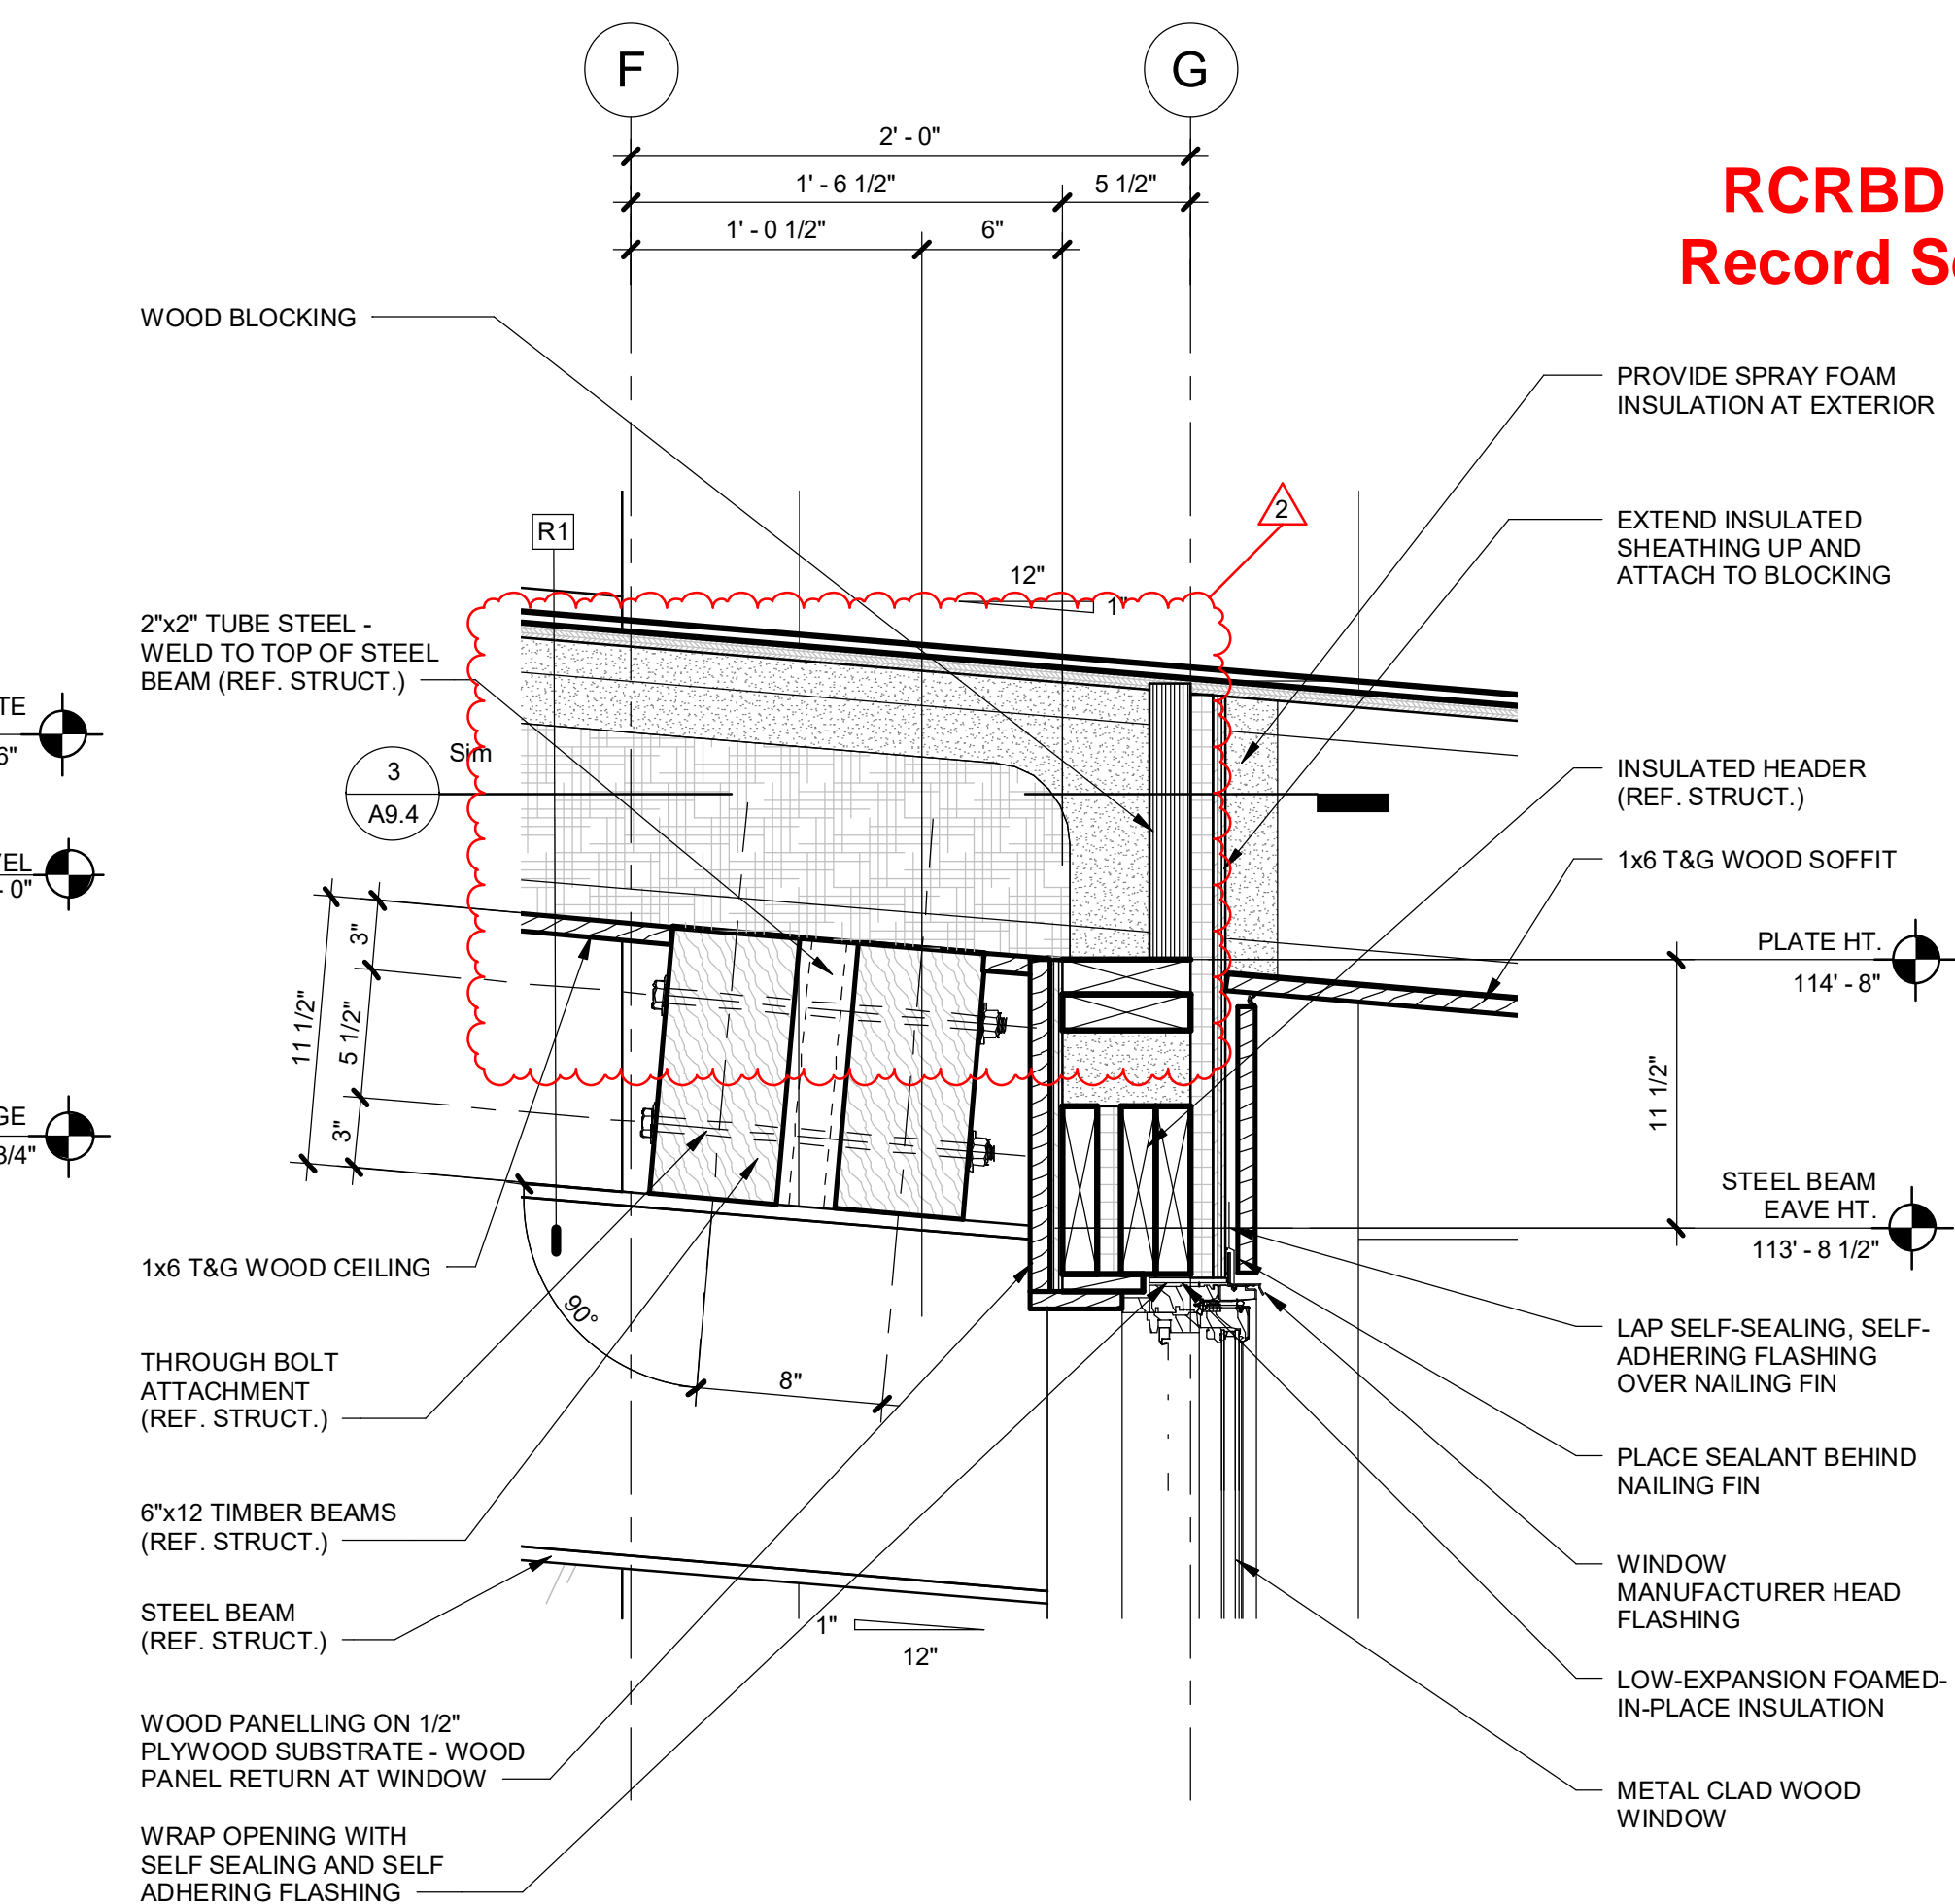

2 FRAMING DETAIL
1 1/2" = 1'-0"

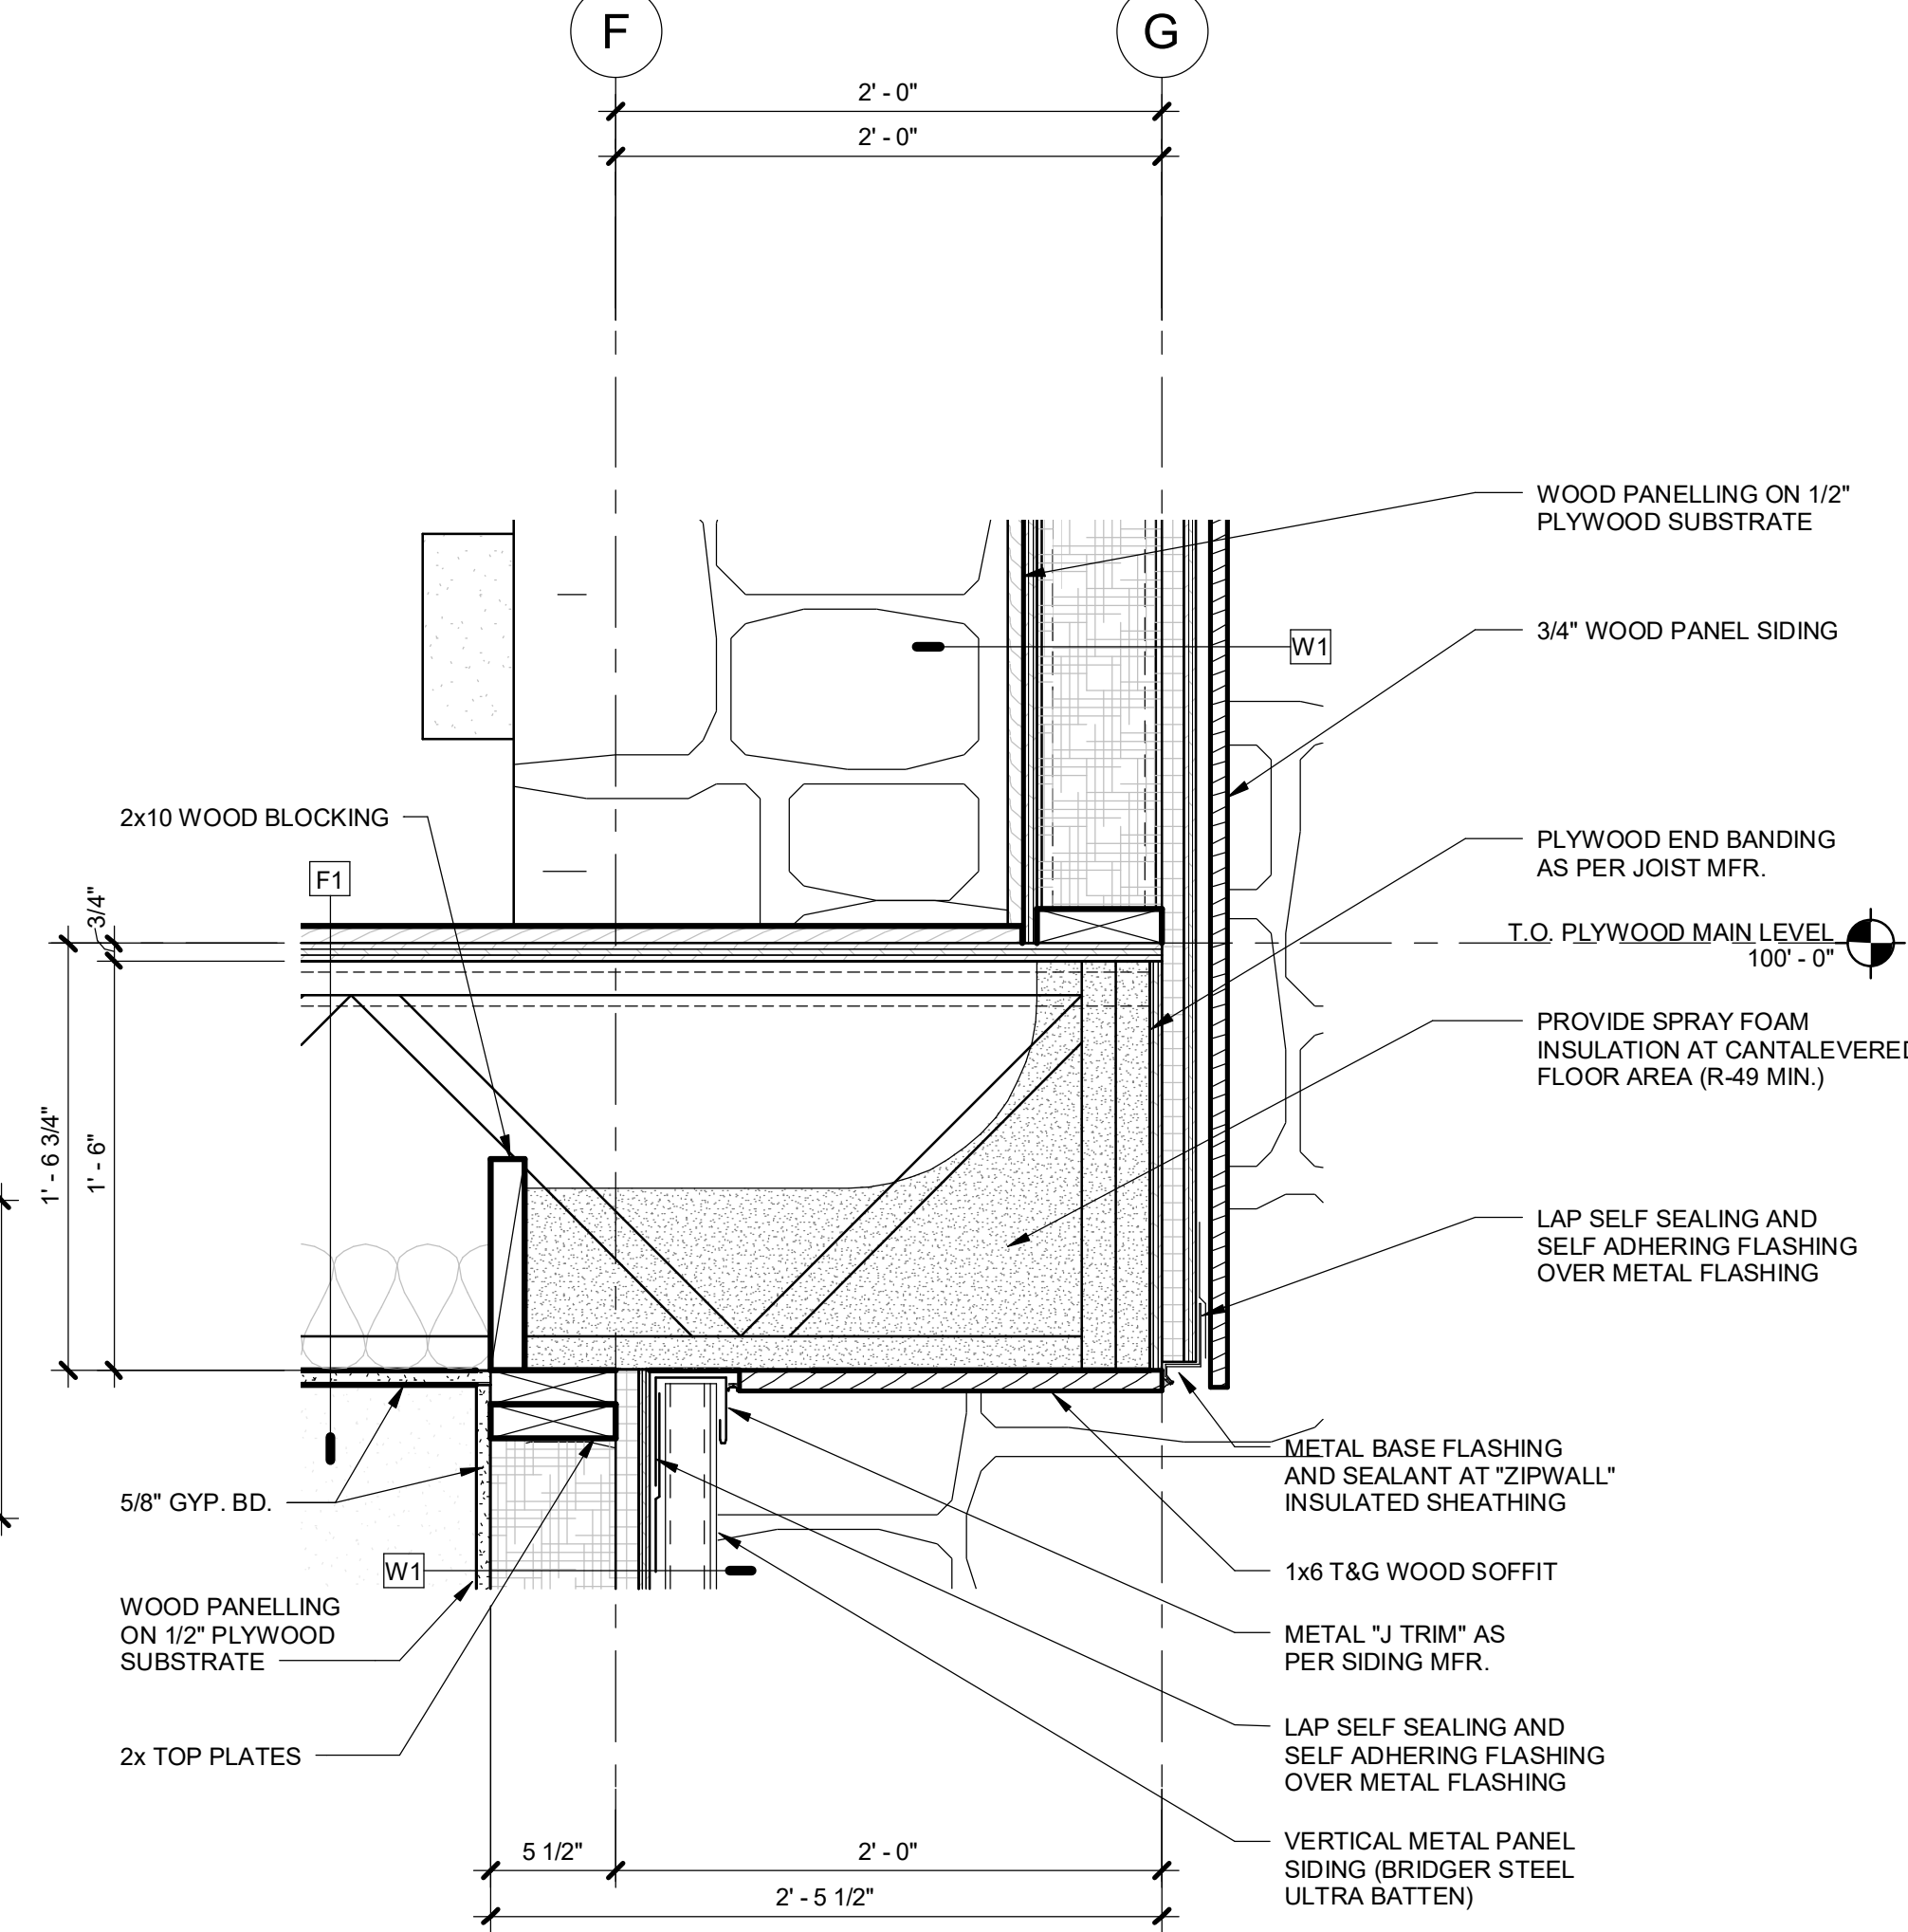


1 FLOOR DETAIL
1 1/2" = 1'-0"

RCRBD
Record Set



ARCHITECTURE
PLANNING
LANDSCAPE
INTERIORS

Copyright VERTICAL ARTS, INC.
All Rights Reserved
This document, and the ideas and designs incorporated herein, are an instrument of professional services, is the property of Vertical Arts Inc. and is not to be used, in whole or in part, for any other project without the written authorization from a principal of Vertical Arts, Inc.

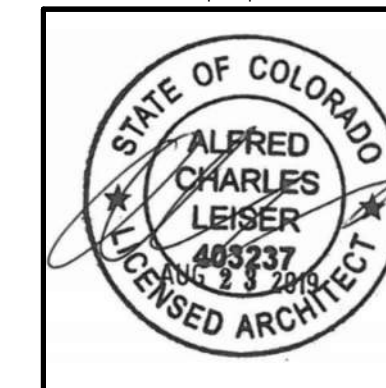

CAMPBELL RESIDENCE
LOT #5 - EAGLES VISTA
STEAMBOAT SPRINGS, CO.
#1907

| ISSUE NAME | DATE |
|---------------------|------------|
| BUILDING PERMIT | 08/23/2019 |
| PERMIT RE-SUBMITTAL | 09/25/2019 |
| REV REVISIONS | 10/14/2019 |









DRAWING TITLE

DETAILS


SHEET NO.

A9.4













10/14/2019 7:37:44 AM

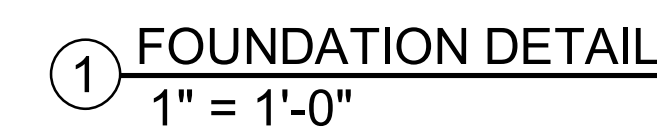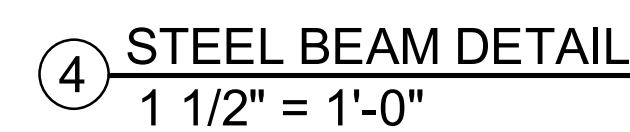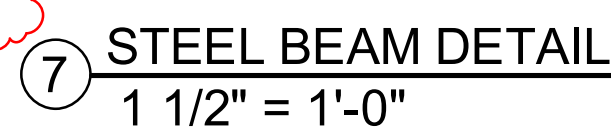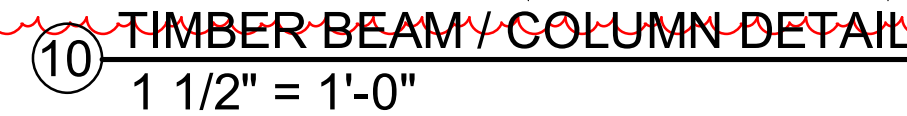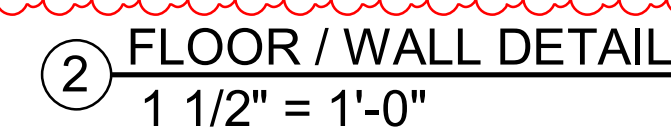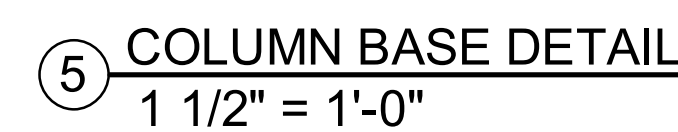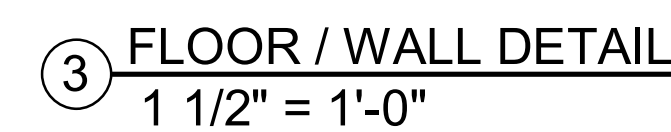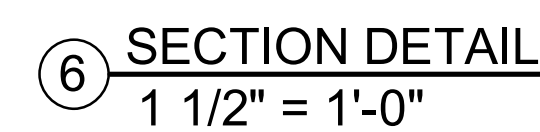

his document, and the ideas and designs incorporated herein, as an instrument of professional service, is the property of Vertical Arts, Inc. and is not to be used, in whole or in part, for any other project without the written authorization from a principal of Vertical Arts, Inc.

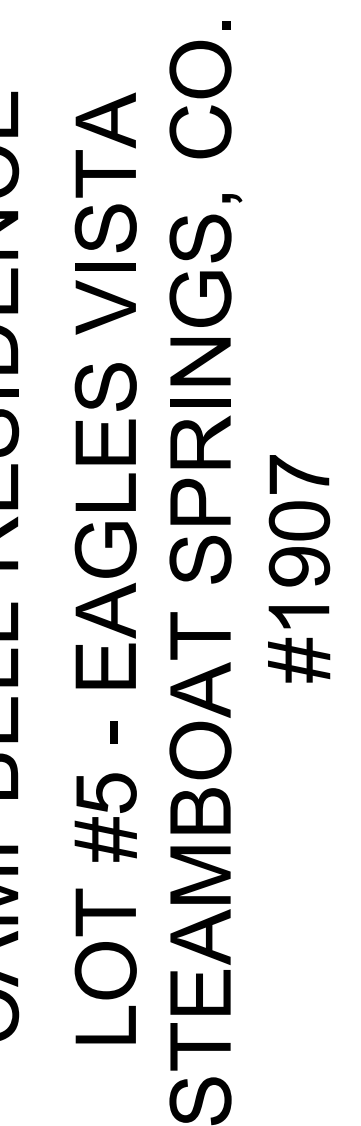A9.6

10/14/2019 7:37:32 AM

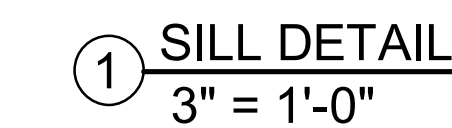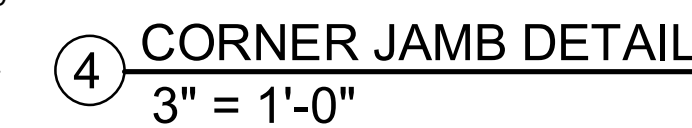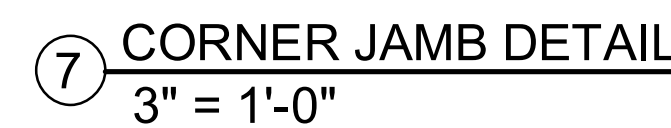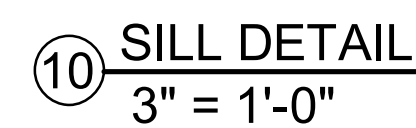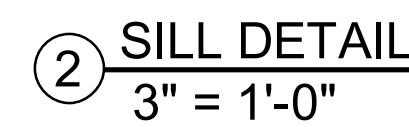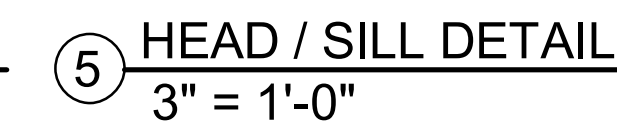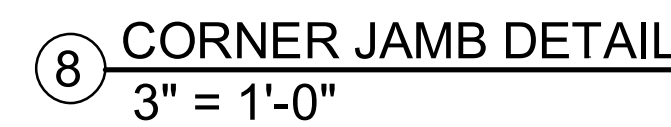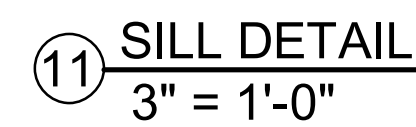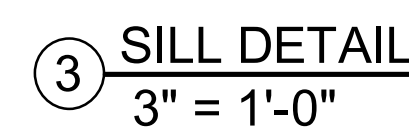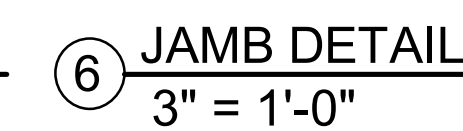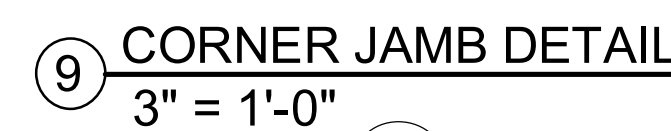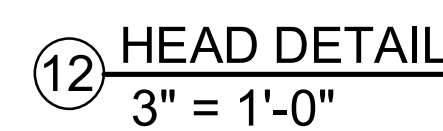

| ISSUE NAME | DATE |
|---------------------|------------|
| BUILDING PERMIT | 08.23.2019 |
| PERMIT RE-SUBMITTAL | 09.25.2019 |
| VE REVISIONS | 10.14.2019 |

DRAWING TITLE

WINDOW/DOOR
DETAILS

SHEET NO.

A10.4

10/14/2019 7:37:53 AM

STRUCTURAL GENERAL NOTES

DESIGN LOADS:

- DESIGN LOADS: 2015 INTERNATIONAL BUILDING CODE WITH ROUTT COUNTY AMENDMENTS, ASCE 7-10
- RISK CATEGORY: II STANDARD
- SITE LOCATION:
 - ELEVATION: 7070.0'
- ROOFS:
 - ROOF DEAD LOAD 20 PSF
 - ROOF LIVE LOAD 20 PSF, 300 LBS
 - GROUND SNOW LOAD, P_g 115 PSF PER ROUTT COUNTY REGIONAL BLDG DEPT)
 - FLAT-ROOF SNOW LOAD, P_f 90 PSF (FOR DESIGN)
 - SNOW EXPOSURE FACTOR, C_e 1.0
 - SNOW IMPORTANCE FACTOR, I_s 1.0
 - THERMAL FACTOR, C_t 1.1
- FLOOR LOADS:

| OCCUPANCY OR USE | UNIFORMLY DISTRIBUTED (PSF) | CONCENTRATED LOAD (LBS) | LIVE LOAD REDUCTION |
|---|---|-------------------------|---------------------|
| RESIDENTIAL LIVE LOAD | 40 | N/A | YES |
| BALCONIES & DECKS (COVERED) LIVE LOAD | 1.5 TIMES LL FOR THE OCCUPANCY SERVED (100 MAX) | N/A | NO |
| BALCONIES & DECKS (UNCOVERED) LIVE LOAD | 90 | N/A | NO |
| RESIDENTIAL DEAD LOAD | 20 (NO GYPCORET) | N/A | NO |
| RESIDENTIAL DECK DEAD LOAD | 15 | N/A | NO |
| RESIDENTIAL GARAGE LIVE LOAD | 40 | 3000 | NO |
| RESIDENTIAL GARAGE DEAD LOAD | 65 | N/A | NO |

6. WIND:

- ULTIMATE DESIGN WIND SPEED, V_{ult} , (3-SECOND GUST) 115 MPH
 - NOMINAL DESIGN WIND SPEED, V_{ASD} , (3-SECOND GUST) 90 MPH
 - INTERNAL PRESSURE COEFFICIENT 0.18 (ENCLOSED)
 - WIND EXPOSURE C
 - AIR DENSITY COEFFICIENT .81
 - COMPONENTS AND CLADDING ULTIMATE DESIGN WIND PRESSURES
 - WALLS:
 - WITHIN 12 FEET OF CORNERS +23 PSF -31 PSF
 - AWAY FROM CORNERS +23 PSF -25 PSF
 - ROOFS:
 - WITHIN 12 FEET OF CORNERS +16 PSF -43 PSF
 - WITHIN 12 FEET OF EDGES +16 PSF -38 PSF
 - AWAY FROM EDGES +16 PSF -28 PSF
 - OVERHANGS:
 - WITHIN 6 FEET OF CORNERS +16 PSF -36 PSF
 - AWAY FROM CORNERS +16 PSF -23 PSF
 - PRESSURES MAY BE REDUCED FOR EFFECTIVE WIND AREAS LARGER THAN 10 SQUARE FEET, BUT NOT BELOW 16 PSF
- SEISMIC:
 - SPECTRAL RESPONSE ACCELERATION PARAMETERS
 - SHORT PERIOD
 - S_s 0.27g
 - S_{DS} 0.285g
 - ONE SECOND
 - S_1 0.074g
 - S_{D1} 0.119g
 - SOILS SITE CLASS D
 - SEISMIC IMPORTANCE FACTOR 1.0
 - SEISMIC DESIGN CATEGORY B
 - BASIC SEISMIC-FORCE-RESISTING SYSTEMS)
 - PER IBC SECTION 1613.1 EXCEPTION 1- SEISMIC DESIGN NOT REQUIRED
 - ANALYSIS PROCEDURE EQUIVALENT LATERAL FORCE

FOUNDATION DESIGN:

- REFER TO SOILS REPORT NO. 17-10640 BY NORTHEAST COLORADO CONSULTNACTS (NWCC), DATED SEPTEMBER 5,2017.
- GEOTECHNICAL ENGINEER SHALL VERIFY SOIL CONDITIONS AND TYPES DURING EXCAVATION AND PRIOR TO PLACEMENT OF FORMWORK OR CONCRETE.
- MINIMUM FROST DEPTH SHALL BE 4'-0" BELOW EXTERIOR GRADE.

FOOTINGS:

- DESIGN OF FOOTINGS IS BASED ON
 - MAXIMUM ALLOWABLE BEARING PRESSURE 3,000 PSF
- MINIMUM DEAD LOAD PRESSURE 700 PSF.
- BEAR ON THE NATURAL UNDISTURBED SOIL OR COMPACTED STRUCTURAL FILL. EXTERIOR FOOTINGS SHALL BEAR BELOW FROST DEPTH.

EARTH RETAINING STRUCTURES:

- EARTH EQUIVALENT FLUID LATERAL PRESSURE:
 - WALLS RESTRAINED AT TOP (AT REST) 50 PCF - ON-SITE SOILS
 - WALLS RESTRAINED AT TOP (AT REST) 45 PCF - IMPORTED FREE DRAINING MATERIAL
 - CANTILEVERED WALLS (ACTIVE) 45 PCF - ON-SITE SOILS
 - CANTILEVERED WALLS (ACTIVE) 35 PCF - IMPORTED FREE DRAINING MATERIAL
 - PASSIVE RESISTING 250 PCF (ASSUMED)
- COEFFICIENT OF SLIDING FRICTION 0.4

REINFORCED CONCRETE:

- DESIGN IS BASED ON ACI 318 "BUILDING CODE REQUIREMENTS FOR STRUCTURAL CONCRETE."
- CONCRETE WORK SHALL CONFORM TO ACI 301 "STANDARD SPECIFICATIONS FOR STRUCTURAL CONCRETE."
- STRUCTURAL CONCRETE SHALL HAVE THE FOLLOWING PROPERTIES:

| INTENDED USE | EXPOSURE CLASS | f'_c PSI 28 DAYS | MAX W/C/M RATIO | MAXIMUM AGGREGATE | SLUMP, INCHES (+/- 1") | AIR CONTENT PERCENT (+/- 1.5%) | CEMENT TYPE | ADMIXTURES/ COMMENTS |
|------------------------|----------------|--------------------|-----------------|-------------------|------------------------|--------------------------------|-------------|----------------------|
| FOOTINGS | F0-S0-W0-C1 | 3000 | 0.52 | 3/4" STONE | 5 | 2% | III | |
| STEM WALLS | F0-S0-W0-C1 | 4500 | 0.45 | 3/4" STONE | 4 | 6% | VII | |
| WALLS | F0-S0-W0-C0 | 4000 | 0.45 | 3/4" STONE | 4 | 3% | VII | |
| INTERIOR SLAB - GARAGE | F0-S0-W0-C0 | 4000 | 0.45 | 3/4" STONE | 4 | 3% | VII | |
| EXTERIOR SLAB ON GRADE | F3-S0-W0-C2 | 5000 | 0.40 | 3/4" STONE | 4 | 6% | VII | 25% MAX FLY ASH |

- DETAILING, FABRICATION, AND PLACEMENT OF REINFORCING STEEL SHALL BE IN ACCORDANCE WITH ACI 315 "DETAILS AND DETAILING OF CONCRETE REINFORCEMENT."
- WELDED WIRE FABRIC SHALL CONFORM TO ASTM A185.
- REINFORCING BARS SHALL CONFORM TO ASTM A615, GRADE 60, EXCEPT TIES OR BARS SHOWN TO BE FIELD-BENT, WHICH SHALL BE GRADE 40.
- EPOXY COATED REINFORCING BARS SHALL CONFORM TO ASTM A775 (STRAIGHT BARS) AND ASTM A934 (PRE-FABRICATED BARS).
- ZINC COATED (GALVANIZED) REINFORCING BARS SHALL CONFORM TO ASTM A767.
- BARS TO BE WELDED SHALL CONFORM TO ASTM A706.
- UNLESS NOTED OTHERWISE ON THE STRUCTURAL DRAWINGS, LAP BARS 50 DIAMETERS (MINIMUM).
- AT CORNERS AND INTERSECTIONS, MAKE HORIZONTAL BARS CONTINUOUS OR PROVIDE MATCHING CORNER BARS FOR EACH LAYER OF REINFORCEMENT.
- TRIM OPENINGS IN WALLS AND SLABS WITH (2) #5 FOR EACH LAYER OF REINFORCEMENT, FULLY DEVELOPED BY EXTENSION OR HOOK.
- IN CONTINUOUS MEMBERS, SPICE TOP BARS AT MID-SPAN AND SPICE BOTTOM BARS OVER SUPPORTS.
- FORM INTERMITTENT SHEAR KEYS AT ALL CONSTRUCTION JOINTS AND AS SHOWN ON THE STRUCTURAL DRAWINGS.
- EXCEPT AS NOTED ON THE DRAWINGS, CONCRETE PROTECTION FOR REINFORCEMENT IN CAST-IN-PLACE CONCRETE SHALL BE AS FOLLOWS:
 - CAST AGAINST AND PERMANENTLY EXPOSED TO EARTH: 3"
 - EXPOSED TO EARTH OR WEATHER:
 - #6 THROUGH #18 BARS 2"
 - #5 BAR, W31 OR D31 WIRE, AND SMALLER 1-1/2"
 - NOT EXPOSED TO WEATHER OR IN CONTACT WITH GROUND:
 - SLABS, WALLS, JOISTS: #11 BARS AND SMALLER 3/4"
 - BEAMS AND COLUMNS:
 - PRIMARY REINFORCEMENT 1-1/2"
 - STIRRUPS, TIES, SPIRALS 1-1/2"
- ANCHOR BOLTS AND RODS FOR BEAM AND COLUMN-BEARING PLATES SHALL BE PLACED WITH SETTING TEMPLATES.

POST-INSTALLED ANCHORS

- ALL CAST IN PLACE ANCHORS DESIGNED IN ACCORDANCE WITH ACI 318.
- POST-INSTALLED ANCHORS SHALL ONLY BE USED WHERE SPECIFIED ON THE CONSTRUCTION DOCUMENTS. THE CONTRACTOR SHALL OBTAIN APPROVAL FROM THE ENGINEER-OF-RECORD PRIOR TO INSTALLING POST-INSTALLED ANCHORS IN PLACE OF MISSING OR MISPLACED CAST-IN-PLACE ANCHORS.
- CARE SHALL BE TAKEN IN PLACING POST-INSTALLED ANCHORS TO AVOID CONFLICTS WITH EXISTING REBAR. EXISTING REINFORCING BARS SHALL NOT BE CUT UNLESS APPROVED BY THE EOR.
- ALL ANCHORS MUST BE INSTALLED IN STRICT ACCORDANCE WITH THE MANUFACTURER'S PRINTED INSTALLATION INFORMATION (MPI) IN CONJUNCTION WITH EDGE DISTANCE, SPACING, AND EMBEDMENT DEPTH AS INDICATED ON THE DRAWINGS. HOLES SHALL BE DRILLED AND CLEANED IN ACCORDANCE WITH THE MPI.
- SUBSTITUTION REQUESTS, FOR PRODUCTS OTHER THAN THOSE SPECIFIED, SHALL BE SUBMITTED BY THE CONTRACTOR TO THE ENGINEER-OF-RECORD ALONG WITH CALCULATIONS THAT ARE PREPARED & SEALED BY A REGISTERED PROFESSIONAL ENGINEER. REGISTRATION MUST BE IN THE STATE IN WHICH THE PROJECT IS LOCATED. THE CALCULATIONS SHALL DEMONSTRATE THAT THE SUBSTITUTED PRODUCT IS CAPABLE OF ACHIEVING EQUIVALENT PERFORMANCE VALUES (MINIMUM) OF THE SPECIFIED PRODUCT USING THE APPROPRIATE DESIGN PROCEDURE AND/OR STANDARD(S) AS REQUIRED BY THE AUTHORITY HAVING JURISDICTION.
- THE CONTRACTOR SHALL ARRANGE FOR A MANUFACTURER'S FIELD REPRESENTATIVE TO PROVIDE INSTALLATION TRAINING FOR ALL PRODUCTS TO BE USED PRIOR TO THE ANCHOR INSTALLATION. A RECORD OF TRAINING SHALL BE KEPT ON SITE AND MADE AVAILABLE TO THE EOR/S SPECIAL INSPECTOR AS REQUESTED.
- ADHESIVE ANCHORS INSTALLED IN HORIZONTAL TO VERTICALLY OVERHEAD ORIENTATION THAT SUPPORT SUSTAINED TENSION LOADS SHALL BE DONE BY A CERTIFIED ANCHOR INSTALLER (AAI) AS CERTIFIED THROUGH AICORSI (ACI 318-11 D 9.2.2, ACI 318-14 17.8.2.2). PROOF OF CURRENT CERTIFICATION SHALL BE SUBMITTED TO THE EOR FOR APPROVAL PRIOR TO COMMENCEMENT OF INSTALLATION.
- ADHESIVE ANCHORS MUST BE INSTALLED IN CONCRETE AGED A MINIMUM OF 21 DAYS (ACI 318-11 D 2.2, ACI 318-14 17.1.2).
- ALL POST INSTALLED ANCHORS SHALL BE INSTALLED IN DRY HOLES THAT HAVE BEEN DRILLED, CLEANED, AND PREPARED IN STRICT ACCORDANCE WITH THE MANUFACTURER'S PRINTED INSTALLATION INFORMATION AND THE RESPECTIVE ICC-ES EVALUATION REPORTS.
- PROVIDE SPECIAL INSPECTION FOR ALL MECHANICAL AND ADHESIVE ANCHORS PER THE APPLICABLE BUILDING CODE AND PER THE CURRENT ICC-ES REPORT (IBC 2012/2015 TABLE 1705.3 NOTE B).

| CONCRETE POST INSTALLED ANCHORS | | | | |
|---------------------------------|--------------------------------|-----------------------------|------------------------------|--|
| ANCHOR TYPE | DEWALT | HILTI | SIMPSON | |
| EXPANSION | POWER-STUD: SD2 (ICC ESR-2502) | KWIK BOLT T2 (ICC ESR-1917) | STRONG-BOLT 2 (ICC ESR-3037) | |
| CONCRETE SCREW | SCREW-BOLT+ (ICC ESR 3889) | KWIK HUS-EZ (ICC ESR-3027) | TITEN HD (ICC ESR 2713) | |
| ADHESIVE | AC208+ (ICC ESR-4027) | HIT-HY 200 (ICC ESR-3187) | AT-XP (UES ESR-263) | |

STRUCTURAL STEEL:

- STRUCTURAL STEEL SHALL BE DETAILED, FABRICATED, AND ERECTED IN ACCORDANCE WITH THE "SPECIFICATION FOR STRUCTURAL STEEL BUILDINGS" (AISC 360) AND THE "CODE OF STANDARD PRACTICE FOR STEEL BUILDINGS AND BRIDGES" (AISC 303) BY THE AMERICAN INSTITUTE OF STEEL CONSTRUCTION (AISC).
- STRUCTURAL STEEL WIDE FLANGE BEAMS SHALL CONFORM TO ASTM A992, 50 KSI YIELD.
- ROLLED STEEL FLOOR PLATES SHALL CONFORM TO ASTM A786, COMMERCIAL GRADE.
- OTHER ROLLED SHAPES, INCLUDING PLATES, CHANNELS, WTS, AND ANGLES SHALL CONFORM TO ASTM A36, 36 KSI YIELD.
- HOLLOW STRUCTURAL SECTION (HSS) RECTANGULAR SHAPES SHALL CONFORM TO ASTM A500, GRADE C, 50 KSI YIELD.
- HSS ROUND SHAPES SHALL CONFORM TO ASTM A500, GRADE C, 46 KSI YIELD.
- PIPE SHAPES SHALL CONFORM TO ASTM A53, GRADE B, 35 KSI YIELD.
- EXCEPT AS NOTED, FRAMED BEAM CONNECTIONS SHALL BE BEARING-TYPE WITH 3/4" DIAMETER, SNUG TIGHT, ASTM A325 BOLTS, DETAILED IN CONFORMANCE WITH THE STRUCTURAL DRAWINGS AND THE "STEEL CONSTRUCTION MANUAL" BY THE AISC. INSTALL BOLTS IN ACCORDANCE WITH AISC'S "SPECIFICATION FOR STRUCTURAL JOINTS USING ASTM A325 OR A490 BOLTS".
- ALL BEAMS SHALL HAVE FULL DEPTH WEB STIFFENERS EACH SIDE OF WEBS ABOVE AND BELOW COLUMNS.
- ANCHOR RODS SHALL CONFORM TO ASTM F1554, GRADE 36, 55 WITH WELDABILITY SUPPLEMENT S1, AND/OR 105) AS NOTED ON THE STRUCTURAL DRAWINGS.
- HEADED ANCHOR STUDS (HAS) SHALL CONFORM TO ASTM A108 AND SHALL BE CONNECTED TO STRUCTURAL STEEL WITH EQUIPMENT APPROVED BY THE STUD MANUFACTURER ACCORDING TO THE STUD MANUFACTURER'S RECOMMENDATIONS.
- WELDING SHALL BE DONE BY A CERTIFIED WELDER IN ACCORDANCE WITH THE AISC DOCUMENTS LISTED ABOVE, THE AMERICAN WELDING SOCIETY (AWS) D1.1: STRUCTURAL WELDING CODE, AND THE RECOMMENDATIONS FOR USE OF WELD E70 ELECTRODES. WHERE NOT SPECIFICALLY NOTED, MINIMUM WELD SHALL BE 3/16" FILLET BY LENGTH OF CONTACT EDGE.
- GROUT BENEATH COLUMN BASE AND BEAM BEARING PLATES SHALL HAVE A MINIMUM 28-DAY, COMPRESSIVE STRENGTH OF 7,500 PSI AND SHALL BE NON-SHRINK, NON-METALLIC, AND TESTED IN ACCORDANCE WITH ASTM C1107.

STRUCTURAL WOOD FRAMING:

- IN-GRADE BASE VALUES HAVE BEEN USED FOR DESIGN.
- DIMENSIONAL LUMBER FRAMING SHALL BE S4S DOUG FIR NO. 2 AND BETTER UNO.
- SOLID TIMBER BEAMS AND POSTS SHALL BE DOUGLAS FIR-LARCH NO. 1 AND BETTER UNO.
- STUDS SHALL BE DOUG FIR STUD GRADE AND BETTER UNO.
- TOP AND BOTTOM PLATES SHALL BE DOUGLAS FIR-LARCH NO. 2 AND BETTER UNO.
- LUMBER SHALL BE 18% MAXIMUM MOISTURE CONTENT AT THE TIME OF INSTALLATION UNO.
- ALL WOOD EXPOSED TO WEATHER OR IN CONTACT WITH CONCRETE OR MASONRY SHALL BE PRESURE TREATED DOUGLAS FIR-LARCH OR SOUTHERN YELLOW PINE. PRESERVATIVE-TREATED WOOD SHALL BE TREATED IN ACCORDANCE WITH AWWA STANDARDS U1 AND M4. TREATMENTS SHALL HAVE NO AMMONIA ADDED AND SHALL BE THE FOLLOWING USE CATEGORY:
 - UC24 AT INTERIOR
 - UC38 AT EXTERIOR WITH NO GROUND CONTACT
 - UC48 AT EXTERIOR WITH GROUND CONTACT
- FASTENERS FOR USE WITH TREATED WOOD SHALL BE CORROSION RESISTANT IN ACCORDANCE WITH SECTION 2304.10.5 IN 2015 IBC.
- ALL CONNECTORS USED WITH PRESURE-TREATED MATERIAL SHALL BE STAINLESS STEEL ASTM 304 OR 316, OR HAVE A SIMPSON 2 MAX (C150) OR HATCO CONNECTION (590) IS ACCEPTABLE AT INTERIOR CONDITIONS WITH NON PRESURE-TREATED LUMBER ONLY. CONNECTORS ARE TO BE IN ACCORDANCE WITH ASTM A663 OR ASTM 123.
- ALL IRON AND STEEL PRODUCTS ATTACHED TO TREATED LUMBER SHALL BE HOT-DIPPED GALVANIZED IN ACCORDANCE WITH ASTM A123 OR SHALL BE TYPE 304 OR 316 STAINLESS STEEL.
- STRUCTURAL MEMBERS SHALL NOT BE CUT FOR PIPES, ETC. UNLESS SPECIFICALLY NOTED OR DETAILED ON THE STRUCTURAL DRAWINGS.
- ALL BOLTS SHALL BE RETIGHTENED PRIOR TO CLOSING IN OF WALLS, FLOORS, AND ROOFS.
- ALL BOLTS BEARING ON WOOD SHALL HAVE STANDARD CUT WASHERS UNDER HEAD AND/OR NUT, UNO.
- METAL FRAMING ANCHORS SHOWN OR REQUIRED, SHALL BE SIMPSON STRONG-TIE OR EQUAL CODE APPROVED CONNECTORS AND INSTALLED WITH ALL HOLES FILLED (ROUND AND TRIANGULAR) WITH THE MAXIMUM SIZE NAIL RECOMMENDED BY THE MANUFACTURER TO DEVELOP THE MAXIMUM RATED CAPACITY.
- CONNECTOR BOLTS AND LAG SCREWS SHALL CONFORM TO ANSISMAE B18.2.1 AND ASTM SAE J429 GRADE 1.
- NAILS AND SPIKES SHALL CONFORM TO ASTM F1667.
- WOOD SCREWS SHALL CONFORM TO ANSISMAE B18.6.1.
- LEAD HOLES FOR LAG SCREWS SHALL BE 40%-70% OF THE SHANK DIAMETER AT THE THREADED SECTION AND EQUAL TO THE SHANK DIAMETER AT THE UNTHREADED SECTION.
- CONVENTIONAL LIGHT FRAMING SHALL COMPLY WITH IBC SECTION 2308.
- COLUMNS/ MULTIPLE STUDS IN BEARING WALLS SUPPORTING ALL BEAMS AND HEADERS SHALL OCCUR CONTINUOUSLY THROUGH EACH FLOOR LEVEL DOWN TO THE FOUNDATION OR ANOTHER SUPPORT BEAM. SOLID SQUASH BLOCKING EQUIVALENT IN AREA TO THE COLUMN/MULTIPLE STUDS ABOVE SHALL BE PROVIDED WITHIN THE JOIST SPACE BENEATH THE COLUMN/MULTIPLE STUDS.
- ALL BEAMS AND TRUSSES SHALL BE BRACED AGAINST ROTATION AT POINTS OF BEARING.
- 2X BLOCKING SHALL BE PLACED BETWEEN JOISTS OR RAFTERS AT ALL SUPPORTS, UNO.
- CROSS-BRIDGING OR SOLID BLOCKING SHALL BE PROVIDED AT 8'-0" MAX. FOR ALL JOISTS AND RAFTERS MORE THAN 10' IN DEPTH, 2X3 OR APPROVED METAL TYPE BRIDGING MAY BE USED.
- PROVIDE A MINIMUM OF (3) STUDS AT EACH CORNER, UNO.
- ALL JOISTS AND BEAMS (EXCLUDING I-JOISTS) SHALL BE SEAT-CUT FOR FULL UNIFORM BEARING AT SUPPORTS, SEATS, CAPS, ETC.
- VENTING IS REQUIRED IN ALL ENCLOSED ROOF AND CRAWL SPACE FRAMING CAVITIES. SEE ARCHITECTURAL DRAWINGS.
- EXCEPT AS NOTED OTHERWISE, MINIMUM NAILING SHALL BE PROVIDED AS SPECIFIED IN TABLE 2304.10.1 "FASTENING SCHEDULE" IN 2015 IBC.
- ALL MULTIPLE MEMBER BEAMS SHALL BE NAILED TOGETHER WITH MAX NUMBER OF 100 NAILS VERTICALLY @ 3" AND HORIZONTALLY @ 12" PER VLY.
- TONGUE AND GROOVE DECKING SHALL BE INSTALLED IN ACCORDANCE WITH THE "STANDARD FOR TONGUE AND GROOVE HEAVY TIMBER ROOF DECKING", ATC 112, WHERE DECKING MUST BE NAILED FROM THE BOTTOM SIDE. USE (2) 16D GALVANIZED FINISH NAILS AT EACH SUPPORT, COUNTERSUNK AND FILLED.
- ALL ROOF RAFTERS, JOISTS, TRUSSES, AND BEAMS SHALL BE ANCHORED TO SUPPORTS WITH H2.5A METAL FRAMING ANCHORS UNO. PROVIDE (2) WITHIN 4'-0" OF ALL CORNERS.

WOOD SHEATHING:

- PLYWOOD AND ORIENTED STRAND BOARD (OSB) FLOOR AND ROOF SHEATHING SHALL BE APA RATED WITH STAMP INCLUDING APA TRADEMARK AND PANEL SPAN RATING.
 - MINIMUM FLOOR SHEATHING: 23/32" APA STURD-I-FLOOR RATED 24 INCH O.C. TONGUE & GROOVE, GLUED AND NAILED
 - MINIMUM ROOF SHEATHING: 15/32" OSB OR CDX PLYWOOD, APA 32/16, NAILED
 - MINIMUM WALL SHEATHING: 7/16" OSB OR CDX PLYWOOD, APA 24/16, BLOCKED AND NAILED.
 - OPTIONAL WALL SHEATHING: ZIP SYSTEM RS SHEATHING OR EQUIVALENT, 7/16" APA LAMINATED TO 1" RIGID INSULATION NAILED WITH 10d SHANK NAIL (0.131"x3") AT 3" PANEL EDGES AND 12" IN FIELD OF PANEL, BLOCK AND NAIL ALL EDGES BETWEEN STUDS
- NAIL WALL SHEATHING WITH MINIMUM 80 COMMON OR 10d BOX AT 6" AT PANEL EDGES, AND 12" AT INTERMEDIATE FRAMING EXCEPT AS NOTED. BLOCK AND NAIL ALL EDGES BETWEEN STUDS.
- MINIMUM (3) 8D NAILS PER STUD. NAIL ALL PLATES USING EDGE NAIL SPACING INDICATED.
- SHEATHE ALL EXTERIOR WALLS. SHEATHE INTERIOR WALLS AS DESIGNATED ON THE DRAWINGS.
- SHEATHING SHALL BE CONTINUOUS FROM BOTTOM PLATE TO TOP PLATE. CUT IN "L" AND "T" SHAPES AROUND OPENINGS. LAP SHEATHING OVER SINGLE 2X PLATE MEMBER AT ROOF JOIST. AT RIM JOIST PROVIDE A MINIMUM OF 3" BETWEEN SHEATHING EDGE AND TOP/BOTTOM EDGE OF RIM.
- MINIMUM HEIGHT OF SHEATHING PANELS SHALL BE 16" TO ENSURE THAT PLATES ARE TIED TO STUDS.
- ALL SHEATHING SHEETS SHALL HAVE 1/8" GAP AT ALL EDGES AND JOINTS.
- FULLY NAIL FLOOR SHEATHING IMMEDIATELY AFTER GLUING (DO NOT SPOT NAIL).
- PROVIDE (1) PANEL SHEATHING CLIP AT ALL UNSUPPORTED ROOF SHEATHING PANEL EDGES. WHERE SPANS ARE GREATER THAN 32' PROVIDE (2) CLIPS.

ENGINEERED LUMBER:

- STRUCTURAL CAPACITIES OF STRUCTURAL COMPOSITE LUMBER SHALL BE IN CONFORMANCE WITH SECTION 2303.1.9 (2303.1.10 OF THE 2015 IBC) OF THE IBC.
- MANUFACTURER OF STRUCTURAL COMPOSITE LUMBER PRODUCTS SHALL HAVE PROPER CODE EVALUATION REPORTS FOR ALL PRODUCTS AND SHALL BE APPROVED BY THE STRUCTURAL ENGINEER.
- THE CONTRACTOR SHALL NOT CUT, NOTCH, OR OTHERWISE ALTER STRUCTURAL COMPOSITE LUMBER MEMBERS WITHOUT WRITTEN PERMISSION OF THE STRUCTURAL ENGINEER AND THE MANUFACTURER; HOWEVER, HOLES MAY BE CUT IN MEMBERS IN ACCORDANCE WITH THE MANUFACTURERS ALLOWABLE HOLE CHART.
- MEMBERS NOTED AS LVL (LAMINATED VENEER LUMBER) ON PLAN SHALL BE 1-3/4" WIDE X DEPTH INDICATED, PLANT-FABRICATED, AND HAVE THE FOLLOWING MINIMUM ALLOWABLE DESIGN VALUES:
 - F_y = 2600 PSI
 - F_x = 285 PSI
 - C_{F90R} = 2460 PSI
 - F_{90PERP} = 750 PSI
 - E = 1900 KSI
- MEMBERS NOTED AS PSL (PARALLEL STRAND LUMBER) ON PLAN SHALL BE PLANT-FABRICATED AND HAVE THE FOLLOWING MINIMUM ALLOWABLE DESIGN VALUES:
 - F_y = 2600 PSI
 - F_x = 290 PSI
 - C_{F90R} = 2900 PSI
 - F_{90PERP} = 750 PSI
 - E = 2000 KSI
- MEMBERS NOTED AS LSL (LAMINATED STRAND LUMBER) ON PLAN SHALL BE PLANT-FABRICATED AND HAVE THE FOLLOWING MINIMUM ALLOWABLE DESIGN VALUES:
 - F_y = 1700 PSI
 - F_x = 400 PSI
 - C_{F90R} = 1400 PSI
 - F_{90PERP} = 680 PSI
 - E = 1800 KSI
- BRIDGING AND BLOCKING SHALL BE INSTALLED ACCORDING TO THE FABRICATOR'S REQUIREMENTS.
- WOOD I-JOISTS SHALL HAVE THE DEPTH, SPACING, SPAN, AND LAYOUT SHOWN ON THE DRAWINGS. MEMBERS SHALL BE FACTORY MANUFACTURED WITH ORIENTED STRAND BOARD (OSB) WEBS, LAMINATED VENEER LUMBER (LVL) OR MACHINE STRESS RATED (MSR) LUMBER FLANGES PER CODE APPROVAL BY ICB OR NER. STRUCTURAL WOOD FLANGES AND WEBS SHALL BE DESIGNED FOR STRUCTURAL CAPACITIES AND DESIGN PROVISIONS ACCORDING TO ASTM D 5065. SUBSTITUTION OF EQUIVALENT SERIES BY OTHERS SHALL BE SUBMITTED TO THE STRUCTURAL ENGINEER FOR APPROVAL.
- JOISTS SHALL BE INSTALLED PER THE MANUFACTURER'S RECOMMENDATIONS. HOLES IN WEBS SHALL NOT EXCEED MANUFACTURER'S PUBLISHED LIMIT CRITERIA.
- OPEN WEB TRUSSES SHALL HAVE THE DEPTH, SPACING, SPAN, AND LAYOUT SHOWN ON THE DRAWINGS. MEMBERS SHALL BE FACTORY MANUFACTURED WITH ORIENTED STRAND BOARD (OSB) WEBS, AND LAMINATED VENEER LUMBER (LVL) OR MACHINE STRESS RATED (MSR) LUMBER CHORDS PER CODE APPROVAL BY ICB OR NER.
- OPEN WEB JOISTS SHALL BE DESIGNED BY A PROFESSIONAL ENGINEER REGISTERED IN THE STATE IN WHICH THE PROJECT IS LOCATED TO CARRY THE LOADS INDICATED ON THE STRUCTURAL DRAWINGS.
- MEMBER FORCES SHALL BE DETERMINED BY THE FABRICATOR. STRESSES SHALL NOT EXCEED THOSE ALLOWED BY THE IBC.
- DEFLECTION LIMITS FOR WOOD I-JOISTS AND OPEN WEB JOISTS SHALL NOT EXCEED THE FOLLOWING DEFLECTION CRITERIA:
 - ROOF LIVE LOAD = $L/360$
 - ROOF TOTAL LOAD = $L/240$ (1" MAXIMUM)
 - FLOOR LIVE LOAD = $L/480$
 - FLOOR TOTAL LOAD = $L/240$ (1" MAXIMUM)

LIGHT-METAL-PLATE-CONNECTED WOOD TRUSSES:

- TRUSS MANUFACTURER SHALL COMPLY WITH ALL REQUIREMENTS AS STATED IN SECTION 2303.4 OF THE IBC.
- ALL PRE-ENGINEERED GABLE END TRUSSES OR TRUSSES WITH INTEGRATED PARAPETS SHALL BE DESIGNED FOR WIND FORCES PERPENDICULAR TO THE TRUSS.
- ALL PRE-ENGINEERED TRUSSES SHALL BE FABRICATED SUCH THAT THEY INCORPORATE ALL ROOF PLANES. AT CONTRACTOR'S OPTION, STANDARD SHAPE TRUSSES MAY BE USED IN CONJUNCTION WITH OVERFRAMING.
- FULL HEIGHT BLOCKING SHALL BE PLACED BETWEEN TRUSSES AT ALL SUPPORTS.
- CROSS BRIDGING DESIGN SHALL BE PROVIDED BY TRUSS MANUFACTURER AS REQUIRED FOR LATERAL EFFECTS.
- TRUSS MEMBERS AND COMPONENTS SHALL NOT BE CUT, NOTCHED, DRILLED, SPLICED OR OTHERWISE ALTERED IN ANY WAY WITHOUT WRITTEN APPROVAL OF A REGISTERED DESIGN PROFESSIONAL.
- MANUFACTURE AND INSTALLATION OF METAL PLATED WOOD TRUSSES SHALL COMPLY WITH ANSITP1 1 "NATIONAL DESIGN STANDARD FOR METAL-PLATE-CONNECTED WOOD TRUSS CONSTRUCTION" BCSI (BUILDING COMPONENT SAFETY INFORMATION) "GUIDE TO GOOD PRACTICE FOR HANDLING."
- INSTALLING & BRACING OF METAL PLATE CONNECTED WOOD TRUSSES: "AND DSB-89 "RECOMMENDED DESIGN SPECIFICATION FOR TEMPORARY BRACING OF METAL PLATE CONNECTED WOOD TRUSSES"
- PRE-ENGINEERED, PREFABRICATED TRUSSES SHALL BE DESIGNED BY AN ENGINEER REGISTERED IN THE STATE IN WHICH TO PROJECT IS LOCATED TO CARRY THE LOADS INDICATED ON THE STRUCTURAL DRAWINGS IN WHICH THE PROJECT IS LOCATED.
- TRUSSES SHALL BE DESIGNED TO SUPPORT THE FULL DEAD LOADS AND THE SUPERIMPOSED DESIGN LOADS NOTED ABOVE OR ON THE DRAWINGS.
- STRESSES SHALL NOT EXCEED THOSE LISTED IN THE NATIONAL DESIGN SPECIFICATION FOR WOOD CONSTRUCTION (AFPA NDS). <NO INCREASES IN STRESS ARE ALLOWED FOR DURATION OF LOAD.>
- SCISSOR TYPE TRUSSES SHALL BE DESIGNED FOR A MAXIMUM OF 1/2" TOTAL HORIZONTAL DEFLECTION UNDER DEAD PLUS LIVE LOADS.
- THE FABRICATOR SHALL DETERMINE TRUSS WEB ARRANGEMENTS AND MEMBER FORCES.
- TRUSS TO TRUSS CONNECTIONS SPECIFIED SHALL BE BY TRUSS SUPPLIER, UNLESS SPECIFICALLY NOTED ON THE DRAWINGS.
- TRUSSES SHALL BE DESIGNED IN BEARING TO NOT EXCEED THE PERPENDICULAR TO GRAIN BEARING VALUES FOR THE TOP PLATE GRADES INDICATED IN THE "STRUCTURAL WOOD FRAMING" GENERAL NOTES. WHERE TRUSS BEARING EXCEED THIS VALUE THE TRUSS MANUFACTURER SHALL PROVIDE BEARING ENHANCERS TO COMPENSATE FOR OVERSTRESSES. TRUSS MANUFACTURER SHALL SPECIFY SIZE, SPECIES, AND NAILING FOR BEARING BLOCKS.
- TRUSS FABRICATOR SHALL SPECIFY ALL FLOOR AND ROOF TRUSS BRACING AND BRIDGING.
- CALCULATIONS AND SHOP DRAWINGS, INCLUDING MEMBER SIZES, LUMBER SPECIES AND GRADES, AND SUBSTANTIATING DATA FOR CONNECTOR CAPACITIES, SHALL BE SUBMITTED TO THE ARCHITECT, GC, AND STRUCTURAL ENGINEER FOR REVIEW PRIOR TO FABRICATION.
- TRUSS DESIGN SHALL INCLUDE A 250 LBS LOAD PER NFPA TO SUPPORT SPRINKLER LOADS LOCATED ANYWHERE ALONG THE BOTTOM CHORD OF THE TRUSS.
- DEFLECTION LIMITS FOR TRUSSES SHALL NOT EXCEED THE FOLLOWING DEFLECTION CRITERIA:
 - FLOOR LIVE LOAD = $L/480$
 - FLOOR TOTAL LOAD = $L/240$ (1" MAXIMUM)

STRUCTURAL ERECTION AND BRACING REQUIREMENTS:

- THE STRUCTURAL DRAWINGS ILLUSTRATE AND DESCRIBE THE COMPLETED STRUCTURE WITH ELEMENTS IN THEIR FINAL POSITIONS, PROPERLY SUPPORTED, CONNECTED, AND/OR BRACED.
- THE STRUCTURAL DRAWINGS ILLUSTRATE TYPICAL AND REPRESENTATIVE DETAILS TO ASSIST THE GENERAL CONTRACTOR. DETAILS SHOWN APPLY AT ALL SIMILAR CONDITIONS UNLESS OTHERWISE INDICATED. ALTHOUGH DUE DILIGENCE HAS BEEN APPLIED TO MAKE THE DRAWINGS AS COMPLETE AS POSSIBLE, NOT EVERY DETAIL IS ILLUSTRATED AND NOT EVERY EXCEPTIONAL CONDITION IS ADDRESSED.
- ALL PROPRIETARY CONNECTIONS AND ELEMENTS SHALL BE INSTALLED IN ACCORDANCE WITH THE MANUFACTURERS' RECOMMENDATIONS.
- ALL WORK SHALL BE ACCOMPLISHED IN A WORKMANLIKE MANNER AND IN ACCORDANCE WITH THE APPLICABLE CODES AND LOCAL ORDINANCES.
- THE GENERAL CONTRACTOR IS RESPONSIBLE FOR COORDINATION OF ALL WORK, INCLUDING LAYOUT AND DIMENSION VERIFICATION, MATERIALS COORDINATION, SHOP DRAWING REVIEW, AND THE WORK OF SUBCONTRACTORS. ANY DISCREPANCIES OR OMISSIONS DISCOVERED IN THE COURSE OF THE WORK SHALL BE IMMEDIATELY REPORTED TO THE ARCHITECT AND STRUCTURAL ENGINEER FOR RESOLUTION.
- CONTINUATION OF WORK WITHOUT NOTIFICATION OF DISCREPANCIES RELIEVES THE ARCHITECT AND STRUCTURAL ENGINEER FROM ALL CONSEQUENCES.
- UNLESS OTHERWISE SPECIFICALLY INDICATED, THE STRUCTURAL DRAWINGS DO NOT DESCRIBE METHODS OF CONSTRUCTION.
- THE GENERAL CONTRACTOR, IN THE PROPER SEQUENCE, SHALL PERFORM OR SUPERVISE ALL WORK NECESSARY TO ACHIEVE THE FINAL COMPLETED STRUCTURE, AND TO PROTECT THE STRUCTURE, WORKMEN, AND OTHERS DURING CONSTRUCTION. SUCH WORK SHALL INCLUDE, BUT NOT BE LIMITED TO TEMPORARY BRACING, SHORING FOR CONSTRUCTION EQUIPMENT, SHORING FOR EXCAVATION, FORMWORK, SCAFFOLDING, SAFETY DEVICES AND PROGRAMS OF ALL KINDS, SUPPORT AND BRACING FOR CRANES AND OTHER ERECTION EQUIPMENT.
- DO NOT BACKFILL AGAINST BASEMENT OR RETAINING WALLS UNTIL SUPPORTING SLABS AND FLOOR FRAMING ARE IN PLACE AND SECURELY ANCHORED. UNLESS ADEQUATE TEMPORARY BRACING IS PROVIDED.
- TEMPORARY BRACING SHALL REMAIN IN PLACE UNTIL ALL FLOORS, WALLS, ROOFS AND ANY OTHER SUPPORTING ELEMENTS ARE IN PLACE.
- THE ARCHITECT AND STRUCTURAL ENGINEER BEAR NO RESPONSIBILITY FOR THE ABOVE ITEMS, AND OBSERVATION VISITS TO THE SITE DO NOT IN ANY WAY INCLUDE INSPECTIONS OF THESE ITEMS.

PRECAUTIONARY NOTES ON STRUCTURAL BRACING:

- INTERIOR ARCHITECTURAL FINISH DETAILING MUST ACCOMMODATE THE RELATIVE DIFFERENTIAL MOVEMENTS OF SUPPORTING STRUCTURAL ELEMENTS.
- WHERE THE ROOF FRAMING ELEMENT SPANS ARE LONG, APPLIED LOADING WILL NATURALLY CAUSE SUBSTANTIAL DEFLECTION. INTERIOR ELEMENTS HUNG FROM THE ROOF STRUCTURE WILL DEFLECT WITH THE ROOF.
- EXTERIOR/PERIMETER WALL ASSEMBLIES HUNG FROM THE EDGE OF THE BUILDING STRUCTURE WILL BE DIRECTLY AFFECTED (TO SOME DEGREE) BY CHANGES IN EXTERNAL TEMPERATURE AND FLOOR DEFLECTION.
- EXTERIOR/PERIMETER AND INTERIOR ARCHITECTURAL FINISH DETAILS SHOULD ALLOW FOR RELATIVE MOVEMENTS BETWEEN ELEMENTS WITH DIFFERENT SUPPORT CONDITIONS.

LETTERS OF CONSTRUCTION COMPLIANCE:

- THE GENERAL CONTRACTOR SHALL DETERMINE FROM THE LOCAL BUILDING AUTHORITY, AT THE TIME THE BUILDING PERMIT IS OBTAINED, WHETHER ANY LETTERS OF CONSTRUCTION COMPLIANCE WILL BE REQUESTED FROM THE STRUCTURAL ENGINEER.
- THE CONTRACTOR SHALL NOTIFY THE STRUCTURAL ENGINEER OF ALL SUCH REQUIREMENTS IN WRITING PRIOR TO THE START OF CONSTRUCTION.
- TWO-DAY ADVANCE NOTICE SHALL BE GIVEN WHEN REQUESTING SITE VISITS NECESSARY AS THE BASIS FOR THE COMPLIANCE LETTER.
- THE GENERAL CONTRACTOR SHALL PROVIDE COPIES OF ALL THIRD-PARTY TESTING AND INSPECTION REPORTS TO THE ARCHITECT AND STRUCTURAL ENGINEER A MINIMUM OF ONE WEEK PRIOR TO THE DATE THAT THE COMPLIANCE LETTER IS NEEDED.

SPECIAL INSPECTIONS - 2012:

- THE FOLLOWING SPECIAL INSPECTIONS AND TESTING SHALL BE PERFORMED BY A QUALIFIED SPECIAL INSPECTOR, RETAINED BY THE OWNER, IN ACCORDANCE WITH THE FOLLOWING SECTIONS OF IBC CHAPTER 17:
 - SECTION 1704 SPECIAL INSPECTIONS, CONTRACTOR RESPONSIBILITY, AND STRUCTURAL OBSERVATIONS AND THE FOLLOWING SUB-SECTIONS:
 - 1704.2 SPECIAL INSPECTIONS
 - 1704.3 STATEMENT OF SPECIAL INSPECTIONS
 - SECTION 1705 REQUIRED VERIFICATION AND INSPECTION AND THE FOLLOWING SUB-SECTIONS:
 - 1705.1 SPECIAL CASES
 - 1705.2 STEEL CONSTRUCTION
 - 1705.3 CONCRETE CONSTRUCTION
 - 1705.5 WOOD CONSTRUCTION
 - 1705.6 SOILS
 - SECTION 1711 MATERIAL AND TEST STANDARDS
- THE SPECIAL INSPECTOR SHALL BE A QUALIFIED PERSON WHO SHALL DEMONSTRATE COMPETENCE, TO THE SATISFACTION OF THE BUILDING OFFICIAL, FOR INSPECTION OF THE PARTICULAR TYPE OF CONSTRUCTION OR OPERATION REQUIRING SPECIAL INSPECTION. THE APPROVED INSPECTOR MUST BE INDEPENDENT FROM THE CONTRACTOR RESPONSIBLE FOR THE WORK BEING INSPECTED.
- DUTIES AND RESPONSIBILITIES OF THE SPECIAL INSPECTOR SHALL BE TO INSPECT AND/OR TEST THE WORK OUTLINED ABOVE AND WITHIN THE STATEMENT OF SPECIAL INSPECTIONS IN ACCORDANCE WITH CHAPTER 17 OF THE IBC FOR CONFORMANCE WITH THE APPROVED CONSTRUCTION DOCUMENTS.
- ALL DISCREPANCIES SHALL BE BROUGHT TO THE IMMEDIATE ATTENTION OF THE CONTRACTOR FOR CORRECTION.
- PER SECTION 1704.2.4 THE SPECIAL INSPECTOR SHALL FURNISH REGULAR REPORTS TO THE BUILDING OFFICIAL AND THE STRUCTURAL ENGINEER. PROGRESS REPORTS FOR CONTINUOUS INSPECTION SHALL BE FURNISHED WEEKLY. INDIVIDUAL REPORTS OF PERIODIC INSPECTIONS SHALL BE FURNISHED WITHIN ONE WEEK OF INSPECTION DATES. THE REPORTS SHALL NOTE UNCORRECTED DEFICIENCIES, CORRECTION OF PREVIOUSLY REPORTED DEFICIENCIES, AND CHANGES TO THE APPROVED CONSTRUCTION DOCUMENTS AUTHORIZED BY THE STRUCTURAL ENGINEER OF RECORD.
- THE SPECIAL INSPECTOR SHALL SUBMIT A FINAL SIGNED REPORT WITHIN 10 DAYS OF THE FINAL SPECIAL INSPECTION STATING WHETHER THE WORK REQUIRING SPECIAL INSPECTION WAS, TO THE BEST OF THE INSPECTOR'S KNOWLEDGE, IN CONFORMANCE WITH THE APPROVED CONSTRUCTION DOCUMENTS AND THE APPLICABLE WORKMANSHIP PROVISIONS OF THE IBC. WORK NOT IN COMPLIANCE SHALL BE NOTED IN THE REPORT.
- THE CONTRACTOR SHALL SUBMIT A WRITTEN STATEMENT OF RESPONSIBILITY TO THE BUILDING OFFICIAL AND THE OWNER PRIOR TO THE COMMENCEMENT OF WORK ON A MAIN WIND- OR SEISMIC-FORCE-RESISTING SYSTEM PER SECTION 1704.4. THE STATEMENT SHALL ACKNOWLEDGE THE AWARENESS OF THE SPECIAL LISTED REQUIREMENTS OF DESIGNATED SEISMIC SYSTEM OR A WIND- OR SEISMIC-RESISTING COMPONENT IN THE STATEMENT OF SPECIAL INSPECTIONS PER SECTION 1705.
- EXCEPT AS NOTED, THE SPECIAL INSPECTIONS OUTLINED ABOVE ARE IN ADDITION TO, AND BEYOND THE SCOPE OF, PERIODIC STRUCTURAL OBSERVATIONS AS DEFINED IN SECTION 1704.5. STRUCTURAL OBSERVATIONS ARE INCLUDED IN THE STRUCTURAL ENGINEERING DESIGN AND CONSTRUCTION ADMINISTRATION SERVICES PROVIDED BY THE STRUCTURAL ENGINEER.

SHOP DRAWINGS:

- THE STRUCTURAL DRAWINGS ARE COPYRIGHTED AND SHALL NOT BE COPIED FOR USE AS ERECTION PLANS OR SHOP DETAILS. USE OF JVA'S ELECTRONIC FILES AS THE BASIS FOR SHOP DRAWINGS REQUIRES PRIOR APPROVAL BY JVA. A SIGNED RELEASE OF LIABILITY BY THE GENERAL CONTRACTOR AND/OR HIS SUBCONTRACTORS, AND DELETION OF JVA'S NAME AND LOGO FROM ALL SHEETS SO USED.
- THE GENERAL CONTRACTOR SHALL SUBMIT IN WRITING ANY REQUESTS TO MODIFY THE STRUCTURAL DRAWINGS OR PROJECT SPECIFICATIONS.
- ALL SHOP AND ERECTION DRAWINGS SHALL BE CHECKED AND STAMPED (AFTER HAVING BEEN CHECKED) BY THE GENERAL CONTRACTOR PRIOR TO SUBMISSION FOR STRUCTURAL ENGINEERS REVIEW. SHOP DRAWING SUBMITTALS NOT CHECKED BY THE GENERAL CONTRACTOR PRIOR TO SUBMISSION TO THE STRUCTURAL ENGINEER WILL BE RETURNED WITHOUT REVIEW.
- FURNISH ELECTRONIC VERSION (PDF) OF SHOP AND ERECTION DRAWINGS TO THE STRUCTURAL ENGINEER FOR REVIEW PRIOR TO FABRICATION FOR:
 - CONCRETE MIX DESIGNS
 - CONCRETE REINFORCING FOOT
 - PLANT FABRICATED WOOD JOISTS
 - PRE-ENGINEERED WOOD TRUSSES



| SYMBOLS KEY | | | |
|-------------|-----------------------------------|------------------------------|---|
| | DIRECTION OF DECK SPAN | | TOP OF CONCRETE OR MASONRY ELEVATION |
| | GRID DESIGNATION | [XXX'-X] | TOP OF BEAM ELEVATION |
| | REVISION | | JOIST BEARING ELEVATION |
| | SHEAR WALL | | BRICK LEDGE ELEVATION |
| | SHORING | (XXX'-X) | TOP OF FOOTING ELEVATION |
| | STEP IN FLOOR ELEVATION | XXX'-X | TOP OF FLOOR ELEVATION |
| | CMU (CONCRETE MASONRY UNIT) | | COLUMN CONTINUOUS FROM LEVEL BELOW |
| | BRICK | | COLUMN STARTING AT THIS LEVEL |
| | CIP CONCRETE | | COLUMN STOPPING BELOW THIS LEVEL, SEE FRAMING PLAN AT NEXT LOWER LEVEL |
| | EXISTING STONE | | COLUMN STARTING AND ENDING AT THIS LEVEL OF FRAMING |
| | EXISTING CONCRETE | | COLUMN CONNECTING A LOWER BEAM TO A HIGHER BEAM AT THIS LEVEL OF FRAMING |
| | EARTH | | TOP OF CONCRETE OR MASONRY ELEVATION |
| | ISOLATED SPREAD FOOTING MARK | | STEP TOP OF WALL |
| | SPREAD FOOTING MARK | | BRICK LEDGE ELEVATION |
| | STEP IN BOTTOM OF WALL/GRADE BEAM | (XXX'-X) | TOP OF FOOTING ELEVATION |
| | ROOF SLOPE | XXX'-X | TOP OF FLOOR ELEVATION |
| | DIRECTION OF SLOPE (DOWN) | | |
| | STAIR OR RAMP DIRECTION | | |
| | | BUILDING COLUMN DESIGNATIONS | |
| | | | WOOD BEARING WALL |
| | | | WOOD SHEAR WALL |
| | | | COLUMN ABOVE |
| | | | COLUMN OR OTHER ELEMENT BELOW SEE SCHEDULES & NOTES |
| | | | Cx = COLUMN Bpx = BASE PLATE EPx = EMBEDDED PLATE ABx = ANCHOR BOLT HDx = HOLDOWN |
| | | | COLUMN CONTINUOUS FROM LEVEL BELOW |
| | | | "X" NUMBER OF KING STUDS BELOW "Y" NUMBER OF TRIMMER STUDS BELOW |
| | | | "X" NUMBER OF BUILT-UP 2x6 STUDS IN COLUMN BELOW |
| | | | "X" NUMBER OF BUILT-UP 2x4 STUDS IN COLUMN BELOW |
| | | | HOLDOWN |
| | | | WOOD HEADER |
| | | | WOOD JOIST OR BEAM SUPPORTED BY METAL HANGER |
| | | | WOOD JOIST CONTINUOUS OVER INTERMEDIATE SUPPORT |
| | | | WOOD JOIST BEARING ON TOP OF SUPPORT |



Copyright VERTICAL ARTS, INC.
All Rights Reserved

This document, and the ideas and designs incorporated herein, as an instrument of professional service, is the property of Vertical Arts Inc. and is not to be used, in whole or in part for any other project without the written authorization from a principal of Vertical Arts, Inc.

[illegible]

SHEET NO.

S0.1

10/15/2019 11:14:45 AM



Copyright VERTICAL ARTS, INC.
All Rights Reserved

This document, and the ideas and designs incorporated herein, as an instrument of professional service, is the property of Vertical Arts Inc. and is not to be used, in whole or in part, for any other project without the written authorization from a principal of Vertical Arts, Inc.



DRAWING TITLE

FOUNDATION PLAN

S2.1

| FOOTING SCHEDULE | | | | |
|------------------|-------|--------|-----------|----------------------------------|
| MARK | WIDTH | LENGTH | THICKNESS | REINFORCING |
| F2.0 | 2'-0" | 2'-0" | 1'-0" | (3) #5 EACH WAY, BOTTOM |
| F2.5 | 2'-6" | 2'-6" | 1'-0" | (3) #5 EACH WAY, BOTTOM |
| F3.0 | 3'-0" | 3'-0" | 1'-0" | (4) #5 EACH WAY, BOTTOM |
| F4.0 | 4'-0" | 4'-0" | 1'-0" | (5) #5 EACH WAY, BOTTOM |
| F4.5 | 4'-6" | 4'-6" | 1'-0" | (5) #5 EACH WAY, BOTTOM |
| F6.0 | 6'-0" | 6'-0" | 1'-2" | (7) #5 EACH WAY, BOTTOM |
| F24 | 2'-0" | CON'T | 1'-0" | (3) #5 CONT. #5 @ 16" TRANSVERSE |
| F30 | 2'-6" | CON'T | 1'-0" | (3) #5 CONT. #5 @ 16" TRANSVERSE |
| F36 | 3'-0" | CON'T | 1'-0" | (4) #5 CONT. #5 @ 16" TRANSVERSE |

The diagram shows a square cross-section of an HSS column. The wall thickness is labeled as 'HSS COLUMN WALL THICKNESS IN 16ths OF AN INCH (EXAMPLE: '5' INDICATES '5/16" WALL THICKNESS, '10' INDICATES '5/8", ETC...)'. The corner radii are labeled as 'CXX OR CXXX'.



- USGS ELEVATION 7059.50' = 100'-0" ARCH, TOP OF MAIN LEVEL INTERIOR FLOOR
- LOCATION OF STEP BOTTOM OF WALL PER 13/S5.0 NOTED THUS: FS
- INTERIOR AND PERIMETER STEEL COLUMNS BEAR ON FOOTINGS, PEDESTALS, OR PILASTERS NOTED ON PLAN

CAMPBELL RESIDENCE
Lot 5 - Eagle's Vista
Steamboat Springs, CO 80487
1907

| ISSUE NAME | DATE |
|-----------------|------------|
| BUILDING PERMIT | 08/23/2019 |
| VE REVISIONS | 10/15/2019 |


DRAWING TITLE

LOWER LEVEL
FRAMING PLAN

SHEET NO.

S2.2

10/15/2019 11:14:53 AM

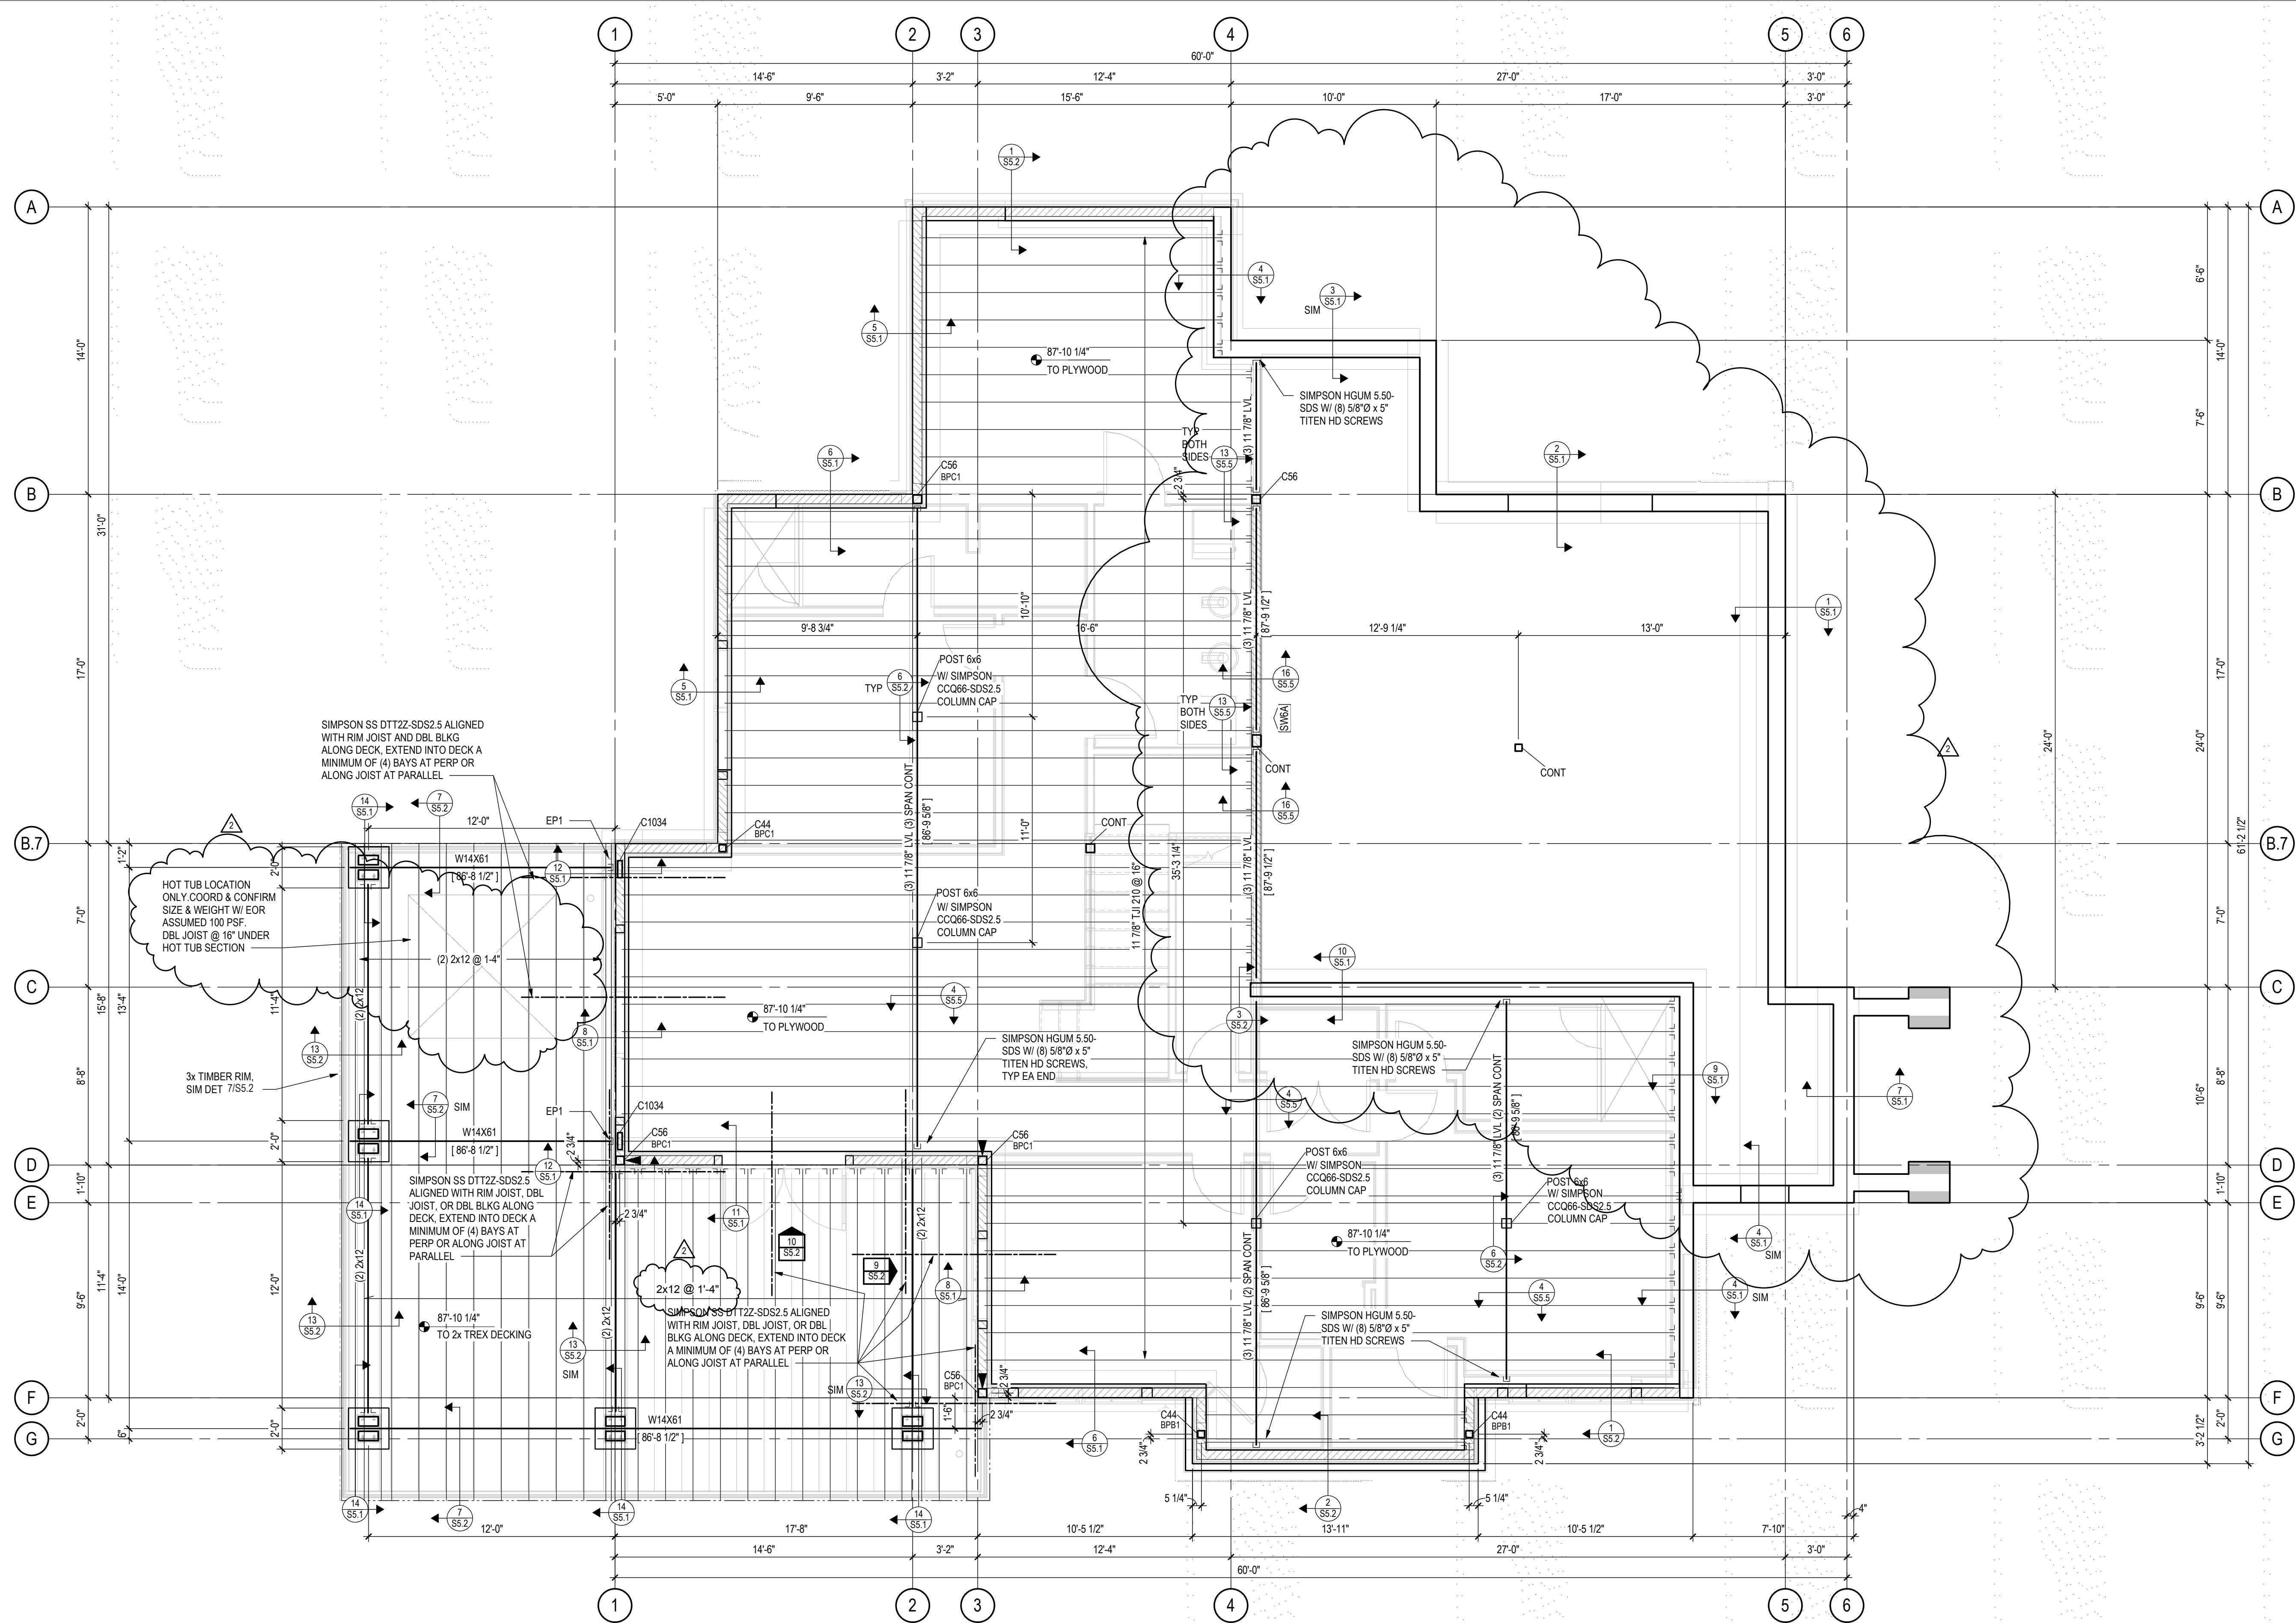

HOLDOWNS:
• HOLDOWNS ARE INDICATED ON PLAN THUS: HDX
• HOLDOWNS INDICATED ARE LOCATED AT THE FLOOR LEVEL
• SEE HOLDOWN SCHEDULE ON SHEET S5.3


TYPICAL WOOD FRAMED WALLS & WALL SHEATHING:
• ALL EXTERIOR WALLS HATCHED THUS: ARE 2x6 @ 16" STUD SHEAR WALLS SHEATHED WITH ZIP SYSTEM R-6 SHEATHING OR EQUIVALENT (7/16" APA LAMINATED TO 1" RIGID INSULATION) NAILED WITH 10d SHANK (0.131" x 3") @ 3" AT PANEL EDGES AND 12" IN FIELD OF PANEL; BLOCK AND NAIL ALL EDGES BETWEEN STUDS
• ALL INTERIOR WALLS HATCHED THUS: ARE 2x6 @ 16" STUD SHEAR WALLS SHEATHED WITH 1532" APA NAILED WITH 8d COM (0.131" x 2 1/2") @ 6" AT PANEL EDGES AND 12" IN FIELD OF PANEL; BLOCK AND NAIL ALL EDGES BETWEEN STUDS; EXPOSED SURFACE TO BE NAILED CAREFULLY FOR FINISHED APPEARANCE
• ALL INTERIOR WALLS HATCHED THUS: W4 ARE 2x4 @ 16" STUD BEARING WALLS
• ALL INTERIOR WALLS HATCHED THUS: W6 ARE 2x6 @ 16" STUD BEARING WALLS

TYPICAL FLOOR SHEATHING:
3/4" STURD-I-FLOOR, APA RATED 24" O.C. TONGUE & GROOVE SHEATHING GLUED AND NAILED WITH 8d NAILS (0.113" x 2 3/8") @ 6" ALONG PANEL EDGES AND @ 12" ALONG INTERMEDIATE FRAMING MEMBERS; LAY PANELS PERPENDICULAR TO FRAMING MEMBERS AND STAGGER PANEL JOINTS.



LOWER LEVEL FRAMING PLAN

1/4" = 1'-0"

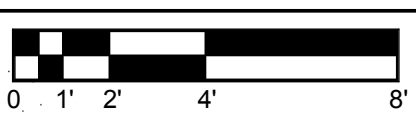

- USGS ELEVATION 7059.50' = 100'-0" DRAWING ELEVATION
- TOP OF FLOOR SHEATHING = 87'-10 1/4" UNLESS NOTED THUS:
- ALL BEAMS ARE FLUSH, UNLESS NOTED OTHERWISE ON PLAN
- ALL HEADERS ARE FLUSH, UNLESS NOTED OTHERWISE ON PLAN
- ALL COLUMNS ARE BELOW
- ALL EXTERIOR HEADERS ARE (3) 2x10 HEADERS UNLESS NOTED OTHERWISE ON PLAN
- ALL INTERIOR HEADERS ARE (3) 2x8 UNLESS NOTED OTHERWISE ON PLAN

CAMPBELL RESIDENCE
Lot 5 - Eagle's Vista
Steamboat Springs, CO 80487
1907

| ISSUE NAME | DATE |
|-----------------|------------|
| BUILDING PERMIT | 08/23/2019 |
| VE REVISIONS | 10/15/2019 |


DRAWING TITLE

MAIN LEVEL FLOOR
FRAMING PLAN

SHEET NO.

S2.3

10/15/2019 11:23:14 AM

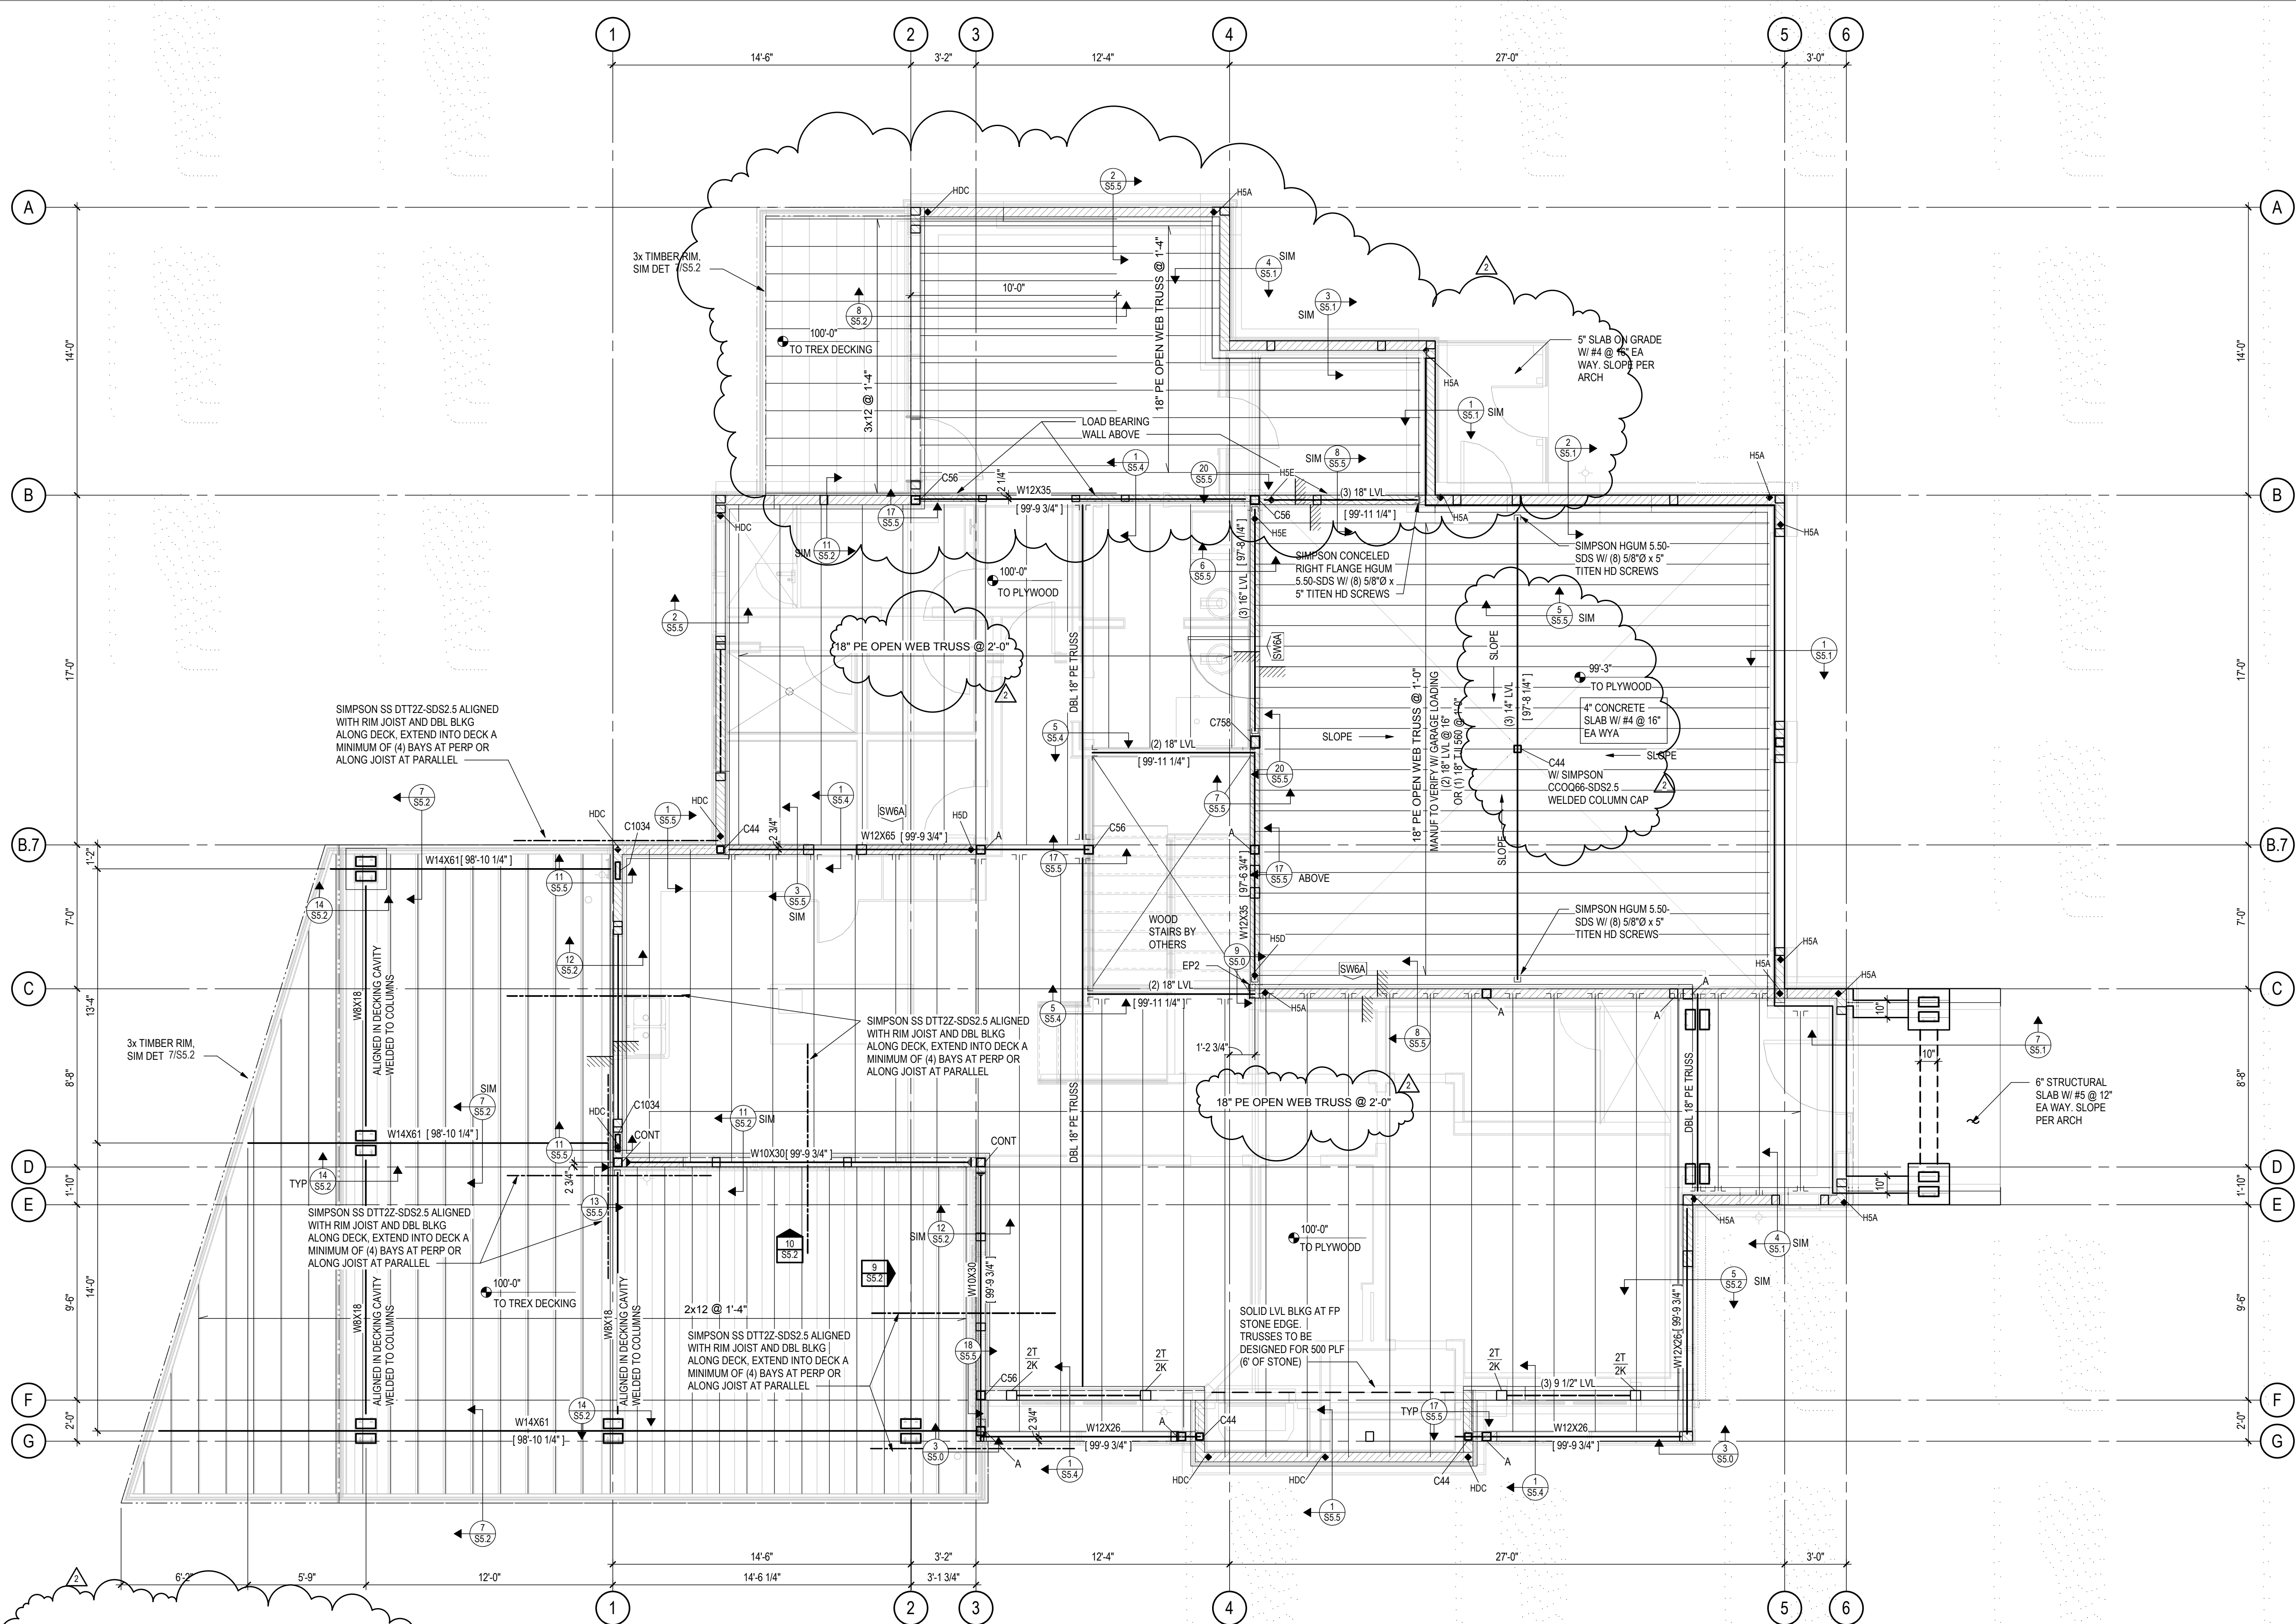

FLOOR TRUSS SUPPLIER NOTE:
DESIGN ALL FLOOR TRUSSES TO CLEAR SPAN TO
BEARING WALLS/ BEAMS INDICATED ON PLAN.
DESIGN LOADS ARE AS FOLLOWS:
DEAD LOAD BOTTOM CHORD = 10 PSF
DEAD LOAD TOP CHORD = 15 PSF
LIVE LOAD TOP CHORD = 40 PSF
GARAGE DEAD LOAD TOP CHORD = 65 PSF
GARAGE LIVE LOAD TOP CHORD = 40 PSF
GARAGE LIVE LOAD POINT LOAD = 3000 LB
LIMIT DEFLECTION TO:
SPAN/480 FOR LIVE LOAD
SPAN/360 (LIMIT TO 1\"/>

ALL TRUSS-TO-TRUSS CONNECTIONS TO BE DESIGNED AND SUPPLIED BY TRUSS
MANUFACTURER. SEE DET SHIT S5.4 FOR REFERENCE. TRUSS FABRICATOR SHALL
SUBMIT SHOP DRAWINGS AND CALCULATIONS STAMPED BY A COLORADO
REGISTERED ENGINEER TO ARCHITECT FOR REVIEW BEFORE FABRICATION.
DO NOT ALTER TRUSS LAYOUT. BEARING DESIGN SHALL ASSUME HEM FIR WALL
TOP PLATES (405 psf). USE MULTIPLE PILES, BEARING BLOCKS, OR BEARING
ENHANCERS TO ACCOMMODATE 5-12\"/>


HOLD-DOWNS:
• HOLD-DOWNS ARE INDICATED ON PLAN THUS:
• HOLD-DOWNS INDICATED ARE LOCATED AT THE FLOOR LEVEL
• SEE HOLD-DOWN SCHEDULE ON SHEET S5.3

TYPICAL WOOD FRAMED WALLS & WALL SHEATHING:
ALL EXTERIOR WALLS HATCHED THUS: ARE [SW6] 2x6 @ 16\"/>

TYPICAL FLOOR SHEATHING:
3/4\"/>

TYPICAL HEADERS AND TRIM / KING STUDS:
• PROVIDE (3) 2x10 HEADERS WITH (2) KING STUDS (2K) AND (1)
TRIM STUD (1T) AT ALL WOOD OPENINGS, TYP UNO
• AT OPENINGS EQUAL TO OR SMALLER THAN 3'-0\"/>

XX K INDICATES NUMBER OF 2x KING STUDS T INDICATES
NUMBER OF 2x TRIM STUDS (EQUAL TO WALL STUD WIDTH)
XX INDICATES NUMBER OF 2x6 STUDS IN A STUDPACK
XX INDICATES NUMBER OF 2x8 STUDS IN A STUDPACK

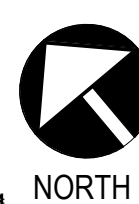

MAIN LEVEL FLOOR FRAMING PLAN

1/4" = 1'-0"
0 1' 2' 4' 8'

- USGS ELEVATION 7059.50' = 100'-0" DRAWING ELEVATION
- TOP OF FLOOR SHEATHING = 100'-0" UNLESS NOTED THUS: XXX'-X"
- ALL BEAMS ARE FLUSH, UNLESS NOTED OTHERWISE ON PLAN
- ALL HEADERS ARE FLUSH, UNLESS NOTED OTHERWISE ON PLAN
- ALL COLUMNS ARE BELOW
- ALL EXTERIOR HEADERS ARE (3) 2x10 HEADERS UNLESS NOTED OTHERWISE ON PLAN
- ALL INTERIOR HEADERS ARE (3) 2x8 UNLESS NOTED OTHERWISE ON PLAN

CAMPBELL RESIDENCE
Lot 5 - Eagle's Vista
Steamboat Springs, CO 80487
1907


| ISSUE NAME | DATE |
|-----------------|------------|
| BUILDING PERMIT | 08/23/2019 |
| VE REVISIONS | 10/15/2019 |

DRAWING TITLE
LOW ROOF FRAMING PLAN

SHEET NO.

S2.4

10/15/2019 11:30:56 AM

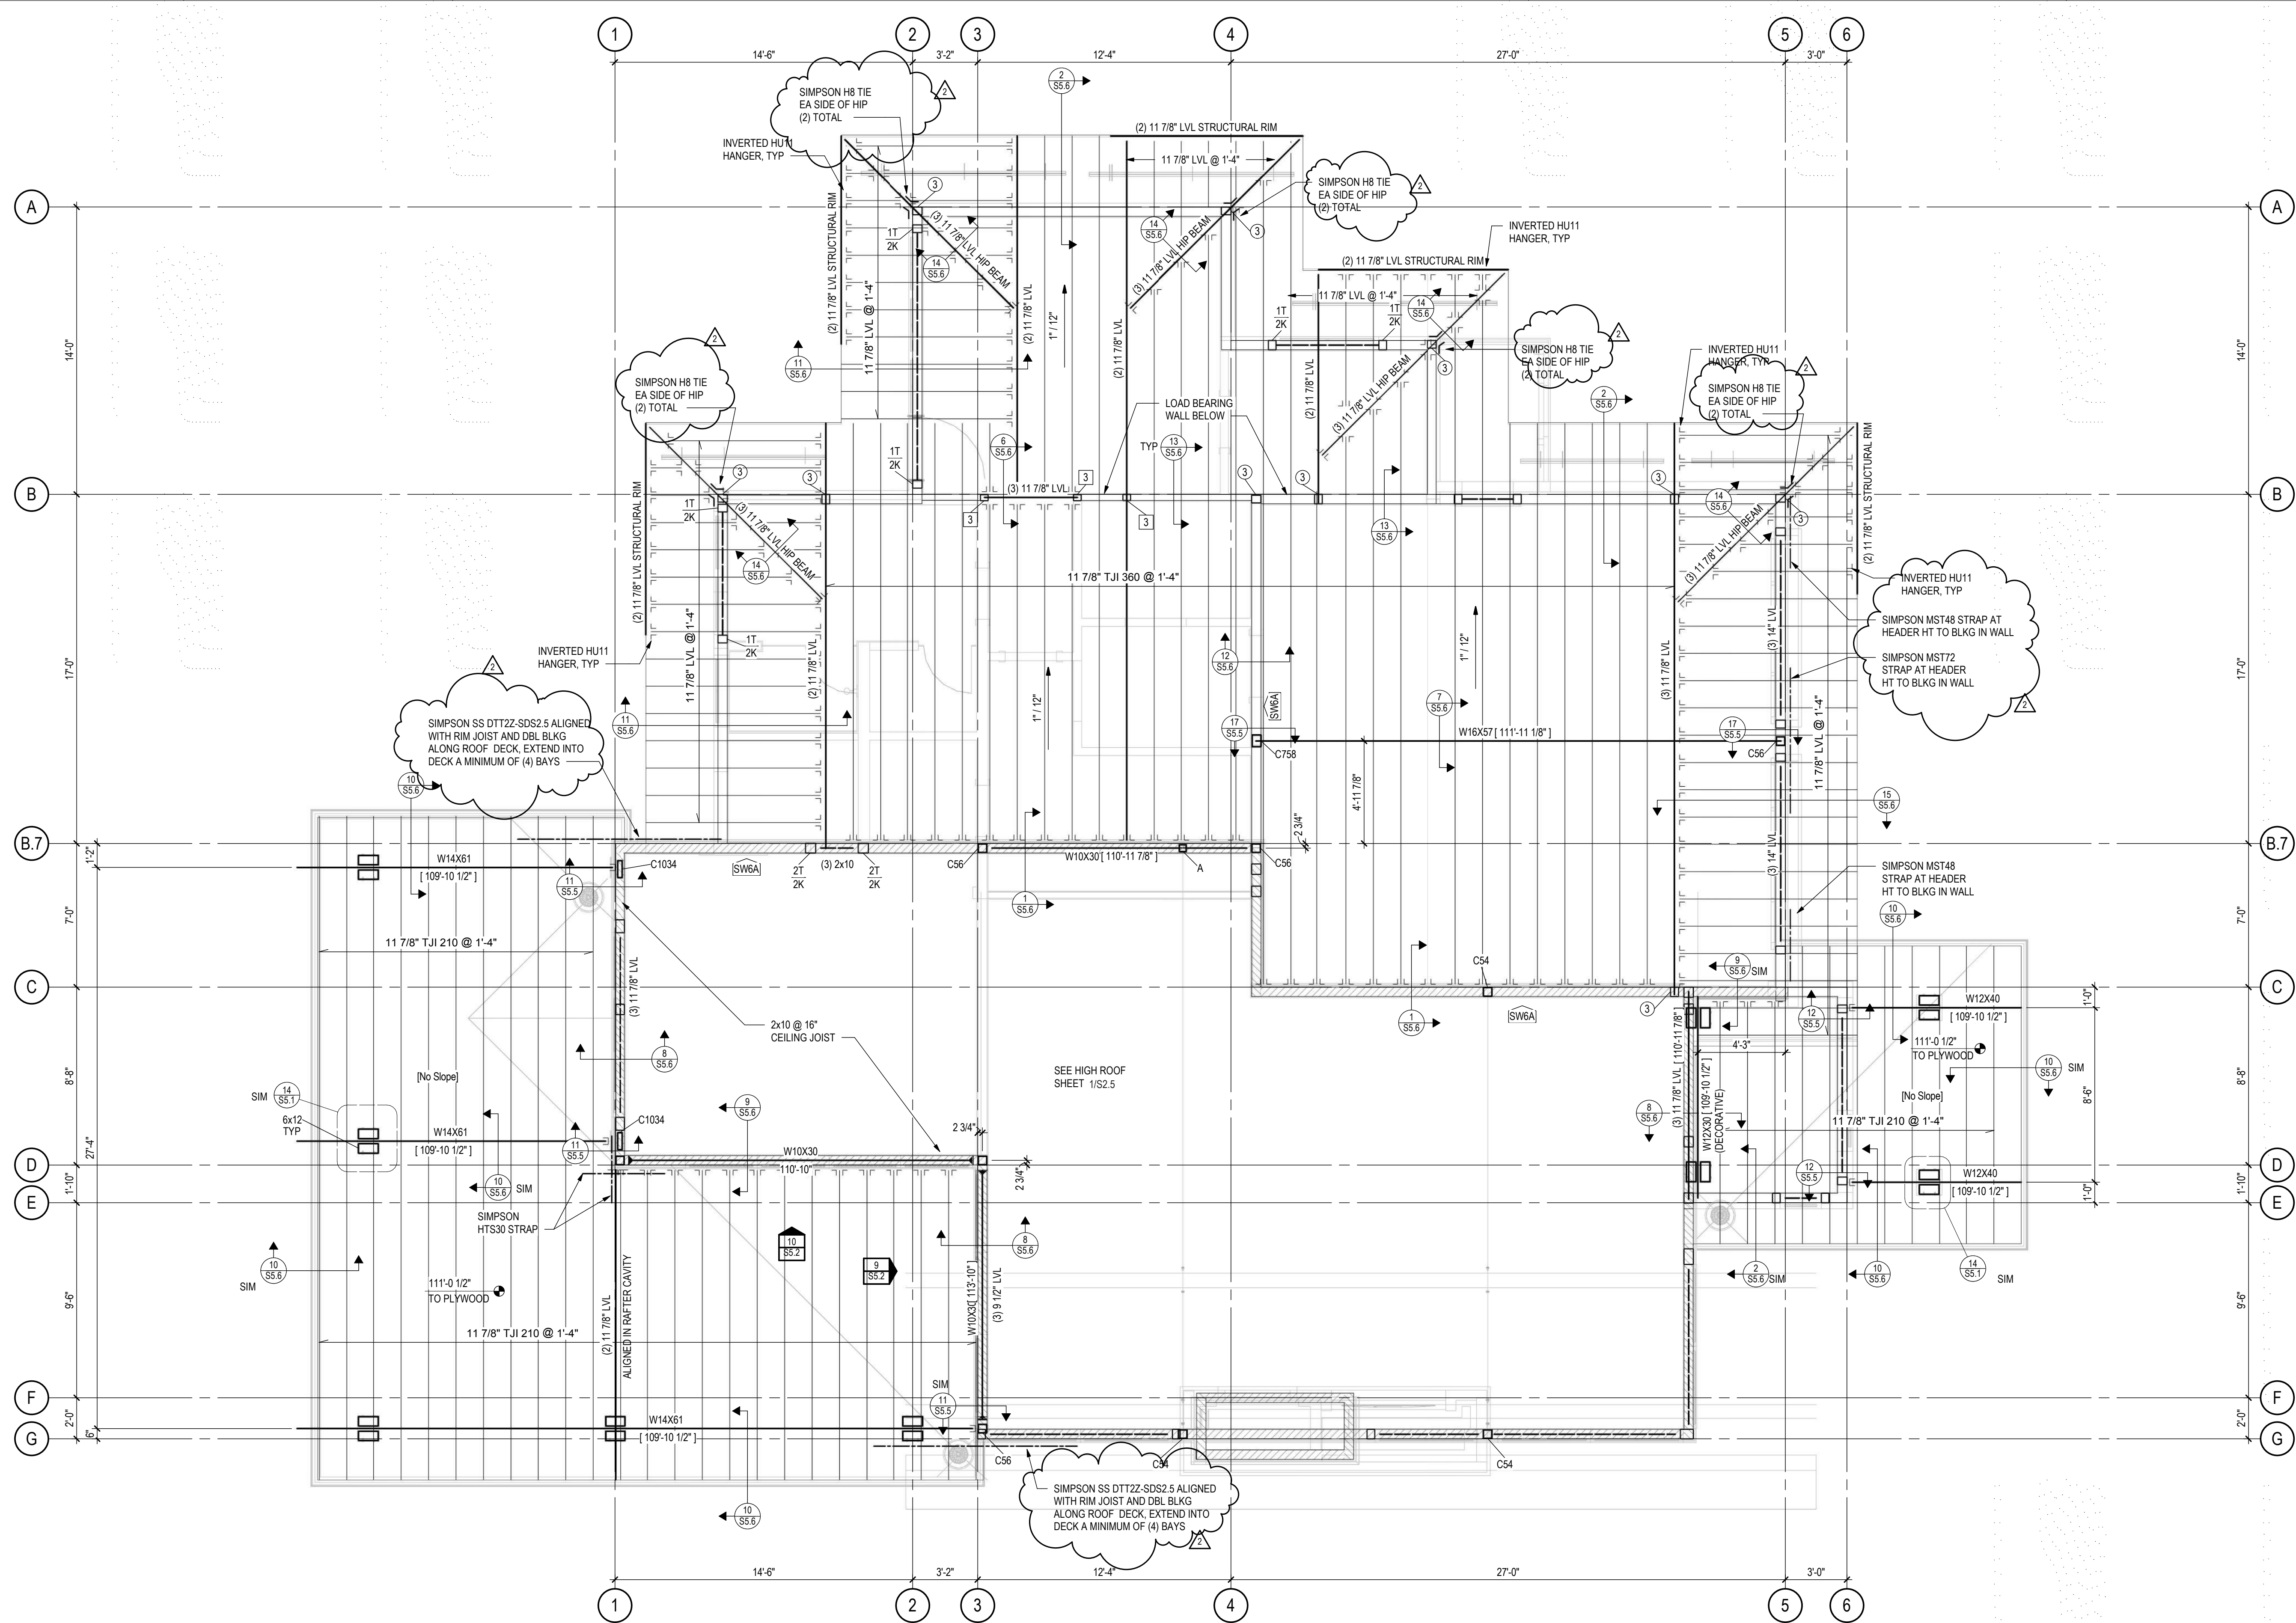


TYPICAL HEADERS AND TRIM / KING STUDS:
• PROVIDE (3) 2x10 HEADERS WITH (2) KING STUDS (2K) AND (1) TRIM STUD (1T) AT ALL WOOD OPENINGS, TYP UNO
• AT OPENINGS EQUAL TO OR SMALLER THAN 3'-0", (1) KING STUD (1K) AND (1) TRIM STUD (1T) MAY BE USED

KX K INDICATES NUMBER OF 2x KING STUDS T INDICATES NUMBER OF 2x TRIM STUDS (EQUAL TO WALL STUD WIDTH)
XX INDICATES NUMBER OF 2x6 STUDS IN A STUDPACK
XX INDICATES NUMBER OF 2x8 STUDS IN A STUDPACK

HOLD-DOWNS:
• HOLD-DOWNS ARE INDICATED ON PLAN THUS: HDX
• HOLD-DOWNS INDICATED ARE LOCATED AT THE FLOOR LEVEL
• SEE HOLD-DOWN SCHEDULE ON SHEET S5.3

TYPICAL WOOD FRAMED WALLS & WALL SHEATHING:
• ALL EXTERIOR WALLS HATCHED THUS: [SW6] 2x6 @ 16" STUD SHEAR WALLS SHEATHED WITH ZIP SYSTEM R-6 SHEATHING OR EQUIVALENT (7/16" APA LAMINATED TO 1" RIGID INSULATION) NAILED WITH 10d SHANK (0.131"x3") @ 3" AT PANEL EDGES AND 12" IN FIELD OF PANEL; BLOCK AND NAIL ALL EDGES BETWEEN STUDS
• ALL INTERIOR WALLS HATCHED THUS: [SW6] 2x6 @ 16" STUD SHEAR WALLS SHEATHED WITH 15/32" APA NAILED WITH 8d COM (0.131"x2 1/2") @ 6" AT PANEL EDGES AND 12" IN FIELD OF PANEL; BLOCK AND NAIL ALL EDGES BETWEEN STUDS; EXPOSED SURFACE TO BE NAILED CAREFULLY FOR FINISHED APPEARANCE
• ALL INTERIOR WALLS HATCHED THUS: [W4] ARE 2x4 @ 16" STUD BEARING WALLS [W6] ARE 2x6 @ 16" STUD BEARING WALLS

TYPICAL ROOF SHEATHING:
13/32" APA 4020 RATED TONGUE & GROOVE SHEATHING FASTENED WITH 8d NAILS (0.113"x3 x 2 3/8") @ 6" ALONG PANEL EDGES AND @ 12" ALONG INTERMEDIATE FRAMING MEMBERS. LAY PANELS PERPENDICULAR TO FRAMING MEMBERS AND STAGGER PANEL JOINTS.

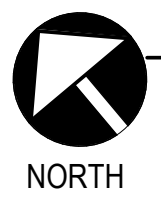

LOW ROOF FRAMING PLAN

1/4" = 1'-0"

- USGS ELEVATION 7059.50' = 100'-0" DRAWING ELEVATION
- ALL BEAMS ARE FLUSH, UNLESS NOTED OTHERWISE ON PLAN
- ALL HEADERS ARE DROPPED, UNLESS NOTED OTHERWISE ON PLAN
- ALL COLUMNS ARE BELOW
- ALL EXTERIOR HEADERS ARE (3) 2x10 HEADERS UNLESS NOTED OTHERWISE ON PLAN
- ALL INTERIOR HEADERS ARE (3) 2x10 UNLESS NOTED OTHERWISE ON PLAN



**Copyright VERTICAL ARTS, INC.
All Rights Reserved**

This document, and the ideas and designs incorporated herein, as an instrument of professional service, is the property of Vertical Arts Inc. and is not to be used, in whole or in part, for any other project without the written authorization from a principal of Vertical Arts, Inc.



DRAWING TITLE

.....

.....

HIGH ROOF FRAMING
PLAN

S2.5

10/15/2019 11:30:58 AM


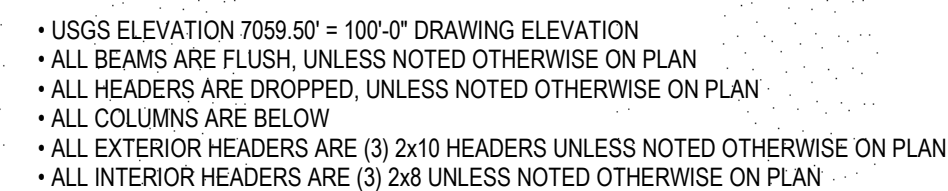




Diagram illustrating the plan and details of anchors. The diagram shows a cross-section of a concrete slab with two U-shaped anchors. Key labels include:

- TOP OF CONC
- EDGE OF CONC AS OCCURS
- ANCHORS PLAN & DETAILS
- Dimensions E and S are indicated.

1. INSTALL ADHESIVE ANCHORS PER MANUFACTURER'S INFORMATION AND ICC REPORT.
2. CONTRACTOR TO VERIFY MINIMUM EDGE DISTANCES, SPACING AND THICKNESS ARE IN ACCORDANCE WITH SCHEDULE PRIOR TO INSTALLING ANCHORS.
3. HOLES ARE TO BE DRILLED WITH ROTARY DRILL ONLY. WHEN DRILLING HOLES IN EXISTING CONCRETE, USE CARE AND CAUTION TO AVOID CAUSING OR DAMAGING THE EXISTING REINFORCING BARS.
4. MAINTAIN A REASONABLE CLEARANCE BETWEEN REINFORCEMENT AND THE DRILLED-IN ANCHOR. FILL ABANDONED HOLES WITH HIGH STRENGTH GROUT.
5. SPECIAL INSPECTION IS REQUIRED PER IRC SECTION 1705 AND THE REQUIREMENTS OF THE ICC REPORTS. THE SPECIAL INSPECTOR MUST BE ON THE JOB SITE PERIODICALLY DURING ANCHOR INSTALLATION TO VERIFY ANCHOR TYPE, ANCHOR DIMENSIONS, HOLE CLEANLINESS, EMBEDMENT DEPTH, CONCRETE TYPE, CONCRETE COMPRESSIVE STRENGTH, DRILL BIT ADHESION, HOLE DEPTH, EDGE DISTANCE(S), ANCHOR SPACING(S), CONCRETE THICKNESS, AND ADHESIVE INJECTION.

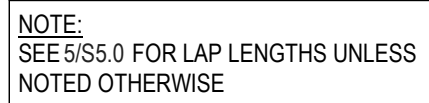

| EMBEDDED PLATE SCHEDULE | | | | | | | | |
|-------------------------|--------|-------|-----------|---------------------|----------|--------|--------|-----|
| MARK | PLATE | | | HEADED ANCHOR STUDS | | | | |
| | LENGTH | WIDTH | THICKNESS | NUMBER | DIAMETER | LENGTH | COLUMN | ROW |
| EP1 | 12" | 8" | 5/8" | 4 | 1/2" Ø | 6" | 4" | 8" |
| EP2 | 18" | 8" | 5/8" | 6 | 1/2" Ø | 6" | 4" | 8" |

* ALL EMBEDDED PLATES SHALL BE PLACED WITH EXPOSED FACE FLUSH TO EXPOSED FACE OF CONCRETE WALL.


7 ADHESIVE ANCHORS

LAP SCHEDULE

FOOTING NOTES:

- CENTER FOOTINGS UNDER STEMWALLS, PILASTERS, & COLUMNS, TYPICAL UNLESS NOTED OTHERWISE
- FOOTING WIDTHS SHALL NOT VARY IN THE FIELD FROM SIZE NOTED; OVERSIZE FOOTINGS ARE NOT ALLOWED
- LAPPED BOARD FORMING NOT ALLOWED
- TRENCH FORMING NOT ALLOWED


1 S5.0 FOOTING SCHEDULE --- 3/4" = 1'-0"

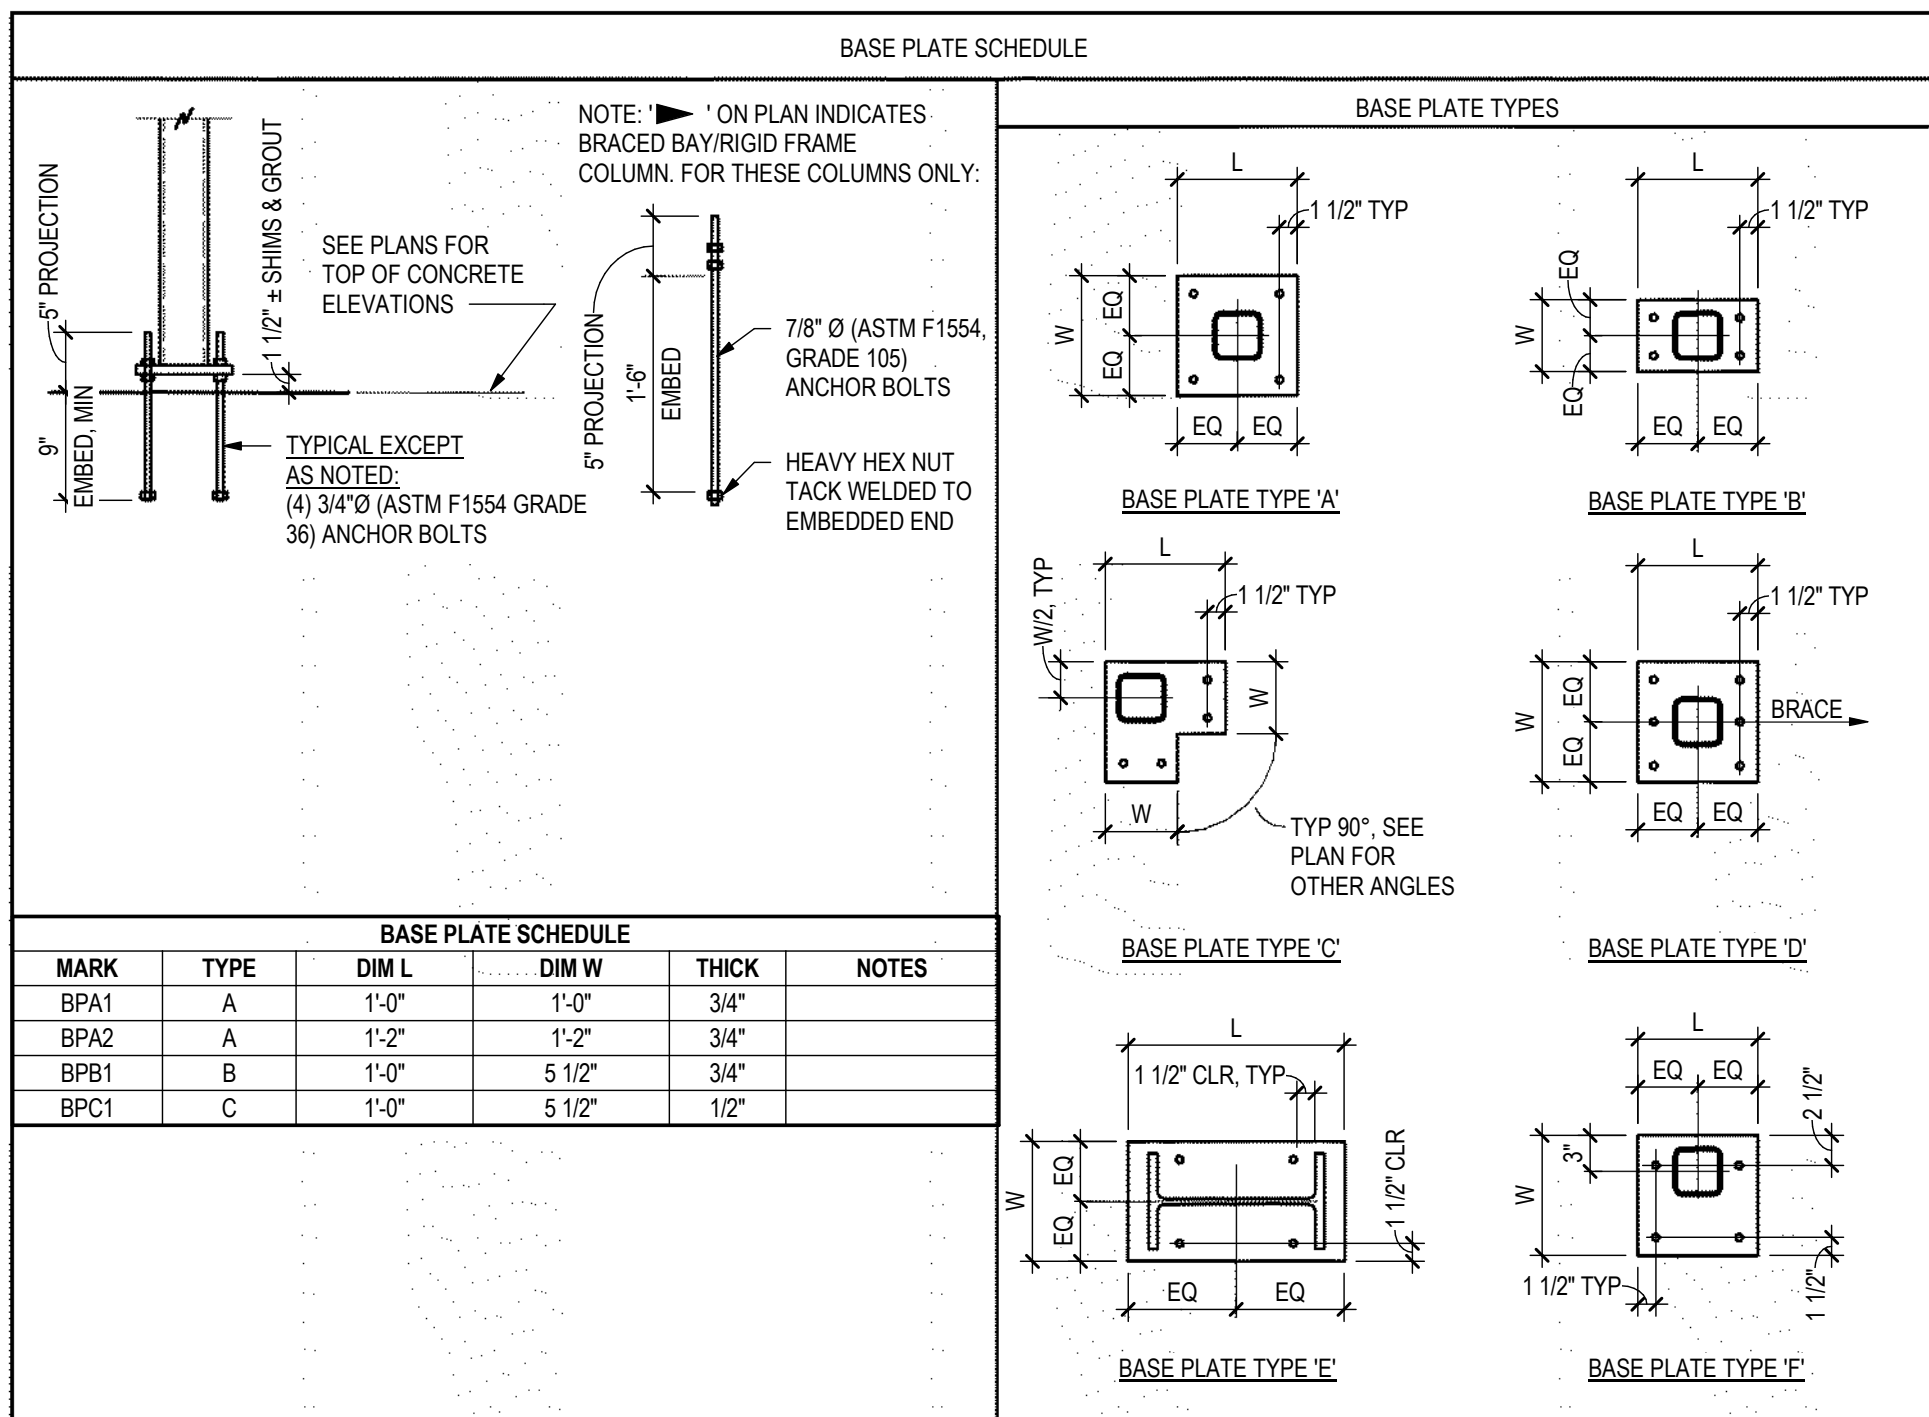

2 TYPICAL COLUMN BASE DETAILS

S5.0 3/4" = 1'-0"

9 SCHEDULE

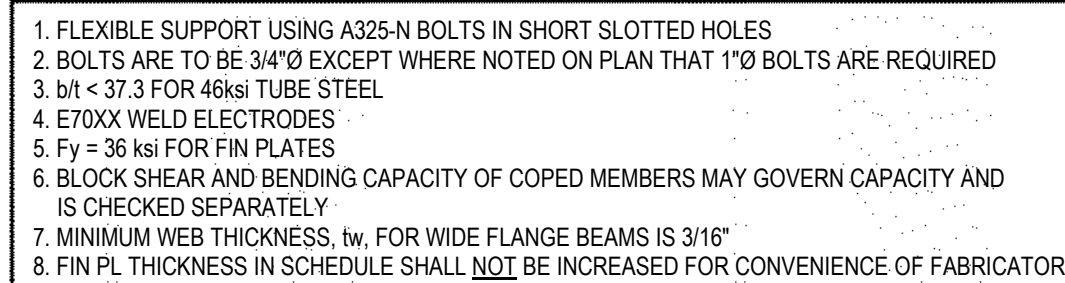

3 SCHEDULE 30
S5.0 3/4" = 1'-0"

10 TRIM REINFORCING DETAIL
S5.0 3/4" = 1'-0"


1. INSTALL SCREW ANCHORS PER MANUFACTURER'S INFORMATION AND ICC REPORT INSTRUCTIONS. SPECIAL INSPECTION IS REQUIRED PER SECTION 1705 OF THE IBC AND THE REQUIREMENTS OF THE ICC REPORTS. INSTALLED ANCHORS SHALL BRING CONNECTED PILES INTO FIRM CONTACT, MEETING THE INSTALL TORQUE BUT NOT EXCEEDING THE MAXIMUM INSTALL TORQUE.
2. CONTRACTOR TO VERIFY MINIMUM EDGE DISTANCES, SPACING AND THICKNESS ARE IN ACCORDANCE WITH SCHEDULE PRIOR TO INSTALLING ANCHOR.
3. HOLES TO BE DRILLED WITH ROTARY DRILL ONLY. WHEN INSTALLING DRILLED-IN ANCHORS IN EXISTING REINFORCED CONCRETE, USE CARE AND CAUTION TO AVOID CUTTING OR DAMAGING THE EXISTING REINFORCING BARS. MAINTAIN A REASONABLE CLEARANCE BETWEEN REINFORCEMENT AND THE DRILLED-IN ANCHOR. FILL ABANDONED HOLES WITH HIGH STRENGTH GROUT.
4. THE SPECIAL INSPECTOR MUST BE ON THE JOBSITE PERIODICALLY DURING ANCHOR INSTALLATION TO VERIFY ANCHOR TYPE, ANCHOR DIMENSIONS, HOLE CLEANLINESS, EMBEDMENT DEPTH, CONCRETE TYPE, CONCRETE COMPRESSIVE STRENGTH, DRILL BIT DIAMETER, HOLE DEPTH, EDGE DISTANCE(S), ANCHOR SPACING(S), CONCRETE THICKNESS, AND TIGHTENING TORQUE.

4 SCREW ANCHOR DETAIL

S5.0 3/4" = 1'-0"



This document, and the ideas and designs incorporated herein, as an instrument of professional service, is the property of Vertical Arts Inc. and is not to be used, in whole or in part, for any other project without the written authorization from a principal of Vertical Arts, Inc.

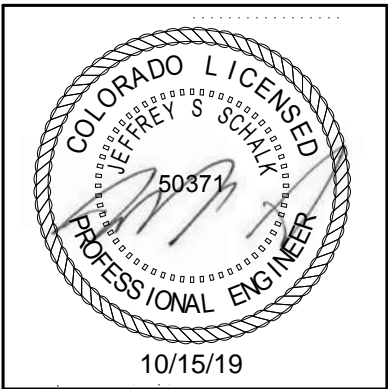

CAMPBELL RESIDENCE
Lot 5 - Eagle's Vista
Steamboat Springs, CO 80444
1907


| ISSUE NAME | DATE |
|-----------------|------------|
| BUILDING PERMIT | 08/23/2019 |
| VE REVISIONS | 10/15/2019 |

SCHEDULES & TYPICAL DETAILS

SHEET NO.

\$5.0

10/15/2019 11:15:06 AM

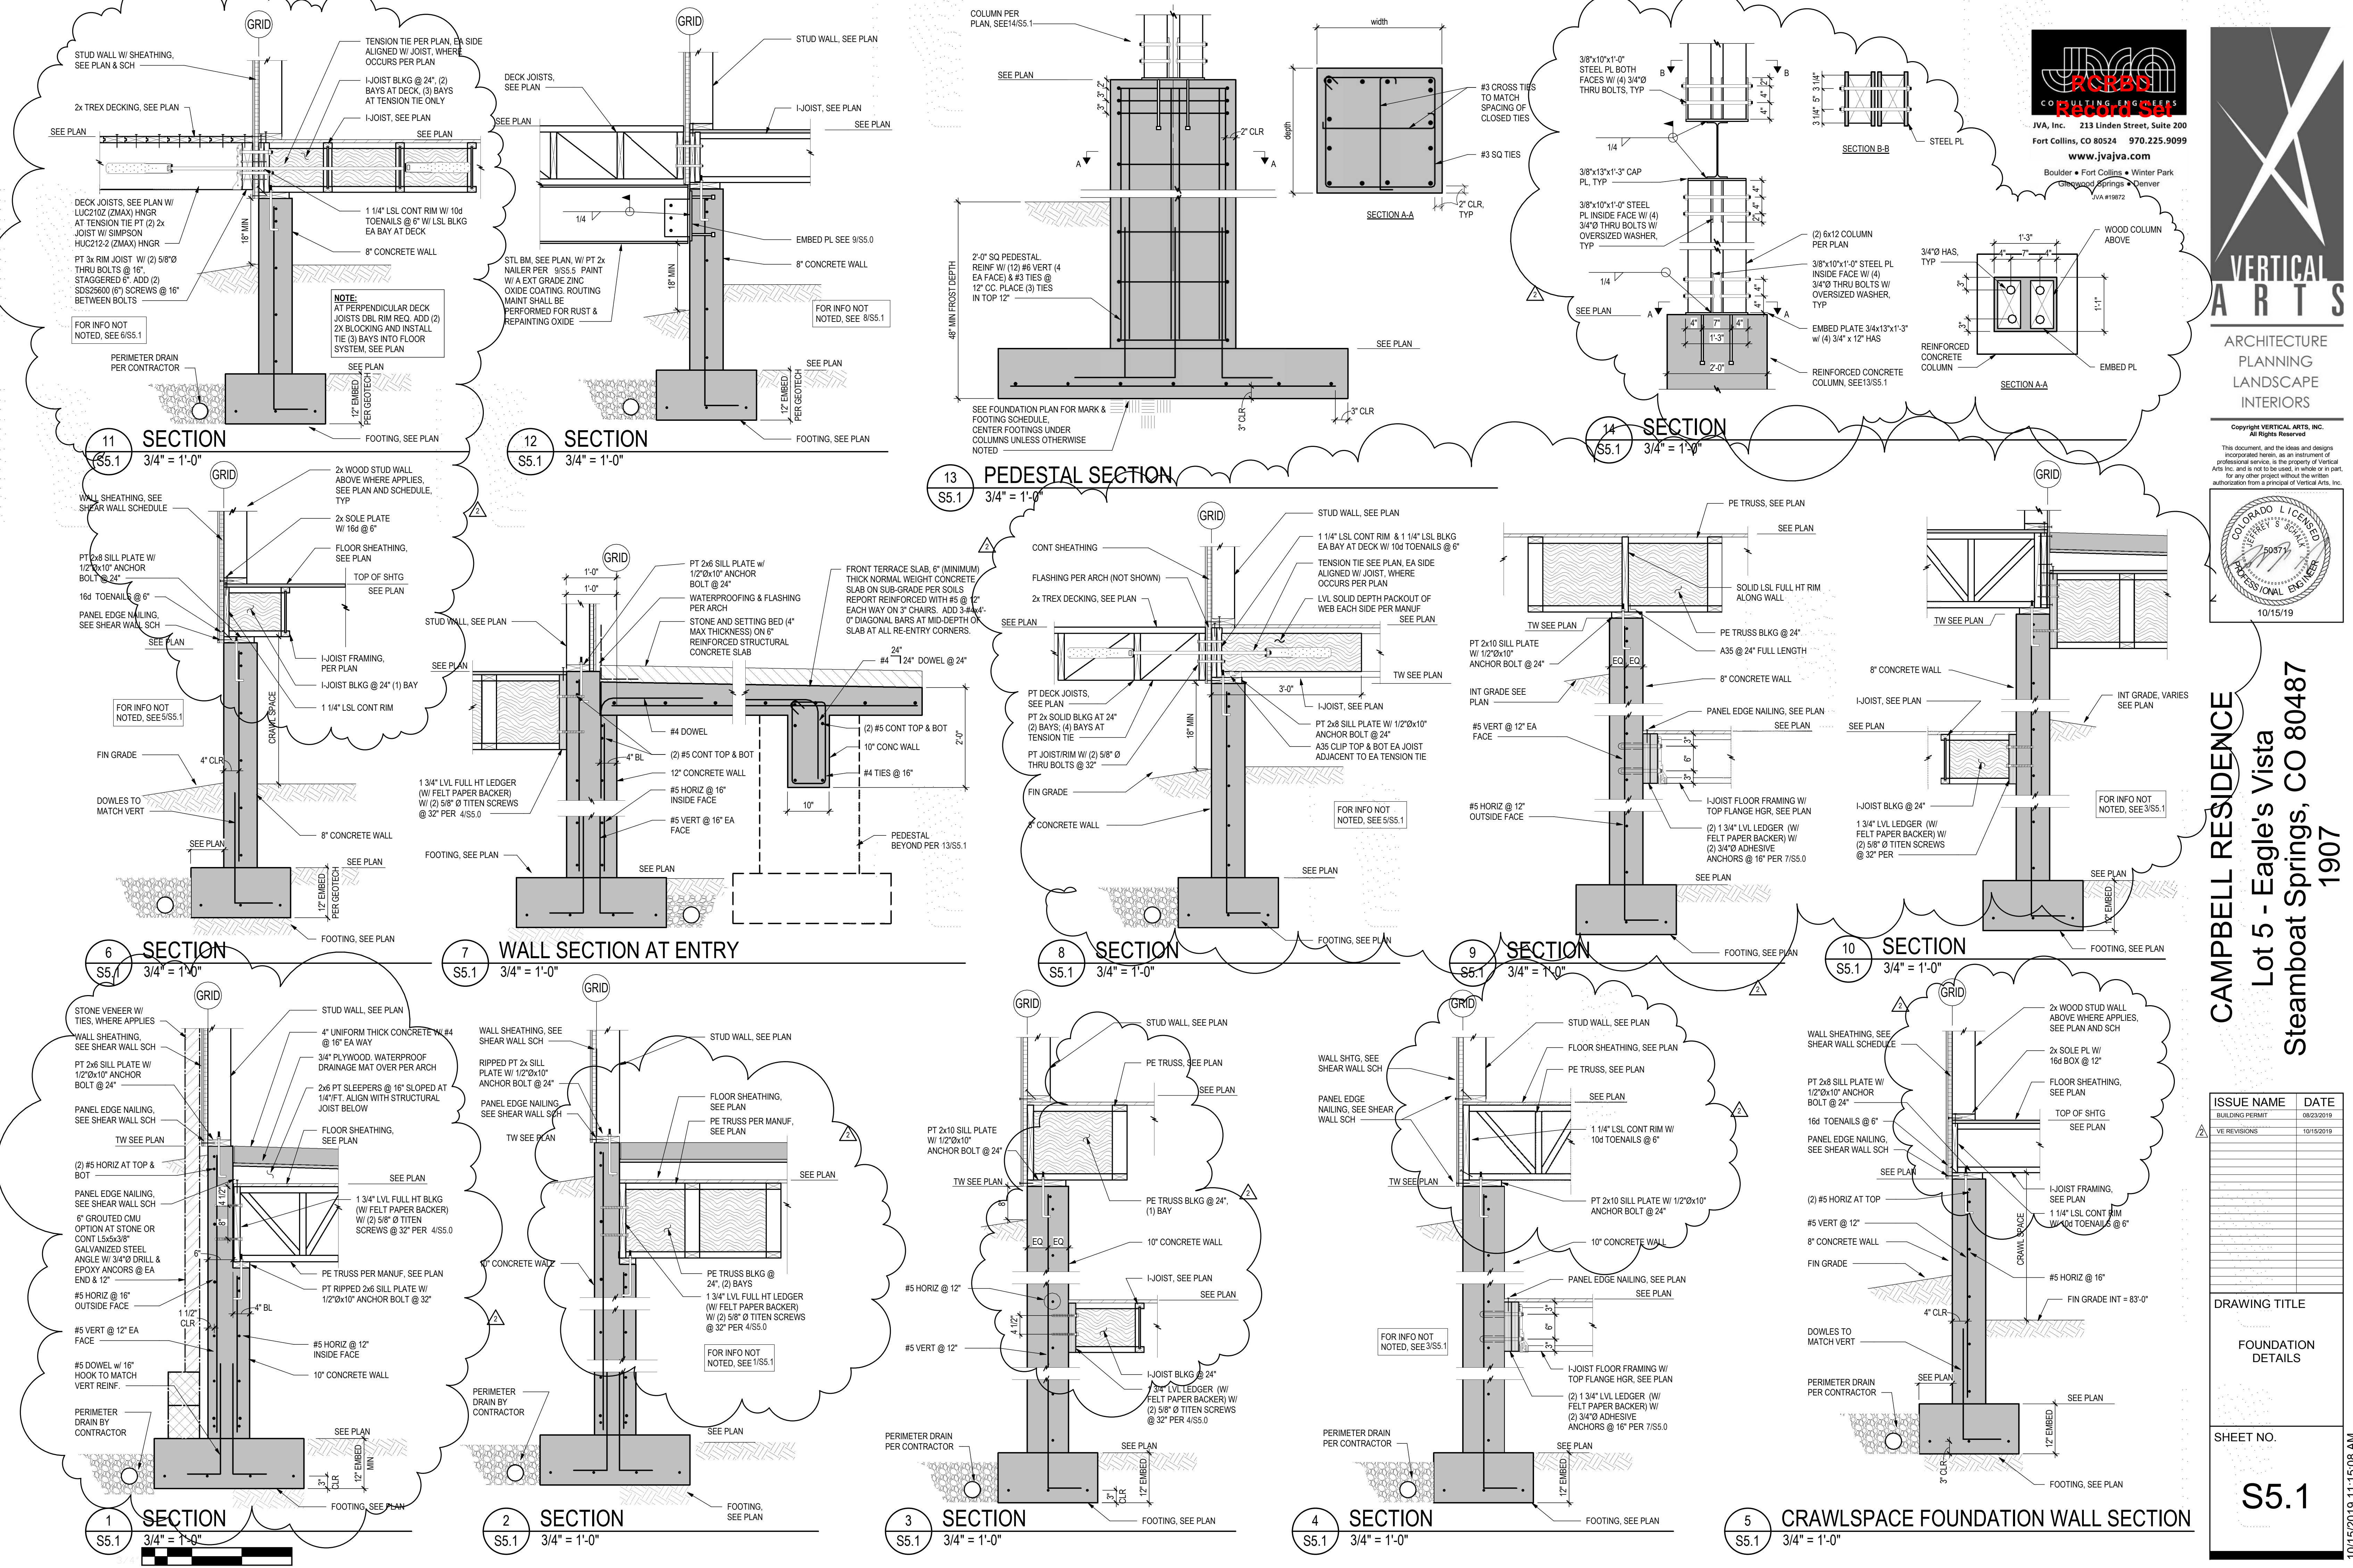


JVA
CONSULTING ENGINEERS
Record Set
JVA, Inc. 213 Linden Street, Suite 200
Fort Collins, CO 80524 970.225.9099
www.jvajva.com
Boulder • Fort Collins • Winter Park
Chattanooga • Denver
JVA #10872



ARCHITECTURE
PLANNING
LANDSCAPE
INTERIORS

Copyright VERTICAL ARTS, INC.
All Rights Reserved
This document, and the ideas and designs incorporated herein, is an instrument of professional service, is the property of Vertical Arts Inc. and is not to be used, in whole or in part, for any other project without the written authorization from a principal of Vertical Arts, Inc.

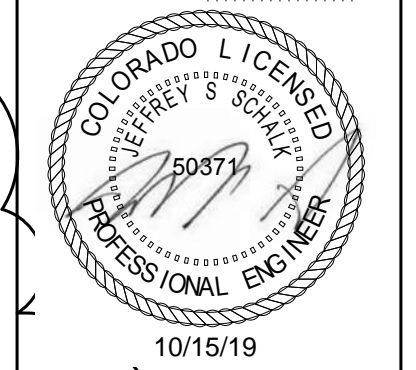





CAMPBELL RESIDENCE
Lot 5 - Eagle's Vista
Steamboat Springs, CO 80487
1907

| ISSUE NAME | DATE |
|-----------------|------------|
| BUILDING PERMIT | 08/23/2019 |
| VE REVISIONS | 10/15/2019 |
| | |
| | |
DRAWING TITLE
FOUNDATION DETAILS

SHEET NO.
S5.1


10/15/2019 11:15:08 AM

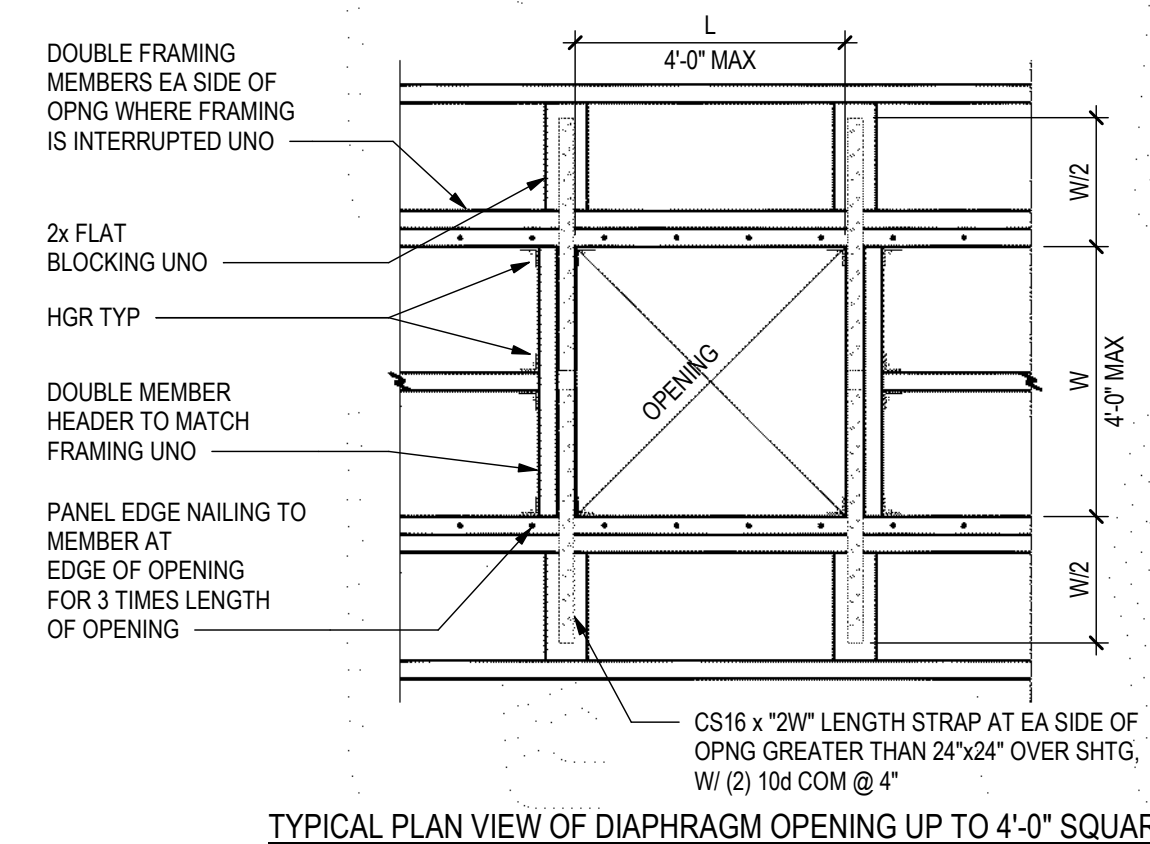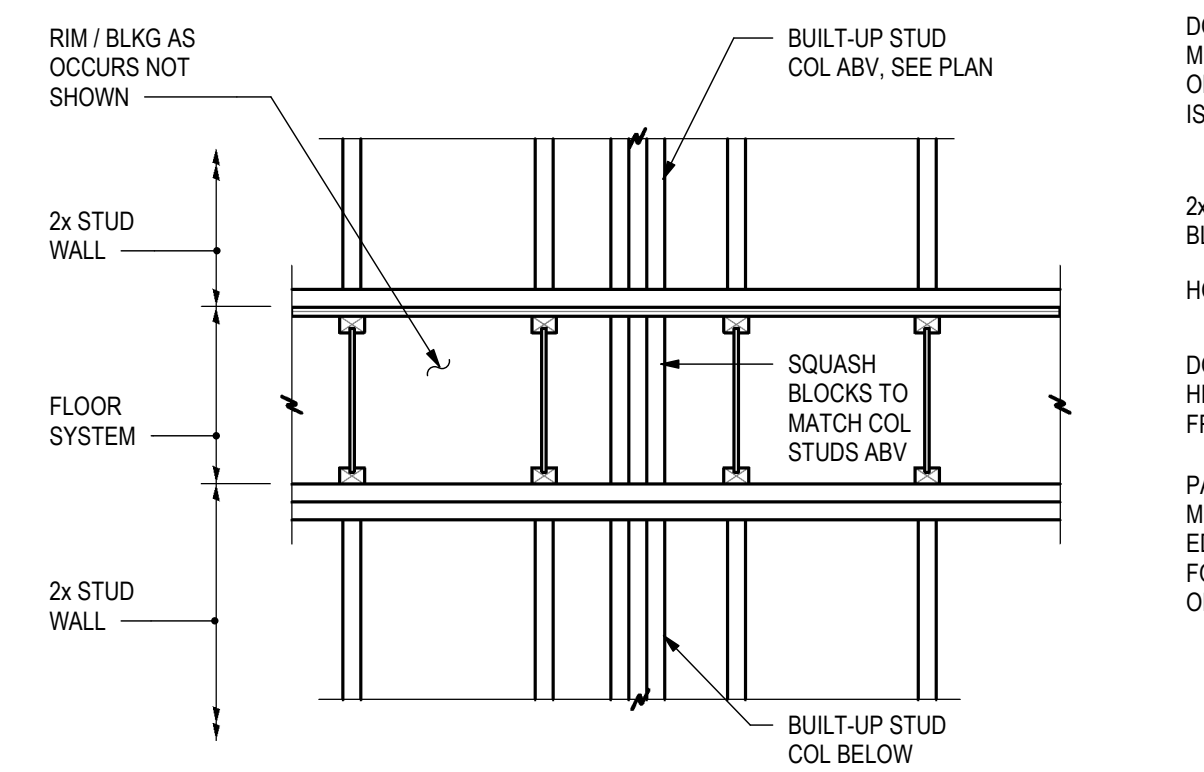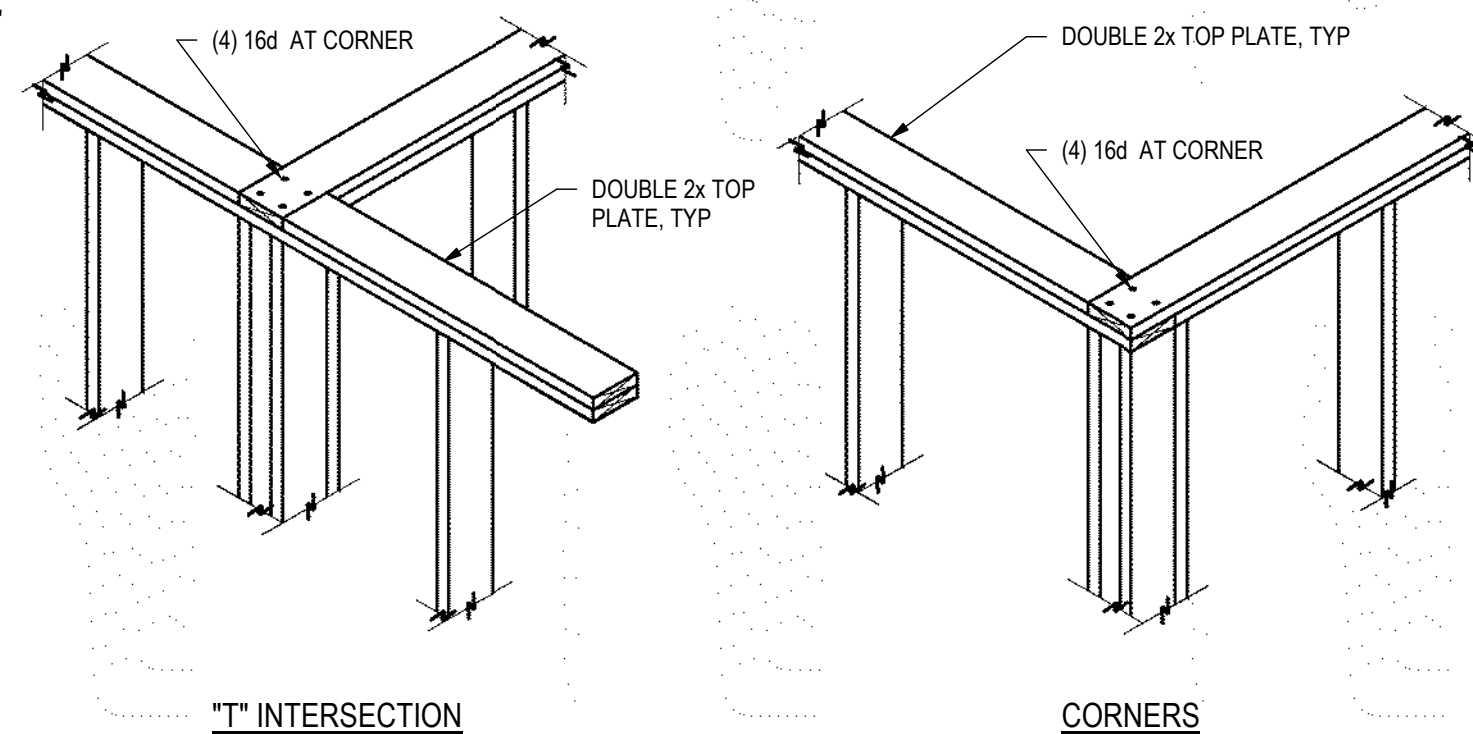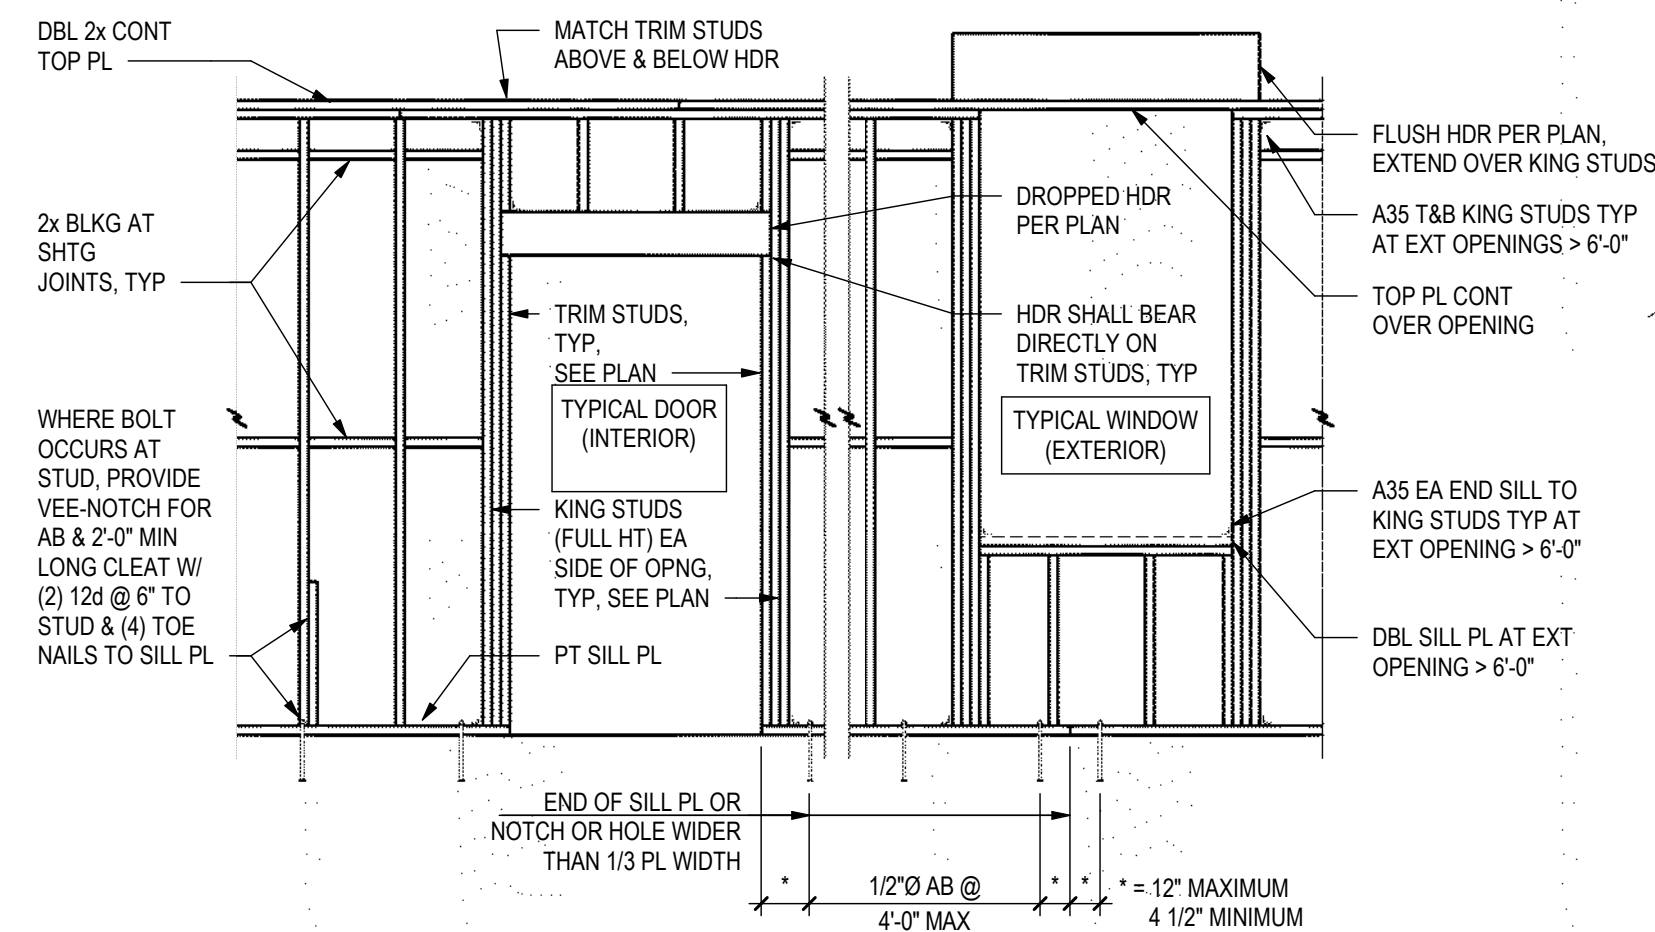

ARCHITECTURE
PLANNING
LANDSCAPE
INTERIORS

Copyright VERTICAL ARTS, INC.
All Rights Reserved

This document, and the ideas and designs incorporated herein, as an instrument of professional service, is the property of Vertical Arts Inc. and is not to be used, in whole or in part for any other project without the written authorization from a principal of Vertical Arts, Inc.

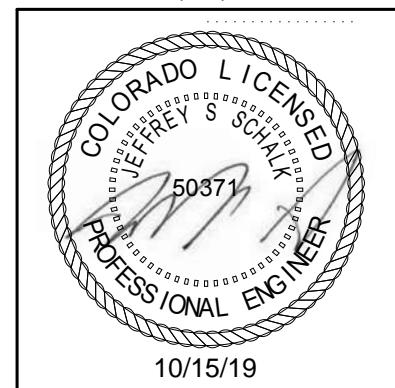

CAMPBELL RESIDENCE
Lot 5 - Eagle's Vista
Steamboat Springs, CO 80488
1907

| ISSUE NAME | DATE |
|---------------------|------------|
| BUILDING PERMIT | 08/23/2019 |
| PERMIT RE-SUBMITTAL | 10/2/19 |
| VE REVISIONS | 10/15/2019 |

DRAWING TITLE

TYP WOOD DETAILS

SHEET NO.

S5.3






10/15/2019 11:15:15 AM

STUD WALL ELEVATION

12 TOP PLATE LAP ISO
S5.3 NO SCALE

13 TYP SQUASH BLOCKING
S5.3 3/4" = 1'-0"

14 DIAPHRAGM OPENING DETAIL
S5.3 $3/4" = 1'-0"$

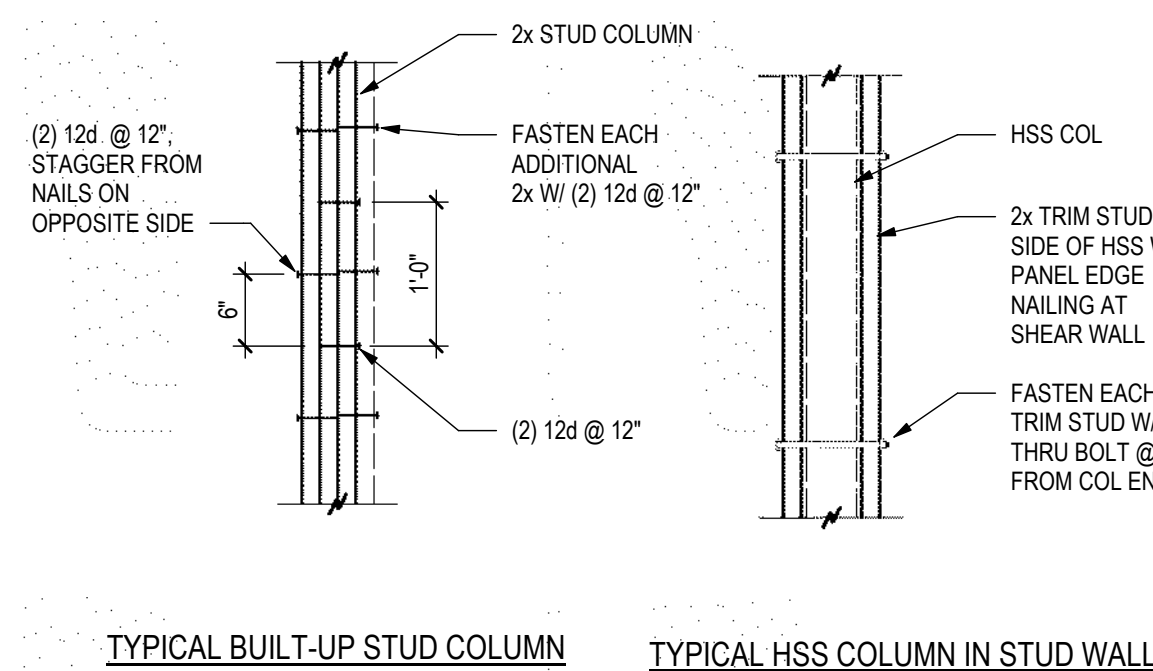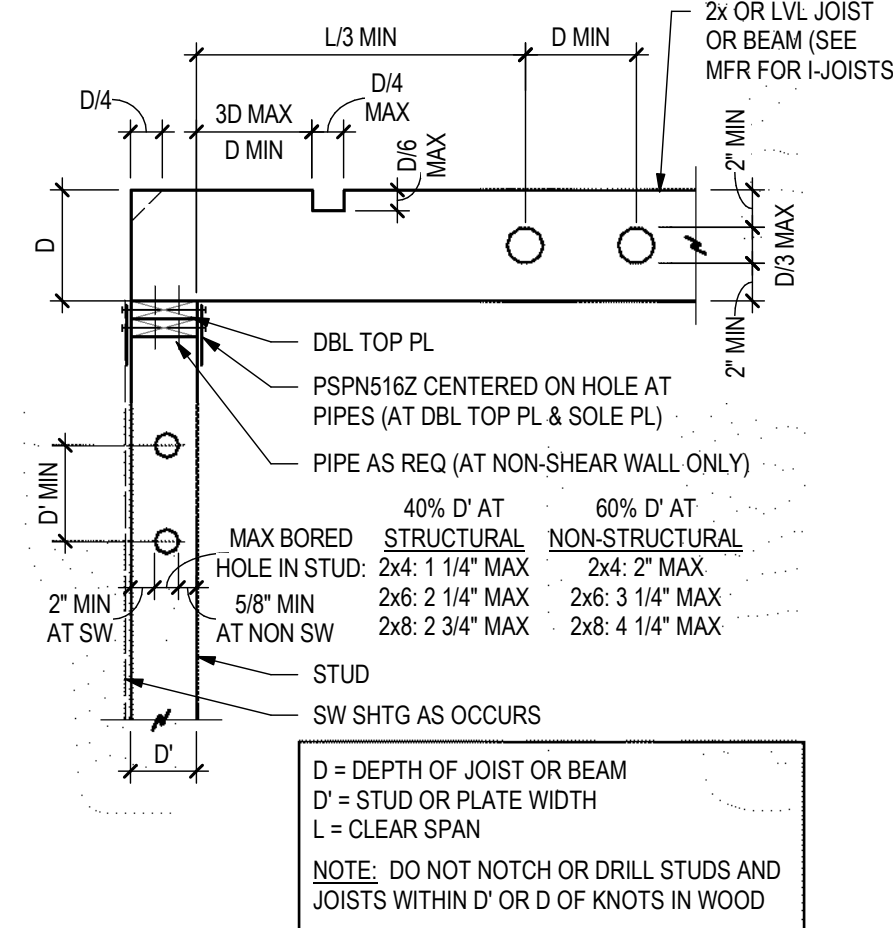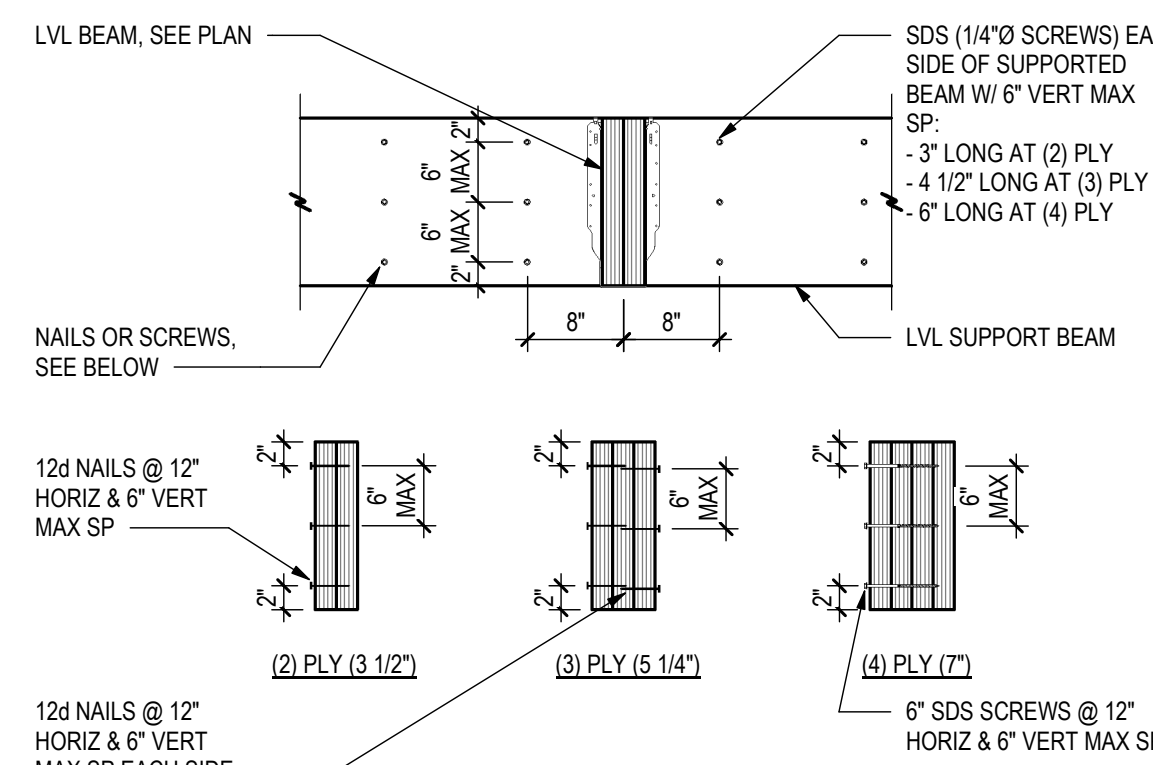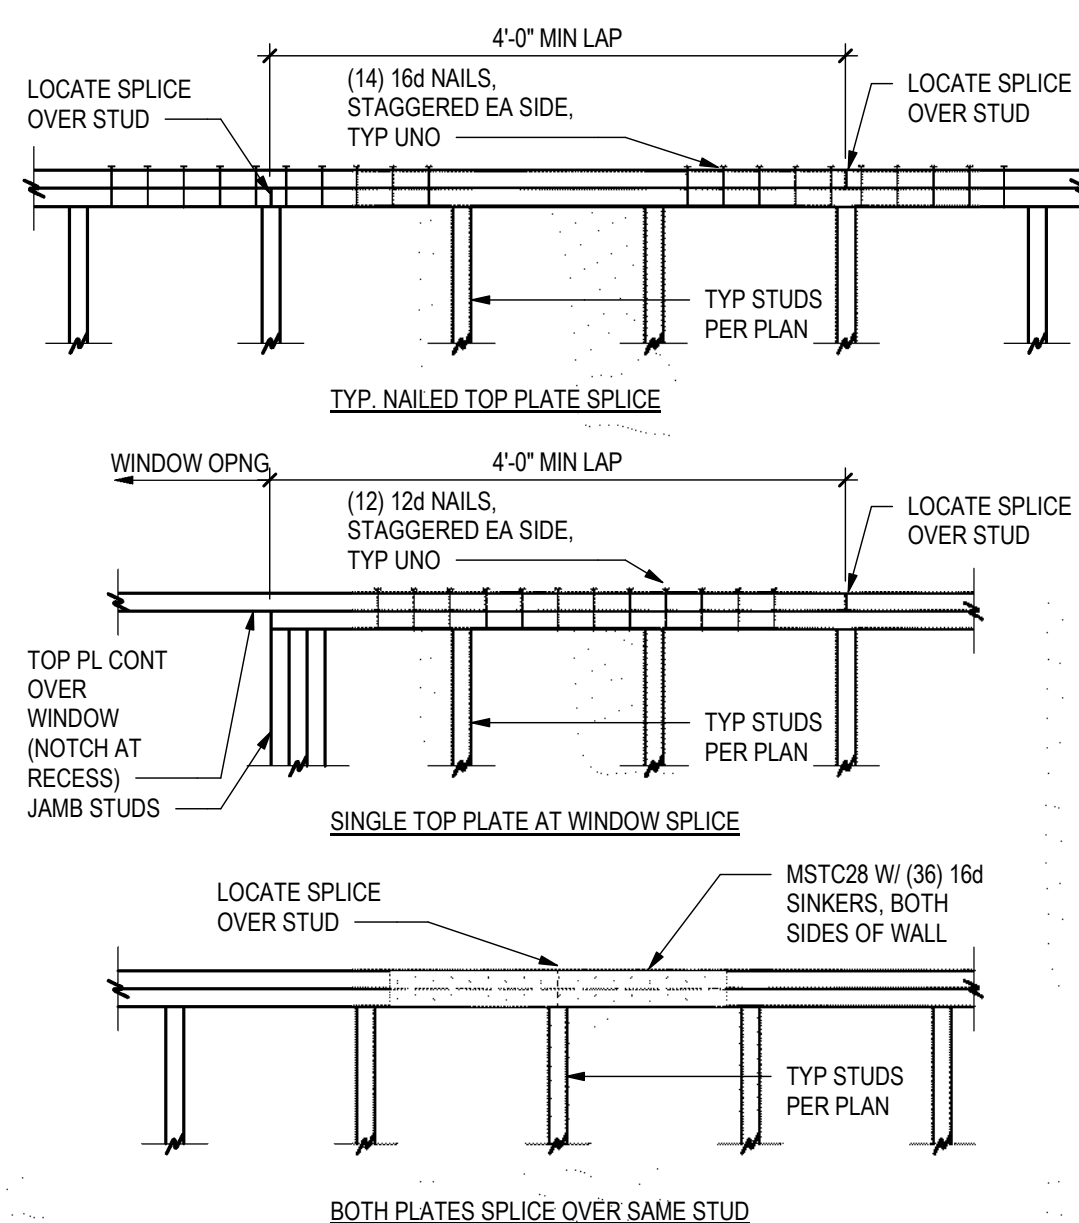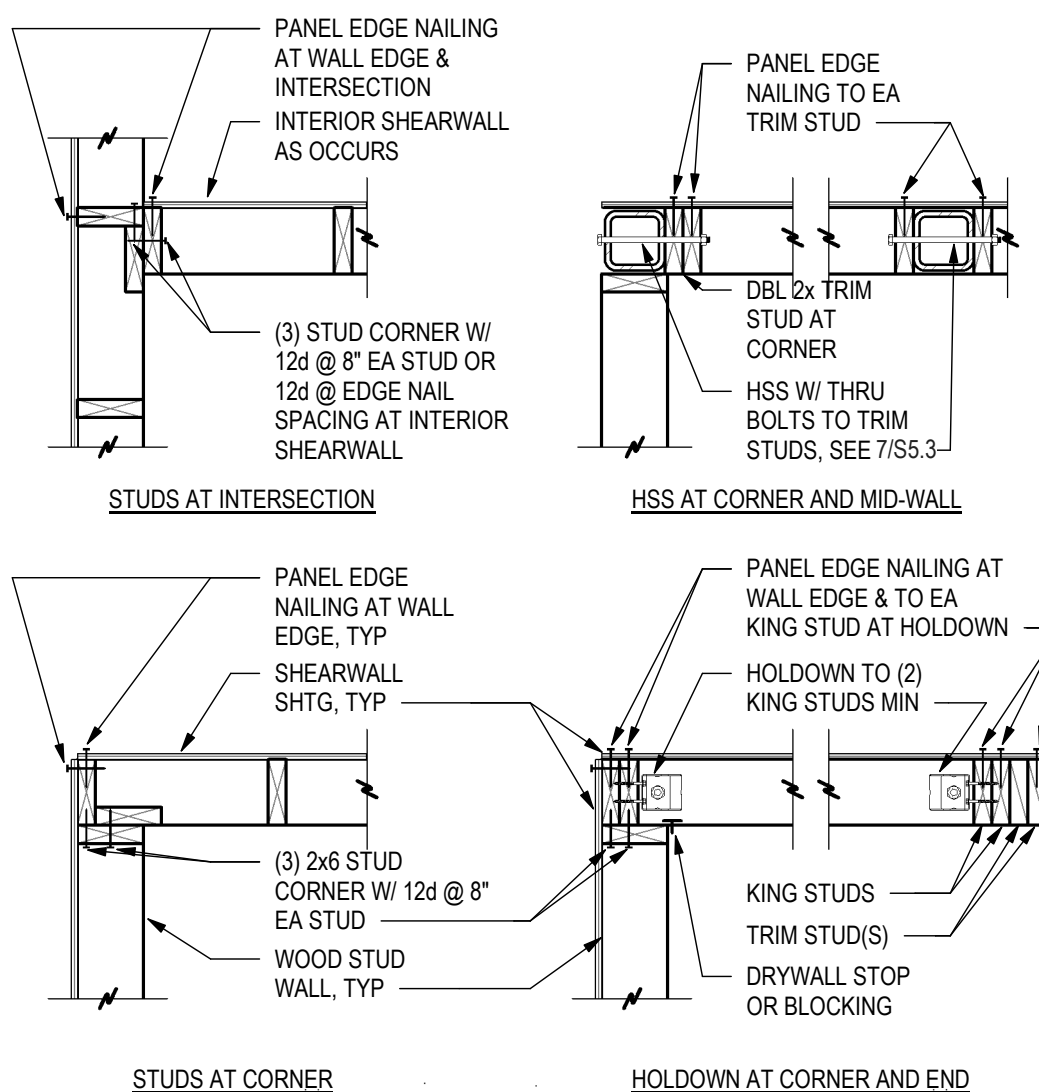

| WOOD FRAMING FASTENING SCHEDULE | | |
|--|---|---|
| CONNECTION | FASTENING | LOCATION |
| 1. JOIST/RAFTER/BLOCKING TO BEARING SUPPORT | (3) 8d COMMON [OR] (3) 12d SINKER | TOENAIL |
| 2. BRIDGING/BLOCKING TO JOIST | (2) 8d COMMON [OR] (2) 12d SINKER | TOENAIL, EACH END |
| 3. SOLE PLATE TO JOIST OR BLOCKING | 16d COMMON @ 16" [OR] 12d SINKER @ 8" | FACE NAIL |
| 4. STUD TO TOP SOLE PLATE | (2) 16d COMMON [OR] (3) 12d SINKER | END NAIL |
| 5. STUD TO SOLE PLATE | (4) 8d COMMON [OR] (4) 12d SINKER | TOENAIL |
| 6. DOUBLE STUDS AND BUILD-UP CORNER STUDS | 16d COMMON @ 24" [OR] 12d SINKER @ 12" | FACE NAIL, EACH STUD |
| 7. DOUBLE TOP PLATES | 16d COMMON @ 16" [OR] 12d SINKER @ 12" (8) 16d COMMON [OR] (12) SINKER | TYPICAL FACE NAIL LAP SPlice FACE NAIL |
| 8. RIM JOIST AND JOIST BLOCKING TO TOP PLATE | 8d COMMON @ 5" [OR] 12d SINKER @ 6" | TOENAIL |
| 9. TOP PLATE INTERSECTION | (2) 16d COMMON [OR] (3) 12d SINKER | FACE NAIL |
| 10. BUILD UP HEADER | 16d COMMON @ 16" [OR] 12d SINKER @ 12" | FACE NAIL ALONG EACH EDGE, EACH 2x |
| 11. HEADER TO KING STUD | (4) 8d COMMON [OR] (4) 12d SINKER | TOENAIL |

GENERAL NOTES:

1. REFER TO IBC TABLE 2304.9.1 FOR MORE INFORMATION.
2. ALL FASTENINGS ARE TYPICAL, UNLESS NOTED OTHERWISE.

5
S5.3

STUD WALL PLAN DETAILS

3/4" = 1'-0"

6 TOP PLATE SPLICE DETAIL
S5.3 $3/4" = 1'-0"$

7 COLUMN DETAILS
S5.3 $3/4" = 1'-0"$

| WOOD SHEAR WALL SCHEDULE | | | | | | | | | |
|--------------------------|---|---|---|--------------------------------|--------------------|----------------|------------------------|---------------|--------------------------|
| MARK | STUDS | SHEATHING | SHEATHING NAILS | PANEL EDGE NAIL SPACING | FIELD NAIL SPACING | ANCHOR BOLTS | WASHERS | WIND CAPACITY | AS3 INSTEAD OF AS16 WALL |
| SW4 | 2x6 @ 16" | 7/16" APA (24/16) INTERIOR & ZIP SYSTEM R-6 SHEATHING | 8d COMMON NAILS (0.131"x2 1/2") INT & 10d SHANK NAILS (0.131"x3") AT ZIP SYSTEM EXT | 6" INTERIOR & 3" AT ZIP SYSTEM | 12" | 1/2"x10" @ 24" | 0.229"x3" PL (BPS12/4) | 730 PLF | 1-4" |
| SW6 | 2x6 @ 16" WALLS OVER 14'-0" TALL USE 1 1/2" x 1.5E LSL STUDS @ 16" | 7/16" APA (24/16) OR ZIP SYSTEM R-6 SHEATHING | 8d COMMON NAILS (0.131"x2 1/2") OR 10d SHANK NAILS (0.131"x3") AT ZIP SYSTEM EXT | 6" OR 3" AT ZIP SYSTEM | 12" | 1/2"x10" @ 32" | STANDARD | 365 PLF | 2-8" |
| SW6A | 2x6 @ 16" | 7/16" APA (24/16) | 8d COMMON NAILS (0.131"x2 1/2") | 6" | 12" | 1/2"x10" @ 32" | STANDARD | 365 PLF | 2-8" |

EDGE NAIL EA STD
DBL STUD AT VERT EDGE
SPICES
16d @ 2'

AT VERT EDGES

2x FLAT BLKG AT HORIZ EDGE
SPICES

AT HORIZ EDGES

TYPICAL FOR ALL SHEAR WALL NAILING:

PER IRC / AWC SDOCS, SHEATHING NAILS SHALL BE DRIVEN FLUSH BUT SHALL NOT FRACTURE THE SURFACE OF THE SHEATHING. SHEATHING PANEL NAILING NOT CONFORMING TO THIS SECTION WILL NOT BE ACCEPTABLE AND WILL HAVE TO BE REINSTALLED. IT IS THE CONTRACTOR'S RESPONSIBILITY TO ENSURE THAT THE NAIL GUNS USED FOR FASTENING ARE SET AT THE PROPER DEPTH AND/OR AIR PRESSURE TO ACHIEVE THE REQUIRED PENETRATION

GENERAL NOTES:

1. VALUES ARE BASED ON DOUGLAS FIR-LARCH FRAMING, SEE GENERAL NOTES
2. SEE PLAN FOR HOLDOWN TYPE AND LOCATION
3. UNLESS NOTED OTHERWISE NUMBER OF STUDS AT EACH END OF SHEAR WALLS IS CALLED OUT ON PLAN
4. NO PENETRATIONS GREATER THAN 12"x12" IN SHEAR WALLS, BLOCK AND NAIL ALL EDGES
5. NO MECHANICAL OR PLUMBING PENETRATIONS IN TOP AND BOTTOM PLATES
6. ALL EDGES SHALL BE BLOCKED WITH 2x MEMBERS AT PLYWOOD/OSB SHEATHED WALLS
7. ALL WALLS HAVE (2) 2x TOP PLATES AND (1) 2x BOTTOM PLATE EQUAL TO WIDTH OF STUD SIZE, TYP UNO
8. MINIMUM WIDTH OF SHEATHING PANELS AT ENDS OF SHEAR WALLS SHALL BE 4'-0" TO ENSURE END STUDS ARE ENGAGED
9. SEE DETAILS FOR ATTACHMENT OF DIAPHRAGMS TO SHEARWALL PLATES, TYPICAL

0.229"x3" PLATE WASHER DETAIL

PLATE WASHER, DIAGONALLY
SLOTTED HOLES ARE ACCEPTABLE UP TO 3/16" LARGER THAN HOLE DIAMETER. SLOT LENGTH NOT TO EXCEED 1/4"
BP OR BPS MAY BE USED


| WOOD WALL | | |
|-----------|------|--|
| | TYPE | STUDS & SPACING |
| SW4 | | 2x6 @ 16" |
| SW6 | | 2x6 @ 16", WALLS OVER 14'-0" TALL USE 1 1/2" x 1.5E LSL STUDS @ 16" |
| SW6A | | 2x6 @ 16" |
| W4 | | 2x4 @ 16" |
| W6 | | 2x6 @ 16" |

GENERAL NOTES:

1. ALL WALLS TO BE DOUGLAS FIR-LARCH, SEE GENERAL NOTES
2. WALLS TO HAVE (2) 2x TOP PLATES AND (1) 2x BOTTOM PLATE
3. STUDS EQUAL TO WIDTH OF STUDS
4. DEMISING WALLS TO HAVE MIN HEIGHT 2x4 BLOCKING

| JOIST / BEAM HANGER SCHEDULE (UNLESS NOTED OTHERWISE ON PLAN) | | |
|---|---------------|--|
| JOIST / BEAM | FACE MOUNT | TOP FLANGE |
| 7 1/4" LVL | HU7 (MAX) | NOT ALLOWED |
| 11 7/8" LVL | HU11 | ITS1.81/11.88 |
| (2) 11 7/8" LVL | HU412 | BA3.56/11.88 |
| (3) 11 7/8" LVL | HU612 | HB5.50/11.88 |
| 16" LVL | IUS1.81/16 | ITS1.81/16 |
| 14" LVL | HU416 | BA3.56/16 |
| 14" LVL | HU616 | HB5.50/16 |
| 9 1/2" TJI 210 | IUS2.06/9.5 | ITS2.06/9.5 |
| 11 7/8" TJI 210 | IUS2.06/11.88 | ITS2.06/11.88 LBV 2.06/11.88 AT WELD CONNECTION |
| 11 7/8" TJI 560 | IUS3.56/11.88 | ITS3.56/11.88 |
| 14" TJI 210 | IUS2.06/14 | ITS2.06/14 |
| 14" TJI 360 | IUS2.37/14 | ITS2.56/14 |
| 14" TJI 560 | IUS3.56/14 | ITS3.56/14 |
| (2) 14" LVL | HHUS410 | HB3.56/14 |
| (3) 14" LVL | HHUSS.50/10 | HB5.50/14 |
| 2x4 | LUS24 | |
| (2) 2x4 | LUS24-2 | |
| (2) 18" LVL | HUCQ412-SDS | HB3.56/18 |
| 16" PE TRUSS | THA422 | THA422 |

GENERAL NOTES:
1. ALL HANGERS SHALL HAVE ALL NAIL HOLES FILLED
2. HANGERS EXPOSED TO TREATED LUMBER SHALL BE GALVANIZED
3. WEB STIFFENERS ARE REQUIRED AT JOIST HANGERS AT ALL ROOF & ROOF DECK LOCATIONS TO ALLOW FOR UPLIFT NAILING THRU THE WEB
4. WHERE TOP FLANGE HANGERS ARE SHOWN TO BE WELDED TO STEEL BEAMS, PROVIDE 1/8" x 2" PLATE WELD EACH SIDE OF EACH TOP FLANGE TAB

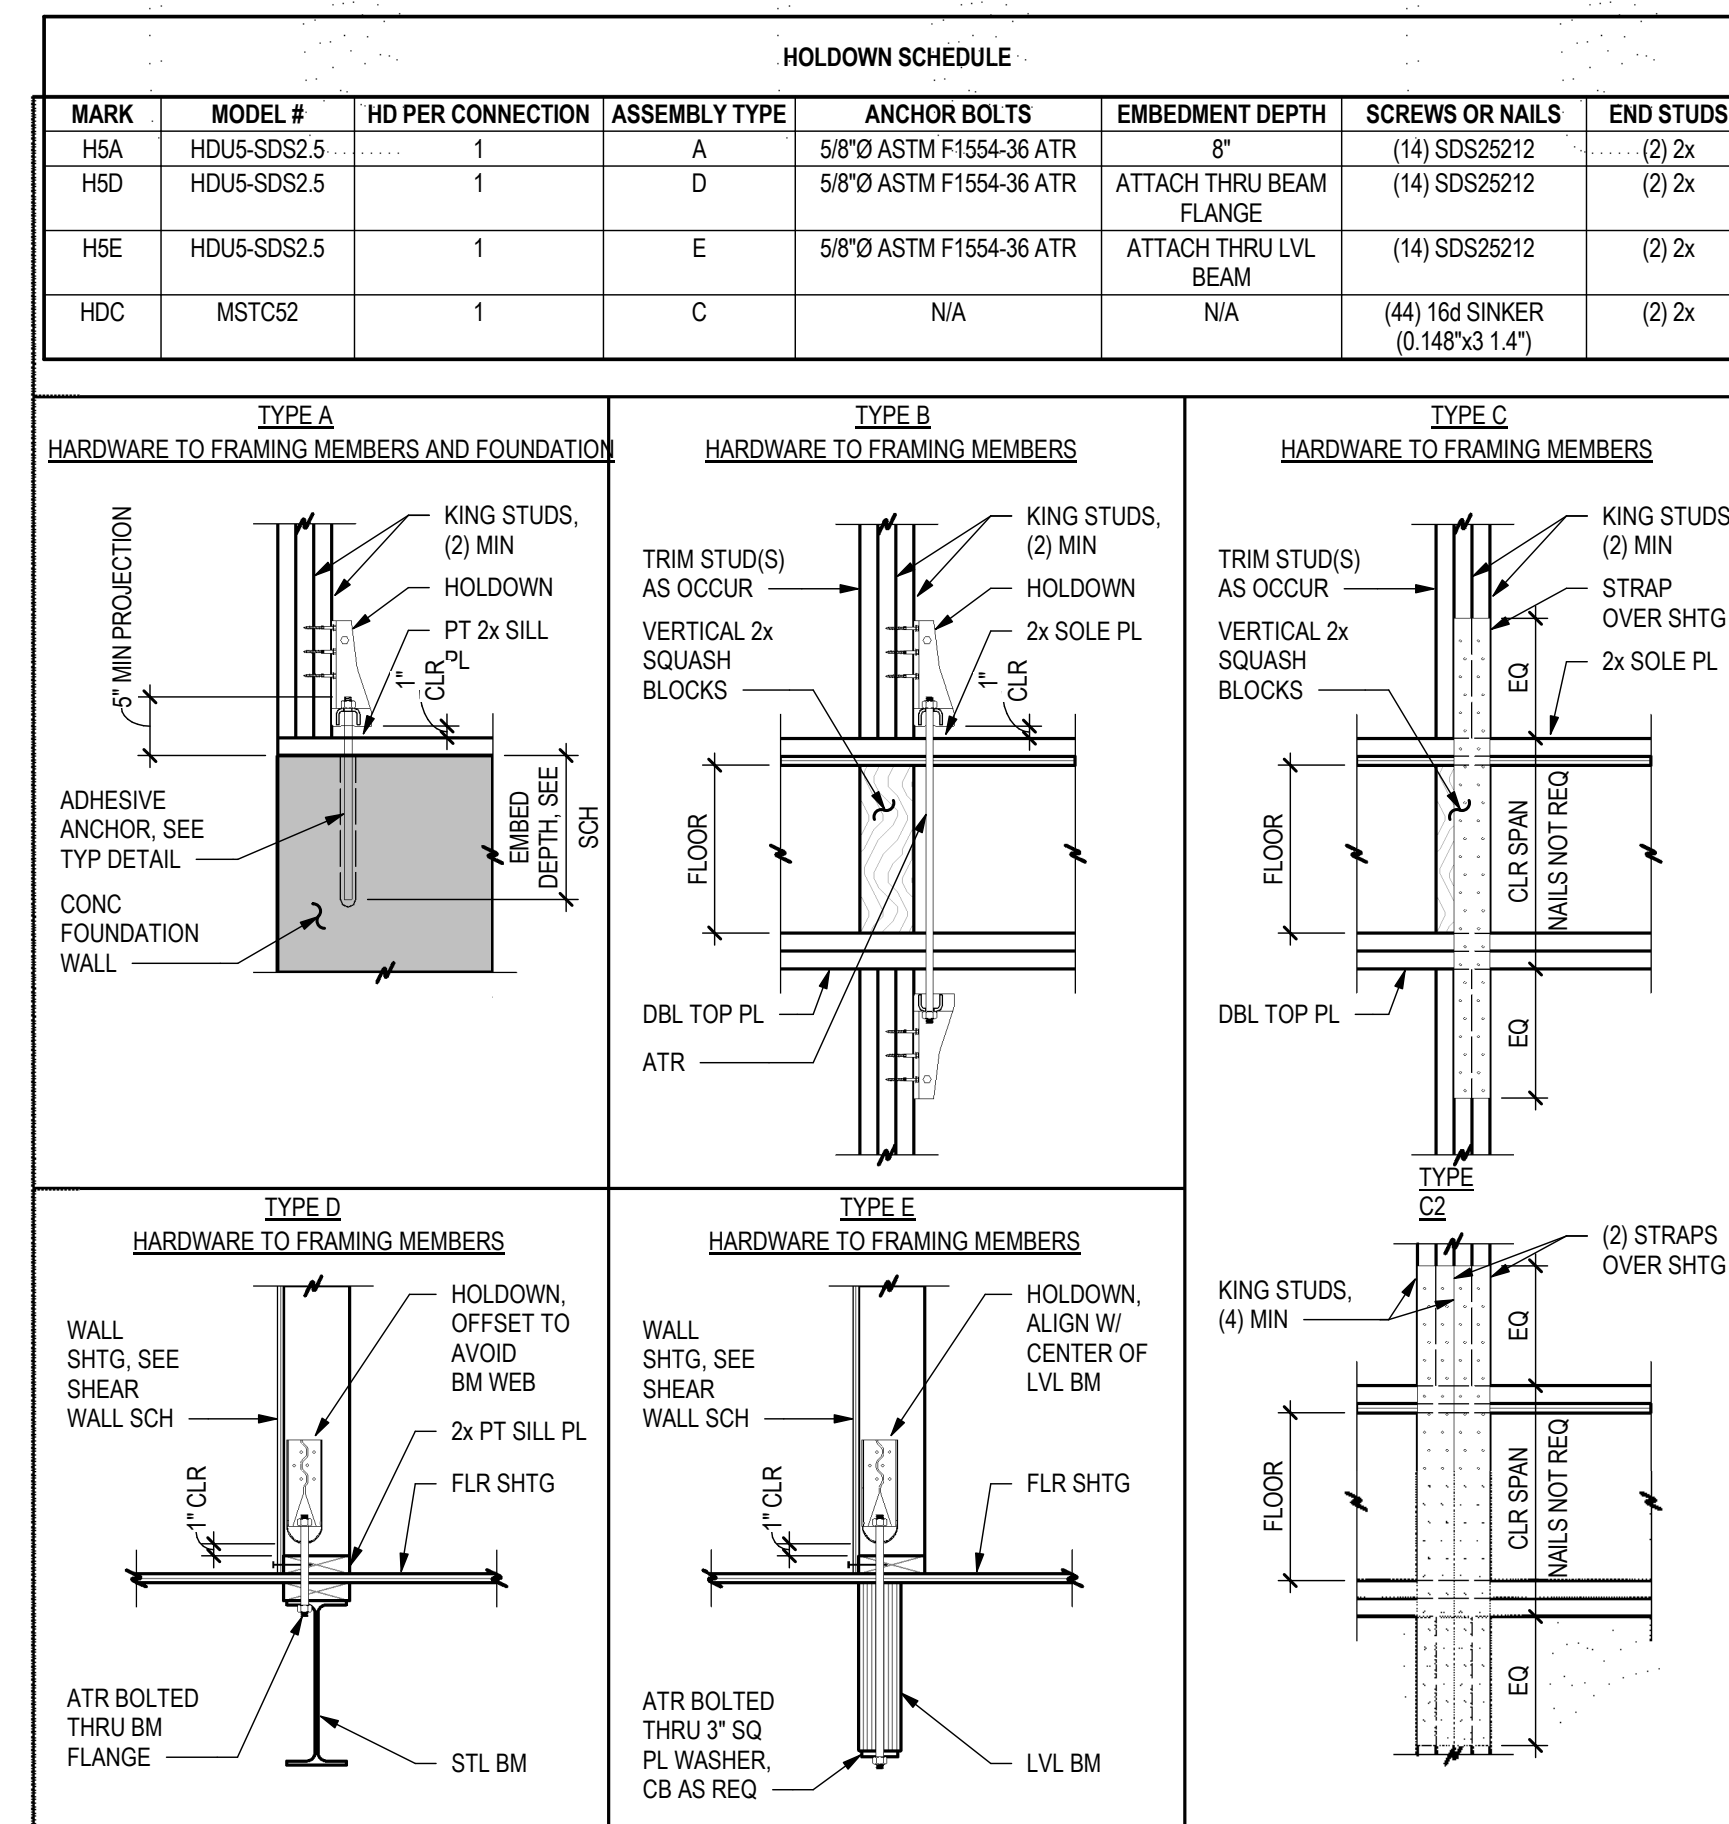

1 SHEAR WALL SCHEDULE

2 BEARING WALL SCHEDULE

JOIST HANGER SCHEDULE
























4 HOLDOWN SCHEDULE & DETAILS



DRAWING TITLE

TYP PE TRUSS JOIST
DETAILS


S5.4

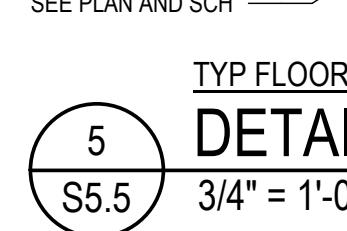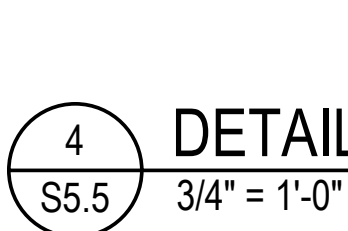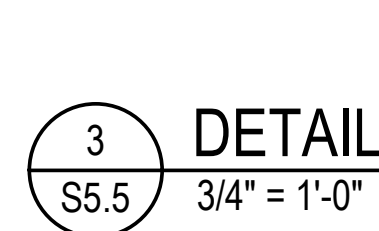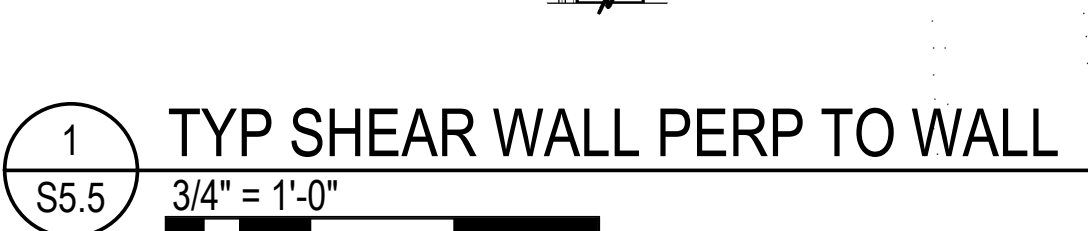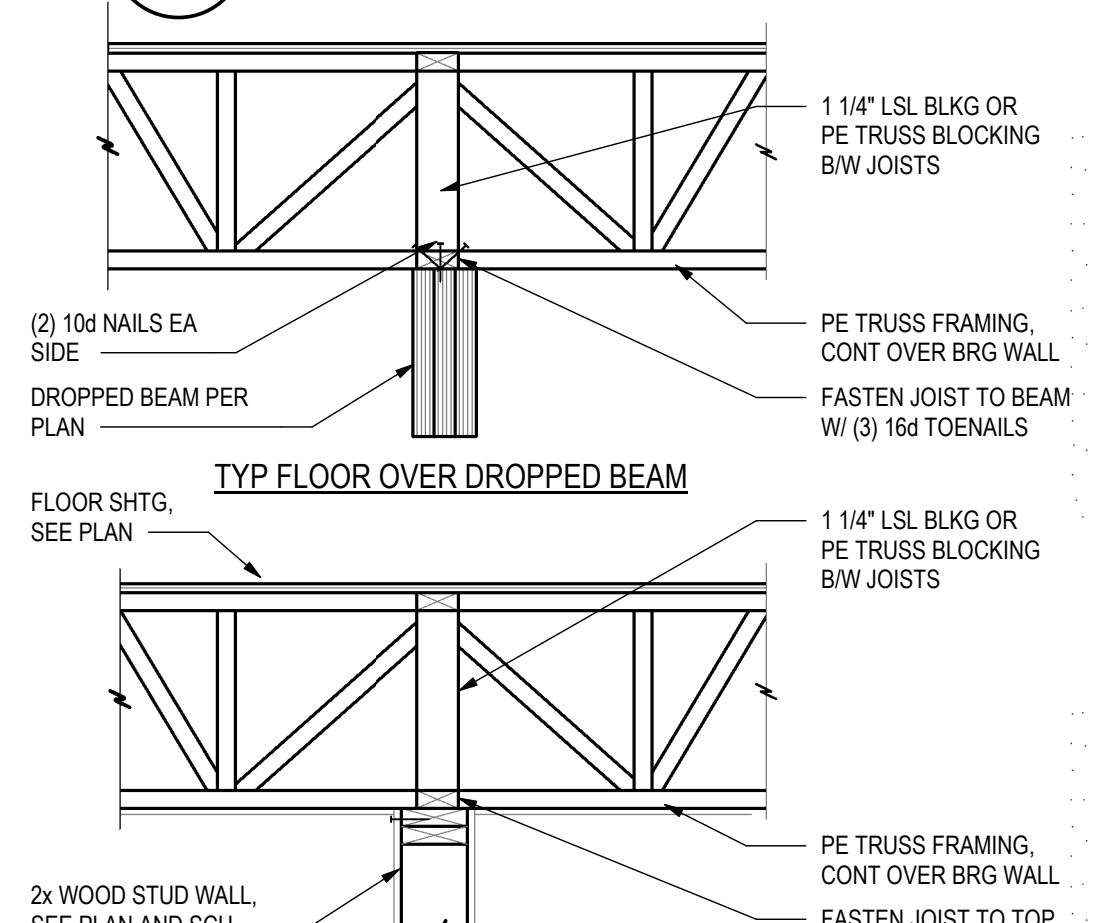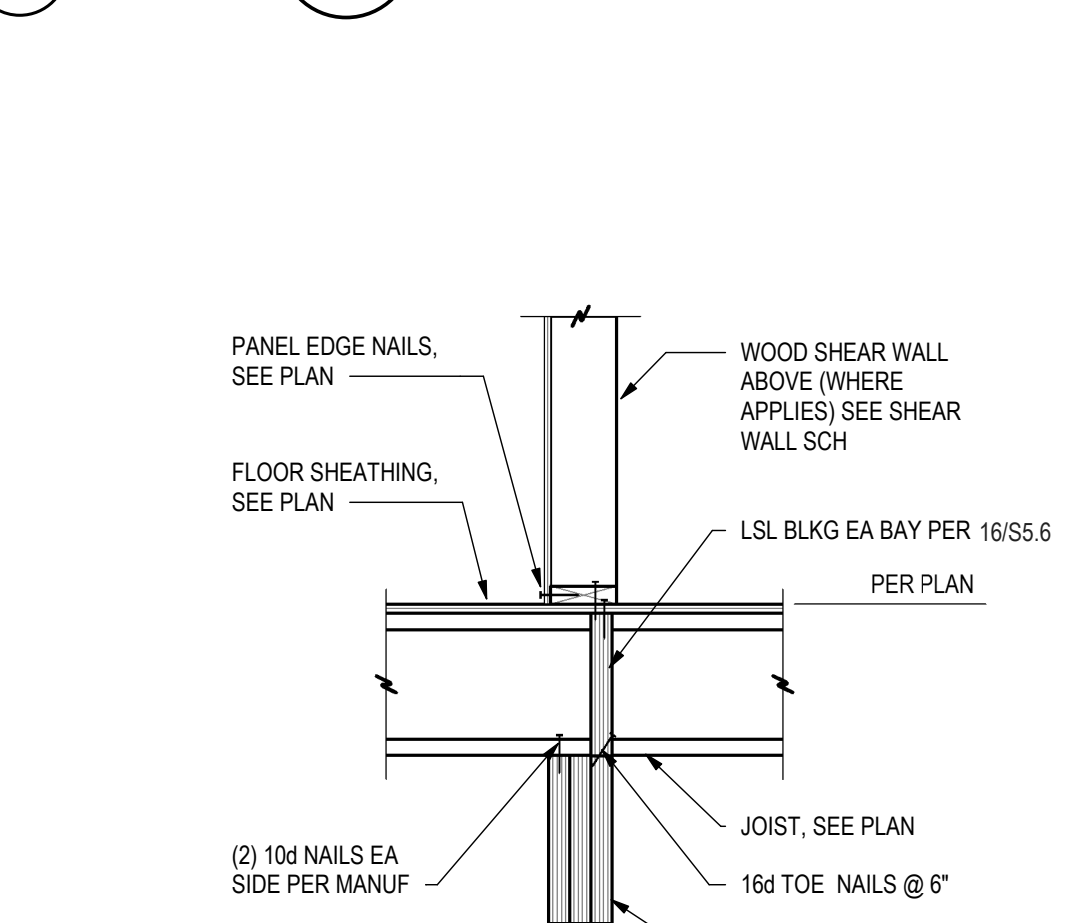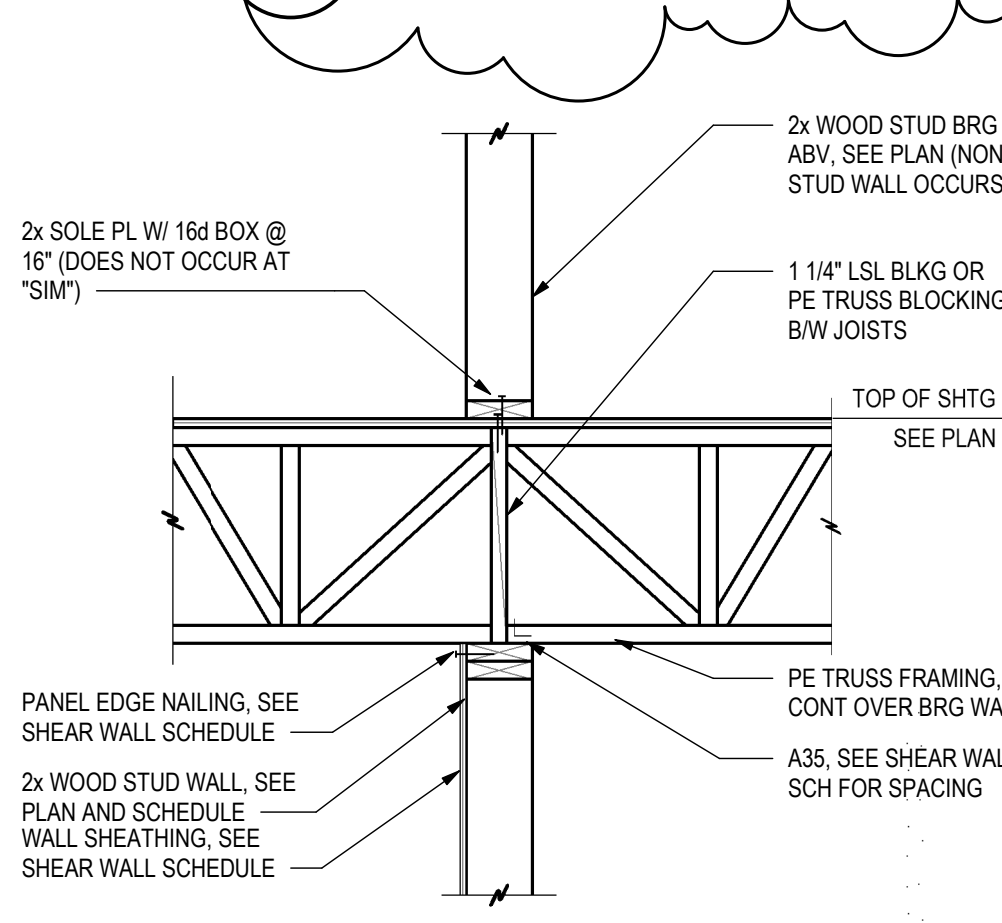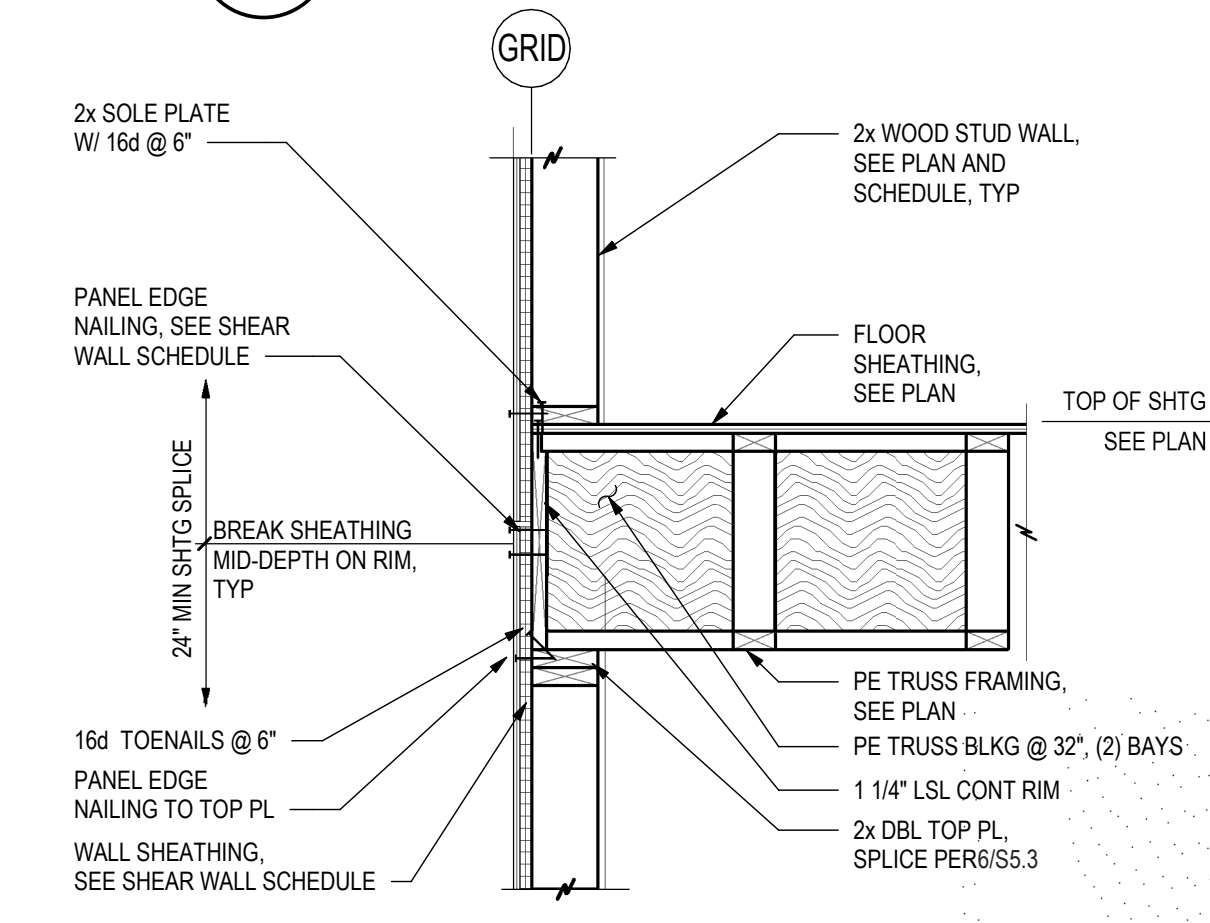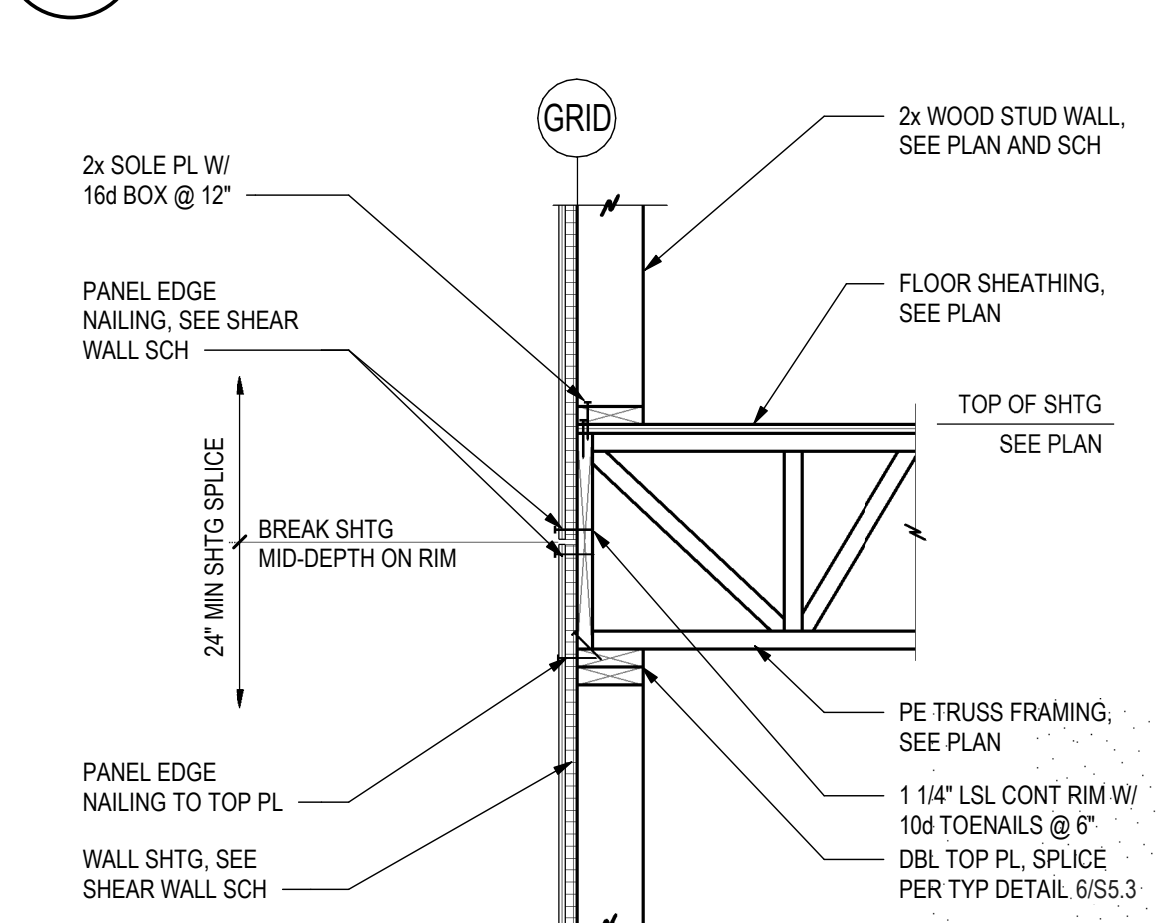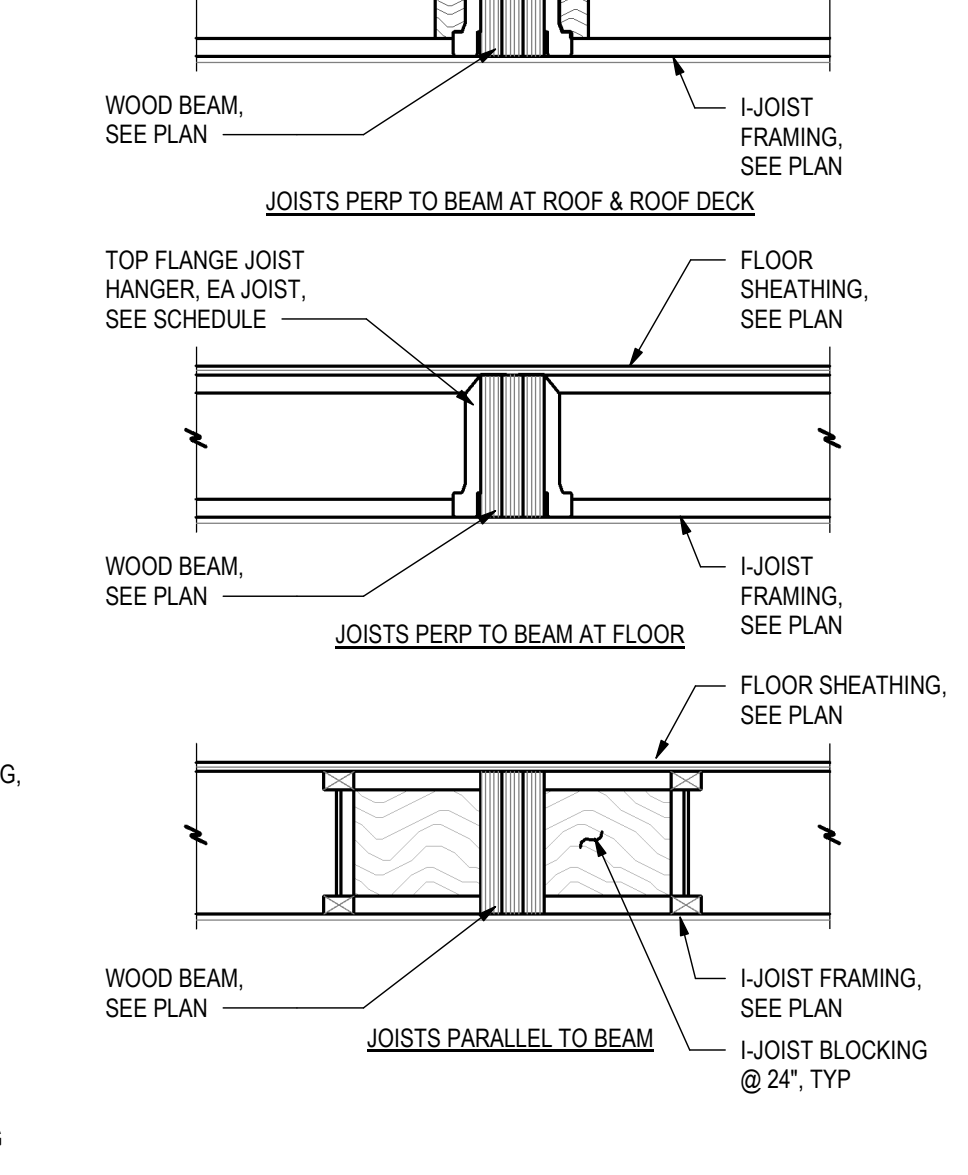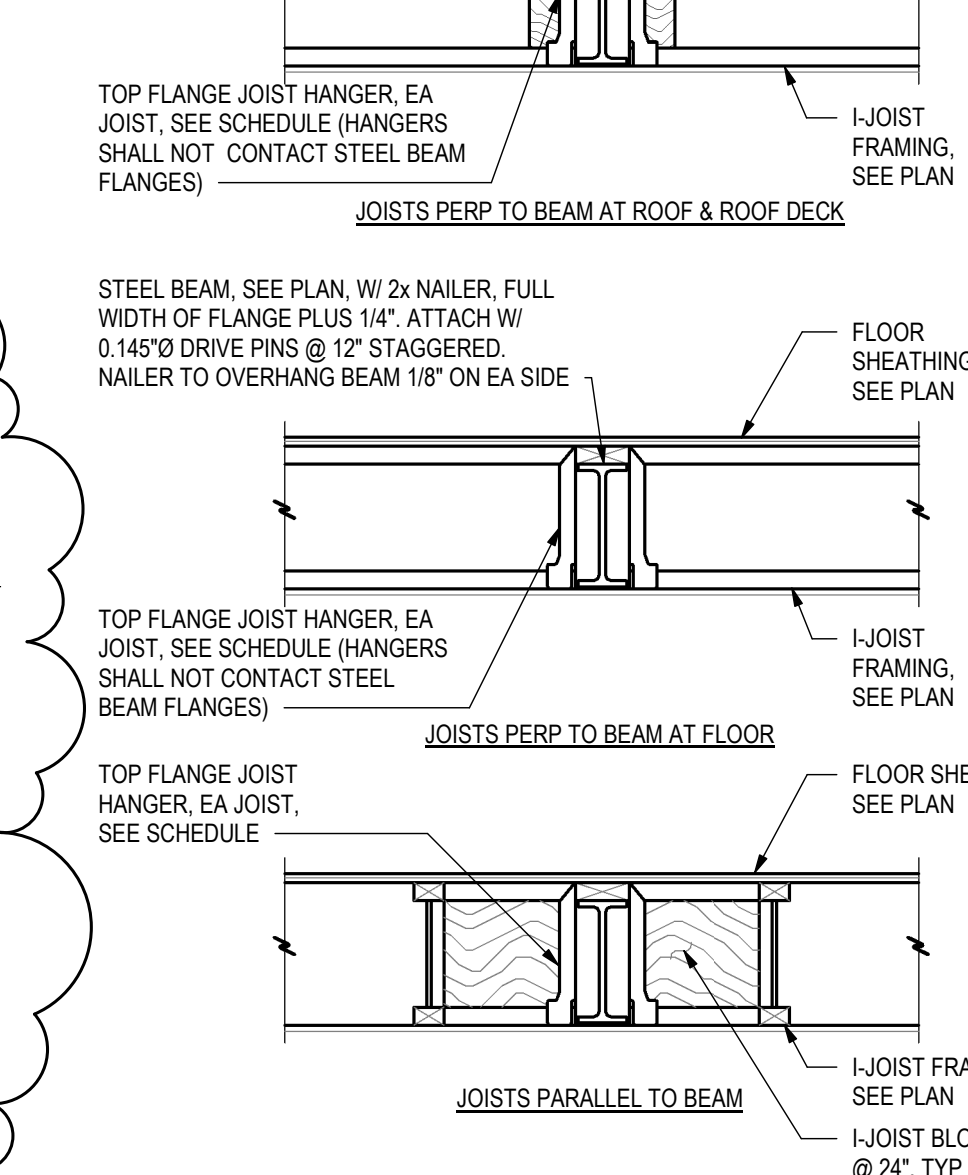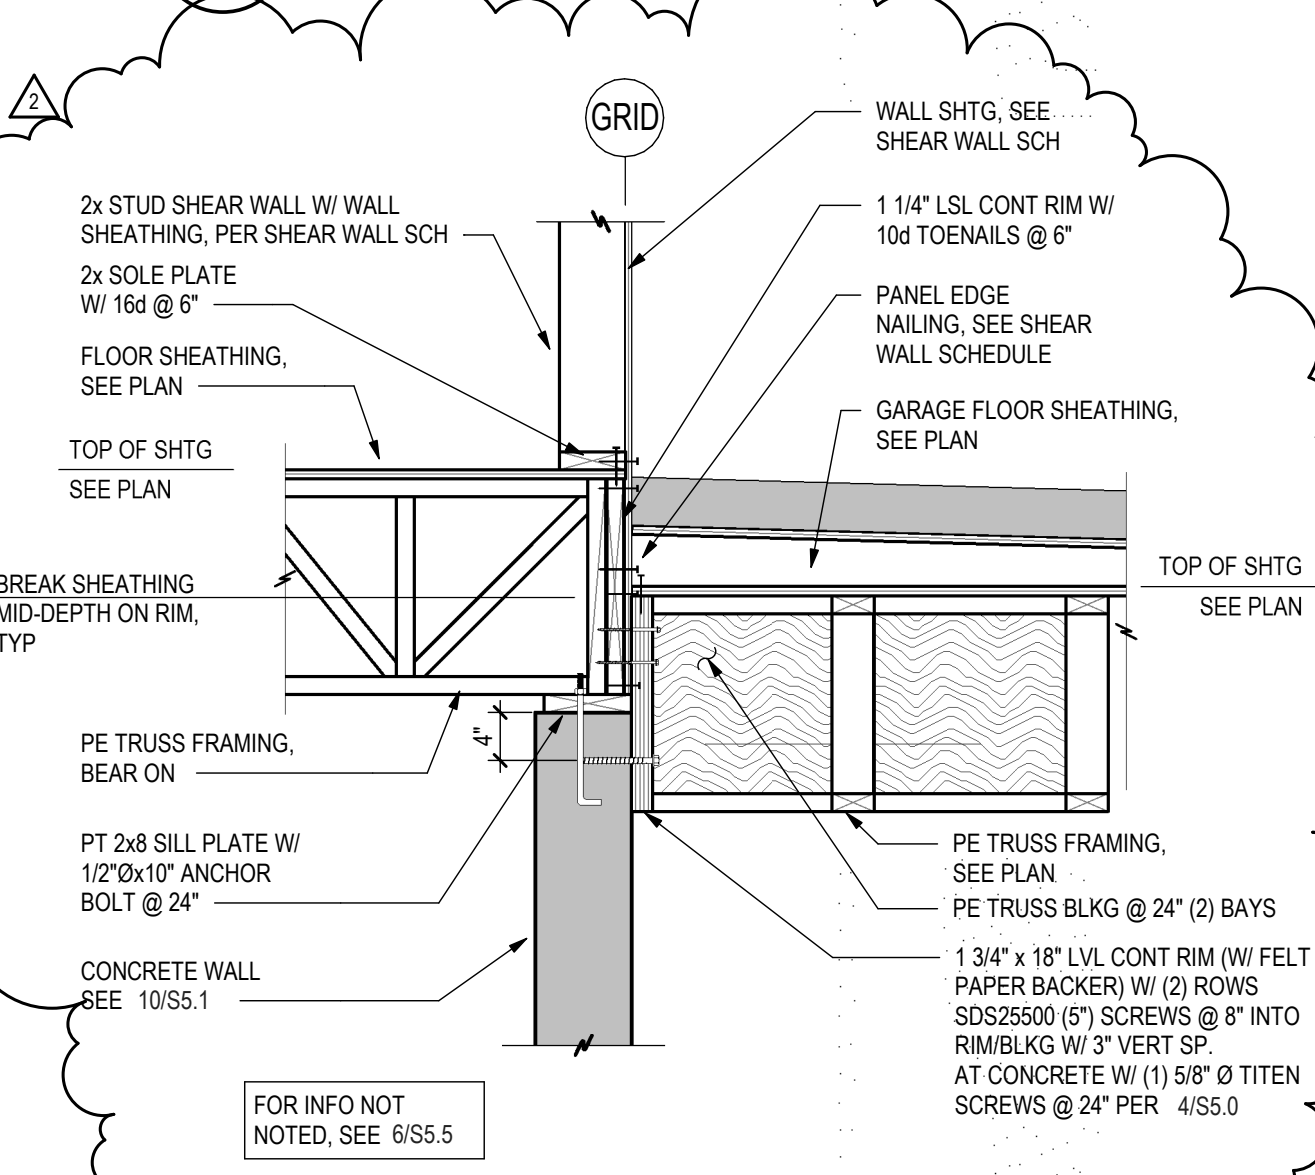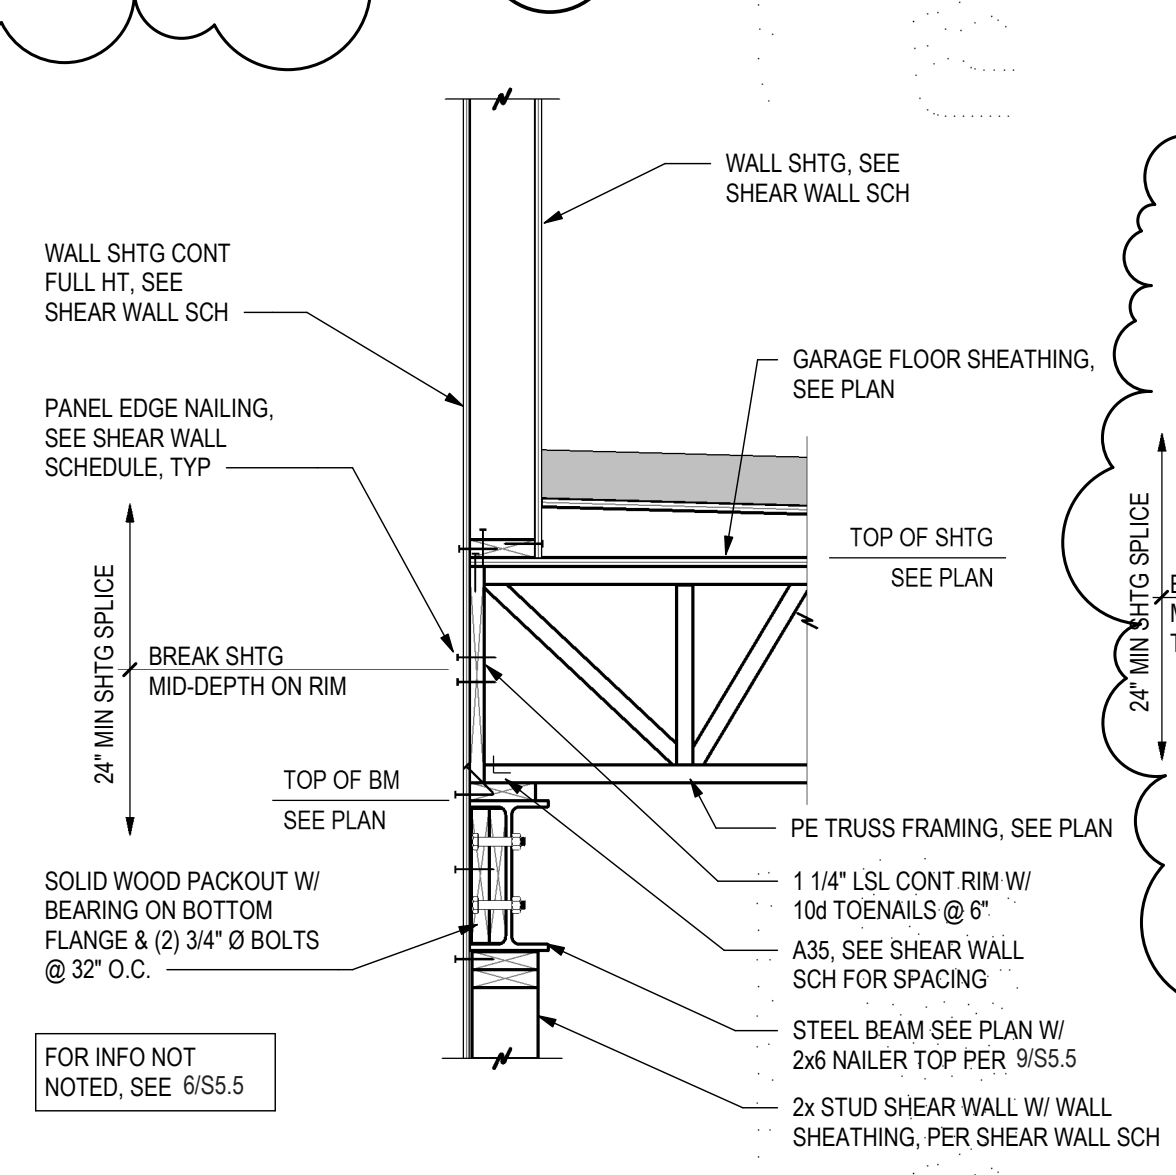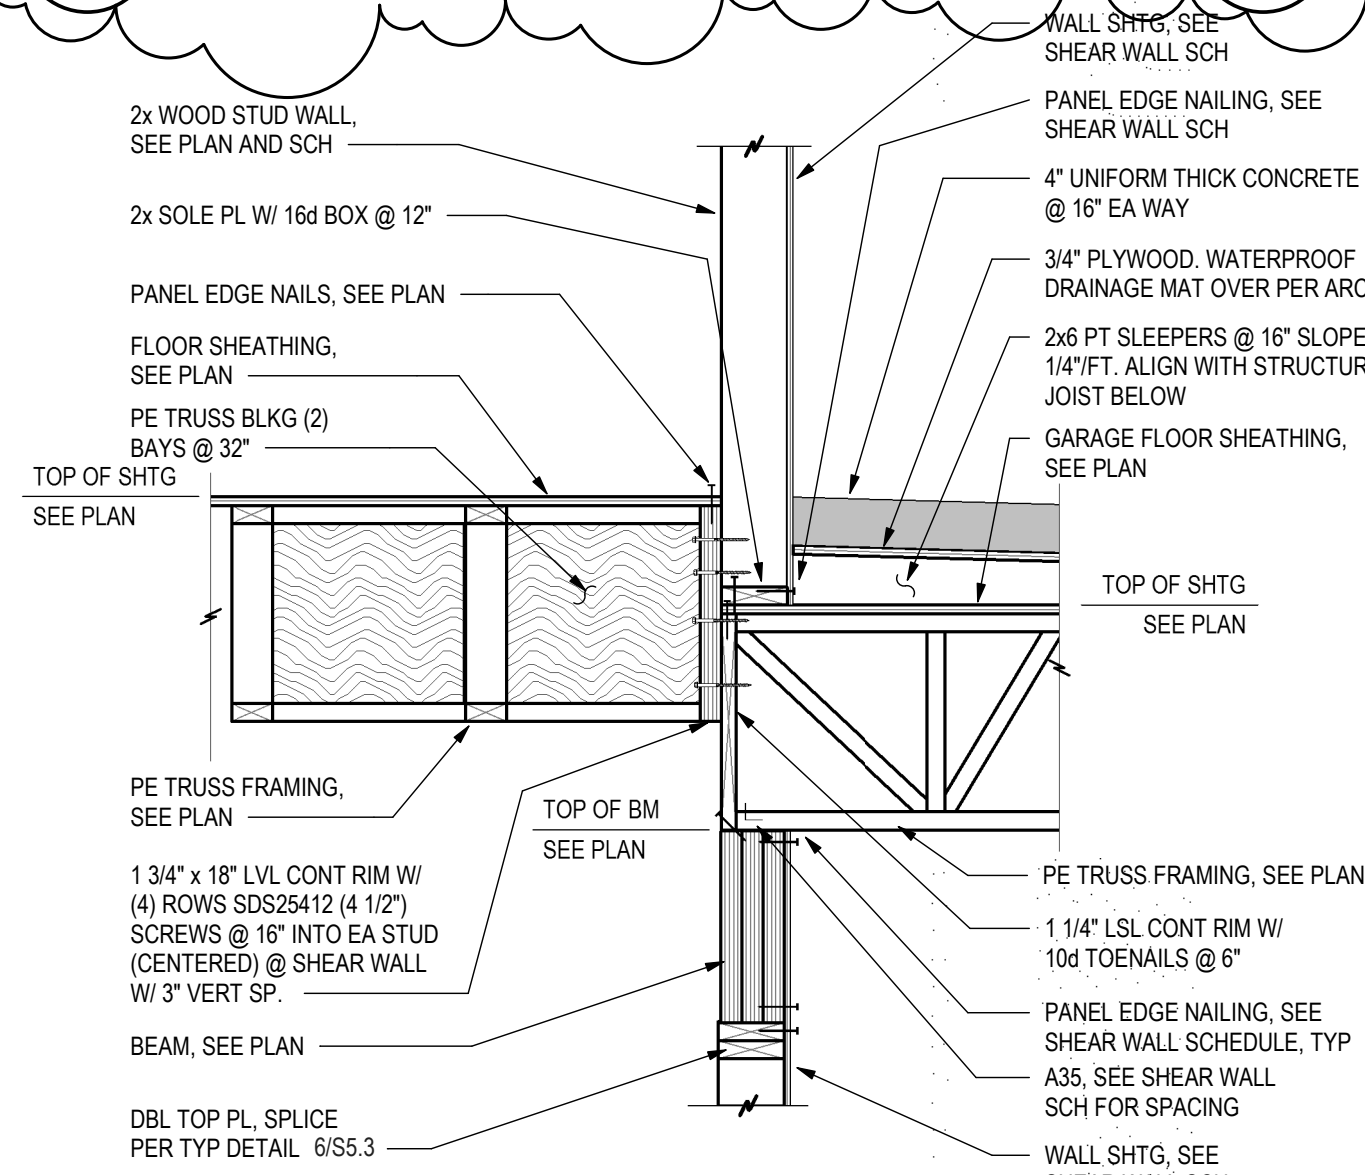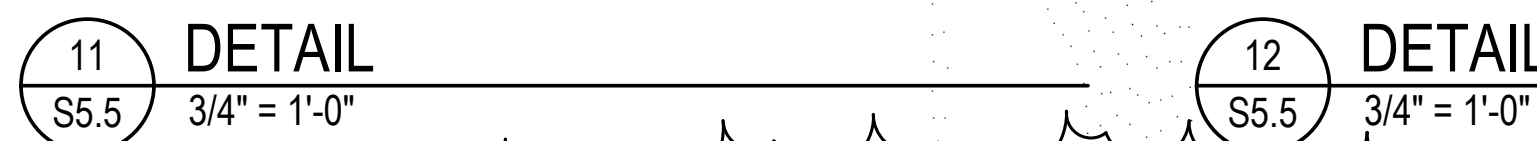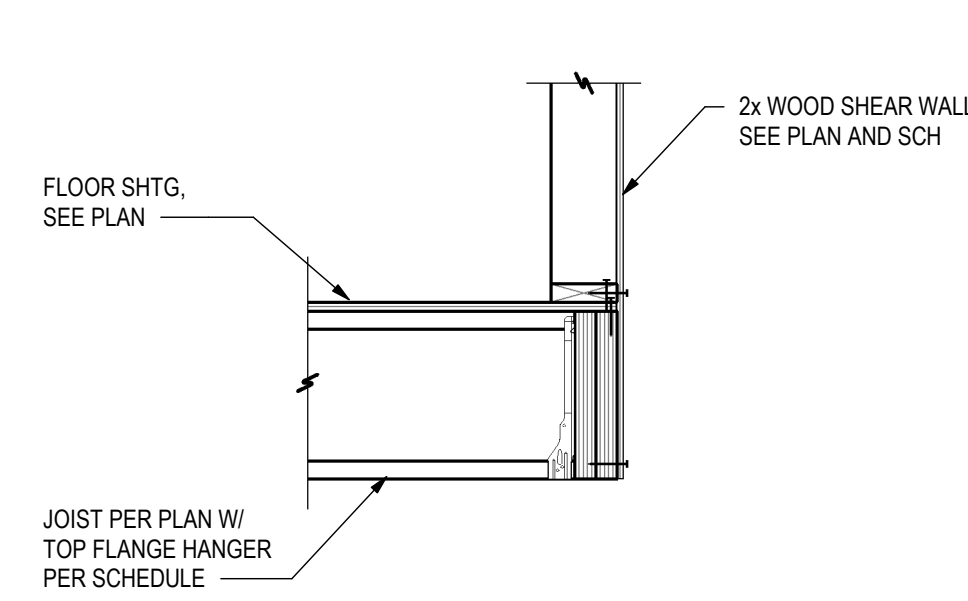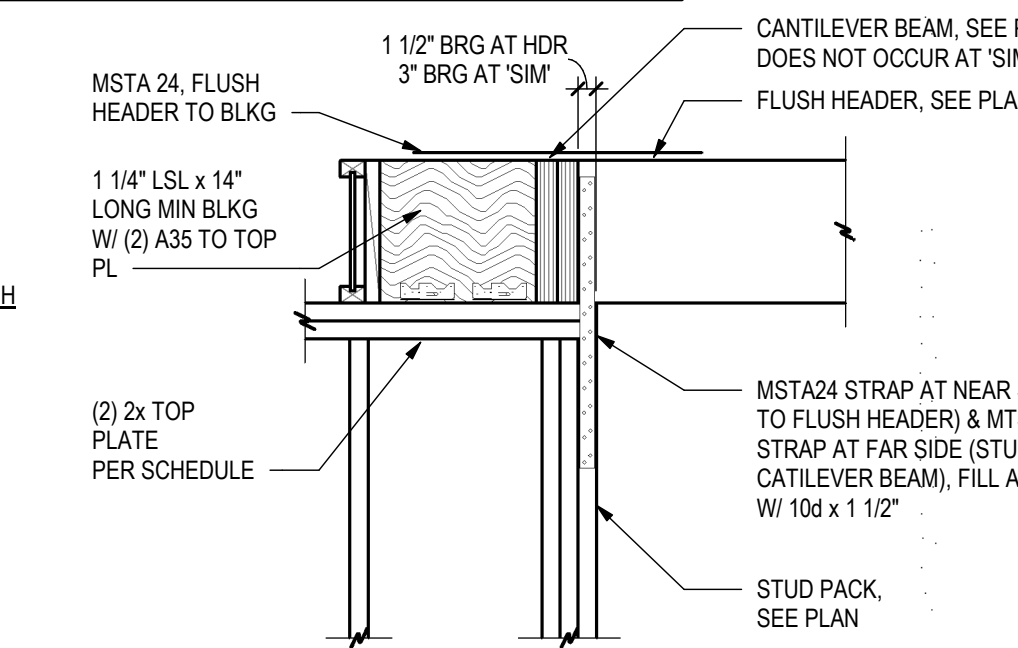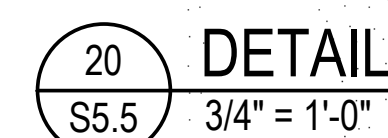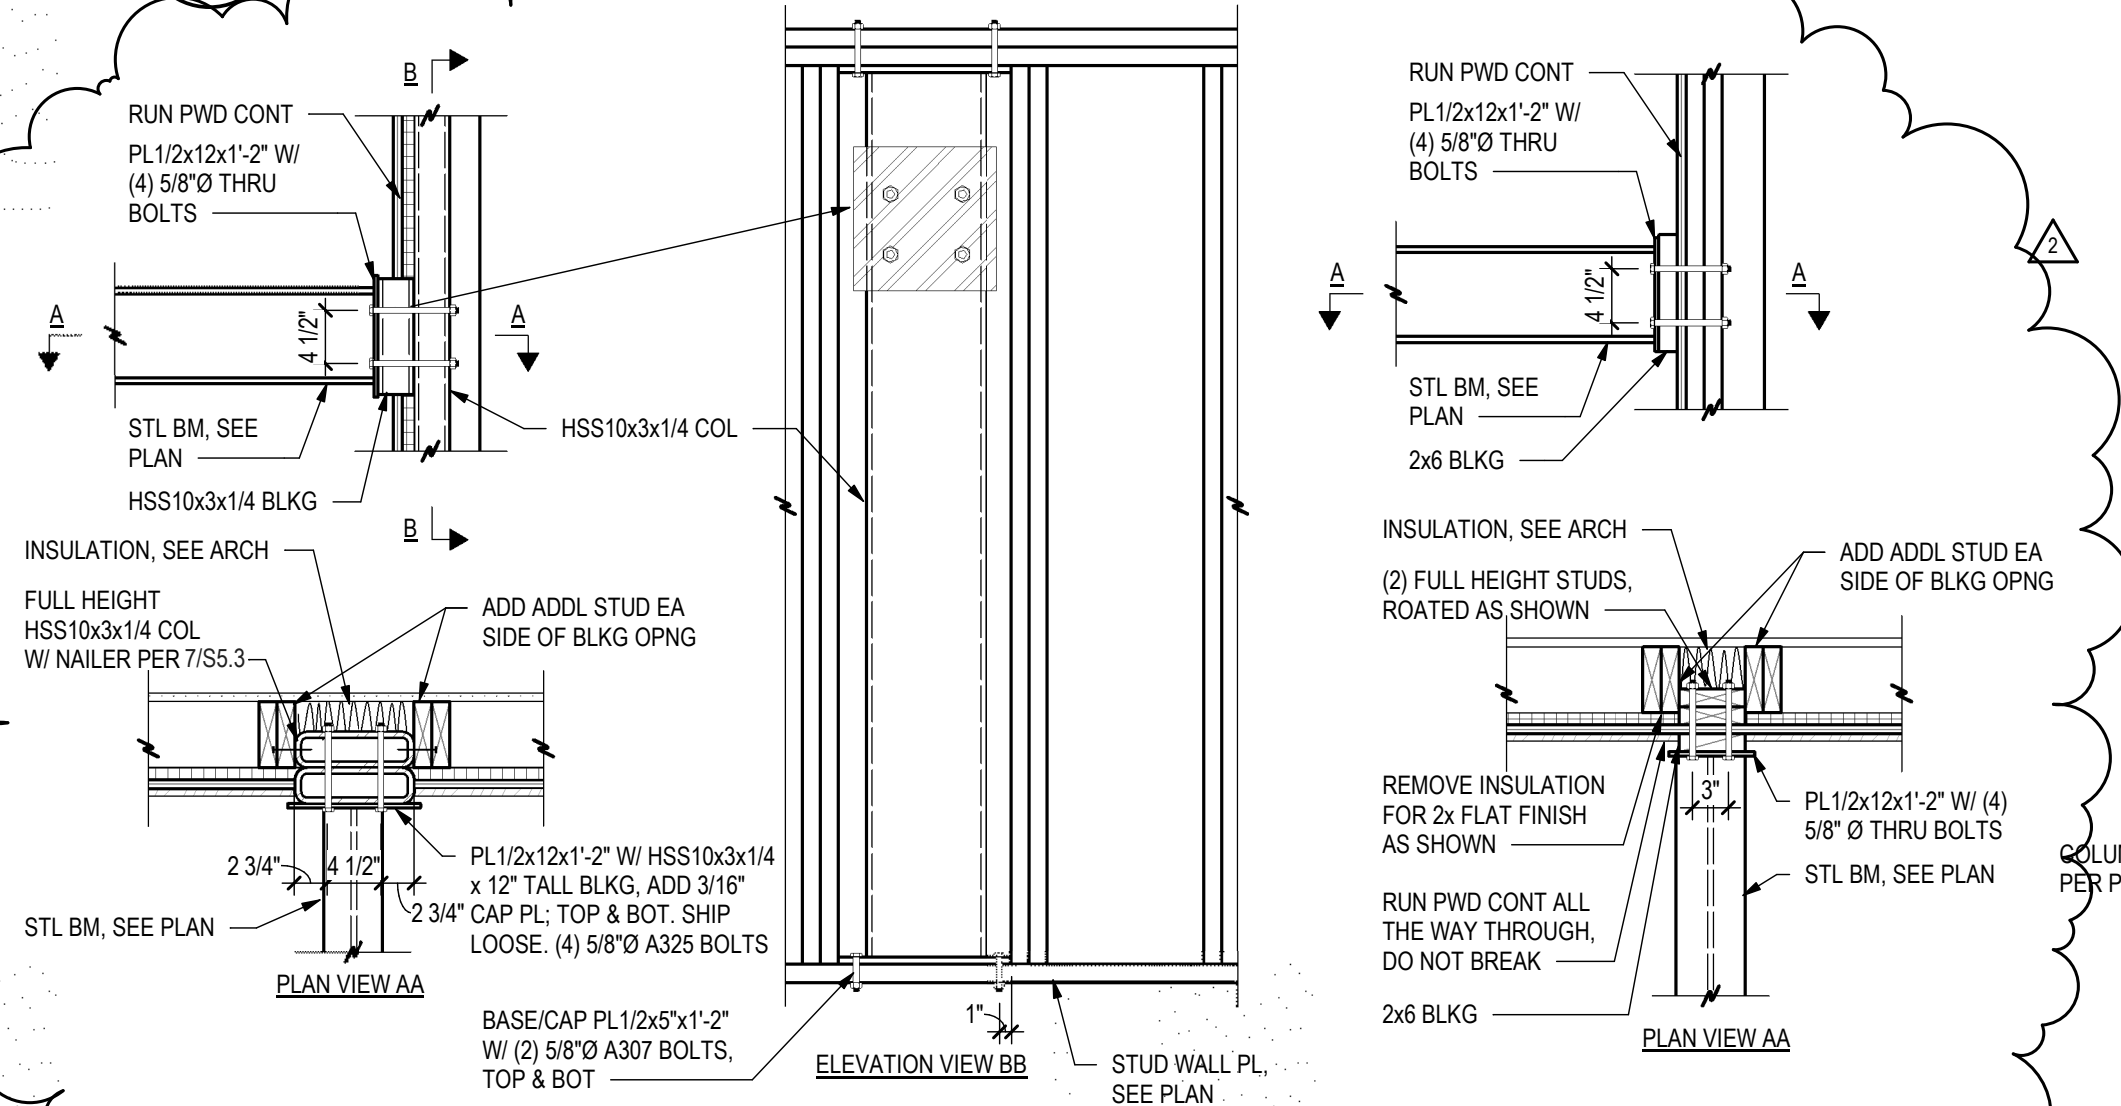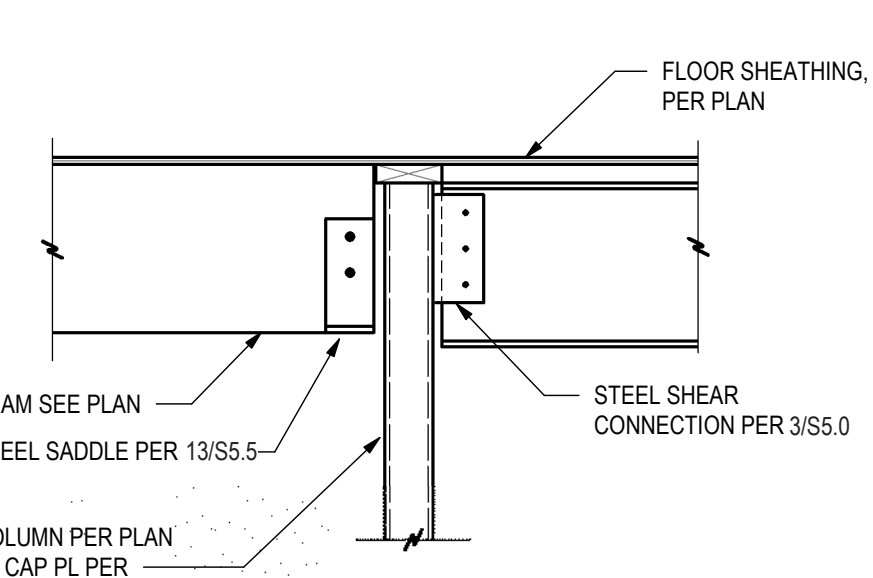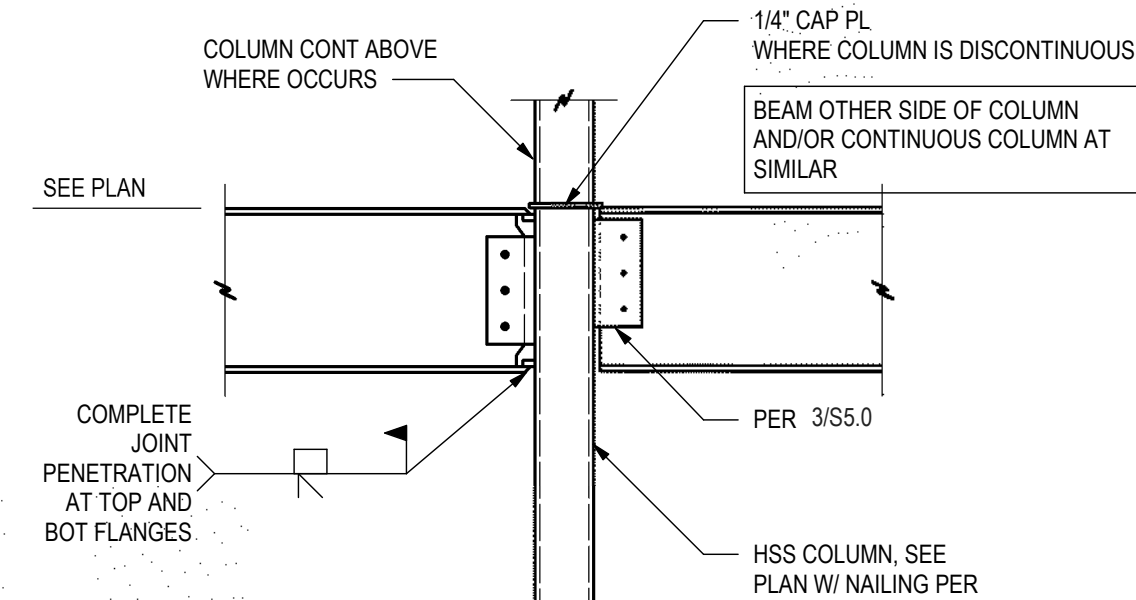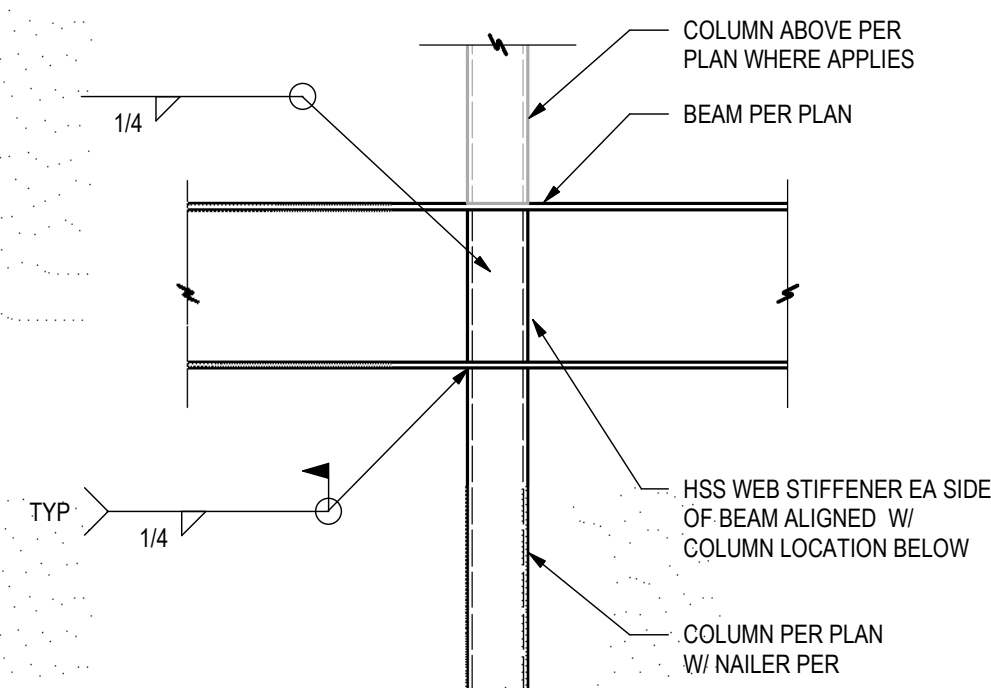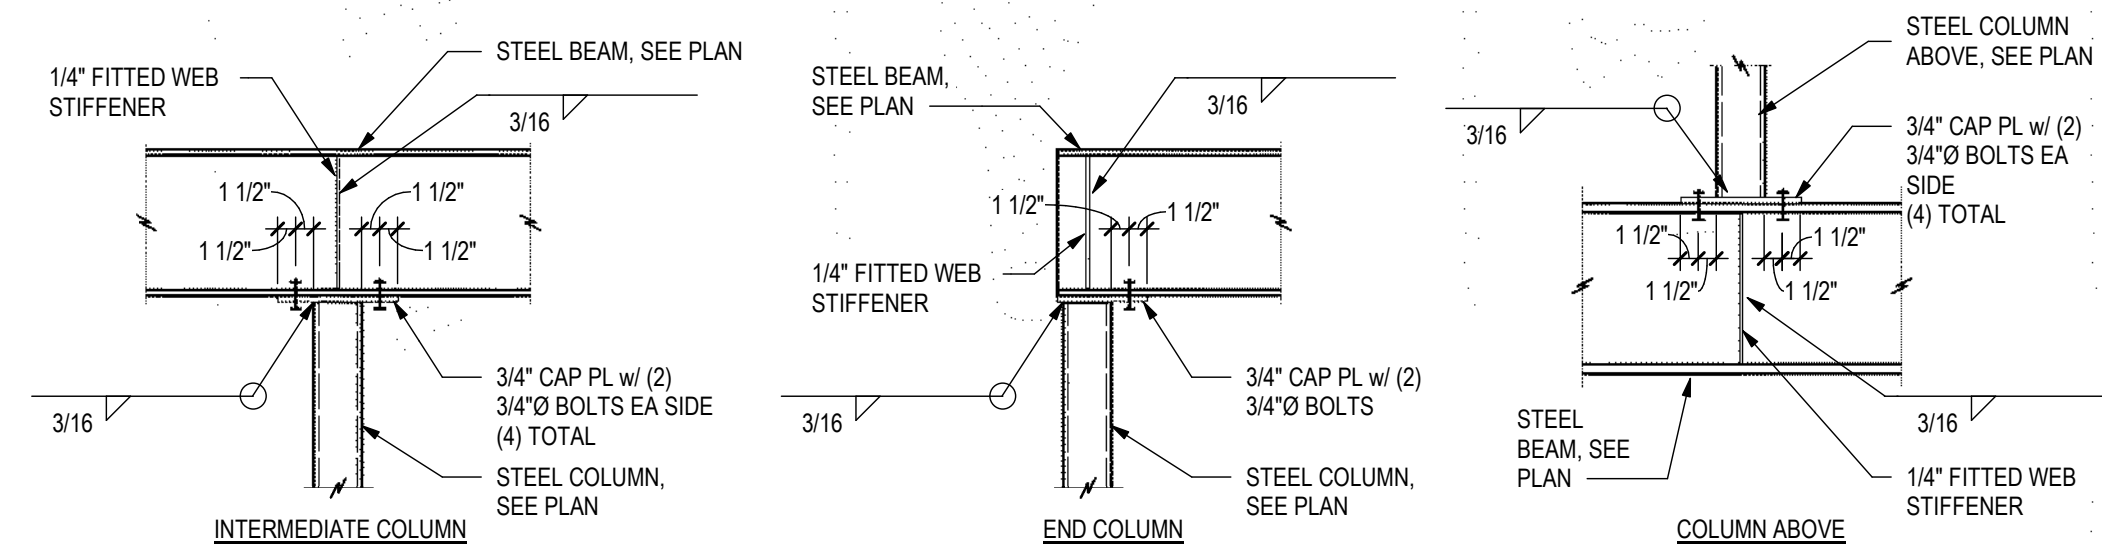

ARCHITECTURE
PLANNING
LANDSCAPE
INTERIORS

Copyright VERTICAL ARTS, INC.
All Rights Reserved

This document, and the ideas and designs incorporated herein, as an instrument of professional service, is the property of Vertical Arts, Inc. and is not to be used, in whole or in part, for any other project without the written authorization from a principal of Vertical Arts, Inc.

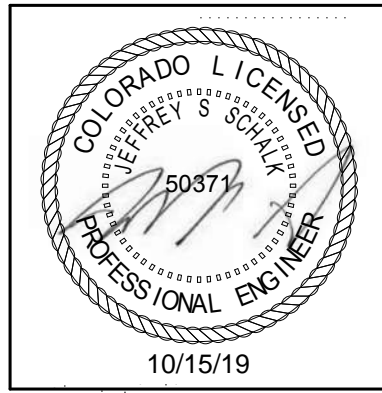

CAMPBELL RESIDENCE
Lot 5 - Eagle's Vista
Steamboat Springs, CO 80487
1907

[illegible]

| | |
|---------------|--|
| DRAWING TITLE | |
|---------------|--|



FRAMING DETAILS

[illegible]

SHEET NO.

S5.5

0/15/2019 11:15:20 AM

