




## FOUNDATION 3D - EAST ELEVATION

NO SCALE

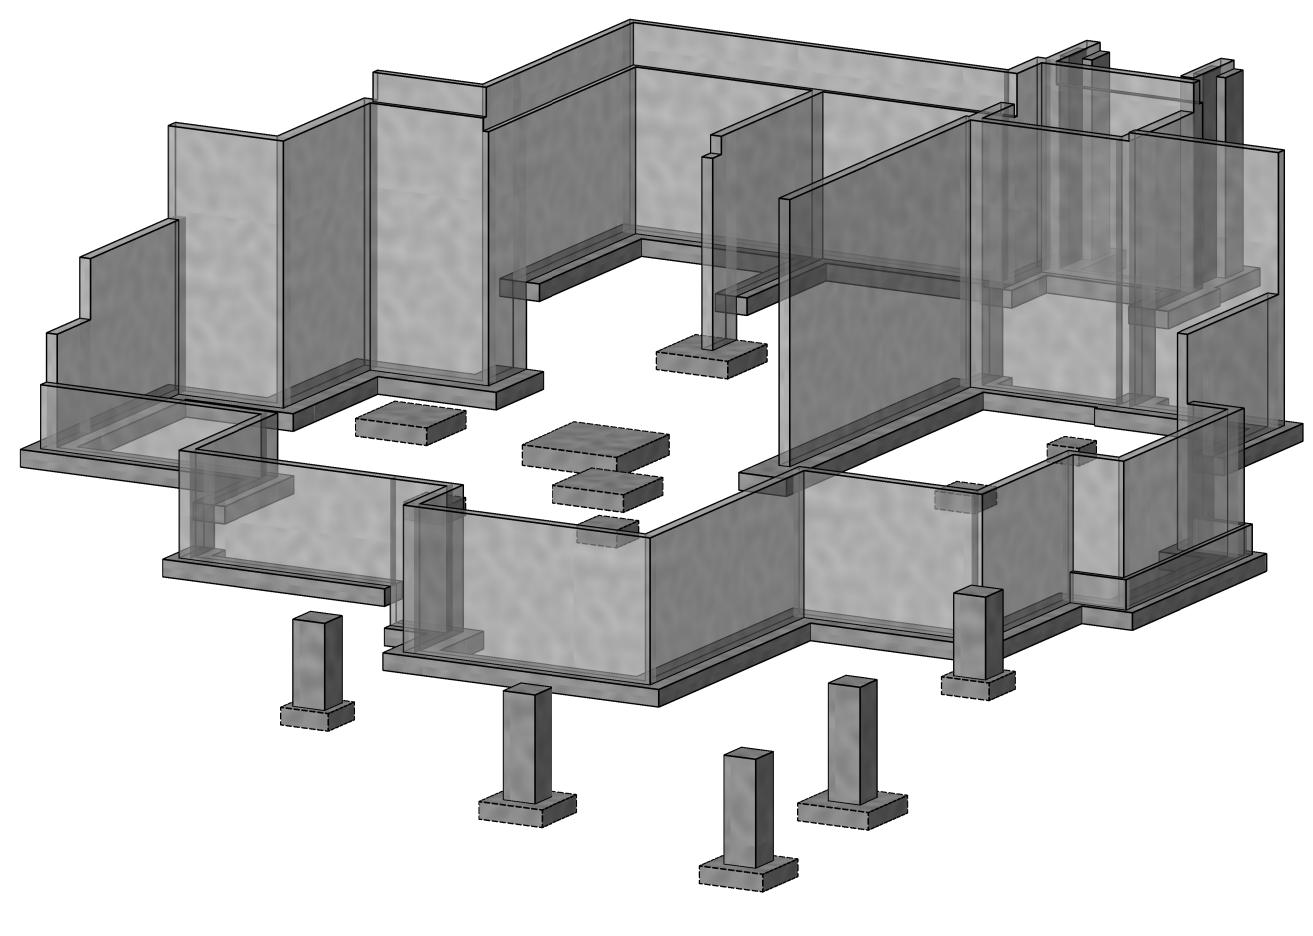


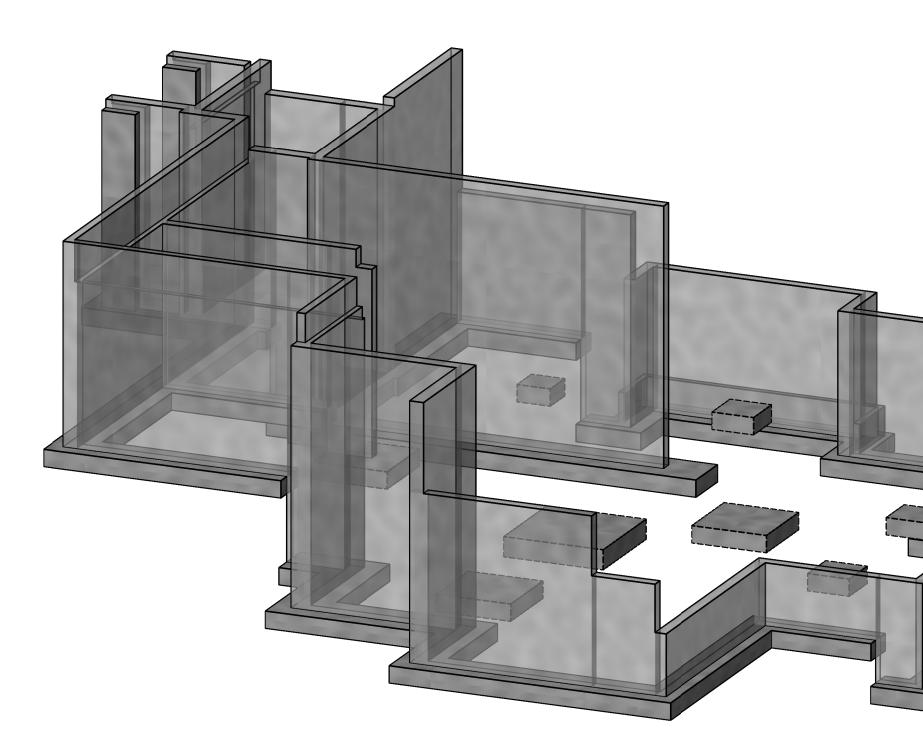

## FOUNDATION 3D - NORTH ELEVATION NO SCALE

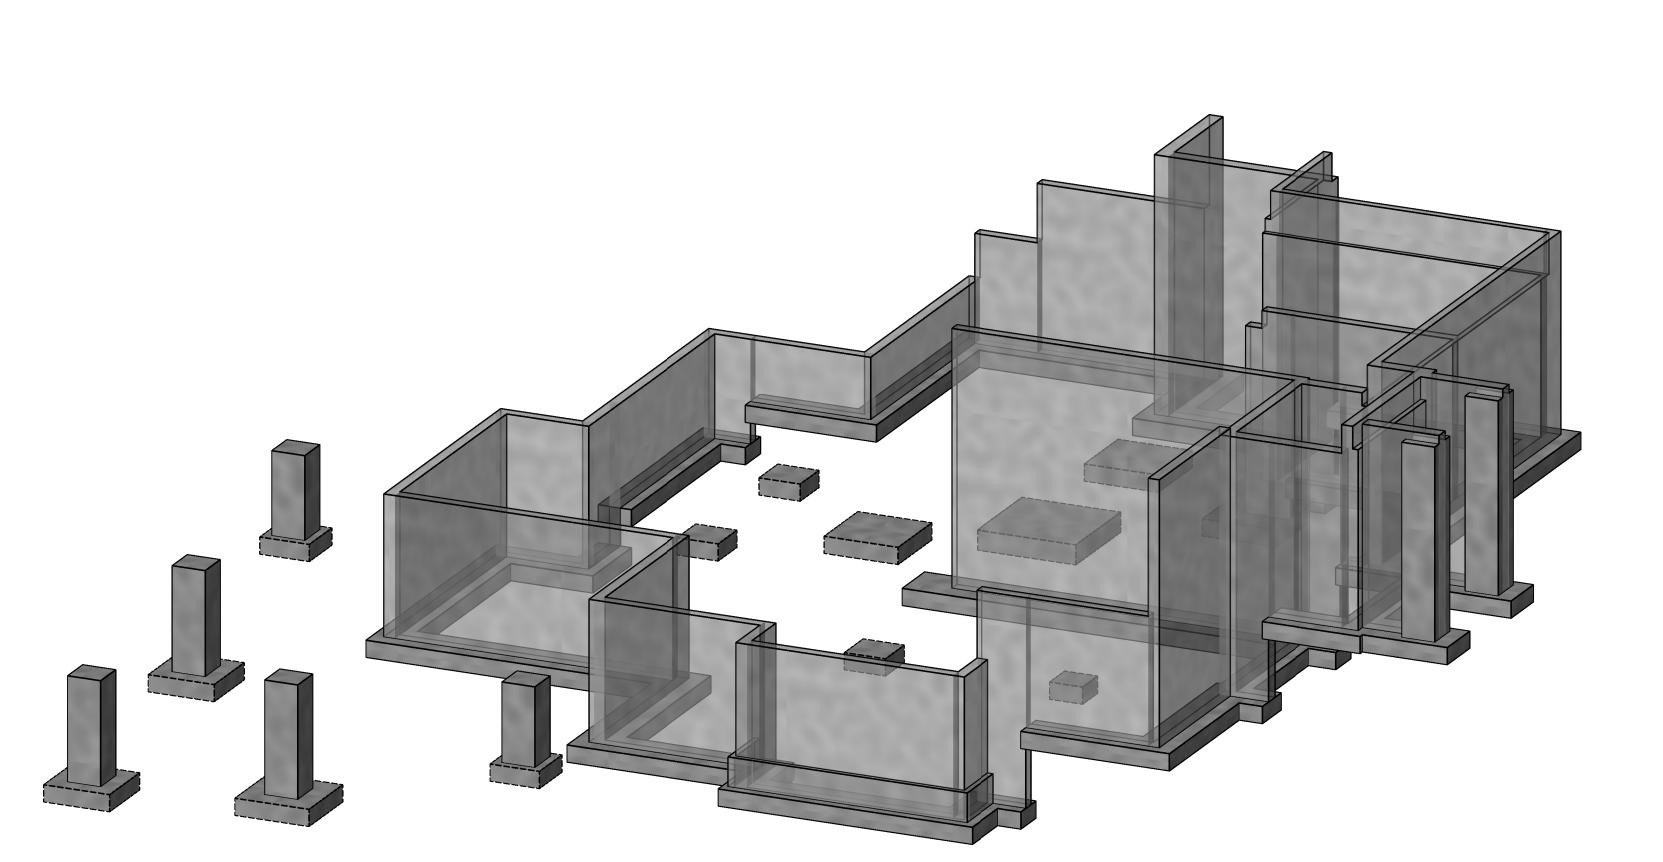


FOUNDATION 3D - SOUTH ELEVATION NO SCALE

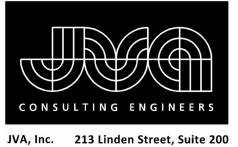


Fort Collins, CO 80524 970.225.9099 www.jvajva.com Boulder ● Fort Collins ● Winter Park Glenwood Springs ● Denver JVA #19872




ARCHITECTURE PLANNING LANDSCAPE INTERIORS

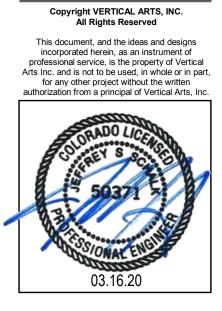


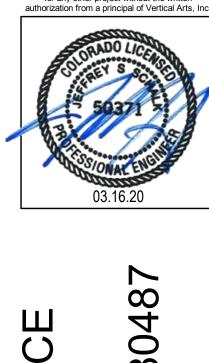

Vista CO 80487 RESIDENCE gle's Ś. Spring: 1907 AMPBE σ S Steambo: Ö Ú

ISSUE NAME	DATE
FOUNDATION 3D	10/16/19
DRAWING TITL	.E
3D FOUNDA VIEWS	
SHEET NO.	
S0.2	2

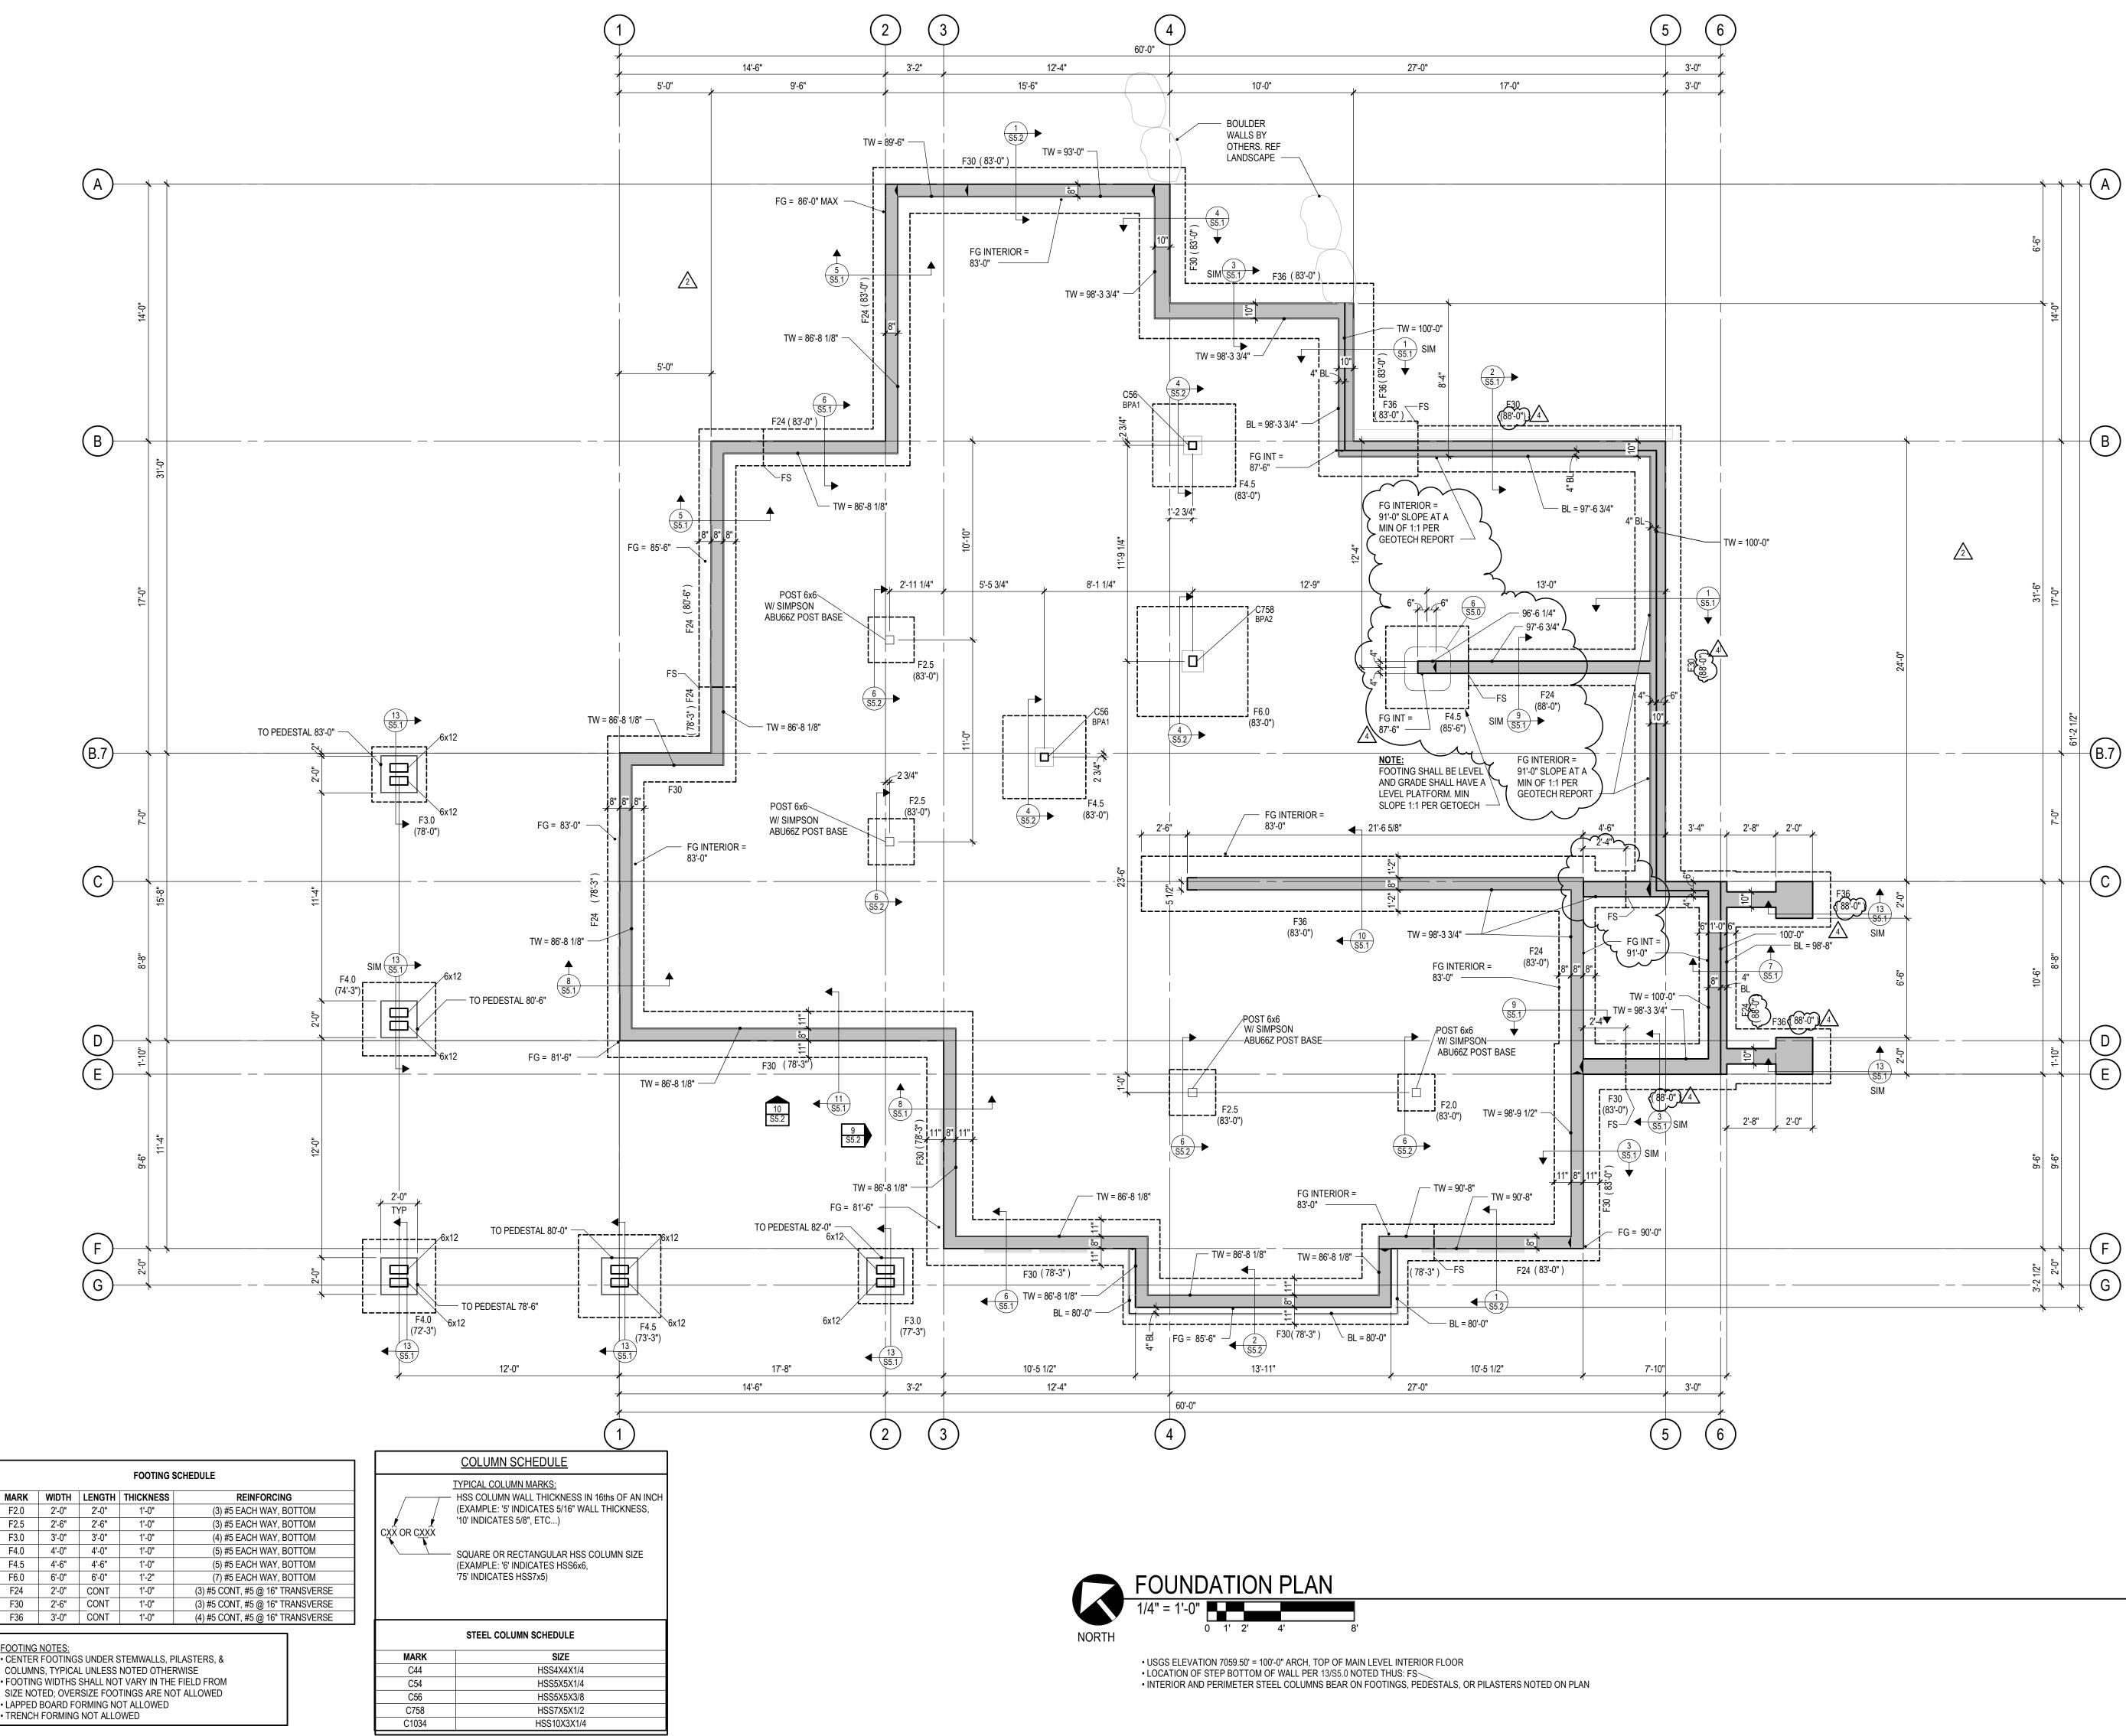

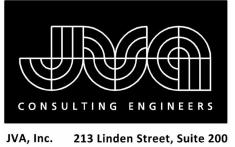

Fort Collins, CO 80524 970.225.9099 www.jvajva.com Boulder • Fort Collins • Winter Park JVA #19872




ARCHITECTURE PLANNING LANDSCAPE INTERIORS



Vista CO 80487 RESIDENCE  $\mathbf{O}$ gle's S oring 907 Ω 0 <del>~</del> S AMPBE S σ Steambo ot  $\mathbf{O}$ 

ISSUE NAME	DATE
BUILDING PERMIT PERMIT RE-SUBMITTAL	08/23/2019 10/2/19
VE REVISIONS	10/15/2019
FOUNDATION REVISIONS	03/13/2020
DRAWING TITL	.E
FOUNDATION	I PLAN
SHEET NO.	
S2.	1
	-

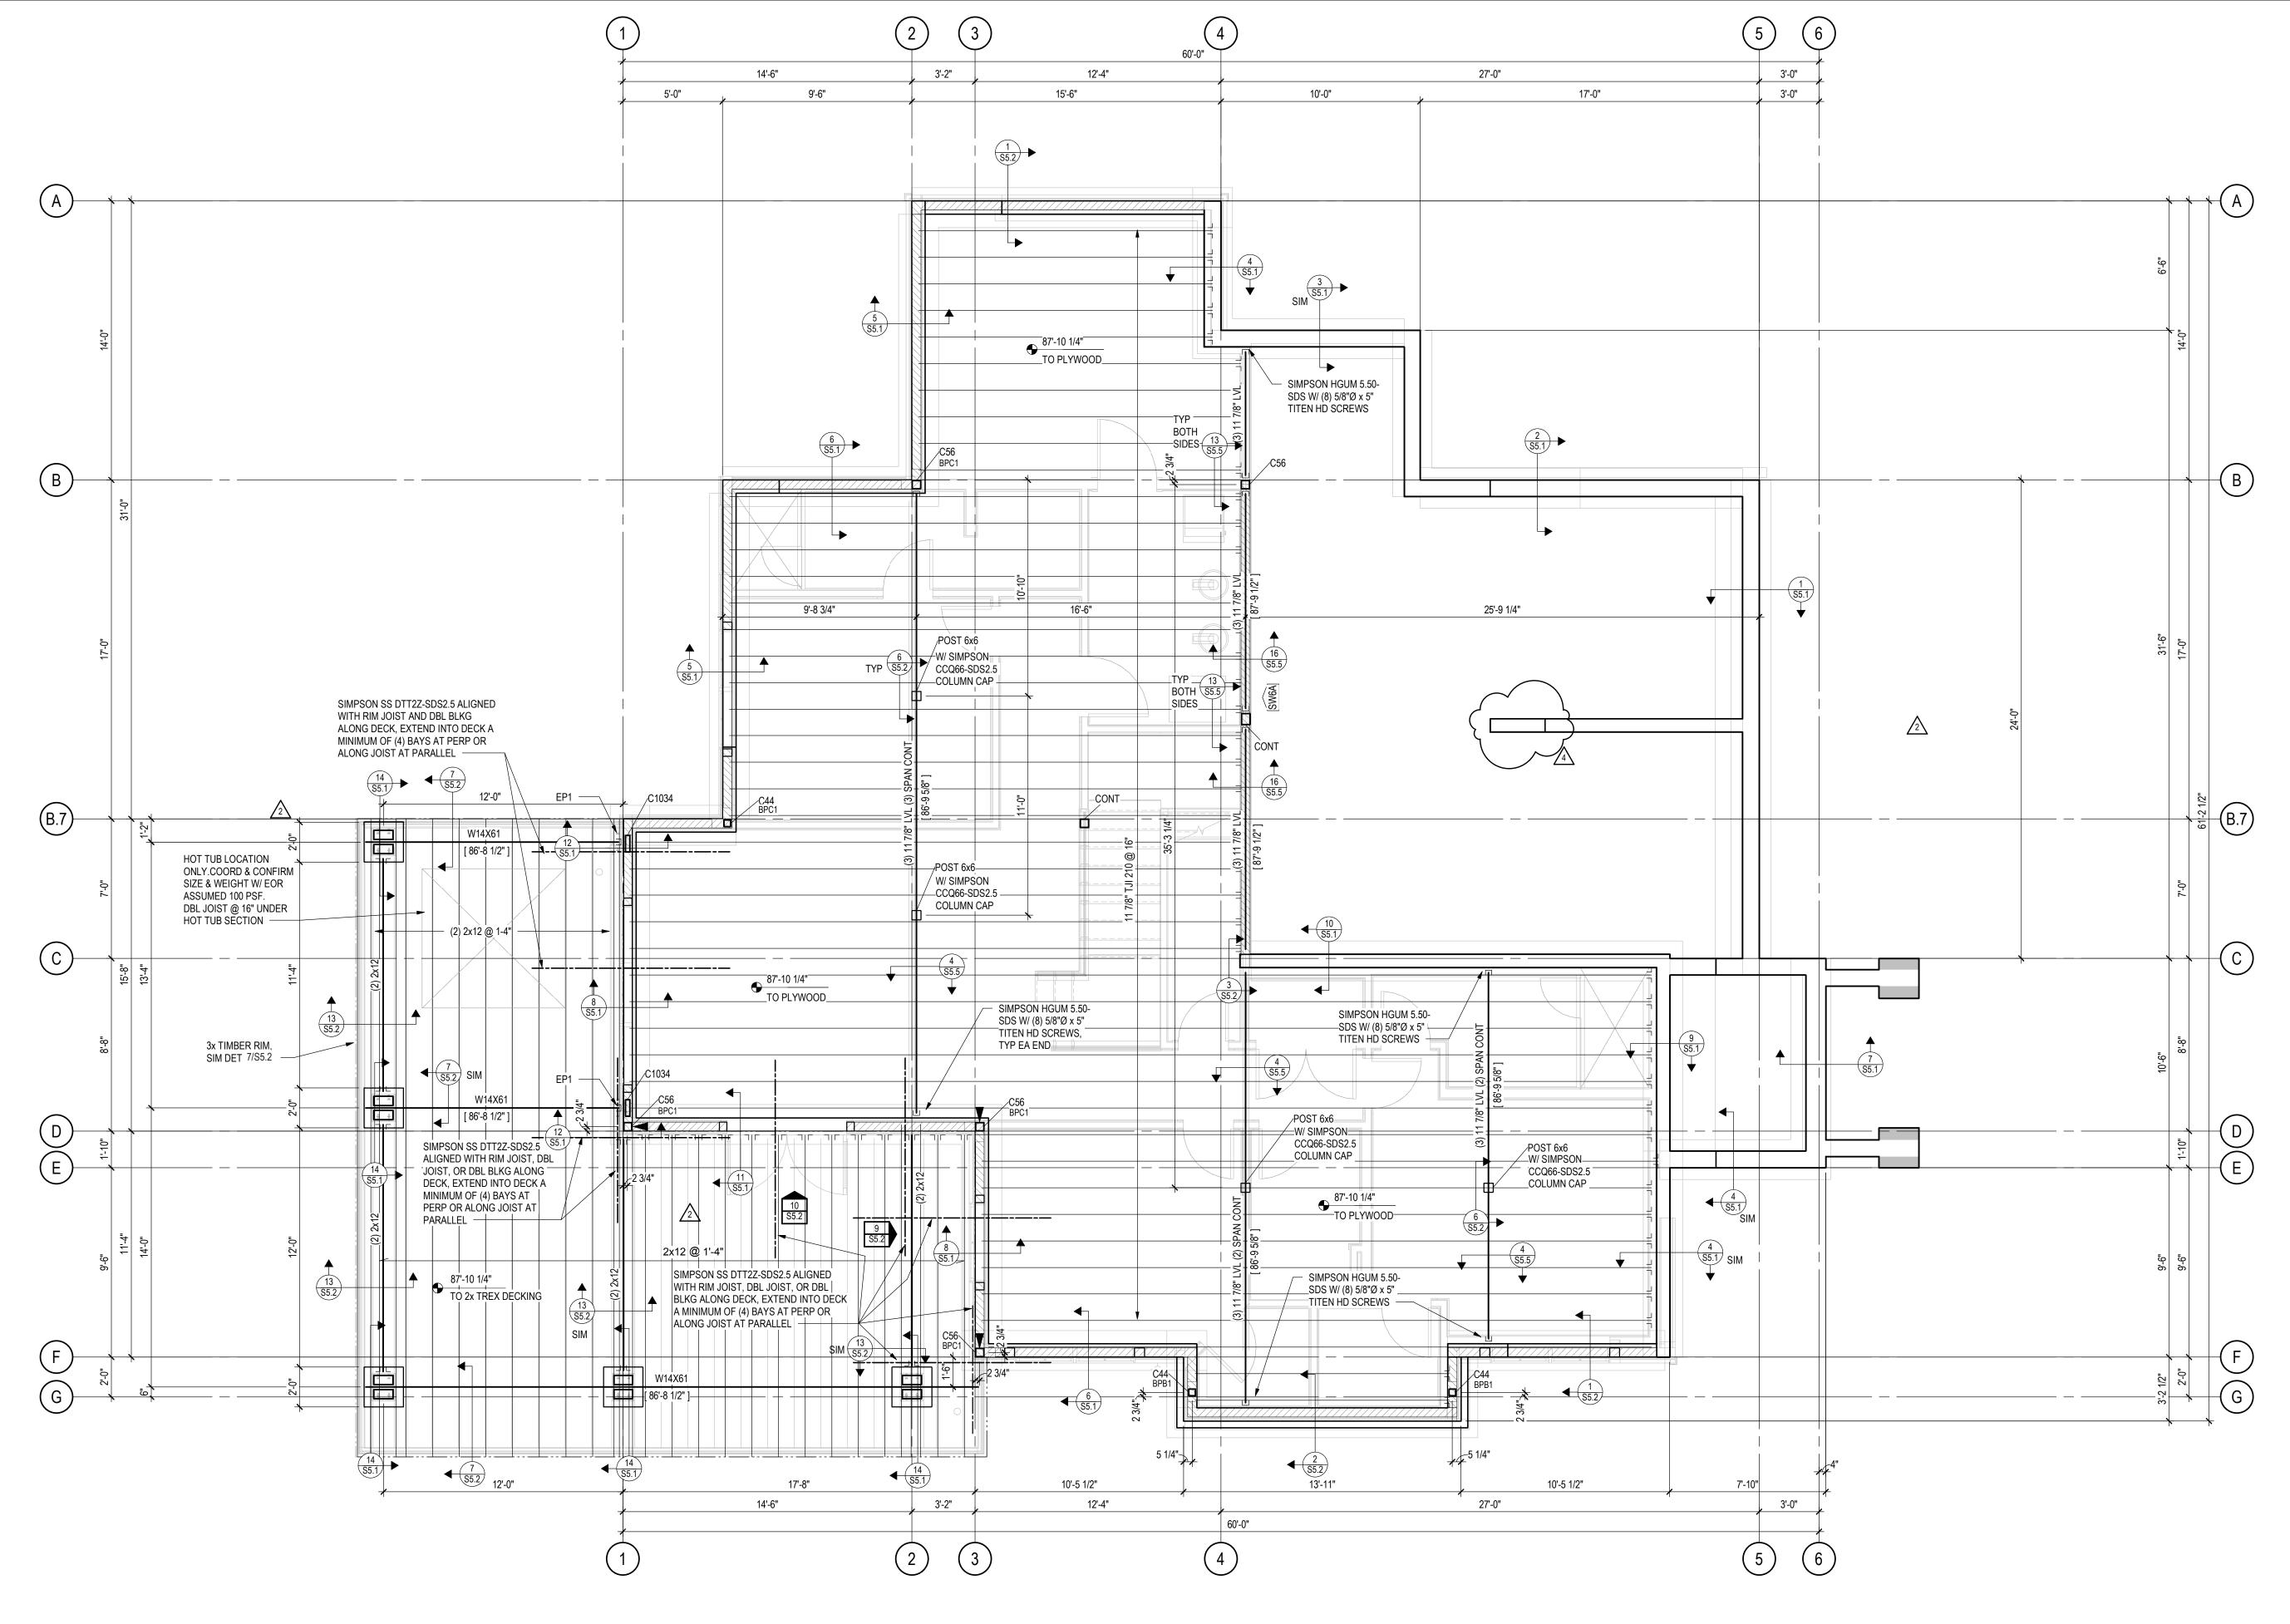

HOLDOWNS: ∕HDX HOLDOWNS ARE INDICATED ON PLAN THUS:
 HOLDOWNS INDICATED ARE LOCATED AT THE FLOOR LEVEL • SEE HOLDOWN SCHEDULE ON SHEET S5.3

 TYPICAL WOOD FRAMED WALLS & WALL SHEATHING:

 • ALL EXTERIOR WALLS HATCHED THUS:

 SW6

 2x6 @ 16

STUD SHEAR WALLS SHEATHED WITH ZIP SYSTEM R-6 SHEATHING OR EQUIVALENT (7/16" APA LAMINATED TO 1" RIGID INSULATION) NAILED WITH 10d SHANK (0.131"Øx3") @ 3" AT PANEL EDGES AND 12" IN FIELD OF PANEL BLOCK AND NAIL ALL EDGES BETWEEN STUDS • ALL INTERIOR WALLS HATCHED THUS: STUD SHEAR WALLS SHEATHED WITH 15/32" APA NAILED WITH 8d COM (0.131"Øx2 1/2") @ 6" AT PANEL EDGES AND 12" IN FIELD OF PANEL; BLOCK AND NAIL ALL EDGES BETWEEN STUDS; EXPOSED SURFACE TO BE NAILED CAREFULLY FOR FINISHED APPEARANCE • ALL INTERIOR WALLS HATCHED THUS: W4 ARE 2x4 @ 16" STUD BEARING WALLS. W6 ARE 2x6 @ 16" STUD BEARING WALLS

## LOWER LEVEL FRAMING PLAN 1/4" = 1'-(

TYPICAL FLOOR SHEATHING: 3/4" STURD-I-FLOOR, APA RATED 24" O.C. TONGUE & GROOVE SHEATHING GLUED AND NAILED WITH 8d NAILS (0.113"Ø x 2 3/8") @ 6" ALONG PANEL EDGES AND @ 12" ALONG INTERMEDIATE FRAMING MEMBERS. LAY PANELS PERPENDICULAR TO FRAMING MEMBERS AND STAGGER PANEL JOINTS.

• ALL BEAMS ARE FLUSH, UNLESS NOTED OTHERWISE ON PLAN

• ALL HEADERS ARE FLUSH, UNLESS NOTED OTHERWISE ON PLAN

NORTH

0 1' 2' 4'

 ALL COLUMNS ARE BELOW • ALL EXTERIOR HEADERS ARE (3) 2x10 HEADERS UNLESS NOTED OTHERWISE ON PLAN

- 8'

• ALL INTERIOR HEADERS ARE (3) 2x8 UNLESS NOTED OTHERWISE ON PLAN




Fort Collins, CO 80524 970.225.9099 www.jvajva.com Boulder • Fort Collins • Winter Park JVA #19872





ARCHITECTURE PLANNING LANDSCAPE INTERIORS



Vista CO 80487 SIDENCE  $\mathbf{O}$ agle's vrings, 907 ШК **D** <del>C</del> Ш S AMPBE S σ Lot Steamboa  $\mathbf{O}$ 

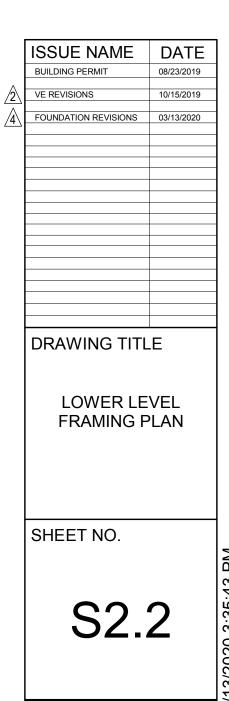

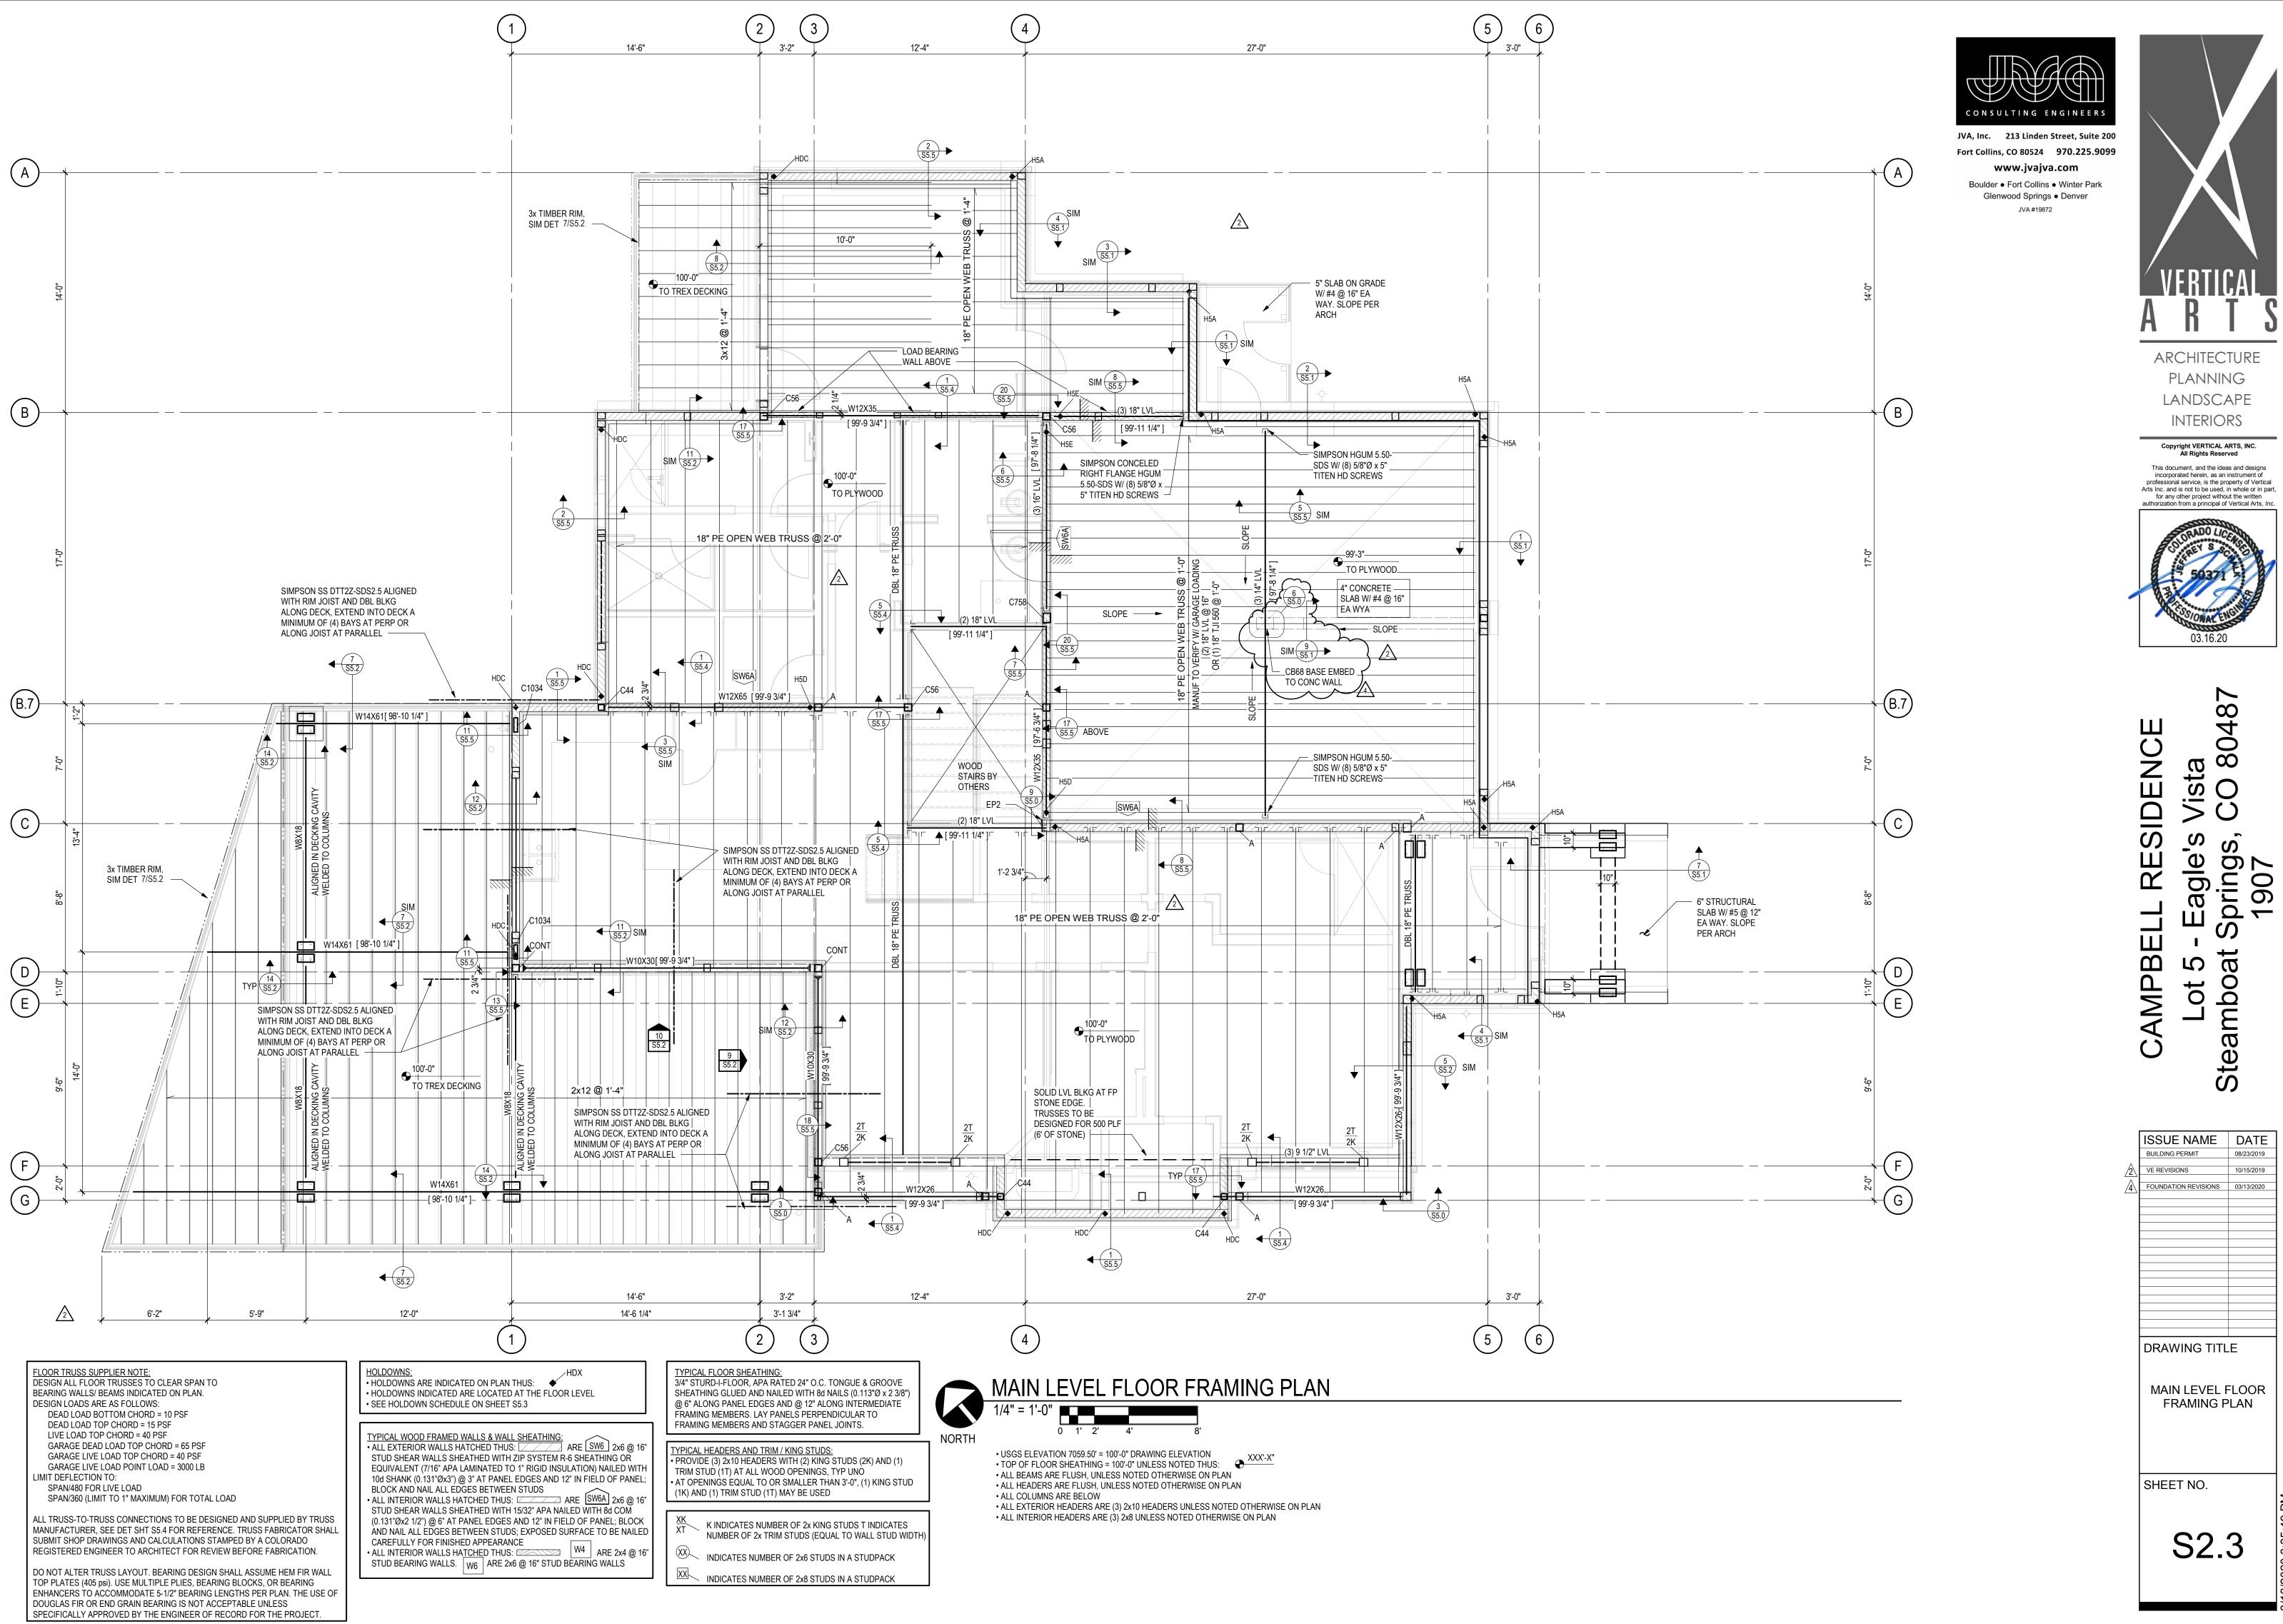

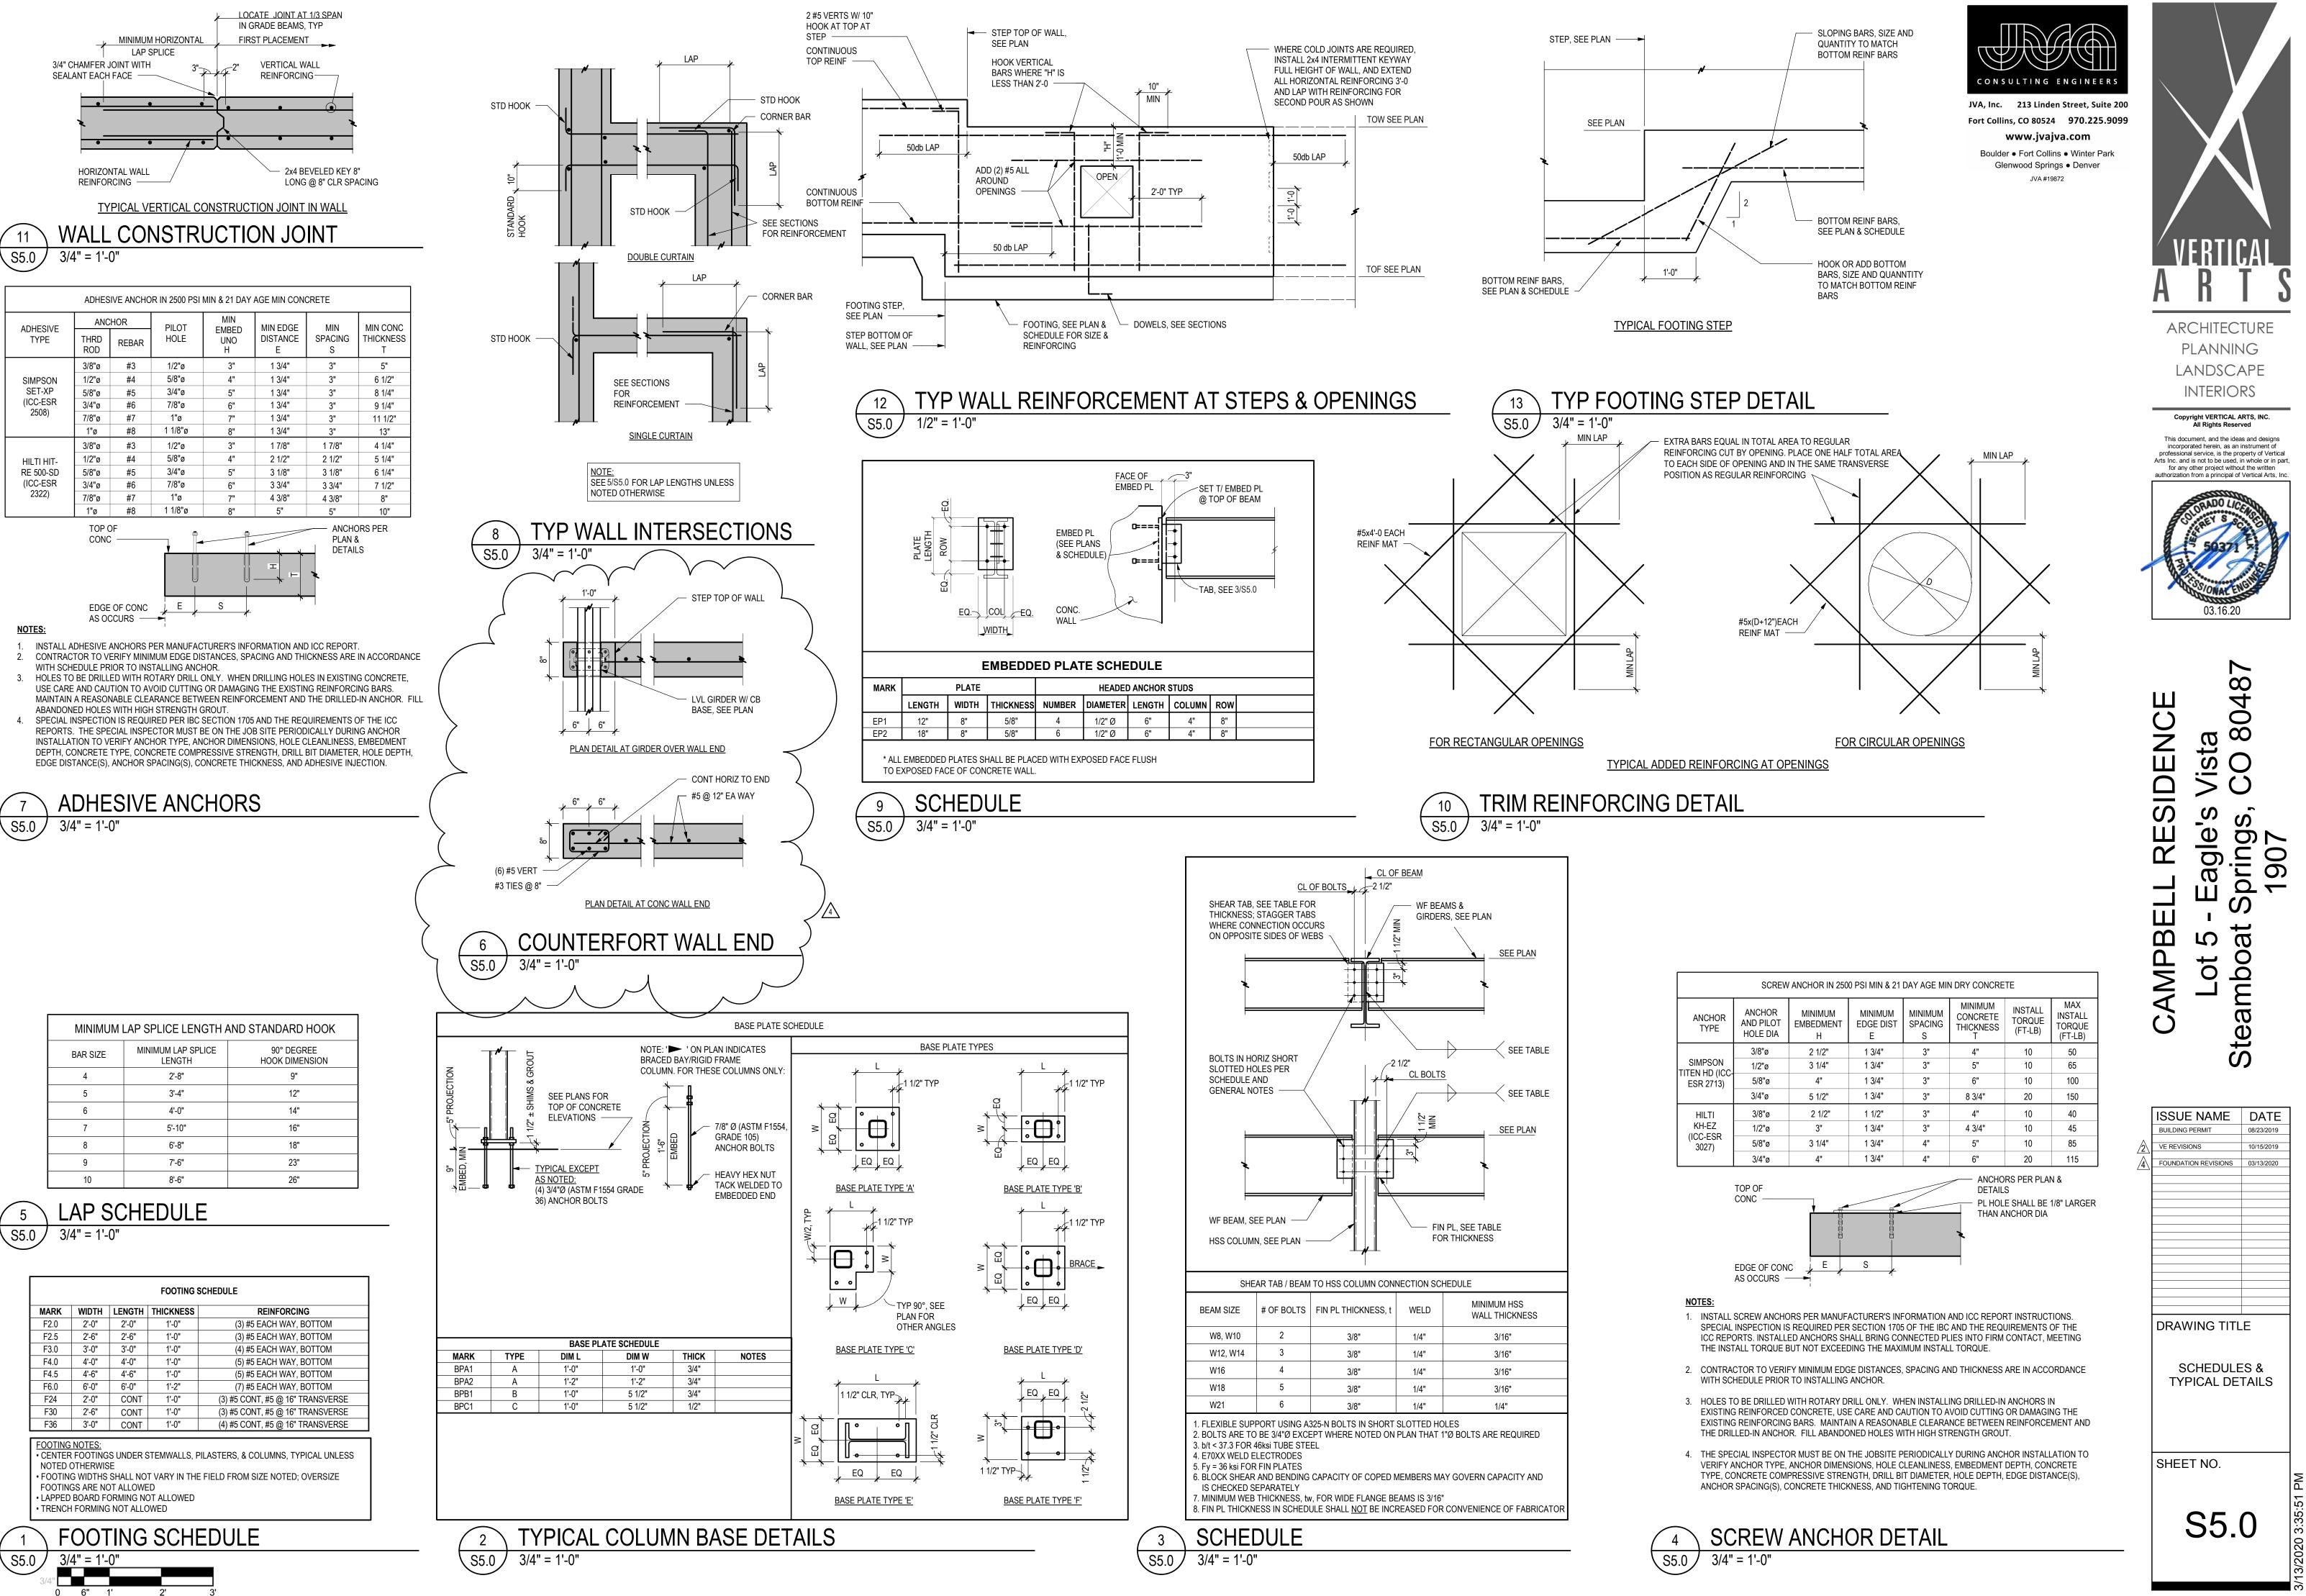

BAR SIZE	MINIMUM LAP SPLICE LENGTH	90° DEGREE HOOK DIMENSION			
4	2'-8" 9"				
5	3'-4" 12"				
6	4'-0" 14"				
7	5'-10" 16"				
8	6'-8" 18"				
9	7'-6" 23"				
10	8'-6" 26"				



FOOTING SCHEDULE				
MARK	WIDTH	LENGTH	THICKNESS	REINFORCING
F2.0	2'-0"	2'-0"	1'-0"	(3) #5 EACH WAY, BOTTOM
F2.5	2'-6"	2'-6"	1'-0"	(3) #5 EACH WAY, BOTTOM
F3.0	3'-0"	3'-0"	1'-0"	(4) #5 EACH WAY, BOTTOM
F4.0	4'-0"	4'-0"	1'-0"	(5) #5 EACH WAY, BOTTOM
F4.5	4'-6"	4'-6"	1'-0"	(5) #5 EACH WAY, BOTTOM
F6.0	6'-0"	6'-0"	1'-2"	(7) #5 EACH WAY, BOTTOM
F24	2'-0"	CONT	1'-0"	(3) #5 CONT, #5 @ 16" TRANSVERSE
F30	2'-6"	CONT	1'-0"	(3) #5 CONT, #5 @ 16" TRANSVERSE
F36	3'-0"	CONT	1'-0"	(4) #5 CONT, #5 @ 16" TRANSVERSE

