LOOSE LINTELS:

0'-8" to 4'-0" L3 1/2x3 1/2x1/4 4'-1" to 5'-4" L5x3 1/2x1/4 (LLV)

5'-5" to 10'-0" L6x3 1/2x5/16 (LLV)

Jnless noted otherwise, provide loose lintels as follows: (one angle for each 4" of wall thickness to bear 4" minimum each end)

PRECAUTIONARY NOTES ON STRUCTURAL BEHAVIOR:

Interior architectural finish detailing must accommodate the relative differential movements of supporting structural elements. Where the roof framing element spans are long, applied loading will naturally cause substantial deflection. Interior elements hung from the roof structure will deflect with the roof.

The floor is a floating concrete slab-on-grade and may experience movements independent of the structural foundations. Interior elements supported on the slab-on-grade floor will move with the floor. Interior elements supported on foundations and columns will not experience similar or measurable movements

Exterior/perimeter wall assemblies hung from the edge of the building structure will be directly affected (to some degree) by changes in

external temperature and floor deflection. Exterior/perimeter and interior architectural finish details should allow for relative movements between elements with different support

The foundation design shown assumes that the owner/builder is aware of the presence of expansive soils, and that he has read the previously referenced soils report. Use of these plans is indication that the owner/builder accepts the risks associated with building on this site, especially those related to slab on grade construction in finished areas. Anthem, LLC will not be held liable for damages caused by slab movement.

DEFERRED SUBMITTALS:

Portions of the structure have elements of proprietary design and fabrication, which shall be submitted by the supplier for approval after award These items shall conform to the load, capacity, size, geometry, connection, and support criteria noted on the structural drawings.

Shop drawings and calculations shall be prepared by an engineer registered in the State of Colorado. Final shop drawing submittals shall be Submittals will be reviewed by the structural engineer of record for compliance with the specified design requirements, stamped as

"Reviewed," and forwarded to the local building authority for review as required. Final issue of the building permit may, at the approval authority's option, be contingent on its approval of the deferred submittal documents. Deferred submittal items shall not be installed until their design calculations and drawings have been reviewed by the architect, structural engineer, and/or local building authority as required.

LETTERS OF CONSTRUCTION COMPLIANCE: The general contractor shall determine from the local building authority, at the time the building permit is obtained, whether any letters of construction compliance will be requested from the structural engineer. The contractor shall notify the structural engineer of all such requirements in writing prior to the start of construction.

Two day advance notice shall be given when requesting site visits necessary as the basis for the compliance letter. The general contractor shall provide copies of all third-party testing and inspection reports to the architect and structural engineer a minimum of

SPECIAL INSPECTIONS (valid for IBC 2018):

The following Special Inspections and Testing shall be performed by a qualified Special Inspector, retained by the Owner, in accordance with the following sections of IBC Chapter 17: Section 1704

one week prior to the date that the compliance letter is needed.

1704.2.5 Special inspections of fabricated items and fabricators Section 1705 Special inspections and the following sub-sections:

1705.2 Steel Construction including 1705.2.1 Structural Steel, 1705.2.2 Cold-formed steel deck 1705.3 Concrete Construction including 1705.3.1 Welding of reinforcing bars, 1705.3.2 Material tests 1705.4 Masonry Construction, level B

1705.6 Soils 1705.10 Fabricated items

Section 1705.12 Special Inspections for seismic resistance with the following sub-sections: 1705.12.1 Structural Steel

1705.12.1.1 Seismic force-resisting system 1705.12.1.2 Structural steel elements (struts, collector, chords and foundation elements)

1705.12.4 Designated seismic systems 1705.12.5 Architectural components

1705.12.6 Plumbing, mechanical and electrical components Section 1705.13 Structural Testing for Seismic Resistance and the following sub-sections:

1705.13.1 Structural Steel 1705.13.1.1 Seismic force-resisting systems

1705.13.1.2 Structural steel elements (struts, collectors, chords and foundation elements) 1705.13.2 Nonstructural components

1705.13.3 Designated seismic systems Section 1706 Design Strengths of Materials

Section 1707 Alternative Test Procedures Section 1708 In-Situ Load Tests

Section 1709 Preconstruction Load Tests

The Special Inspector shall be a qualified person who shall demonstrate competence, to the satisfaction of the building official, for inspection of the particular type of construction or operation requiring special inspection. Duties and responsibilities of the Special Inspector shall be to inspect and/or test the work outlined above and within the Statement of Special

Inspections in accordance with Chapter 17 of the IBC for conformance with the approved construction documents. All discrepancies shall be brought to the immediate attention of the contractor for correction. Per section 1704.2.4 the Special Inspector shall furnish regular reports to the building official and the structural engineer. Progress reports for continuous inspection shall be furnished weekly. Individual reports of periodic inspections shall be furnished within one week of inspection

dates. The reports shall note uncorrected deficiencies, correction of previously reported deficiencies, and changes to the approved construction documents authorized by the Structural Engineer of Record. The Special Inspector shall submit a final signed report within 10 days of the final special inspection stating whether the work requiring special inspection was, to the best of the inspector's knowledge, in conformance with the approved construction documents and the applicable

workmanship provisions of the IBC. Work not in conformance shall be noted in the report. The contractor shall submit a statement of responsibility to the building official and the owner prior to the commencement of work on a main wind- or seismic-force-resisting system, designated seismic system or a wind- or seismic-resisting component listed in the Statement of

Special Inspections per section 1704.5. Except as noted, the special inspections outlined above are in addition to, and beyond the scope of, periodic Structural Observations as defin in section 1704.6. Structural Observations are included in the structural engineering design and construction administration services provided by the structural engineer.

> SHEET LIST SHEET NUMBER SHEET NAME S 0.01 STRUCTURAL COVER SHEET S 0.02 SPECIAL INSPECTIONS S 1.01 FOUNDATION PLAN MAIN AND ROOF LEVEL S 1.02 FRAMING PLAN BURGESS CREEK BRIDGE PLAN S 1.04 S 5.01 TYPICAL DETAILS S 5.02 DETAILS S 5.03 DETAILS AND SCHEDULES



			ABBREV	IATIONS	KEY		
AB	Anchor Rod (Bolt)	E-E	End to End	LVL	Laminated Veneer Lumber (generic)	RMO	Rough Masonry Opening
ADDL	Additional	EF	Each Face	LW	Light Weight	RO	Rough Opening
AFF	Above Finished Floor	EJ	Expansion Joint	MASY	Masonry	SC	Slip Critical
ALT	Alternative	EL	Elevation	MATL	Material	SCH	Schedule
AMT	Amount	EN	Edge Nailing	MAX	Maximum	SDST	Self Drilling Self Tapping
APPROX	Approximate	ENGR	Engineer	MECH	Mechanical	SECT	Section
ARCH	Architect, Architectural	EQ	Equal	MEZZ	Mezzanine	SF	Square Feet
ASD	Allowable Stress Design	EQUIP	Equipment	MFR	Manufacture, -er, -rd	SHT	Sheet
AVG	Average	EQUIV	Equivalent	MIN	Minimum	SHTG	Sheathing
ВС	Bottom of Concrete	ES	Each Side	MTL	Metal	SIM	Similar
BL	Brick Ledge	EST	Estimate	<n></n>	"New"	SL	Sloped
BLK	Block	E-W	East to West	NIC	Not In Contract	SOG	Slab On Grade
BLKG	Blocking	EXC	Excavate	N-S	North to South	SP	Space,-s
BM	Beam	EXP	Expansion	NTS	Not to Scale	SPEC	Specifications
BOT	Bottom	EXT	Exterior	OD	Outside Diameter	SQ	Square
BRG	Bearing	FDN	Foundation	OF	Outside Face	STD	Standard
CANT	Cantilever	FF	Finished Floor	OH	Opposite Hand	STL	Steel
CF	Cubic Foot	FIG	Figure	OPNG	Opening	STIFF	Stiffener
CFS	Cold Form Steel	FL	Flush	OPP	Opposite	STRUCT	Structure (Structural)
CIP	Cast In Place	FLR	Floor	OSB	Oriented Strand Board	SY	Square Yard
CJ	Construction Joint (Control Joint)	FP	Full Penetration	PAF	Powder Actuated Fastener	SYM	Symmetrical
CLG	Ceiling	FTG	Footing	PC	Precast	T&B	Top and Bottom
CLR	Clear	GA	Gage (Gauge)	PE	Pre-engineered (trusses)	T&G	Tongue and Groove
CMU	Concrete Masonry Unit	GALV	Galvanized	PEN	Penetration	TB	Top of Beam
COL	Column	GC	General Contractor	PERP	Perpendicular	TC	Top of Concrete
COM	Common	GEN	General	PKT	Pocket	TJ	Top of Joist
CONC	Concrete	GL	Glue Laminated (Glu-lam)	PL	Property Line	TL	Total Load, Top of Ledge
CONN	Connection	GR	Grade	PLF	Pounds per Linear Foot	TM	Top of Masonry
CONT	Continue (Continuous)	GT	Girder Truss	PSF	Pounds per Square Foot	T.0	Top of
CONSTR	Construction	GYP BD	Gypsum Board	PSI	Pounds per Square Inch	TRANS	Transverse
COORD	Coordinate, Coordination	HAS	Headed Anchor Stud	PSL	Parallel Strand Lumber (generic)	TYP	Typical
CS	Countersink	HNGR	Hanger	PT	Pressure Treated	ULT	Ultimate
CTR	Center	HORIZ	Horizontal	P.T	Post Tensioned	UNO	Unless Noted Otherwise
CY	Cubic Yard	HT	Height or Heavy Timber	PV	Photovoltaic	VERT	Vertical
DAB	Deformed Anchor Bar	ID	Inside Diameter	QTY	Quantity	VIF	Verify In Field
DIAG	Diagonal Diagonal	INT	Interior	<r></r>	To be Removed	WA	Wedge Anchor
DIM	Dimension	K	Kip (1,000 lbs)	R	Radius	WF	Wide Flange
DL	Dead Load	LGS	Light Gage Stud	RE	Reference (refer to)	WP	Work Point
DN	Down	LL	Live Load	RECT	Rectangle	WT	Weight
DP	Drilled Pier	LLH	Long Leg Horizontal	REINF	Reinforcement	WWF	Welded Wire Fabric
DWG	Drawing Drawing	LLV	Long Leg Vertical	REQ	Required	XS	Extra Strong
<e></e>	Existing	LSH	Long Side Horizontal	REQMT	Requirement	XSECT	Cross Section
EA	Each	LSV	Long Side Vertical	RET	Requirement Retaining Wall	XXS	Double Extra Strong
		LSV	+			۸۸٥	Double Latia Strong
ECC	Eccentric	LI	Light	RM	Room		

ARRDEVIATIONS KEV

	LEG	END		
□ XK, YT	"X" King studs, "Y" Trimmer studs, studs to match wall thickness		CMU	
□ C	Indicates column continuous through level shown	4 4 4 4 4 4	Concrete	
□ В	Indicates bottom of column at level shown, see next level framing plan for size; install squash blocking in floor cavity of equal size and equal column size below to foundation - unless noted otherwise	— <u>————————————————————————————————————</u>	Earth fill	
XXXX, STUB	Indicates top of column and type <u>below</u> framing level STUB indicates shorter column that extends vertically between beams		Porous fill (i.e. gravel)	
XX'-XX"	Indicates top of concrete slab or wood subfloor elevation		Interior wood bearing wall below framing	
777777	Indicates step in floor elevation		Wood shear wall below framing	
SLOPE	Indicates direction of slope	[]]]	Structural wall above framing	
O FD	Indicates floor drain	WXXXX	Indicates Wood Stud wall type, see schedule	
(XX'-XX") {XX'-XX"}	Indicates top of footing or pier elevation Indicates minimum pier penetration into bedrock	BWX	Indicates Building Wall type, see schedule	
FXX	Continuous spread footing. See schedule for size and reinforcing	SWX	Indicates shear wall. See schedule for sheathing type and nailing	
FX.X	Isolated pad footing. See schedule for size and reinforcing	HDX	Indicates holdown. See schedule for description	
TC=XX'-XX" BC=XX'-XX"	Indicates top of concrete elevation Indicates bottom of concrete elevation		Joist, or Truss bears on wall or beam below	
STEP BC	Indicates step in bottom of concrete elevation	<u>L</u>	Beam, Joist, or Truss connected to support with metal hanger	
TL=XX'-XX"	Indicates top of concrete ledge elevation	E	Beam, Joist, or Truss connected to support with concealed hanger	
PKT XxYxZ XX'-XX"	Indicates beam pocket in concrete wall (X=width, Y=height, Z= ledge depth in inches) with bottom of pocket elevation		Indicates steel deck or concrete slab span direction	7021
4 4 4	Indicates step in top of concrete wall or ledge elevation. Arrow points toward lower elevation	[XX'-XX"]	Indicates top of steel beam elevation	03/29/2021
	Indicates shoring		Indicates location of bend in bent beam	_
(E)	Indicates 'existing'	(BX)	Indicates braced frame	— Г П
(N)	Indicates 'new'	, , ,	Indicates brace location	
(R)	Indicates 'to be removed'	MFX	Indicates rigid frame	
BPX	Indicates Baseplate	— □ —	Moment connection	_ Y



NOTICE: DUTY OF COOPERATION Release of these plans contemplates further ooperation among the owner, his contractor and the architect Design and construction are complex Although the architect and his consultants have performed their services with due care and diligence they cannot guarantee perfection. Communication is imperfect and every contingency cannot be anticipated.
Any ambiguity or discrepancy discovered by the use of these plans shall be reported immediately to the architect. Failure to notify the architect compounds misunderstanding and increases construction costs. A failure to cooperate by a simple notice to the architect shall relieve the architect from responsibility for the consequences. Changes made from the plans withou consent of the architect are unauthorized and shall relieve the architect of responsibility for all consequences arriving out of such changes. All design, documents and data prepared by Eric Smith Associates, P.C. as instruments of service

shall remain property of Eric Smith Associates, P.C and shall not be copied, changed or disclosed in any written consent of Eric Smith Associates, P.C. Eric Smith Associates, P.C

REVISIONS			
No.	Description	Date	
	PERMIT SET	3-5-2021	
2	ADDENDUM #2	3-26-2021	
3	ASI #1	4-20-2021	
4	ASI #2	6-7-2021	
	-		
	<u> </u>		
	1		
	<u> </u>		
	1		



Job Number:	20034		
Date:	3/5/2021		
Drawn By:	KLM		
Checked By:	CRR		
D			
Project Pl	nase		
CONSTRUCTION DOCL	JMENTS		
Sheet Title			

STRUCTURAL COVER SHEET **Sheet Number**



FOUNDATION PLAN NOTES:

1. SEE S0.01 FOR GENERAL STRUCTURAL NOTES, ABBREVIATIONS AND LEGEND

2. SEE S5.01 FOR TYPICAL DETAILS

3. SEE S5.03 FOR SCHEDULES 4. CONCRETE FOUNDATION GRADE WALL (UNO):
 8" THICK CONCRETE WALLS REINFORCED WITH #5 @ 18" EACH WAY CENTERED IN WALL. ALSO INSTALL (2) #5 BARS TOP AND

 10" RETAINING WALLS, SEE SCHEDULE AND 8/S5.01 FOR WALL REINFORCING.

• 12" THICK CONCRETE WALLS REPRORCED WITH #4 @ 18" VERT EACH FACE AND #4 @ 16" HORIZ EACH FACE.

5. CONCRETE SLAB ON GRADE; 4" THICK CONCRETE SLAB ON PREPARED SUB-GRADE PER SOILS REPORT. REINFORCE WITH #4 @18" EA WAY PLACED AT MID-DEPTH. SAWCUT OR TOOLED 1/8"x1" CONTROL JOINTS @ 10'-0" MAX EACH WAY. INSTALL (3) #4 x 5'-0" DIAGONAL BARS AT MID-DEPTH OF SLAB AT ALL RE-ENTRANT

6. INDICATES MODULAR BLOCK RETAINING WALL TO BE

7. SEE ARCHITECTURAL DRAWINGS FOR LOCATIONS OF RAMPS,

SLAB SLOPES, AND OTHER INFORMATION NOT SHOWN.

DESIGNED BY OTHERS, SEE ARCH

	FOUNDATION PLAN KEYNOTES		No.	Description
				PERMIT SET
\\\\\\\\\\\\\\\\\\\\\\\\\\\\\\\\\\\\			1	ADDENDUM #1
$\langle X \rangle$	DESCRIPTION		2	ADDENDUM #2
			3	ASI #1
1	10" WIDE x 24" DEEP CONCRETE BORDER WALL. REINFORCE W/#4 BARS		4	ASI #2
	@ 12" EACH WAY CENTERED IN WALL. PLACE WALL TIGHT TO MODULAR			
	BLOCK WALL.			
2	PROVIDE #5 HORIZONTAL CORNER BARS @ 6" OC CENTERED IN WALL AT			
2	FROUDE #3 HORIZONTAL CORNER BARS @ 0 OC CENTERED IN WALL AT	- 1 - 1		

MINIMUM OF 4'-0" EACH WAY. 3 24"x24" CONCRETE PIER FOR LIGHT POLE CAST INTEGRAL W/ WALL W/ (8) #6 VERTICALS; #4 TIES AT 12" ,(3) TIES @ 3" TOP. SEE ELECTRICAL FOR

THIS CORNER PER DETAIL 2/S5.01. EXTEND EACH LEG OF CORNER BAR

ANCHOR BOLTS AND CONDUIT LAYOUT 4 30"x30" CONCRETE PIER FOR SPUR RAIL SUPPORT CAST INTEGRAL W/ WALL W/ (12) #8 VERTICALS; #4 TIES AND CROSSTIES AT 12" ,(3) TIES @ 3" TOP. SEE DOPPELMAYR FOR ANCHOR BOLT LAYOUT

5 | 12" THICKENED SLAB FOR PARKING RAIL SUPPORT, REINFORCE W/ #4 @ 12" EACH WAY TOP AND BOT OF SLAB. SEE DOPPELMAYR FOR EMBED IN

6 MIN 12"x12" CONCRETE PIER W/(4)-#5 VERT AND #3 TIES @ 12"; (3) TIES @3" TOP. COORDINATE LOCATION WITH DOPPELMAYER. MIN DEPTH =

	CONCRETE FOOTING SCHEDULE (CONT)				
	MARK	WIDTH	THICKNESS	REINFORCEMENT	
	F16	1'-4"	1'-0"	(2) #5's BOT	
	F20	1'-8"	1'-0"	(3) #4 CONT	
	F28	2'-4"	1'-0"	(4) #4 CONT	
	F30	2'-6"	1'-0"	SEE 8/S5.01	
	F42	3'-6"	1'-0"	SEE 8/S5.01	
	F60	5'-0"	1'-0"	SEE 8/S5.01	
	F84	7'-0"	1'-0"	SEE 8/S5.01	
\sim	$\overline{\gamma}$	~~~~	~~~~~~~~~~~~~~~~~~~~~~~~~~~~~~~~~~~~~~	~~~~~~~~~~~~~~~~~~~~~~~~~~~~~~~~~~~~~~	

CONCRETE FOOTING SCHEDULE (ISOLATED PADS)

				·	•
MARK	LENGTH	WIDTH	THICKNESS	TOP REINFORCEMENT	BOTTOM REINFORCEMENT
F4.0	4'-0"	4'-0"	1'-0"		(5) #5 EA WAY

NOTICE: DUTY OF COOPERATION Release of these plans contemplates further cooperation among the owner, his contractor and the architect. Design and construction are complex. Although the architect and his consultants have performed their services with due care and diligence, they cannot guarantee perfection. Communication is imperfect and every contingency cannot be anticipated. Any ambiguity or discrepancy discovered by the use of these plans shall be reported immediately to the architect. Failure to notify the architect compounds misunderstanding and increases construction costs. A failure to cooperate by a simple notice to the architect shall relieve the architect from responsibility for the consequences. Changes made from the plans without consent of the architect are unauthorized and shall relieve the architect of responsibility for all consequences arriving out of such changes.

All design, documents and data prepared by Eric Smith Associates, P.C. as instruments of service shall remain property of Eric Smith Associates, P.C. and shall not be copied, changed or disclosed in any form whatsoever without first obtaining the express written consent of Eric Smith Associates, P.C.

Eric Smith Associates, P.C

REVISIONS					
No.	Description	Date			
	PERMIT SET	3-5-2021			
1	ADDENDUM #1	3-12-2021			
2	ADDENDUM #2	3-26-2021			
3	ASI #1	4-20-2021			
4	ASI #2	6-7-2021			

Job Number:	20034
Date:	3/5/2021
Drawn By:	KLM
Checked By:	CRR

Project Phase

CONSTRUCTION DOCUMENTS **Sheet Title** FOUNDATION PLAN

Sheet Number

FOUNDATION PLAN PLAN NORTH

- TC = 6908'-0" TC = 6907'-7" -6902'-0" 6903'-0" 9'-0 1/8" THICKENED SLAB FOR CABIN GUIDE 6903'-0" ATTACHEMENT, SEE 7/S5.02. VERIFY EXTENTS WITH DOPPELMAYR 1.0. 4" SLAB AT APEX - NEW PIER BY DÖPPELMAYR, VERIFY LOCATION PRIOR TO ANY CONCRETE PLACEMENT — START AND STOP RETAINING WALL AND FOOTING EACH SIDE OF PIER. VERIFY EXACT LOCATION IN FIELD 9'-0 1/8" ∼ START OF RADIUS 🔁 MODULAR BLOCK WALL BY OTHERS ---ACCESS PATH, SEE ARCH/CIVIL 24" DEEP SUMP PIT, BY MECH. CONTRACTOR TRANSFORMER PADS, - 4" HOUSEKEEPING PAD ABOVE SOG, REINFORCE PER PLAN BY OTHERS NOTES. SEE 9/S5.01 AND SEE MECH. F16 6893'-7" TC = 6907'-9 1/2" -24'-4" 49'-8" 36'-0"

24'-4"

TC = 6907'-3" —

6903'-0"

10"-1

TC = 6907'-4" -

PLACEMENT

REINFORCEMENT

) TOP OF WALL ELEVATIONS NOTED ARE APPROXIMATE,

SEE ARCH. FOR RFID GATE SLAB DIMENSIONS AND

ELEVATIONS/SLOPES. 4" SLAB TO BE REINFORCED W

1.5 POUNDS PER CUBIC YARD OF MICRO FIBER

INTENT IS FOR TOP OF WALL TO MATCH ADJACENT PAVER

angle elevation. Slope top of wall between elevations NOTED. CONFIRM WITH CIVIL PRIOR TO CONCRETE

110'-0"

110'-0"

36'-0"

MODULAR BLOCK WALL BY OTHERS -

6903'-7"

STEP BC

F16

6903'-0"

6902'-0"

1

- NEW GONDOLA

DOPPELMAYR

EQUIPMENT PER


49'-8"

SAND AND PAVER SYSTEM ABOVE, SEE ARCH -

WITH DOPPELMAYR -

BLOCKOUT(S) IN FOUNDATION WALL, VERIFY EXACT SIZE AND LOCATION



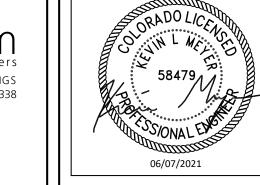

NOTICE: DUTY OF COOPERATION Release of these plans contemplates further cooperation among the owner, his contractor and the architect. Design and construction are complex. Although the architect and his consultants have performed their services with due care and diligence, they cannot guarantee perfection. Communication is imperfect and every contingency cannot be anticipated. Any ambiguity or discrepancy discovered by the use of these plans shall be reported immediately to the architect. Failure to notify the architect compounds misunderstanding and increases construction costs. A failure to cooperate by a simple notice to the architect shall relieve the architect from responsibility for the consequences. Changes made from the plans without consent of the architect are unauthorized and shall relieve the architect of responsibility for all consequences arriving out of such changes.

All design, documents and data prepared by Eric Smith Associates, P.C. as instruments of service shall remain property of Eric Smith Associates, P.C. and shall not be copied, changed or disclosed in any form whatsoever without first obtaining the express written consent of Eric Smith Associates, P.C. Eric Smith Associates, P.C.

REVISIONS Description ADDENDUM #1 ADDENDUM #2

REINFORCE WITH 4LBS/CUBIC YARD MACRO FIBER REINFORCING OR #4 SUPPORT WITH 5/8" PUDDLE WELD AT 36/4 PATTERN. FASTEN SIDE LAPS W/#10 TEK SCREWS @ 18". SEE DETAILS FOR CONNECTION TO WALLS. CAST INTO TOP OF CONCRETE WALL. WELD COLUMN TO EMBED PLATE

ROOF FRAMING PLAN KEYNOTES

MAIN LEVEL FRAMING PLAN KEYNOTES

1 2"x18GA COMPOSITE STEEL DECK (VULCRAFT VLI OR EQUIV) W/3-1/2"

NORMAL WEIGHT CONCRETE TOPPING (5-1/2" TOTAL THICKNESS).

BARS @18" EACH WAY CENTERED IN SLAB. WELD DECK TO STEEL

2 10"x1/2"x0'-10" EMBED PLATE W/(4)-1/2"Øx5"HEADED STUDS @ 8" GAGE

3 PROVIDE EMBED PLATE IN CONCRETE WALL PER 11/S5.01 FOR BEAM

DESCRIPTION

DESCRIPTION


W/ 3/16" FILLET ALL AROUND.

CONNECTION.

1 2"x18GA COMPOSITE STEEL DECK (VULCRAFT VLI OR EQUIV) W/3-1/2" NORMAL WEIGHT CONCRETE TOPPING (5-1/2" TOTAL THICKNESS). REINFORCE WITH 4LBS/CUBIC YARD MACRO FIBER REINFORCING OR #4 BARS @18" EACH WAY CENTERED IN SLAB. WELD DECK TO STEEL SUPPORT WITH 5/8" PUDDLE WELD AT 36/4 PATTERN. FASTEN SIDE LAPS W/#10 TEK SCREWS @ 18". SEE DETAILS FOR CONNECTION TO

SEE 1/55/02 FOR BEAM BEARING PLATE REQUIREMENTS IN CMU WALL. MIN. W8x18 ELEVATOR HOIST BEAM. COORDINATE LOCATION AND

ELEVATION WITH ELEVATOR SUPPLIER.

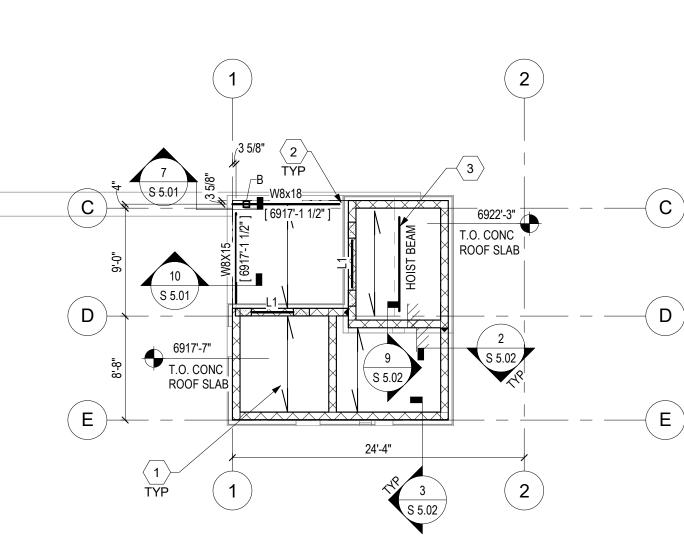

ROOF FRAMING PLAN

- 2. SEE S5.01 FOR TYPICAL DETAILS AND S5.03 FOR CMU WALL, PIER AND LINTEL SCHEDULES 3. AT ROOF DRAINS, ACCEPTABLE TO CORE DRILL MAXIMUM 8" HOLE THROUGH COMPOSITE ROOF DECK.
- 4. LOCATE MECHANICAL OPENINGS IN WALLS MIN. 1'-4" FROM BEAM BEARING LOCATIONS. PROVIDE 'L1'
- LINTEL OVER MECHANICAL OPENINGS UP TO 6'-0" IN LENGTH.

PLAN NORTH ROOF PLAN NOTES: 1. SEE S0.01 FOR GENERAL STRUCTURAL NOTES, ABBREVIATIONS AND LEGEND

-(D)

NOTIFY ANTHEM IF LARGER OPENING IS REQUIRED PRIOR TO POURING DECK.

5. UNLESS NOTED OTHERWISE, TYPICAL T/SLAB = 6917'-7".

Job Number:	20034
Date:	3/5/2021
Drawn By:	KLM
Checked By:	CRR

Project Phase CONSTRUCTION DOCUMENTS

Sheet Title MAIN AND ROOF LEVEL FRAMING

Sheet Number

MAIN LEVEL FRAMING PLAN PLAN NORTH

49'-8"

- EMBED PLATES IN TOP OF FOUNDATION WALL

BY OTHERS FOR POC

- SAND AND PAVER SYSTEM, SEE ARCH -

OPERATOR CABIN

STRUCTURE BY

OTHERS -

EMBED PLATES IN TOP

OF FOUNDATION WALL

BY OTHERS

TYP ALL CMU WALLS

EMBED PLATES IN TOP OF PIER BY OTHERS —

- SEE REVIEWED SHOP DRAWINGS AND SK-01 FOR

T.O. CONC AT DOOR INTO ELEVATOR: 6907'-9 1/2"

S 5.01 / END 24'-4"

UPDATED ELEVATIONS, SLOPES AND DETAILS AT PLATFORM

- MAIN LEVEL PLAN NOTES:

 1. SEE S0.01 FOR GENERAL STRUCTURAL NOTES, ABBREVIATIONS AND LEGEND 2. SEE S5.01 FOR TYPICAL DETAILS AND S5.03 FOR CMU WALL, PIER AND LINTEL SCHEDULES
- 3. SEE S1.01 FOR TOP OF FOUNDATION WALL ELEVATION.
- 4. TYPICAL CMU WALL IS 8" CMU WITH 'MW1' REINFORCING PER S5.03. PROVIDE 5'-0" DOWELS AT TOP OF CONCRETE FOUNDATION WALL TO MATCH MASONRY WALL REINFORCING SIZE AND SPACING. PROJECT
- 30" ABOVE TOP OF FOUNDATION WALL. 5. UNLESS NOTED OTHERWISE, TYPICAL TOP OF SLAB = 6907'-9 1/2"

S 5.01


1'-2" HSS6X6X1/4 FILLED

W/CONC

EMBED PLATES IN TOP OF FOUNDATION WALL

BY OTHERS —



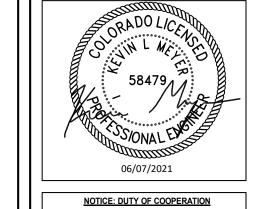

Release of these plans contemplates further cooperation among the owner, his contractor and the architect. Design and construction are complex. Although the architect and his consultants have performed their services with due care and diligence, they cannot guarantee perfection. Communication is imperfect and every contingency cannot be anticipated. Any ambiguity or discrepancy discovered by the use of these plans shall be reported immediately to the architect. Failure to notify the architect compounds misunderstanding and increases construction costs. misunderstanding and increases construction costs. A failure to cooperate by a simple notice to the architect shall relieve the architect from responsibility for the consequences. Changes made from the plans without consent of the architect are unauthorized and shall relieve the architect of responsibility for all consequences arriving out of such changes.

All design, documents and data prepared by Eric Smith Associates, P.C. as instruments of service shall remain property of Eric Smith Associates, P.C. and shall not be copied, changed or disclosed in any form whatsoever without first obtaining the express written consent of Eric Smith Associates, P.C. Eric Smith Associates, P.C.

REVISIONS				
No.	Description	Date		
3	ASI#1	4-20-2021		
4	ASI#2	6-7-2021		




Job Number:	20034
Date:	3/5/2021
Drawn By:	JE5
Checked By:	KLM

Project Phase CONSTRUCTION DOCUMENTS Sheet Title

VAULT

Sheet Number

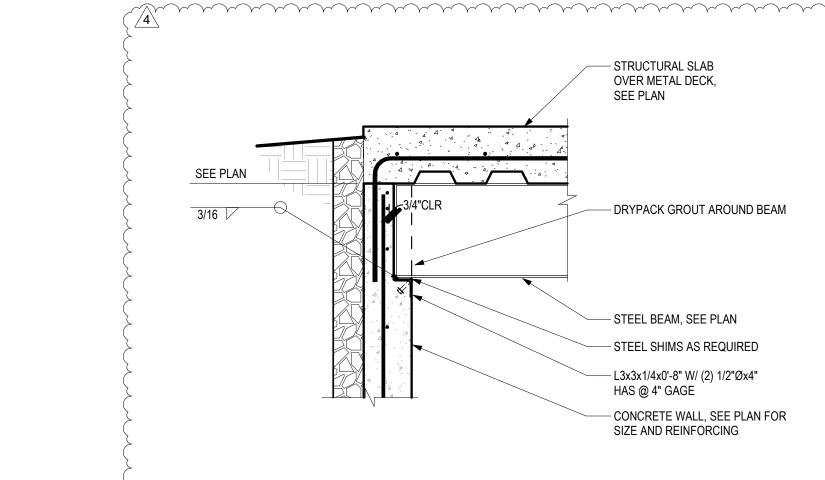

STEEL BEAM POCKET

