SITE GENERAL NOTES

A. ALL EXTERIOR LIGHTING CIRCUITS SHALL UTILIZE A MINIMUM WIRE SIZE OF #8AWG COPPER, UON.

KEYNOTE LEGEND

KEY VALUE

KEYNOTE TEXT

PROVIDE (3) 3" AND (1) 2" CONDUITS FOR FIBER OPTIC AND COMMUNICATIONS SERVICE CABLING ROUTED FROM SERVICE INTERCONNECTION POINT INTO NEW UNDERGROUND ELECTRICAL VAULT FOR ROUTING TO OPERATOR CABIN, TOWER #4 AND CHRISTIE PEAK CHAIR LIFT. EC SHALL COORDINATE EXACT LOW-VOLTAGE CONDUIT ROUTING AND SIZING REQUIREMENTS WITH CIVIL SITE UTILITY DRAWINGS AND OWNER (SSRC) PRIOR TO COMMENCING WORK. REFER TO VAULT ELECTRICAL PLAN, SHEET E300, AND LOW-VOLTAGE RISER DIAGRAM, SHEET E600, FOR ADDITIONAL INFORMATION.

PROVIDE (2) 3" CONDUITS FOR FIBER OPTIC AND COMMUNICATIONS SERVICE CABLING ROUTED THROUGH NEW UNDERGROUND ELECTRICAL VAULT TO OPERATORS CABIN. REFER TO CIVIL SITE UTILITY DRAWINGS FOR EXACT ROUTING AND SIZING REQUIREMENTS. REFER TO LOW-VOLTAGE RISER DIAGRAM, SHEET E600, FOR ADDITIONAL INFORMATION.

- APPROXIMATE ROUTING OF NEW UNDERGROUND UTILITY PRIMARY FROM NEW UTILITY TRANSFORMER TO UTILITY INTERCONNECTION POINT WITHIN EXISTING UTILITY EASEMENT. COORDINATE EXACT ROUTING AND REQUIREMENTS WITH ELECTRICAL UTILITY (YAMPA VALLEY ELECTRIC ASSOCIATION) AND GENERAL CONTRACTOR PRIOR TO COMMENCING WORK. COORDINATE FINAL ROUTING WITH ALL OTHER NEW/EXISTING UNDERGROUND UTILITIES INCLUDING FUTURE BASE BUILDING ELECTRICAL UTILITY PRIMARY/SECONDARY ROUTING PRIOR TO EXCAVATING.
- THE EC SHALL FURNISH AND INSTALL THE REQUIRED METER HOUSING AS COORDINATED WITH YVEA. UTILITY SHALL FURNISH, INSTALL, AND CONNECT THE METER IN THAT HOUSING. ALL COSTS FOR WORK DESCRIBED ABOVE TO BE PERFORMED BY UTILITY SHALL BE CARRIED AS PART OF THE PROJECT BUDGET AND SHALL BE PAID BY THE CONTRACTOR. TRANSFORMER CONCRETE PAD BY GC, COORDINATE PAD AND CLEARANCE REQUIREMENTS WITH UTILITY ELECTRICAL SERVICE INSTALLATION MANUAL.
- APPROXIMATE ROUTING OF NEW UNDERGROUND ELECTRICAL SECONDARY FEEDER FROM UTILITY TRANSFORMER TO NEW BUILDING ELECTRICAL SERVICE CT CABINET AND MAIN DISCONNECT LOCATED ON BUILDING EXTERIOR. REFER TO ELECTRICAL ONE-LINE DIAGRAM FOR MORE INFORMATION.
- ANTICIPATED LOCATION OF NEW 480/277V, 3-PHASE PAD MOUNTED UTILITY TRANSFORMER. IT IS ANTICIPATED THAT UTILITY (YVEA - YAMPA VALLEY ELECTRIC ASSOCIATION) WILL PROVIDE BORING/TRENCHING FOR ALL PRIMARY CONDUIT BETWEEN UTILITY CONNECTION AND THE TRANSFORMER. UTILITY SHALL PROVIDE ALL PRIMARY CONDUIT AND WIRING TO THE TRANSFORMER, INCLUDING TRENCHING BETWEEN THE NEAREST UTILITY CONNECTION POINT AND THE PRIMARY CONNECTION AT THE TRANSFORMER. THE EC SHALL COORDINATE ROUTING AND TERMINATION IN THE FIELD AS TO ACHIEVE BUILDING POWER ACTIVATION. THE EC SHALL PERFORM ALL TRENCHING AND BACKFILLING ON THE SECONDARY SIDE OF THE TRANSFORMER. UTILITY SHALL MAKE ALL CONNECTIONS OF PRIMARY AND SECONDARY CABLING AT THE TRANSFORMER LANDINGS.
- NEW UNDERGROUND VAULT STRUCTURE, EXISTING SKI SCHOOL BLOCKHOUSE 1, TO BEDEMOLISHED AS REQUIRED TO ACCOMMODATE MEW VAULT CONSTRUCTION. NEW VAULT TO HOUSE NEW/RELOCATED ELECTRICAL EQUIPMENT AND SNOW MAKING EQUIPMENT. REFER TO NEW VAULT ELECTRICAL ONE-LINE DIAGRAMS AND ENLARGED PLANS, SHEET E300, FOR ADDITIONAL INFORMATION.
- EXISTING UNDERGROUND ELECTRICAL AND TELECOMMUNICATIONS CONDUITS AND CABLING FROM BLOCKHOUSE TO DEMOLISHED SKI CARPET LIFT EQUIPMENT SHALL BE REMOVED IN THEIR ENTIRETY BACK TO SOURCE AS REQUIRED TO ACCOMMODATE NEW PLATFORM BUILDING CONSTRUCTION.
 - EXISTING UNDERGROUND POWER AND TELECOMMUNICATIONS SERVICES (CONDUIT AND CABLING) SUPPLYING DEMOLISHED BLOCKHOUSE FROM CHRISTIE PEAK CHAIR LIFT. EXISTING POWER CONDUIT AND WIRING ANTICIPATED TO BE REMOVED AND REPLACED AS REQUIRED TO PROVIDE NEW UNDERGROUND POWER FEEDER FROM CHRISTIE PEAK CHAIR LIFT TO NEW VAULT ELECTRICAL PANEL HV1. CONTRACTOR SHALL PROVIDE NEW TRENCH FROM EXISTING CHRISTIE PEAK CHAIR LIFT TO NEW VAULT LOCATION AS NECESSARY TO ACCOMMODATE NEW CONDUIT INSTALLATION. REFER TO VAULT ELECTRICAL ONE-LINE DIAGRAM, SHEET E300, FOR ADDITIONAL INFORMATION. EXISTING POWER AND TELECOMMUNICATIONS CONDUIT ANTICIPATED TO BE RE-ROUTED/EXTENDED AS NECESSARY TO TERMINATE IN NEW VAULT ELECTRICAL ROOM FOR NEW PATHWAY AS REQUIRED. EC SHALL VERIFY EXISTING CONDUIT SIZING AND ROUTING IN FIELD. COORDINATE EXACT NEW COMMUNICATIONS CONDUIT SIZING/REQUIREMENTS AND ROUTING WITH OWNER PRIOR TO COMMENCING WORK.
- ALL NEW UNDERGROUND CONDUIT ROUTED TO OPERATOR CABIN SHALL BE ROUTED THROUGH NEW STRUCTURAL BLOCK OUT IN OPERATOR CABIN FOUNDATION. EC SHALL COORDINATE EXACT BLOCK OUT LOCATION AND INSTALLATION REQUIREMENTS OF ALL ASSOCIATED CONDUIT/WIRING FOR OPERATOR CABIN POWER/TELECOMMUNICATIONS WITH DOPPELMAYR AND STRUCTURAL DRAWINGS PRIOR TO COMMENCING WORK. REFER TO ELECTRICAL FIRST LEVEL POWER PLAN, #1/E111, FOR ADDITIONAL INFORMATION.
- APPROXIMATE ROUTING OF EXISTING TO REMAIN POWER AND COMMUNICATIONS CONDUITS TO EXISTING TO REMAIN BUCKAROO SKI CARPET LIFT. MAINTAIN ANY EXISTING CONDUIT/WIRING CONNECTIONS AND RE-CONNECT POWER TO NEW/RELOCATED PANEL IN NEW VAULT ELECTRICAL ROOM. EC SHALL RE-ROUTE EXISTING CONDUIT/WIRING AS NECESSARY TO RE-CONNECT POWER. REFER TO VAULT ELECTRICAL ONE-LINE DIAGRAMS, SHEET E300, FOR ADDITIONAL INFORMATION.
- APPROX. LOCATION OF EXISTING CARPET LIFT POWER/COMMUNICATIONS TERMINATION POINT TO BE REMOVED. COORDINATE EXACT LOCATION IN FIELD AND VERIFY TIMING OF REMOVAL WITH OWNER PRIOR TO COMMENCING WORK.


06/11/2021

NOTICE: DUTY OF COOPERATION Release of these plans contemplates further architect. Design and construction are complex. performed their services with due care and diligence they cannot guarantee perfection. Communication is imperfect and every contingency cannot be anticipated Any ambiguity or discrepancy discovered by the use of these plans shall be reported immediately to the architect. Failure to notify the architect compounds misunderstanding and increases construction costs. A shall relieve the architect from responsibility for the consequences. Changes made from the plans without consent of the architect are unauthorized and shall relieve the architect of responsibility for all consequences arriving out of such changes.

All design, documents and data prepared by Eric Smith Associates, P.C. as instruments of service shall remain property of Eric Smith Associates, P.C. and shall not be copied, changed or disclosed in any form whatsoever without first obtaining the express written consent of Eric Smith Associates, P.C.

Eric Smith Associates, P.C.

	REVISIONS									
No.	Description	Date								
1	ADDENDUM #1	3/12/2021								
3	ASI #1	4/19/2021								
4	ASI #2	6/7/2021								

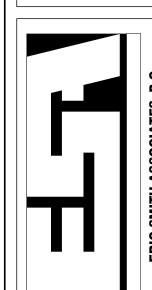

Job Number: 20034 Drawn By: BDJ, MAE Checked By:

Project Phase CONSTRUCTION DOCUMENTS

Sheet Title


ELECTRICAL SITE PLAN **Sheet Number**

Integrated Lighting and Electrical Solutions 1900 Wazee Street #205 | Denver, CO 80202 | 303.296.3034

KEYNOTE LEGEND KEY VALUE KEYNOTE TEXT PROVIDE 120V, 20-AMP CIRCUIT FOR MECHANICAL CONTROLS. COORDINATE EXACT CONTROL EQUIPMENT LOCATION AND MOUNTING HEIGHT PRIOR TO ROUGH-IN. RUN 2#12, 1#12G, 3/4"C. EC SHALL COORDINATE EXACT ELECTRICAL PANEL LOCATIONS AND NEC REQUIRED WORKING CLEARANCES WITH MECHANICAL CONTRACTOR AND NEW MECHANICAL EQUIPMENT IN BOILER ROOM IN-FIELD PRIOR TO COMMENCING WORK. ALL FINAL INSTALLED ELECTRICAL PANEL CLEARANCES SHALL COMPLY WITH NEC REQUIREMENTS. EC SHALL SUSPEND ELECTRICAL TRANSFORMER FROM STRUCTURE AS REQUIRED. REFER TO DETAIL #1/E600 FOR MORE INFORMATION. EC SHALL COORDINATE ELEVATOR SHAFT/PIT RECEPTACLE LOCATION WITH APPROVED MANUFACTURER'S ELEVATOR EQUIPMENT SHOP DRAWINGS PRIOR TO PROVIDE EPO SWITCH FOR SHUTDOWN OF MECHANICAL BOILER(S) AS REQUIRED. COORDINATE EXACT LOCATION IN-FIELD WITH MECHANICAL CONTRACTOR. REFER TO MECHANICAL DRAWINGS FOR ADDITIONAL INFORMATION. 24V THERMOSTAT WITH REMOTE SENSOR PROVIDED BY TCC. EC SHALL PROVIDE LINE-VOLTAGE CONTROLS TO RADIANT HEATER AS NECESSARY. COORDINATE EXACT REQUIREMENTS WITH MECHANICAL CONTRACTOR AND REFER TO MECHANICAL DRAWINGS FOR ADDITIONAL INFORMATION. EC SHALL PROVIDE TOGGLE SWITCH WITH INDICATOR LIGHT FOR TRENCH DRAIN HEAT TRACE CONTROL. COORDINATE AND CONFIRM EXACT LOCATION WITH ARCHITECT/OWNER PRIOR TO ROUGH-IN. REFER TO FIRST LEVEL POWER PLAN FOR PROVIDE (3)120V, 20-AMP CIRCUITS FOR POWER CONNECTION TO NEW RFID TICKET GATE LOW-VOLTAGE TRANSFORMER/POWER SUPPLY (12 TOTAL QTY. ANTICIPATED). CIRCUITS TO CONNECTED THROUGH OWNER PROVIDED CONTROL CABINET ENCLOSURE AS NECESSARY. COORDINATE EXACT LOCATIONS, QUANTITY, AND REQUIREMENTS WITH OWNER (STEAMBOAT SKI AND RESORT) IN FIELD PRIOR TO COMMENCING WORK. ASI #2 8 EC SHALL PROVIDE WALL RECESSED JUNCTION BOX AND 374 C TO OPERATOR CABIN TELECOMMUNICATIONS HEAD END EQUIPMENT/CABINET FOR ELEVATOR LANDING TWO-WAY COMMUNICATIONS CALL STATION AND LOW-VOLTAGE CABLING. COORDINATE EXACT LOCATION AND REQUIREMENTS WITH ARCHITECT AND OWNER THE PRIOR TO ROUGHITM TO THE PRIOR TO ROUGHITM TO THE PRIOR TO ROUGHITM TO THE PRIOR TO THE PRIO EC SHALL VERIFY PANELBOARD LOCATION AND CLEARANCES PER NEC ARTICLE 110.26 REQUIREMENTS PRIOR TO INSTALLATION. ANTICIPATED LOCATION OF OWNER (SSRC) RE-USED ELECTRICAL CONTROL AND BATTERY CABINET ENCLOSURES (24"X30" WALL MOUNTED ENCLOSURES TO BE

STACKED VERTICALLY WITH TOP OF ENCLOSURES NOT TO EXCEED 6'-7"). EC SHALL COORDINATE INSTALLATION REQUIREMENTS AND AVAILABLE/RESERVED WALL SPACE

WITH OWNER (SSRC) PRIOR TO COMMENCING WORK.

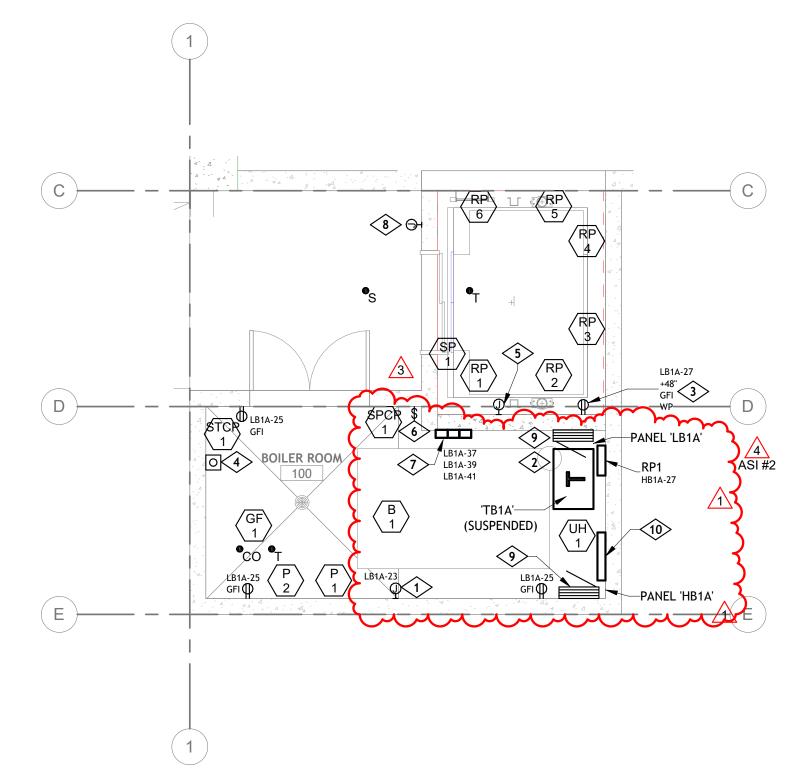

2 ENLARGED ELECTRICAL POWER PLAN - BOILER ROOM
E101 | 1/4" = 1'-0"

AE DESIGN
Integrated Lighting and Electrical Solutions
1900 Wazee Street #205 | Denver, CO 80202 | 303.296.3034
aedesign-inc.com Project #: 5155.00

NOTICE: DUTY OF COOPERATION

Release of these plans contemplates further cooperation among the owner, his contractor and the architect. Design and construction are complex.

performed their services with due care and diligence, they cannot guarantee perfection. Communication is imperfect and every contingency cannot be anticipated. Any ambiguity or discrepancy discovered by the use of

these plans shall be reported immediately to the architect. Failure to notify the architect compounds misunderstanding and increases construction costs. A

failure to cooperate by a simple notice to the architect

shall relieve the architect from responsibility for the consequences. Changes made from the plans without

consent of the architect are unauthorized and shall relieve the architect of responsibility for all

consequences arriving out of such changes.

All design, documents and data prepared by Eric

Smith Associates, P.C. as instruments of service shall remain property of Eric Smith Associates, P.C.

and shall not be copied, changed or disclosed in any form whatsoever without first obtaining the express written consent of Eric Smith Associates, P.C.

Eric Smith Associates, P.C.

REVISIONS

3/12/2021

4/19/2021

6/7/2021

Description

ADDENDUM #1

ASI #1

4 ASI #2

ERIC SMITH ASSOCIATES, P.C.
1919 SEVENTH STREET
BOILINER COLORADO 80302

Job Number: 20034
Date: 03/29/2
Drawn By: BDJ, MAE
Checked By: 1PK

Project Phase
CONSTRUCTION DOCUMENTS

Sheet Title
ELECTRICAL LOWER LEVEL

Sheet Number

E101

KEYNOTE LEGEND **KEYNOTE TEXT**

KEY VALUE

PROVIDE 120V, 20-AMP CONNECTION FOR LINE VOLTAGE THERMOSTAT AND MOTORIZED DAMPER FOR EF-1. REFER TO MECHANICAL DRAWINGS FOR MORE INFORMATION, INCLUDING EXACT CONNECTION REQUIREMENTS AND LOCATION. RUN

2#12, 1#12G, 3/4"C. PROVIDE (2) 2"C ROUTED UP THROUGH CRAWL SPACE AS NECESSARY AND THEN ROUTED BELOW GRADE/FINISHED PAVERS BETWEEN PANEL LB1A IN LOWER LEVEL BOILER ROOM AND IT EQUIPMENT IN UPPER LEVEL OPERATOR CABIN FOR ENTRY GATE AND TICKET SCANNER POWER/DATA CABLING PATHWAY. CONDUIT SHALL BE ROUTED TO JUNCTION BOXES AS SHOWN FOR FINAL TERMINATIONS TO ENTRY GATE AND TICKET SCANNER EQUIPMENT. COORDINATE EXACT LOCATIONS AND ROUTING WITH OWNER PRIOR TO COMMENCING WORK.

PROVIDE (1) 2"C WITH PULL-STRING FOR DATA CABLING AND (2) SPARE 2"C WITH PULL-STRING FOR FUTURE POWER/DATA, ROUTED BELOW GRADE/FINISHED PAVERS FROM BOILER ROOM ON LOWER LEVEL TO OPERATOR CABIN FOR POWER/DATA CABLING PATHWAY(S). REFER TO LOW VOLTAGE RISER DIAGRAM, #2/E600, FOR MORE INFORMATION.

PROVIDE 3/4"C CONDUIT ROUTED FROM TELECOMMUNICATIONS HEAD END EQUIPMENT LOCATION TO ELEVATOR CONTROLLER FOR LOW-VOLTAGE TELEPHONE CABLING RACEWAY. CONTRACTOR SHALL PROVIDE (1) CAT6 CABLE FOR CONNECTION TO ELEVATOR CONTROL PANEL. EC SHALL COORDINATE EXACT LOCATIONS AND REQUIREMENTS WITH APPROVED ELEVATOR MANUFACTURER SHOP DRAWINGS PRIOR TO INSTALLATION.

PROVIDE ELEVATOR FUSED DISCONNECT EQUIPMENT IN ELEVATOR MACHINE ROOM. PROVIDE EATON ELEVATOR CONTROL SWITCH #ES SERIES WITH FIRE SAFETY INTERFACE RELAY, VOLTAGE MONITORING RELAY, AND AUXILIARY CONTACTS AS REQUIRED FOR FIRE ALARM SHUNT TRIP OPERATION OF ELEVATOR POWER. EC SHALL COORDINATE EXACT DISCONNECT LOCATION, SIZING AND FIRE ALARM RELAY SPECIFICATION WITH THE APPROVED ELEVATOR SUBMITTALS AND FIRE ALARM SYSTEM SUBMITTALS PRIOR TO ORDERING.

PROVIDE LOCKABLE 120V, 20-AMP CIRCUIT FOR POWER CONNECTION TO ELEVATOR CAB. EC SHALL COORDINATE EXACT LOCATION AND REQUIREMENTS WITH APPROVED MANUFACTURER'S SHOP DRAWINGS PRIOR TO ROUGH-IN.

> EC SHALL PROVIDE 208V, SINGLE-PHASE, 20A/2P ELECTRICAL CONNECTION WITH 30MA GFEP PROTECTION FOR HEAT TRACE SYSTEM CONTROL PANEL LOCATED IN BOILER ROOM AND HEAT TRACE CABLING LOCATED WITHIN TRENCH DRAIN AS INDICATED WITH DASHED LINE. EC SHALL COORDINATE EXACT LOCATIONS AND INSTALLATION REQUIREMENTS OF HEAT TRACE CABLE, CONTROL PANEL, THERMOSTATS, SENSORS, POWER CONNECTION KITS, INDICATOR LIGHTS, AND OTHER ACCESSORIES WITH MECHANICAL CONTRACTOR PRIOR TO COMMENCING WORK. REFER TO ENLARGED BOILER ROOM PLAN FOR CONTROLLER LOCATION. BASIS OF DESIGN SHALL BE RAYCHEM GM-2X CABLE, PROVIDED BY MECHANICAL CONTRACTOR. EC SHALL PROVIDE ANY ADDITIONAL ELECTRICAL BRANCH CIRCUIT POWER WIRING, CONDUIT, AND JUNCTION BOXES REQUIRED FOR A COMPLETE SYSTEM. EC SHALL COORDINATE EXACT ELECTRICAL CONNECTIONS AND REQUIREMENTS WITH MANUFACTURER'S INSTALLATION INSTRUCTIONS. REFER TO MECHANICAL DRAWINGS FOR ADDITIONAL INFORMATION AND CONTROL SYSTEM REQUIREMENTS.

APPROXIMATE LOCATION OF NEW TERMINAL ELECTRICAL CABINET EQUIPMENT 'DMEC', PROVIDED BY DOPPELMAYR USA. REFER TO ONE-LINE DIAGRAM FOR

ADDITIONAL INFORMATION. NEW POC (CONTROL STATION) SHOWN FOR REFERENCE ONLY. ALL DEVICE JUNCTION BOXES, CONDUIT, AND WIRING/TERMINATIONS PROVIDED BY OTHERS. NEW GATE ACCESS CONTROL STATION SHOWN FOR REFERENCE ONLY. ALL DEVICE JUNCTION BOXES, CONDUIT, AND WIRING/TERMINATIONS PROVIDED BY OTHERS.

NEW OPERATOR CABIN PRE-MANUFACTURED BUILDING SHALL BE PRE-WIRED FOR ALL INTERIOR AND EXTERIOR BUILDING MOUNTED POWER, LIGHTING, AND COMMUNICATIONS DEVICES. EC SHALL PROVIDE CONDUIT AND WIRING FOR NEW POWER FEEDER TO LIFTER TERMINAL ELECTRICAL CABINET 'DMEC' (PANEL PROVIDED BY OTHERS), AND NEW COMMUNICATIONS SERVICE TO OPERATOR CABIN (SEE ELECTRICAL SITE PLAN FOR MORE INFORMATION). ALL NEW UNDERGROUND CONDUIT ROUTED TO OPERATOR CABIN SHALL BE ROUTED THROUGH NEW STRUCTURAL BLOCK OUT IN OPERATOR CABIN FOUNDATION. EC SHALL COORDINATE EXACT BLOCK OUT LOCATION AND INSTALLATION REQUIREMENTS OF ALL ASSOCIATED CONDUIT/WIRING FOR OPERATOR CABIN POWER/TELECOMMUNICATIONS WITH DOPPELMAYR AND STRUCTURAL DRAWINGS

PRIOR TO COMMENCING WORK. PROVIDE 13"X24"X18"D HUBBELL QUAZITE PG SERIES IN-GRADE PULL-BOX WITH (2) PVC OUTDOOR RATED, WATER-TIGHT JUNCTION BOXES MOUNTED INSIDE PULL-BOX ENCLOSURE, (1) FOR POWER AND (1) FOR DATA CONNECTIONS TO NEW ENTRY GATE AND TICKET SCANNER EQUIPMENT. COORDINATE EXACT LOCATIONS WITH OWNER

PRIOR TO ROUGH-IN. COORDINATE INSTALLATION WITHIN FINISHED PAVERS WITH GENERAL CONTRACTOR. PROVIDE 3/4"C FROM SNOW/ICE DETECTOR TO BOILER ROOM SNOWMELT CONTROL PANEL FOR SENSOR CONTROL WIRING AS NECESSARY. COORDINATE EXACT ZONES/QUANTITIES, LOCATIONS AND INSTALLATION REQUIREMENTS WITH

MECHANICAL CONTRACTOR PRIOR TO COMMENCING WORK. PROVIDE NEW 120V, 20-AMP DUPLEX RECEPTACLE MOUNTED WITHIN NEW RETAINING WALL. COORDINATE EXACT INSTALLATION REQUIREMENTS WITH ARCHITECT AND RETAINING WALL CONSTRUCTION AS REQUIRED FOR FLUSH RECESSED DEVICE AND BOX/COVER MOUNTING. COORDINATE EXACT LOCATION AND MOUNTING HEIGHT IN-FIELD WITH OWNER PRIOR TO ROUGH-IN. APPROXIMATE LOCATION OF TELECOMMUNICATIONS CABINET IN OPERATOR CABIN TO BE MOUNTED BELOW FACP. REFER TO SITE PLAN AND LOW-VOLTAGE SERVICE

ENTRANCE CONDUIT ROUTING FOR MORE INFORMATION. EC SHALL PROVIDE WALL RECESSED JUNCTION BOX AND 3/4"C TO OPERATOR CABIN TELECOMMUNICATIONS HEAD END EQUIPMENT/CABINET FOR ELEVATOR LANDING TWO-WAY COMMUNICATIONS CALL STATION AND LOW-VOLTAGE CABLING. COORDINATE EXACT LOCATION AND REQUIREMENTS WITH ARCHITECT AND OWNER

SECURITY CABLING AS NECESSARY. REFER TO LIGHTING PLAN FOR POLE LIGHT LOCATIONS. COORDINATE EXACT REQUIREMENTS WITH OWNER AND SECURITY INSTALLER PRIOR TO ROUGH-IN.

FIRE ALARM CONTROL PANEL TO BE MOUNTED ABOVE TELECOMMUNICATIONS CABINET. COORDINATE EXACT MOUNTING HEIGHT WITH OWNER AND LOW-VOLTAGE INSTALLER PRIOR TO ROUGH-IN.

NOTICE: DUTY OF COOPERATION Release of these plans contemplates further cooperation among the owner, his contractor and the architect. Design and construction are complex. performed their services with due care and diligence they cannot guarantee perfection. Communication is imperfect and every contingency cannot be anticipated. Any ambiguity or discrepancy discovered by the use of these plans shall be reported immediately to the architect. Failure to notify the architect compounds misunderstanding and increases construction costs. A failure to cooperate by a simple notice to the architect shall relieve the architect from responsibility for the consequences. Changes made from the plans without consent of the architect are unauthorized and shall

Smith Associates, P.C. as instruments of service shall remain property of Eric Smith Associates, P.C. and shall not be copied, changed or disclosed in any form whatsoever without first obtaining the express written consent of Eric Smith Associates, P.C.

relieve the architect of responsibility for all

consequences arriving out of such changes.

Eric Smith Associates, P.C

No.	Description	Date
1	ADDENDUM #1	3/12/2021
3	ASI #1	4/19/2021
4	ASI #2	6/7/2021

Job Number: | 20034

Drawn By: BDJ, MAE Checked By: **Project Phase**

CONSTRUCTION DOCUMENTS

Sheet Title ELECTRICAL FIRST LEVEL POWER PLAN

Sheet Number

Integrated Lighting and Electrical Solutions 1900 Wazee Street #205 | Denver, CO 80202 | 303.296.3034

1 | FIRST LEVEL - ELECTRICAL POWER PLAN

E111 1/8" = 1'-0"

B. CIRCUIT ALL EMERGENCY LIGHTING UNITS AND EXIT SIGNS TO NEAREST LINE VOLTAGE CIRCUIT, AHEAD OF ALL SWITCH LEGS.

KEYNOTE LEGEND

KEY VALUE

KEYNOTE TEXT

EC TO PROVIDE MOUNTING EQUIPMENT AND ACCESSORIES TO COORDINATE MOUNTING HEIGHT TO BE 12'-0" AFF OF BOILER ROOM FLOOR.

35717 06/11/2021

NOTICE: DUTY OF COOPERATION

Release of these plans contemplates further cooperation among the owner, his contractor and the architect. Design and construction are complex.

Although the architect and his consultants have performed their services with due care and diligence, they cannot guarantee perfection. Communication is imperfect and every contingency cannot be anticipated. Any ambiguity or discrepancy discovered by the use of these plans shall be reported immediately to the architect. Failure to notify the architect compounds misunderstanding and increases construction costs. A failure to cooperate by a simple notice to the architect shall relieve the architect from responsibility for the consequences. Changes made from the plans without consent of the architect of responsibility for all consequences arriving out of such changes.

All design, documents and data prepared by Eric Smith Associates, P.C. as instruments of service shall remain property of Eric Smith Associates, P.C. and shall not be copied, changed or disclosed in any form whatsoever without first obtaining the express written consent of Eric Smith Associates, P.C.

NDOLA N SS, CO

STEAMBOAT SPRINGS, CO

ERIC SMITH ASSOCIATES, P.C.

Job Number: 20034
Date: 03/29/2
Drawn By: BDJ, MAE
Checked By: 1PK


Project Phase

CONSTRUCTION DOCUMENTS


Sheet Title


Sheet Title
ELECTRICAL LOWER LEVEL
LIGHTING PLAN
Sheet Number


E201

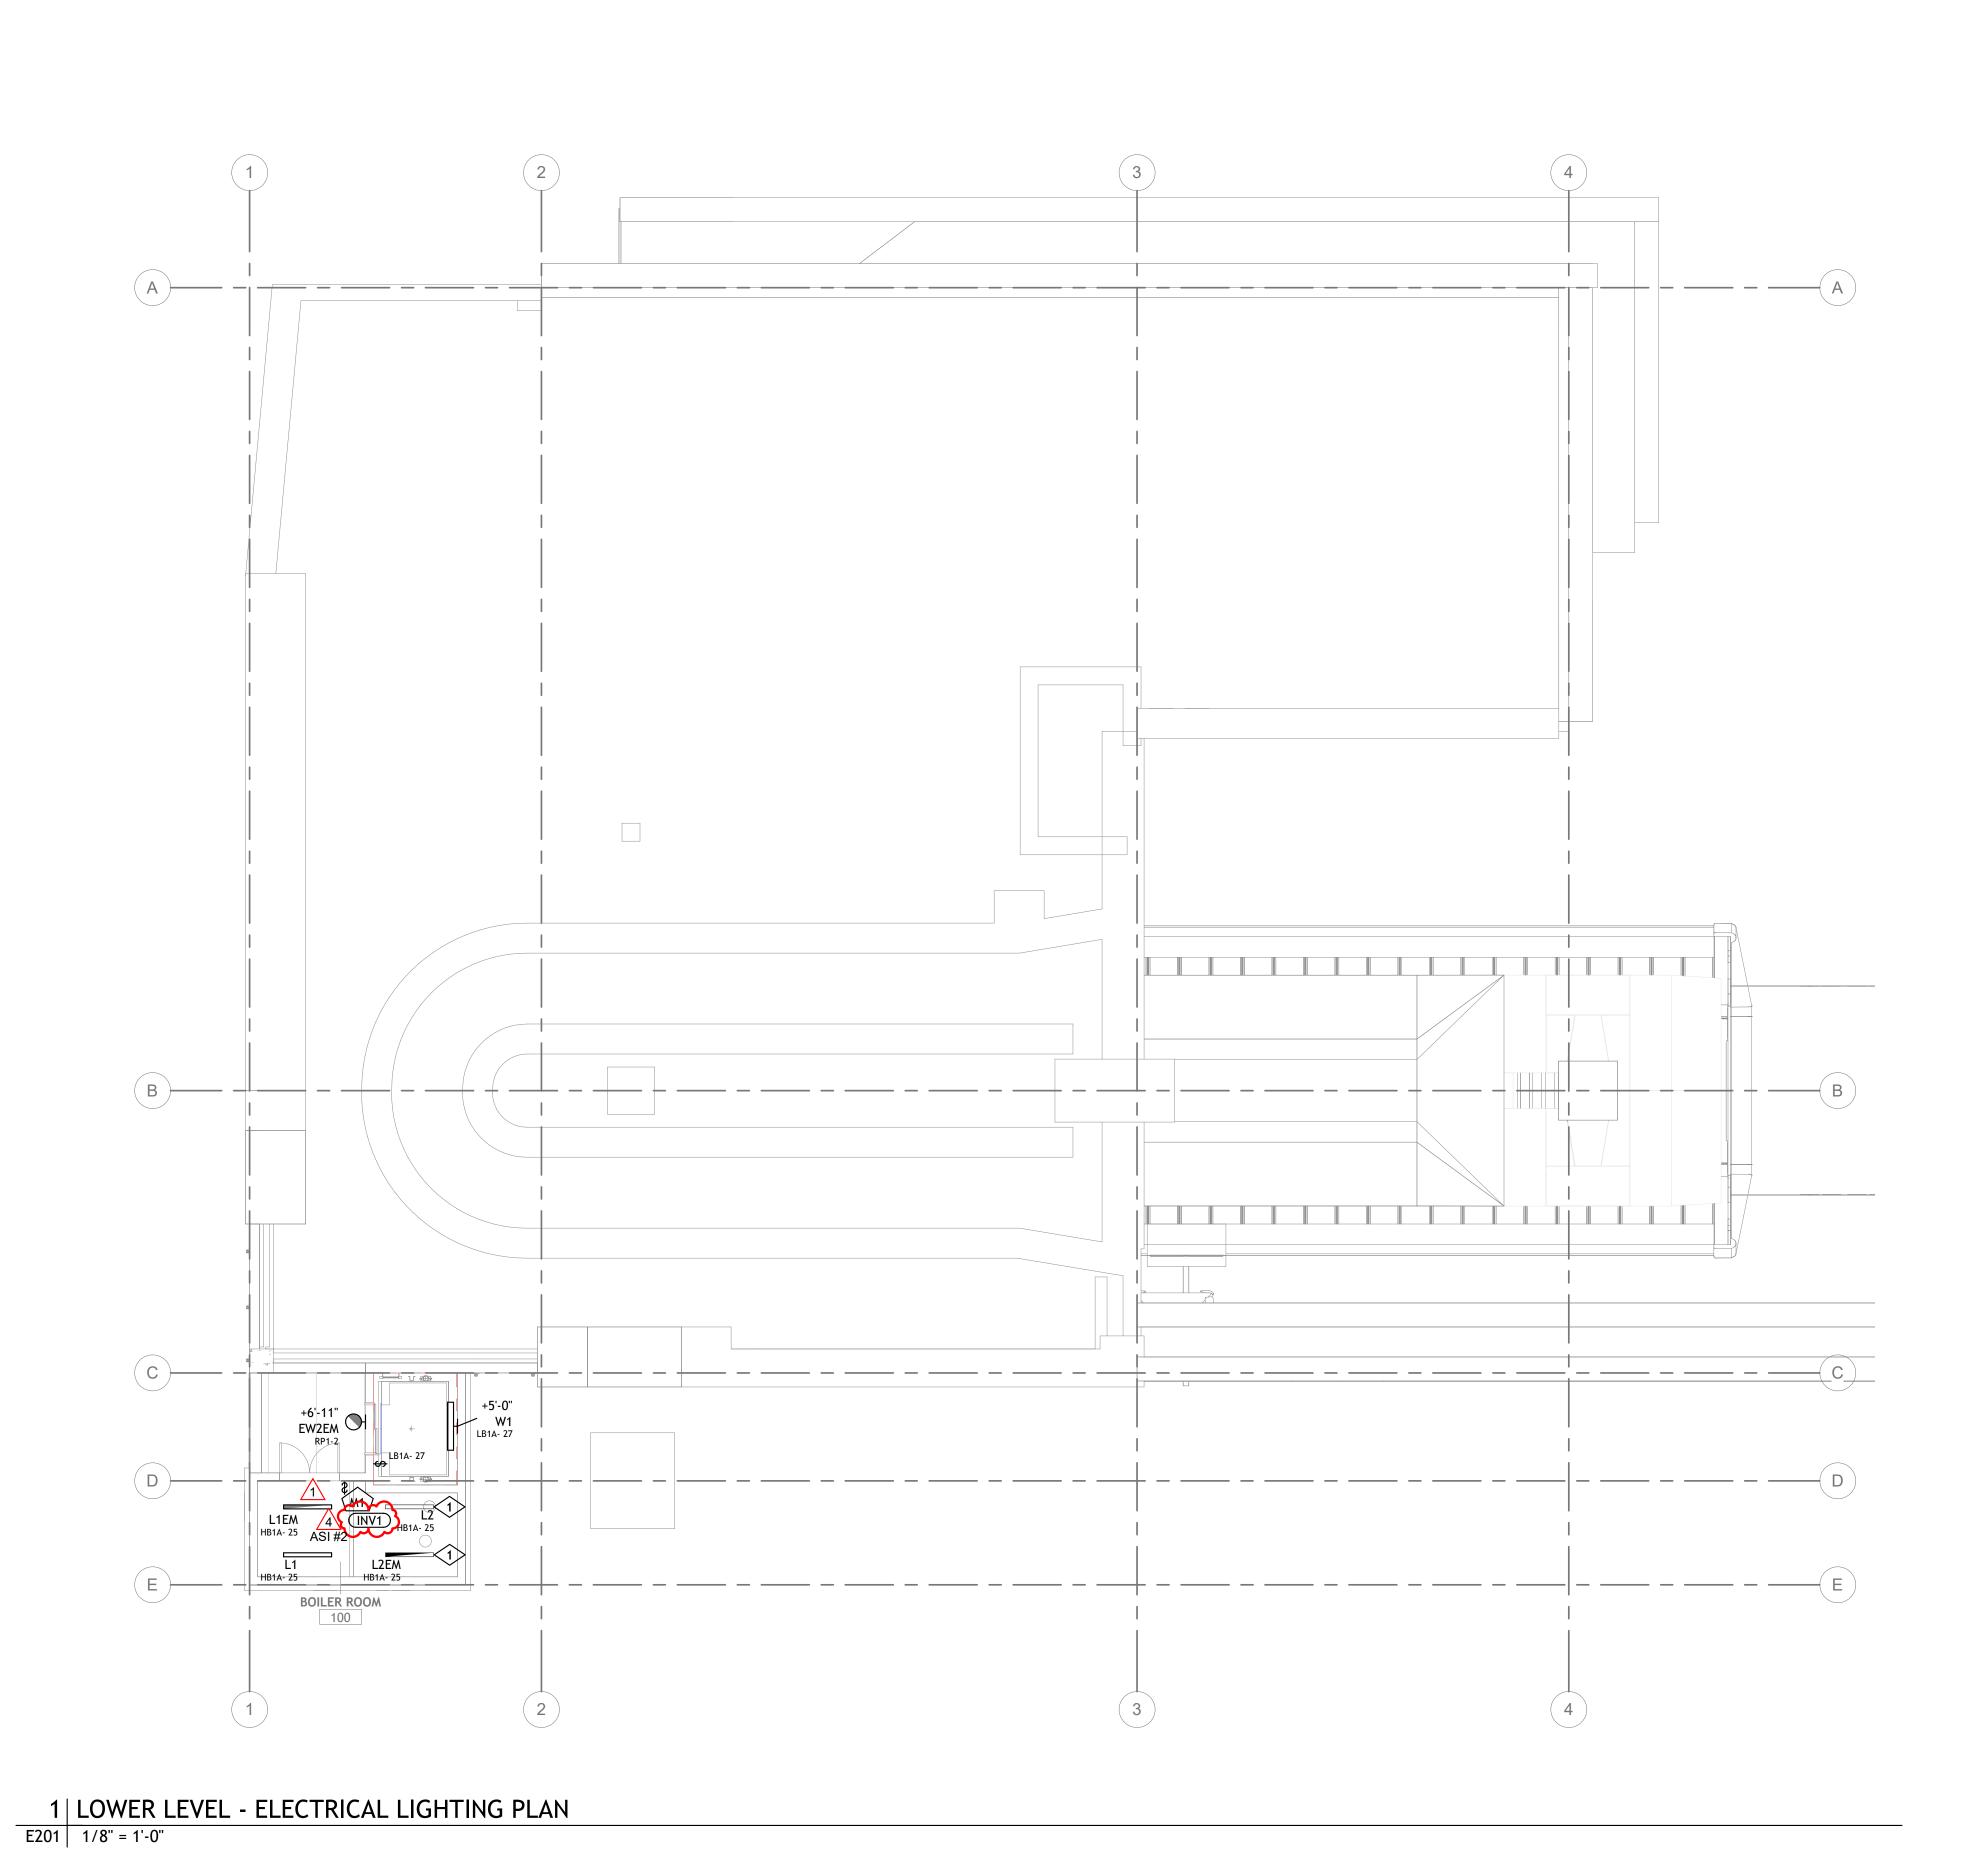

AE DESIGN
Integrated Lighting and Electrical Solutions
1900 Wazee Street #205 | Denver, CO 80202 | 303.296.3034
aedesign-inc.com Project #: 5155.00

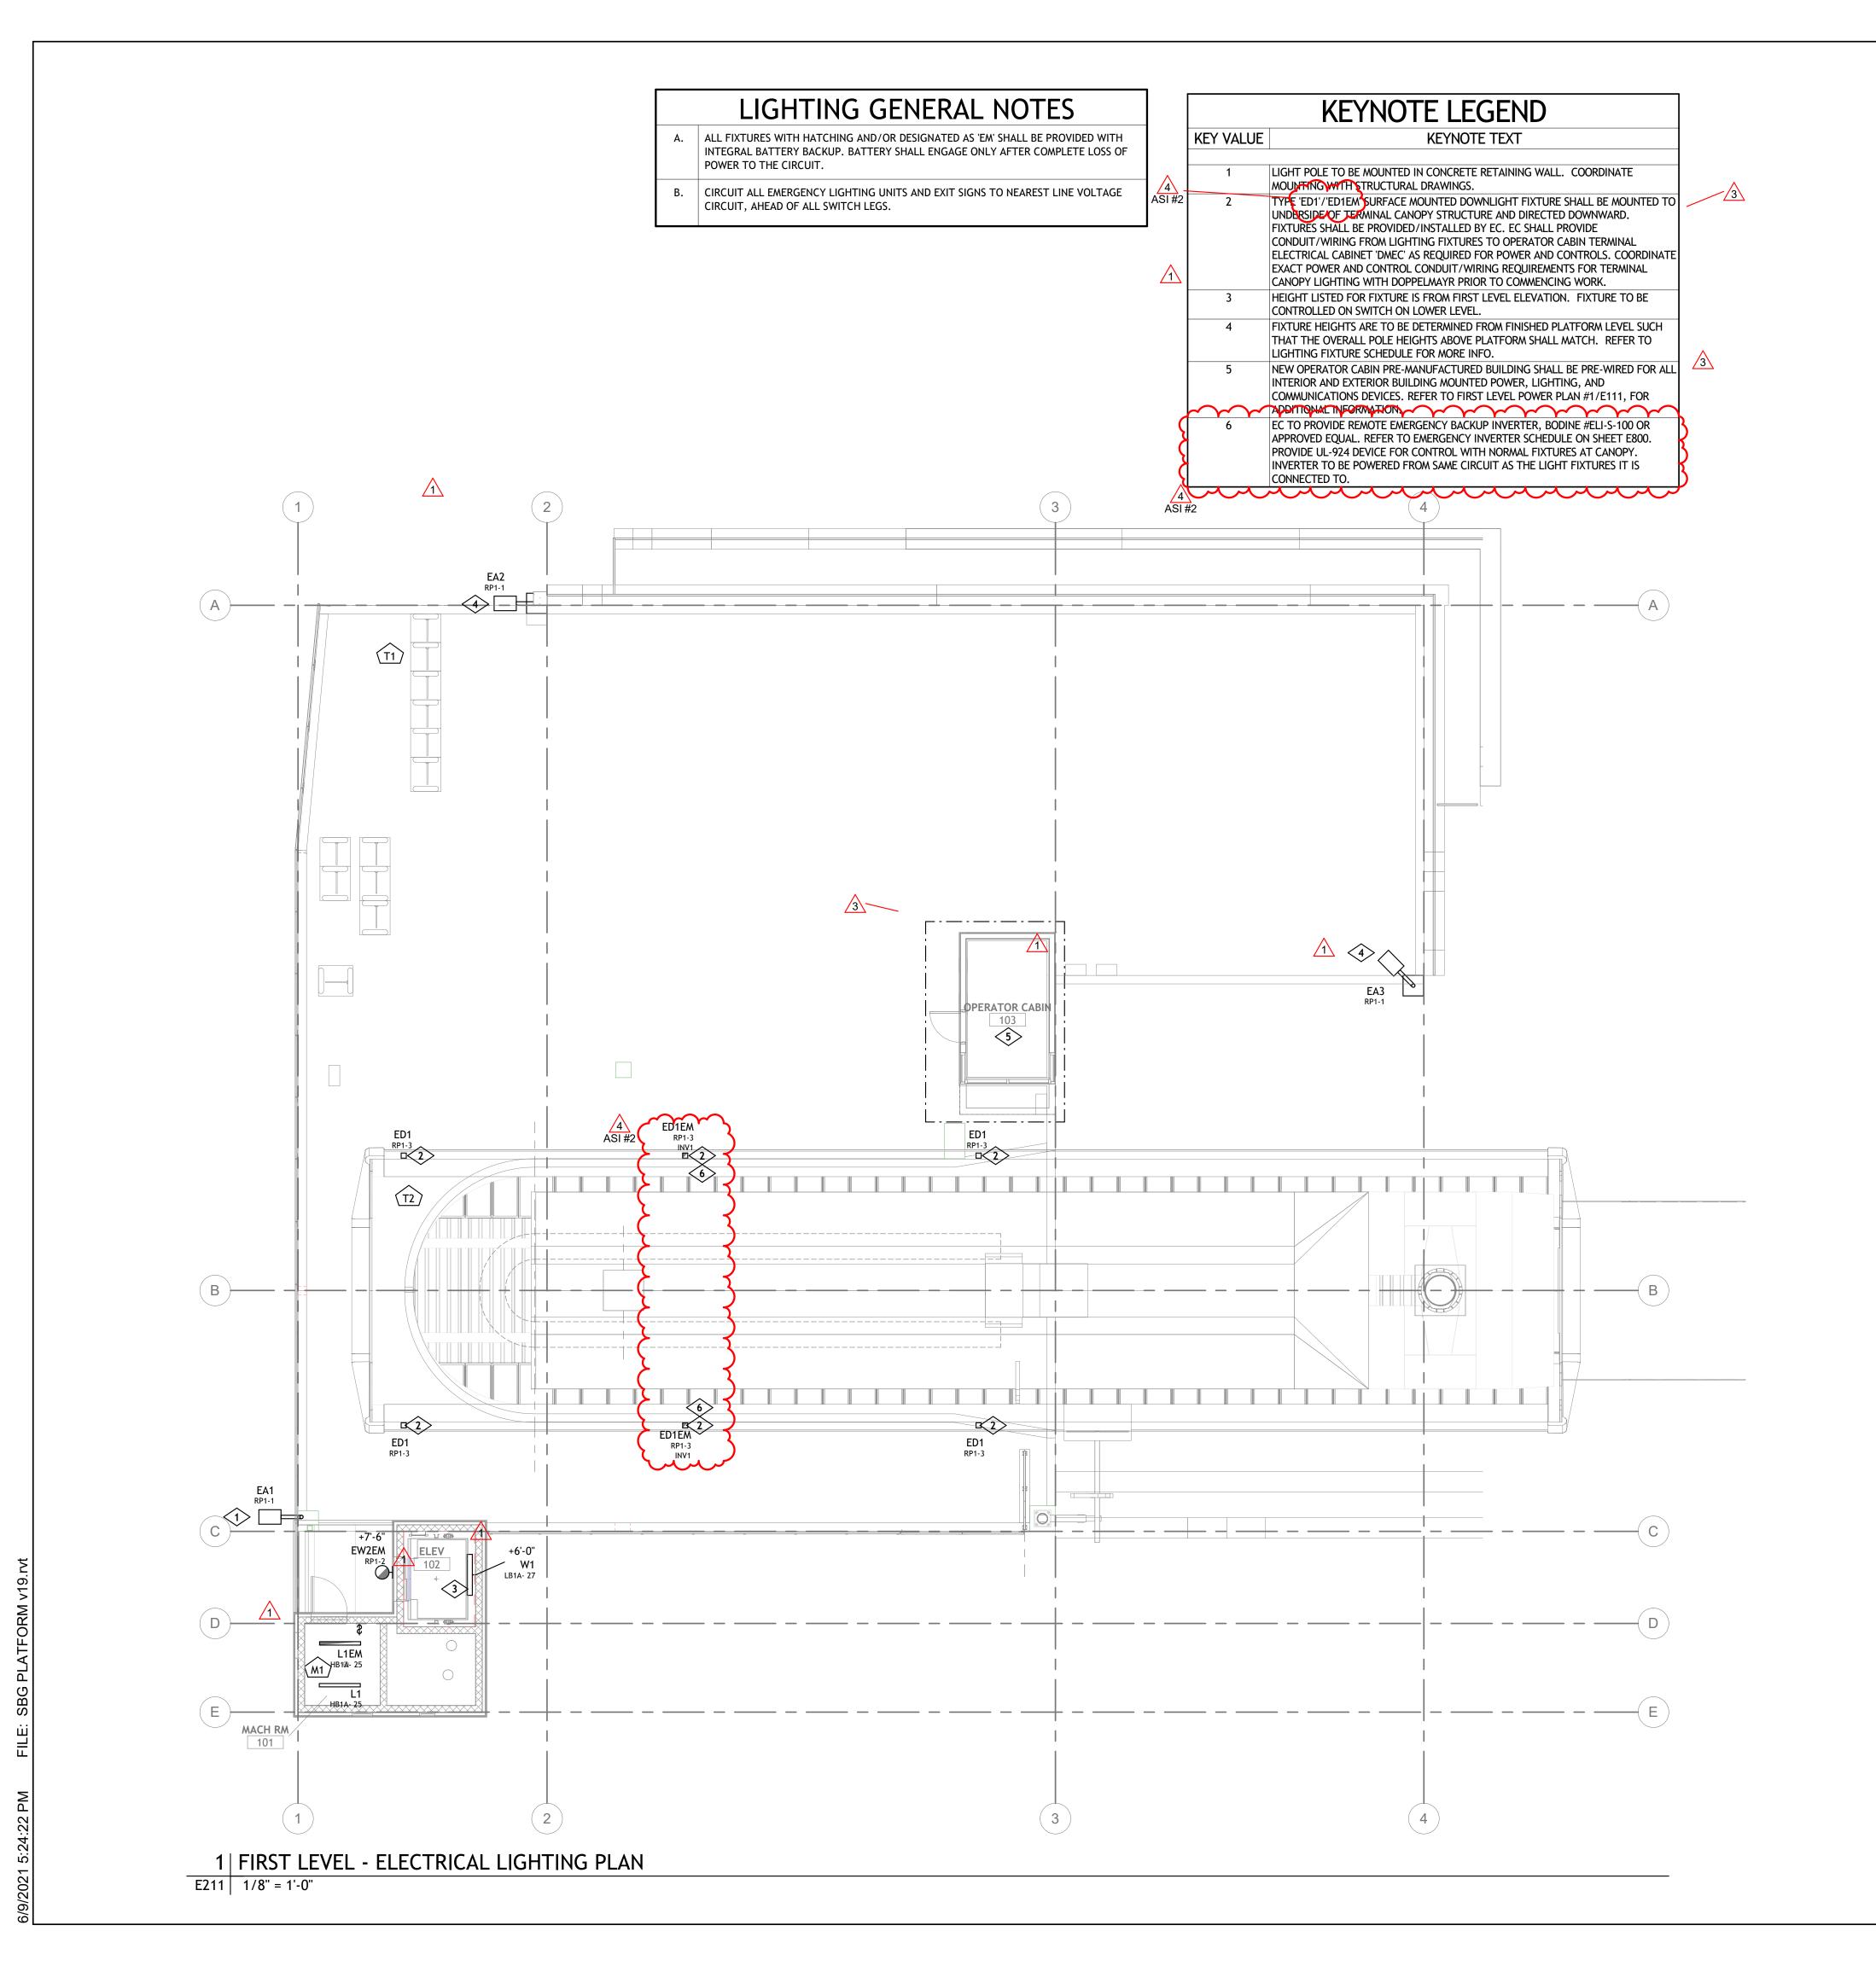

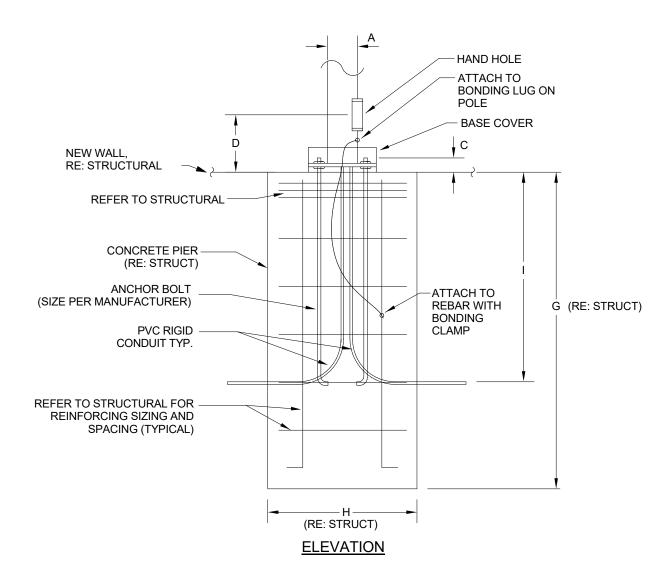

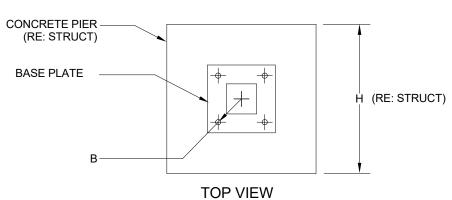

POLE	OVERALL	۸	ANCHO	CHOR BOLT DATA			F	Е	C	Н	ı
KEY	HEIGHT	ζ	В	SIZE	С	ם	_	'	G	'''	'
EA1/2/3	15'0"	4"	PE	R MANU	R MANUFACTUR		N/A	N/A	RE: S	TRUCT	36"

LIGHTING POLE SHALL BE INSTALLED INTO CAST-IN-PLACE STRUCTURAL CONCRETE PIER INTEGRATED WITH STRUCTURAL WALL/FOUNDATION SYSTEM, REFER TO STRUCTURAL DRAWINGS FOR ADDITIONAL INFORMATION REGARDING CONCRETE PIER AND FOUNDATION INSTALLATION REQUIREMENTS INCLUDING CONCRETE PIER SIZING, LOCATIONS, AND REINFORCING SIZING. ELECTRICAL CONTRACTOR SHALL COORDINATE INSTALLATION OF POLE ELECTRICAL CONNECTIONS, BONDING, AND CONDUIT WITH STRUCTURAL DRAWINGS AND GENERAL CONTRACTOR PRIOR TO COMMENCING WORK.

2 EA1, EA2, EA3 POLE BASE DETAIL

E211 N.T.S.

06/11/2021

NOTICE: DUTY OF COOPERATION Release of these plans contemplates further cooperation among the owner, his contractor and the architect. Design and construction are complex. Although the architect and his consultants have performed their services with due care and diligence they cannot guarantee perfection. Communication is imperfect and every contingency cannot be anticipated.
Any ambiguity or discrepancy discovered by the use of these plans shall be reported immediately to the architect. Failure to notify the architect compounds misunderstanding and increases construction costs. A failure to cooperate by a simple notice to the architect shall relieve the architect from responsibility for the consequences. Changes made from the plans without consent of the architect are unauthorized and shall relieve the architect of responsibility for all consequences arriving out of such changes. All design, documents and data prepared by Eric Smith Associates, P.C. as instruments of service shall remain property of Eric Smith Associates, P.C.

and shall not be copied, changed or disclosed in any form whatsoever without first obtaining the express written consent of Eric Smith Associates, P.C. Eric Smith Associates, P.C

REVISIONS Description ADDENDUM #1 3/12/2021 ASI #1 4/19/2021 ASI #2 6/7/2021

STE,

Job Number: 20034 Drawn By: Checked By:

Project Phase CONSTRUCTION DOCUMENTS

Sheet Title

ELECTRICAL FIRST FLOOR

LIGHTING PLAN **Sheet Number**

AE DESIGN Integrated Lighting and Electrical Solutions


1900 Wazee Street #205 | Denver, CO 80202 | 303.296.3034

aedesign-inc.com Project #: 5155.00


- THE CONTRACTOR IS RESPONSIBLE FOR THE COMPLETE DEMOLTION, REPAIR AND REPLACEMENT AS REQUIRED. THE CONTRACTOR, AND ITS SUBCONTRACTORS, ARE SOLELY RESPONSIBLE FOR DETERMINING THE EXTENT OF DEMOLITION AND REPLACEMENT OF EXISTING ELECTRICAL INFRASTRUCTURE OR EQUIPMENT IN AREAS WHERE HIDDEN WORK IS INDICATED IN THE DOCUMENTS (SUCH AS UNDERGROUND WORK) OR CAN BE INFERRED AS BEING REQUIRED DUE TO THE NATURE OF THE WORK. THE DOCUMENTS ARE INTENDED TO BE A GUIDE, AND ARE NOT INTENDED TO PROVIDE DEFINITIVE SCOPE REQUIREMENTS FOR EXACT EXISTING CONDITIONS. THE CONTRACTOR SHALL INSTALL AND MAINTAIN ALL NECESSARY COVERINGS, PROTECTIVE ENCLOSURES, TEMPORARY PARTITIONS AND BARRIERS TO PROVIDE SECURITY AND PROTECTION TO ALL OCCUPANTS, EQUIPMENT, AND NEW/EXISTING WORK. REPAIR AND REPLACE ANY DAMAGE CAUSE BY IMPROPER PROTECTION AT NO ADDITIONAL COST TO OWNER. NEW OR EXISTING INSTALLATIONS DAMAGED DURING CONSTRUCTION/DEMOLITION OR NOT CONFORMING TO SPECIFIED STANDARDS, TOLERANCES OR MANUFACTURER'S INSTRUCTIONS FOR INSTALLATION SHALL BE REPLACED AT NO ADDITIONAL COST TO
- THE BASIS OF THESE DRAWINGS WERE SITE OBSERVATIONS, ORIGINAL BUILDING DRAWINGS AND VARIOUS OTHER SOURCES. EVERY ATTEMPT HAS BEEN MADE TO DOCUMENT THE ACTUAL CONDITIONS. HOWEVER, THE CONTRACTOR SHALL CAREFULLY EXAMINE THE CONTRACT DOCUMENTS, VISIT THE SITE, AND THOROUGHLY BECOME FAMILIAR WITH THE BUILDING STANDARDS, AND THE EXISTING SITE CONDITIONS RELATING TO THE WORK. FAILURE TO DO SO WILL NOT RELIEVE THE CONTRACTOR OF THE OBLIGATIONS OF THE CONTRACT.
- THE ELECTRICAL CONTRACTOR SHALL NOTIFY THE ARCHITECT/ENGINEER/OWNER OF ANY MATERIALS OR APPARATUS BELIEVED TO BE INADEQUATE, UNSUITABLE, IN VIOLATION OF LAWS, ORDINANCES, RULES OR REGULATIONS OF AUTHORITIES HAVING JURISDICTION.
- THE ELECTRICAL CONTRACTOR SHALL INCLUDE IN HIS COST THE REMOVAL OF ALL EXISTING ELECTRICAL DEVICES, CONDUITS, FIXTURES AND EQUIPMENT AS NOTED AND REQUIRED TO ACCOMMODATE SCOPE OF WORK. COORDINATE REMOVAL AND DISCARDING OF ALL EQUIPMENT WITH OWNER.
- EXISTING EQUIPMENT NOT NOTED AS EXISTING (E) OR INDICATED ON PLANS SHALL REMAIN, AS THEY PRESENTLY EXIST.
- THE DEMOLITION OF SOME DEVICES OR EQUIPMENT MAY INTERRUPT POWER TO DEVICES DOWN STREAM. THE ELECTRICAL CONTRACTOR IS RESPONSIBLE FOR RE-WORKING THESE CIRCUITS TO MAINTAIN POWER TO THE DOWN STREAM DEVICES AND EQUIPMENT WHICH WILL REMAIN.
- ALL UNENERGIZED/DEMOLISHED CIRCUITRY SHALL HAVE THE CONDUCTORS REMOVED FROM THE CONDUIT AND THE CONDUIT SHALL BE MARKED "EMPTY" WITH INDELIBLE MARKER.

LOAD SUMMARY EXISTING MAIN DISTRIBUTION PANEL (MDP) (600A, 480/277V, 3PH, 4W) NEW LOAD ON PANEL 'LV1' 15.2 KVA 42.2 AMPS REMOVED LOAD ON PANEL 'HV1' -5.0 KVA -13.9 AMPS (DEMOLISHED LOAD CENTER) REMOVED LOAD ON PANEL 'HV1' -49.8 KVA -138.3 AMPS (REMOVED CARPET LIFTS) NET REMOVED LOAD -40 KVA -47.6 AMPS(**) AT 480/277V, 3PH (**)TOTAL REMOVED LOAD IS GREATER THAN ADDED/NEW LOAD ON EXISTING PANEL 'MDP', THEREFORE THE LOAD IS JUSTIFIED.

GENERAL NOTES A. PER APPROVED VE ALTERNATE ALUMINUM CONDUCTOR WIRING SHALL BE ACCEPTABLE FOR DISTRIBUTION WIRING RATED 100-AMPS AND LARGER. ALL ALUMINUM WIRING TERMINATIONS SHALL BE MADE WITH APPROPRIATE CONNECTORS, HARDWARE AND OTHER MATERIALS AND COMPONENTS LISTED AND RATED FOR ALUMINUM WIRING CONNECTIONS AS REQUIRED PER NEC. ALUMINUM WIRING AND TERMINATIONS SHALL BE INSTALLED ACCORDING TO LATEST NECA/AA-104 STANDARDS AND REQUIREMENTS. SEE ONE-LINE DIAGRAM AND ALUMINUM FEEDER SCHEDULE FOR SPECIFIED ALUMINUM FEEDERS.

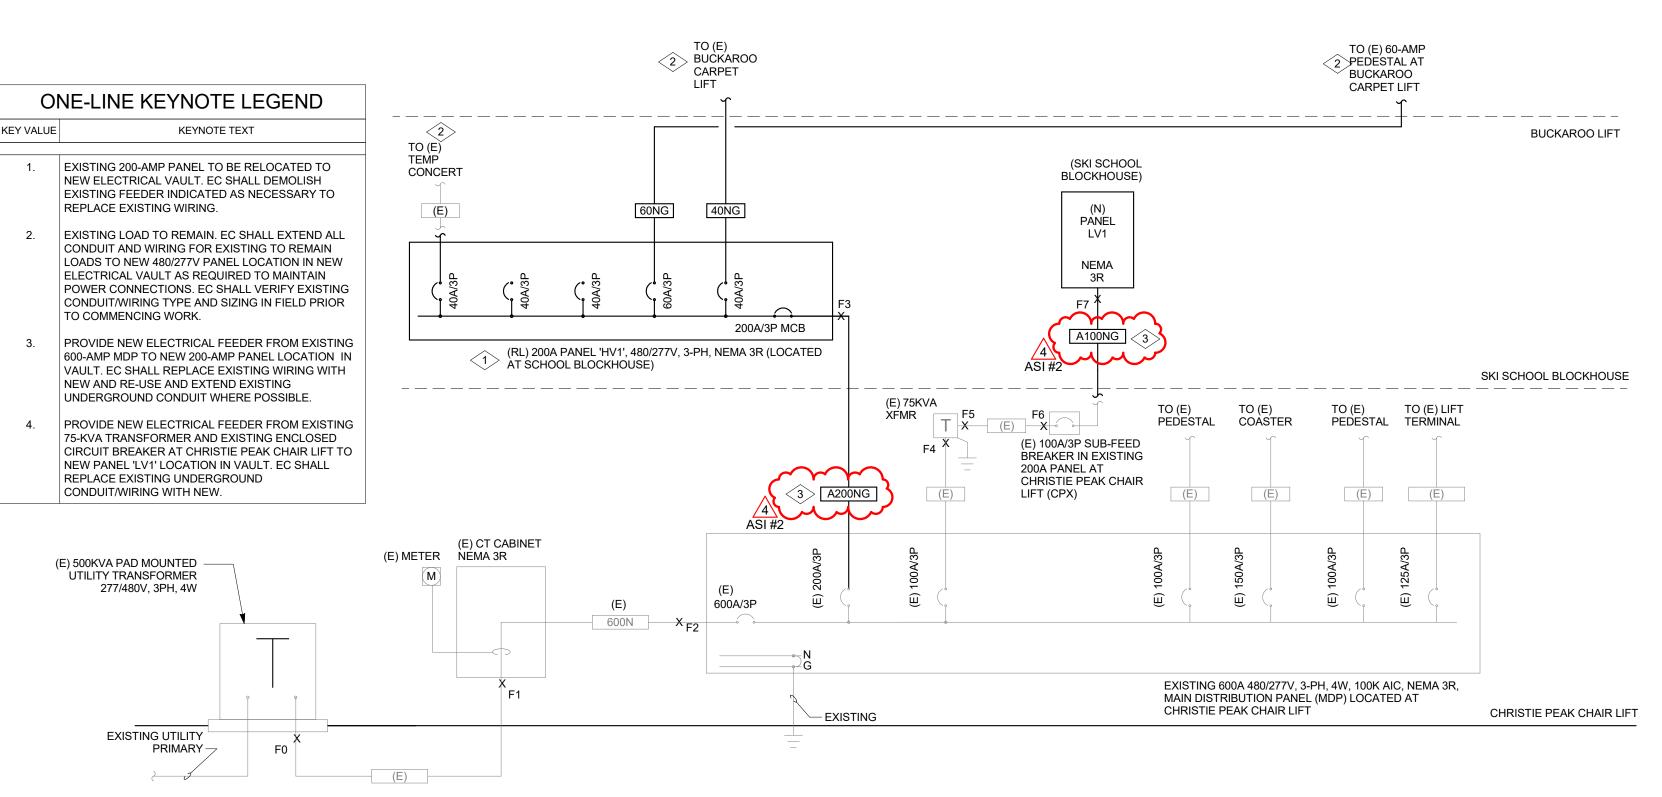


3 | VAULT NEW ELECTRICAL ONE-LINE DIAGRAM

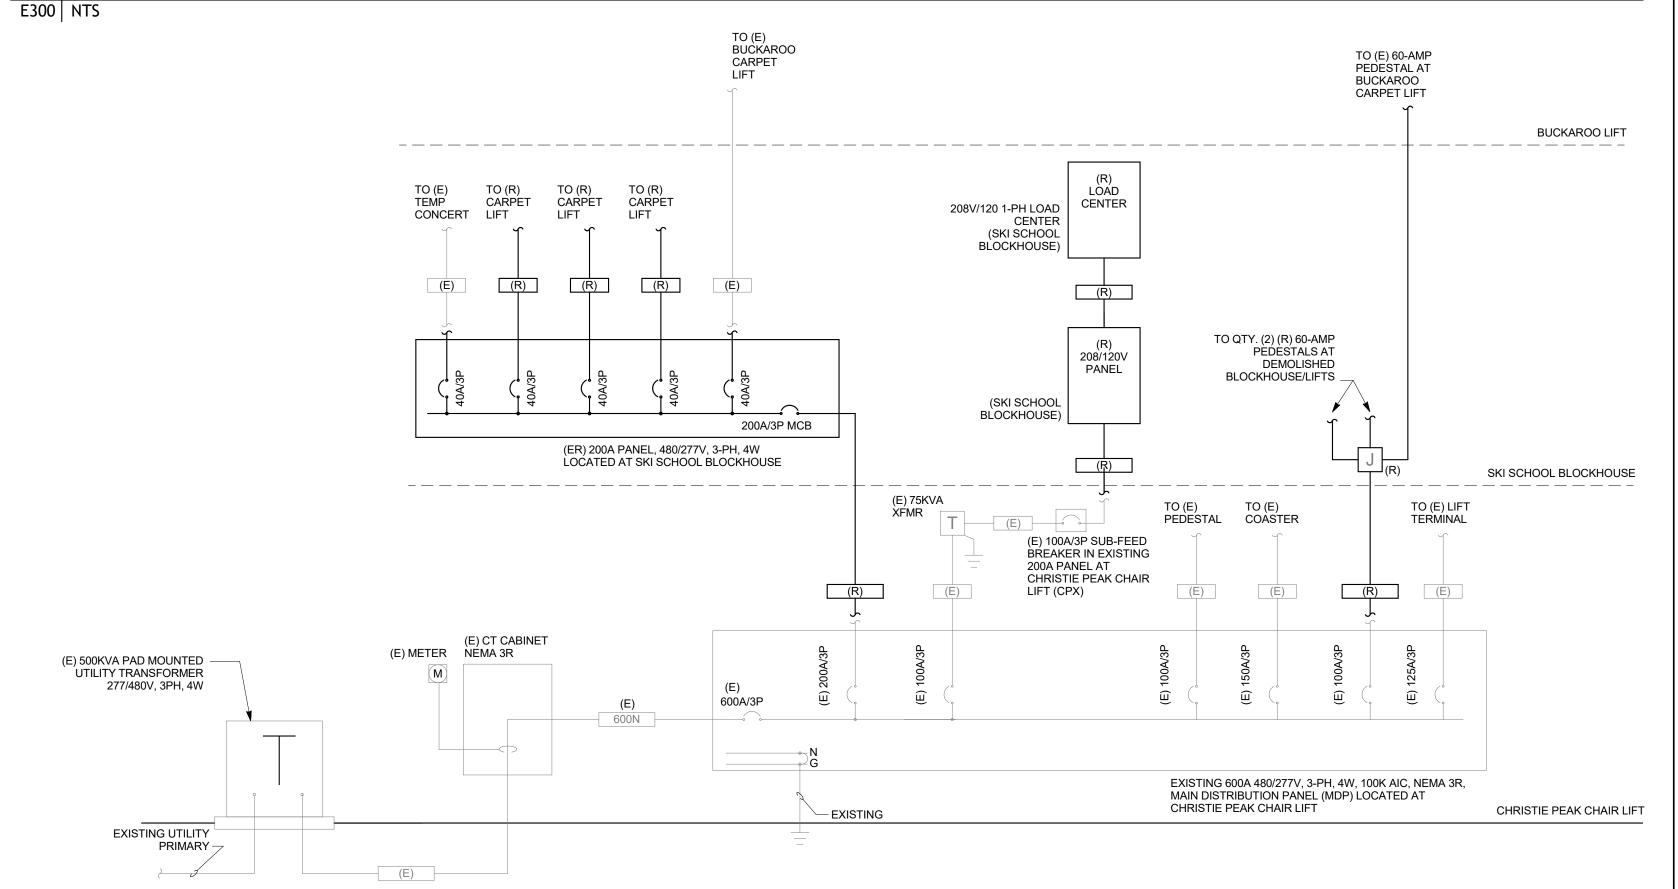

2 | VAULT DEMO ELECTRICAL ONE-LINE DIAGRAM E300 NTS

POINT	LOCATION	LENGTH (L)	VOLTAGE	VOLTAGE	PHASE	WIRE	CONDUCTOR	CONDUCTOR	CONDUIT	VOLTAGE	С	# OF PARALLEL	Isc AVAILABLE	Isc	POINT
	DESCRIPTION	(ft)	(EL-L)	(EL-N)		SIZE	MATERIAL	TYPE	MATERIAL	CLASS	VALUE	RUNS	UPSTREAM	AT EQUIP	
														(I3ph) OR (IL-L)	
F0	500 KVA UTILITY XFMR													100,000	F0
F1	(E) CT CABINET	10	480	277	3	350	COPPER	THREE SINGLE CONDUCTORS	NONMAGNETIC	600V	22736	2	100,000	92,648	F1
~P3~	(E) 600/ MDP	√ 5 √	189	217~		350	COPPER	THREE SINCLE CONDUCTORS	SVEET	~000	19703		92,648	\\\\\\\\\\\\\\\\\\\\\\\\\\\\\\\\\\\\\\	1 2
F3	PANEL 'HV1	150	4 <mark>8</mark> 0	277	3	250	ALUMINUM	THREE SINGLE CONDUCTORS	STEEL	600V	12122	1	88,878	17,889	F3
	EL JOKWA XPMR PRI		480	1 2/1	حري ا		CORPER	THREE SINGLE CONDUCTORS		6004	202		7,88	16,434	
F5	(E) 75KVA XFMR SEC	1	208	120	3	3X	COPPER	THREE SINGLE CONDUCTORS	STEEL	600V	12843	1	5,538	5,518	F5
~~~	(F) PANEL AT CXP	5	208	20		-OA	COPPER	THREE SINGLE SONDUCTORS	SVEEL	600	12845	$ \sim \sim \sim$	5,518	5,427	
F7	(N) PANEL 'LV1'	150	208	120	3	1	ALUMINUM	HREE SINGLE CONDUCTORS	STEEL	600V	4645	1	5,421	2,206	F7
NOTES:					_										
	ALL CALCULATIONS WERE														
2.	REFER TO PLANS FOR ASSU	JMED UTILITY TRA	NSFORMER SIZ	ZE UTILIZED FOR	R CALCULA	TIONS. EX	KACT TRANSFORME	ER SIZE, IMPEDANCE, AND AVAILABLE	SHORT CIRCUIT CURRE	ENT SHALL BE \	ERIFIED WITH	I UTILITY PRIOR			
	TO ORDERING ELECTRICAL	EQUIPMENT. CON	ITRACTOR SHA	LL NOTIFY ENGI	NEER OF A	NY DISCF	REPANCIES.								
	DISTRIBUTION TRANSFORM	ED IMPEDANCES	LIGED IN THE C	ALCHILATIONS M	EDE TAKE	I EBOM E	ATON'S PURI ISHE	D IMPEDANCES FOR DOE 2016 DRY-T	PE TRANSFORMERS						

**Integrated Lighting and Electrical Solutions** 1900 Wazee Street #205 | Denver, CO 80202 | 303.296.3034

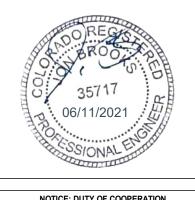

NOTICE: DUTY OF COOPERATION Release of these plans contemplates further cooperation among the owner, his contractor and the architect. Design and construction are complex. Although the architect and his consultants have performed their services with due care and diligence they cannot guarantee perfection. Communication is imperfect and every contingency cannot be anticipated. Any ambiguity or discrepancy discovered by the use of these plans shall be reported immediately to the architect. Failure to notify the architect compounds misunderstanding and increases construction costs. A failure to cooperate by a simple notice to the architect shall relieve the architect from responsibility for the consequences. Changes made from the plans without consent of the architect are unauthorized and shall relieve the architect of responsibility for all consequences arriving out of such changes. All design, documents and data prepared by Eric Smith Associates, P.C. as instruments of service shall remain property of Eric Smith Associates, P.C. and shall not be copied, changed or disclosed in any form whatsoever without first obtaining the express

written consent of Eric Smith Associates, P.C. Eric Smith Associates, P.C **REVISIONS** Date Description 4/19/2021 4 ASI #2

**Job Number:** 20034 Drawn By: Checked By: Checker

Project Phase CONSTRUCTION DOCUMENTS


**Sheet Title** ELECTRICAL VAULT PLAN

**Sheet Number** 

## KEYNOTE LEGEND **KEYNOTE TEXT**

KEY VALUE

- PROVIDE 120V, 20-AMP POWER CONNECTION TO NEW VALVE CONTROL PANEL FOR SNOW-MAKING EQUIPMENT VALVE/ACTUATOR CONTROLS. EC SHALL COORDINATE EXACT LOCATION AND REQUIREMENTS WITH NEW OWNER (STEAMBOAT SKI AND RESORT) IN FIELD PRIOR TO COMMENCING WORK.
- EC SHALL PROVIDE 120V, 20-AMP POWER CONNECTIONS TO EACH SNOW-MAKING VALVE ACTUATOR/MOTOR AS REQUIRED. EC SHALL ANTICIPATE APPROXIMATELY (6) OUTLET VALVE ACTUATOR CONNECTIONS AND (1) MAIN-SUPPLY VALVE ACTUATOR CONNECTION IN THE SNOW-MAKING VAULT. EC SHALL COORDINATE EXACT LOCATION AND REQUIREMENTS WITH NEW OWNER (STEAMBOAT SKI AND RESORT) IN FIELD PRIOR TO COMMENCING WORK.
- PROVIDE 18"X24"X6"D WALL-MOUNTED TELECOMMUNICATIONS ENCLOSURE/PULL-BOX WITH 3" CONDUIT KNOCKOUTS LOCATED IN NEW UNDERGROUND ELECTRICAL VAULT FOR FIBER OPTIC AND COMMUNICATIONS CABLING ROUTED THROUGH VAULT TO NEW GONDOLA PLATFORM BUILDING OPERATOR CABIN AS SHOWN. ASSEMBLY AND ALL COMPONENTS SHALL BE UL LISTED AND NEMA 3R RATED FOR OUTDOOR LOCATIONS. PROVIDE "COMMUNICATIONS" LABEL ON COVER. COORDINATE EXACT LOCATION OF PULL-BOX ENCLOSURE WITH OWNER PRIOR TO COMMENCING WORK. REFER TO ELECTRICAL SITE PLAN, SHEET E010, AND LOW-VOLTAGE RISE DIAGRAM, SHEET E600, FOR ADDITIONAL INFORMATION.

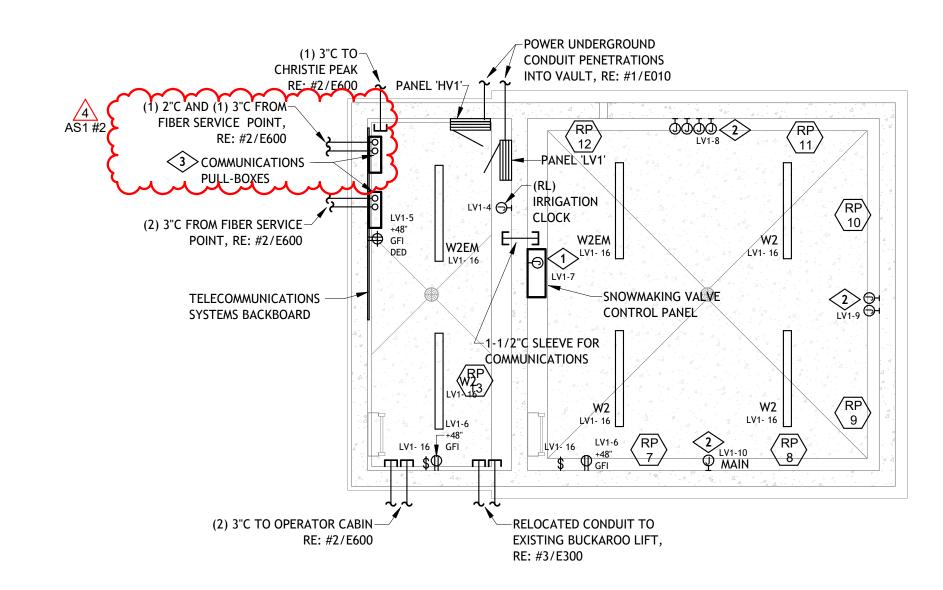

1 | LOWER LEVEL - ELECTRICAL POWER PLAN - VAULT

E300 1/4" = 1'-0"

ALL GROUND CONNECTORS SHALL BE STRANDED.

ALL BUS BARS SHALL BE ATTACHED TO SURFACE WITH NON-CONDUCTIVE STAND-OFFS.

GROUND BUS BAR AND GROUNDING SYSTEM SHALL BE UL LISTED AND COMPLY WITH MANUFACTURERS INSTALLATION INSTRUCTIONS.

## GROUNDING ELECTRODE SYSTEMS NOTES

METAL UNDERGROUND WATER PIPE - MAKE CONNECTION TO METAL UNDERGROUND WATER PIPE IN DIRECT CONTACT WITH THE EARTH FOR 10' OR AND ELECTRICALLY CONTINUOUS TO THE POINTS OF CONNECTION TO THE GROUNDING ELECTRODE CONDUCTOR AND BONDING CONDUCTORS. CONNECTION POINT TO BE AT A MAXIMUM OF 5' OF THE POINT OF ENTRANCE ON THE INTERIOR OF THE BUILDING.


BUILDING STEEL - THE METAL FRAME OF THE BUILDING OR STRUCTURE, WHERE ANY OF THE FOLLOWING METHODS ARE USED TO MAKE AN EARTH CONNECTION:

A. AT LEAST ONE STRUCTURAL METAL MEMBER THAT IS IN DIRECT CONTACT WITH THE EARTH FOR 10' OR MORE, WITH OR WITHOUT CONCRETE ENCASEMENT.

HOLD-DOWN BOLTS SECURING THE STRUCTURAL STEEL COLUMN THAT ARE CONNECTED TO A CONCRETE ENCASED ELECTRODE THAT COMPLIES WITH 250.52(A)(3) AND IS LOCATED IN THE SUPPORT FOOTING OR FOUNDATION. THE HOLD-DOWN BOLTS SHALL BE CONNECTED TO THE CONCRETE-ENCASED ELECTRODE BY WELDING, EXOTHERMIC WELDING, THE USUAL STEEL TIE WIRES, OR OTHER APPROVED MEANS.


UFER GROUND (CONCRETE-ENCASED ELECTRODE) - AN ELECTRODE ENCASED BY AT LEAST 2" OF CONCRETE, LOCATED WITHIN AND NEAR THE BOTTOM OF A CONCRETE FOUNDATION OR FOOTING THAT IS IN DIRECT CONTACT WITH EARTH, CONSISTING OF AT LEAST 20' OF ONE OR MORE BARE OR ZINC GALVANIZED OR OTHER ELECTRICALLY CONDUCTIVE COATED STEEL REINFORCING BARS OR RODS OF NOT LESS THAN 1/2" IN DIAMETER, OR CONSISTING OF AT LEAST 20' OF BARE COPPER CONDUCTOR NOT SMALLER THAN NO. 4 AWG. REINFORCING BARS SHALL BE PERMITTED TO BE BONDED TOGETHER BY THE USUAL STEEL TIE WIRES OR OTHER EFFECTIVE MEANS.

GROUND ROD - ROD IS TO BE 8FT IN LENGTH AND SHALL BE MADE OF IRON OR STEEL AT LEAST 5/8" DIAMETER. INSTALLATION METHODS FOR GROUND ROD SHALL BE IN COMPLIANCE WITH THE NEC SUCH THAT AT LEAST 8' OF LENGTH IS IN CONTACT WITH THE EARTH.

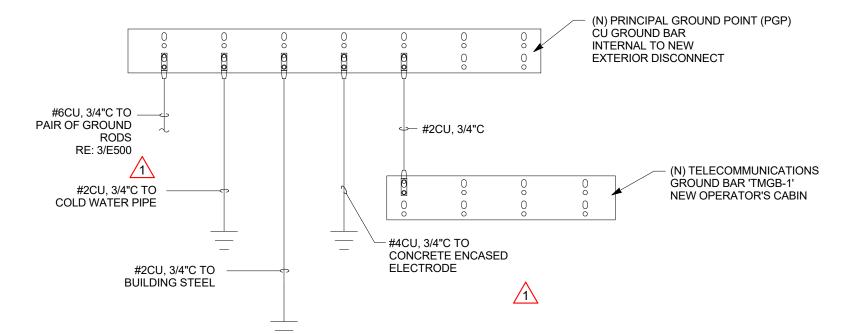

## 2 ELECTRICAL GROUNDING DIAGRAM

E500 SCALE: NTS

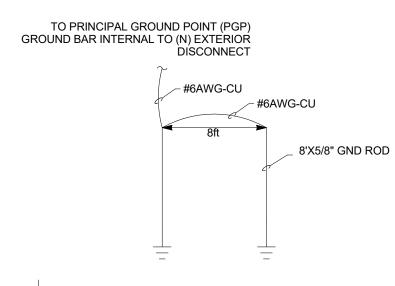

3 GROUND ROD 'PAIR' DIAGRAM E500 | SCALE: NTS

	TRA	NSFOR	MER SO	CHEDULE - C	OPPER	WINDINGS (	2016 DOE EF	FICIENC	XYS	TAN	1DA	RDS)	
KVA	PRIMARY	SECONDARY	PRIMARY	PRIMARY	SECONDARY	SECONDARY	GROUNDING ELECTRODE	TRANSFORMER	APPRO	X. DIMEN	ISIONS	APPROX.	SPECIFIC
RATING	FLA	FLA	PROTECTION	FEEDER	PROTECTION	FEEDER	CONDUCTOR (GEC)	IMPEDANCE	HIGH	WIDE	DEEP	WEIGHT	NOTES
3	3.6	8.3	15A/3P	3#12, 1#12G, 3/4"C	15A/3P	4#12, 1#8G, 3/4"C	1#8, 3/4"C	4.57%	15	15	11	140LBS	1,2
6	7.2	16.7	15A/3P	3#12, 1#12G, 3/4"C	20A/3P	4#12, 1#8G, 3/4"C	1#8, 3/4"C	4.57%	15	15	11	145LBS	1,2
9	10.8	25.0	15A/3P	3#12, 1#12G, 3/4"C	30A/3P	4#10, 1#8G, 3/4"C	1#8, 3/4"C	4.57%	20	20	15	245LBS	1,2
15	18.1	41.7	25A/3P	3#10, 1#10G, 3/4"C	50A/3P	4#6, 1#8G, 1-1/4"C	1#8, 3/4"C	2.88%	26	21.88	17.75	250LBS	
30	36.1	83.3	45A/3P	3#6, 1#10G, 1"C	100A/3P	4#1, 1#6G, 1-1/2"C	1#6, 3/4"C	2.56%	36.88	24.88	21.13	415LBS	
45	54.2	125.0	70A/3P	3#4, 1#8G, 1-1/4"C	150A/3P	4#1/0, 1#6G, 2"C	1#6, 3/4"C	3.44%	36.88	24.88	21.13	478LBS	
75	90.3	208.3	125A/3P	3#1, 1#6G, 1-1/2"C	250A/3P	4#250MCM, 1#2G, 3"C	1#2G, 3/4"C	3.21%	43	30.54	24	676LBS	
112.5	135.4	312.5	175A/3P	3#2/0, 1#6G, 2"C	400A/3P	2[4#3/0, 1#2G, 2-1/2"C]	1#2G, 3/4"C	3.63%	51	34.5	31.5	1263LBS	
150	180.5	416.7	225A/3P	3#4/0, 1#4G, 2"C	500A/3P	2[4#250MCM, 1#1/0G, 3"C]	1#1/0G, 3/4"C	3.39%	51	34.5	31.5	1410LBS	
225	270.8	625.0	350A/3P	3#500MCM, 1#3G, 3"C	800A/3P	2[4#500MCM, 1#2/0G, 3-1/2"C]		4.34%	60	38	33.5	1745LBS	
300	361.0	833.3	450A/3P	2[3#4/0, 1#2G, 2"C]	1000A/3P	3[4#400MCM, 1#3/0G, 3-1/2"C]		3.48%	66.18	42.18	33.5	2354LBS	
500	601.7	1388.9	750A/3P	2[3#500MCM, 1#1/0G, 3"C]	1600A/3P	5[4#400MCM, 1#3/0G, 3-1/2"C]	1#3/0G, 3/4"	4.57%	60	56	36	3450LBS	1,2
750	902.5	2083.3	1200A/3P	3[3#350MCM, 1#3/0G, 3"C]	2500A/3P	7[4#500MCM, 1#3/0G, 3-1/2"C]	1#3/0G, 3/4"	4.57%	74	56	41	3950LBS	1,2
GENERA	L NOTES:	•	•		•					•		•	

30	36.1	83.3	45A/3P	3#6, 1#10G, 1"C	100A/3P	4#1, 1#6G, 1-1/2"C	1#6, 3/4"C	2.56%	30.00	24.88 21.1		
45	54.2	125.0	70A/3P	3#4, 1#8G, 1-1/4"C	150A/3P	4#1/0, 1#6G, 2"C	1#6, 3/4"C	3.44%		24.88 21.1		
75	90.3	208.3	125A/3P	3#1, 1#6G, 1-1/2"C	250A/3P	4#250MCM, 1#2G, 3"C	1#2Ġ, 3/4"C	3.21%		30.54 24		
112.5	135.4	312.5	175A/3P	3#2/0, 1#6G, 2"C	400A/3P	2[4#3/0, 1#2G, 2-1/2"C]	1#2G, 3/4"C	3.63%		34.5 31.		
150	180.5	416.7	225A/3P	3#4/0, 1#4G, 2"C	500A/3P	2[4#250MCM, 1#1/0G, 3"C]	1#1/0G, 3/4"C	3.39%		34.5 31.		
225	270.8	625.0	350A/3P	3#500MĆM, 1#3G, 3"C	800A/3P	2[4#500MCM, 1#2/0G, 3-1/2"C]	1#2/0G, 3/4"C	4.34%	60	38 33.		LBS
300	361.0	833.3	450A/3P	2[3#4/0, 1#2G, 2"C]	1000A/3P	3[4#400MCM, 1#3/0G, 3-1/2"C]	1#3/0G, 3/4"	3.48%	66.18			
500	601.7	1388.9	750A/3P	2[3#500MCM, 1#1/0G, 3"C]	1600A/3P	5[4#400MCM, 1#3/0G, 3-1/2"C]	1#3/0G, 3/4"	4.57%	60	56 36		
750	902.5	2083.3	1200A/3P	3[3#350MCM, 1#3/0G, 3"C]	2500A/3P	7[4#500MCM, 1#3/0G, 3-1/2"C]	1#3/0G, 3/4"	4.57%	74	56 41	3950L	LBS 1,
GENERAL	NOTES:		•			· · · · · · · · · · · · · · · · · · ·			·	·	· ·	·
		MFRS ARF 480V	3PHASE, DELTA	PRIMARY AND 208Y/120V, 3PHA	ASE SECONDARY							
		•	,	INS FOR INCREASED CONDUCTO		OLTAGE DROP						
		,	•				CURRENT CYCTEMS					
					SU - GROUNDING S	SEPERATELY DERIVED ALTERNATING	CUKKENI SYSTEMS.					
). WEI	IGHT SHOWN	n for referenc	E ONLY, AND MA	Y VARY BY MANUFACTURER.								
-, ,,												
	NOTES:											
SPECIFIC I		IMPEDANCE IS T	HE ASSUMED VAL	UE AND IS USED FOR FAULT-CU	IRRENT CALCULA	TIONS. IF SUBMITTED TRANSFORME	R IS OF A DIFFERENT VALUE. F	REVISED CALCULATI	ONS MAY BE			
SPECIFIC I	ANSFORMER	IMPEDANCE IS T	HE ASSUMED VAL	UE AND IS USED FOR FAULT-CU	IRRENT CALCULA ⁻	TIONS. IF SUBMITTED TRANSFORME	R IS OF A DIFFERENT VALUE, F	REVISED CALCULATI	ONS MAY BE			
PECIFIC I A. TRA REQ	ANSFORMER QUIRED.					TIONS. IF SUBMITTED TRANSFORME	R IS OF A DIFFERENT VALUE, F	REVISED CALCULATI	ONS MAY BE			
SPECIFIC I A. TRA REQ	ANSFORMER QUIRED.			UE AND IS USED FOR FAULT-CU		TIONS. IF SUBMITTED TRANSFORME	R IS OF A DIFFERENT VALUE, F	REVISED CALCULATI	ONS MAY BE			
<b>SPECIFIC I</b> A. TRA REQ	ANSFORMER QUIRED.					TIONS. IF SUBMITTED TRANSFORME	R IS OF A DIFFERENT VALUE, F	REVISED CALCULATI	ONS MAY BE			
<b>SPECIFIC I</b> A. TRA REQ	ANSFORMER QUIRED.		OF NON DOE 2016	AS THEY MAY VARY BY MANUF	ACTURER.						0-0	-0-0
SPECIFIC I A. TRA REQ	ANSFORMER QUIRED.		OF NON DOE 2016	AS THEY MAY VARY BY MANUF	ACTURER.	TIONS. IF SUBMITTED TRANSFORME					~~	<b>~~~</b>
SPECIFIC I A. TRA REQ B. EC T	ANSFORMER QUIRED. TO FIELD VE	ERIFY WEIGHTS C	DF NON DOE 2016	AS THEY MAY VARY BY MANUF	ACTURER.	~~~~~~~~~~~~~~~~~~~~~~~~~~~~~~~~~~~~~~	~~~~	~~~	~~	~~		<u> </u>
SPECIFIC I A. TRA REQ B. EC T	ANSFORMER QUIRED. TO FIELD VE	ERIFY WEIGHTS C	DF NON DOE 2016	AS THEY MAY VARY BY MANUF	ACTURER.	~~~~~~~~~~~~~~~~~~~~~~~~~~~~~~~~~~~~~~	~~~~	~~~	~~	~~		<u> </u>
SPECIFIC I  A. TRA  REQ  B. EC 1	ANSFORMER QUIRED. TO FIELD VE	SFORM	VER SCH	AS THEY MAY VARY BY MANUF	ACTURER.  UMINU	M WINDINGS	(2016 DOE E	FFICIEN	1CY S	~~ STAN	DARI	DS)
SPECIFIC I  A. TRA  REQ  B. EC 1	ANSFORMER QUIRED. TO FIELD VE	SFORM SECONDARY	JER SCH	AS THEY MAY VARY BY MANUF  HEDULE - AL  PRIMARY	UMINU SECONDARY	M WINDINGS (	(2016 DOE E	FFICIEN TRANSFORMER	ICY S	STAN DIMENSIONS	DARI	DS)
SPECIFIC I A. TRA REQ B. EC T	ANSFORMER QUIRED. TO FIELD VE RANS PRIMARY FLA	SFORM SECONDARY FLA	JER SCH PRIMARY PROTECTION	AS THEY MAY VARY BY MANUF  HEDULE - AL  PRIMARY FEEDER	UMINU  SECONDARY PROTECTION	M WINDINGS (  SECONDARY FEEDER	(2016 DOE E GROUNDING ELECTRODE CONDUCTOR (GEC)	FFICIEN TRANSFORMER IMPEDANCE	APPROX.	STAN  DIMENSIONS  VIDE   DEEP	DARI APPROX WEIGH	DS)  DX.   SPECIF
SPECIFIC I  A. TRA  REQ  B. EC 1	ANSFORMER QUIRED. TO FIELD VE  RANS PRIMARY FLA 3.6	SFORM SECONDARY FLA 8.3	PRIMARY PROTECTION 15A/3P	PRIMARY FEEDER 3#10, 1#10G, 1-1/4"C	SECONDARY PROTECTION 15A/3P	M WINDINGS  SECONDARY FEEDER 4#10, 1#6G, 1-1/4"C	(2016 DOE E GROUNDING ELECTRODE CONDUCTOR (GEC) 1#6, 3/4"C	TRANSFORMER IMPEDANCE 4.57%	APPROX. HIGH W	STAN  DIMENSIONS  VIDE DEEF  15 11	APPROX WEIGH 140LB	DS)  DX. SPECIF HT NOTE BS 1,2
SPECIFIC I  A. TRA  REQ  B. EC 1	RANSFORMER QUIRED. TO FIELD VE  RANS PRIMARY FLA 3.6 7.2	SFORM SECONDARY FLA 8.3 16.7	PRIMARY PROTECTION 15A/3P 15A/3P	PRIMARY FEEDER 3#10, 1#10G, 1-1/4"C 3#10, 1#10G, 1-1/4"C	SECONDARY PROTECTION 15A/3P 20A/3P	M WINDINGS  SECONDARY FEEDER 4#10, 1#6G, 1-1/4"C 4#10, 1#6G, 1-1/4"C	CONDUCTOR (GEC)  1#6, 3/4"C  1#6, 3/4"C	TRANSFORMER IMPEDANCE 4.57% 4.57%	APPROX. HIGH W 15 15	DIMENSIONS //IDE DEEF 15 11 15 11	APPRO WEIGH 140LB 145LB	DS)  DX. SPECIFIED NOTE  35 1,2 35 1,2
SPECIFIC I  A. TRA  REQ  B. EC T	RANSFORMER QUIRED. TO FIELD VE  RANS  PRIMARY FLA 3.6 7.2 10.8	SFORM SECONDARY FLA 8.3 16.7 25.0	PRIMARY PROTECTION 15A/3P 15A/3P 15A/3P	PRIMARY FEEDER 3#10, 1#10G, 1-1/4"C 3#10, 1#10G, 1-1/4"C 3#10, 1#10G, 1-1/4"C	SECONDARY PROTECTION 15A/3P 20A/3P 30A/3P	SECONDARY FEEDER 4#10, 1#6G, 1-1/4"C 4#10, 1#6G, 1-1/4"C 4#8, 1#6G, 1-1/4"C	(2016 DOE E GROUNDING ELECTRODE CONDUCTOR (GEC) 1#6, 3/4"C 1#6, 3/4"C 1#6, 3/4"C	TRANSFORMER IMPEDANCE 4.57% 4.57% 4.57%	APPROX. HIGH W 15 15 20	DIMENSIONS //IDE DEEF 15 11 15 11 20 15	APPRO WEIGH 140LB 145LB 245LB	DS)  DX. SPECIFIED NOTE  35 1,2  35 1,2  35 1,2  35 1,2
SPECIFIC I A. TRA REQ B. EC T	RANSFORMER QUIRED. TO FIELD VE  RANS  PRIMARY FLA 3.6 7.2 10.8 18.1	SFORM SECONDARY FLA 8.3 16.7 25.0 41.7	PRIMARY PROTECTION 15A/3P 15A/3P 15A/3P 25A/3P	PRIMARY FEEDER 3#10, 1#10G, 1-1/4"C 3#10, 1#10G, 1-1/4"C 3#10, 1#10G, 1-1/4"C 3#10, 1#10G, 1-1/4"C	SECONDARY PROTECTION 15A/3P 20A/3P 30A/3P 50A/3P	SECONDARY FEEDER 4#10, 1#6G, 1-1/4"C 4#10, 1#6G, 1-1/4"C 4#8, 1#6G, 1-1/4"C 4#6, 1#6G, 1-1/4"C	(2016 DOE E  GROUNDING ELECTRODE  CONDUCTOR (GEC)  1#6, 3/4"C  1#6, 3/4"C  1#6, 3/4"C  1#6, 3/4"C	TRANSFORMER IMPEDANCE 4.57% 4.57% 4.57% 3.74%	APPROX. HIGH W 15 15 20 26 26 2	DIMENSIONS //IDE DEEP 15 11 15 11 20 15 1.88 17.75	APPRO: WEIGH 140LB 145LB 245LB 225LB	DS)  DX.   SPECIFIED NOTE  3S   1,2  3S   1,2  3S   1,2  3S   1,2  3S   1,2
SPECIFIC I A. TRA REQ B. EC T	RANSFORMER QUIRED. TO FIELD VE  RANS  PRIMARY FLA 3.6 7.2 10.8	SFORM SECONDARY FLA 8.3 16.7 25.0	PRIMARY PROTECTION 15A/3P 15A/3P 15A/3P	PRIMARY FEEDER 3#10, 1#10G, 1-1/4"C 3#10, 1#10G, 1-1/4"C 3#10, 1#10G, 1-1/4"C	SECONDARY PROTECTION 15A/3P 20A/3P 30A/3P	SECONDARY FEEDER 4#10, 1#6G, 1-1/4"C 4#10, 1#6G, 1-1/4"C 4#8, 1#6G, 1-1/4"C	(2016 DOE E GROUNDING ELECTRODE CONDUCTOR (GEC) 1#6, 3/4"C 1#6, 3/4"C 1#6, 3/4"C	TRANSFORMER IMPEDANCE 4.57% 4.57% 4.57%	APPROX. HIGH W 15 15 20 26 26 36.88 24	DIMENSIONS //IDE DEEF 15 11 15 11 20 15	APPRO: WEIGH 140LB 145LB 245LB 225LB 409LB	DS)  DX.   SPECIFIED SPECI

									<del> </del>			
	$LD V V^{I}$	くたしひょん	FD CCL	HEDULE - AL		WINDINGS	(2016 DOF F	FFICIFN	יועע כ-	LVVIL	NDDC	<i>[ ]</i>
	INAIN			ILDULL - AL		COMIDINA			<b>1C 1 3</b>	HINL	AND.	) <i>j</i>
KVA	PRIMARY	SECONDARY	PRIMARY	PRIMARY	SECONDARY	SECONDARY	GROUNDING ELECTRODE	TRANSFORMER	APPROX. DI	<b>NENSIONS</b>	APPROX.	ŚPECIFIC
RATING	FLA	FLA	PROTECTION	FEEDER	PROTECTION	FEEDER	CONDUCTOR (GEC)	IMPEDANCE	HIGH WID	E DEEP	WEIGHT	NOTES
3	3.6	8.3	15A/3P	3#10, 1#10G, 1-1/4"C	15A/3P	4#10, 1#6G, 1-1/4"C	1#6, 3/4"C	4.57%	15 15	11	140LBS	1,2
6	7.2	16.7	15A/3P	3#10, 1#10G, 1-1/4"C	20A/3P	4#10, 1#6G, 1-1/4"C	1#6, 3/4"C	4.57%	15 15	11	145LBS	1,2
9	10.8	25.0	15A/3P	3#10, 1#10G, 1-1/4"C	30A/3P	4#8, 1#6G, 1-1/4"C	1#6, 3/4"C	4.57%	20 20	15	245LBS	1,2
15	18.1	41.7	25A/3P	3#8, 1#8G, 1-1/4"C	50A/3P	4#6, 1#6G, 1-1/4"C	1#6, 3/4"C	3.74%	26 21.8	8 17.75	225LBS	
30	36.1	83.3	45A/3P	3#6, 1#8G, 1-1/4"C	100A/3P	4#1, 1#4G, 1-1/4"C	1#4, 3/4"C	2.74%	36.88 24.8	8 21.13	409LBS	
45	54.2	125.0	70A/3P	3#3, 1#6G, 1-1/4"C	150A/3P	4#3/0, 1#4, 2"C	1#4, 3/4"C	3.51%	36.88 24.8	8 21.13	416LBS	
75	90.3	208.3	125A/3P	3#3/0, 1#4G, 2"C	250A/3P	4#350, 1#1/0, 3"C	1#1/0G, 3/4"C	3.61%	43 30.5	4 24	570LBS	
112.5	135.4	312.5	175A/3P	3#4/0, 1#4G, 2-1/2"C	400A/3P	2[4#250, 1#2G, 2-1/2"C]	1#1/0G, 3/4"C	4.37%	51 34.	5 31.5	976LBS	
150	180.5	416.7	225A/3P	3#300, 1#2G, 2-1/2"C	500A/3P	2[4#350, 1#1/0G, 3"C]	1#3/0G, 3/4"C	3.46%	51 34.	5 31.5	1239LBS	
225	270.8	625.0	350A/3P	2[3#4/0, 1#1G, 2-1/2"C]	800A/3P	3[4#400, 1#1/0G, 3"C]	1#4/0G, 3/4"C	4.29%	60 38	33.5	1571LBS	
300	361.0	833.3	450A/3P	2[3#300, 1#1/0G, 2-1/2"C]	1000A/3P	4[4#350, 1#1/0G, 3"C]	1#4/0G, 3/4"C	4.45%	66.18 42.1	8 33.5	2157LBS	
500	601.7	1388.9	750A/3P	3[3#400, 1#3/0G, 3"C]	1600A/3P	6[4#400, 1#1/0G, 3"C]	1#250G, 3/4"C	4.57%	60 56	36	3450LBS	1,2
750	902.5	2083.3	1200A/3P	4[3#500, 1#250G, 3-1/2"C]	2500A/3P	9[4#500, 1#1/0G, 3"C]	1#250G, 3/4"C	4.57%	74 56	41	3950LBS	1,2
			1		l l	- · · · · · · · · · · · · · · · · · · ·	,				1	

**GENERAL NOTES:** 

 ALL TRANSFORMERS ARE 480V, 3PHASE, DELTA PRIMARY AND 208Y/120V, 3PHASE SECONDARY. ALL CONDUCTORS ARE THWN, ALUMINUM, SEE PLANS FOR INCREASED CONDUCTOR SIZE DUE TO VOLTAGE DROP.

BONDING AND GROUNDING CONDUCTORS ARE TO BE INSTALLED PER NEC 250.30 - GROUNDING SEPERATELY DERIVED ALTERNATING CURRENT SYSTEMS.

WEIGHT SHOWN FOR REFERENCE ONLY, AND MAY VARY BY MANUFACTURER.

SPECIFIC NOTES:

TRANSFORMER IMPEDANCE IS THE ASSUMED VALUE AND IS USED FOR FAULT-CURRENT CALCULATIONS. IF SUBMITTED TRANSFORMER IS OF A DIFFERENT VALUE, REVISED

CALCULATIONS MAY BE REQUIRED.

EC TO FIELD VERIFY WEIGHTS OF NON DOE 2016 AS THEY MAY VARY BY MANUFACTURER. mmuniment in the second second

POINT	LOCATION	LENGTH (L)	VOLTAGE	VOLTAGE	PHASE	WIRE	CONDUCTOR	CONDUCTOR	CONDUIT	VOLTAGE	С	# OF PARALLEL	Isc AVAILABLE	Isc	POINT
	DESCRIPTION	(ft)	(EL-L)	(EL-N)		SIZE	MATERIAL	TYPE	MATERIAL	CLASS	VALUE	RUNS	UPSTREAM	AT EQUIP	
														(I3ph) OR (IL-L)	
	UTILITY XFMR						5	~~~~~~~~~~~~~~~~~~~~~~~~~~~~~~~~~~~~~~						15,500	F0
F1	400A CT CABINET	12	480	277	3	250	ALUMINUM	THREE SINGLE CONDUCTORS	NONMAGNETIC	600V	12862	2	15,500	15,106	F1
F2	400A DISC. 'MSD'	5	480	277	3	250	ALUMINUM	THREE SINGLE CONDUCTORS	STEEL	600V	12122	2	15,106	14,938	F2
F3	PANEL 'HB1A'	10	480	277	3	250	ALUMINUM	THREE SINGLE CONDUCTORS	STEEL	600V	12122	2	14,938	14,613	F3
F41	NEW EQUIPMENT	<u> </u>	480	277	~\d3 ~	<b>√</b> 3X <b>~</b>	ALUMNUM	THREE SINGLE CONDUCTORS	A ATEELA	<b>1600V</b>	8126	ار المرا المرا الم	14,617	11452	F4 ,
<u> 55</u>	XFMR 'TBTA' PRI	20	480	277	3	4	COPPER	THREE SINGLE CONDUCTORS	STEE	600V	3806		14 613	11,443	F5
F6	XFMR '181A' SEC	0	208	120	3	3X	ALUMINUM	THREE SINGLE CONDUCTORS	SVEEL	600V	8816	Y Y Y	3,192	3,19	<b>F</b> 6
F7_	PANEL 'LB1A'	10	208	120		3X	▲ ALUMINUM	THREE SINGLE CONDUCTORS	STEEL	600V	8826	A . A 1 . A .	3,192	3,090	<b>♣ ₽</b> 7
F8	ELEV-1 DISC.	20	480	217	<b>-</b>		COPPER	THREE SINGLE CONDUCTORS	STEEL	6007	3806		14,013	11,443	<b>~</b>

1. ALL CALCULATIONS WERE DONE USING BUSSMAN "POINT-TO-POINT" METHOD.

2. REFER TO PLANS FOR ASSUMED UTILITY TRANSFORMER SIZE UTILIZED FOR CALCULATIONS. EXACT TRANSFORMER SIZE, IMPEDANCE, AND AVAILABLE SHORT CIRCUIT CURRENT SHALL BE VERIFIED WITH UTILITY PRIOR TO ORDERING ELECTRICAL EQUIPMENT. CONTRACTOR SHALL NOTIFY ENGINEER OF ANY DISCREPANCIES.

3. DISTRIBUTION TRANSFORMER IMPEDANCES USED IN THE CALCULATIONS WERE TAKEN FROM EATON'S PUBLISHED IMPEDANCES FOR DOE 2016 DRY-TYPE TRANSFORMERS.


4. CONDUCTOR LENGTHS INDICATED IN THIS SCHEDULE ARE FOR THE PUROPOSES OF FAULT CURRENT CALCULATIONS ONLY. THESE LENGTHS ASSUME WORST CASE SHORTEST DISTANCE CONDITIONS AND SHOULD NOT BE UTILIZED BY THE ELECTRICAL CONTRACTOR FOR BIDDING PURPOSES. THE ELECTRICAL CONTRACTOR SHALL BE RESPONSIBLE FOR ESTIMATING AND MEASURING ACTUAL FIELD CONDITION LENGTHS AS PART OF THE BID PROCESS.

L	<u>ree</u>	DER SCHEDU	JLL	<u>(ALUMINUM</u>
l	KEY/	FEEDER CONDUIT	KEY/	FEEDER CONDUIT
L	AMPS	AND CONDUCTORS	AMPS	AND CONDUCTORS
L	SERVICE EI	NTRANCE FEEDERS	SDS XFMF	R FEEDERS (NOTE 1)
L	A400N	2[4#250, 3"C]	A150S	4#3/0, 1#1/0G, 2-1/2"C
L	A600N	2[4#500, 3-1/2 ["] C]	A250S	4#350, 1#1/0G, 3"C
Γ	A800N	3[4#400, 3"C]	A400S	2[4#250, 1#3/0G, 3"C]
	A1000N	4[4#350, 3"C]	A500S	2[4#350, 1#3/0G, 3"C]
Ì	A1200N	4[4#500, 3"C]	A800S	3[4#400, 1#250G, 3"C]
İ	A1600N	6[4#400, 3"C]	A1000S	4[4#350, 1#3/0G, 3"C]
ľ	A2000N	8[4#350, 3"C]	A1600S	6[4#400, 1#3/0G, 3"C]
	A2500N	9[4#500, 3-1/2"C]	A2500S	9[4#500, 1#3/0G, 3-1/2"C]
	A3000N	10[4#500, 3-1/2"C]	7.2000	<u> </u>
	A3500N	12[4#350, 3"C]		
	A4000N	13[4#500, 3-1/2"C]		
	EQUIPMEN		-1	
_	A20NG	4#10, 1#10G, 3/4"C	A20G	3#10, 1#10G, 3/4"C
_	A30NG	4#8, 1#8G, 1"C	A30G	3#8, 1#8G, 1"C
	A40NG	4#8, 1#8G, 1"C	A30G A40G	3#8, 1#8G, 1"C
	A50NG	4#6, 1#8G, 1"C		3#6, 1#8G, 1"C
_		4#4, 1#8G, 1-1/4"C	A50G	
_	A60NG		A60G	3#4, 1#8G, 1-1/4"C
-	A70NG	4#3, 1#6G, 1-1/2"C	A70G	3#3, 1#6G, 1-1/2"C
	A100NG	4#1, 1#6G, 1-1/2"C	A100G	3#1, 1#6G, 1-1/2"C
	A150NG	4#3/0, 1#4G, 2"C	A150G	3#3/0, 1#4G, 2"C
	A175NG	4#4/0, 1#4G, 2-1/2"C	A175G	3#4/0, 1#4G, 2-1/2"C
_	A200NG	4#250, 1#1G, 2-1/2"C	A200G	3#250, 1#1G, 2-1/2"C
	A225NG	4#300, 1#2G, 2-1/2"C	A225G	3#300, 1#2G, 2-1/2"C
	A250NG	4#350, 1#2G, 3"C	A250G	3#350, 1#2G, 3"C
	A300NG	4#500, 1#2G, 3-1/2"C	A300G	3#500, 1#2G, 3-1/2"C
	A350NG	2[4#4/0, 1#1G, 2-1/2"C]	A350G	2[3#4/0, 1#1G, 2-1/2"C]
	A400NG	2[4#250, 1#1G, 2-1/2"C]	A400G	2[3#250, 1#1G, 2-1/2"C]
	A450NG	2[4#300, 1#1/0G, 2-1/2"C]	A450G	2[3#300, 1#1/0G, 2-1/2"C]
	A500NG	2[4#350, 1#1/0G, 3"C]	A500G	2[3#350, 1#1/0G, 3"C]
	A600NG	2[4#500, 1#1/0G, 3-1/2"C]	A600G	2[3#500, 1#1/0G, 3-1/2"C]
	A700NG	3[4#350, 1#3/0G, 3"C]	A700G	3[3#350, 1#3/0G, 3"C]
	A800NG	3[4#400, 1#3/0G, 3"C]	A800G	3[3#400, 1#3/0G, 3"C]
1	A1000NG	4[4#350, 1#4/0G, 3"C]	A1000G	4[3#350, 1#4/0G, 3"C]
7	A1200NG	4[4#500, 1#250G, 3-1/2"C]	A1200G	4[3#500, 1#250G, 3-1/2"C]
1	41600NG	6[4#400, 1#350G, 3"C]	A1600G	6[3#400, 1#350G, 3"C]
1	12000NG	7[4#500, 1#400G, 3-1/2"C]	A2000G	7[3#500, 1#400G, 3-1/2"C]
		G CONDUCTORS	ABBREVIA	ATIONS
_	AG8	1#8, 3/4" C	MECH	SEE MECH SCHEDULE
	AG6	1#6, 3/4" C	XFMR	SEE XFMR SCHEDULE
	AG4	1#4, 3/4" C	/ // // //	SEE / WITH SCHILDOLL
	AG2	1#4, 3/4 C		
_	AG2 AG10	1-1/0, 3/4" C		
_	AG10 AG20	1-2/0, 3/4" C		
	AG20 AG30	1-2/0, 3/4 C 1-3/0, 3/4" C		
_	IOTES:	1-3/0, 3/4 C		I
N		FEEDER FOR SECONDARY OF SE	DADATELY	DEDIVED
	1.			
	2	SYSTEM (SDS). GROUND SIZE P		
	۷.	ALL CONDUCTORS ARE SINGLE		
		UNLESS NOTED OTHERWISE. AN	MPACITY BA	ASED ON
	_	NEC TABLE 310.16.	c \	TUEDUUSE EU
	3.	ALL CONDUITS ARE EMT UNLES		THERWISE, FILL RATIOS
		BASED ON NEC ANNEX C TABLE	C1.	

KEY/	FEEDER CONDUIT	KEY/	FEEDER CONDUIT
AMPS	AND CONDUCTORS	AMPS	AND CONDUCTORS
	NTRANCE FEEDERS		R FEEDERS (NOTE 1)
400N	2[4#3/0, 2"C]	30S	4#10, 1#8G, 3/4"C
600N	2[4#350, 3"C]	50\$	4#6, 1#8G, 1-1/4"C
800N	2[4#500, 3-1/2"C]	100S	4#1, 1#6G, 1-1/2"C
1000N	3[4#400, 3-1/2"C]	150S	4#1/0, 1#6G, 2"C
1200N	4[4#350, 3"C]	250S	4#250, 1#2G, 3"C
1600N	5[4#400, 3-1/2"C]	400S	2[4#3/0, 1#2G, 2"C]
2000N	6[4#400, 3-1/2"C]	500S	2[4#250, 1#1/0G, 3"C]
2500N	7[4#500, 3-1/2"C]	8005	2[4#500, 1#2/0G, 3-1/2"C]
3000N	8[4#500, 3-1/2"C]	1000S	3[4#400, 1#4/0G, 3-1/2"C]
3500N	10[4#500, 3-1/2"C]	1600S	5[4#400, 1#350G, 3-1/2"C]
4000N	11[4#500, 3-1/2"C]	2500S	7[4#500, 1#500G, 3-1/2"C]
	T FEEDERS		
20NG	4#12, #12G, 3/4"C	20G	3#12, #12G, 3/4"C
30NG	4#10, 1#10G, 3/4"C	30G	3#10, 1#10G, 3/4"C
40NG	4#8, 1#10G, 1"C	40G	3#8, 1#10G, 1"C
50NG	4#6, 1#10G, 1-1/4"C	50G	3#6, 1#10G, 1"C
60NG	4#4, 1#10G, 1-1/4"C	60G	3#4, 1#10G, 1"C
70NG	4#4, 1#8G, 1-1/4"C	70G	3#4, 1#8G, 1-1/4"C
80NG	4#3, 1#8G, 1-1/4"C	80G	3#3, 1#8G, 1-1/4"C
90NG	4#2, 1#8G, 1-1/2"C	90G	3#2, 1#8G, 1-1/4"C
100NG	4#1, 1#8G, 1-1/2"C	100G	3#1, 1#8G, 1-1/2"C
110NG	4#1, 1#6G, 2"C	110G	3#1, 1#6G, 1-1/2"C
125NG	4#1/0, 1#6G, 2"C	125G	3#1/0, 1#6G, 1-1/2"C
150NG	4#1/0, 1#6G, 2"C	150G	3#1/0, 1#6G, 1-1/2"C
175NG	4#2/0, 1#6G, 2"C 4#3/0, 1#6G, 2-1/2"C	175G 200G	3#2/0, 1#6G, 2"C 3#3/0, 1#6G, 2"C
200NG 225NG	4#4/0, 1#4G, 2-1/2"C	200G 225G	3#4/0, 1#4G, 2"C
250NG	4#470, 1#4G, 2-172 C 4#250, 1#4G, 3"C	250G	3#4/0, 1#4G, 2 C
300NG	4#250, 1#4G, 3°C	300G	3#250, 1#4G, 2-1/2"C 3#350, 1#4G, 2-1/2"C
350NG	4#500, 1#3G, 3-1/2"C	350G	3#500, 1#3G, 3"C
400NG	2[4#3/0, 1#3G, 2-1/2"C]	400G	2[3#3/0, 1#3G, 2"C]
450NG	2[4#3/0, 1#3G, 2-1/2 C] 2[4#4/0, 1#2G, 2-1/2 C]	450G	2[3#4/0, 1#2G, 2"C]
500NG	2[4#250, 1#2G, 3"C]	500G	2[3#470, 1#2G, 2-C] 2[3#250, 1#2G, 2-1/2"C]
600NG	2[4#350, 1#1G, 3"C]	600G	2[3#350, 1#1G, 2-1/2"C]
700NG	2[4#500, 1#1/0G, 3-1/2"C]	700G	2[3#500, 1#1/0G, 3"C]
800NG	2[4#500, 1#1/0G, 3-1/2"C]	800G	2[3#500, 1#1/0G, 3"C]
1000NG	3[4#400, 1#2/0G, 3-1/2"C]	1000G	3[3#400, 1#2/0G, 3"C]
1200NG	4[4#350, 1#3/0G, 3"C]	1200G	4[3#350, 1#3/0G, 3"C]
1600NG	5[4#400, 1#4/0G, 3-1/2"C]	1600G	5[3#400, 1#4/0G, 3"C]
2000NG	6[4#400, 1#250G, 3-1/2"C]	2000G	6[3#400, 1#250G, 3"C]
	IG CONDUCTORS	ABBREVIA	
G8	1#8, 3/4" C	MECH	SEE MECH SCHEDULE
G6	1#6, 3/4" C	XFMR	SEE XFMR SCHEDULE
G4	1#4, 3/4" C		
G2	1#2, 3/4" C		
G10	1-1/0, 3/4" C		
G20	1-2/0, 3/4" C		
G30	1-3/0, 3/4" C		
NOTES:	,	•	

ALL CONDUCTORS ARE SINGLE CONDUCTOR COPPER THWN UNLESS NOTED OTHERWISE. AMPACITY BASED ON NEC TABLE

ALL CONDUITS ARE EMT UNLESS NOTED OTHERWISE, FILL RATIOS BASED ON NEC ANNEX C TABLE C1.

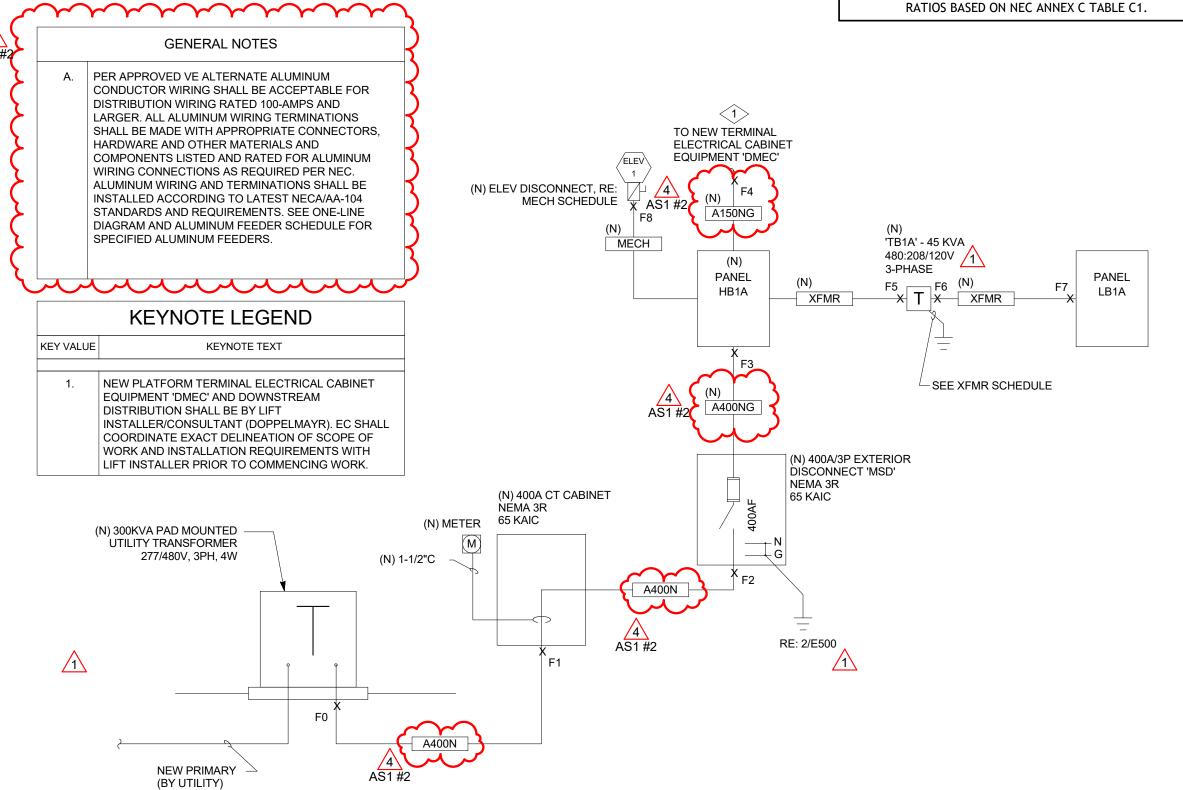

4 | ELECTRICAL ONE-LINE DIAGRAM

E500 NO SCALE

DIAGRAM

06/11/2021

NOTICE: DUTY OF COOPERATION Release of these plans contemplates further cooperation among the owner, his contractor and the architect. Design and construction are complex. Although the architect and his consultants have performed their services with due care and diligence they cannot guarantee perfection. Communication is imperfect and every contingency cannot be anticipated.
Any ambiguity or discrepancy discovered by the use of these plans shall be reported immediately to the architect. Failure to notify the architect compounds misunderstanding and increases construction costs. A failure to cooperate by a simple notice to the architect shall relieve the architect from responsibility for the consequences. Changes made from the plans without consent of the architect are unauthorized and shall relieve the architect of responsibility for all consequences arriving out of such changes.

All design, documents and data prepared by Eric Smith Associates, P.C. as instruments of service shall remain property of Eric Smith Associates, P.C. and shall not be copied, changed or disclosed in any form whatsoever without first obtaining the express written consent of Eric Smith Associates, P.C. Eric Smith Associates, P.C.

REVISIONS Description ADDENDUM #1 3/12/2021 ASI #2 6/7/2021

**Job Number:** | 20034 03/29/2 Date: Drawn By: BDJ, MAE Checked By: 1PK

Project Phase CONSTRUCTION DOCUMENTS

**Sheet Title** ELECTRICAL ONE LINE

**Sheet Number** 

# **KEYNOTE LEGEND**

### KEY | KEYNOTE TEXT NEW (3) 3" PVC CONDUIT ROUTED 30" BELOW GRADE FOR CONNECTION TO SITE FIBER/TELEPHONE SERVICE INTERCONNECTION POINT (ROUTED THROUGH ELECTRICAL VAULT). ELECTRICAL CONTRACTOR SHALL VERIFY CONDUIT SIZING AND QUANTITY WITH SERVICE PROVIDER AND/OR OWNER (SSRC) PRIOR TO INSTALLATION. REFER TO ELECTRICAL PLANS FOR MORE INFORMATION.

NEW (1)2" AND (1) 3" PVC CONDUIT ROUTED 30" BELOW GRADE FOR CONNECTION TO FIBER OPTIC SERVICE INTERCONNECTION POINT (ROUTED THROUGH ELECTRICAL VAULT) AND TO EXISTING CHRISTIE PEAK CHAIR LIFT. ELECTRICAL CONTRACTOR SHALL VERIFY CONDUIT SIZING AND QUANTITY WITH SERVICE PROVIDER AND/OR OWNER (SSRC) PRIOR TO INSTALLATION. REFER TO ELECTRICAL PLANS FOR

MAIN TELECOMMUNICATIONS DEMARC POINT AND OWNER (SSRC) IT/MDF EQUIPMENT CABINET. EC SHALL PROVIDE MAIN TELEPHONE TERMINAL BOARD 'MTTB' AS NECESSARY AND REQUIRED BY OWNER

(SSRC). IF REQUIRED, TELEPHONE BOARD SHALL CONSIST OF 3/4", FIRE-RETARDANT PAINTED AND TREATED PLYWOOD INSTALLED IN ROOM. EC SHALL COORDINATE EXACT LOCATION AND INSTALLATION REQUIREMENTS WITH OWNER (SSRC) AND IT INSTALLER PRIOR TO COMMENCING WORK. ALL RECEPTACLE DEVICES SHOWN IN BACKBOARD ON PLANS SHALL BE FLUSH MOUNT, UON.  $\lambda$ PROVIDE GREEN COPPER GROUNDING CONDUCTOR (TYPICAL) BETWEEN GROUNDING BUSSES AS

INDICATED. REFER TO #2/E500 FOR SIZING OF GROUNDING CONDUCTOR/CONDUIT. ROUTE (1) 1/2" CONDUIT FOR FIRE ALARM CONTROL PANEL COMMUNICATIONS CABLING RACEWAY. ROUTE (1) 1/2" CONDUIT FOR SECURITY ALARM CONTROL PANEL COMMUNICATIONS CABLING RACEWAY (AS REQUIRED/APPLICABLE TO PROJECT). COORDINATE REQUIREMENTS WITH SECURITY INSTALLER AND/OR OWNER (SSRC) AS NECESSARY.

PROVIDE (3) 2" CONDUIT FROM OPERATOR CABIN TO BOILER ROOM FOR OPTICAL FIBER AND COPPER CABLING RACEWAY. REFER TO SHEET E111 FOR ADDITIONAL INFORMATION. PROVIDE (1) 3/4"C WITH PULL WIRE TO ELEVATOR CONTROL PANEL FOR ELEVATOR COMMUNICATIONS

PRINCIPAL GROUND POINT NEAR ELECTRICAL SERVICE EQUIPMENT.

CABLING RACEWAY. CABLING SHALL BE FURNISHED BY OTHERS.

ASI#2


10. | TELECOMMUNICATIONS MAIN GROUNDING BAR 'TCMGB' FUNCTIONING AS INTERSYSTEM BONDING TERMINATION DEVICE, COMPLYING WITH NEC 250.94.

NEW TYPICAL WORK AREA COMMUNICATIONS OUTLET FOR STRUCTURED CABLE TERMINATIONS. PROVIDE 2" DEEP, 2-GANG BOX WITH 1-GANG PLASTER RING. PROVIDE 1" CONDUIT BACK TO 'MTTB'. RECEPTACLE FACEPLATE, JACK, CABLING, AND TERMINATIONS BY OTHERS.

EXISTING UNDERGROUND CONDUIT TO BUCKAROO CARPET LIFT. EC SHALL RE-ROUTE AND EXTEND CONDUIT TO NEW ELECTRICAL VAULT FOR COMMUNICATIONS CABLING PATHWAY. ELECTRICAL CONTRACTOR SHALL VERIFY EXISTING CONDUIT SIZING AND QUANTITY IN FIELD WITH OWNER (SSRC) PRIOR TO INSTALLATION. REFER TO ELECTRICAL PLANS FOR MORE INFORMATION.

## **GENERAL NOTES**

- PROVIDE EMT FOR ALL CABLING ROUTED THROUGH AREAS WITH EXPOSED STRUCTURAL CEILINGS AND THROUGH INACCESSIBLE CEILINGS, COORDINATE CONDUIT SIZE REQUIREMENTS WITH CABLE INSTALLER.
- ALL EXPOSED CONDUIT SHALL BE CONCEALED TO THE GREATEST EXTENT POSSIBLE, AND SHALL BE INSTALLED PARALLEL AND CLOSE TO STRUCTURAL MEMBERS, PAINT CONDUIT TO MATCH ADJACENT
- PROVIDE PULLCORD FOR ALL CONDUIT INSTALLED FOR CABLE.
- PROVIDE PULLBOXES AS REQUIRED BY ABLE INSTALLER FOR RUNS EXCEEDING MAXIMUM PULL DISTANCE, AS IDENTIFIED BY CABLE INSTALLER.
- FOR ALL FREELY RUN ARMORED METALLIC FIBER OPTIC CABLING, CONTRACTOR SHALL GROUND CABLING ARMOR TO THE NEAREST PBB OR SBB.
- PROVIDE SLEEVES AND CONDUIT BETWEEN FLOORS FOR ROUTING OF CABLE. COORDINATE CONDUIT SIZE WITH CABLE INSTALLER. COORDINATE LOCATION OF RACEWAY WITH ARCHITECT AND CABLE INSTALLER.
- ALL CONDUIT AND CABLING IN CRAWL SPACE IS TO BE SUPPORTED BY AND TIGHT TO STRUCTURE ABOVE WHERE CONDUIT TRANSITIONS FROM BEING SUPPORTED BY STRUCTURE INTO SOIL. ADD LOOP AND/OR FLEXIBLE CONDUIT FOR ANTICIPATED SOIL MOVEMENT.
- NOTE THAT ALL UNDERGROUND CONDUIT BENDS ARE TO BE GALVANIZED RIGID CONDUIT. UNDERGROUND CONDUIT EXTENDING ABOVE SLAB IS ALSO TO BE GALVANIZED RIGID CONDUIT. REFER TO SPECIFICATIONS FOR FULL CONDUIT REQUIREMENTS.
- EC SHALL COORDINATED UNDERGROUND CONDUIT ROUTING TO OPERATOR CABIN WITH NEW STRUCTURAL BLOCK-OUTS IN FOUDNATION PRIOR TO COMMENCING WORK, REFER TO ELECTRICAL PLANS FOR ADDITIONAL INFORMATION.

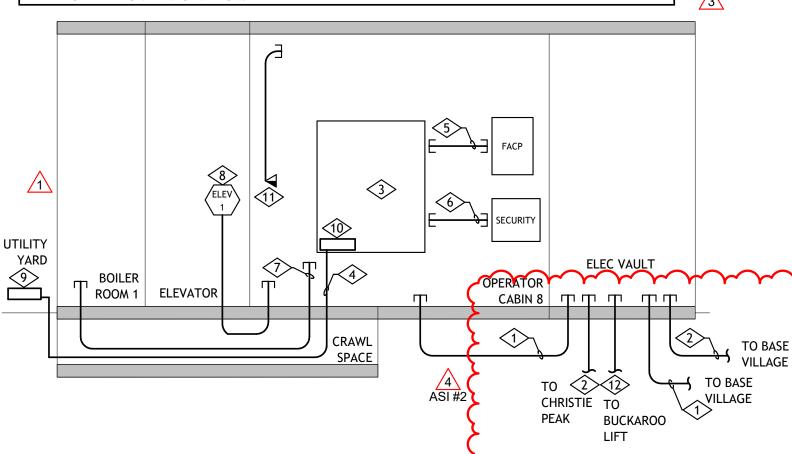

2 LOW VOLTAGE RISER DIAGRAM

# E600 NTS VIBRATION HANGER MASON INDUSTRIES HD SERIES -DRY TYPE TRANSFORMER -1/2" DIAMETER HANGER SUPER STRUT

1. FASTEN VIBRATION HANGER RIGIDLY TO STRUCTURE ABOVE. SIZE TO ACCOMMODATE TRANSFORMER WEIGHT. BOT TRANSFORMER

2. INSTALL FLEXIBLE CONDUIT BETWEEN PRIMARY AND SECONDARY CONDUIT AND TRANSFORMER HOUSING.


1 | SUSPENDED TRANSFORMER DETAIL

TO STRUT.

A-1200 SERIES FRAMING

ASSEMBLY -

CHANNEL WITH HANGER ROD

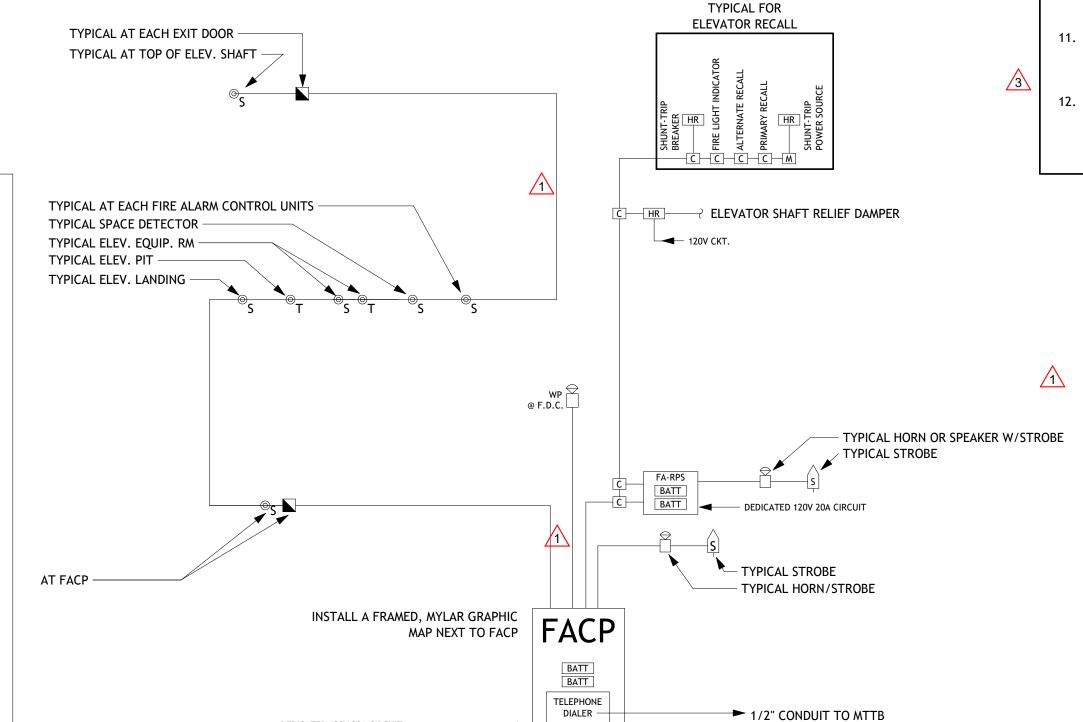

### FIRE ALARM GENERAL NOTES:

THIS IS A FULLY ADDRESSABLE SYSTEM WITH EACH DEVICE HAVING A DISTINCT 'ADDRESS'.

DEDICATED 120V 20A CIRCUIT -

- PROVIDE NON-POWER LIMITING, PLENUM RATED WIRING. INSTALL IN EMT WHERE WIRING IS ROUTED THROUGH HAZARDOUS LOCATIONS, EXPOSED STRUCTURAL CEILINGS, INACCESSIBLE CEILINGS, AND BETWEEN AREAS SEPARATED BY MULTI-STORY ATRIUMS. ALL RACEWAY COMPONENTS SHALL BE PAINTED RED.
- NOT USED.
- SPRINKLER SYSTEM IS A DESIGN-BUILD CONTRACT. COORDINATE WITH SPRINKLER CONTRACTOR FOR QUANTITIES AND LOCATIONS OF ALL FLOW AND TAMPER SWITCHES, AND FOR LOCATION OF FIRE HORN/LIGHT AT EXTERIOR OF BUILDINGS. INSTALL WITH A MINIMUM OF 20% SPARE CAPACITY ON ALL INITIATING AND INDICATING APPLIANCE CIRCUITS.
- PROVIDE 120V CIRCUIT AND LOW-VOLTAGE FIRE ALARM CONTROL CIRCUIT TO ALL SMOKE DAMPERS. COORDINATE LOCATIONS WITH MECHANICAL CONTRACTOR PRIOR TO BID.
- COORDINATE ALL SEQUENCING OF OPERATIONS WITH LOCAL FIRE
- ALL DEVICES INSTALLED IN DAMP, WET OR EXTERIOR LOCATIONS SHALL BE FURNISHED WITH WP HOUSINGS. ALL DEVICES INSTALLED IN GYMNASIUMS SHALL BE FURNISHED WITH WIRE GUARD.

- 8. SYSTEM SHALL TRANSMIT REQUIRED FIRE ALARM SIGNALS TO CENTRAL MONITORING AGENCY (SELECTED BY OWNER) VIA DIALER PROVIDED IN FIRE ALARM CONTROL PANEL.
- 10. THE ELECTRICAL CONTRACTOR SHALL INCLUDE IN HIS BID AN ADDITIONAL 10% SPARE STROBES AND HORN/STROBES, INCLUDING INSTALLATION, AS MAY BE REQUIRED BY AHJ.
- 11. NOT USED.

SEQUENCE OF OPERATION FOR ELEVATOR RECALL: WHEN THE SMOKE DETECTORS IN THE LOBBIES, ELEVATOR SHAFT OR EQUIPMENT ROOM GO INTO ALARM, THE RESPECTIVE ELEVATOR WILL RETURN TO THEIR PRIMARY LEVEL OR SECONDARY LEVEL AND LOCK-OUT; THE LEVEL WILL DEPEND UPON IF THE ELEVATOR LOBBY

DETECTOR SENSES ANY SMOKE AT THE RESPECTIVE LOBBY. SUBSEQUENTLY, IF THE THERMAL DETECTOR IN THE ELEVATOR ROOM GOES INTO ALARM, THE POWER TO THE ELEVATOR CONTROLLER WILL BE DISCONNECTED VIA A SHUNT TRIP CIRCUIT BREAKER.

## 3 | FIRE ALARM RISER DIAGRAM

CANDELA RATINGS, WHEN APPLICABLE.

FIRE ALARM SHOP DRAWING REQUIREMENTS

WITH CALCULATIONS SHOWN.

WILL NOT BE ACCEPTED.

PROPRIETARY, ETC.

CODED, VOICE, ETC.

ADDITIONAL SHEET.

WITH CALCULATIONS SHOWN.

FIRE SAFETY CONTROL FUNCTIONS.

2002 ED., SECTION 4.4.4.1(1))

PROVIDE NEC VALUES AND REFERENCE.

FOLLOWING INFORMATION:

THE FIRE ALARM DEVICES SHOWN ARE FOR GENERAL LAYOUT AND

GUIDELINES ONLY. THE AWARDED FIRE ALARM CONTRACTOR IS TO PROVIDE A

COMPLETE SET OF SHOP DRAWINGS FOR SUBMITTAL AND APPROVAL BY THE

AUTHORITY HAVING JURISDICTION. THESE DOCUMENTS ARE TO INCLUDE THE

A NICET FIRE ALARM LEVEL III CERTIFIED INDIVIDUAL.

1. SHOP DRAWINGS MUST BE PREPARED AND SIGNED BY A MINIMUM OF

2. COMPLETE RISER DIAGRAM SHOWING ALL DEVICES BY FLOOR/AREA AS CONNECTED TO THE CIRCUIT, DEVICE ADDRESSES, WIRE COLOR CODING SCHEDULE, WIRE COUNT, WIRE TYPE AND CONDUIT FILL

PROVIDE A SEQUENCE OF OPERATION (INPUT/OUTPUT MATRIX) IN

INFORMATION PROVIDED IN THE SEQUENCE OF OPERATION MUST BE SPECIFIC TO THE PROJECT. GENERIC SEQUENCE OF OPERATIONS

IDENTIFY THE TYPE OF AUDIBLE NOTIFICATION: TEMPORAL, STEADY,

6. IDENTIFY THE TYPE OF VISUAL NOTIFICATION: PUBLIC OR PRIVATE

PROJECT. IDENTIFY IF WIRING IS ENCLOSED IN CONDUIT, OPEN WIRING, PLENUM WIRING, POWER LIMITED OR NON-POWER LIMITED

PROVIDE AN EQUIPMENT LIST WITH MANUFACTURER, PART NUMBER,

BACK BOX AND SYMBOL USED TO IDENTIFY THE COMPONENT. IF THERE IS INSUFFICIENT SPACE FOR WIRING LEGEND, EQUIPMENT LIST AND SYMBOL LEGEND ON THE TITLE SHEET, THAN INSERT AN

COMPLETE RISER DIAGRAM SHOWING ALL DEVICES BY FLOOR/AREA

CODING SCHEDULE, WIRE COUNT, WIRE TYPE AND CONDUIT FILL

10. DETAIL SHEET INCLUDING THE FOLLOWING; CIRCUIT WIRING

11. PROVIDE VOLTAGE DROP CALCULATIONS FOR EACH CIRCUIT

12. PROVIDE AUDIO CIRCUIT POWER LOSS CALCULATIONS

SHOWING WIRE SIZE, CIRCUIT LOAD AND VOLTAGE DROP.

13. VOLTAGE DROP CALCULATIONS MUST BE PERFORMED USING THE

OUTPUT CIRCUIT VOLTAGE WHEN THE INPUT VOLTAGE TO THE

14. PROVIDE RESISTANCE VALUES WITH SUPPORTING DATA SHEETS OR

15. INDICATE METHOD USED AND SHOW ALL FORMULAS/EQUATIONS.

16. PROVIDE STAND-BY BATTERY CALCULATIONS FOR EACH CONTROL

SUPPLY OR ANY COMPONENT REQUIRING SECONDARY POWER.

NOTIFICATION APPLIANCES WITH TEMPERATURE, DECIBLE AND

17. SHOW LOCATION OF ALL FIRE ALARM INITIATING DEVICES AND

PANEL, SUB PANEL, MONITORING STATION TRANSMITTER, POWER

CONTROL PANEL IS 85% OF ITS NAME PLATE VOLTAGE. (NFPA 72,

AS CONNECTED TO THE CIRCUIT, DEVICE ADDRESSES, WIRE COLOR

DIAGRAM, DEVICE/APPLIANCE MOUNTING HEIGHT PROFILE, TYPICAL

DEVICE AND ANCILLARY DEVICE WIRING, AND THE INTERFACE OF

7. PROVIDE A WIRING LEGEND SPECIFIC TO TYPES USED FOR THE

COMPLIANCE WITH THE NFPA 72 ANNEX MATERIAL. THE

IDENTIFY THE TYPE OF SYSTEM, I.E. CENTRAL, REMOTE,

E600 1/8" = 1'-0"

06/11/2021 NOTICE: DUTY OF COOPERATION

Release of these plans contemplates further cooperation among the owner, his contractor and the architect. Design and construction are complex. Although the architect and his consultants have performed their services with due care and diligence they cannot guarantee perfection. Communication is imperfect and every contingency cannot be anticipated. Any ambiguity or discrepancy discovered by the use of these plans shall be reported immediately to the architect. Failure to notify the architect compounds misunderstanding and increases construction costs. A failure to cooperate by a simple notice to the architect shall relieve the architect from responsibility for the consent of the architect are unauthorized and shall relieve the architect of responsibility for all consequences arriving out of such changes.

All design, documents and data prepared by Eric Smith Associates, P.C. as instruments of service shall remain property of Eric Smith Associates, P.C. and shall not be copied, changed or disclosed in any form whatsoever without first obtaining the express written consent of Eric Smith Associates, P.C. Eric Smith Associates, P.C.

No.	Description	Date
1	ADDENDUM #1	3/12/2021
3	ASI#1	4/19/2021
4	ASI #2	6/7/2021

**Job Number:** | 20034 03/29/2 Drawn By: BDJ, MAE Checked By: 1PK

Project Phase CONSTRUCTION DOCUMENTS

**Sheet Title** ELECTRICAL DIAGRAMS

**AE DESIGN** 

Integrated Lighting and Electrical Solutions 1900 Wazee Street #205 | Denver, CO 80202 | 303.296.3034 **Sheet Number** 

LOCATION: SUPPLY FROM: **MOUNTING:** Surface **ENCLOSURE:** Type 3R

**VOLTS:** 120/208 Wye **A.I.C. RATING:** 10,000 AIC PHASES: 3 WIRES: 4 MAINS RATING: 150 A

MAINS TYPE: MCB

MCB RATING: 100 A

A.I.C. RATING: 65K AIC FULLY RATED

MAINS TYPE: MLO

MAINS RATING: 400 A

MCB RATING: N/A

															l
CVT	CCT TYPE	LOAD DESCRIPTION	TRIP	POLES		A	l	В	(	C	POLES	TRIP	LOAD DESCRIPTION	CCT TYPE	CVT
1					2500	1000					PULES				
'		(E) BUCKAROO CARPET	40	2	2500	1000					1	20	'(E) IRRIGATION HEAT TAPE (*)		2
3							2500	200			1	20	(RL) IRRIGATION CLOCK (*)	E	4
5	R	DED GFCI QUAD RECEPT	20	1					360	360	1	20	GFCI CONV. RECEPTS	R	6
7	E	SNOWMAKING VALVE CONTROL PANEL	20	1	500	400					1	20	QTY (4) NORTH VALVE ACTUATORS	E	8
9	Е	QTY (2) EAST VALVE ACTUATORS	20	1			200	200			1	20	MAIN VALVE ACTUATOR	E	10
11	Е	RADIANT PANEL RP-7,8	20	1					1512	1512	1	20	RADIANT PANEL RP-9,10	E	12
13		SPARE	20	1	0	0					1	20	SPARE		14
15	Е	RADIANT PANEL RP-11,12	20	1			1512	114			1	20	VAULT LIGHTING (**)	L	16
17		SPARE	20	1					0	756	1	20	RADIANT PANEL RP-13,14	E	18
19		SPARE	20	1	0	0					1	20	SPARE		20
21		SPARE	20	1			0	0			1	20	SPARE		22
23		SPARE	20	1					0	0	1	20	SPARE		24
25		SPARE	20	1	0	0					1	20	SPARE		26
27		SPARE	20	1			0	0			1	20	SPARE		28
29		SPARE	20	1					0	0	1	20	SPARE		30
31		SPARE	20	1	0	0					1	20	SPARE		32
33		SPARE	20	1			0	0			1	20	SPARE		34
35		SPARE	20	1					0	0	1	20	SPARE		36
37		BUSSED SPACE			0	0							BUSSED SPACE		38
39		BUSSED SPACE					0	0					BUSSED SPACE		40
41		BUSSED SPACE							0	0			BUSSED SPACE		42
	1			Total Load:	440	0 VA	472	6 VA	450	Ò VA					

LECENID	
I F(¬FNI)	

CCT TYPE:	LOAD	DEMAND LOAD	PANEL TOTALS	
LIGHTING:	114 VA	143 VA		
RECEPTACLE:	720 VA	720 VA	TOTAL CONN. LOAD: 13626 VA	
MOTOR:			TOTAL EST. LOAD: 13655 VA	
EQUIPMENT:	6792 VA	6792 VA	TOTAL CONN.: 38 A	
KITCH EQUIP:			TOTAL EST. DEMAND: 38 A	

**VOLTS:** 480/277 Wye

PHASES: 3

WIRES: 4

9422 0

3048 0

3048 0

4157 0

500 0

0 32333

0 7154

59662 VA

3048 0

0 32333

0 5998

58780 VA

(*) PROVIDE GFEP CIRCUIT BREAKER WITH 30mA GROUND FAULT PROTECTION FOR EQUIPMENT

(**) PROVIDE GFCI CIRCUIT BREAKER WITH 5ma GROUND FAULT CIRCUIT INTERRUPTER PROTECTION FOR PERSONNEL

PANEL: HB1A

MOUNTING: SURFACE

**ENCLOSURE:** NEMA 1

SUPPLY FROM:

CKT CCT LOAD DESCRIPTION

1 M ELEVATOR 'ELEV-1'

7 M PUMP (P-1)

13 M PUMP (P-2)

19 E UNIT HEATERS (UH-1, UH-2)

25 L PLATFORM AND BOH LTG

27 E LTG CONTROL RELAY PANEL 'RP1'

BUSSED SPACE

BUSSED SPACE

9 | -- |--

11 -- --

17 -- --

29 -- SPARE

33 -- BUSSED SPACE

37 -- BUSSED SPACE

41 -- BUSSED SPACE

**LOCATION: BOILER ROOM 100** 

Total Amps:

TRIP POLES CB TYPE

20 3

20 3

-- --

20 3

20 1

20 1

20 1

-- --

Total Load:

PLATFORM MECHANICAL EQUIPMENT SCHEDULE LOAD ELECTRICAL MOCP/MFS FEEDER | DISCONNECT | PANEL | CIRCUIT | NOTES DESCRIPTION B 1 HEATING WATER BOILER 15.0A 208 V/2 3120 VA 25A 2#10, 1#10G, 1"C 30A/2P LB1A 1,3

EF 1 EXHAUST FAN 818 W 120 V/1-818 VA 20A 2#12, 1#12G, 3/4 C 30A/1P LB1A 7 ELEV 1 ELEVATOR 480 V/3-28266 VA 3#4, 1#8G, 1-1/4"C 70A HB1A 1,3,5 34 FLA GF 1 GLYCOL FEEDER 50 W 120 V/1-50 VA 20A 2#12, 1#12G, 3/4"C NEMA 5-20R LB1A 11 P 1 PUMP 7.5 HP 3#12, 1#12G, 3/4"C HB1A 7,9,11 480 V/3-9144 VA 11 FLA P 2 PUMP 7.5 HP 480 V/3-9144 VA 20A 3#12, 1#12G, 3/4"C HB1A 13,15,17 RP 1 RADIANT CEILING PANEL 750 W 2#12, 1#12G, 3/4"C LB1A 17 RP 2 RADIANT CEILING PANEL 750 W 2#12, 1#12G, 3/4"C LB1A 17 RP 3 RADIANT CEILING PANEL 750 W 2#12, 1#12G, 3/4"C LB1A 19 RP 4 RADIANT CEILING PANEL 750 W LB1A 19 120 V/1-750 VA 2#12, 1#12G, 3/4"C RP 5 RADIANT CEILING PANEL 750 W 120 V/1-750 VA 20A 2#12, 1#12G, 3/4"C 20A/1P LB1A 21 RP 6 RADIANT CEILING PANEL 750 W 120 V/1-750 VA 2#12, 1#12G, 3/4"C LB1A 21 LB1A 9 SP 1 PLUMBING PUMP 4/10 HP | 120 V/1-1176 VA 20A 2#12, 1#12G, 3/4"C SUMP PUMP CONTROL 3 FLA 2#12, 1#12G, 3/4"C LB1A 11 20A STCP 1 STORAGE TANK CONTROL 3 FLA LB1A 11 120 V/1-360 VA

		VAUL	Γ ME	CHANIC	AL EQ	UIPMEN	T SCHE	DUL	Ε	
KEY	′	EQUIPMENT DESCRIPTION	LOAD	ELECTRICAL	MOCP/MFS	FEEDER	DISCONNECT	PANEL	CIRCUIT	NOTES
RP	7	RADIANT PANEL	6.3 FLA	120 V/1-756 VA	20A	2#12, 1#12G, 3/4"C	20A/1P \$TO	LV1	11	
RP	8	RADIANT PANEL	6.3 FLA	120 V/1-756 VA	20A	2#12, 1#12G, 3/4"C	20A/1P \$TO	LV1	11	
RP	9	RADIANT PANEL	6.3 FLA	120 V/1-756 VA	20A	2#12, 1#12G, 3/4"C	20A/1P \$TO	LV1	12	

20A

20A

3#12, 1#12G, 3/4"C

3#12, 1#12G, 3/4"C

2#12, 1#12G, 3/4"C 20A/1P \$TO

2#12, 1#12G, 3/4"C 20A/1P \$TO

2#12, 1#12G, 3/4"C 20A/1P \$TO

20A 2#12, 1#12G, 3/4"C 20A/1P \$TO

## MECHANICAL GENERAL NOTES

- A. REFER TO MECHANICAL PLANS FOR SPECIFIC EQUIPMENT LOCATIONS AND REQUIREMENTS.
- PRIOR TO ROUGH-IN, COORDINATE ALL MECHANICAL EQUIPMENT POWER AND CONNECTION REQUIREMENTS WITH MECHANICAL CONTRACTOR'S FINAL SHOP DRAWINGS.
- PROVIDE ALL 120V CONTROL WIRING, REFER TO SPECIFICATIONS FOR FURTHER CONTROL

WIRING CLARIFICATION.

- FOR ANY VAV SYSTEM COORDINATE POWER REQUIREMENTS WITH MECHANICAL CONTRACTOR AND PROVIDE 120V CONNECTIONS AT EACH VAV BOX, OR AT CENTRAL CONTROL PANEL LOCATION(S) AS REQUIRED. IF EXACT QUANTITIES AND LOCATIONS FOR CONTROL PANELS ARE NOT KNOWN AT BID TIME, E.C. IS TO INCLUDE ONE 120V CONNECTION AT EACH VAV DEVICE IN THE BASE BID PRICE AND PROVIDE A CREDIT DURING CONSTRUCTION IF LESS CONNECTIONS ARE
- EXTERIOR DISCONNECT SWITCHES ARE TO BE PROVIDED AS NEMA 3R EQUIPMENT UNLESS OTHERWISE NOTED.
- PROVIDE WEATHERPROOF 120 VOLT GFCI RECEPTACLES WITHIN 25' OF ALL ROOFTOP HEATING VENTILATING, AND AIR CONDITIONING EQUIPMENT. CIRCUIT TO SPARE CIRCUIT ON NEAREST 120V PANELBOARD OR AS INDICATED ON PLANS.
- PROVIDE DUCT DETECTION ON ALL RETURN AIR SYSTEMS OF 2,000 CFM OR GREATER, AND FOR ALL SUPPLY AIR SYSTEMS 15,000 CFM OR GREATER, INCLUDING THOSE SYSTEMS SERVING MULTIPLE FLOORS. PROVIDE ADDITIONAL DUCT DETECTORS AND INSTALL REMOTE INDICATOR LIGHTS AS REQUIRED BY LOCAL AUTHORITY HAVING JURISDICTION.
- FOR ANY BOILER MECHANICAL SYSTEM, E.C. IS TO PROVIDE AN EMERGENCY PUSHBUTTON OFF AND ANY CONTROL WIRING REQUIRED. COORDINATE EXACT REQUIREMENTS WITH MECHANICAL CONTRACTOR AND EQUIPMENT PRIOR TO INSTALLATION.
- EC TO PROVIDE HAND/OFF/AUTO STARTERS FOR ALL MOTORS WHEN NOT INDICATED AS TO BE PROVIDED BY THE MECHANICAL CONTRACTOR ON THE MECHANICAL PLANS. SIZE OF STARTER TO BE BASED UPON SIZE OF MOTOR HORSEPOWER INDICATED.

## MECHANICAL SPECIFIC NOTES

- VERIFY THAT ELECTRICAL DISCONNECT IS PROVIDED BY MANUFACTURER AND INSTALL IN ACCESSIBLE LOCATION.
- 2. EC SHALL PROVIDE DEDICATED 120V DUPLEX GFCI RECEPTACLE WITHIN 3 FEET OF AND BEHIND UNIT. RECEPTACLE TO BE CIRCUITED PER MECHANICAL EQUIPMENT SCHEDULE.
- MOUNT RADIANT PANEL IN ELEVATOR SHAFT WITH BOTTOM OF PANEL AT 18" ABOVE BOTTOM OF PIT. CONFIRM ALL MOUNTING LOCATIONS WITH ELEVATOR INSTALLER.

CCT

TYPE CKT

R 2

E 4

-- 6

-- 12

-- 42

R 8 -/

PANEL: LB1A LOCATION:

**SUPPLY FROM:** TB1A **MOUNTING: SURFACE ENCLOSURE: NEMA 1** 

480 V/3-7482 VA

480 V/3-4989 VA

6.3 FLA | 120 V/1-756 VA

6.3 FLA | 120 V/1-756 VA

9.0 FLA

5.0 KW

6.0 FLA

RP 12 RADIANT PANEL 6.3 FLA 120 V/1-756 VA

RP 13 RADIANT PANEL 6.3 FLA 120 V/1-756 VA

**VOLTS:** 120/208 Wye PHASES: 3 WIRES: 4

HB1A 19,21,23

HB1A 19,21,23

LV1 12

LV1 15

LV1 15

A.I.C. RATING: 10K AIC FULLY RATED MAINS TYPE: MCB MAINS RATING: 150 A MCB RATING: 150 A

TOTAL EST. DEMAND: 52 A

KITCH EQUIP:

NOTES:

UH 1 UNIT HEATER

UH 2 UNIT HEATER

C CB TYPE POLES TRIP LOAD DESCRIPTION	CCT TYPE	СКТ	4 ASI #2	СКТ	CCT TYPE	LOAD DESCRIPTION	TRIP	POLES	СВ ТҮРЕ		\ -^-	В	<b>~</b> ~	(		СВ ТҮРЕ	POLES	TRIP	LOAD DESCRIPTION
BUSSED SPACE		2		1	E	BOILER (B-1)	25	2		1560	180		<b>~</b>	7			1	20	UTILITY YARD RECEPT
BUSSED SPACE		4	}	3								1560	1200	7		GFEP	2	20	HEAT TRACE SYSTEM
9422 0 BUSSED SPACE		6	Y	5		SPARE	20	1		. 4 . 4	. <b>A</b> .	A . A		0	1200	_1	<u>_</u>		
BUSSED SPACE		8		7	<b>X</b>	EXHAUST FAN (ÉF-1)	20			818	540						1	20	RETAINING WALL RECEPTS
BUSSED SPACE		10		9	E	PLUMBING PUMP (SP-1)	20	1				1176	0				1	20	SPARE
3048 0 BUSSED SPACE		12		11	E	CTRL PANELS AND GLYCOL FEEDER	20	1						770	0		1	20	SPARE
BUSSED SPACE		14		13		SPARE	20	1		0	0						1	20	SPARE
BUSSED SPACE		16		15		SPARE	20	1				0	0				1	20	SPARE
3048 0 BUSSED SPACE		18		17	E	RP-1, RP-2	20	1						1500	0		1	20	SPARE
BUSSED SPACE		20		19	E	RP-3, RP-4	20	1		1500	0						1	20	SPARE
BUSSED SPACE		22		21	E	RP-5, RP-6	20	1				1500	0				1	20	SPARE
4157 0 BUSSED SPACE		24		23	E	MECHANICAL CONTROLS	20	1						500	0		1	20	SPARE
BUSSED SPACE		26		25	R	BOILER ROOM RECEPTS	20	1		540	0						1	20	SPARE
BUSSED SPACE		28		27	L; R	ELEVATOR SHAFT RECEPT	20	1				218	0				1	20	SPARE
0 0 BUSSED SPACE		30		29	M	THERMOSTAT AND MOTOR DAMPER	20	1						500	0		1	20	SPARE
3 150 DOPPELMAYR PANEL	E; M	32		31	R	MACHINE ROOM RECEPT	20	1		360	0								BUSSED SPACE
3		34		33	E	ELEVATOR CAB CONNECTION	20	1				1000	0						BUSSED SPACE
0 32333		36		35	E	FIRE ALARM CONTROL PANEL	20	1						500	0				BUSSED SPACE
3 70 PANEL 'LB1A' VIA XFMR 'TB1A'	L; E; R	. 38	3	37		RFID GATE XFMR POWER SUPPLY	20	1		500	0		~		<b>~~</b>				BUSSED SPACE
4 <u>1</u>		40		39	E	RFID GATE XFMR POWER SUPPLY	20	<b>1 Y</b>	<b>T Y Y</b>	7 7	<b>Y</b> Y	500	0	Y Y	, ,,				BUSSED SPACE
0 5470		42	4 ASI #2	41	E.	RFID GATE XFMR POWER SUPPLY	20	1 L	ابر بیرا				M	500	مر الم	)			BUSSED SPACE
57478 VA			7731 #2					Total Load:		5998	3 VA	7154	VA VA	547	J VA				
208 A								otal Amps:		51	Α	60	A	46	Α				

Т	otal Amps:	213 A	216 A	208 A		
CB TYPE LEGEND					CIRCUIT	FPHASE CODE LEGEND
GFCI: 5ma Ground Fault Circuit Interrupter		HC(-ON/OFF): HANDL	E CLAMP FOR LOCKII	NG IN ON/OFF POSITION	N1.	EXISTING LOAD ON EXISTING CIRCUIT BREAKER.
GFEP: 30mA GROUND FAULT PROTECTION FOR EQUIPMENT		HT#: HANDLE TIE WIT	TH GROUPING #		N2.	NEW LOAD ON EXISTING CIRCUIT BREAKER.
AFCI: ARC FAULT CIRCUIT INTERRUPTER		ST: SHUNT TRIP			N3.	NEW LOAD ON NEW CIRCUIT BREAKER. CIRCUIT
CAFCI: COMBINATION ARC FAULT & 5mA GROUND FAULT CIRCUIT	NTERRUPTER	LOCK: PERMANENTLY	LOCKABLE BREAKER			BREAKER AND AIC RATING TO MATCH EXISTING.
CCT TYPE:	LOAD		DEMAND LOAD		·	PANEL TOTALS
LIGHTING:	812 VA	1	1015 VA			
RECEPTACLE:	1800 V	Δ	1800 VA			TOTAL CONN. LOAD: 175921 VA
MOTOR:	54872 V	<b>′</b> A	61939 VA			TOTAL EST. LOAD: 183191 VA
EQUIPMENT:	118437 \	<b>V</b> A	118437 VA			TOTAL CONN.: 212 A
KITCH EQUIP:						TOTAL EST. DEMAND: 220 A
NOTES:		·		·		
CCT TYPE: LIGHTING: RECEPTACLE: MOTOR: EQUIPMENT: KITCH EQUIP:	LOAD 812 VA 1800 VA 54872 V	A A '/A	1015 VA 1800 VA 61939 VA			TOTAL CONN. LOAD: 175921 VA TOTAL EST. LOAD: 183191 VA TOTAL CONN.: 212 A

CB TYPE LEGEND CIRCUIT PHASE CODE LEGEND GFCI: 5ma Ground Fault Circuit Interrupter HC(-ON/OFF): HANDLE CLAMP FOR LOCKING IN ON/OFF POSITION EXISTING LOAD ON EXISTING CIRCUIT BREAKER. HT#: HANDLE TIE WITH GROUPING # GFEP: 30mA GROUND FAULT PROTECTION FOR EQUIPMENT NEW LOAD ON EXISTING CIRCUIT BREAKER. AFCI: ARC FAULT CIRCUIT INTERRUPTER ST: SHUNT TRIP NEW LOAD ON NEW CIRCUIT BREAKER. CIRCUIT LOCK: PERMANENTLY LOCKABLE BREAKER BREAKER AND AIC RATING TO MATCH EXISTING. CAFCI: COMBINATION ARC FAULT & 5mA GROUND FAULT CIRCUIT INTERRUPTER CCT TYPE: DEMAND LOAD PANEL TOTALS LOAD LIGHTING: 38 VA 48 VA 1800 VA TOTAL CONN. LOAD: 18622 VA RECEPTACLE 1800 VA TOTAL EST. LOAD: 18836 VA MOTOR: 1318 VA 1523 VA TOTAL CONN.: 52 A **EQUIPMENT:** 15466 VA 15466 VA

> **AE DESIGN** Integrated Lighting and Electrical Solutions

> > 1900 Wazee Street #205 | Denver, CO 80202 | 303.296.3034

aedesign-inc.com

06/11/2021

NOTICE: DUTY OF COOPERATION Release of these plans contemplates further architect. Design and construction are complex. performed their services with due care and diligence they cannot guarantee perfection. Communication is imperfect and every contingency cannot be anticipated these plans shall be reported immediately to the architect. Failure to notify the architect compounds nisunderstanding and increases construction costs. A shall relieve the architect from responsibility for the consent of the architect are unauthorized and shall consequences arriving out of such changes.

All design, documents and data prepared by Eric Smith Associates, P.C. as instruments of service shall remain property of Eric Smith Associates, P.C. and shall not be copied, changed or disclosed in any written consent of Eric Smith Associates, P.C.

Eric Smith Associates, P.C.

REVISIONS Description ADDENDUM #1 3/12/2021 4/19/2021 ASI #2 6/7/2021

Job Number: | 20034 03/29/2 Date: Drawn By: BDJ, MAE Checked By: 1PK

**Project Phase** CONSTRUCTION DOCUMENTS

**Sheet Title** ELECTRICAL SCHEDULES

**Sheet Number** 

d. GREENGATE e. WATTSTOPPER f. DOUGLAS

FOLLOWING PRE-APPROVED MANUFACTURERS:

ROOM CONTROLLER GENERAL NOTES R1 APPROVED ROOM CONTROLLER LIGHTING CONTROLS TO BE PROVIDED BY ONE OF THE FOLLOWING PRE-APPROVED MANUFACTURERS: a. CRESTRON b. nLIGHT

c. LUTRON d. GREENGATE e. WATTSTOPPER f. DOUGLAS

a. LEVITON

c. LUTRON

b. nLIGHT/SENSORSWITCH

REFER TO ELECTRICAL LIGHTING LAYOUTS FOR LAYOUT OF DEVICES CONNECTED TO ROOM CONTROLLERS. ROOM CONTROLLER COMPONENTS ARE INDICATED IN THE "LIGHTING CONTROL DEVICE" SCHEDULE, THESE COMPONENTS START WITH THE DESIGNATION 'R'.

ROOM CONTROLLER HEAD END EQUIPMENT LOCATIONS ARE INDICATED IN SPACES, HOWEVER DRAWINGS ARE DIAGRAMMATIC AND EXACT QUANTITY OF ROOM CONTROLLER HEAD END EQUIPMENT PIECES VARIES FROM MANUFACTURER TO MANUFACTURER BASED ON DIMMING UTILIZATION, QUANTITY OF RELAYS, NUMBER OF INPUT DEVICES, QUANTITY OUTPUT ZONES AND RECEPTACLE CONTROL.

				LIGH	TING F	FIXTUR	E SCHE	DULE						
TYPE	DESCRIPTION	MANUFACTURER	CATALOG NUMBER	VOLTAGE	LAMP QUAN.	LAMP WATTAGE	LAMP / CCT / CRI	MAX WATTAGE	LUMEN OUTPUT	DIMMING	FIXTURE FINISH	LOCATION	BOF/RFD/O FH	NOTES
EA1	AREA TYPE IV LED POLE	HUBBELL	ALT4-P70-96L-3K-277-BL	277 V	1	224 W	3000K 80 CRI LED	224 VA	19582		BLACK	POLE	15'-0" OFH	1,2
EA2	AREA TYPE V LED POLE	HUBBELL	ALT5-P35-96L-3K-277-BL	277 V	1	104 W	3000K 80 CRI LED	104 VA	11644		BLACK	POLE	15'-0" OFH	1,2
EA3	EXTERIOR LED AREA POLE LIGHT, SINGLE HEAD TYPE III	HUBBELL	ALT4-P35-96L-3K-277-BL	277 V	1	104 W	3000K 80 CRI LED	104 VA	9902		BLACK	POLE	15'-0" OFH	1,2
ED1	15" X 15" SQUARE LED	CREE	CPY250-DM-F-C-UL-BK-30K-	277 V	1	31 W	3000K 80 CRI	31 VA	4210	~~~~	BLACK	CANOPY SUBFACE	2" RFD	1,3
ED1EM	15" X 15" SQUARE LED CANOPY DOWNLIGHT WITH REMOTE EMERGENCY INVERTER	CREE	CPY250-DM-F-C-UL-BK-30K-DIM	277 V	1	31 W	3000K 80 CRI LED	31 VA	4210		BLACK	CANOPY SURFACE	2" RFD	1,3
EWZEM -	MOUNT WITH -20 DEGREES C RATED EMERGENCY BATTERY BACKUP	ETHONIA	LED-P1-30K-80CRI-VW-MVOL T-E20WC-DBLXD	<b>*</b> ***********************************			TED S000K 80 CBI	WIS VA	163		BLACK	SURFASE WALL	SEPPLANS	A .
L1	4' LED STRIP LIGHT	LITHONIA	CLX-L48-3000LM-SEF-L/LENS -MVOLT-GZ10-30K-80CRI-W H	277 V	1	20 W	3000K 80 CRI LED	20 VA	2631	0-10V	WHITE	SURFACE CEILING	1" RFD	1
L1EM	4' LED STRIP LIGHT WITH EMERGENCY	LITHONIA	CLX-L48-3000LM-SEF-L/LENS -MVOLT-GZ10-30K-80CRI-E1 0WLCP-WH	277 V	1	20 W	3000K 80 CRI LED	20 VA	2631	0-10V	WHITE	SURFACE CEILING	1" RFD	1
L2	4' LED STRIP LIGHT SUSPENDED WITH AIRCRAFT CABLE	LITHONIA	CLX-L48-3000LM-SEF-L/LENS -MVOLT-GZ10-30K-80CRI-W H-ZACVH	277 V	1	20 W	3000K 80 CRI LED	20 VA	2631	0-10V	WHITE	SUSPENDED	12'-0" BOF	1
L2EM	4' LED STRIP LIGHT SUSPENDED WITH AIRCRAFT CABLE AND WITH EMERGENCY	LITHONIA	CLX-L48-3000LM-SEF-L/LENS -MVOLT-GZ10-30K-80CRI-W H-ZACVH-E10WLCP	277 V	1	20 W	3000K 80 CRI LED	20 VA	2631	0-10V	WHITE	SUSPENDED	12'-0" BOF	1
W1	4' LED STRIP LIGHT ELEVATOR SHAFT	CREE	C-STRIP-A-LIN4-22L-30K-WH	120 V	1	19 W	3000K 80 CRI LED	19 VA	2200			SURFACE WALL	SEE PLANS	1
W2	WET RATED LED STRIP LIGHT FIXTURE WITH SILICONE GASKETED LENS, IP 65 RATED OR EQUAL ON GFCI CIRCUIT BREAKER	LITHONIA	FEM-L48-LPPCL-MD-MVOLT- GZ10-35K-80CRI	120 V	1	19 W	3000K 80 CRI LED	19 VA	2000LM			SURFACE	SEE PLANS	1
W2EM	WET RATED LED STRIP LIGHT FIXTURE WITH EM BATTERY, SILICONE GASKETED LENS, IP 65 RATED OR EQUAL ON GFCI CIRCUIT BREAKER	LITHONIA	FEM-L48-LPPCL-MD-MVOLT- GZ10-35K-80CRI-E10WMCP	120 V	1	19 W	3000K 80 CRI LED	19 VA	2000LM			SURFACE	SEE PLANS	1

LIGHTING FIXTURE GENERAL NOTES

D. FOR ALL SPECIFIED LUMINAIRES, THE ELECTRICAL CONTRACTOR SHALL BE RESPONSIBLE FOR PROVIDING ALL MOUNTING HARDWARE.

E. THE CONTRACTOR SHALL VERIFY THE CEILING TYPE BEFORE ORDERING LIGHT FIXTURES TO ENSURE COMPATIBILITY WITH SPECIFIED

ACCESSORIES, COMPONENTS, LEADER/JUMPER CABLES, WIRE FEED, CONNECTORS, END CAPS, REMOTE POWER SUPPLIES, AND ANY OTHER

ALL FINISH SELECTIONS SHALL BE VERIFIED BE ARCHITECT/INTERIOR DESIGNER/OWNER AS PART OF THE SUBMITTAL PROCESS. UNLESS

LIGHTING FIXTURE SPECIFIC NOTES

OVERALL FIXTURE HEIGHT DTERMINED FROM PLATFORM LEVEL ELEVATION (LEVEL 1) TO BOTTOM OF FIXTURE LENS. EC SHALL PROVIDE POLE LENGTHS AS REQUIRED FOR OVERALL FIXTURE HEIGHT INDICATED. COORDINATE EXACT POLE HEIGHT REQUIRED WITH OVERALL

FIXTURE TO BE MOUNTED ON UNDERSIDE OF GONDOLA CANOPY. COORDINATE EXACT LOCATION AND MOUNTING REQUIRMENTS WITH

A. ALL FRONT OF HOUSE LED LAMPS TO BE 3000K COLOR TEMPERATURE AND A MINIMUM OF 90CRI, UON.

NECESSARY COMPONENT AS REQUIRED FOR INSTALLING A SECURE AND FULLY FUNCTIONAL SYSTEM.

G. ALL MOUNTING HEIGHTS SHALL BE VERIFIED WITH ARCHITECTURAL ELEVATIONS PRIOR TO ANY ROUGH-IN.

HEIGHT AND ELEVATION OF POLE BASE. COORDINATE EXACT HEIGHT WITH ARCHITECT PRIOR TO ROUGH-IN.

OTHERWISE NOTED, EC SHALL ASSUME STANDARD LUMINAIRE FINISH OPTION FOR PRICING.

B. ALL REFLECTOR LAMPS TO BE PROVIDED AS WIDE FLOOD DISTRIBUTION, UON.

C. LUMENS LISTED ARE DELIVERED LUMENS, NOT INITIAL.

FIXTURES. NOTIFY SPECIFIER OF ANY DISCREPANCIES.

1. ARCHITECT TO VERIFY COLOR FINISH PRIOR TO ORDERING.

GONDOLA VENDOR PRIOR TO ROUGH-IN.

CRI	19 VA	2000LM			SURFACE	SEE PLANS	1							
								J						
					LIGHT	ΓING SEQ	UEN	CE (	OF OPE	RATIO	N			
							_					TARGET		
	CONTROL						SEI	NSOR			DAYLIGHT	ILLUMINANCE		
SI	EQUENCE		ON		0	)FF	T	YPE	TIME OUT	DIMMING	HARVESTING	(FC)	NOTES	
7	M1	MANUAL ON		MANU	IAL OFF		NONE		N/A	0-10V	NO			
		TIMECLOCK AUTOMA PRIOR TO BUSINESS I			CLOCK AUTOMATIC ( E OF BUSINESS	OFF 30 MINUTES AFTER	NONE		N/A	N/A	NO			
	T2	TIMECLOCK AUTOMA	TIC ON 30 MINUT	TES TIMEC	CLOCK AUTOMATIC (	OFF 30 MINUTES AFTER	NONE		N/A	SWITCHING	NO			

	LIGHT	ING REL	ay sch	<b>IEDUL</b>	.E - RP1
RELAY ID	RELAY DESCRIPTION	DIMMING / SWITCHING	VOLTAGE	PANEL-CIF UIT	CONTROL SEQUENCE
INCLATED	ILLAI DESCRITTION	311111111111111111111111111111111111111	VOLIAGE	011	CONTROL SEQUENCE
RP1-1	PLATFORM POLES		277 V	HB1A-25	TIMECLOCK
RP1-2	WALL/ELEVATOR SCONCES		277 V	HB1A-25	TIMECLOCK
RP1-3	GONDOLA DOWNLIGHTS		277 V	HB1A-25	TIMECLOCK
RP1-4	SPARE				
RP1-5	SPARE				
RP1-6	SPARE				
RP1-7	SPARE				
RP1-8	SPARE				

CLOSE OF BUSINESS

PRIOR TO BUSINESS HOURS

	EMERGENC	Y INVE	ERTER SO	CHEDUL	.E	
INVERTER ID	DESCRIPTION	CONTROL ZONE	PANEL-CIRCUIT	CONNECTED LOAD	MAX LOAD	DETAIL
INV1	BODINE #ELI-S-100 OR APPROVED EQUAL	DD1_3	HB1A-25	62 VA	100 VA	

		LIGHTING SEQU	IFNCF (	OF OPE	FRATIO	N		
		LIGITI II (O SEQO					TARGET	
CONTROL			SENSOR				ILLUMINANCE	
EQUENCE	ON	OFF	TYPE	TIME OUT	DIMMING	HARVESTING	(FC)	NOTES
M1	MANUAL ON	MANUAL OFF	NONE	N/A	0-10V	NO		
T1	TIMECLOCK AUTOMATIC ON 30 MINUTES PRIOR TO BUSINESS HOURS	TIMECLOCK AUTOMATIC OFF 30 MINUTES AFTER CLOSE OF BUSINESS	NONE	N/A	N/A	NO		

LIGHTING CONTROLS

NAMING CONVENTION

(THE ABSENCE OF LETTERS ABOVE UNDER 'SYSTEM TYPE'

SYSTEM TYPE

N = NETWORKED

M = MANUAL

O = OCCUPANCY

T = TIMECLOCK

V = VACANCY

D = DIMMER

E = EXTERIOR

S = SENSOR

P = PHOTOCELL

**DEVICES** 

R = ROOM CONTROLLER

**AUTOMATIC MEANS OF SHUTOFF** 

INDICATE A STANDALONE SYSTEM)

L = LIGHT LEVEL (VIA PHOTOCELL)

C = CONTROLLED RECEPTACLE

U = UNIQUE DEVICE TYPE


W = SWITCH MOUNTED DEVICE

1,2,3... = QUANTITY AS REQUIRED FOR

DIFFERENT PROGRAMMING SCENARIOS, DEVICE

CHARACTERISTICS OR MOUNTING CONDITIONS

RP1-7	SPARE					
RP1-8	SPARE					
		000	0000	000		
' Y Y	* * * * * * * * *	~ ~ ~ ~ ·	~ ~ ~ ~ ~ ·	~ ~ ~ ~	~ ~ ~	~ ~ ~
	EMERGENC	V 1N1\/I	EDTED CO			
	EWERGENC	, i linvi			-⊏	
INVERTER		CONTROL		CONNECTED		
INVERIER				1040	NANYLOAD	
ID	DESCRIPTION	ZONE	PANEL-CIRCUIT	LOAD	MAX LOAD	DETAIL
	DESCRIPTION	ZONE	PANEL-CIRCUIT	LOAD	MAX LOAD	DETAIL

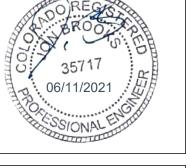

NOTICE: DUTY OF COOPERATION Release of these plans contemplates further cooperation among the owner, his contractor and the architect. Design and construction are complex. performed their services with due care and diligence they cannot guarantee perfection. Communication is imperfect and every contingency cannot be anticipated.
Any ambiguity or discrepancy discovered by the use of these plans shall be reported immediately to the architect. Failure to notify the architect compounds misunderstanding and increases construction costs. A failure to cooperate by a simple notice to the architect shall relieve the architect from responsibility for the consent of the architect are unauthorized and shall relieve the architect of responsibility for all consequences arriving out of such changes. All design, documents and data prepared by Eric

Smith Associates, P.C. as instruments of service shall remain property of Eric Smith Associates, P.C. and shall not be copied, changed or disclosed in any form whatsoever without first obtaining the express written consent of Eric Smith Associates, P.C. Eric Smith Associates, P.C.

No.	Description	Date
1	ADDENDUM #1	3/12/2021
3	ASI #1	4/19/2021
4	ASI #2	6/7/2021

**Job Number:** 20034 03/29/2 Drawn By: BDJ, MAE

Checked By: 1PK **Project Phase** 

CONSTRUCTION DOCUMENTS

**Sheet Title** ELECTRICAL LIGHTING SCHEDULES

**Sheet Number** 

Integrated Lighting and Electrical Solutions 1900 Wazee Street #205 | Denver, CO 80202 | 303.296.3034