



SHADING KEY	
	= PROPOSED OFFICE USE
	= PROPOSED ACCESSORY USE
	= PROPOSED STUDIO USE
	= PROPOSED WAREHOUSE USE
	= STAIRWELL

Building 1 - First Floor Uses			
Unit 22	Level 1	Warehouse	5835
Unit 23	Level 1	Warehouse	1324
Unit 24	Level 1	Studio	11156
Unit 25	Level 1	Studio	857
Unit 25	Level 1	Office	1766
Unit 26	Level 1	Studio	1065
Unit 27	Level 1	Office	3076

SIGNATURE FOR PROPOSED USE DRAWINGS
FOR DEVELOPMENT PERMIT

OWNER: UNITS 22, 23, 24, 25, 26, AND 27, RIVERFRONT PARK,
FILING 3
BRIDGE LANE REALTY, LLC

BY: <u><i>Dan McEntee</i></u>	Dan McEntee
(SIGNATURE)	(PRINT NAME)
ITS: <u>Managing Partner</u>	DATE: <u>2/11/2024</u>

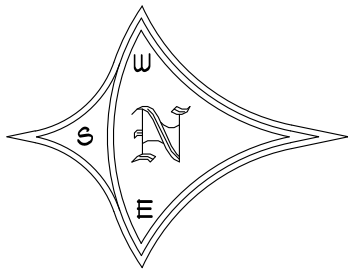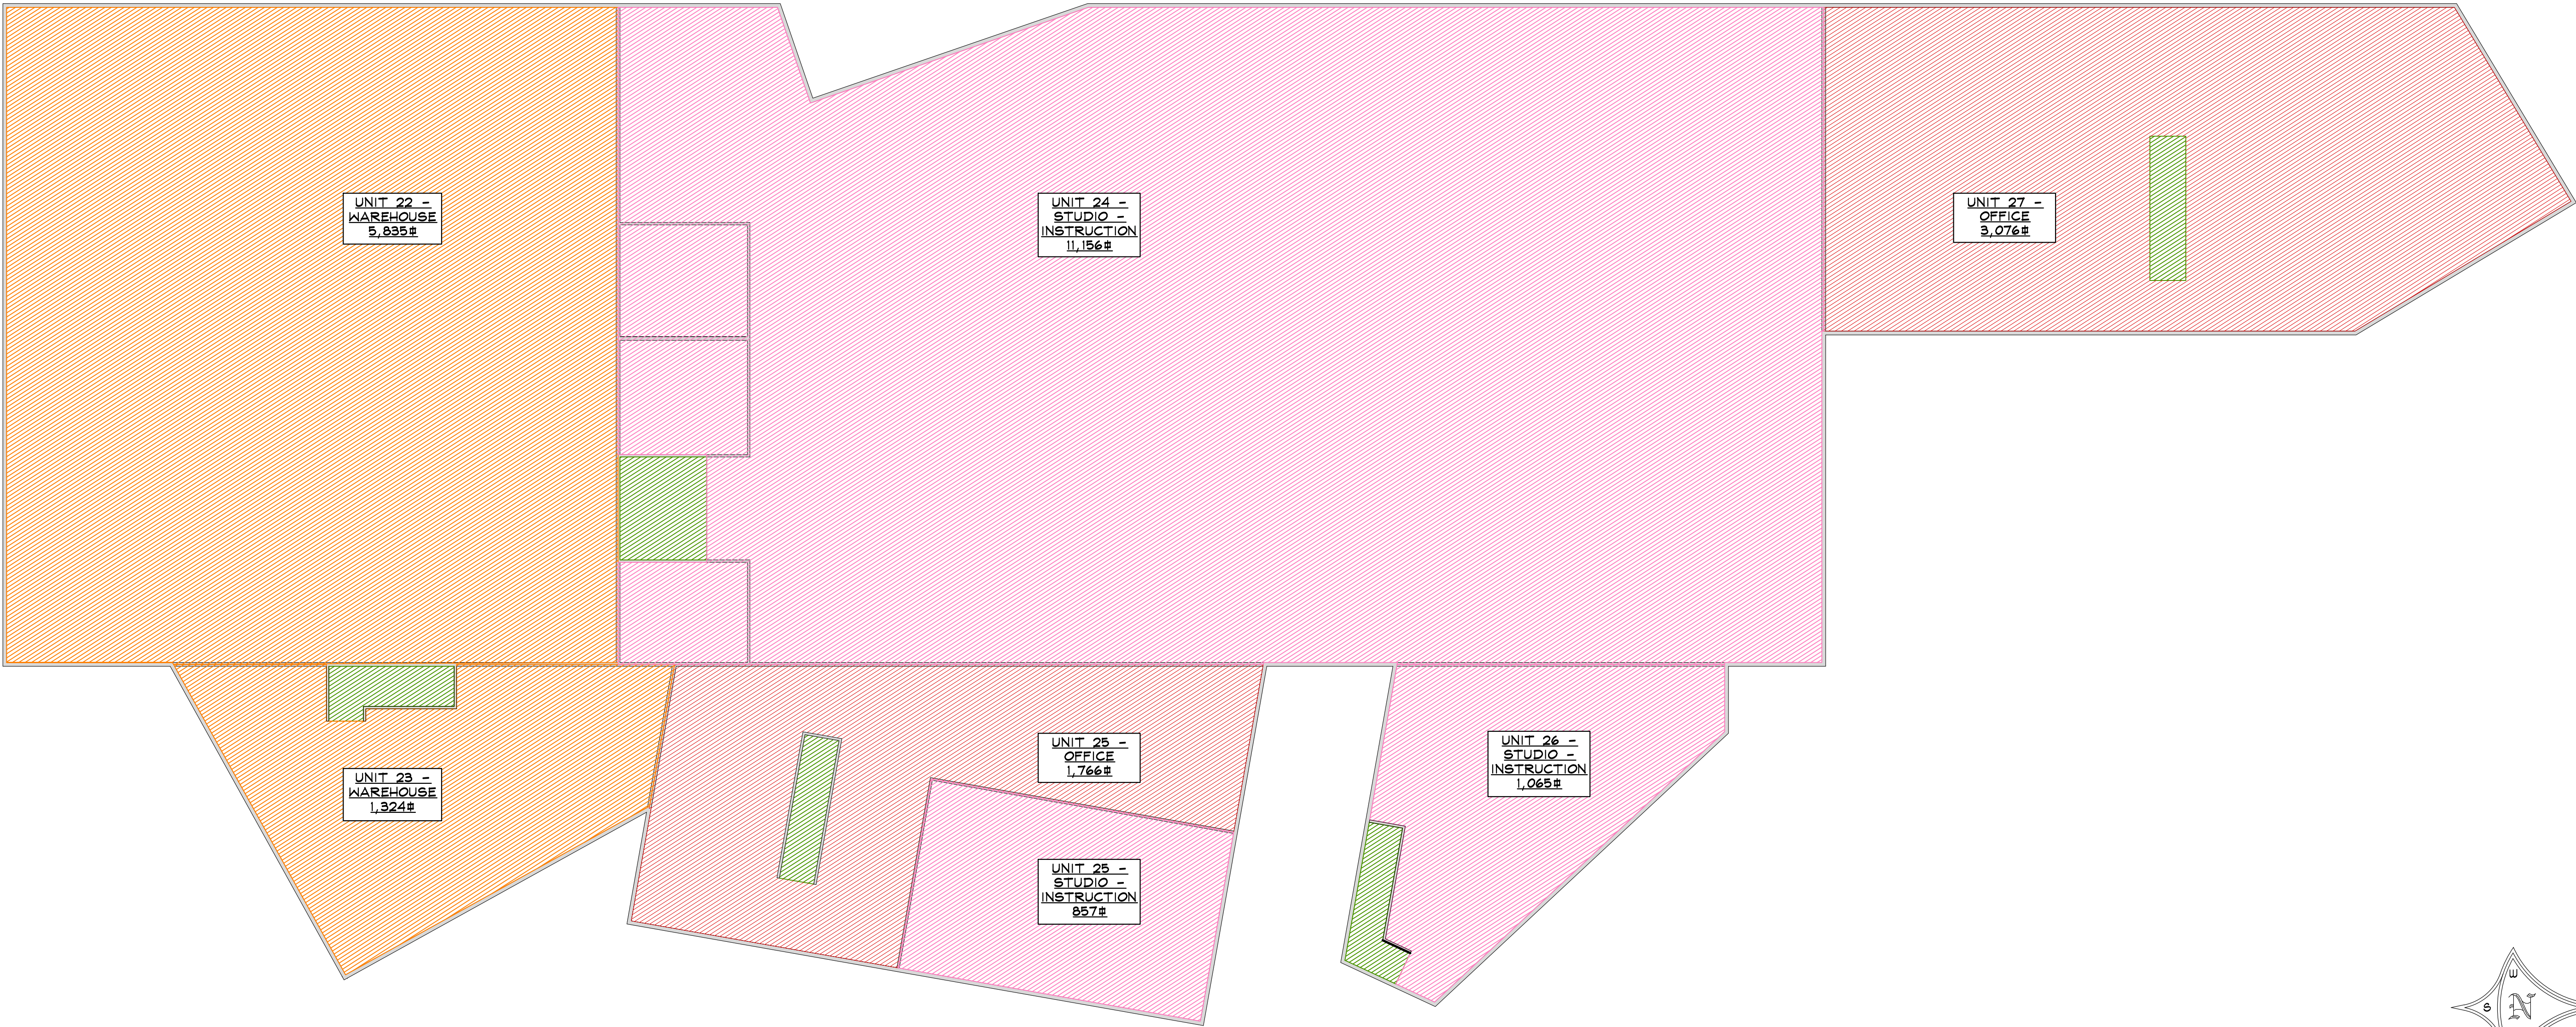

PLAN

1 OVERALL BUILDING 1 1ST LEVEL FLOOR PLAN - USE SHADING

SCALE: N.T.S.

NOT FOR
CONSTRUCTION



RFP BUILDING 1 TENANT FINISH
1955 BRIDGE LANE
STEAMBOAT SPRINGS, COLORADO
AS-BUILT DRAWINGS FOR:
RIVER FRONT PARK HOA

ISSUE DATES

02 . 06 . 24	REVIEW
02 . XX . 24	BY

DRAWN BY: RPM
REVIEWED BY: CWM
PROJECT # 21099

OVERALL BUILDING
1 1ST LEVEL FLOOR
PLAN


A-1

SHADING KEY	
	= PROPOSED OFFICE USE
	= PROPOSED ACCESSORY USE
	= PROPOSED STUDIO USE
	= PROPOSED WAREHOUSE USE
	= STAIRWELL


Building 1 - Second Floor Uses			
Unit 23	Level 2	Office	559
Unit 24	Level 2	Studio	274
Unit 25	Level 2	Office	327
Unit 26	Level 2	Studio	732
Unit 27	Level 2	Office	3076

SIGNATURE FOR PROPOSED USE DRAWINGS
FOR DEVELOPMENT PERMIT

OWNER: UNITS 22, 23, 24, 25, 26, AND 27, RIVERFRONT PARK,
FILING 3
BRIDGE LANE REATLY, LLC
BY: Dan McEntee Dan McEntee
(SIGNATURE) (PRINT NAME)
ITS: Managing Partner DATE: 2/11/2024

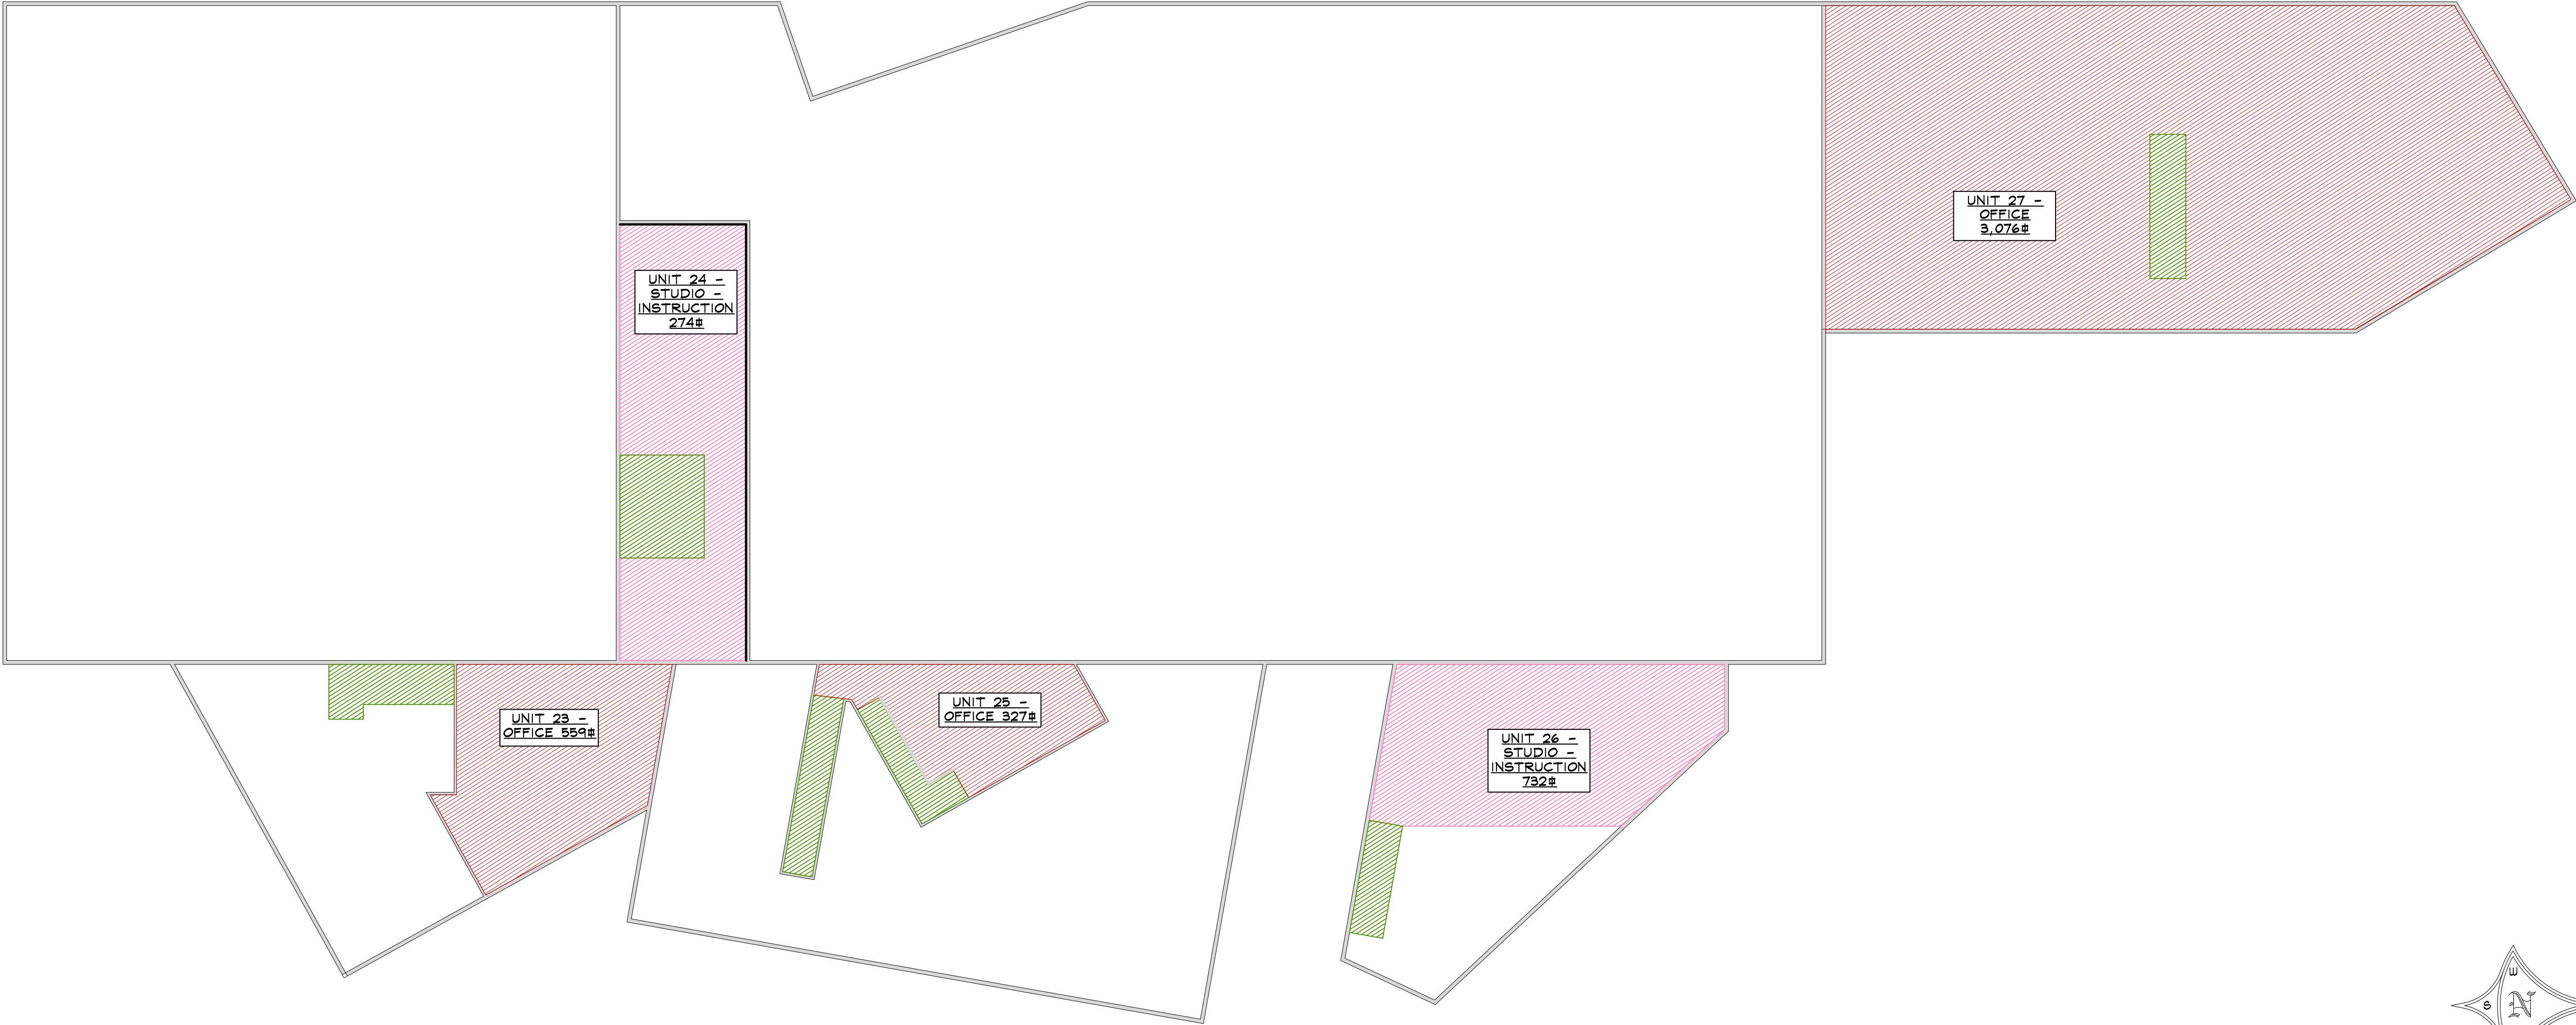

1 OVERALL BUILDING 1 2ND LEVEL FLOOR PLAN - USE SHADING

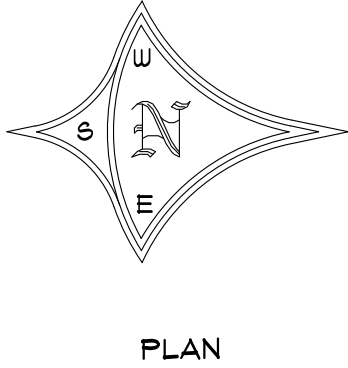

SCALE: N.T.S.

NOT FOR
CONSTRUCTION



STEAMBOAT ENGINEERING AND DESIGN, INC.
2740 Acre Lane Suite 'E' Steamboat Springs, CO 80487
Phone: 970 . 871 . 9101 Fax: 970 . 871 . 9089
E-mail: Jake@seadinc.com

RFP BUILDING 1 TENANT FINISH
1955 BRIDGE LANE
STEAMBOAT SPRINGS, COLORADO
AS-BUILT DRAWINGS FOR:
RIVER FRONT PARK HOA

ISSUE DATES	
02 : 06 : 24	REVIEW
02 : XX : 24	BY

DRAWN BY: RPM
REVIEWED BY: CWM
PROJECT # 21099

OVERALL BUILDING
1 2ND LEVEL
FLOOR PLAN

A-2

SHADING KEY	
	PROPOSED OFFICE USE
	PROPOSED ACCESSORY USE
	PROPOSED STUDIO USE
	PROPOSED WAREHOUSE USE
	STAIRWELL



Building 1 - Third Floor Uses			
Unit 25	Level 3	Accessory	299
Unit 27	Level 3	Accessory	373

SIGNATURE FOR PROPOSED USE DRAWINGS
FOR DEVELOPMENT PERMIT

OWNER: UNITS 22, 23, 24, 25, 26, AND 27, RIVERFRONT PARK,
FILING 3
BRIDGE LANE REALTY, LLC

BY: Dan McEntee Dan McEntee
(SIGNATURE) (PRINT NAME)

ITS: Managing Partner DATE: 2/11/2024

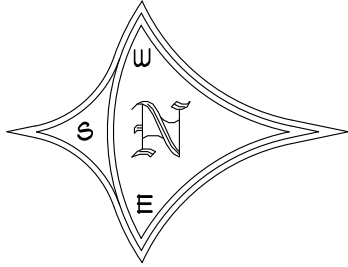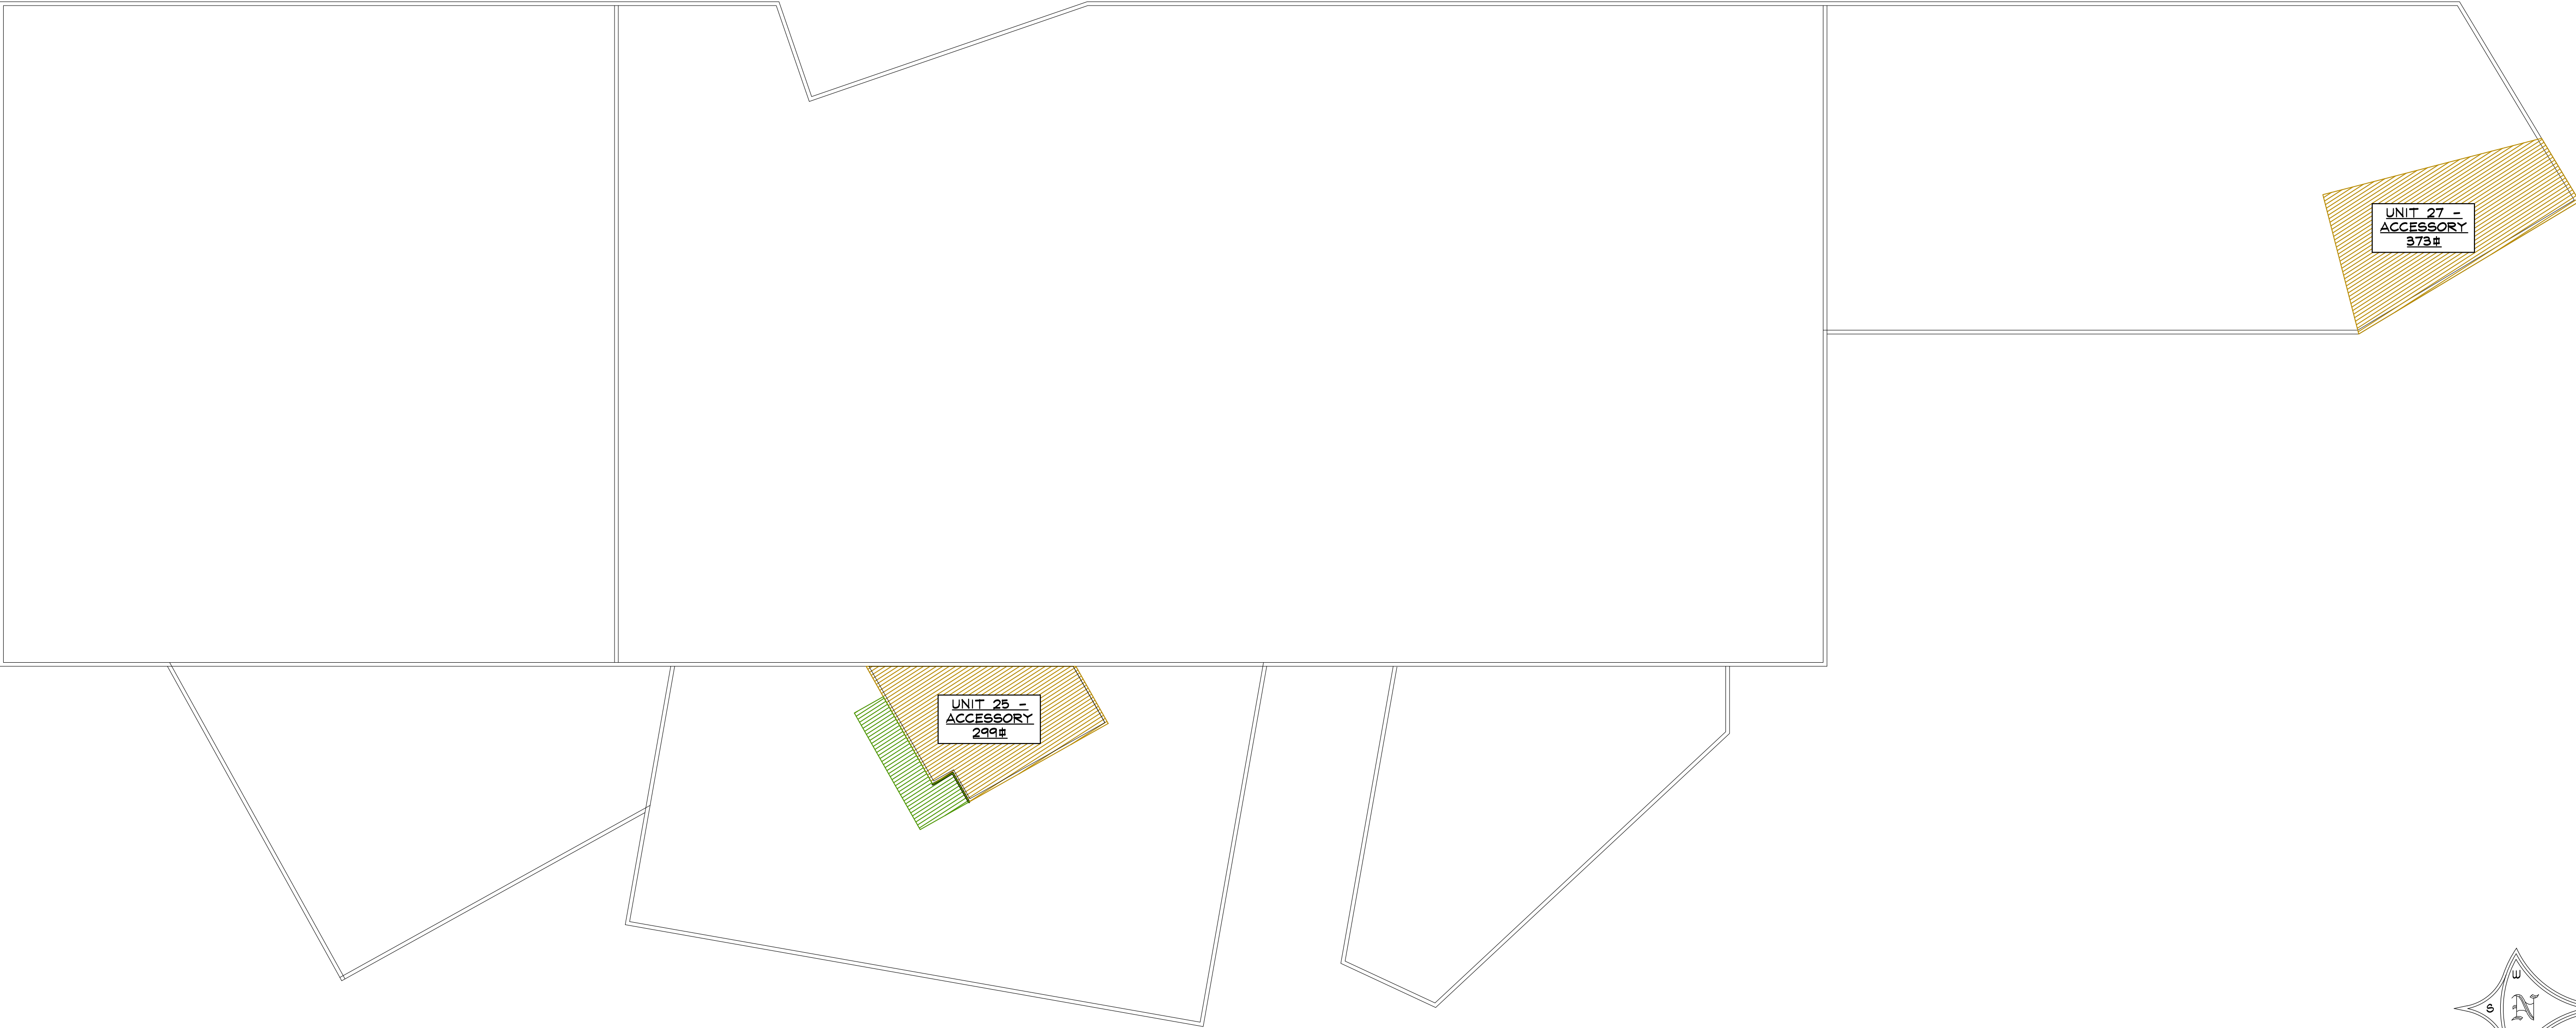

PLAN

1 OVERALL BUILDING 3RD LEVEL FLOOR PLAN - USE SHADING

SCALE: N.T.S.

NOT FOR
CONSTRUCTION



STEAMBOAT ENGINEERING AND DESIGN, INC.
2740 Acre Lane Suite 'E' Steamboat Springs, CO 80487
Phone: 970 . 871 . 9101 Fax: 970 . 871 . 9089
E-mail: Jake@seadinc.com

RFP BUILDING 1 TENANT FINISH
1955 BRIDGE LANE
STEAMBOAT SPRINGS, COLORADO
AS-BUILT DRAWINGS FOR:
RIVER FRONT PARK HOA

ISSUE DATES			
02	06	24	REVIEW
02	XX	24	BY

DRAWN BY: RPM
REVIEWED BY: CWM
PROJECT # 21099

OVERALL BUILDING
1 3RD LEVEL
FLOOR PLAN


A-3

SIGNATURE FOR PROPOSED USE DRAWINGS
FOR DEVELOPMENT PERMIT


OWNER: UNIT 1, RIVERFRONT PARK, PHASE 2

(JOHN DALTON)


(DATE)

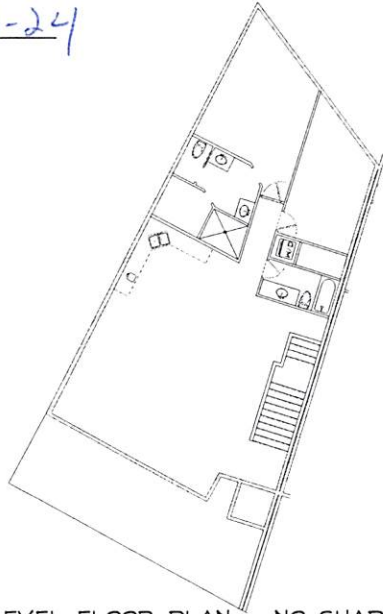

5 3RD LEVEL FLOOR PLAN - NO SHADING
SCALE: 1/4" = 1'-0"

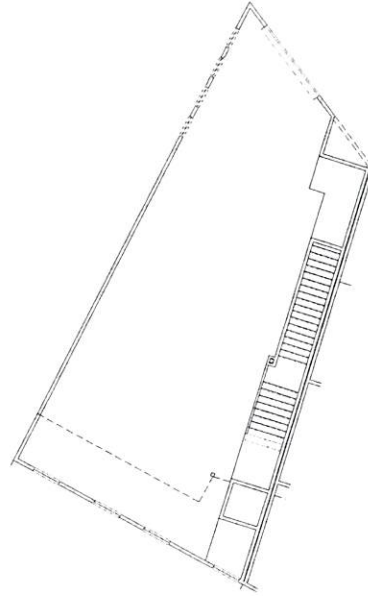


3 2ND LEVEL FLOOR PLAN - NO SHADING
SCALE: 1/4" = 1'-0"

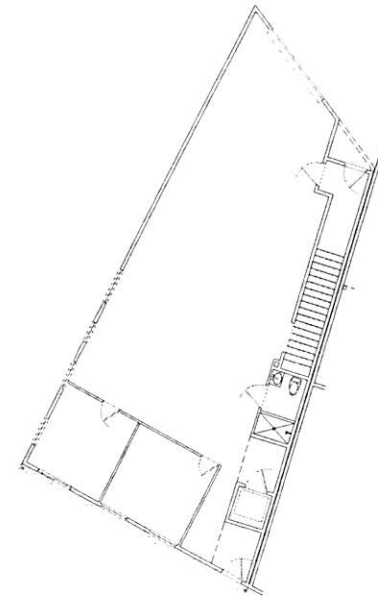


1 1ST LEVEL FLOOR PLAN - NO SHADING
SCALE: 1/4" = 1'-0"

SHADING KEY			
	=	PROPOSED PRIVATE STORAGE USE	
	=	PROPOSED OFFICE USE	
	=	PROPOSED ACCESSORY USE	
	=	PROPOSED RESIDENTIAL USE	
	=	PROPOSED WAREHOUSE USE	
	=	STAIRWELL	


Unit 1	Level 1	Garage	1374
Unit 1	Level 1	Office	500
Unit 1	Level 2	Accessory	64
Unit 1	Level 3	Residential	1471

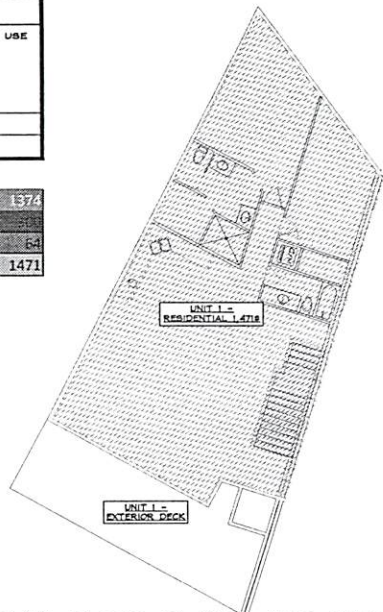

6 1ST LEVEL FLOOR PLAN - USE SHADING
SCALE: 1/4" = 1'-0"

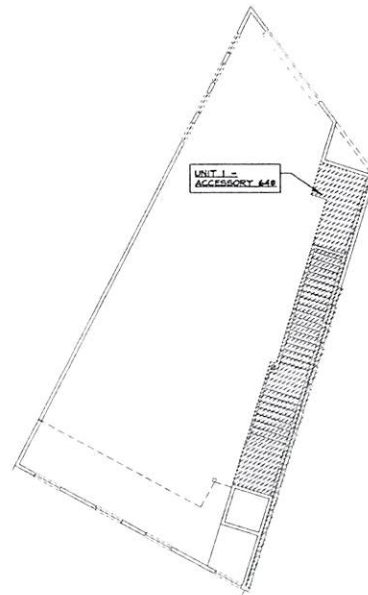

4 2ND LEVEL FLOOR PLAN - USE SHADING
SCALE: 1/4" = 1'-0"

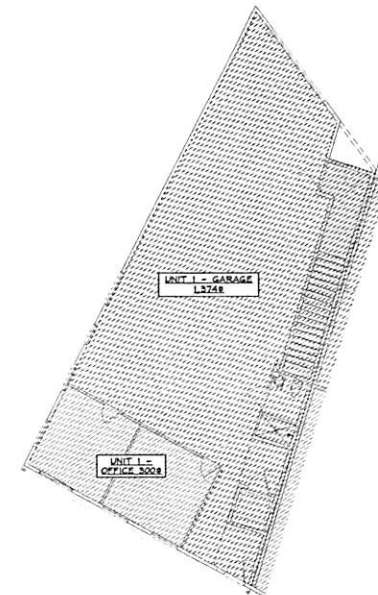

2 1ST LEVEL FLOOR PLAN - USE SHADING
SCALE: 1/4" = 1'-0"

NOT FOR
CONSTRUCTION

SEAD
STEAMBOAT ENGINEERING AND DESIGN, INC.
2140 Acme Lane Suite 200 Steamboat Springs, CO 80487
Phone: 970.871.8101 Fax: 970.871.8089
Email: jsead@seadinc.com

RFP BUILDING 3 TENANT FINISH

1900 BRIDGE LANE

STEAMBOAT SPRINGS, COLORADO

A TENANT FINISH FOR:

RIVER FRONT PARK HOA

ISSUE DATES

08	09	10	100
----	----	-----

DRAWN BY: RPM
REVIEWED BY: CHM
PROJECT # 2104H

UNIT 1 PROPOSED
FLOOR PLANS


UNIT 1

SIGNATURE FOR PROPOSED USE DRAWINGS
FOR DEVELOPMENT PERMIT


OWNER: UNIT 2, RIVERFRONT PARK, FILING 2
RIVERFRONT PROPERTIES, LLC

BY: Scott Buchler Scott Buchler
(SIGNATURE) (PRINT NAME)


ITS: President DATE: 2/16/2024

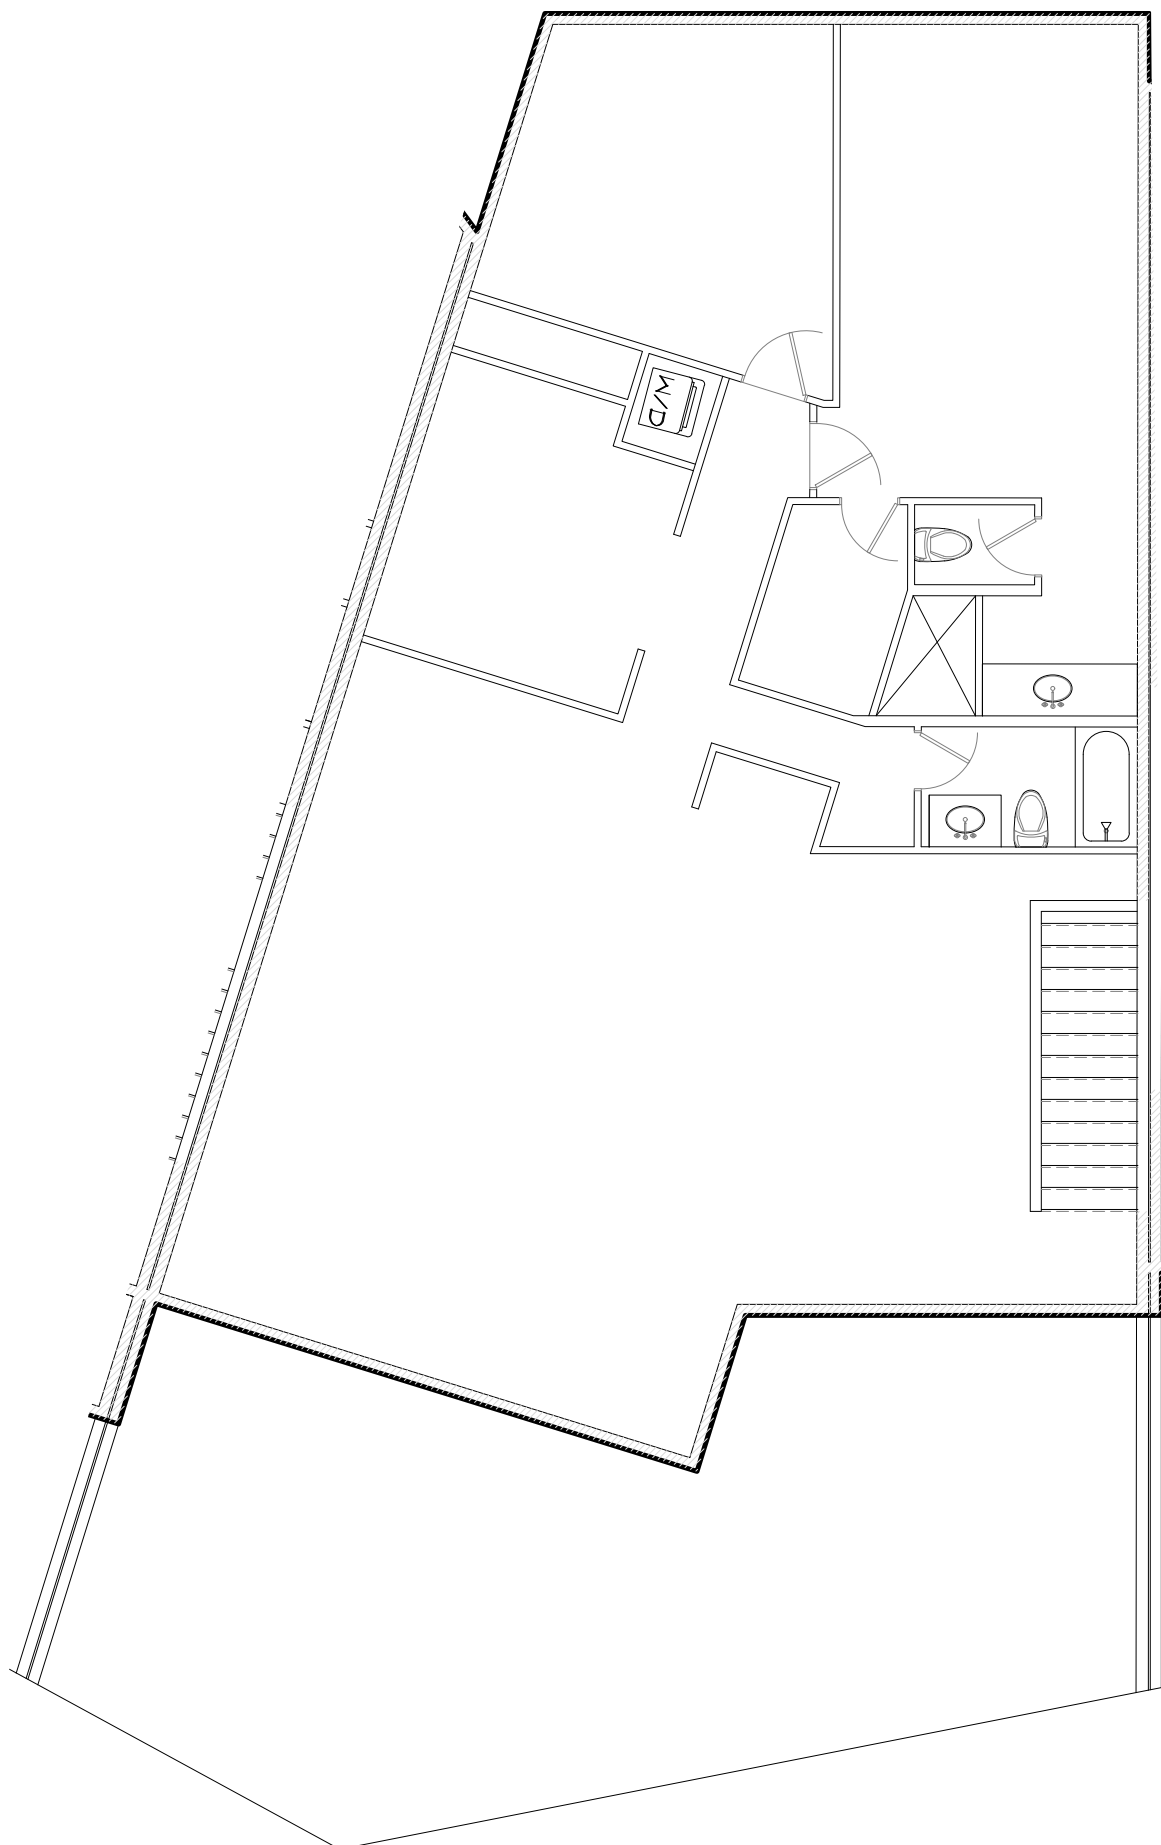

5 3RD LEVEL FLOOR PLAN - NO SHADING
SCALE: 1/8" = 1'-0"

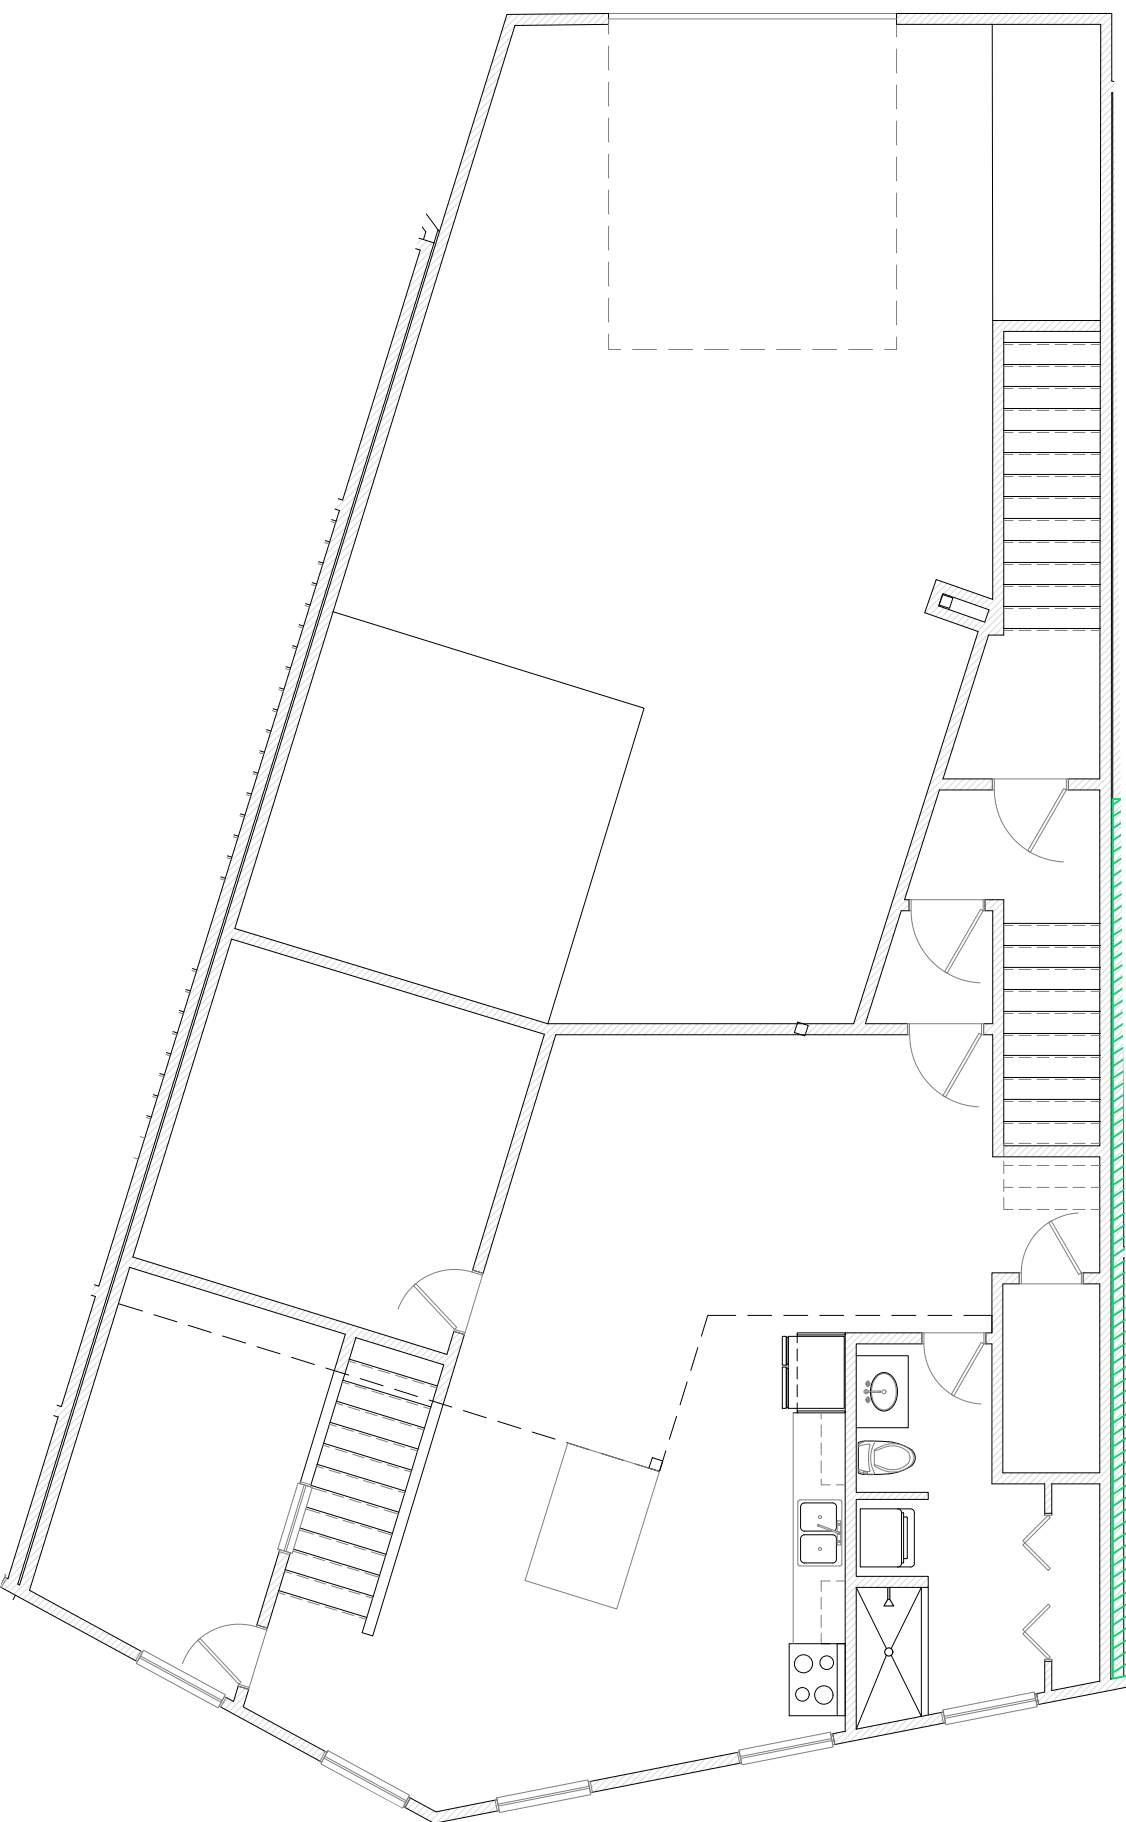


3 2ND LEVEL FLOOR PLAN - NO SHADING
SCALE: 1/8" = 1'-0"

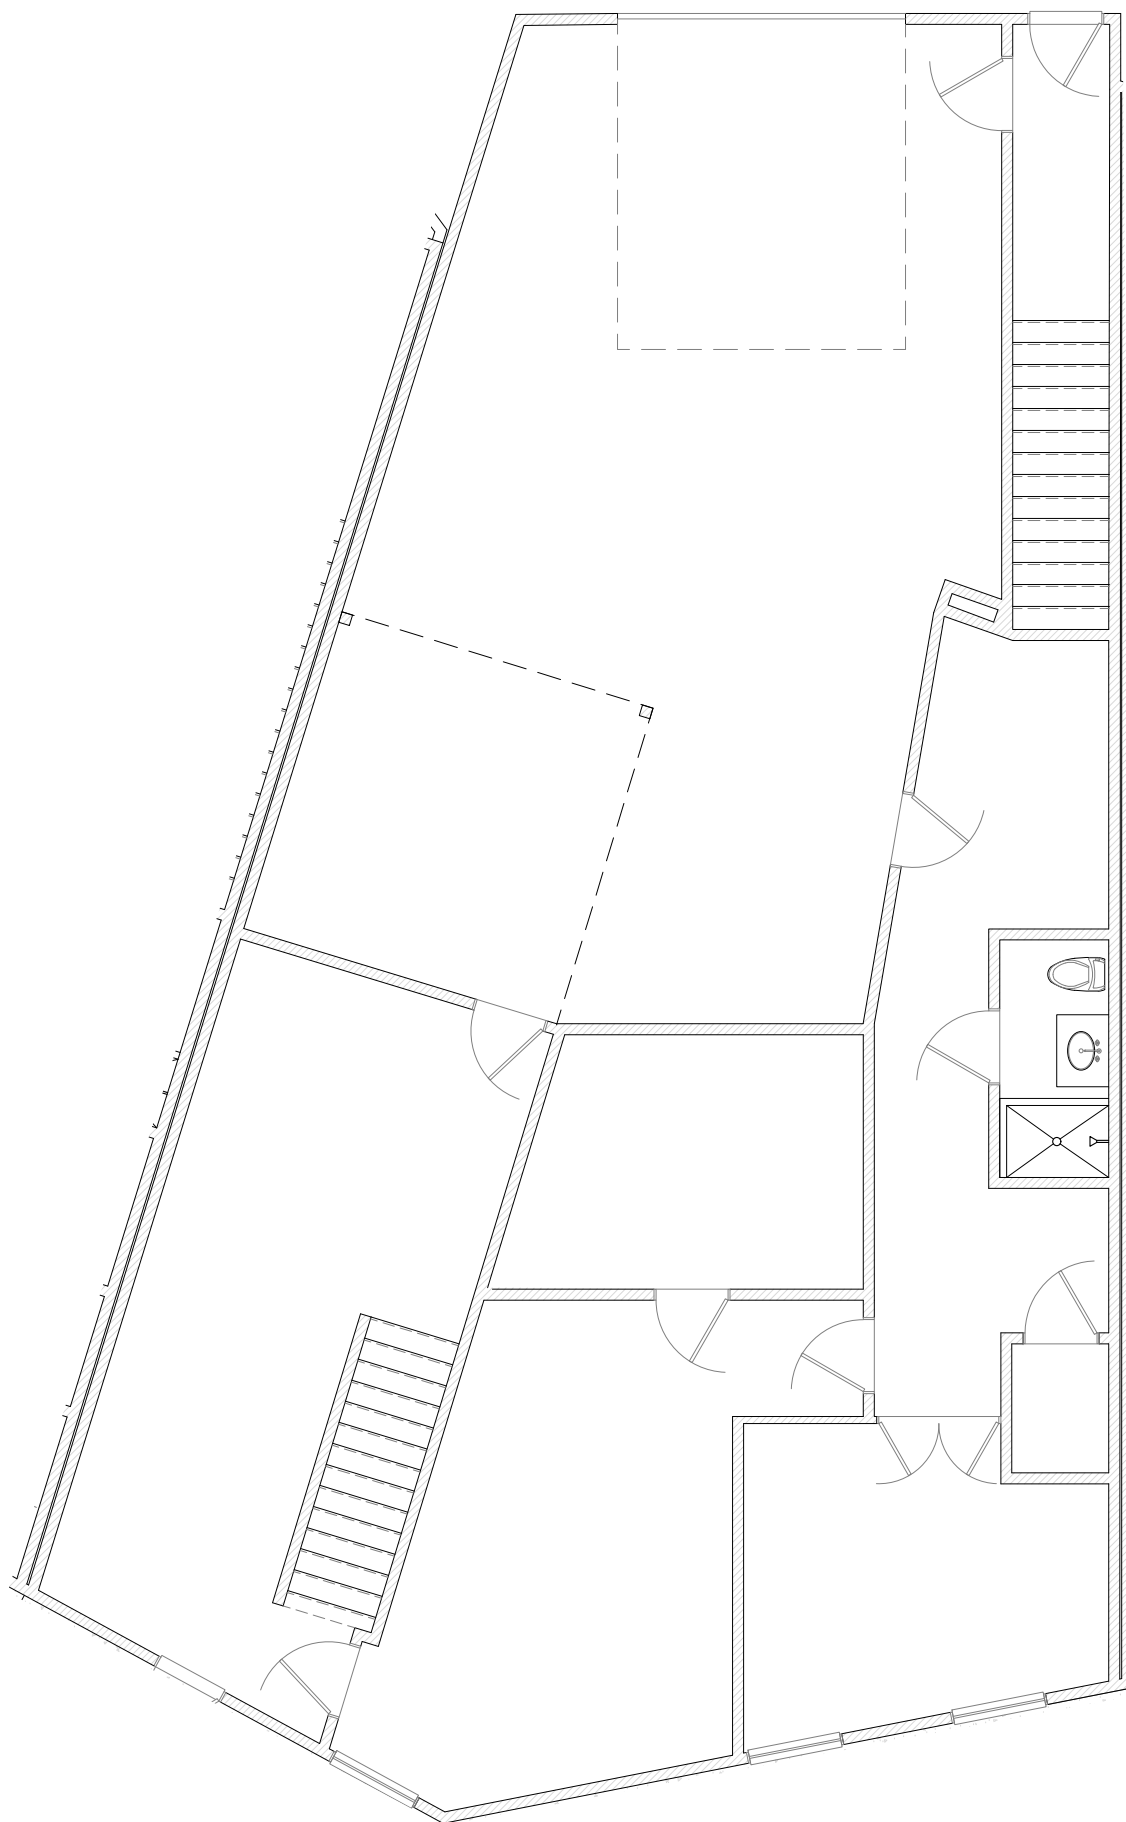


1 1ST LEVEL FLOOR PLAN - NO SHADING
SCALE: 1/8" = 1'-0"

SHADING KEY	
	■ PROPOSED PRIVATE STORAGE USE
	■ PROPOSED OFFICE USE
	■ PROPOSED ACCESSORY USE
	■ PROPOSED RESIDENTIAL USE
	■ PROPOSED WAREHOUSE USE
	■ STAIRWELL


Unit 2	Level 1	Garage	1010
	Level 1	Office	1429
Unit 2	Level 2	Accessory	253
	Level 2	Residential	1251
Unit 2	Level 3	Residential	1793

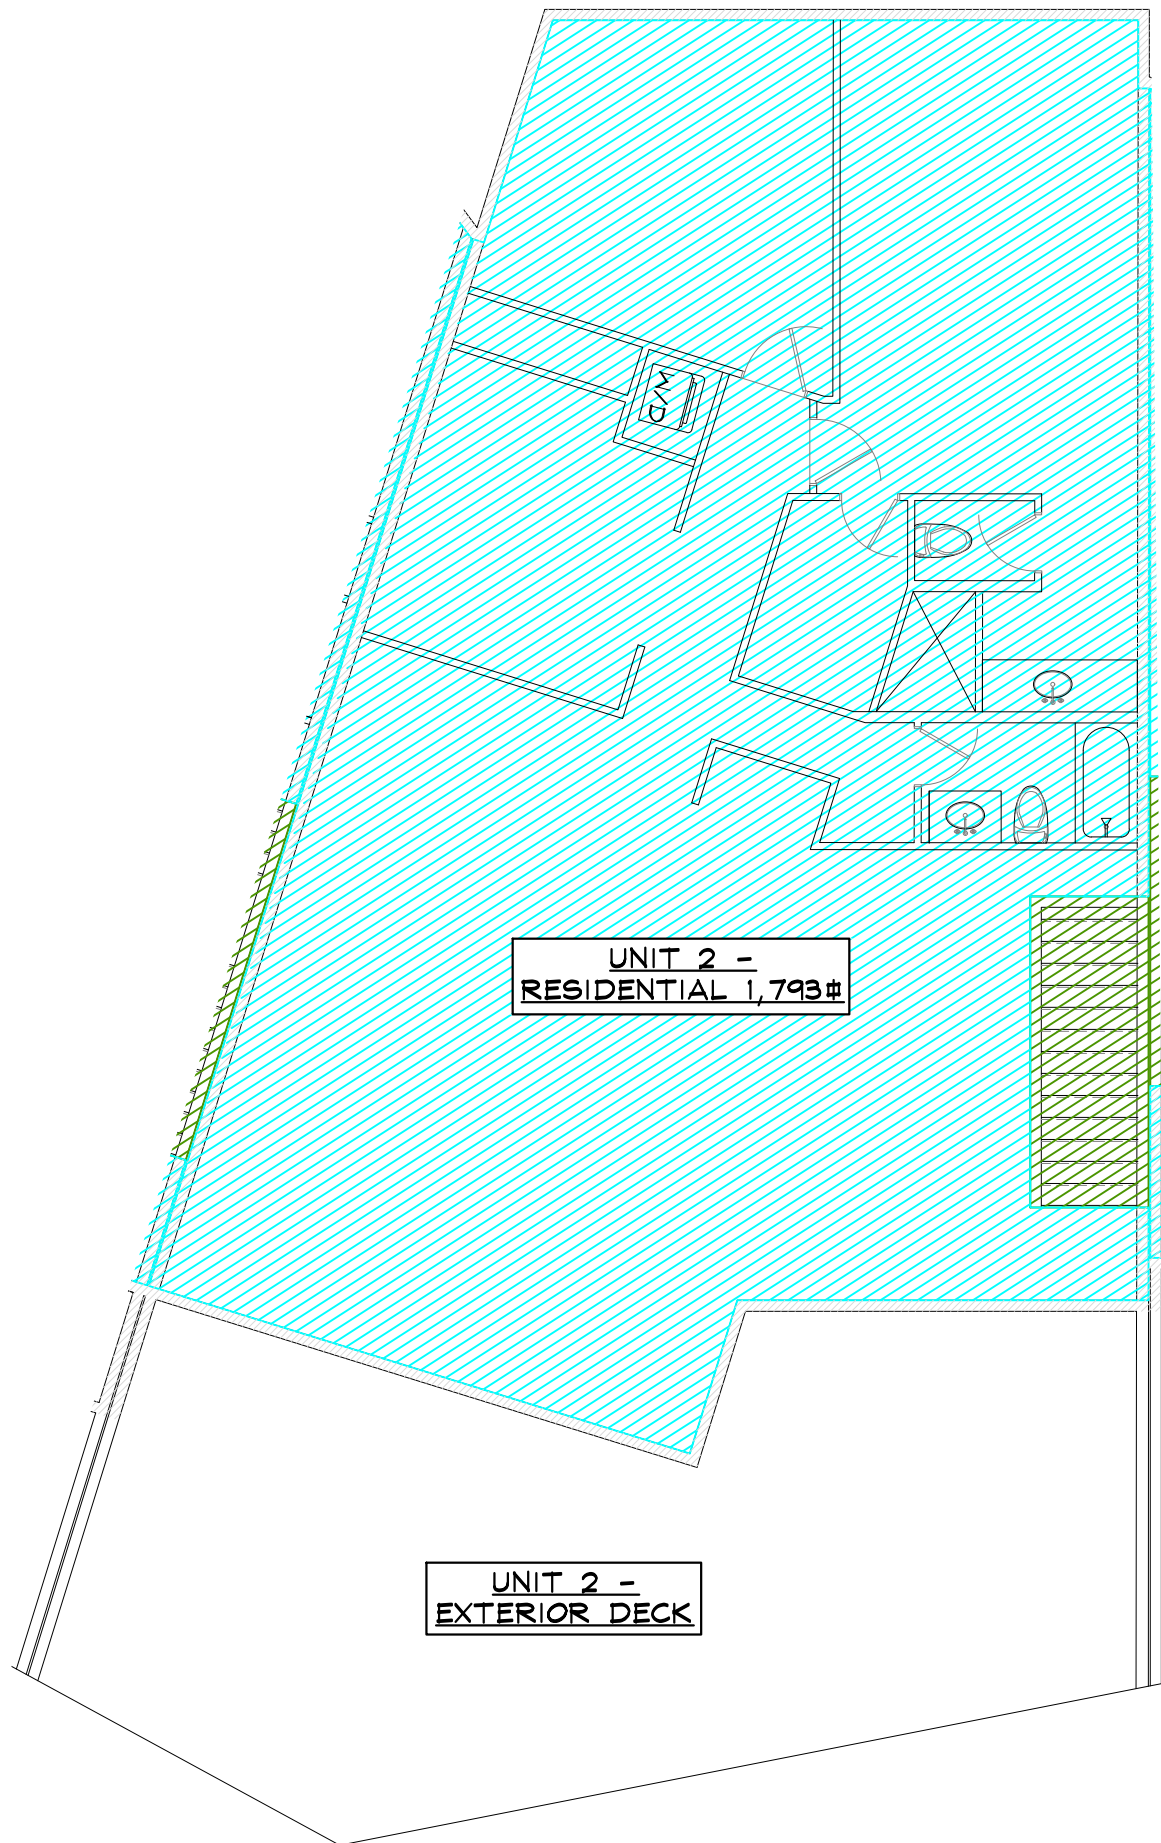

6 1ST LEVEL FLOOR PLAN - USE SHADING
SCALE: 1/8" = 1'-0"

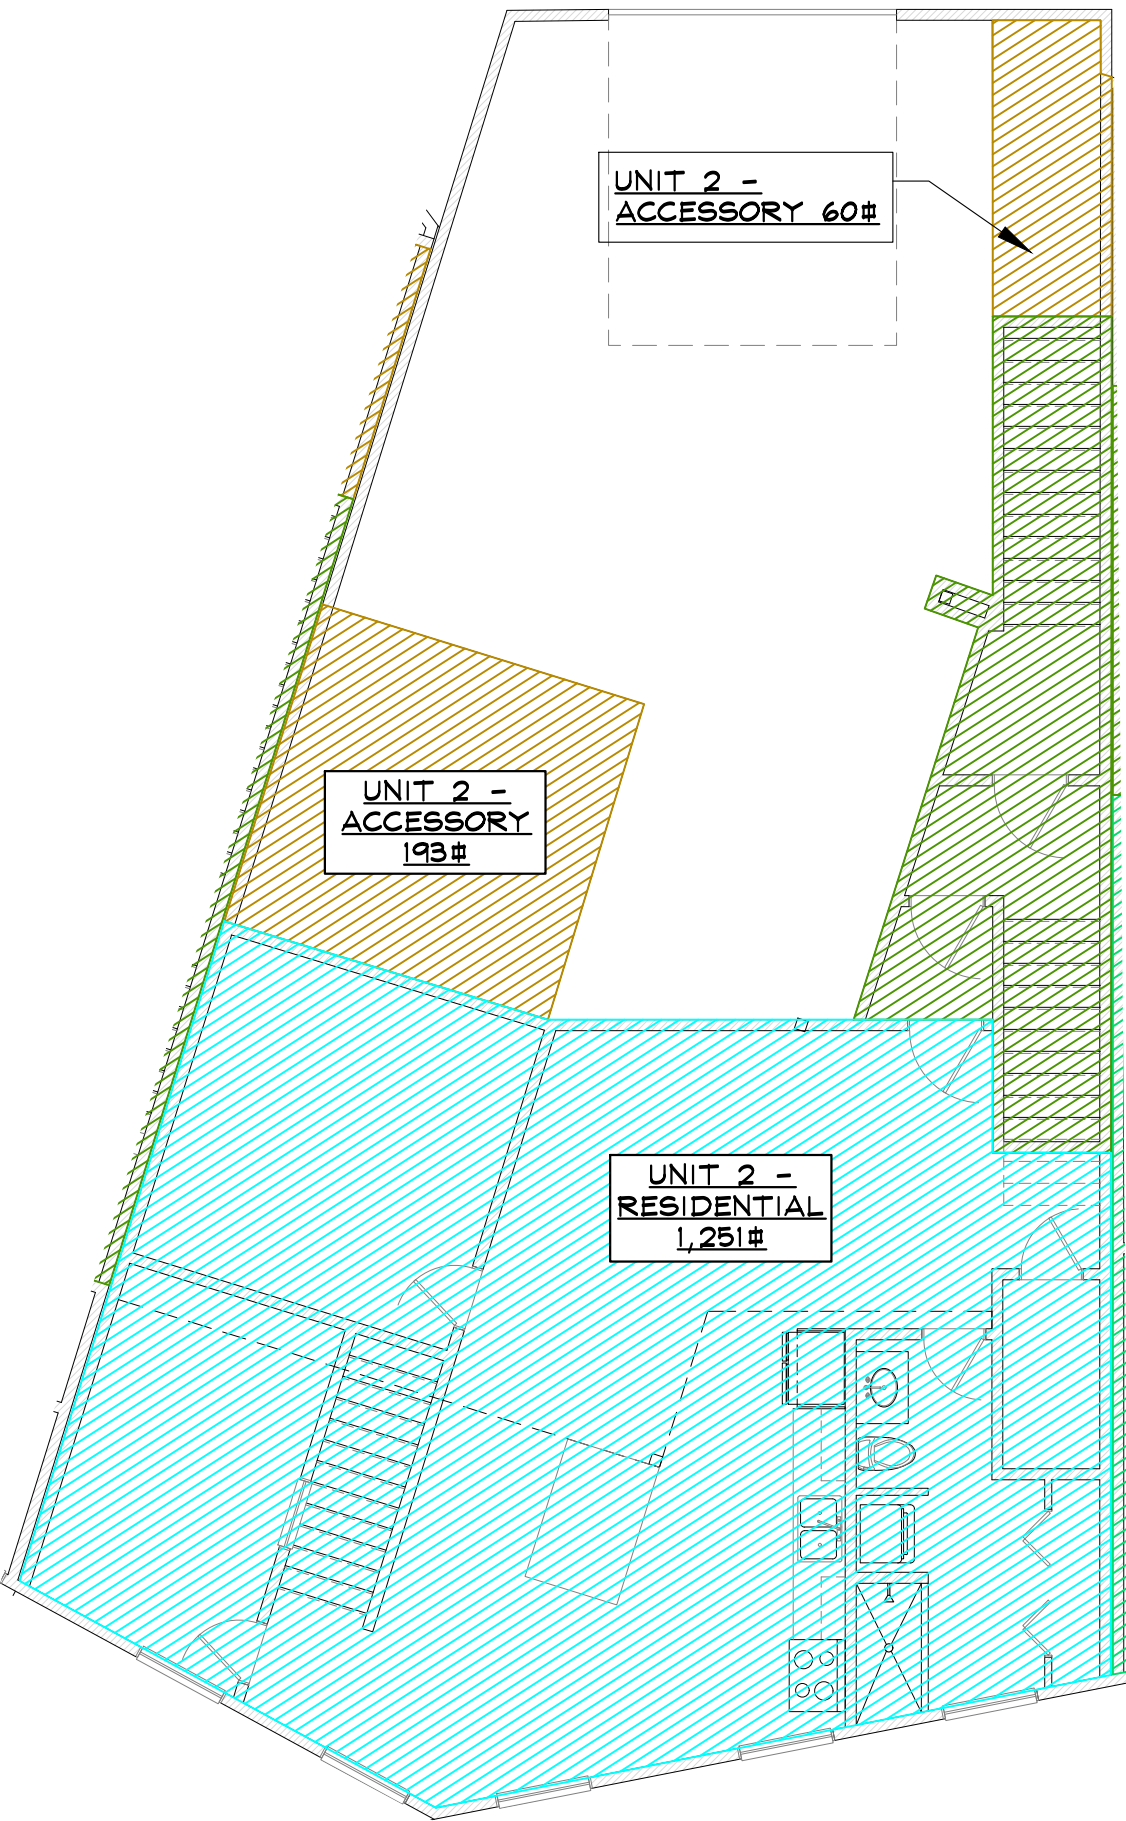

4 2ND LEVEL FLOOR PLAN - USE SHADING
SCALE: 1/8" = 1'-0"

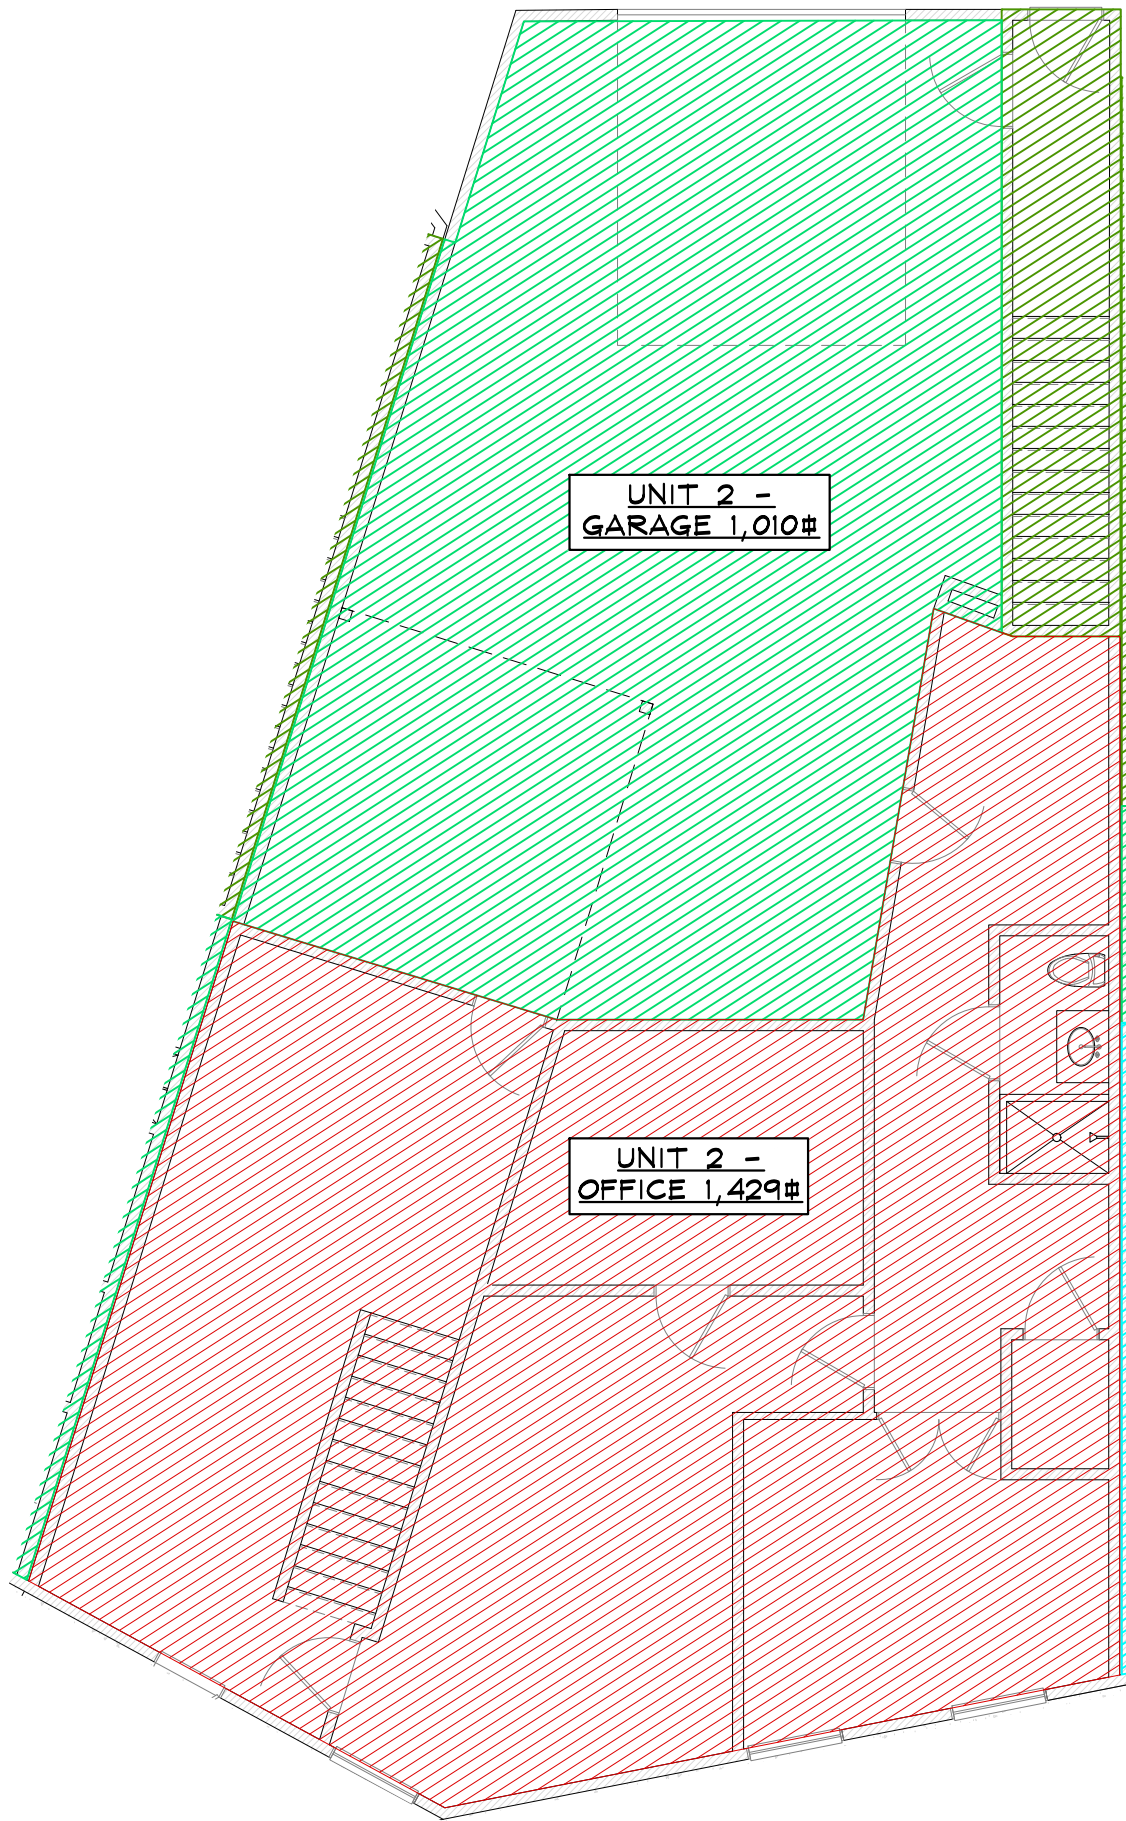

2 1ST LEVEL FLOOR PLAN - USE SHADING
SCALE: 1/8" = 1'-0"

NOT FOR
CONSTRUCTION



STEAMBOAT ENGINEERING AND DESIGN, INC.
2740 Acre Lane Suite 'E' Steamboat Springs, CO 80487
Phone: 970 . 871 . 9101 Fax: 970 . 871 . 9089
E-mail: Jake@seadinc.com

RFP BUILDING 3 TENANT FINISH
1900 BRIDGE LANE
STEAMBOAT SPRINGS, COLORADO
A TENANT FINISH FOR:
RIVER FRONT PARK HOA

ISSUE DATES	
02 . 07 . 24	REVIEW
02 . 04 . 24	DP

DRAWN BY: RPM
REVIEWED BY: CWM
PROJECT # 21099

UNIT 2 PROPOSED
FLOOR PLANS

UNIT 2

SIGNATURE FOR PROPOSED USE DRAWINGS
FOR DEVELOPMENT PERMIT




OWNER: UNIT 3, RIVERFRONT PARK, FILING 2
NS INVESTMENTS, LLC

BY: Stephanie Varbrough
(SIGNATURE)

Stephanie Varbrough
(PRINT NAME)

ITS: Managing Member

DATE: 2/20/2024

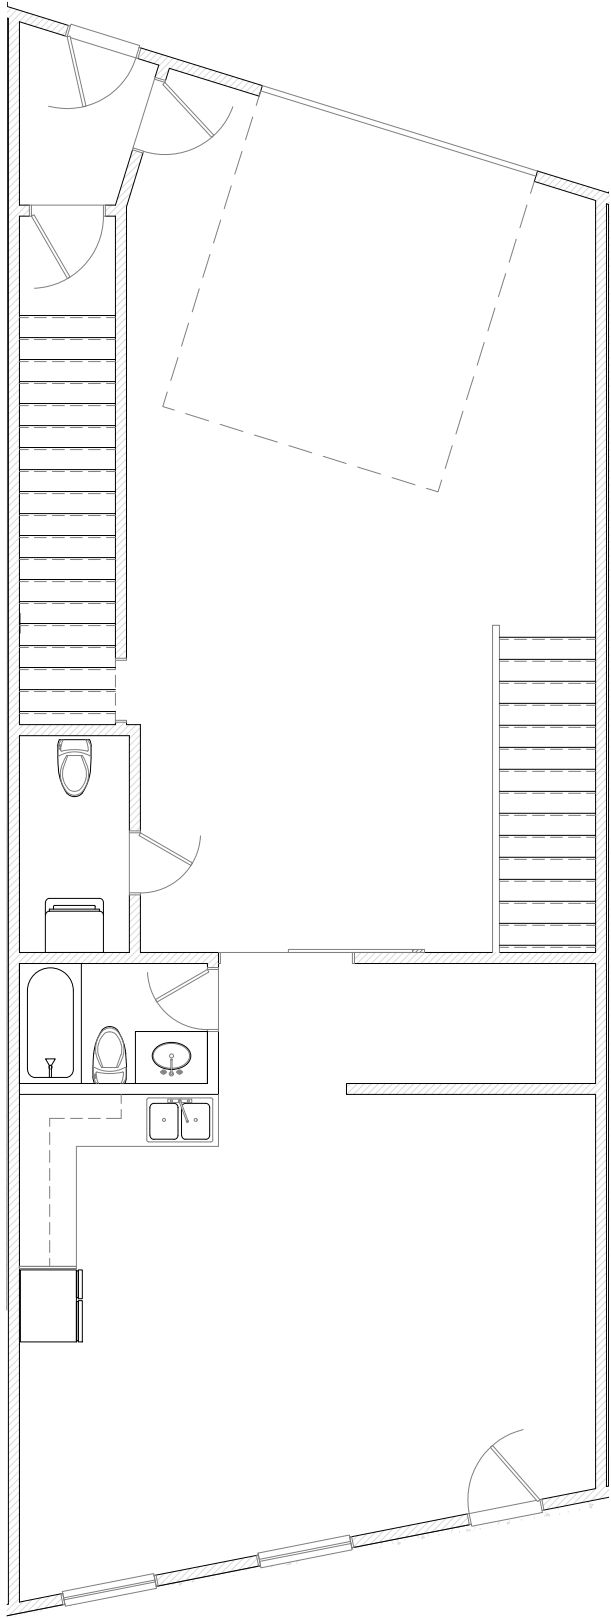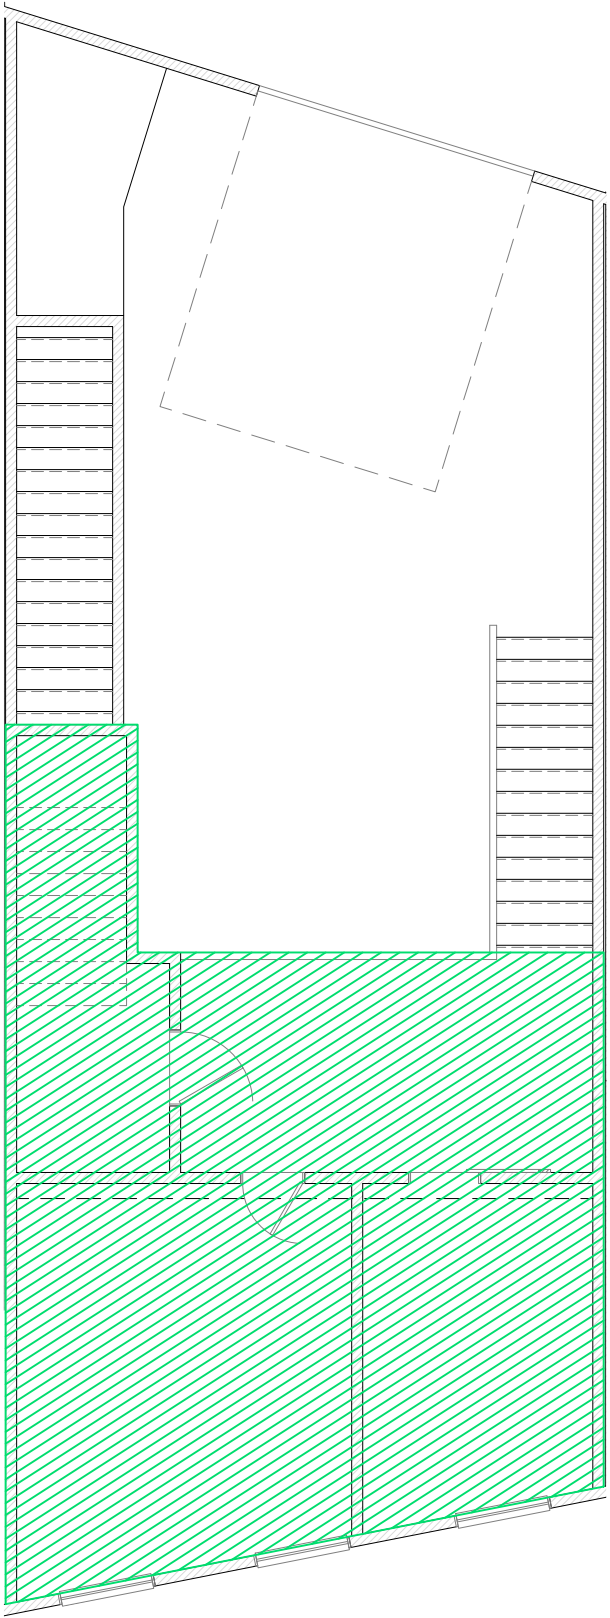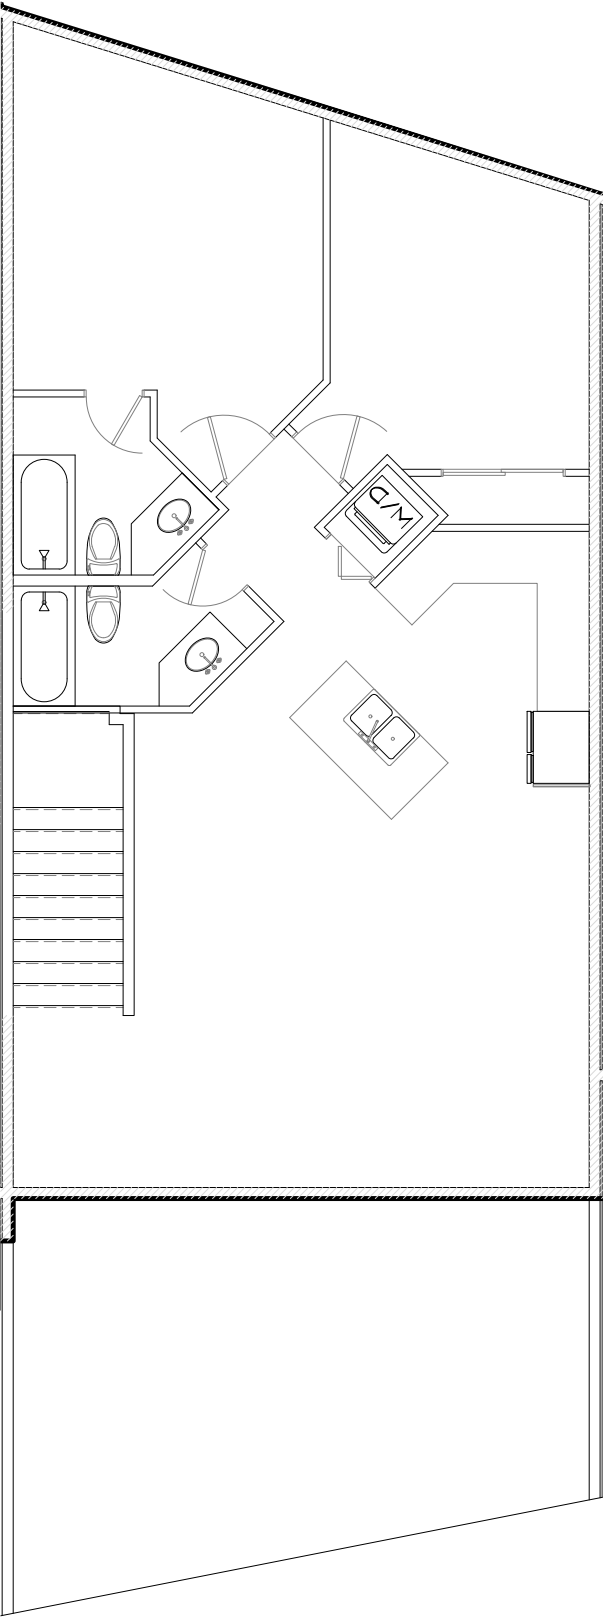




5 3RD LEVEL FLOOR PLAN - NO SHADING
SCALE: 1/8" = 1'-0"

3 2ND LEVEL FLOOR PLAN - NO SHADING
SCALE: 1/8" = 1'-0"

1 1ST LEVEL FLOOR PLAN - NO SHADING
SCALE: 1/8" = 1'-0"

SHADING KEY	
	PROPOSED PRIVATE STORAGE USE
	PROPOSED OFFICE USE
	PROPOSED ACCESSORY USE
	PROPOSED RESIDENTIAL USE
	PROPOSED WAREHOUSE USE
	STAIRWELL

Unit 3	Level 1	Garage	725
	Level 1	Residential	616
Unit 3	Level 2	Accessory	57
	Level 2	Garage	668
Unit 3	Level 3	Residential	1045

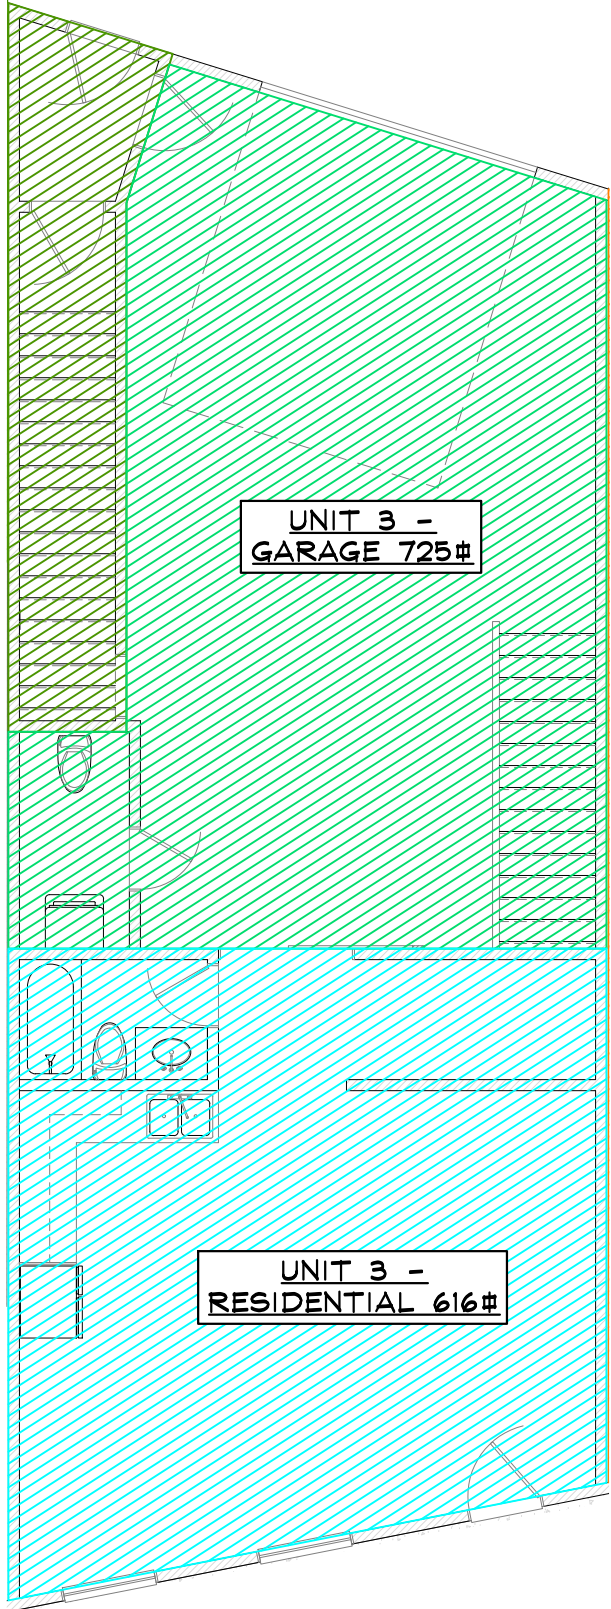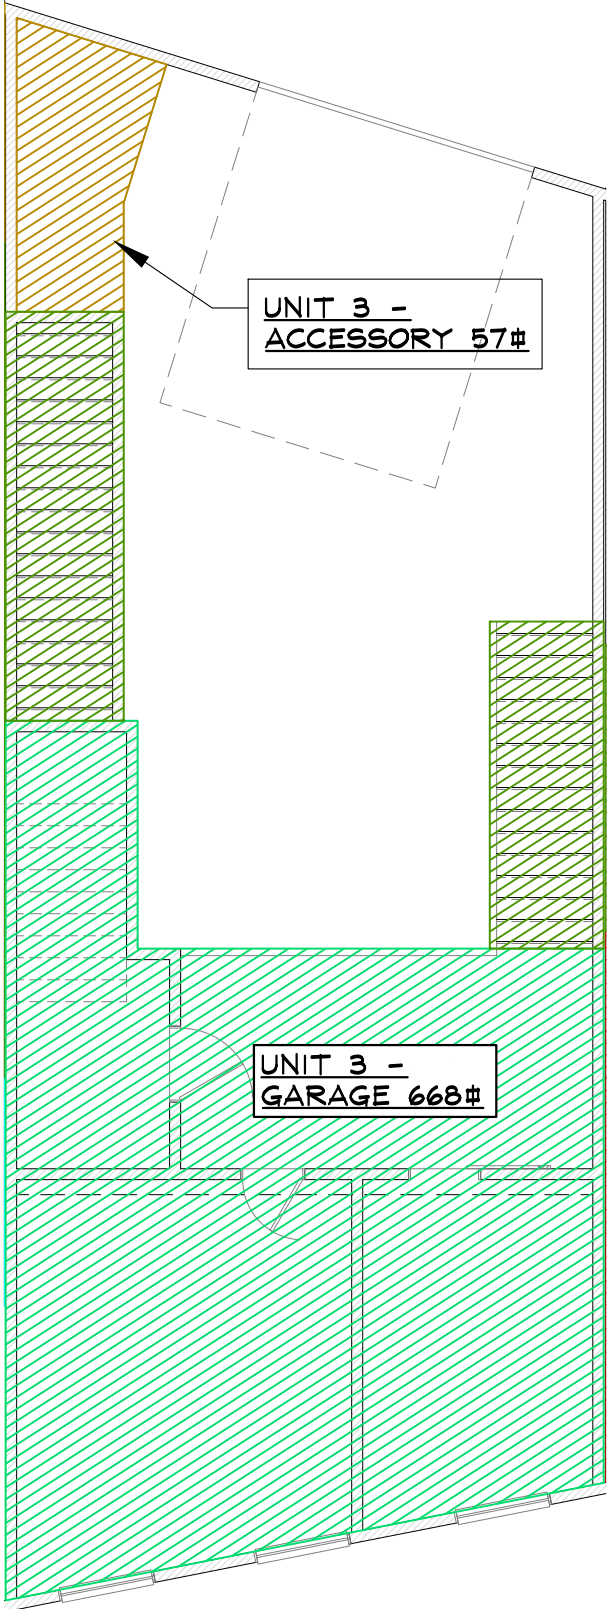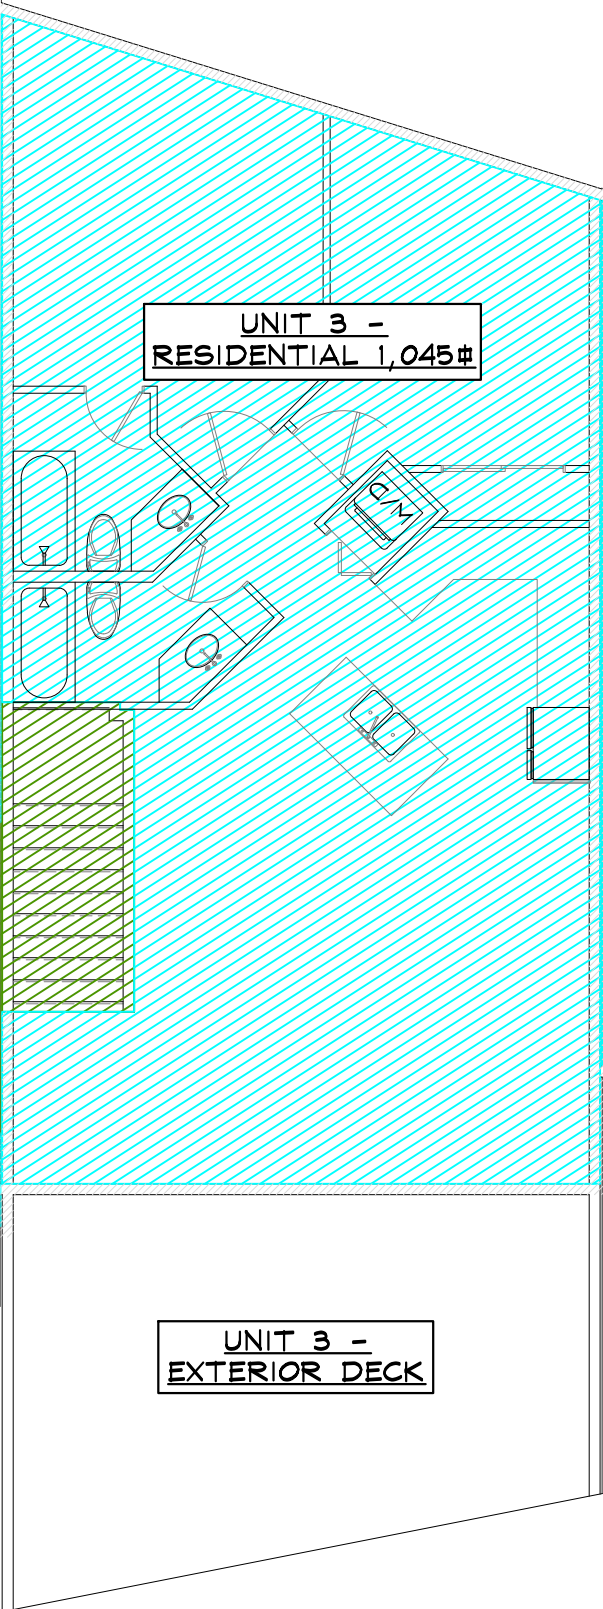

6 1ST LEVEL FLOOR PLAN - USE SHADING
SCALE: 1/8" = 1'-0"

4 2ND LEVEL FLOOR PLAN - USE SHADING
SCALE: 1/8" = 1'-0"

2 1ST LEVEL FLOOR PLAN - USE SHADING
SCALE: 1/8" = 1'-0"

NOT FOR
CONSTRUCTION



RFP BUILDING 3 TENANT FINISH
1900 BRIDGE LANE
STEAMBOAT SPRINGS, COLORADO
A TENANT FINISH FOR:
RIVER FRONT PARK HOA

ISSUE DATES

02 . 07 . 24 REVIEW
02 . 04 . 24 DP

DRAWN BY: RPM
REVIEWED BY: CWM
PROJECT # 21099

UNIT 3 PROPOSED
FLOOR PLANS

UNIT 3

SIGNATURE FOR PROPOSED USE DRAWINGS
FOR DEVELOPMENT PERMIT

OWNER
Rod Wells

UNIT 4, RIVERFRONT PARK, FILING 2
2/16/2024

ARCHITECT
(ROD COY WELLS)




2/16/2024

DATE

2/16/2024

DATE

2/16/2024

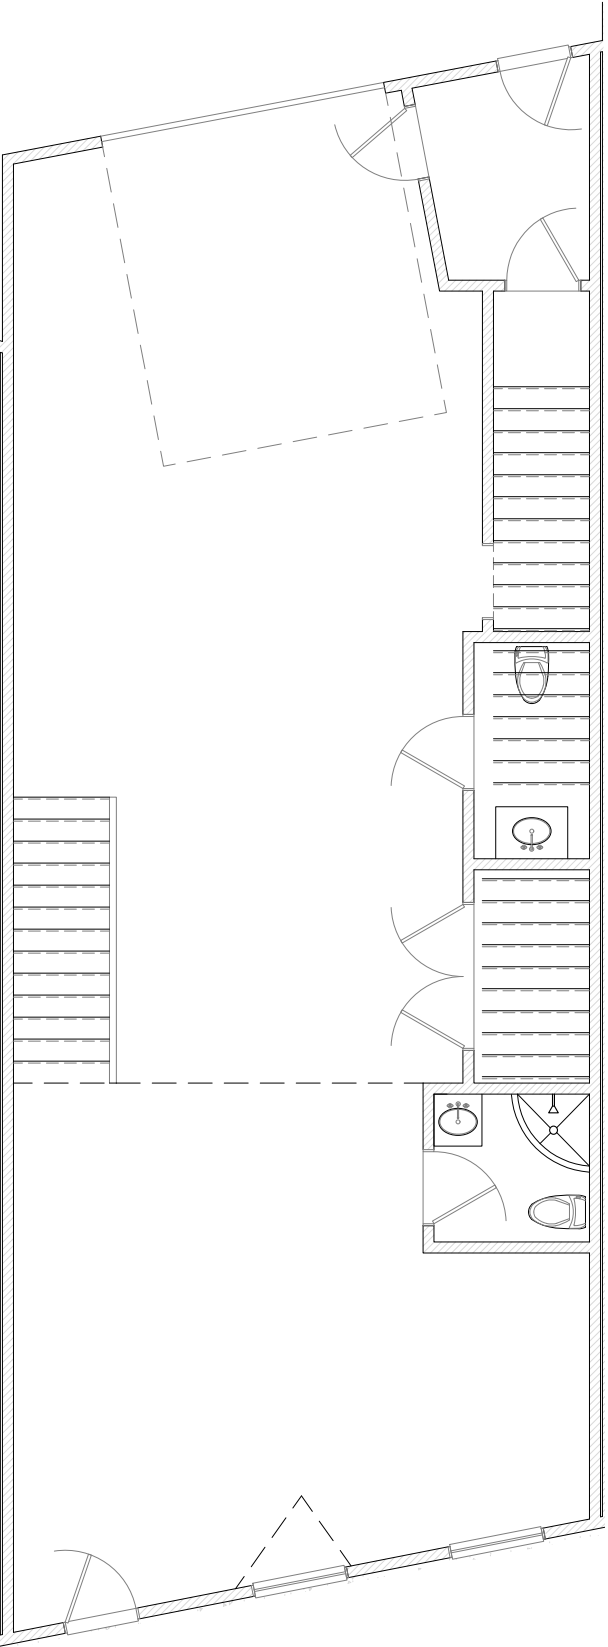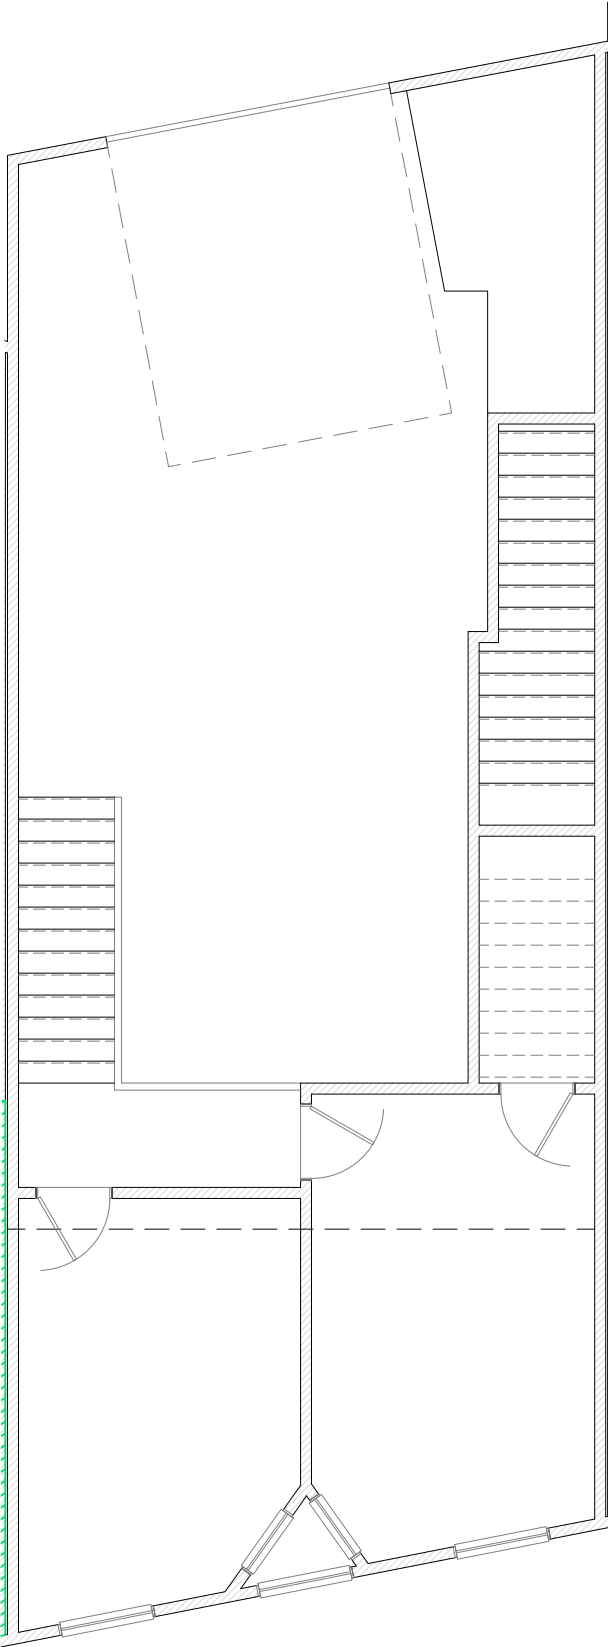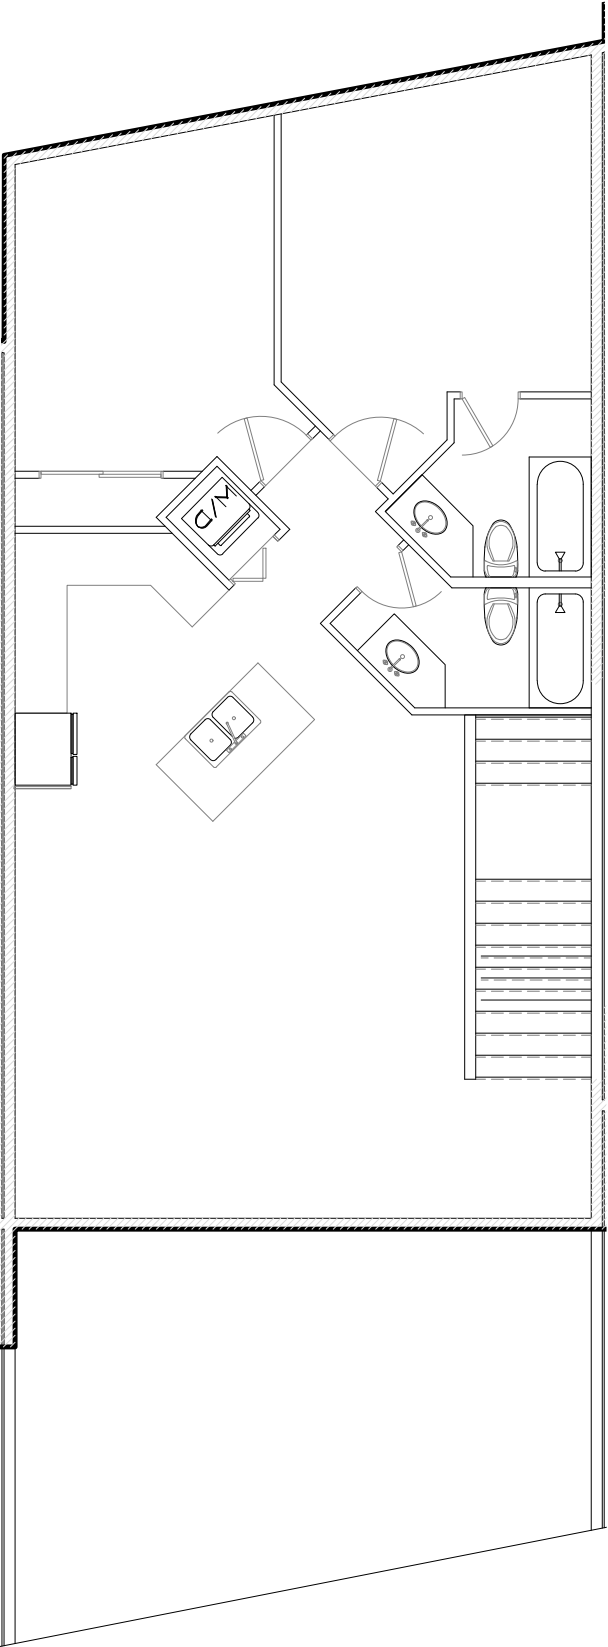




5 3RD LEVEL FLOOR PLAN - NO SHADING
SCALE: 1/8" = 1'-0"

3 2ND LEVEL FLOOR PLAN - NO SHADING
SCALE: 1/8" = 1'-0"

1 1ST LEVEL FLOOR PLAN - NO SHADING
SCALE: 1/8" = 1'-0"

SHADING KEY	
	PROPOSED PRIVATE STORAGE USE
	PROPOSED OFFICE USE
	PROPOSED ACCESSORY USE
	PROPOSED RESIDENTIAL USE
	PROPOSED WAREHOUSE USE
	STAIRWELL

Unit 4	Level 1	Residential	1378
Unit 4	Level 2	Accessory	95
	Level 2	Residential	558
Unit 4	Level 3	Residential	1060

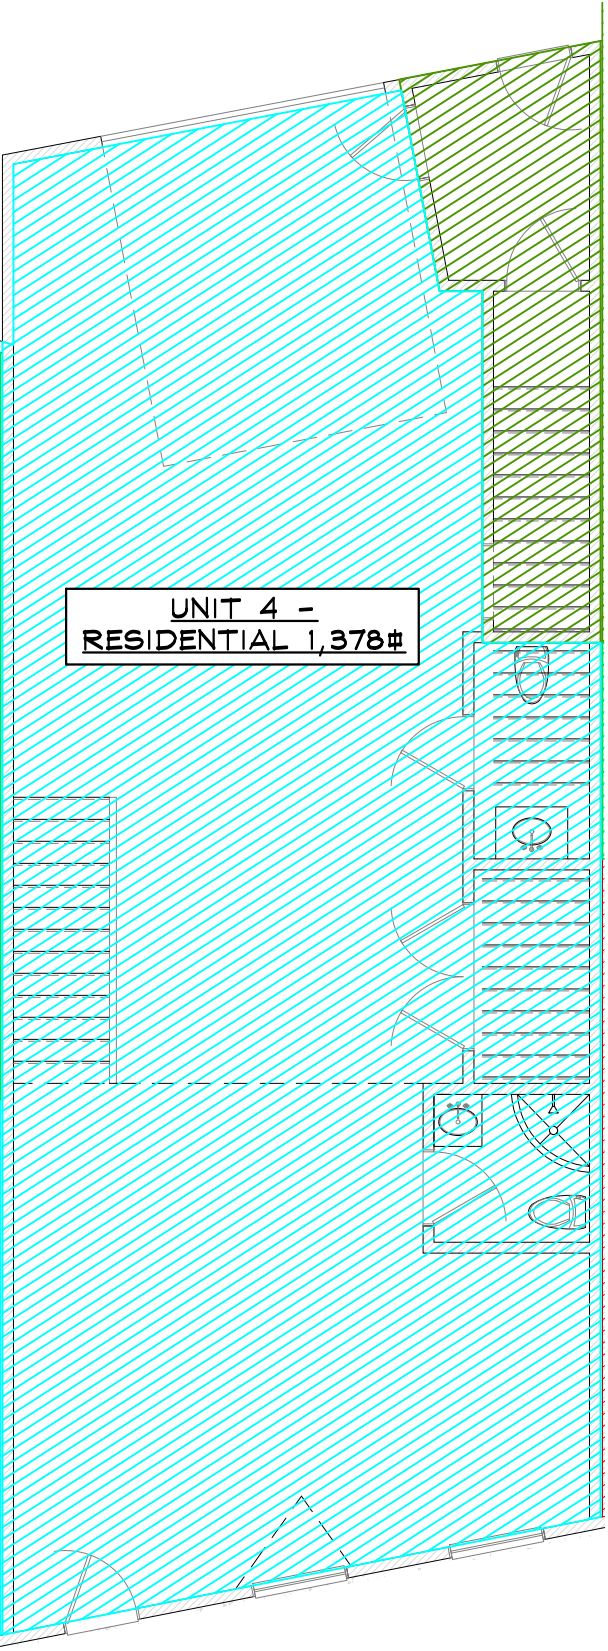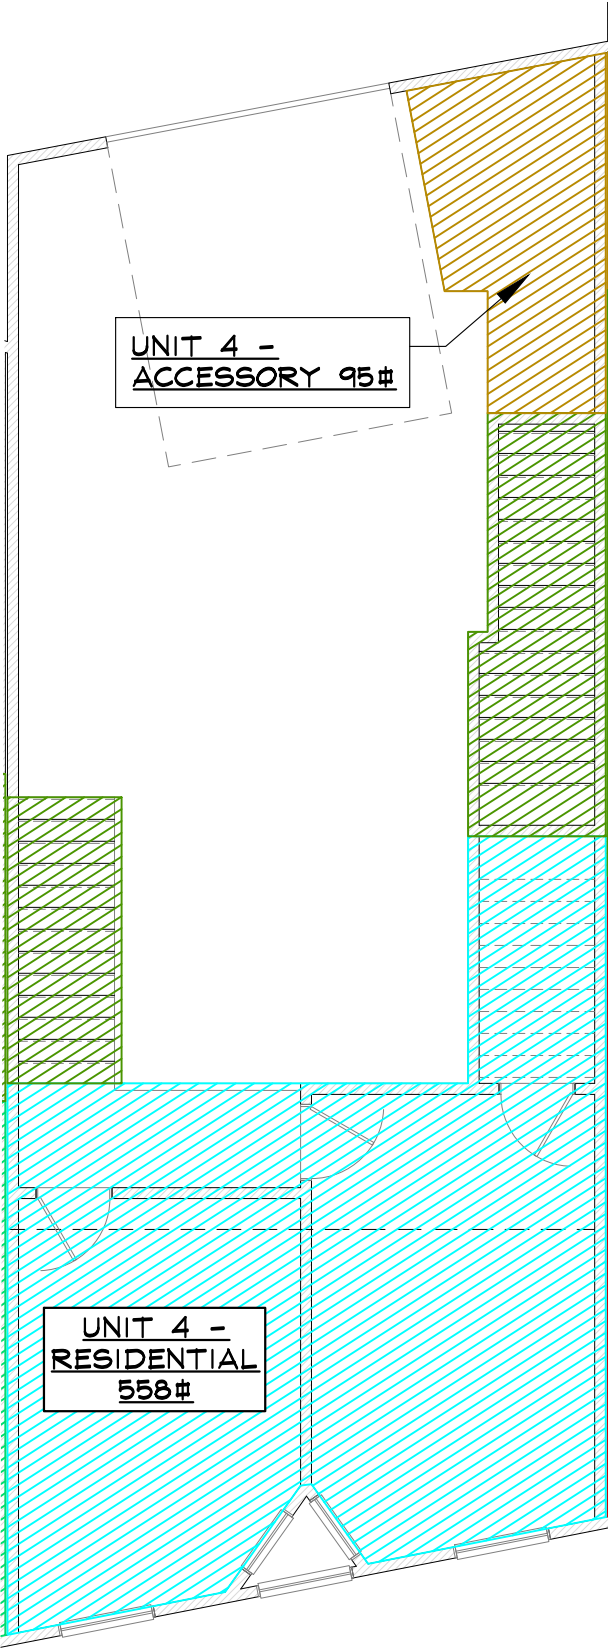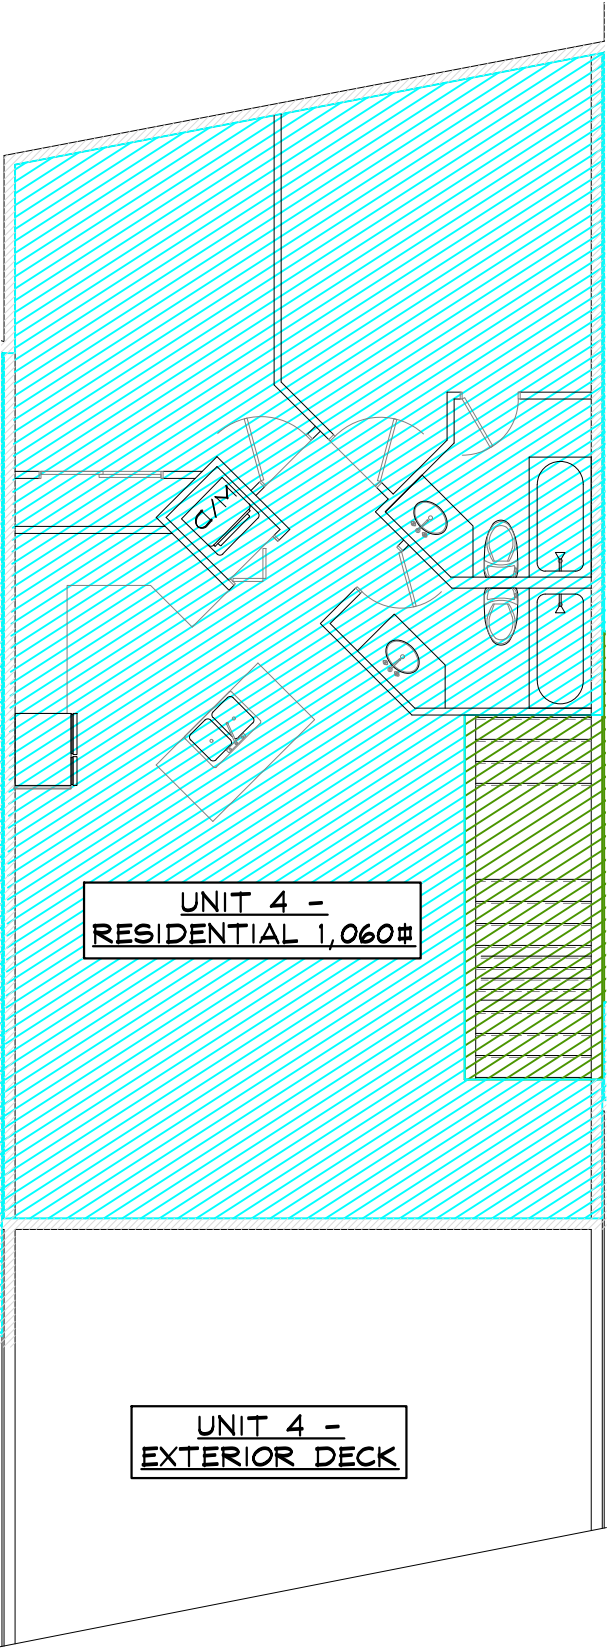

6 1ST LEVEL FLOOR PLAN - USE SHADING
SCALE: 1/8" = 1'-0"

4 2ND LEVEL FLOOR PLAN - USE SHADING
SCALE: 1/8" = 1'-0"

2 1ST LEVEL FLOOR PLAN - USE SHADING
SCALE: 1/8" = 1'-0"

NOT FOR
CONSTRUCTION



RFP BUILDING 3 TENANT FINISH
1900 BRIDGE LANE
STEAMBOAT SPRINGS, COLORADO
A TENANT FINISH FOR:
RIVER FRONT PARK HOA

ISSUE DATES

02 . 07 . 24
02 . 04 . 24

REVIEW
DP

DRAWN BY: RPM
REVIEWED BY: CWM
PROJECT # 21099

UNIT 4 PROPOSED
FLOOR PLANS

UNIT 4

SIGNATURE FOR PROPOSED USE DRAWINGS
FOR DEVELOPMENT PERMIT

OWNER: UNIT 5, RIVERFRONT PARK, FILING 2
FW PROPERTIES, LLC




BY: Dianne Fox-Welch
(SIGNATURE)

Dianne Fox-Welch

(PRINT NAME)

ITS: Owner

DATE: 2/16/2024

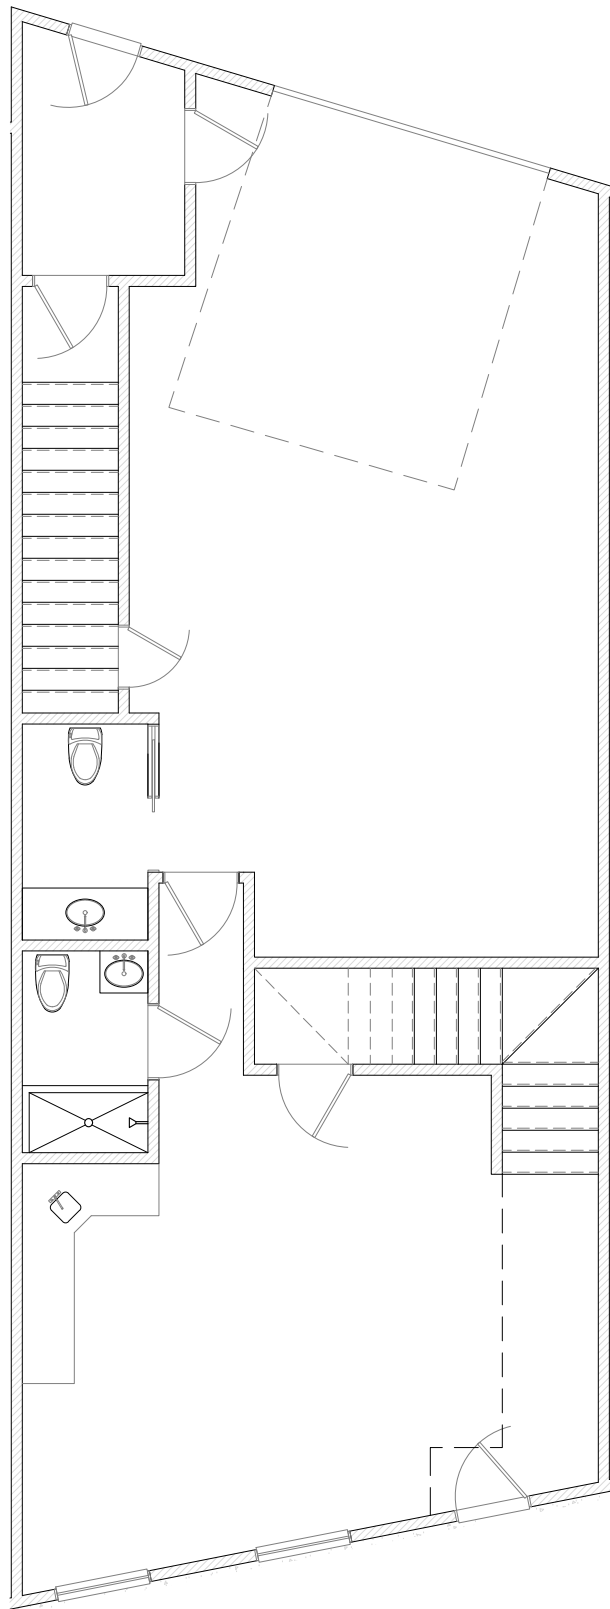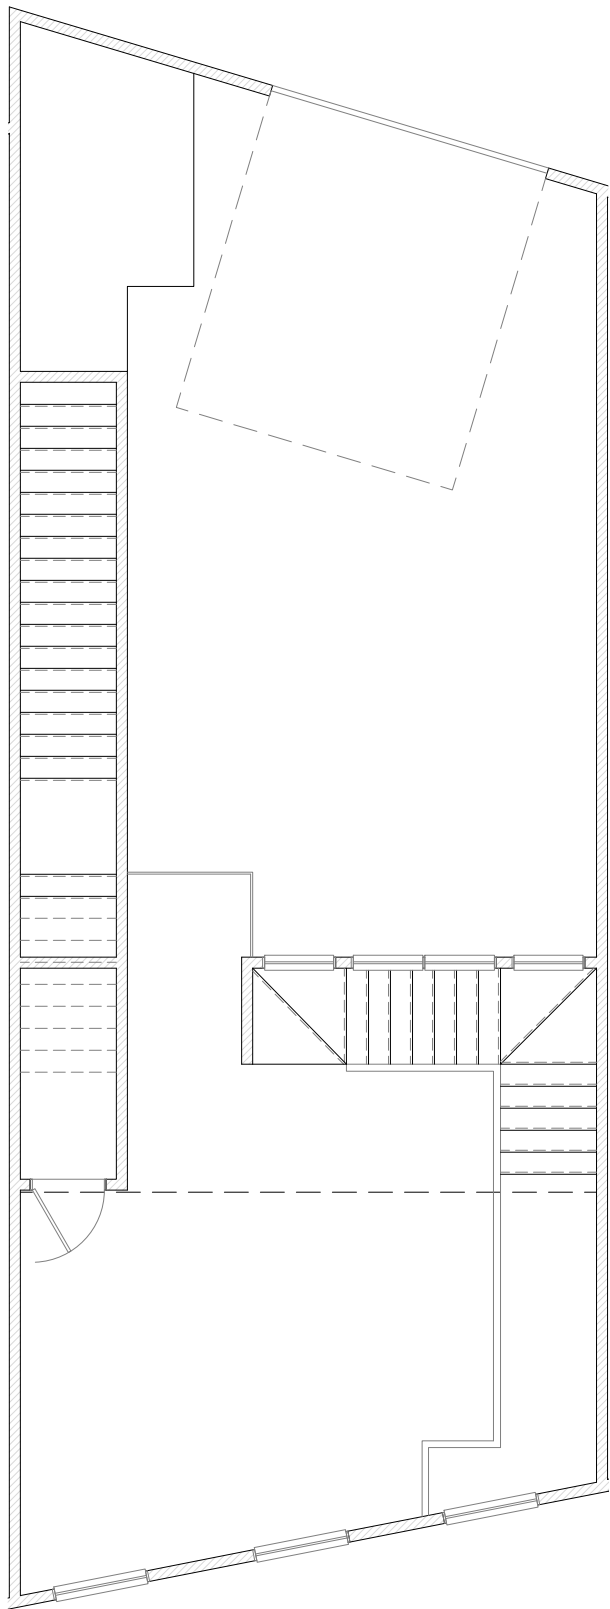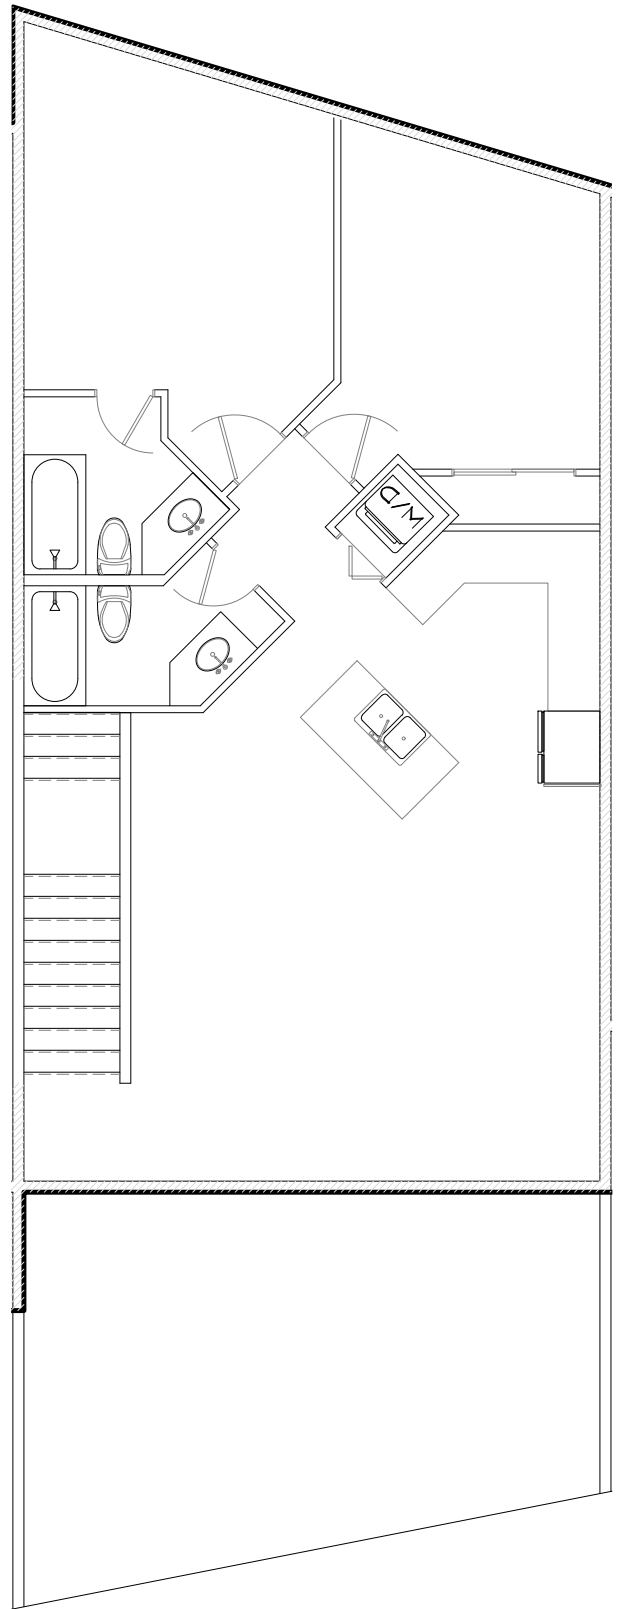




5 3RD LEVEL FLOOR PLAN - NO SHADING
SCALE: 1/8" = 1'-0"

3 2ND LEVEL FLOOR PLAN - NO SHADING
SCALE: 1/8" = 1'-0"

1 1ST LEVEL FLOOR PLAN - NO SHADING
SCALE: 1/8" = 1'-0"

SHADING KEY	
	PROPOSED PRIVATE STORAGE USE
	PROPOSED OFFICE USE
	PROPOSED ACCESSORY USE
	PROPOSED RESIDENTIAL USE
	PROPOSED WAREHOUSE USE
	STAIRWELL

Unit 5	Level 1	Garage	696
	Level 1	Office	624
Unit 5	Level 2	Accessory	93
	Level 2	Office	466
Unit 5	Level 3	Residential	1036

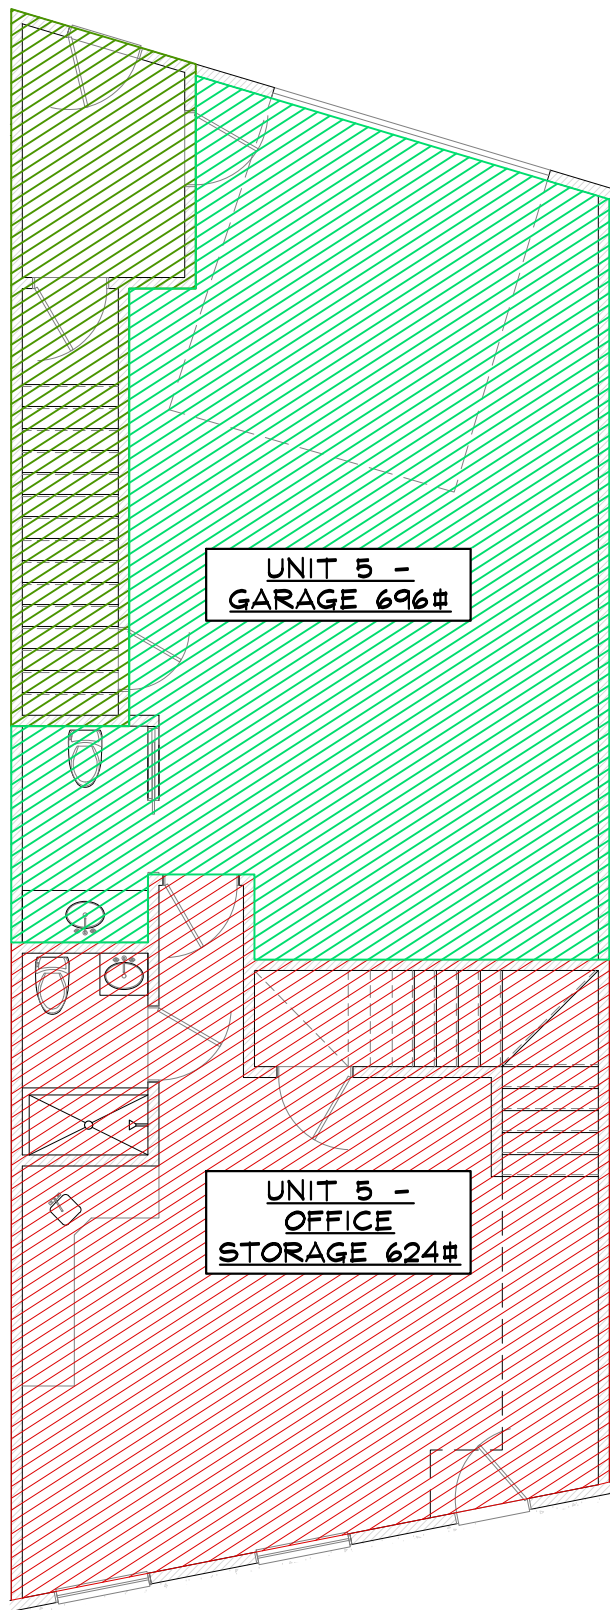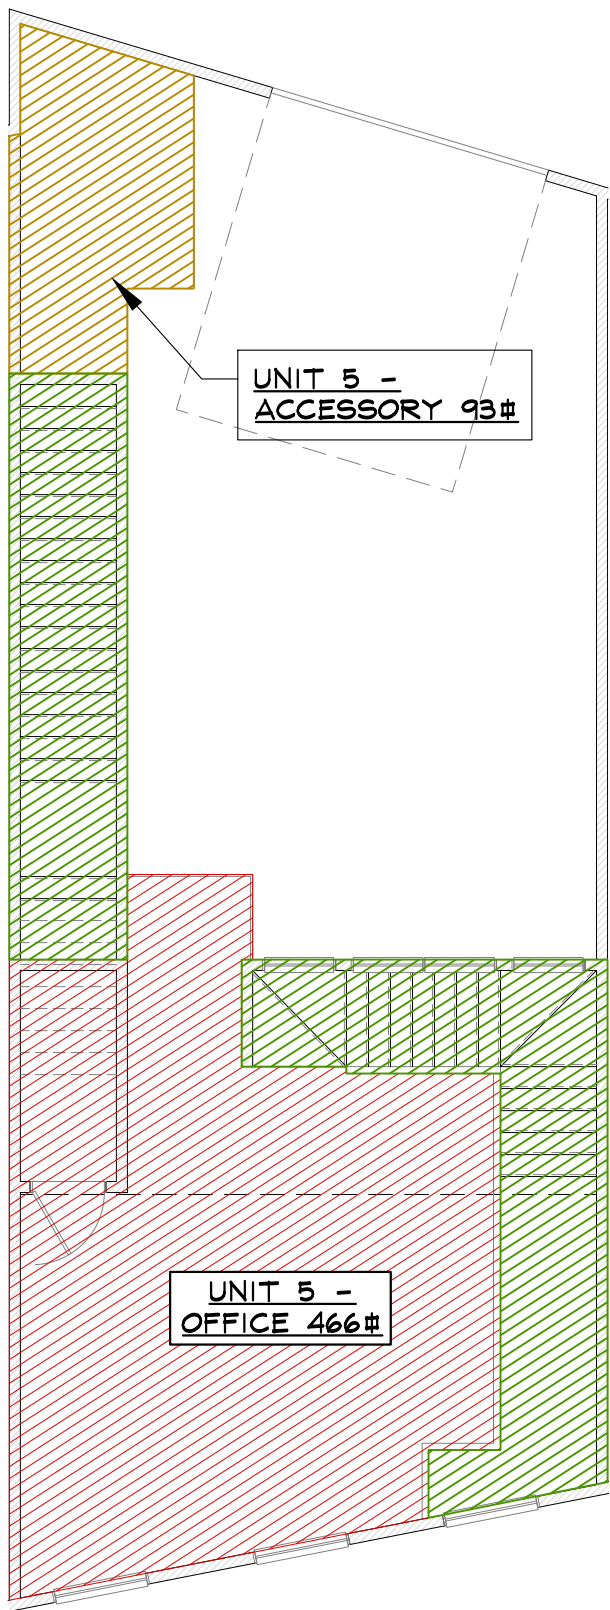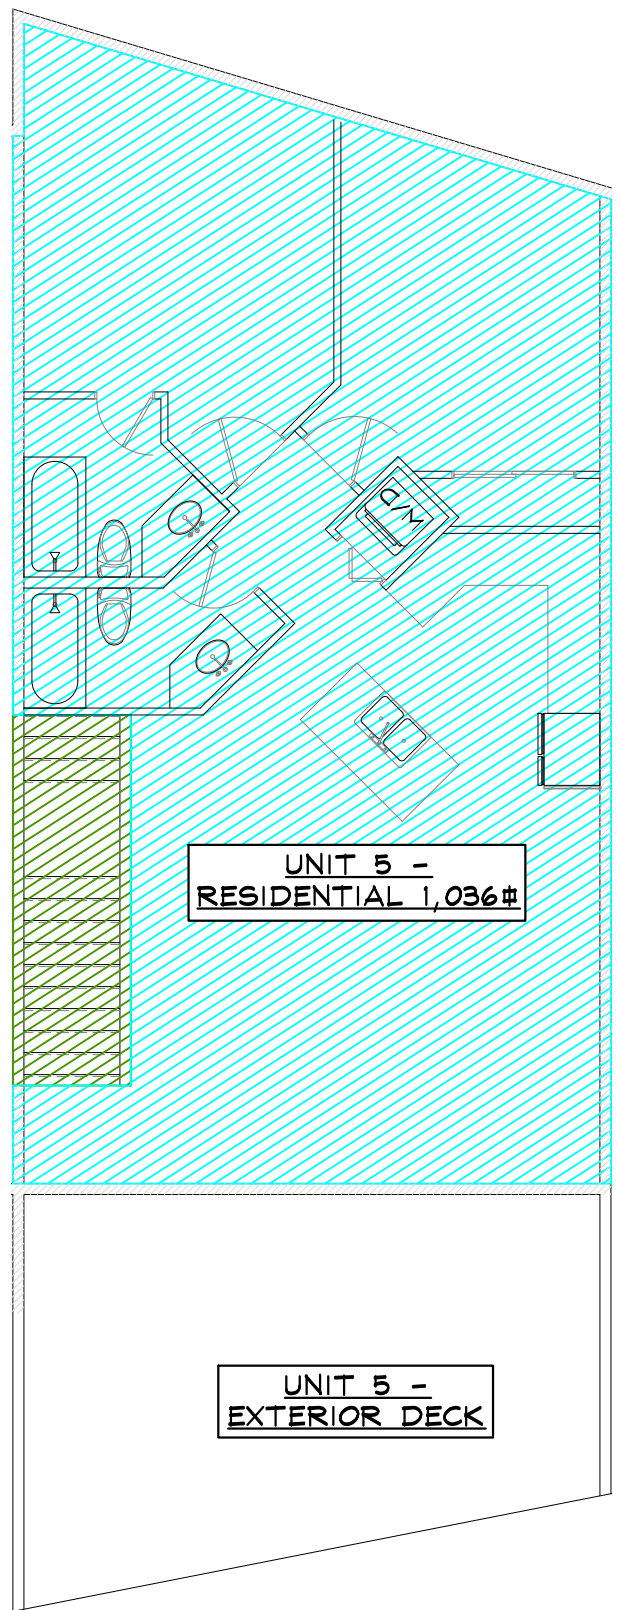

6 1ST LEVEL FLOOR PLAN - USE SHADING
SCALE: 1/8" = 1'-0"

4 2ND LEVEL FLOOR PLAN - USE SHADING
SCALE: 1/8" = 1'-0"

2 1ST LEVEL FLOOR PLAN - USE SHADING
SCALE: 1/8" = 1'-0"

NOT FOR
CONSTRUCTION



RFP BUILDING 3 TENANT FINISH
1900 BRIDGE LANE
STEAMBOAT SPRINGS, COLORADO
A TENANT FINISH FOR:
RIVER FRONT PARK HOA

ISSUE DATES

02 . 07 . 24 REVIEW
02 . 04 . 24 DP


DRAWN BY: RPM
REVIEWED BY: CWM
PROJECT # 21099

UNIT 5 PROPOSED
FLOOR PLANS

UNIT 5

SIGNATURE FOR PROPOSED USE DRAWINGS
FOR DEVELOPMENT PERMIT

OWNER: UNIT 6, RIVERFRONT PARK, FILING 2

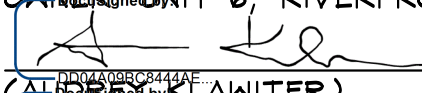
(AUDREY KLAWITER)

2/20/2024




(DATE)

2/20/2024

(DATE)

(CAMERON KLAWITER)

(DATE)

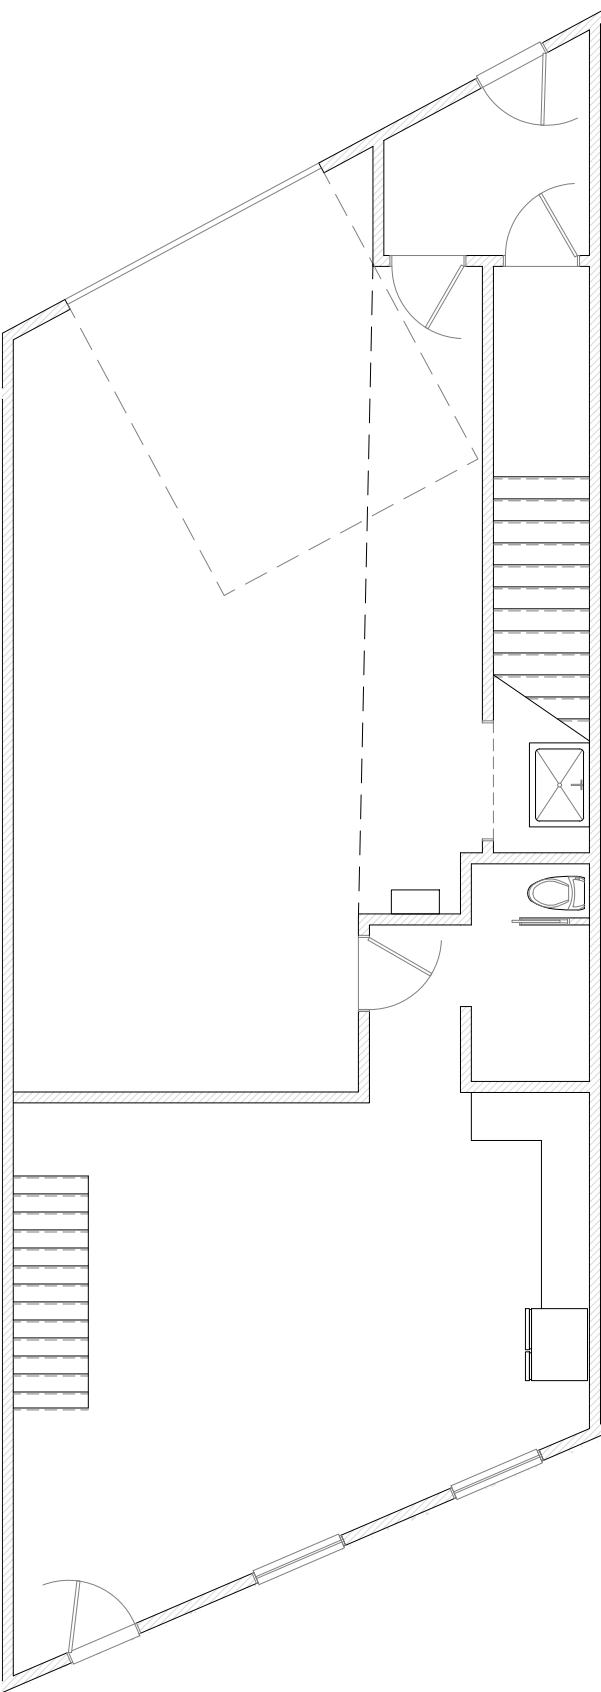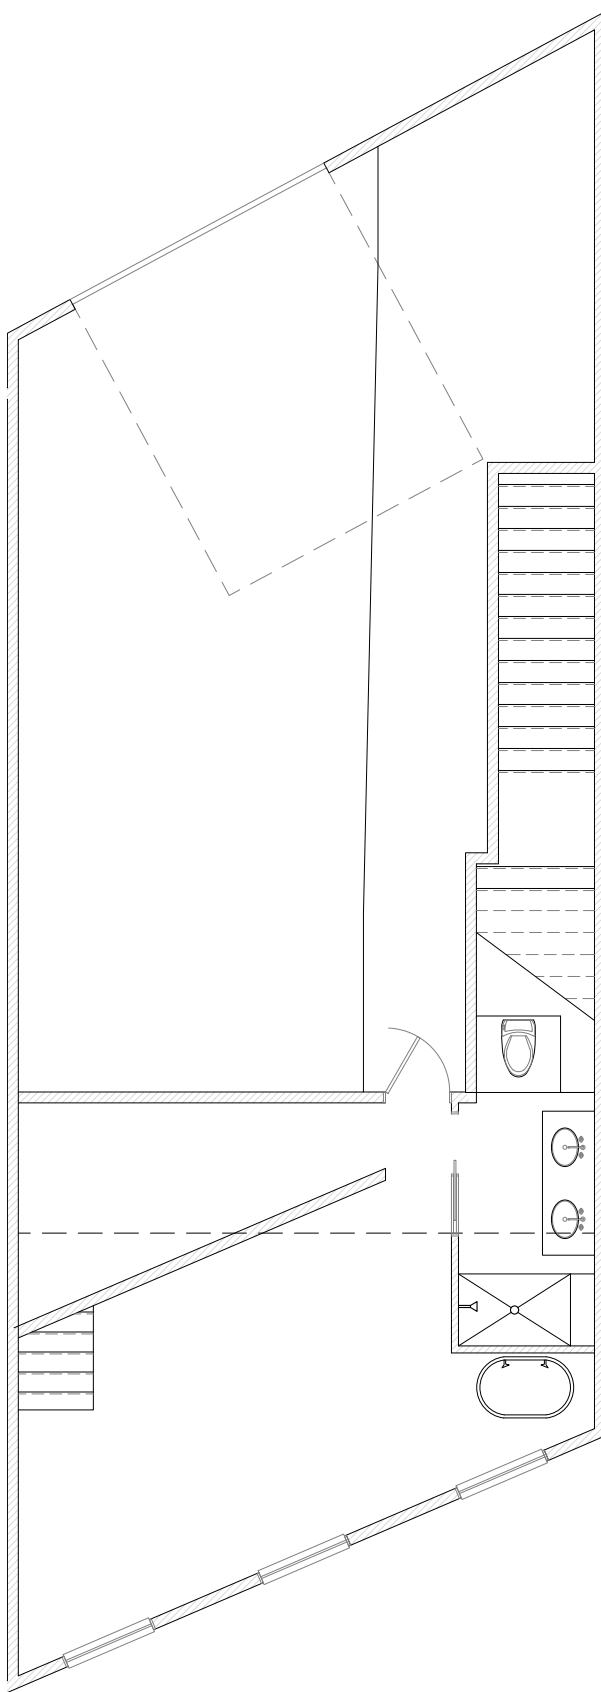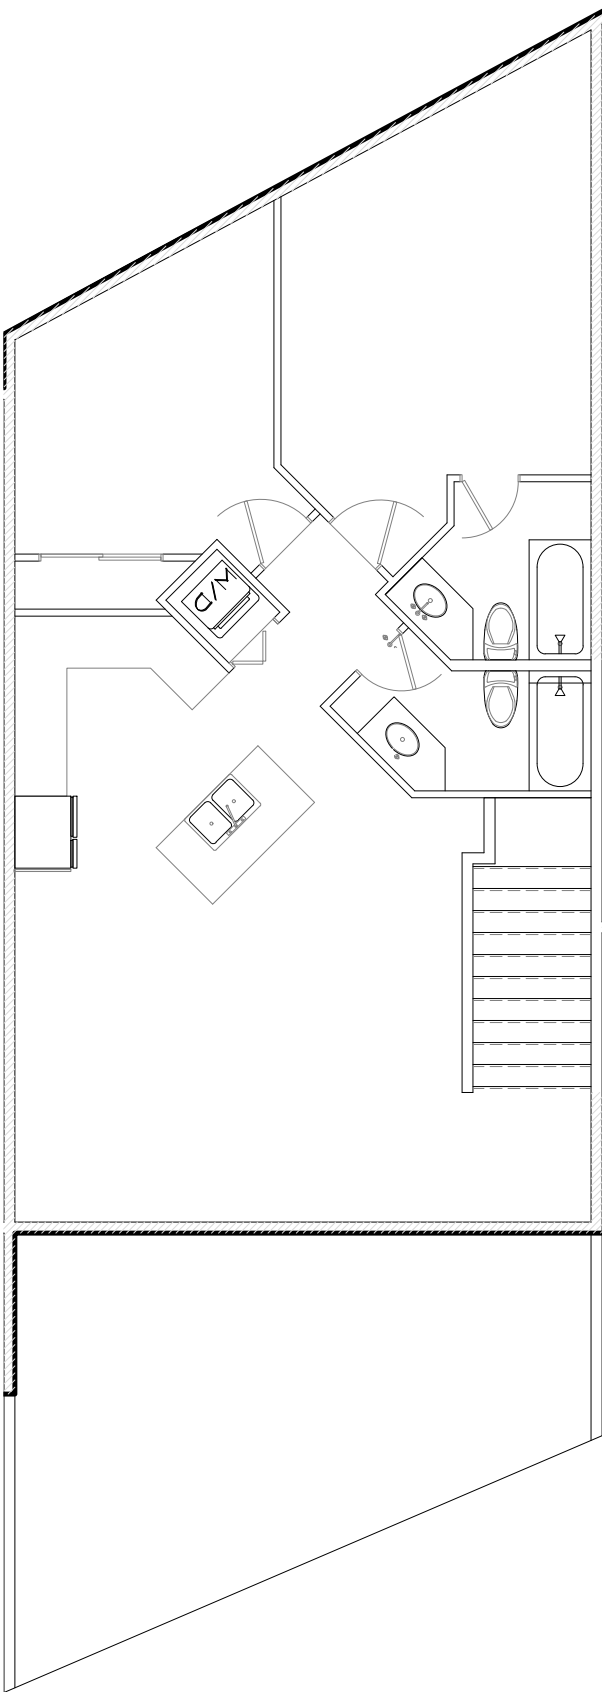




5 3RD LEVEL FLOOR PLAN - NO SHADING
SCALE: 1/8" = 1'-0"

3 2ND LEVEL FLOOR PLAN - NO SHADING
SCALE: 1/8" = 1'-0"

1 1ST LEVEL FLOOR PLAN - NO SHADING
SCALE: 1/8" = 1'-0"

SHADING KEY	
	PROPOSED PRIVATE STORAGE USE
	PROPOSED OFFICE USE
	PROPOSED ACCESSORY USE
	PROPOSED RESIDENTIAL USE
	PROPOSED WAREHOUSE USE
	STAIRWELL

Unit 6	Level 1	Garage	660
	Level 1	Residential	568
Unit 6	Level 2	Accessory	272
	Level 2	Residential	496
Unit 6	Level 3	Residential	1006

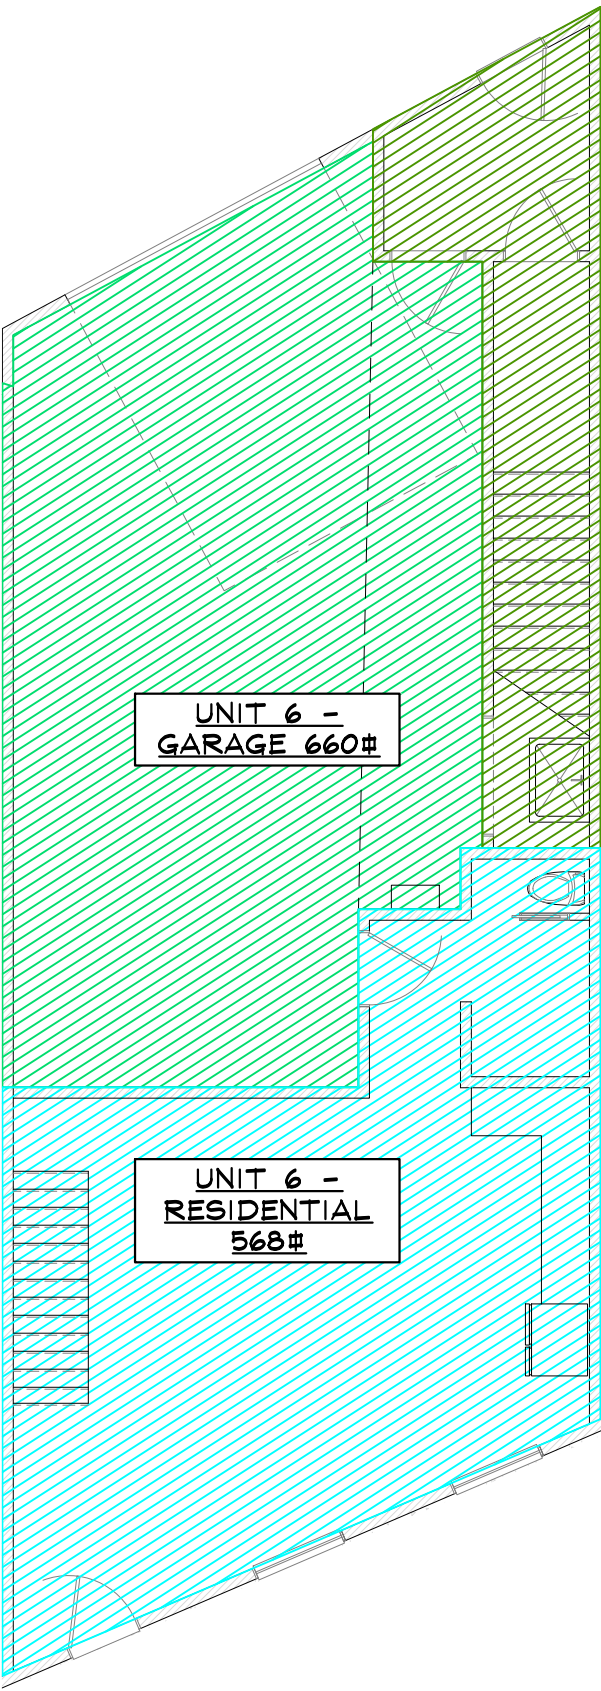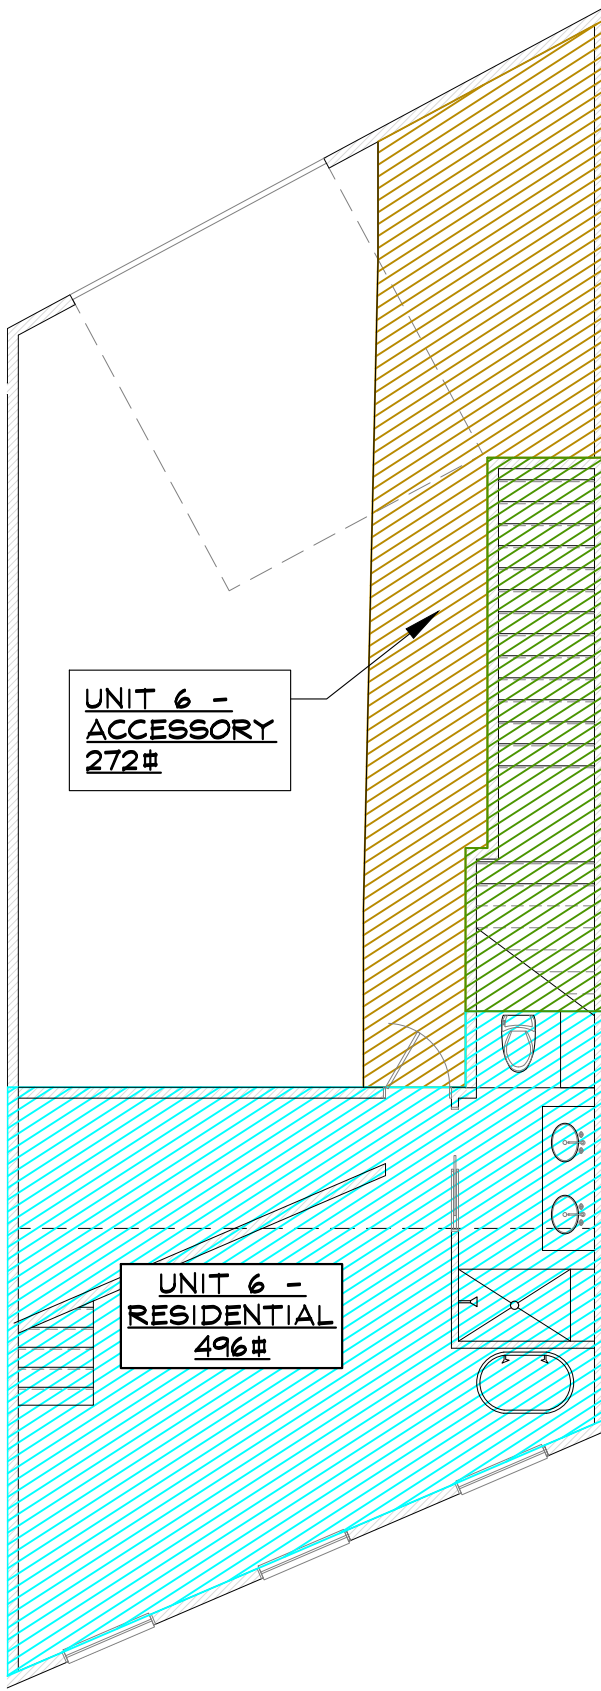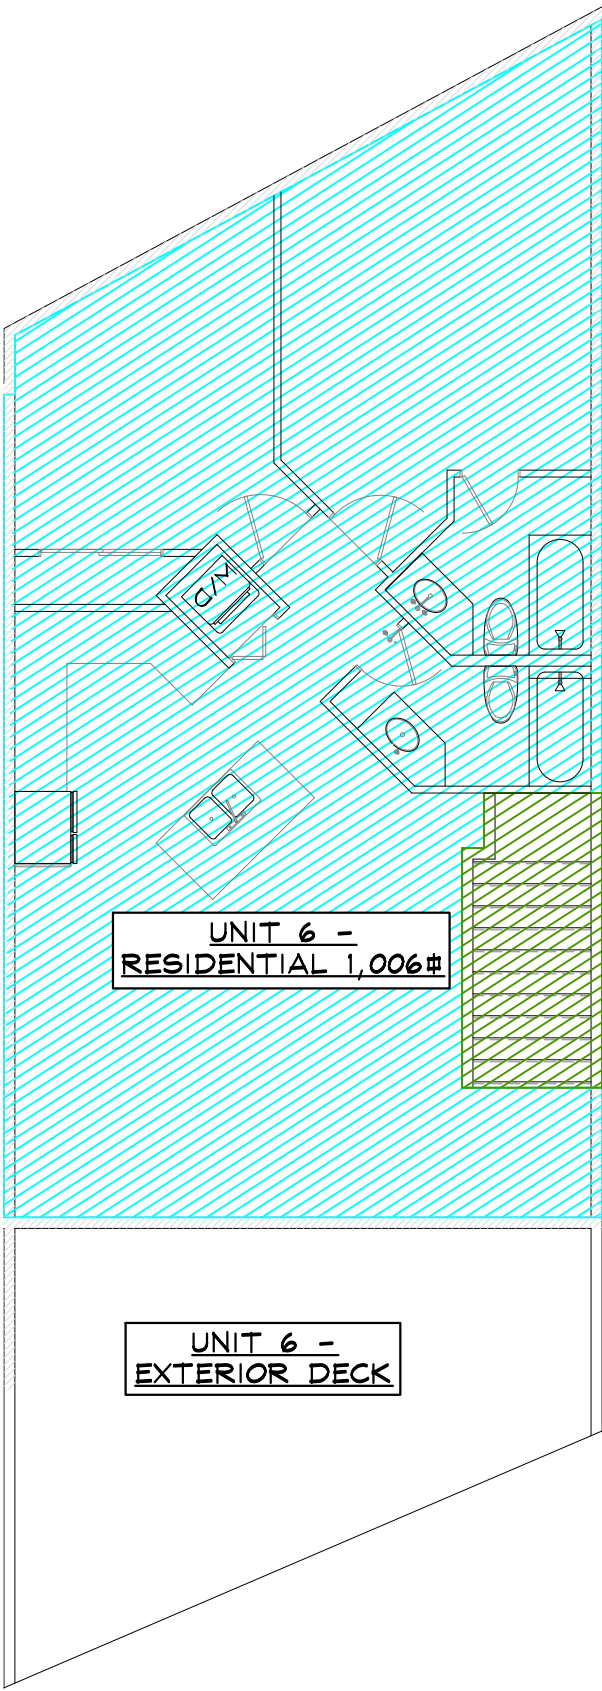

6 1ST LEVEL FLOOR PLAN - USE SHADING
SCALE: 1/8" = 1'-0"

4 2ND LEVEL FLOOR PLAN - USE SHADING
SCALE: 1/8" = 1'-0"

2 1ST LEVEL FLOOR PLAN - USE SHADING
SCALE: 1/8" = 1'-0"

NOT FOR
CONSTRUCTION



STEAMBOAT ENGINEERING AND DESIGN, INC.
2740 Acre Lane Suite 'E' Steamboat Springs, CO 80487
Phone: 970 . 871 . 9101 Fax: 970 . 871 . 9089
E-mail: Jake@seadinc.com

RFP BUILDING 3 TENANT FINISH
1900 BRIDGE LANE
STEAMBOAT SPRINGS, COLORADO
A TENANT FINISH FOR:
RIVER FRONT PARK HOA

ISSUE DATES	
02 . 07 . 24	REVIEW
02 . 04 . 24	DP


DRAWN BY: RPM
REVIEWED BY: CWM
PROJECT # 21099

UNIT 6 PROPOSED
FLOOR PLANS




UNIT 6

SIGNATURE FOR PROPOSED USE DRAWINGS
FOR DEVELOPMENT PERMIT

OWNER: UNIT 7, RIVERFRONT PARK, FILING 2
1900 BRIDGE LANE, LLC

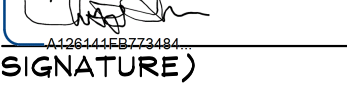BY:  Christy Spencer
(SIGNATURE) (PRINT NAME)

ITS: Owner DATE: 2/12/2024

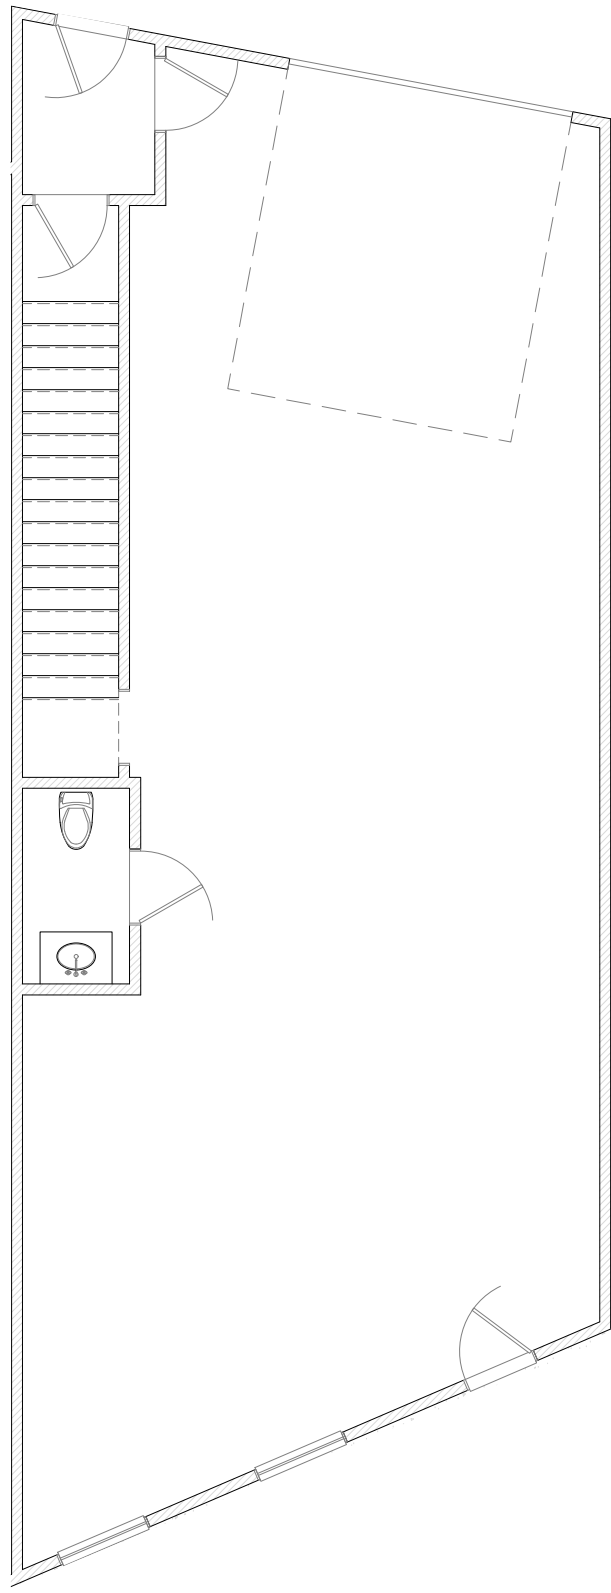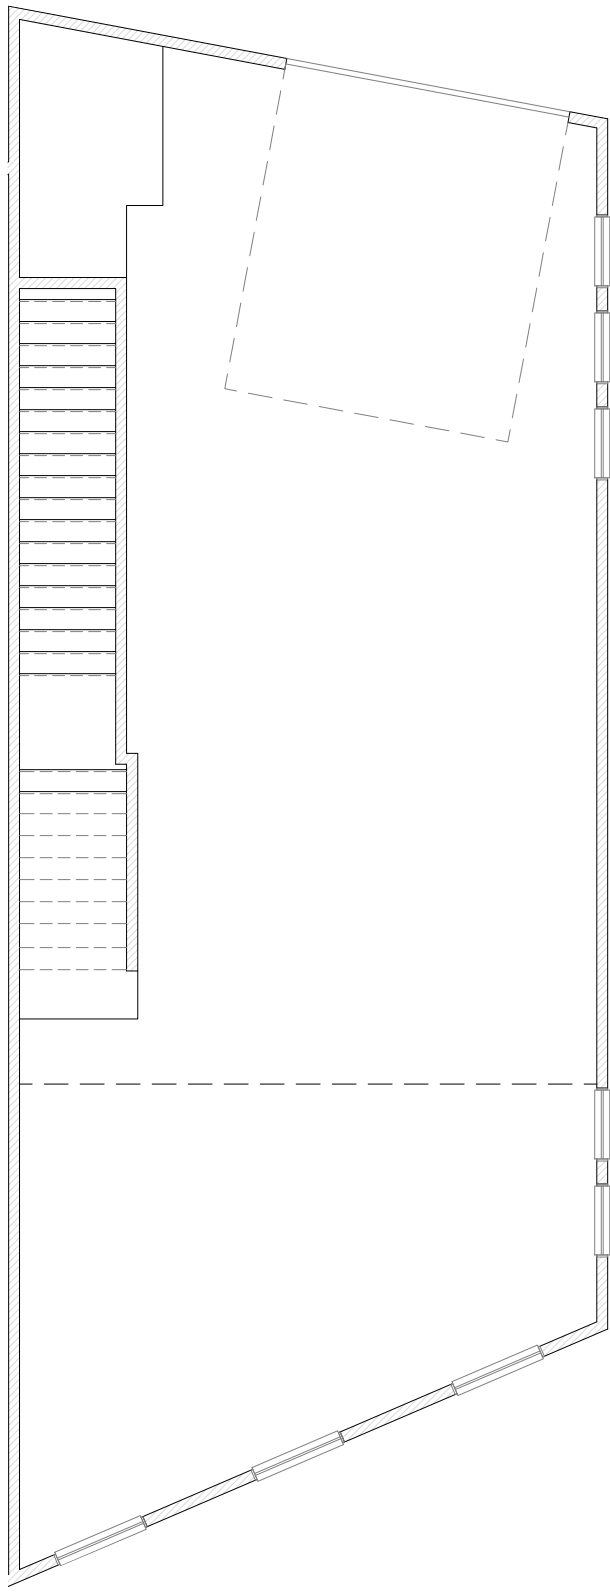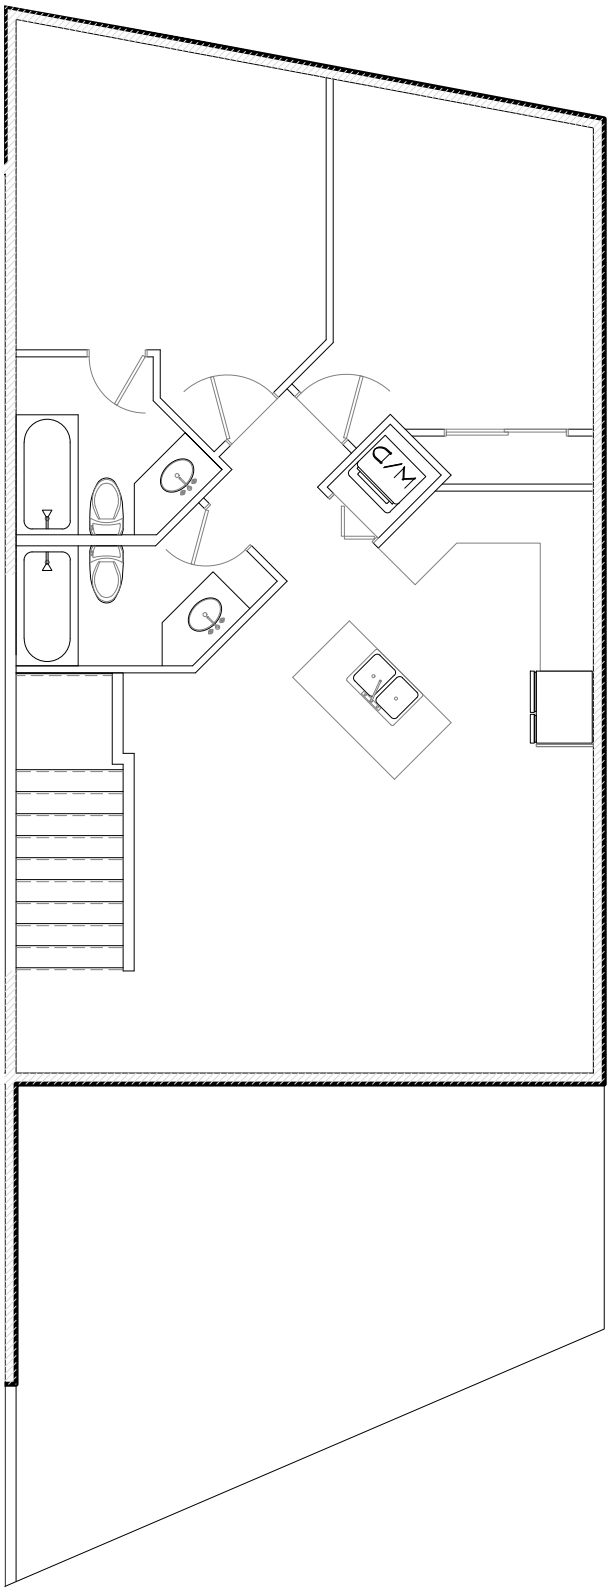




5 3RD LEVEL FLOOR PLAN - NO SHADING
SCALE: 1/8" = 1'-0"

3 2ND LEVEL FLOOR PLAN - NO SHADING
SCALE: 1/8" = 1'-0"

1 1ST LEVEL FLOOR PLAN - NO SHADING
SCALE: 1/8" = 1'-0"

SHADING KEY	
	PROPOSED PRIVATE STORAGE USE
	PROPOSED OFFICE USE
	PROPOSED ACCESSORY USE
	PROPOSED RESIDENTIAL USE
	PROPOSED WAREHOUSE USE
	STAIRWELL

Unit 7	Level 1	Garage	1238
Unit 7	Level 2	Accessory	58
Unit 7	Level 3	Residential	953

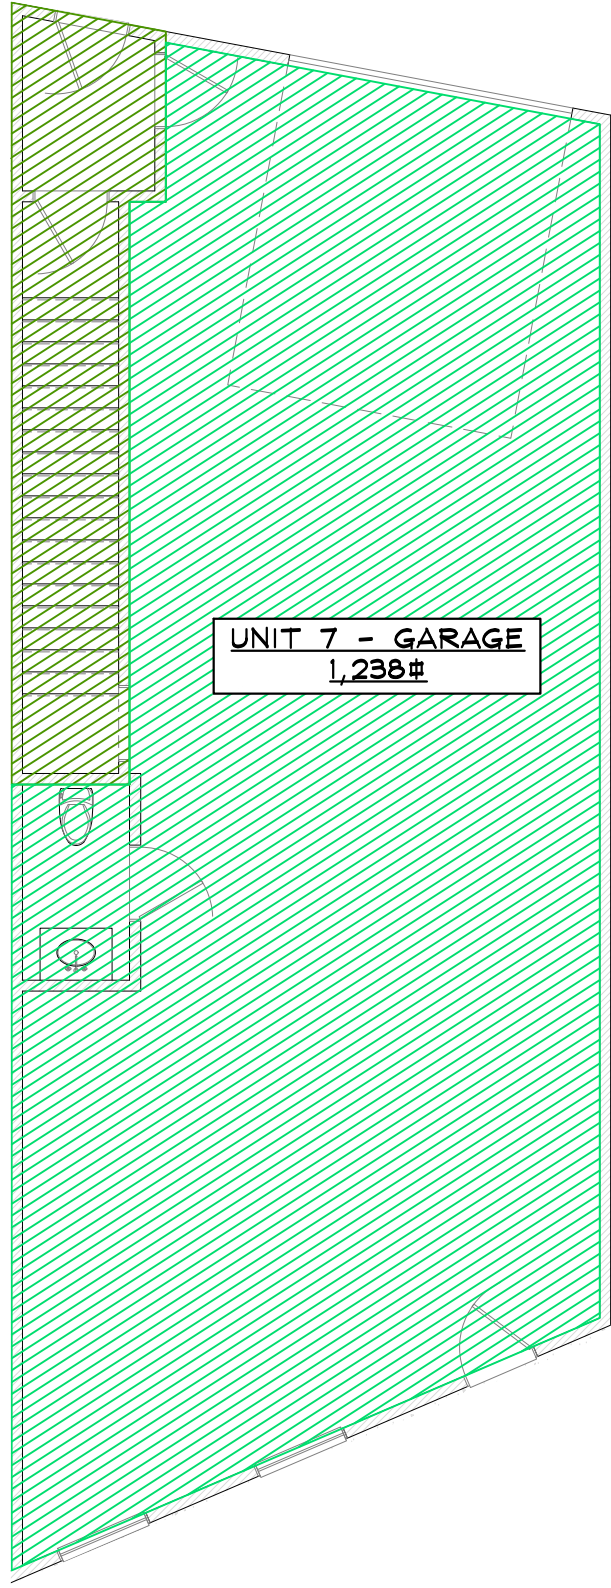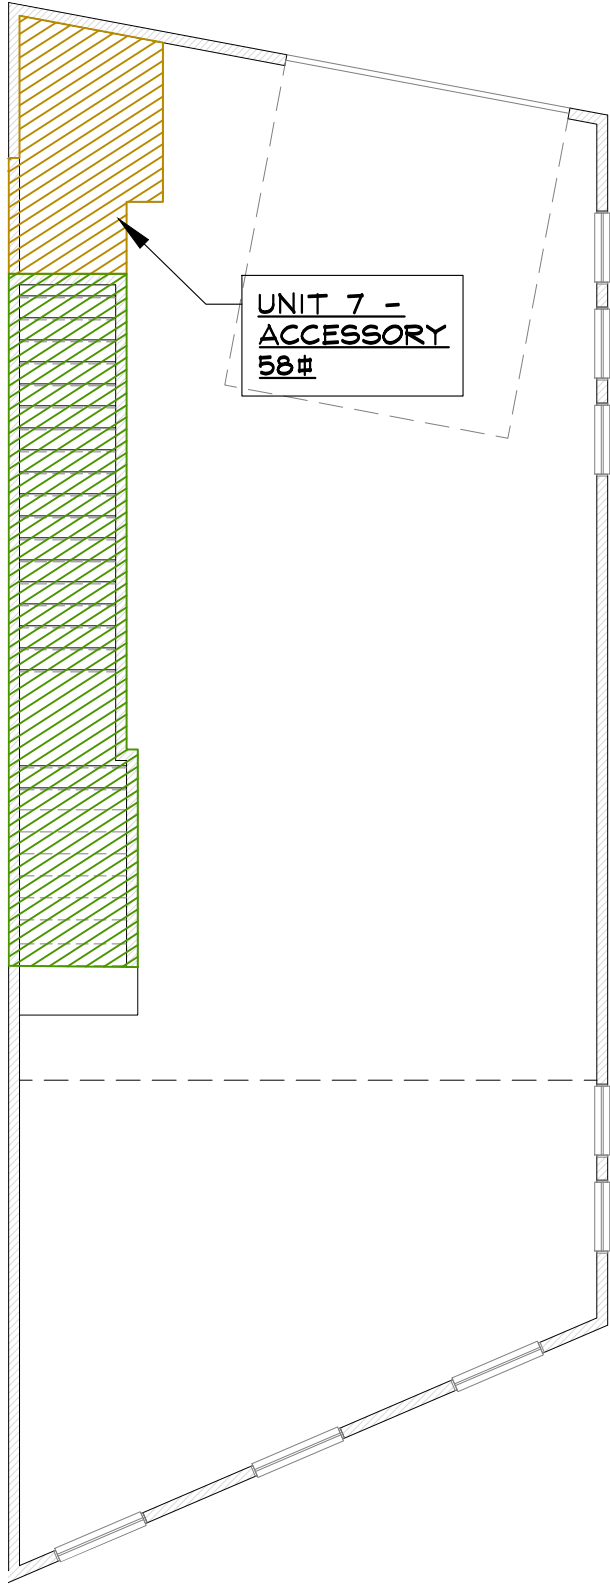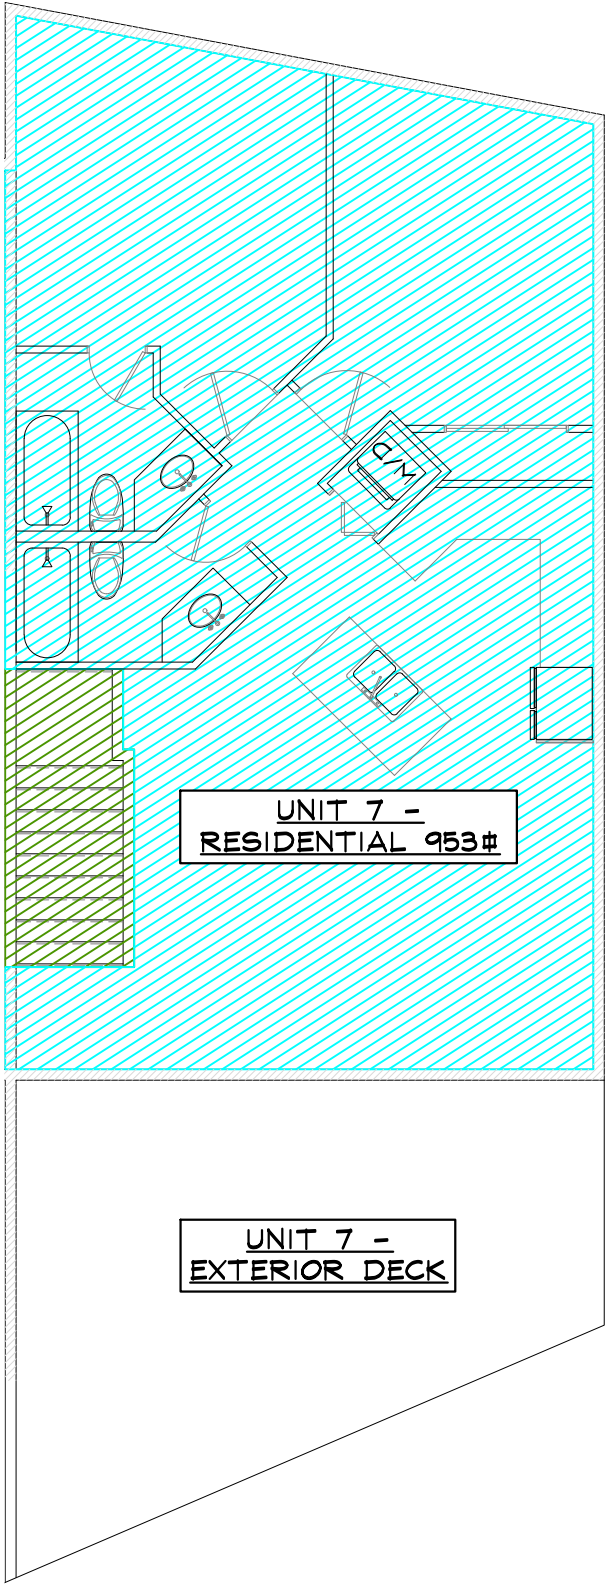

6 1ST LEVEL FLOOR PLAN - USE SHADING
SCALE: 1/8" = 1'-0"

4 2ND LEVEL FLOOR PLAN - USE SHADING
SCALE: 1/8" = 1'-0"

2 1ST LEVEL FLOOR PLAN - USE SHADING
SCALE: 1/8" = 1'-0"

NOT FOR
CONSTRUCTION



RFP BUILDING 3 TENANT FINISH
1900 BRIDGE LANE
STEAMBOAT SPRINGS, COLORADO
A TENANT FINISH FOR:
RIVER FRONT PARK HOA

ISSUE DATES

02 . 07 . 24 REVIEW
02 . 04 . 24 DP

DRAWN BY: RPM
REVIEWED BY: CWM
PROJECT # 21099

UNIT 7 PROPOSED
FLOOR PLANS

UNIT 7

SIGNATURE FOR PROPOSED USE DRAWINGS
FOR DEVELOPMENT PERMIT

OWNER: UNIT 8, RIVERFRONT PARK, FILING 1
LOWRY CAPITAL, LLC

BY: Theresa Lowry
(SIGNATURE)




Theresa Lowry

(PRINT NAME)

2/20/2024

ITS: Owner

DATE:

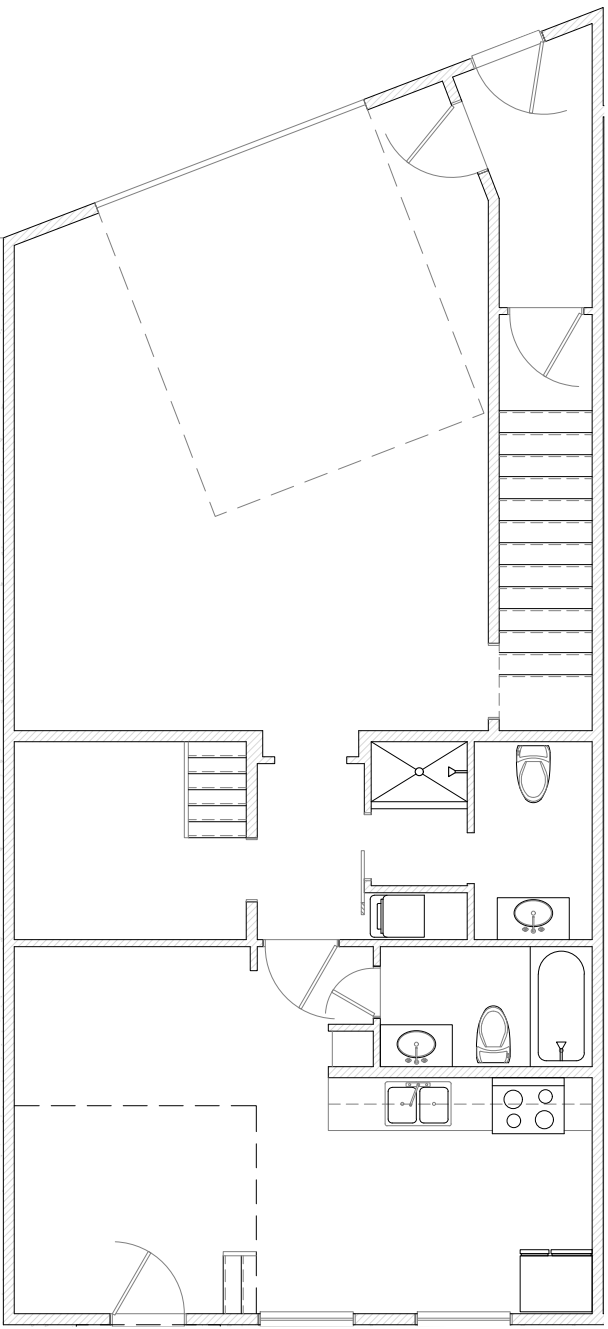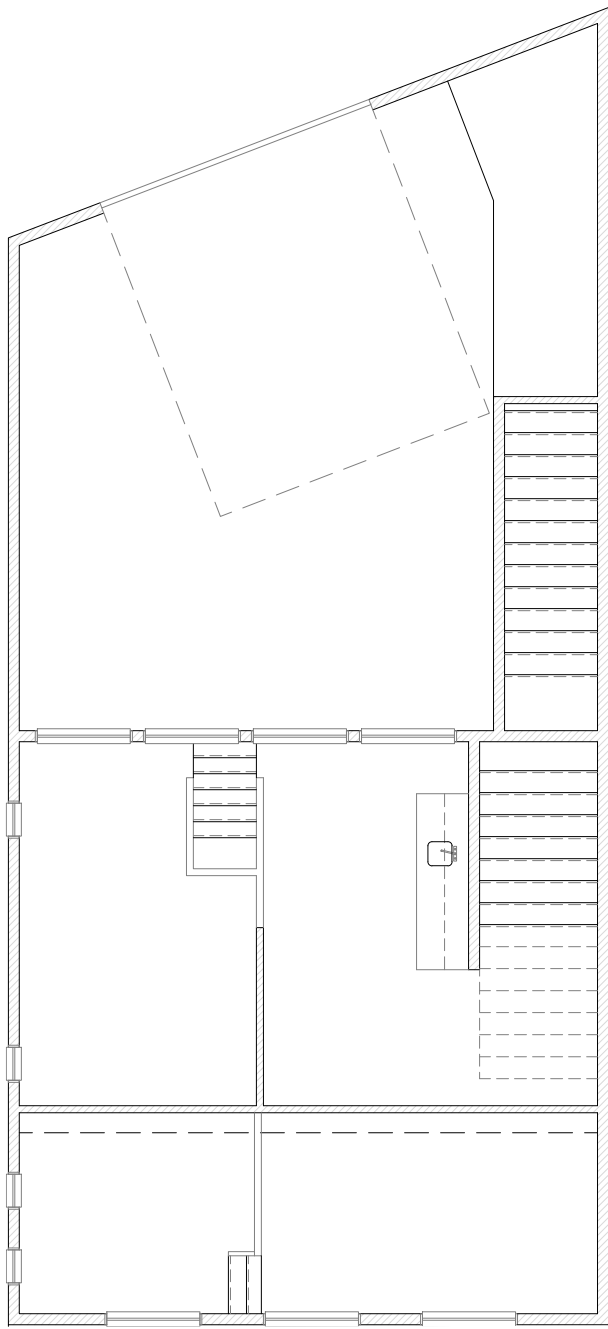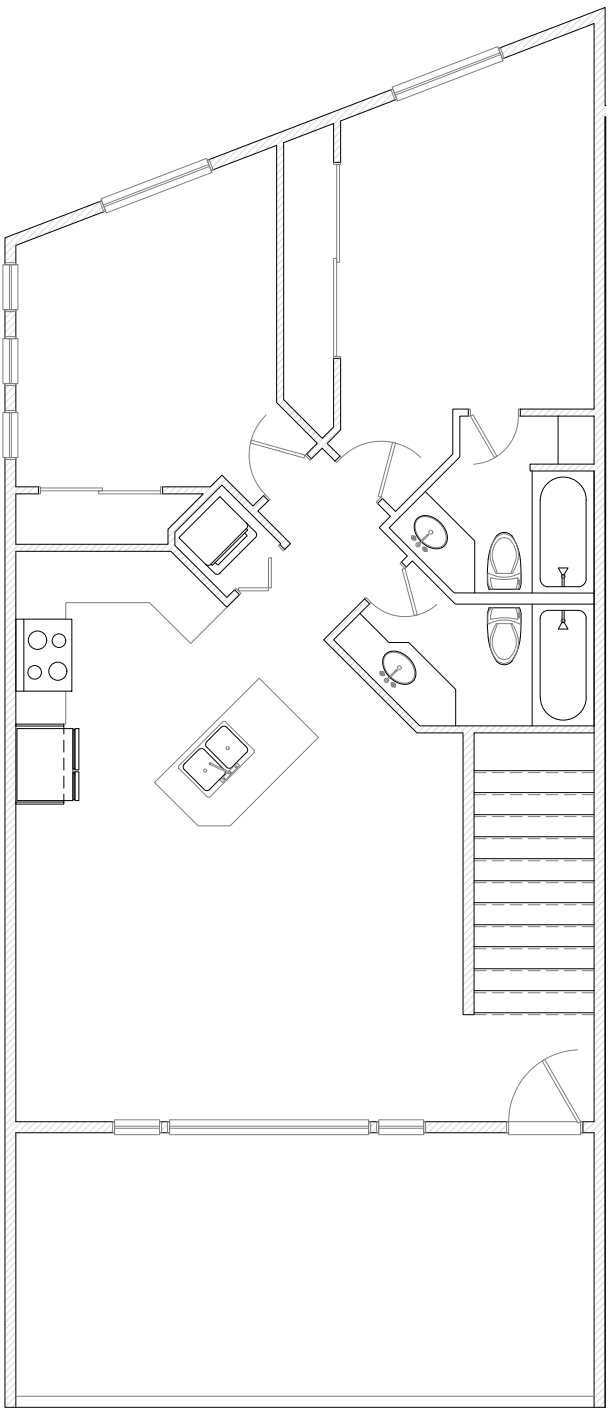



5 3RD LEVEL FLOOR PLAN - NO SHADING
SCALE: 1/8" = 1'-0"

3 2ND LEVEL FLOOR PLAN - NO SHADING
SCALE: 1/8" = 1'-0"

1 1ST LEVEL FLOOR PLAN - NO SHADING
SCALE: 1/8" = 1'-0"

SHADING KEY	
	PROPOSED PRIVATE STORAGE USE
	PROPOSED OFFICE USE
	PROPOSED ACCESSORY USE
	PROPOSED RESIDENTIAL USE
	PROPOSED WAREHOUSE USE
	STAIRWELL

Unit 8	Level 1	Warehouse	683
	Level 1	Residential	383
Unit 8	Level 2	Office	283
	Level 2	Residential	205
	Level 2	Accessory	75
Unit 8	Level 3	Residential	941

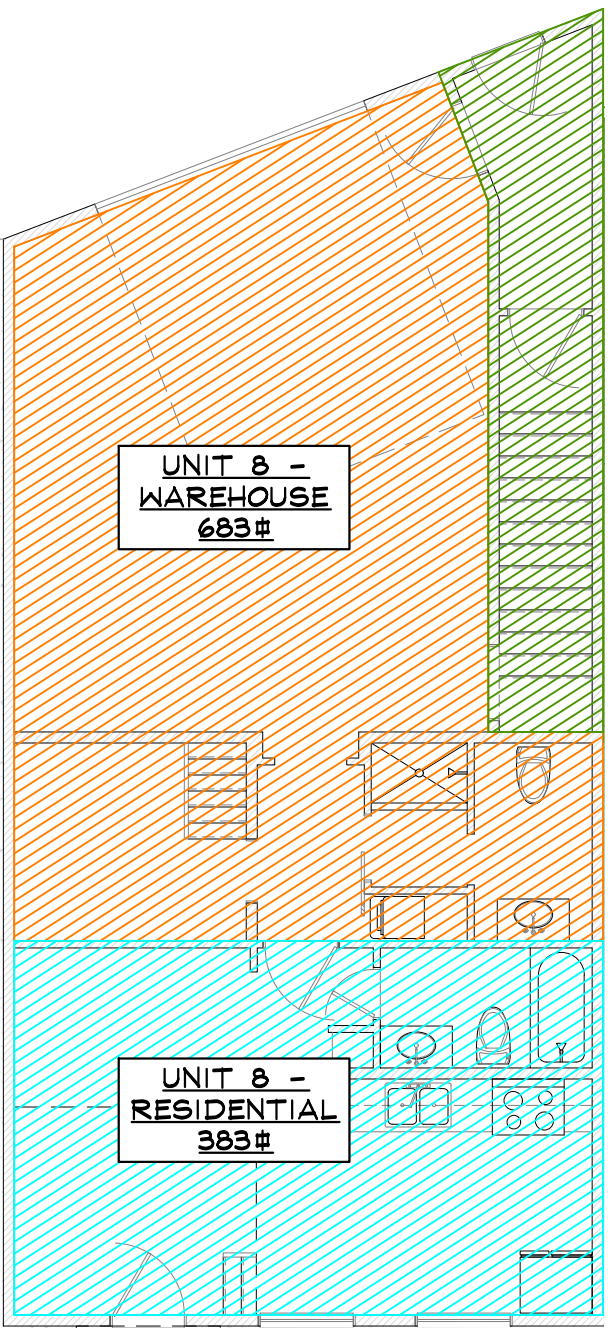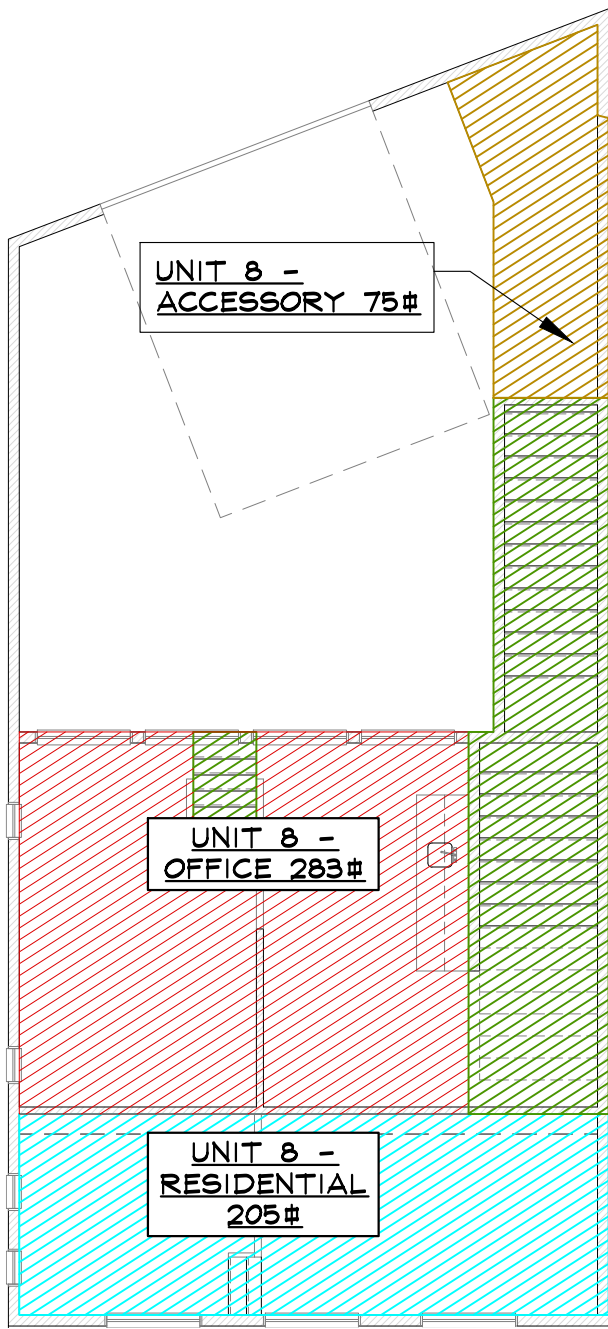

6 1ST LEVEL FLOOR PLAN - USE SHADING
SCALE: 1/8" = 1'-0"

4 2ND LEVEL FLOOR PLAN - USE SHADING
SCALE: 1/8" = 1'-0"

2 1ST LEVEL FLOOR PLAN - USE SHADING
SCALE: 1/8" = 1'-0"

NOT FOR
CONSTRUCTION



RFP BUILDING 4 TENANT FINISH
1920 BRIDGE LANE
STEAMBOAT SPRINGS, COLORADO
A TENANT FINISH FOR:
RIVER FRONT PARK HOA

ISSUE DATES

02 : 07 : 24
XX : XX : 24

REVIEW
BY




DRAWN BY: RPM
REVIEWED BY: CWM
PROJECT # 21099

UNIT 8 PROPOSED
FLOOR PLANS

UNIT 8

SIGNATURE FOR PROPOSED USE DRAWINGS
FOR DEVELOPMENT PERMIT

OWNER: UNIT 9, RIVERFRONT PARK, FILING 1	
Shawn Bertini	2/13/2024
(SHAWN T. BERTINI)	(DATE)
Diane Bertini	2/12/2024
(DIANE D. BERTINI)	(DATE)

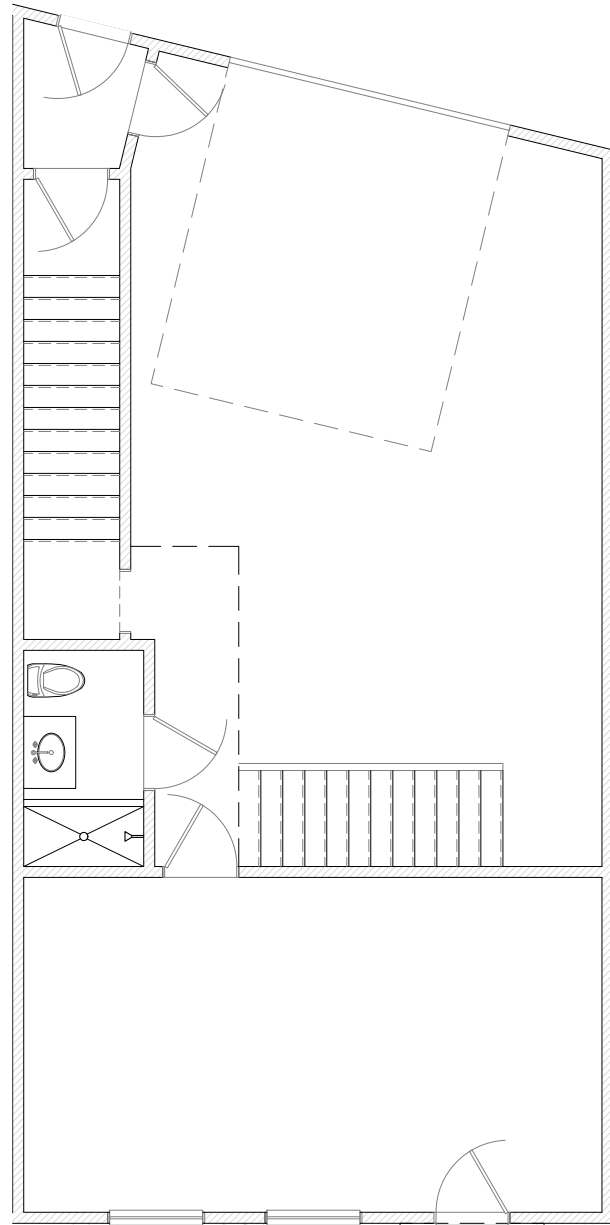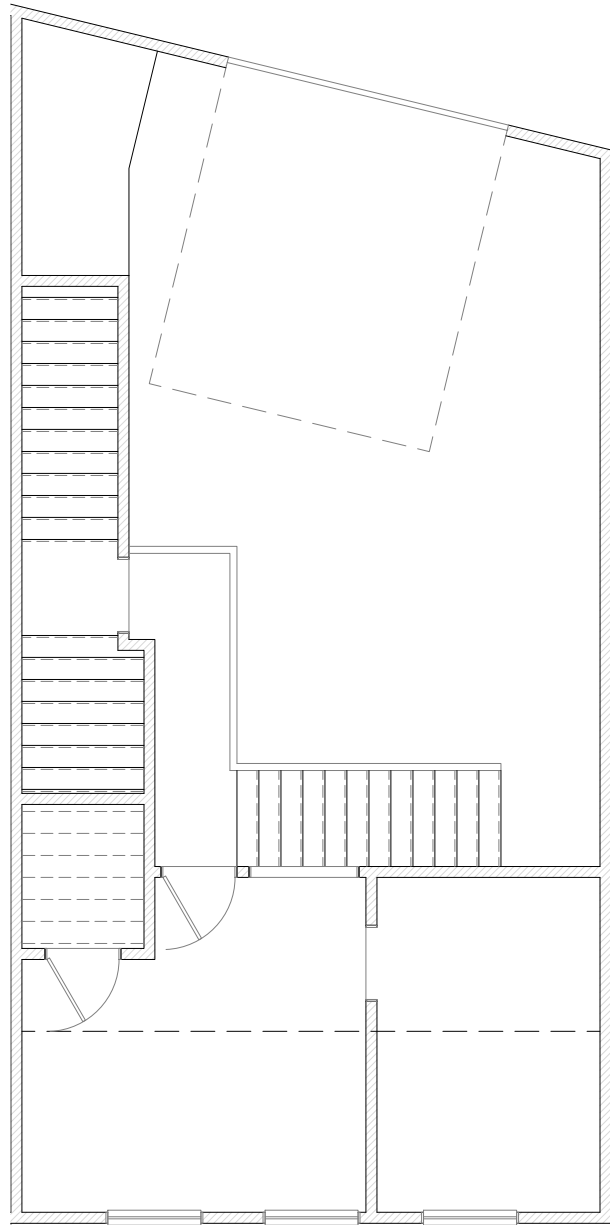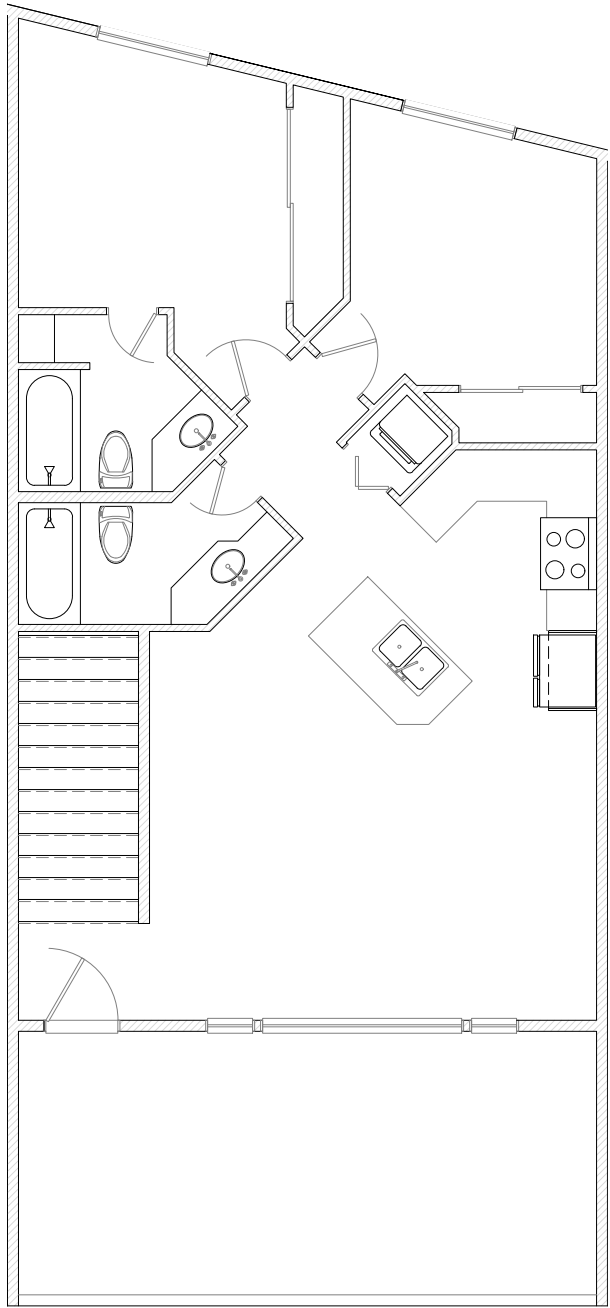




5 3RD LEVEL FLOOR PLAN - NO SHADING
SCALE: 1/8" = 1'-0"

3 2ND LEVEL FLOOR PLAN - NO SHADING
SCALE: 1/8" = 1'-0"

1 1ST LEVEL FLOOR PLAN - NO SHADING
SCALE: 1/8" = 1'-0"

SHADING KEY	
	PROPOSED PRIVATE STORAGE USE
	PROPOSED OFFICE USE
	PROPOSED ACCESSORY USE
	PROPOSED RESIDENTIAL USE
	PROPOSED WAREHOUSE USE
	STAIRWELL

Unit 9	Level 1	Garage	983
	Level 1	Residential	361
Unit 9	Level 2	Accessory	54
	Level 2	Residential	375
Unit 9	Level 3	Residential	898

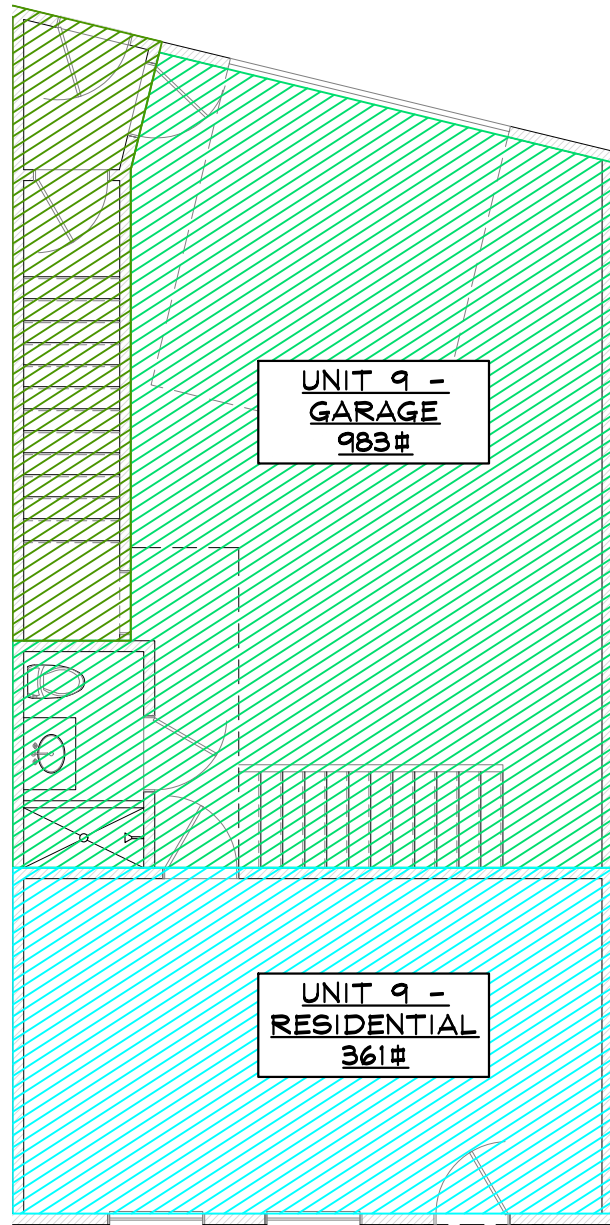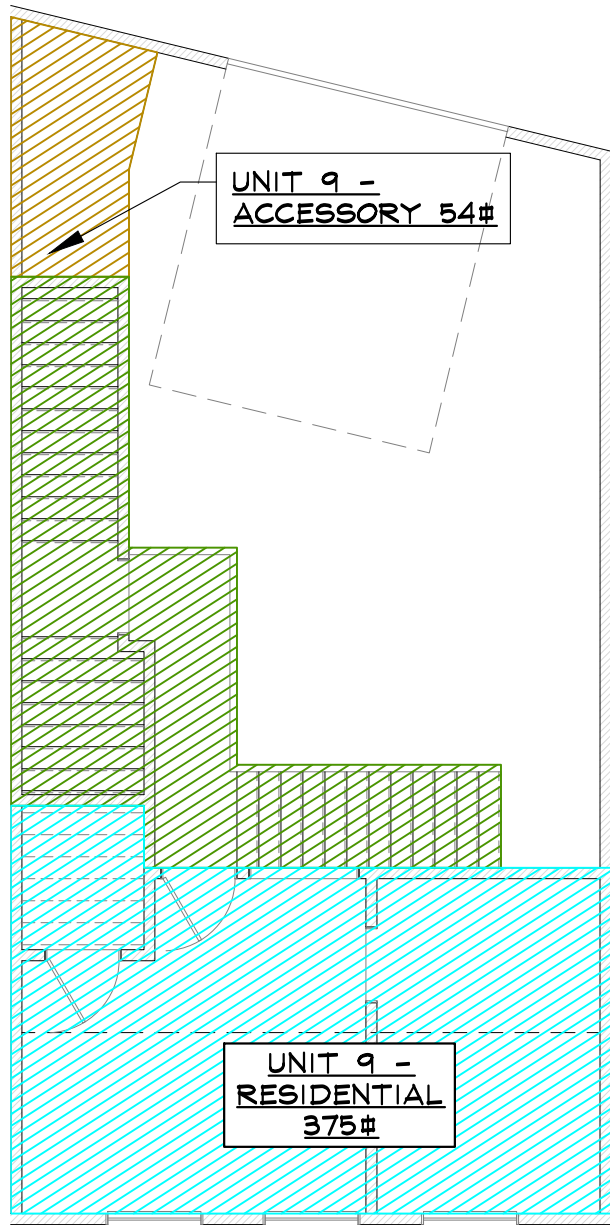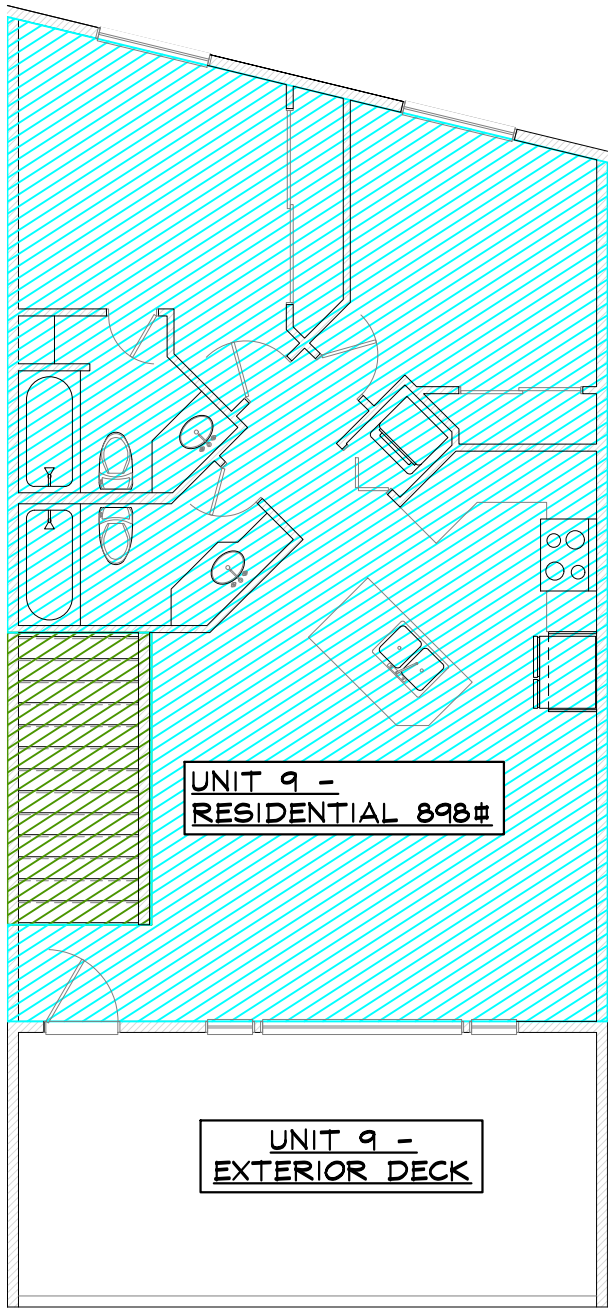

6 1ST LEVEL FLOOR PLAN - USE SHADING
SCALE: 1/8" = 1'-0"

4 2ND LEVEL FLOOR PLAN - USE SHADING
SCALE: 1/8" = 1'-0"

2 1ST LEVEL FLOOR PLAN - USE SHADING
SCALE: 1/8" = 1'-0"

NOT FOR
CONSTRUCTION



RFP BUILDING 4 TENANT FINISH
1920 BRIDGE LANE
STEAMBOAT SPRINGS, COLORADO
A TENANT FINISH FOR:
RIVER FRONT PARK HOA

ISSUE DATES

02 : 07 : 24
XX : XX : 24

REVIEW
BY

DRAWN BY: RPM
REVIEWED BY: CWM
PROJECT # 21099

UNIT 9 PROPOSED
FLOOR PLANS




UNIT 9

SIGNATURE FOR PROPOSED USE DRAWINGS
FOR DEVELOPMENT PERMIT

OWNER: UNIT 10, RIVERFRONT PARK, FILING 1
2/15/2024

(TIMOTHY JAMES ROSS)

(DATE)

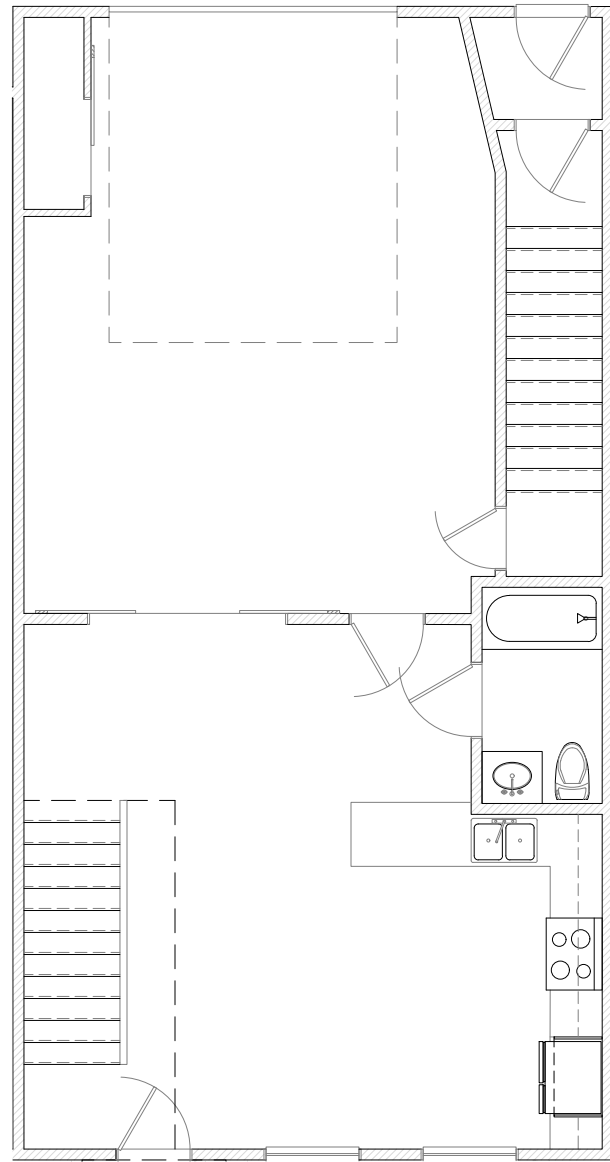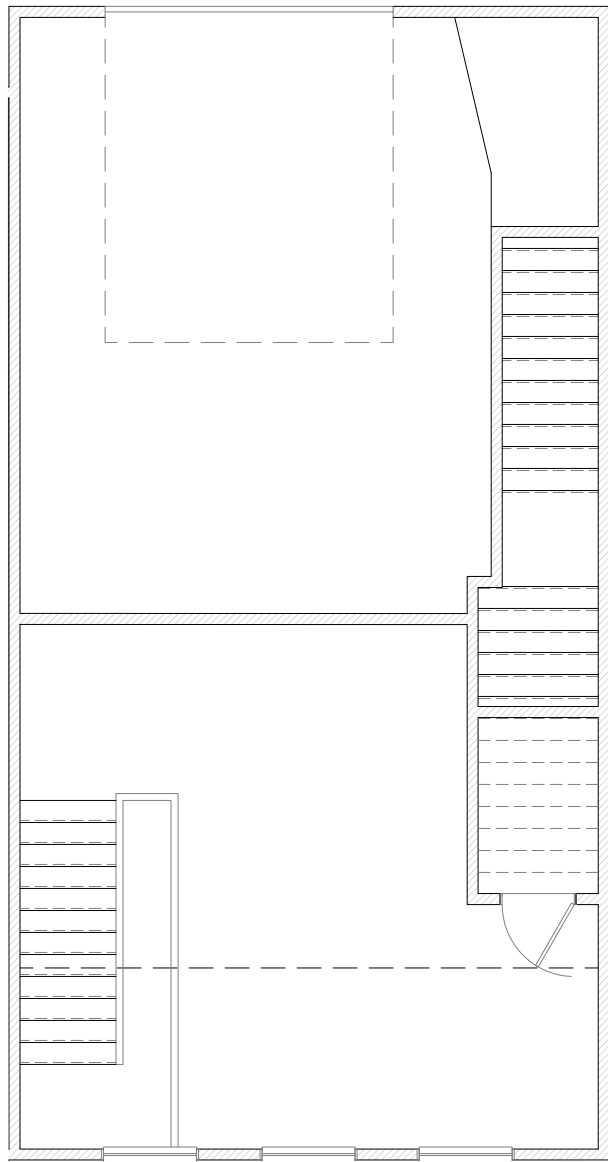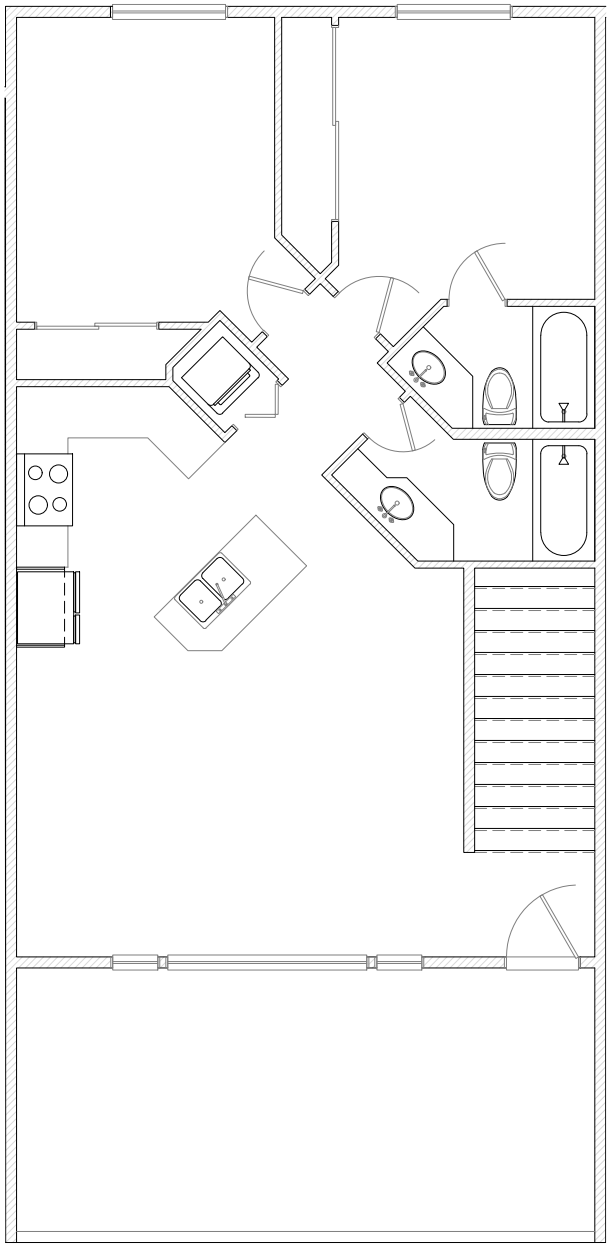




5 3RD LEVEL FLOOR PLAN - NO SHADING
SCALE: 1/8" = 1'-0"

3 2ND LEVEL FLOOR PLAN - NO SHADING
SCALE: 1/8" = 1'-0"

1 1ST LEVEL FLOOR PLAN - NO SHADING
SCALE: 1/8" = 1'-0"

SHADING KEY	
	PROPOSED PRIVATE STORAGE USE
	PROPOSED OFFICE USE
	PROPOSED ACCESSORY USE
	PROPOSED RESIDENTIAL USE
	PROPOSED WAREHOUSE USE
	STAIRWELL

Unit 10	Level 1	Garage	491
	Level 1	Residential	567
Unit 10	Level 2	Accessory	48
	Level 2	Residential	434
Unit 10	Level 3	Residential	907

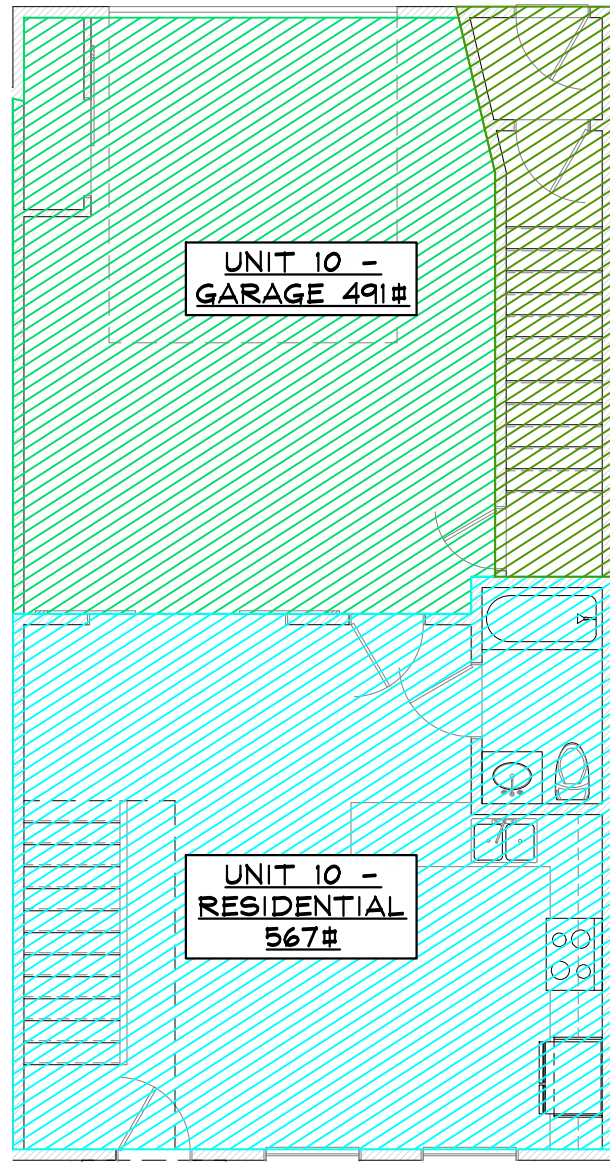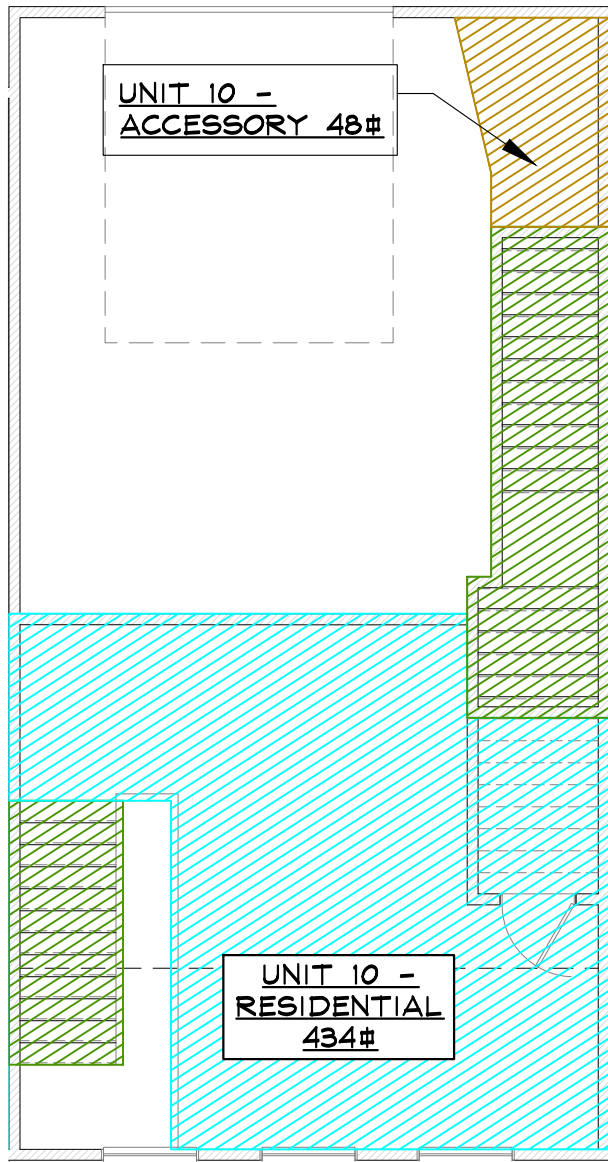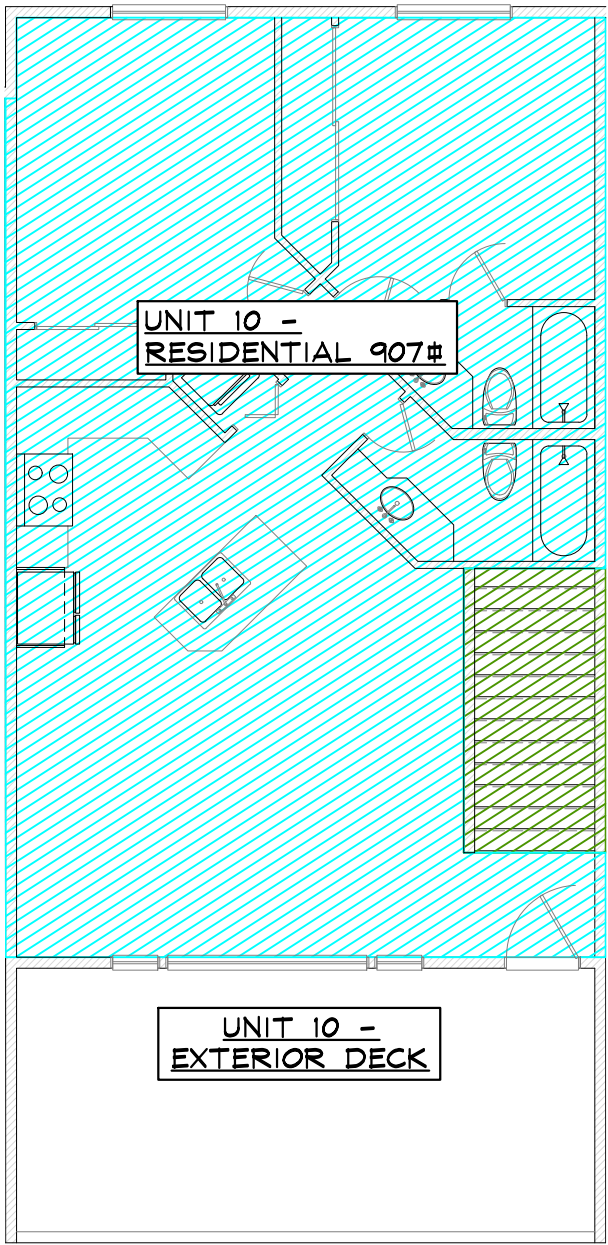

6 1ST LEVEL FLOOR PLAN - USE SHADING
SCALE: 1/8" = 1'-0"

4 2ND LEVEL FLOOR PLAN - USE SHADING
SCALE: 1/8" = 1'-0"

2 1ST LEVEL FLOOR PLAN - USE SHADING
SCALE: 1/8" = 1'-0"

NOT FOR
CONSTRUCTION



RFP BUILDING 4 TENANT FINISH
1920 BRIDGE LANE
STEAMBOAT SPRINGS, COLORADO
A TENANT FINISH FOR:
RIVER FRONT PARK HOA

ISSUE DATES

02 : 07 : 24
XX : XX : 24

REVIEW
BY

DRAWN BY: RPM
REVIEWED BY: CWM
PROJECT # 21099

UNIT 10 PROPOSED
FLOOR PLANS


UNIT 10

SIGNATURE FOR PROPOSED USE DRAWINGS
FOR DEVELOPMENT PERMIT


OWNER: UNIT 11, RIVERFRONT PARK, FILING 1
STEAMBOAT RESIDENTIAL, LLC

BY: Eric Rogers Eric Rogers
(SIGNATURE) (PRINT NAME)


ITS: Managing Member DATE: 2/12/2024

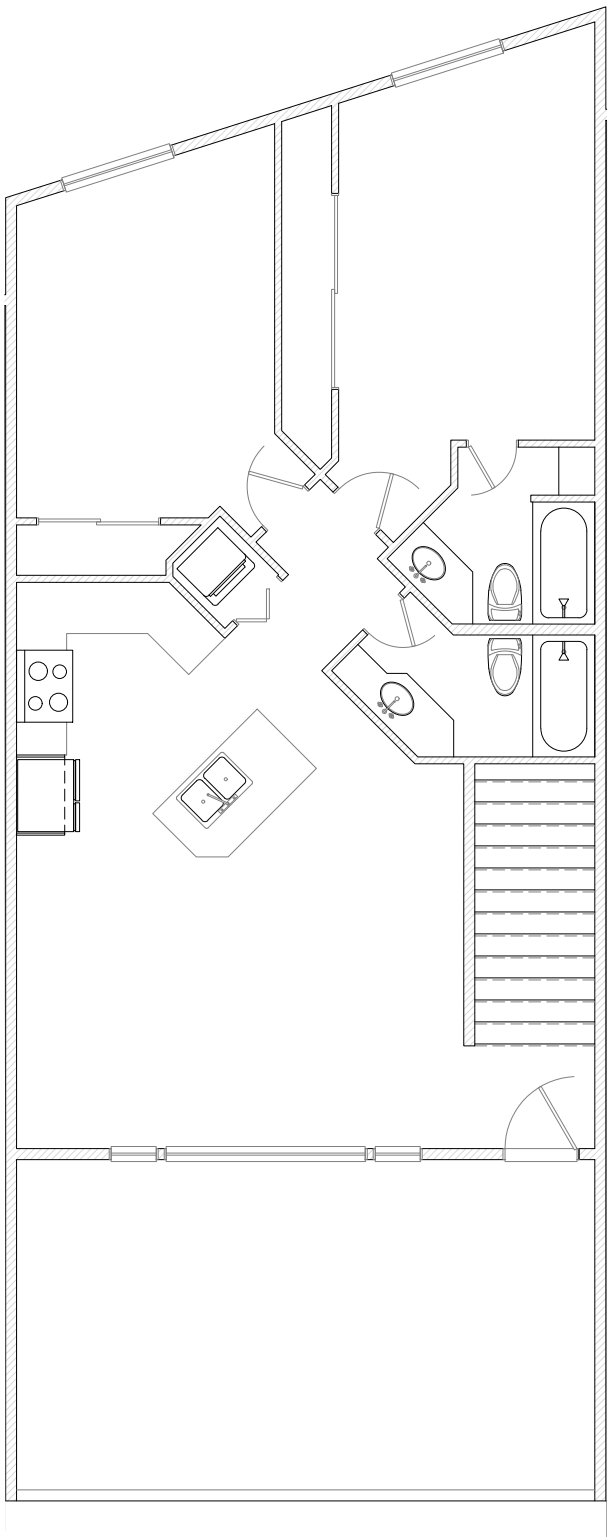

5 3RD LEVEL FLOOR PLAN - NO SHADING
SCALE: 1/8" = 1'-0"

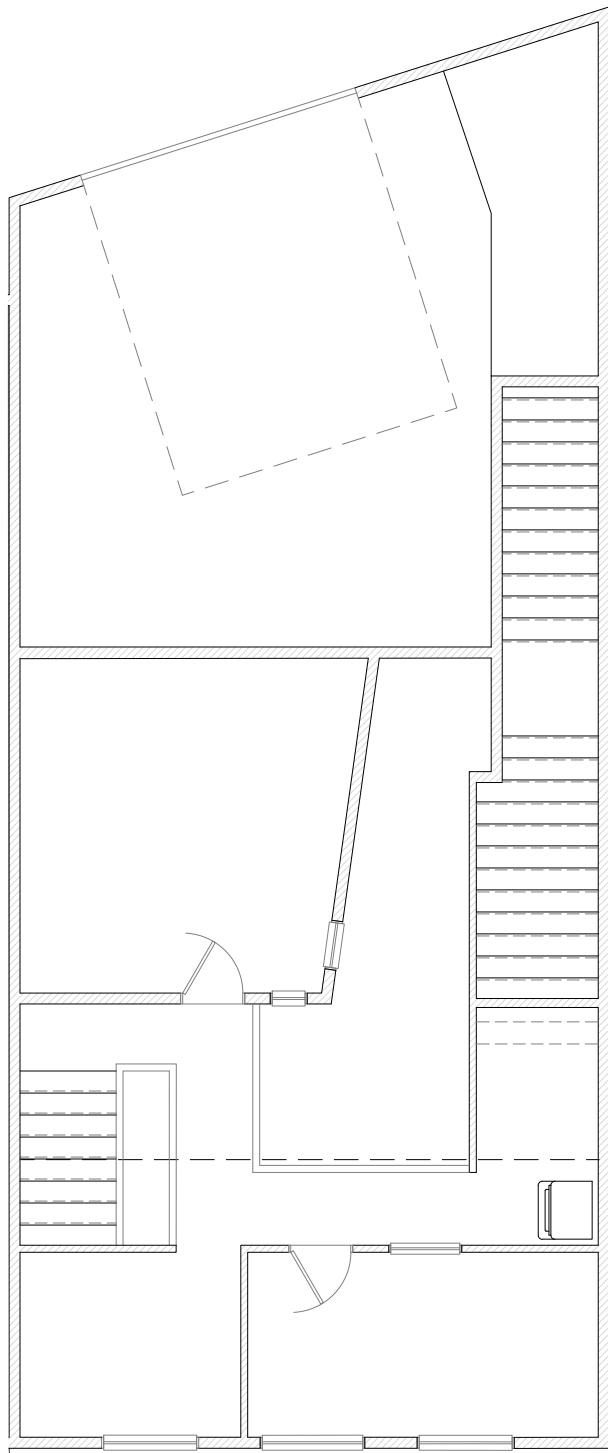


3 2ND LEVEL FLOOR PLAN - NO SHADING
SCALE: 1/8" = 1'-0"

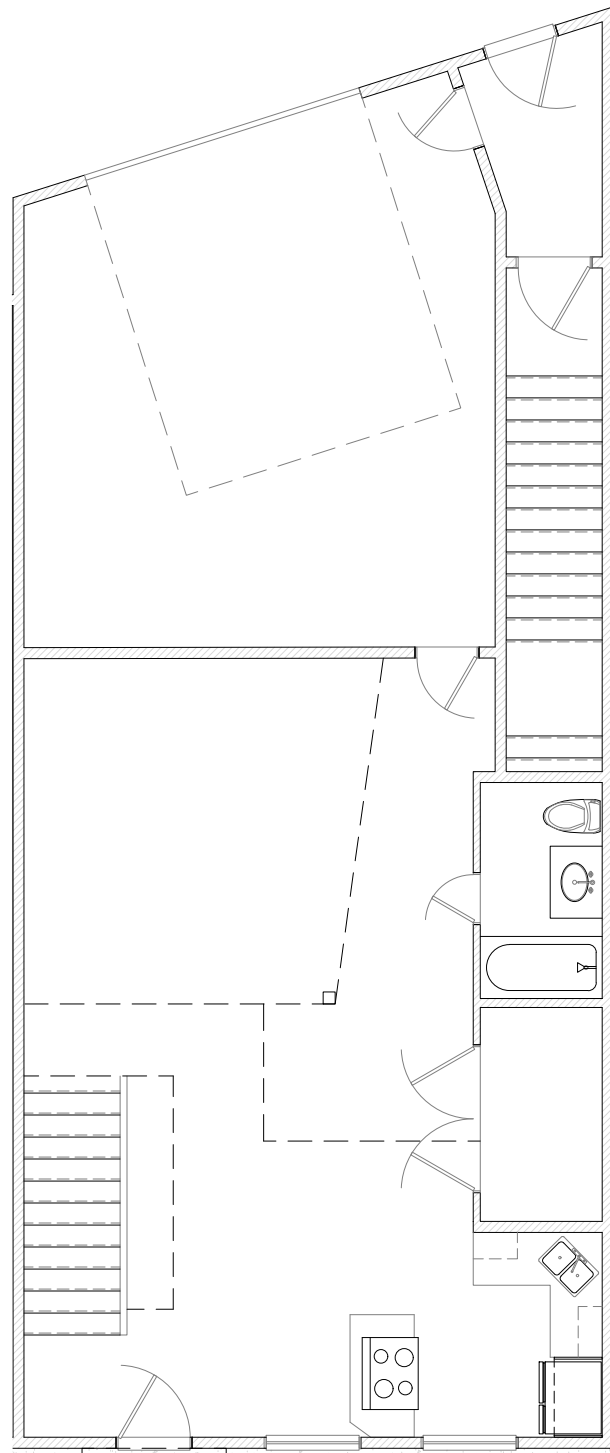


1 1ST LEVEL FLOOR PLAN - NO SHADING
SCALE: 1/8" = 1'-0"

SHADING KEY				
	■	PROPOSED PRIVATE STORAGE USE		
	■	PROPOSED OFFICE USE		
	■	PROPOSED ACCESSORY USE		
	■	PROPOSED RESIDENTIAL USE		
	■	PROPOSED WAREHOUSE USE		
	■	STAIRWELL		


Unit 11	Level 1	Garage	422
	Level 1	Residential	798
Unit 11	Level 2	Accessory	74
	Level 2	Residential	690
Unit 11	Level 3	Residential	1004

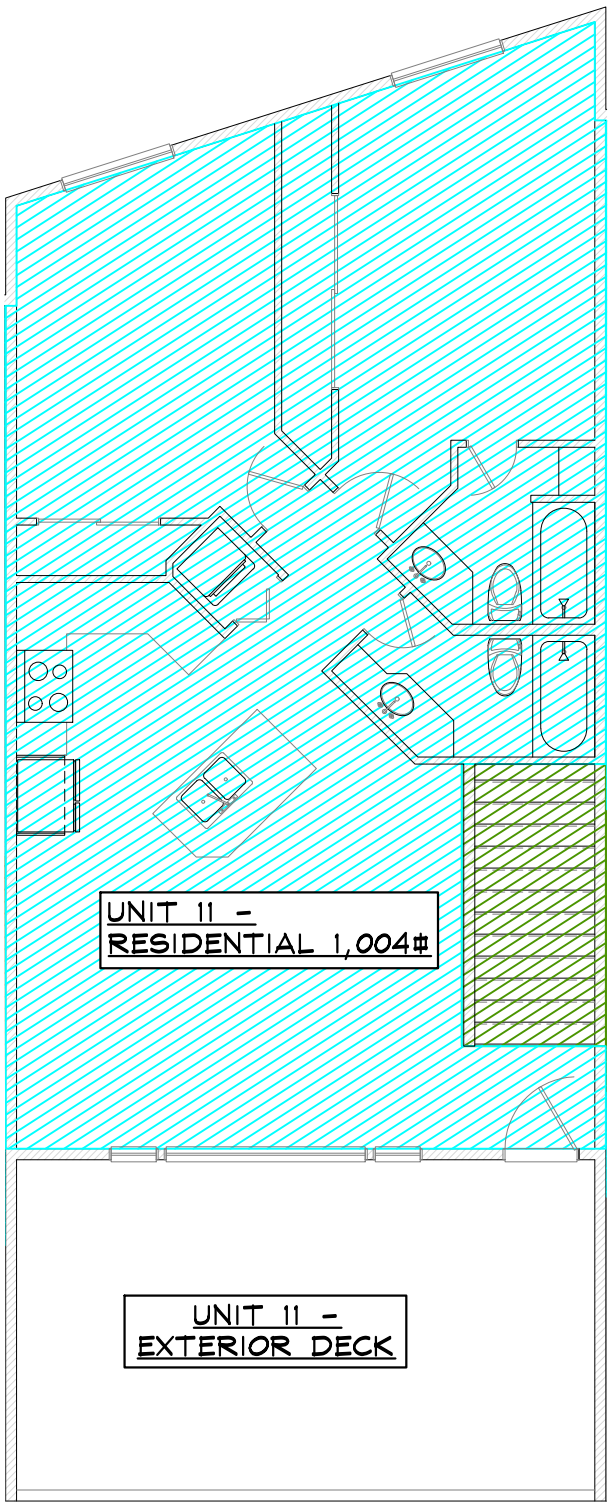

6 1ST LEVEL FLOOR PLAN - USE SHADING
SCALE: 1/8" = 1'-0"

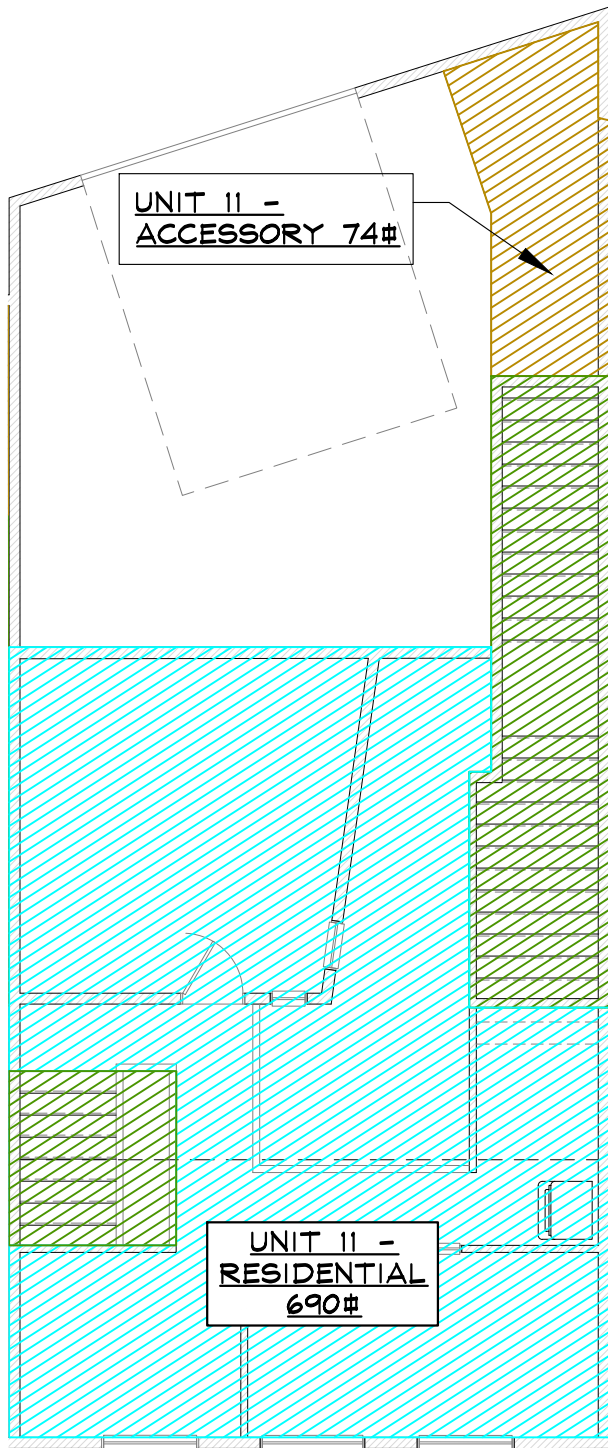

4 2ND LEVEL FLOOR PLAN - USE SHADING
SCALE: 1/8" = 1'-0"

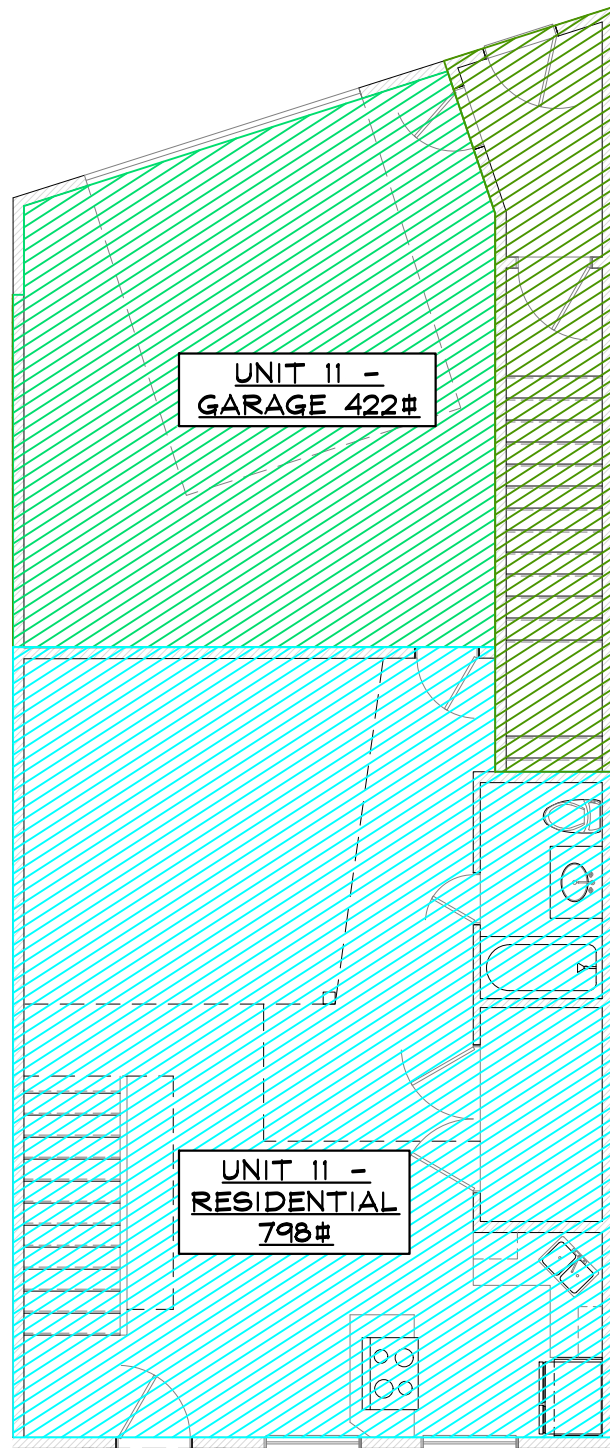

2 1ST LEVEL FLOOR PLAN - USE SHADING
SCALE: 1/8" = 1'-0"

NOT FOR
CONSTRUCTION



RFP BUILDING 4 TENANT FINISH
1920 BRIDGE LANE
STEAMBOAT SPRINGS, COLORADO
A TENANT FINISH FOR:
RIVER FRONT PARK HOA

ISSUE DATES

02 : 07 : 24
XX : XX : 24

REVIEW
BY

DRAWN BY: RPM
REVIEWED BY: CWM
PROJECT # 21099




UNIT 11 PROPOSED
FLOOR PLANS

UNIT 11

SIGNATURE FOR PROPOSED USE DRAWINGS
FOR DEVELOPMENT PERMIT

OWNER: UNIT 12, RIVERFRONT PARK, FILING 1
Lani Cleverly
2/14/2024

(LANI K. CLEVERLY) (DATE)

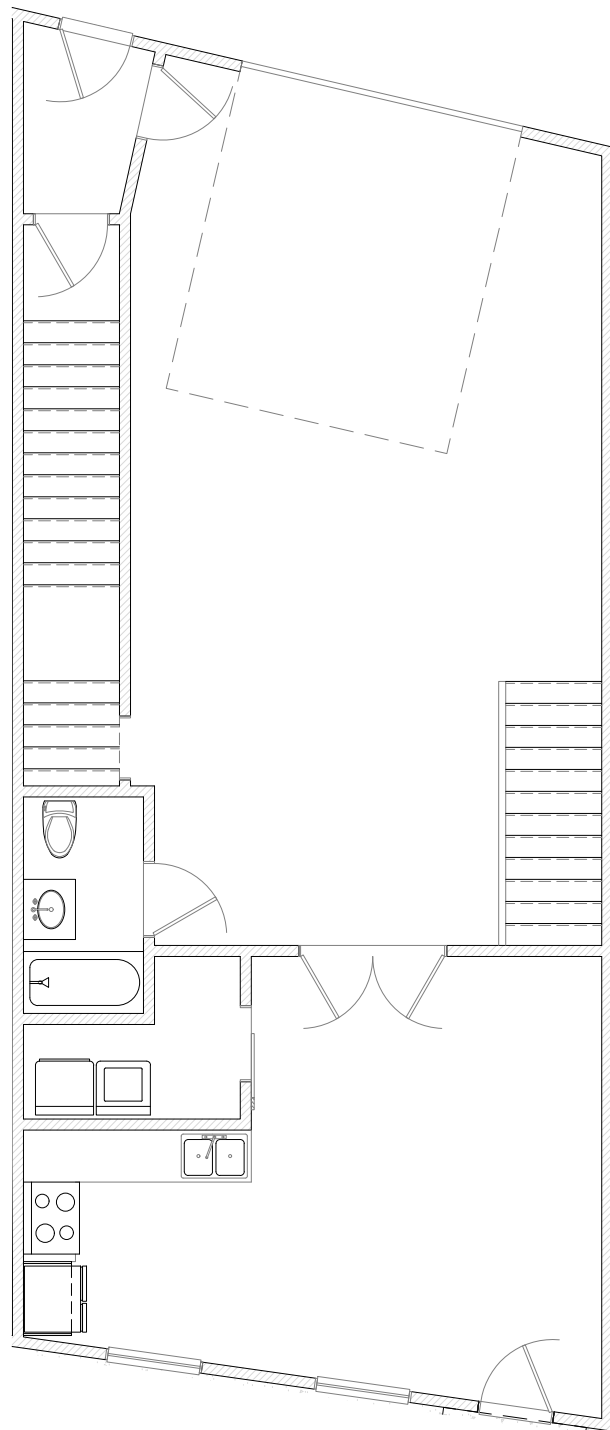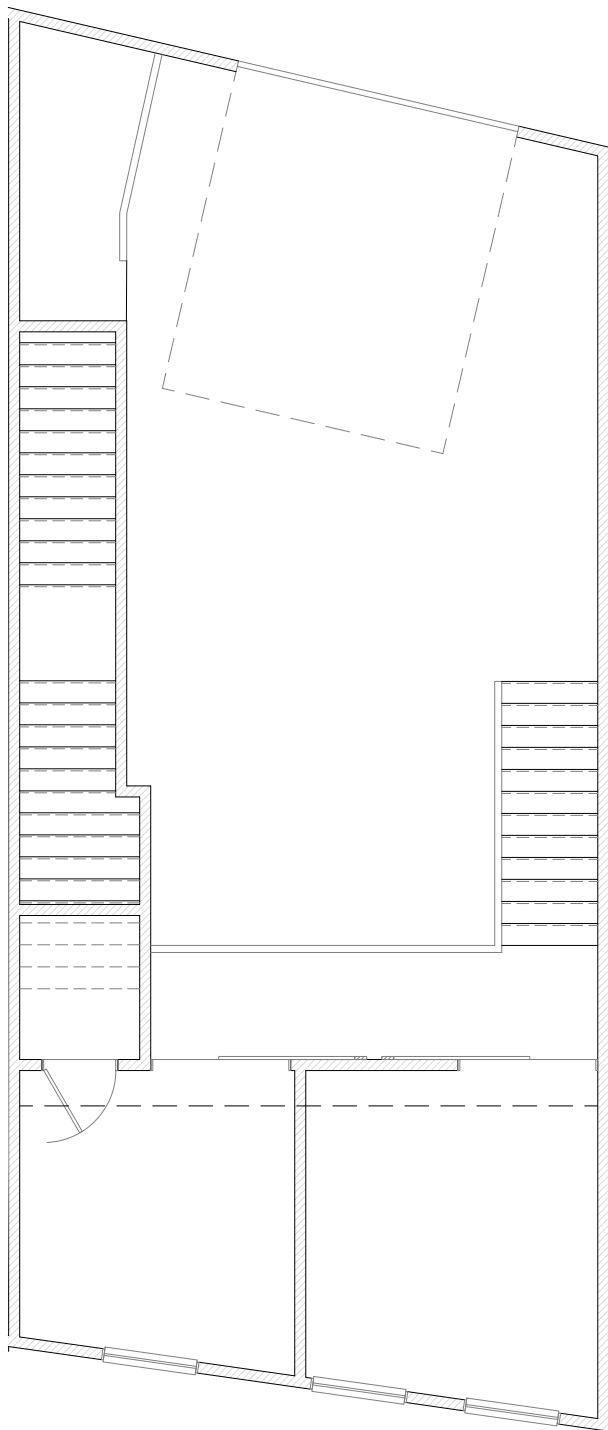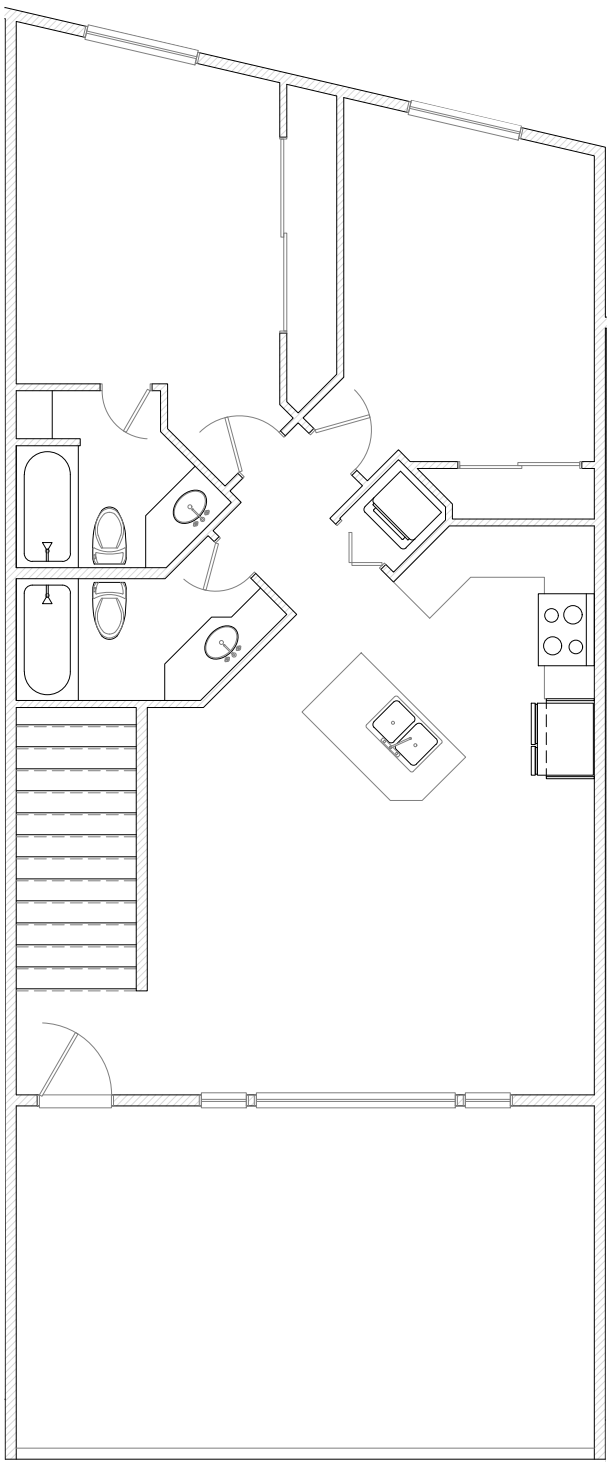




5 3RD LEVEL FLOOR PLAN - NO SHADING
SCALE: 1/8" = 1'-0"

3 2ND LEVEL FLOOR PLAN - NO SHADING
SCALE: 1/8" = 1'-0"

1 1ST LEVEL FLOOR PLAN - NO SHADING
SCALE: 1/8" = 1'-0"

SHADING KEY				
	■	PROPOSED PRIVATE STORAGE USE		
	■	PROPOSED OFFICE USE		
	■	PROPOSED ACCESSORY USE		
	■	PROPOSED RESIDENTIAL USE		
	■	PROPOSED WAREHOUSE USE		
	■	STAIRWELL		

Unit 12	Level 1	Residential	1181
Unit 12	Level 2	Accessory	62
	Level 2	Residential	367
Unit 12	Level 3	Residential	975

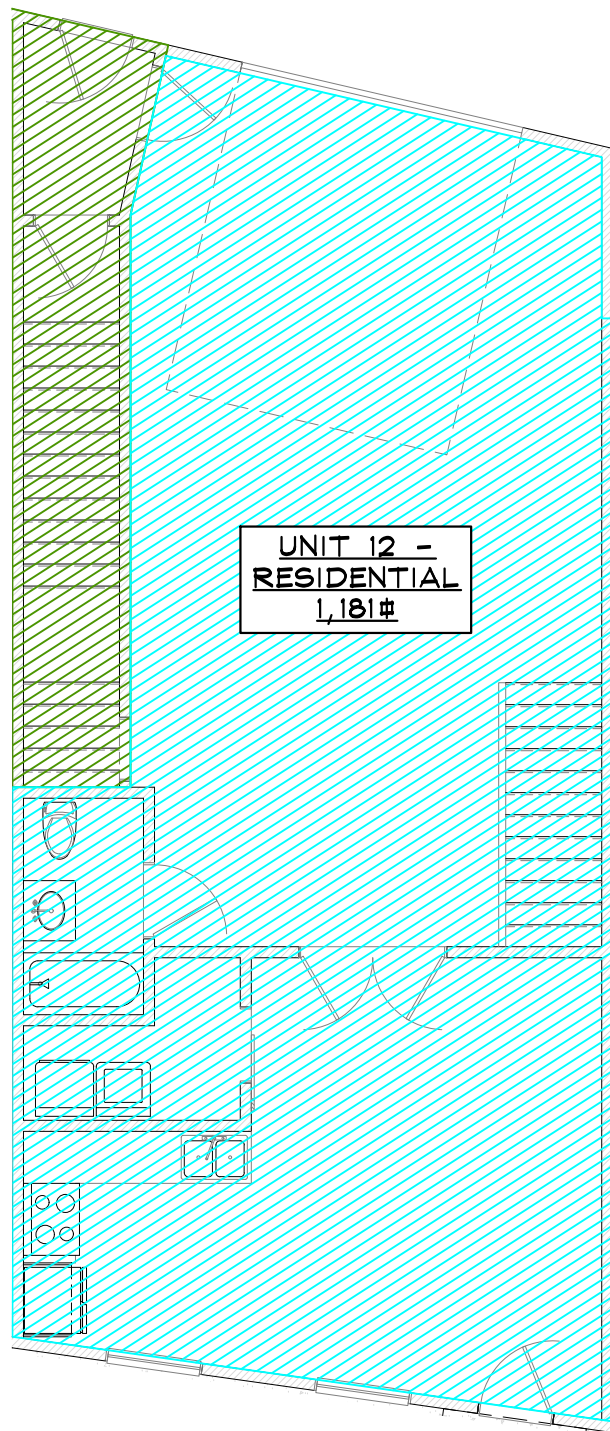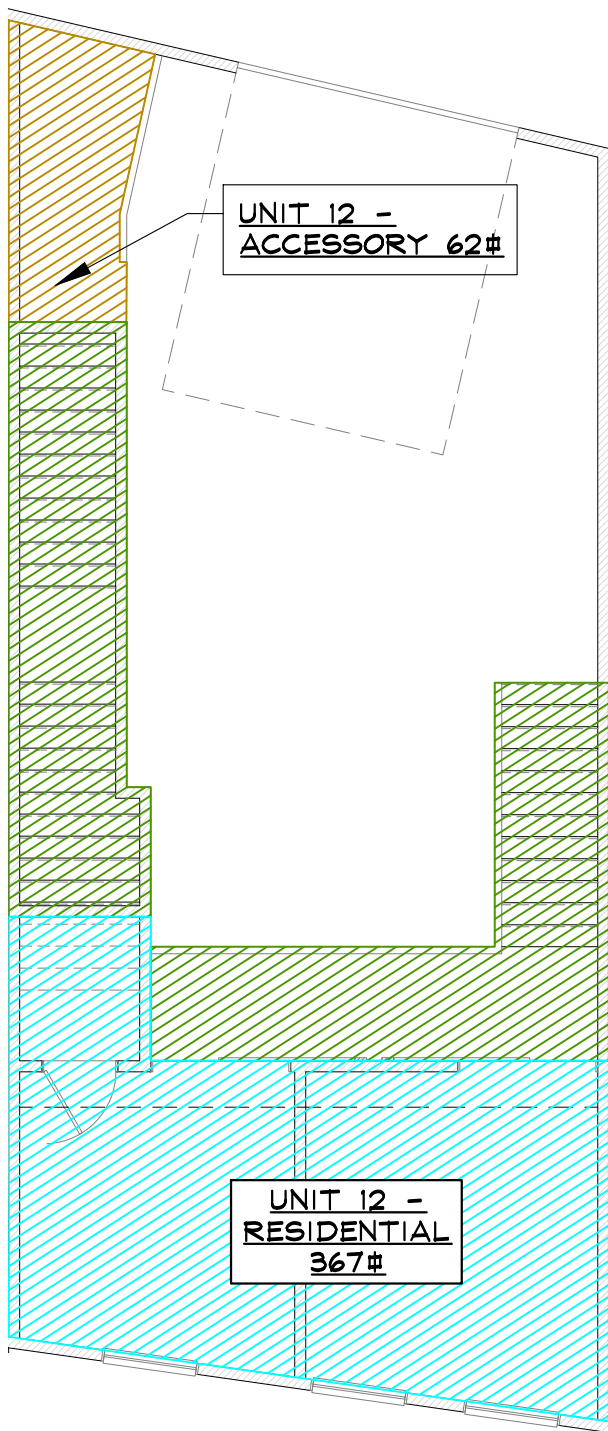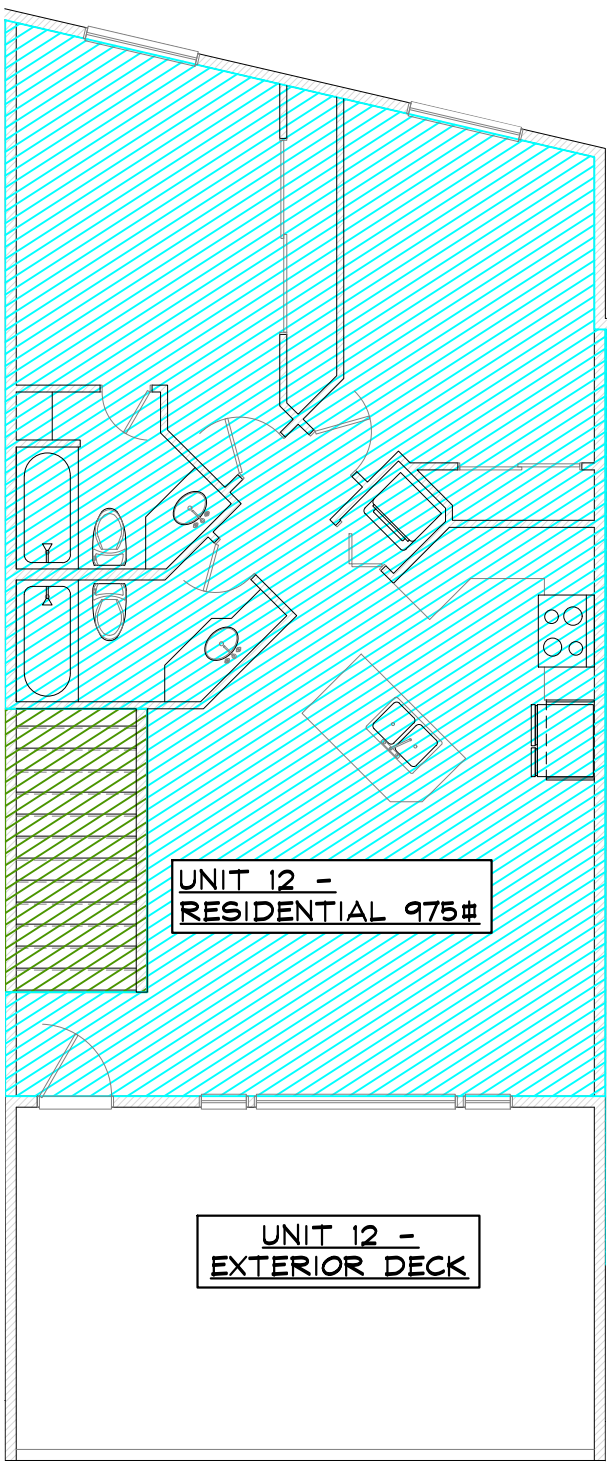

6 1ST LEVEL FLOOR PLAN - USE SHADING
SCALE: 1/8" = 1'-0"

4 2ND LEVEL FLOOR PLAN - USE SHADING
SCALE: 1/8" = 1'-0"

2 1ST LEVEL FLOOR PLAN - USE SHADING
SCALE: 1/8" = 1'-0"

NOT FOR
CONSTRUCTION



RFP BUILDING 4 TENANT FINISH
1920 BRIDGE LANE
STEAMBOAT SPRINGS, COLORADO
A TENANT FINISH FOR:
RIVER FRONT PARK HOA

ISSUE DATES

02 : 07 : 24 REVIEW
XX : XX : 24 BY

DRAWN BY: RPM
REVIEWED BY: CWM
PROJECT # 21099

UNIT 12 PROPOSED
FLOOR PLANS

UNIT 12




SIGNATURE FOR PROPOSED USE DRAWINGS
FOR DEVELOPMENT PERMIT

OWNER: UNIT 13, RIVERFRONT PARK, FILING 1

2/9/2024

(MILO ROBERT VELTUS RUBIN)

(DATE)

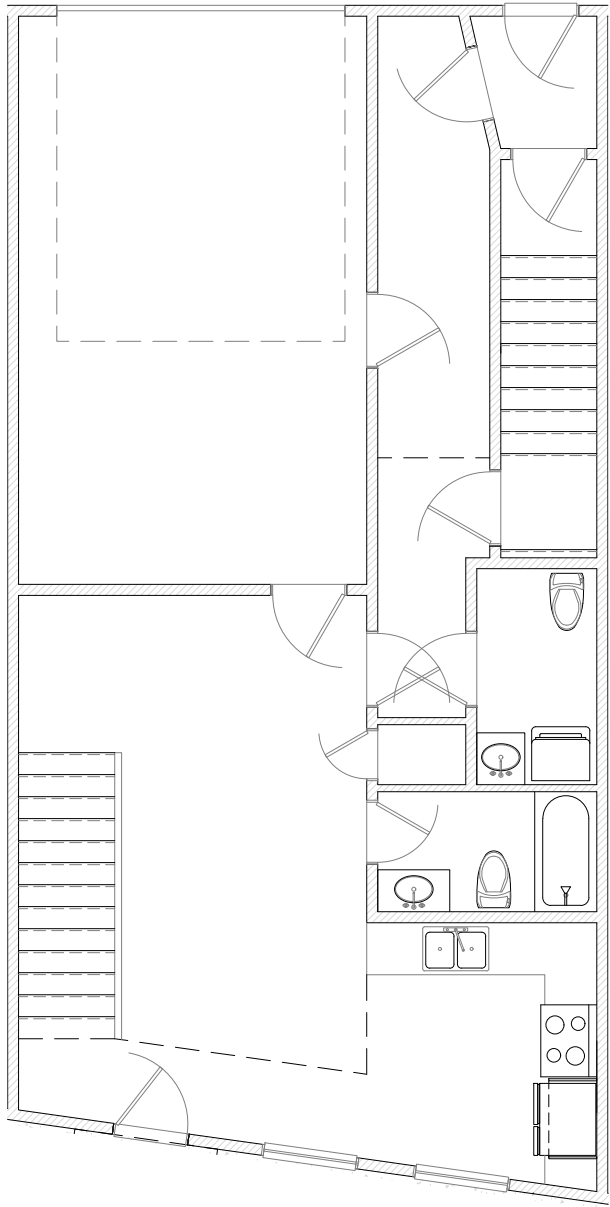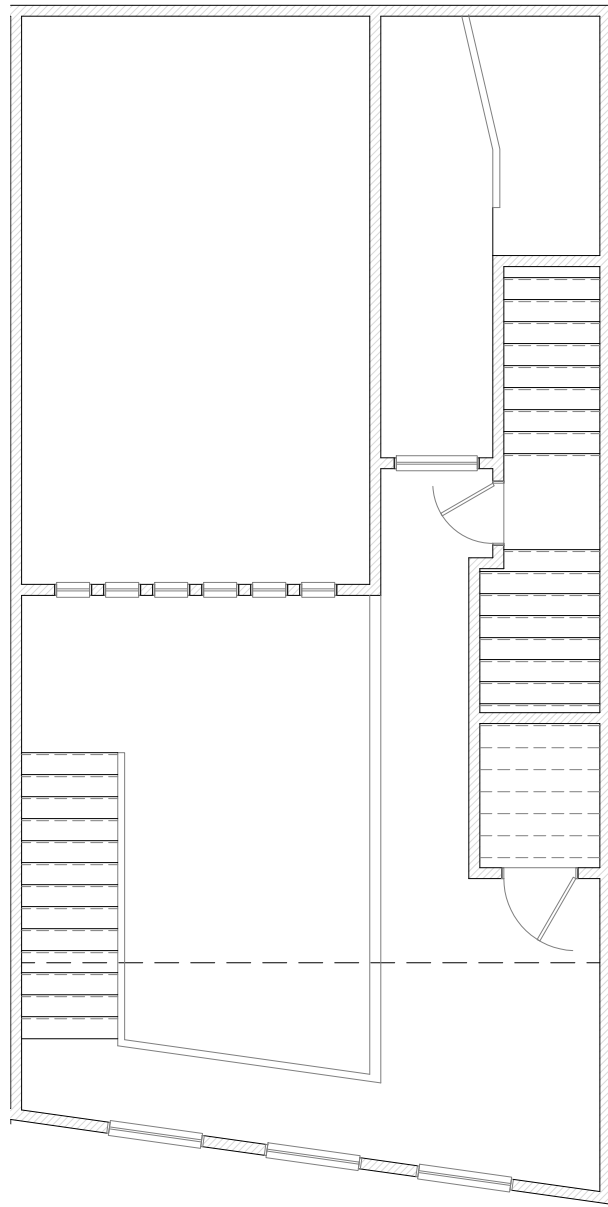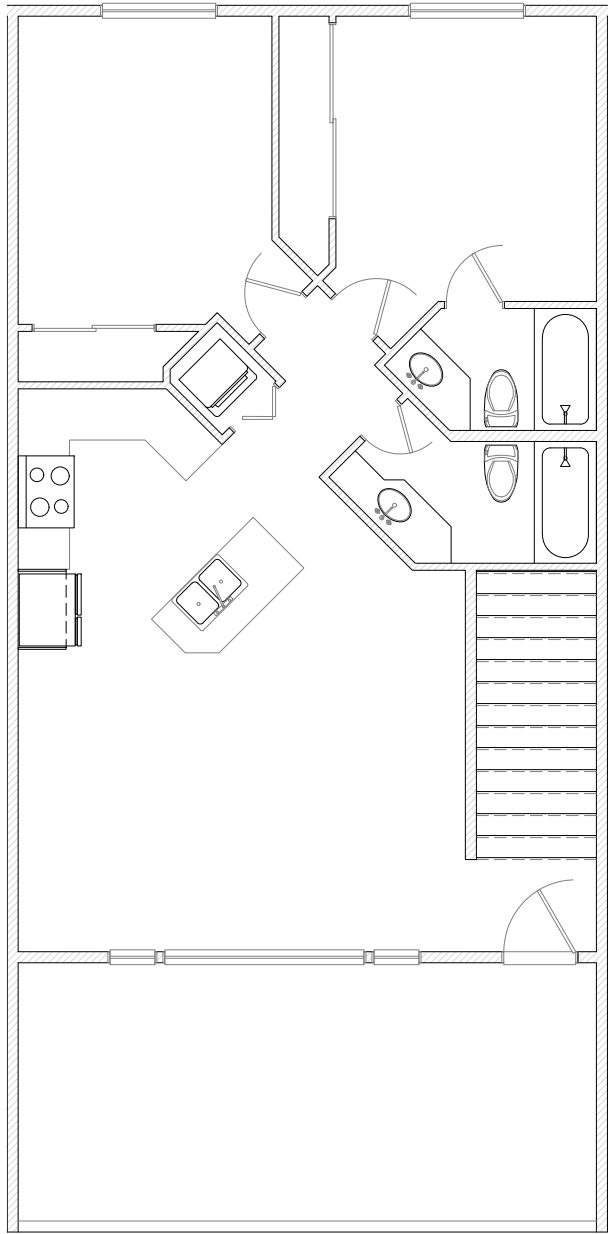




5 3RD LEVEL FLOOR PLAN - NO SHADING
SCALE: 1/8" = 1'-0"

3 2ND LEVEL FLOOR PLAN - NO SHADING
SCALE: 1/8" = 1'-0"

1 1ST LEVEL FLOOR PLAN - NO SHADING
SCALE: 1/8" = 1'-0"

SHADING KEY			
	■	PROPOSED PRIVATE STORAGE USE	
	■	PROPOSED OFFICE USE	
	■	PROPOSED ACCESSORY USE	
	■	PROPOSED RESIDENTIAL USE	
	■	PROPOSED WAREHOUSE USE	
	■	STAIRWELL	

Unit 10	Level 1	Garage	355
	Level 1	Residential	713
Unit 13	Level 2	Accessory	130
	Level 2	Residential	273
Unit 13	Level 3	Residential	903

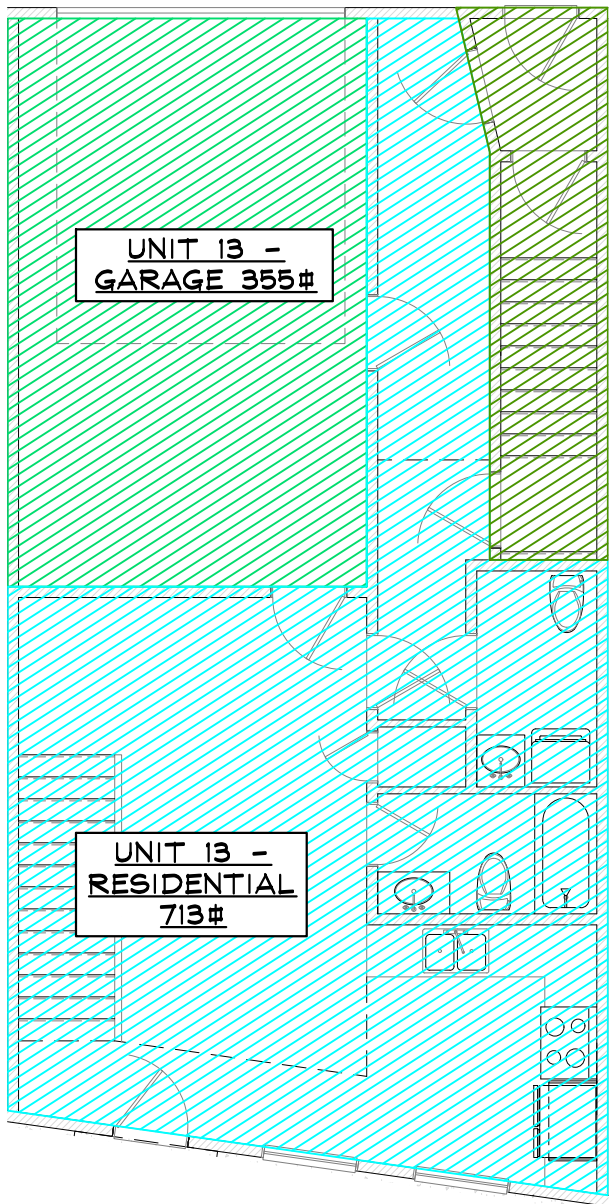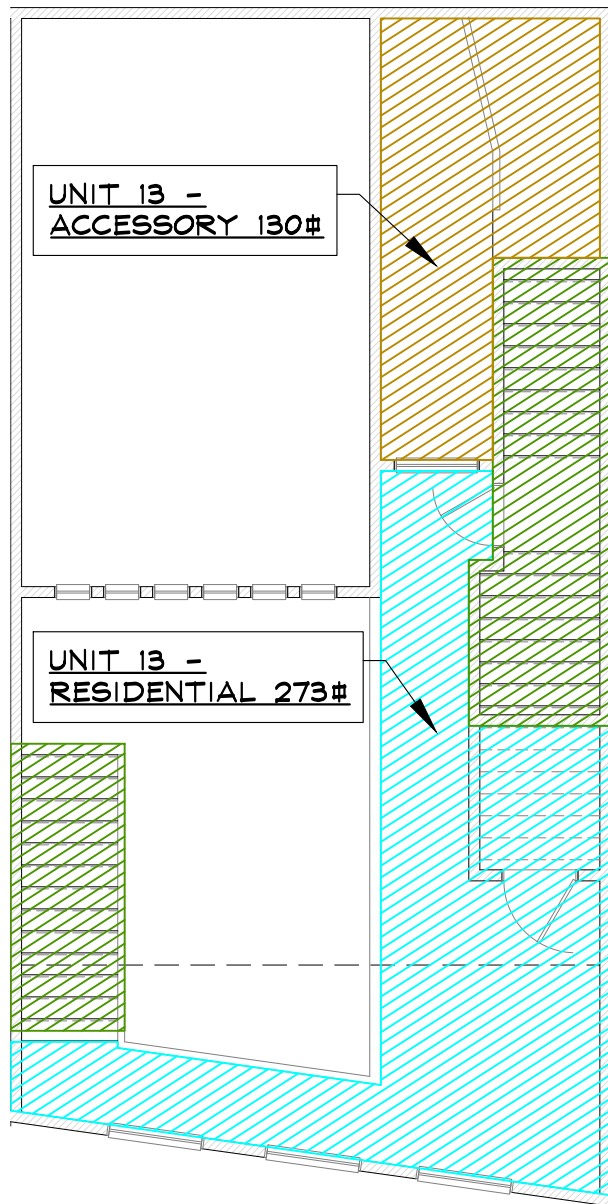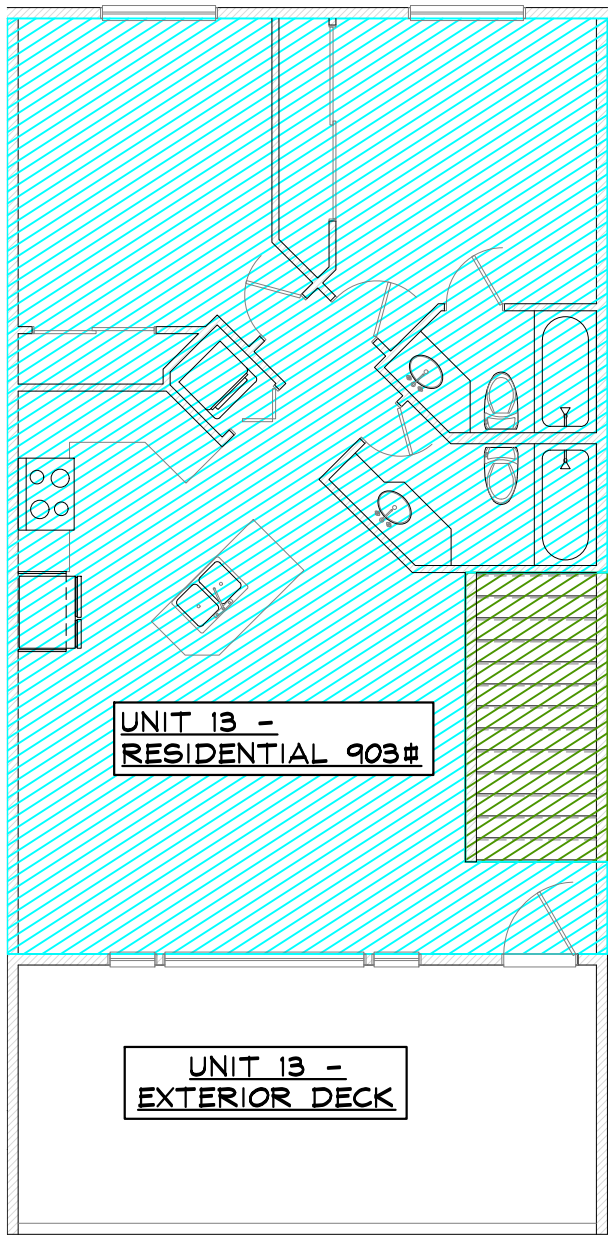

6 1ST LEVEL FLOOR PLAN - USE SHADING
SCALE: 1/8" = 1'-0"

4 2ND LEVEL FLOOR PLAN - USE SHADING
SCALE: 1/8" = 1'-0"

2 1ST LEVEL FLOOR PLAN - USE SHADING
SCALE: 1/8" = 1'-0"

NOT FOR
CONSTRUCTION



RFP BUILDING 4 TENANT FINISH
1920 BRIDGE LANE
STEAMBOAT SPRINGS, COLORADO
A TENANT FINISH FOR:
RIVER FRONT PARK HOA

ISSUE DATES

02 : 07 : 24 REVIEW
XX : XX : 24 DP

DRAWN BY: RPM
REVIEWED BY: CWM
PROJECT # 21099




UNIT 13 PROPOSED
FLOOR PLANS

UNIT 13

SIGNATURE FOR PROPOSED USE DRAWINGS
FOR DEVELOPMENT PERMIT

OWNER: UNIT 14, RIVERFRONT PARK, FILING 1
CO MGP HOLDINGS, LLC

BY: Karl Holt Karl Holt
(SIGNATURE) (PRINT NAME)
ITS: President DATE: 2/9/2024

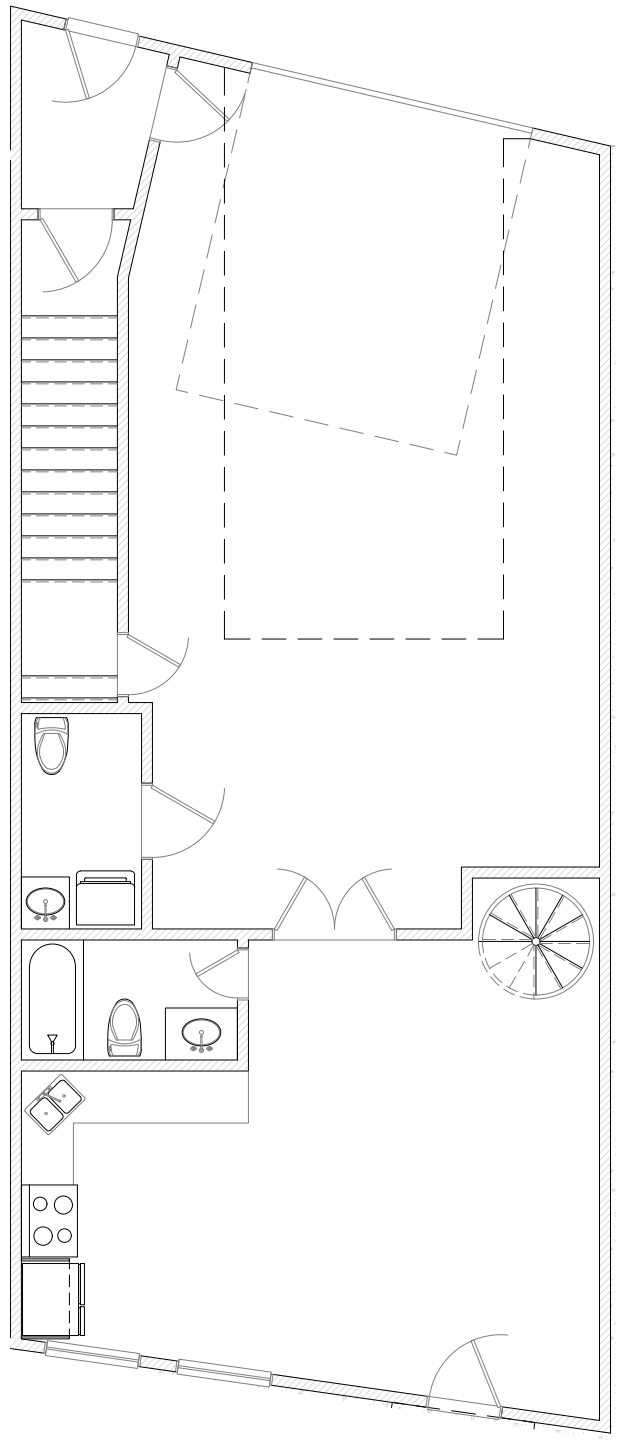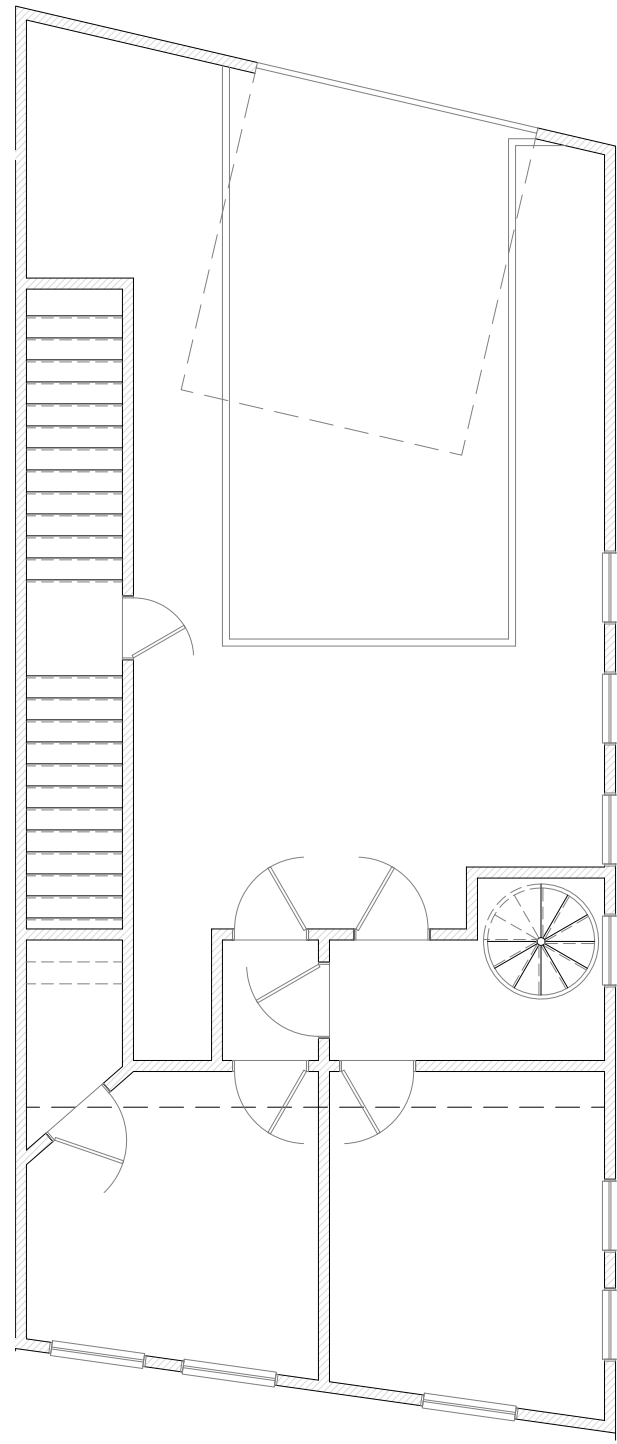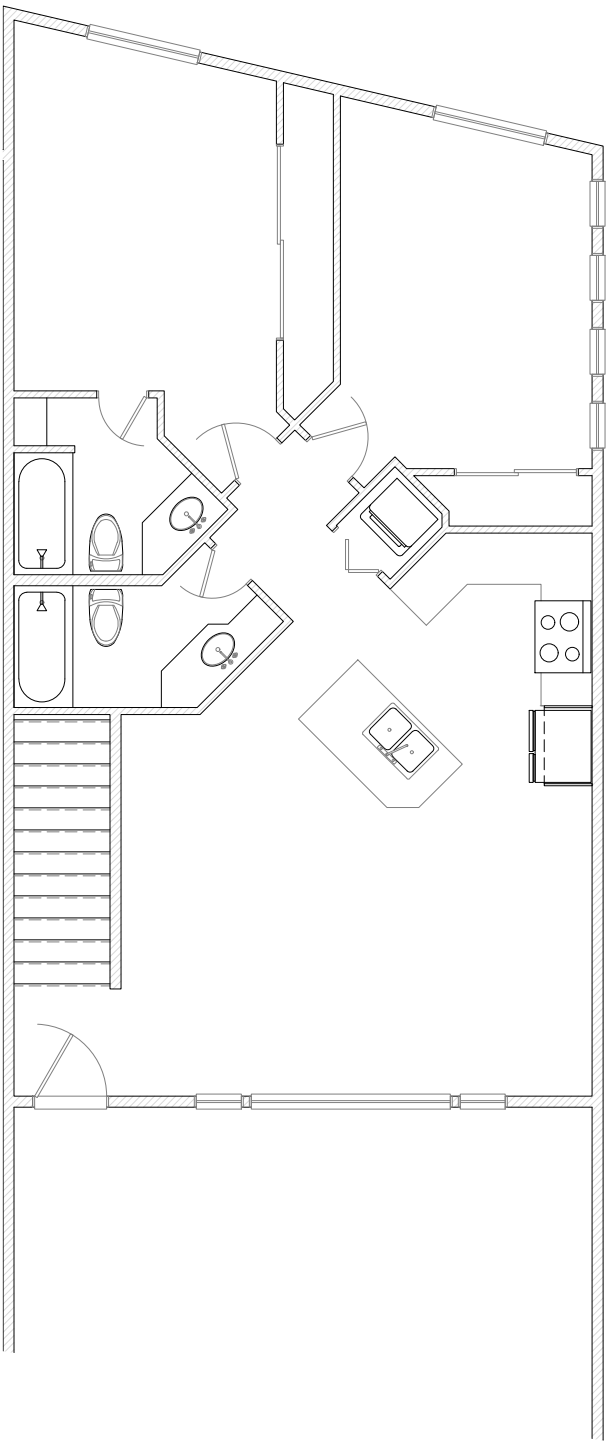




5 3RD LEVEL FLOOR PLAN - NO SHADING
SCALE: 1/8" = 1'-0"

3 2ND LEVEL FLOOR PLAN - NO SHADING
SCALE: 1/8" = 1'-0"

1 1ST LEVEL FLOOR PLAN - NO SHADING
SCALE: 1/8" = 1'-0"

SHADING KEY	
	PROPOSED PRIVATE STORAGE USE
	PROPOSED OFFICE USE
	PROPOSED ACCESSORY USE
	PROPOSED RESIDENTIAL USE
	PROPOSED WAREHOUSE USE
	STAIRWELL

Unit 14	Level 1	Garage	700
	Level 1	Residential	475
Unit 14	Level 2	Accessory	451
	Level 2	Residential	455
Unit 14	Level 3	Residential	975

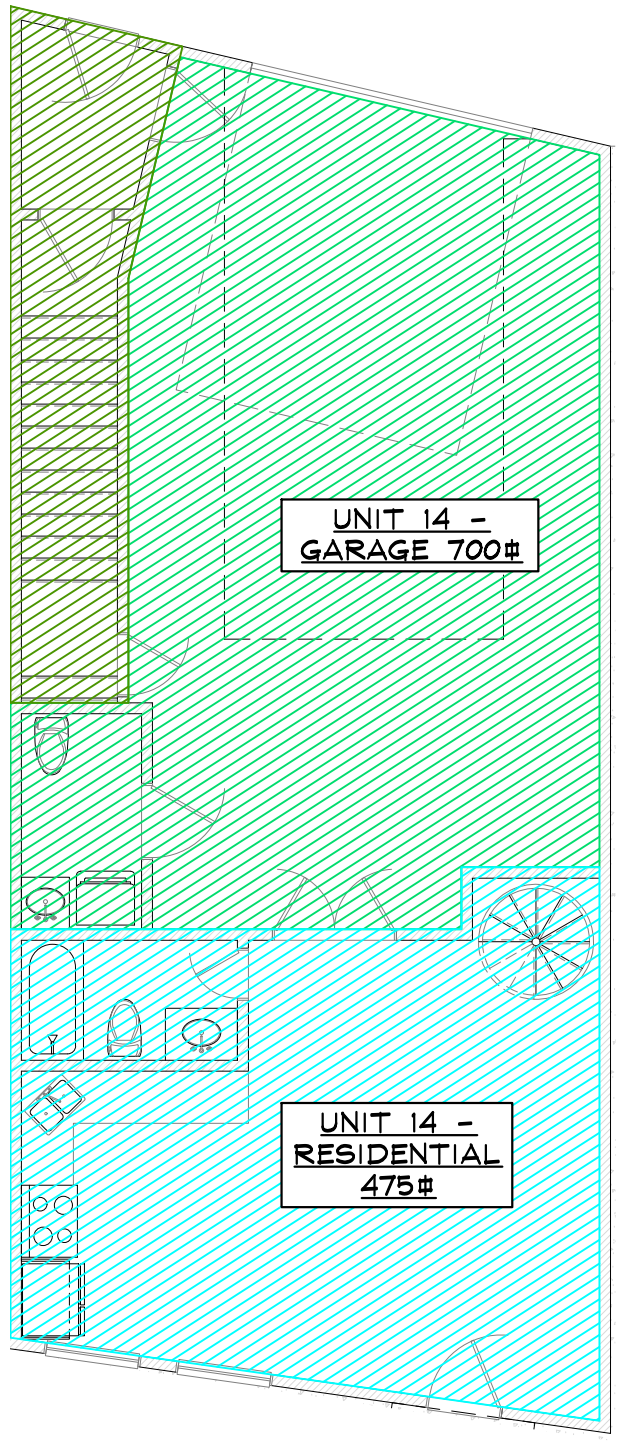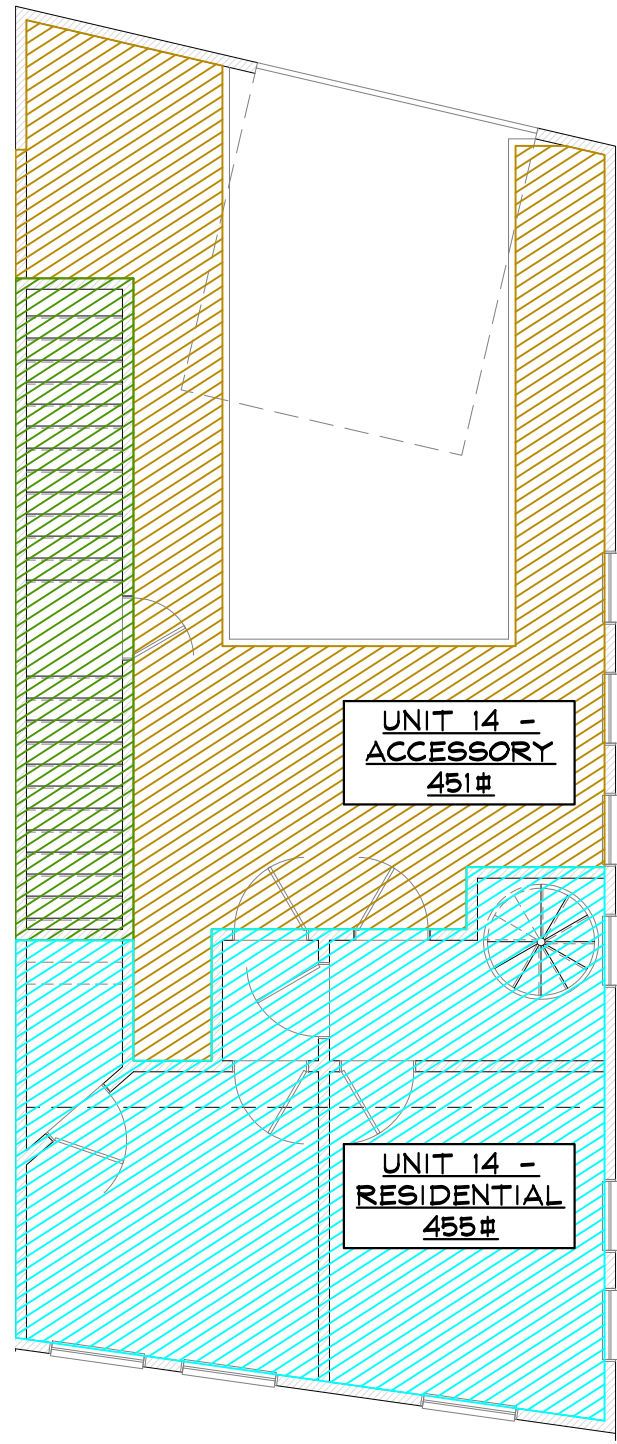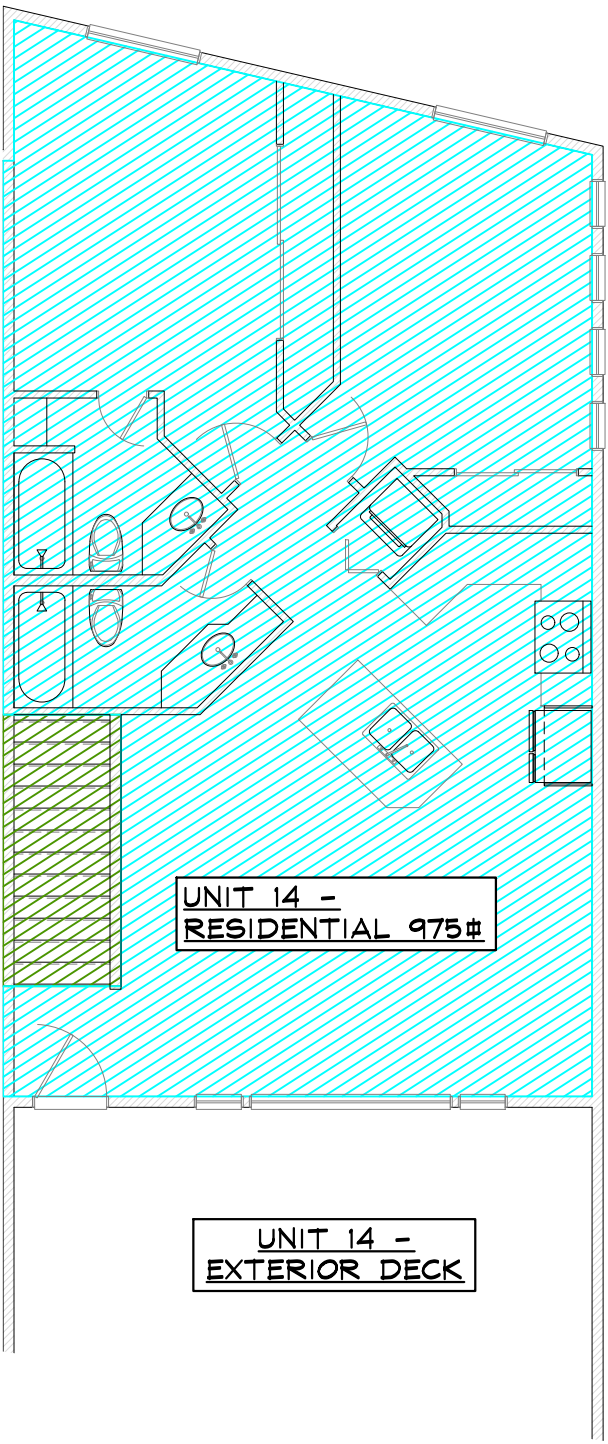

6 1ST LEVEL FLOOR PLAN - USE SHADING
SCALE: 1/8" = 1'-0"

4 2ND LEVEL FLOOR PLAN - USE SHADING
SCALE: 1/8" = 1'-0"

2 1ST LEVEL FLOOR PLAN - USE SHADING
SCALE: 1/8" = 1'-0"

NOT FOR
CONSTRUCTION



RFP BUILDING 4 TENANT FINISH
1920 BRIDGE LANE
STEAMBOAT SPRINGS, COLORADO
A TENANT FINISH FOR:
RIVER FRONT PARK HOA

ISSUE DATES

02 : 07 : 24 REVIEW
XX : XX : 24 BY

DRAWN BY: RPM
REVIEWED BY: CWM
PROJECT # 21099

UNIT 14 PROPOSED
FLOOR PLANS

UNIT 14