
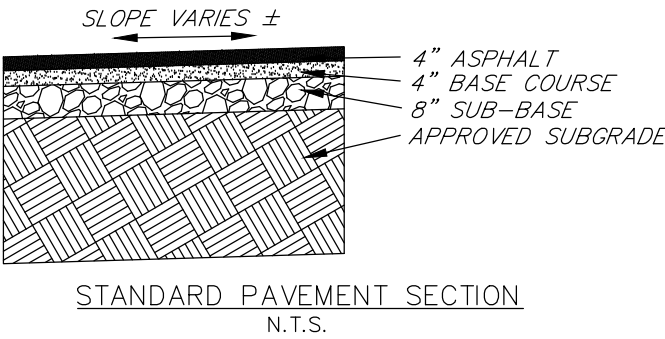
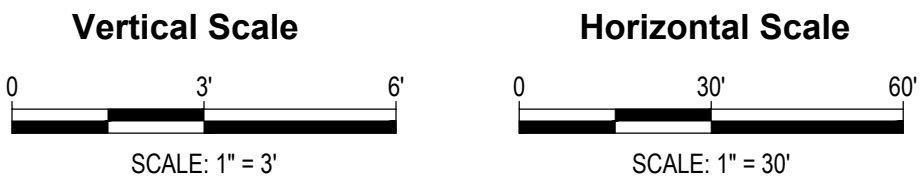
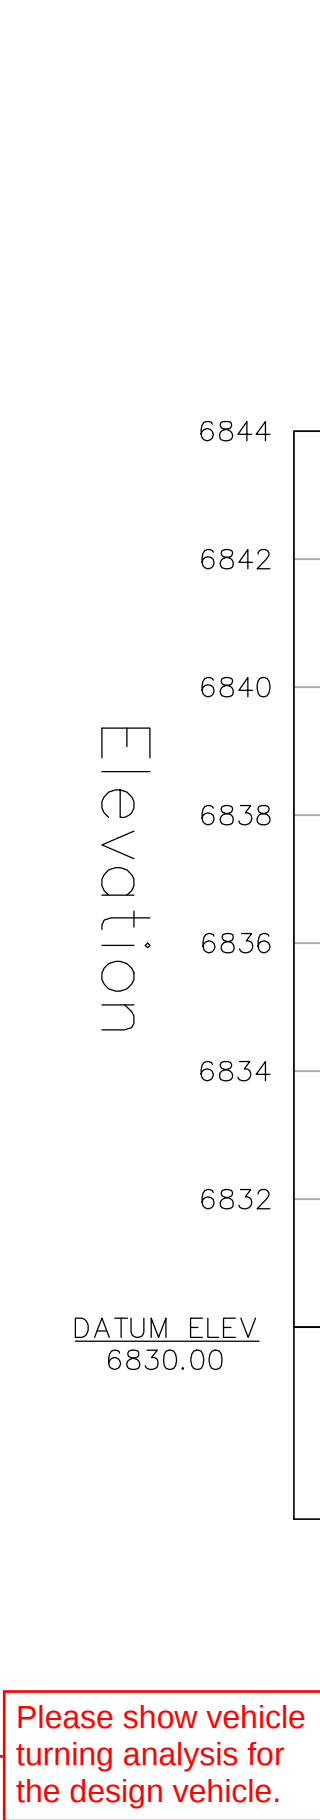
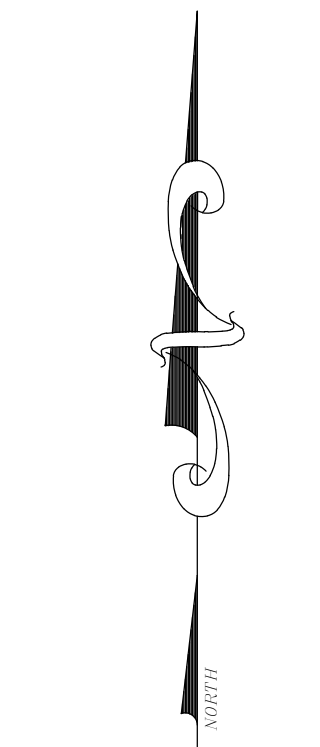


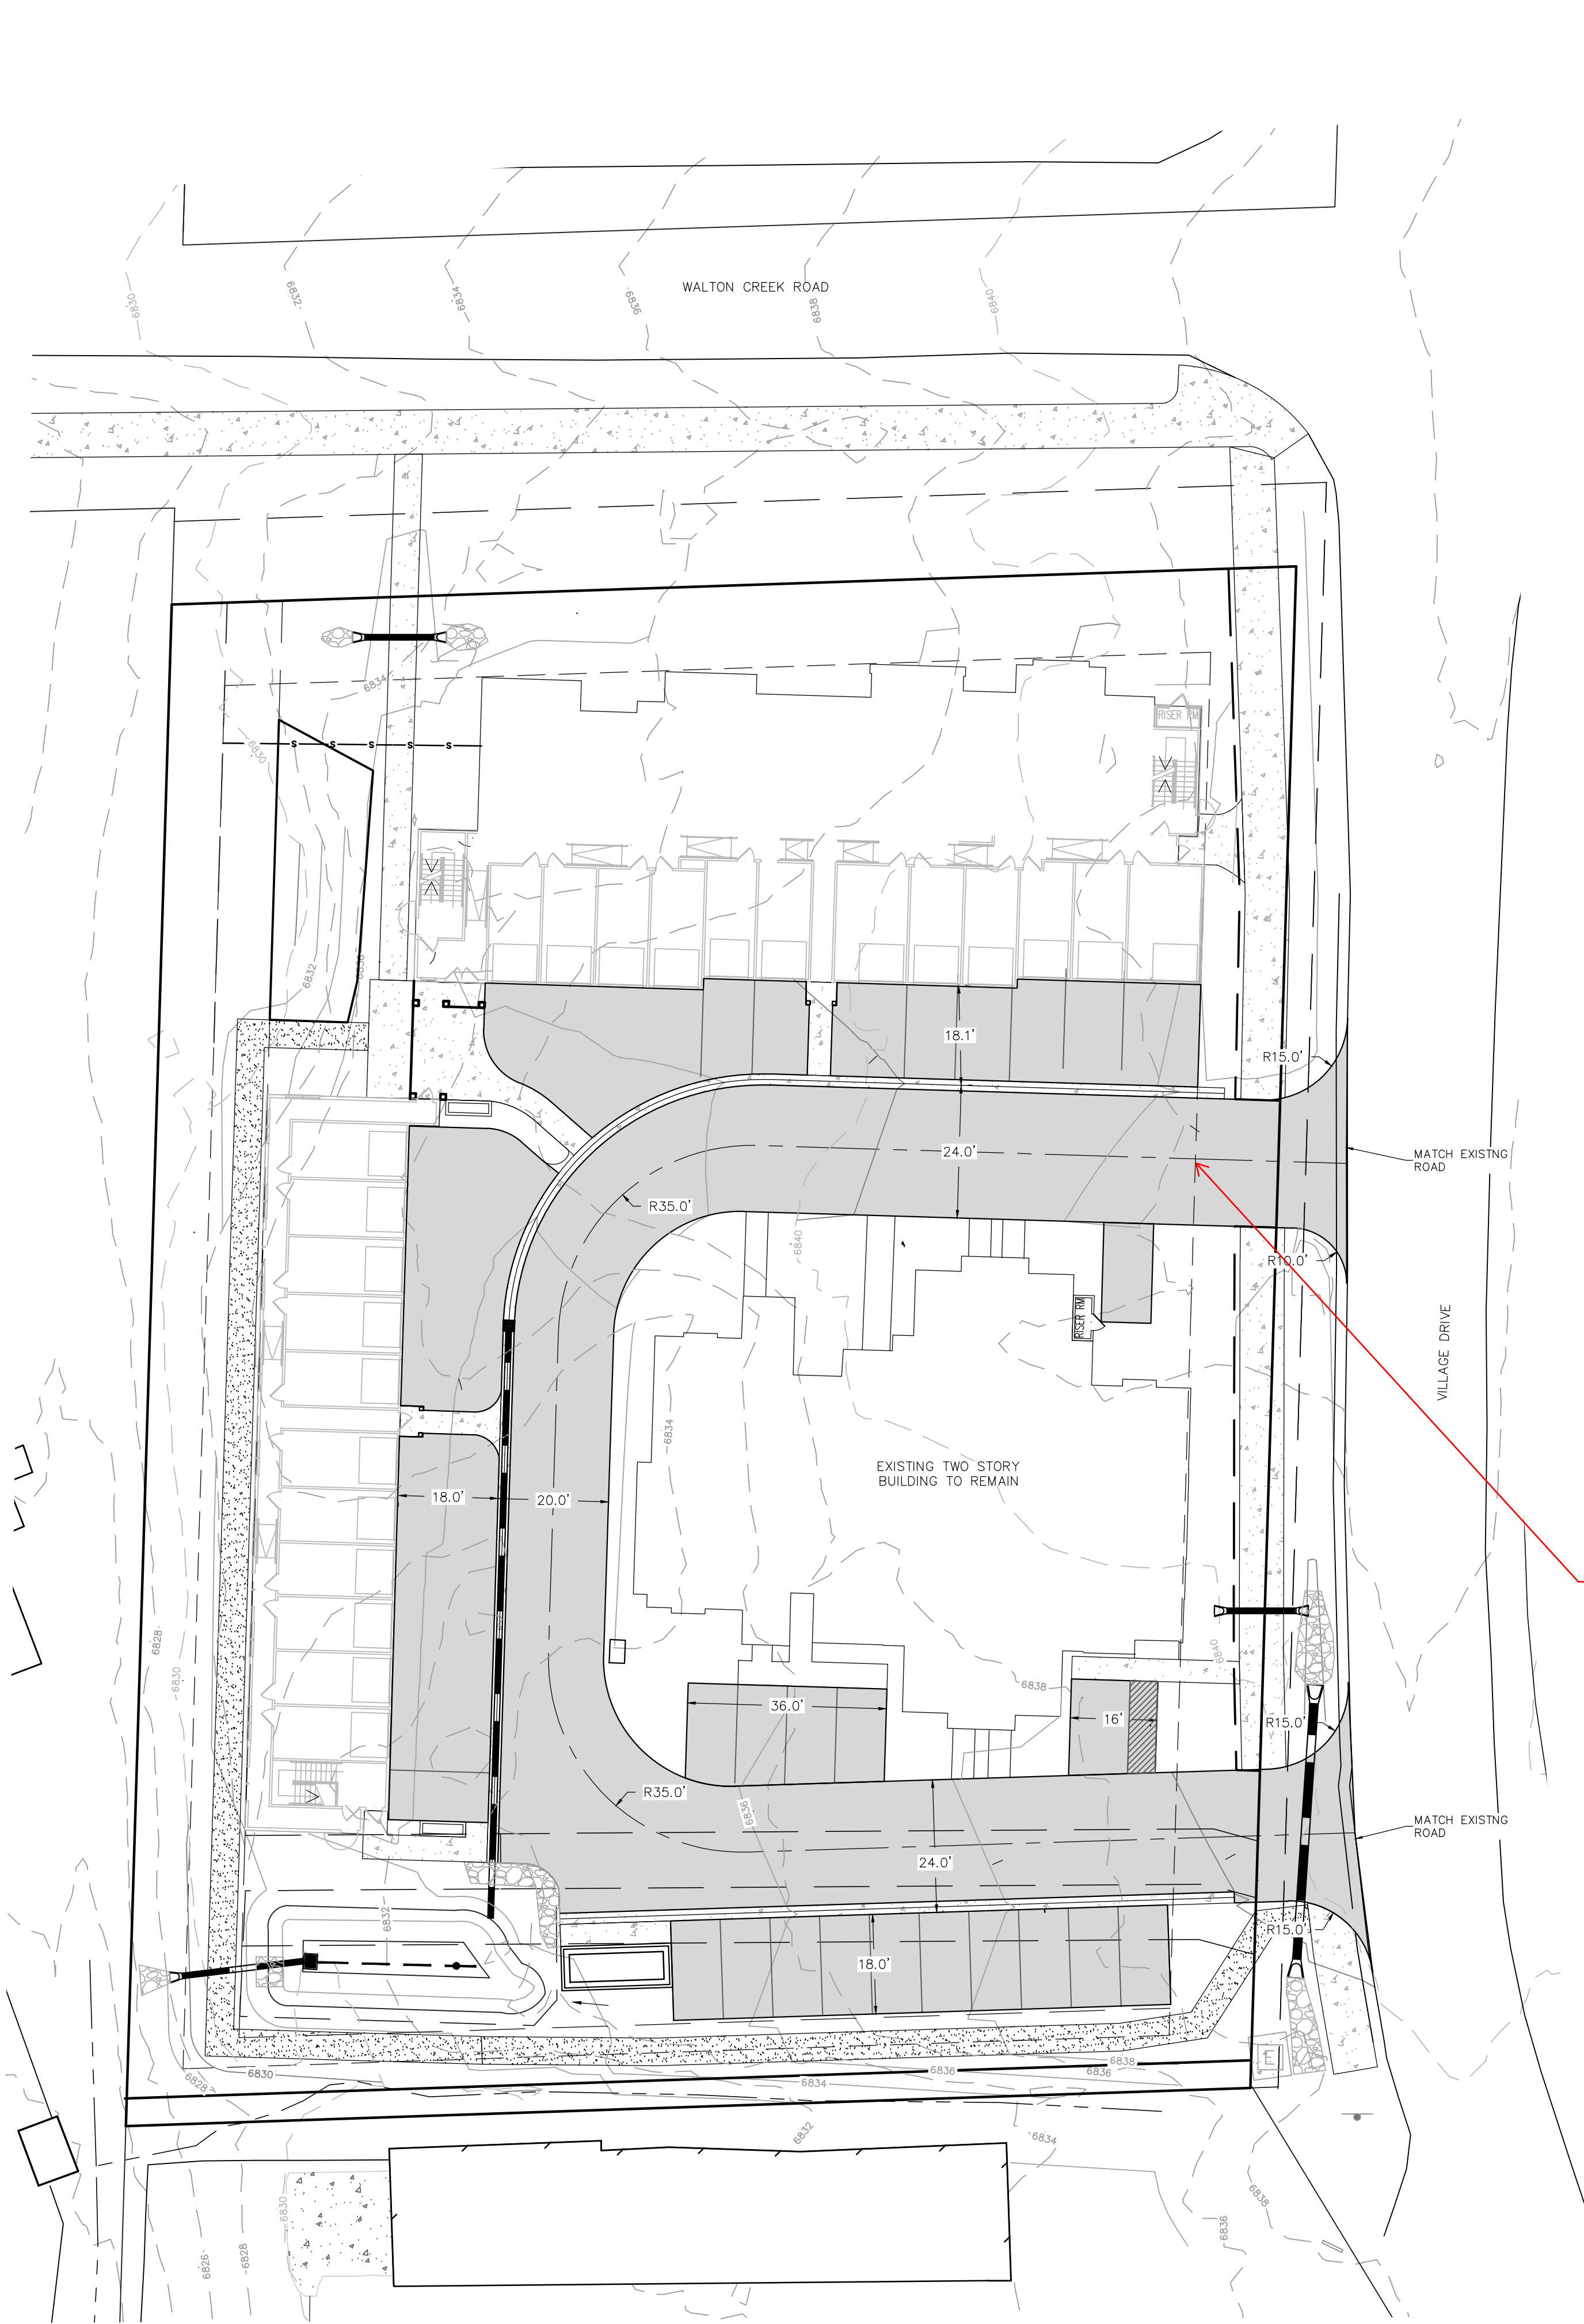

Please show vehicle turning analysis for the design vehicle.

440 S. Lincoln Ave, Suite 4A
P.O. Box 775966
Steamboat Springs, CO 80487
(970)-871-6772
www.fourpointse.com

INT	MDM

REVISIONS	DRT REVIEW AND RESPONSE

No.	DATE
1	5/27/2024

VILLAGE DRIVE APARTMENTS
2955 VILLAGE DRIVE
LOT A AND LOT B
MT. OFFICE PARK
SUBDIVISION

Horizontal Scale
0 20' 40'
SCALE: 1" = 20'

Contour Interval = 2 ft
DATE: 5-28-2024
JOB #: 2033-004
DRAWN BY: MDM
DESIGN BY: MDM
REVIEW BY: MDM

IF THIS DRAWING IS PRESENTED IN A
FORMAT OTHER THAN A4 X 36", THE
GRAPHIC SCALE SHOULD BE UTILIZED.

DRAWING:
**ROADWAY PLAN &
PROFILE**

SHEET #
C5