



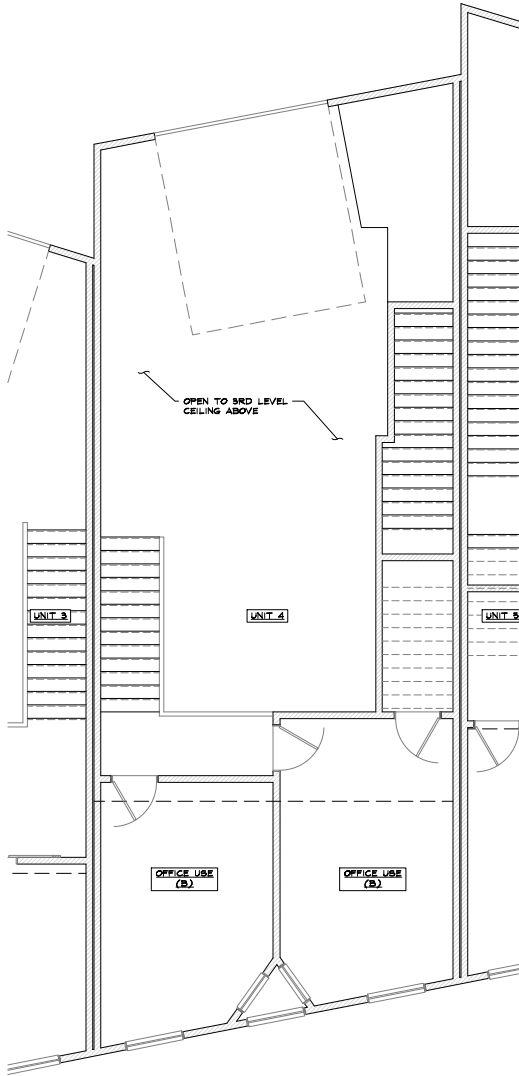

2 UNIT 4 2ND LEVEL FLOOR PLAN

SCALE: $\frac{1}{4}" = 1'-0"$

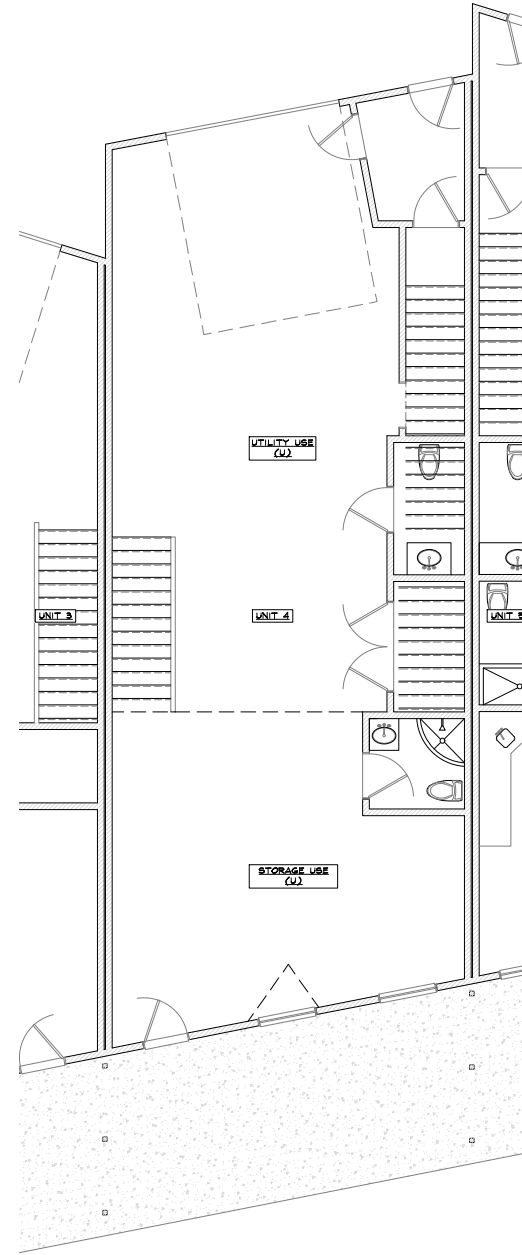

1 UNIT 4 1ST LEVEL FLOOR PLAN



SCALE: $\frac{1}{4}" = 1'-0"$

NOT FOR
CONSTRUCTION

SEAD
STEAMBOAT ENGINEERING AND DESIGN, INC.
2740 Acme Lane Suite "E" Steamboat Springs, CO 80487
Phone: 970.226.1100
E-mail: jake@seadinc.com

RFP BUILDING 3 TENANT FINISH
1800 BRIDGE LANE
STEAMBOAT SPRINGS, COLORADO
A TENANT FINISH FOR:
RIVER FRONT PARK HOA

ISSUE DATES
NOV 18 2022 AS-BUILT
NOV 18 2022 AS-BUILT

DRAWN BY: RPM
REVIEWED BY: CMH
PROJECT # 2109H

UNIT 4 FLOOR
PLANS

A-6