


PROJECT BENCHMARK:
RECOVERED NO. 5 REBAR W/
ALUMINUM CAP STAMPED
"LGI PLS 38569"
FLUSH W/ GROUND
EL = 6715.97
EASTING: 2827953.45
NORTHING: 1423836.76

RECOVERED NO. 5 REBAR W/
YELLOW PLASTIC CAP STAMPED
"DAD"
FLUSH W/ GROUND

PROPERTY DESCRIPTION:
RIVER HOUSE CONDOMINIUM, A CONDOMINIUM
LOCATED IN A PORTION OF LOTS 1, 2, AND 3,
BLOCK 12 AND OAK STREET, TOWN OF
STEAMBOAT SPRINGS, IN THE SOUTHWEST 1/4
OF SECTION 8, TOWNSHIP 6 NORTH, RANGE 84
WEST OF THE 6TH P.M., LOCATED IN THE CITY OF
STEAMBOAT SPRINGS, ROUTT COUNTY,
COLORADO CONTAINING +/- 0.23 ACRES.

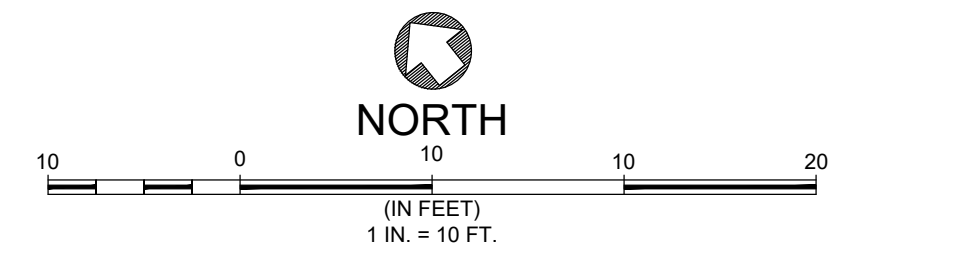

EXISTING CONDITIONS LEGEND:

PROPERTY BOUNDARY	---
ADJACENT PROPERTY BOUNDARY	---
EASEMENT	---
SECTION LINE	---
CENTERLINE	---
PROPERTY MONUMENT	○
SECTION CORNER	●
BUILDING	▭
ROOF LINE/OVERHANG	---
DECK	---
WALL	---
FENCE	---
MAJOR CONTOUR	---
MINOR CONTOUR	---
ASPHALT	---
CONCRETE	---
GRAVEL	---
SIGN	---
SANITARY SEWER LINE MARKER	○
MANHOLE AND CLEANOUT	○
SEPTIC TANK LID AND VENT PIPE	○
WATER LINE MARKER, FIRE HYDRANT	○
GATE VALVE, CURB STOP & METER	○
FIRE DEPT. CONNECTION, YARD HYDRANT,	○
VENT PIPE, WATER MANHOLE AND WELL	○
GAS LINE MARKER, VALVE, MANHOLE/VAULT,	○
METER AND SHUTOFF	○
PROPANE TANK (BURIED)	○
CABLE LINE MARKER, VAULT AND PEDESTAL	○
DUCT BANK	---
SATELLITE DISH	○
FIBER OPTIC LINE MARKER, VAULT & PEDESTAL	○
TELEPHONE LINE MARKER, VAULT,	○
PEDESTAL AND MANHOLE	○
ELECTRIC LINE MARKER, TRANSFORMER,	○
METER AND SECONDARY PEDESTAL	○
ELECTRIC MANHOLE, OUTLET,	○
GENERATOR AND JUNCTION BOX	○
LIGHT POLE, STREET LIGHT, TRAFFIC SIGNAL	○
TRAFFIC CONTROL VAULT AND CABINET	○
OVERHEAD UTILITY LINE	---
GUY POLE, UTILITY POLE & GUY WIRE	○
EDGE OF WATER	---
DITCH/SWALE	---
CULVERT W/ END SECTIONS	---
STORM MANHOLE, MANHOLE INLET,	○
GRATE INLET AND CURB INLET	○
AIR CONDITIONER, MAILBOX, NEWSTAND,	○
TRASH CAN, MISC. MANHOLE	○
BOLLARD, BOLLARD W/LIGHT	○
FLAG POLE AND DELIMITER	○
STUMP, BOULDER AND IRRIGATION VALVE BOX	○
CONFEROUS AND DECIDUOUS TREE	○
(SCALED TO APPROXIMATE DRIPLINE)	
CONFEROUS AND DECIDUOUS SHRUB	○
(SCALED TO APPROXIMATE DRIPLINE)	

NOTES:

1. THIS MAP DOES NOT REPRESENT A MONUMENTED SURVEY. IT IS INTENDED ONLY TO DEPICT THE EXISTING CONDITIONS.
2. DATE OF LAST FIELD INSPECTION: AUGUST 14, 2024.
3. BASIS OF BEARINGS: THE EASTERLY LINE OF RIVER HOUSE CONDOMINIUM, BEING MONUMENTED AS SHOWN HEREON AND BEARING N38°36'52"E BASED ON THE COLORADO COORDINATE SYSTEM, NORTH ZONE, NAD83(2011).
4. THIS MAP DOES NOT CONSTITUTE A TITLE SEARCH BY LANDMARK CONSULTANTS, INC. TO DETERMINE OWNERSHIP OF THIS TRACT, VERIFY THE DESCRIPTIONS SHOWN, VERIFY THE COMPATIBILITY OF THIS DESCRIPTION WITH THAT OF ADJACENT TRACTS, OR VERIFY EASEMENTS OF RECORD. SURVEY PLAT NO. 2173 DATED DECEMBER 12, 2008 WAS RELIED UPON TO DETERMINE OWNERSHIP AND EASEMENTS OF RECORD SHOWN ON THIS MAP.
5. ANY PERSON WHO KNOWINGLY REMOVES, ALTERS OR DEFACES ANY PUBLIC LAND SURVEY MONUMENT OR LAND MONUMENT OR ACCESSORY, COMMITS A CLASS TWO (2) MISDEMEANOR PURSUANT TO STATE STATUTE 18-6-506, C.R.S.
6. THE MEASURED DISTANCES SHOWN HEREON ARE IN U.S. SURVEY FEET.
7. THE SUBJECT PROPERTY IS LOCATED WITHIN FLOODPLAIN ZONE AE, SPECIAL FLOOD HAZARDOUS AREAS SUBJECT TO INUNDATION BY THE 1% ANNUAL CHANCE FLOOD EVENT (BASE FLOOD ELEVATIONS DETERMINED), WITHIN ZONE FLOODWAY ZONE AE, THE CHANNEL OF A STREAM PLUS ANY ADJACENT FLOODPLAIN AREAS THAT MUST BE KEPT FREE OF ENCROACHMENT SO THAT THE 1% ANNUAL CHANCE FLOOD CAN BE CARRIED WITHOUT SUBSTANTIAL INCREASES IN FLOOD HEIGHTS, AND WITHIN ZONE X, AREAS DETERMINED TO BE OUTSIDE THE 0.2% ANNUAL CHANCE FLOODPLAIN AS DETERMINED BY THE F.E.M.A. FLOOD INSURANCE RATE MAP NUMBER 081070287D, WITH AN EFFECTIVE DATE OF FEBRUARY 4, 2005.
8. UNDERGROUND IMPROVEMENTS: LOCATIONS FOR UNDERGROUND IMPROVEMENTS ARE SHOWN HEREON PER ONE OR MORE OF THE FOLLOWING: VISIBLE AND APPARENT SURFACE EVIDENCE, AS-BUILT DRAWINGS PROVIDED BY OTHERS, MARKINGS PROVIDED BY COLORADO 811 ONE CALL SERVICES, PRIVATE UNDERGROUND LOCATING SERVICES, OR GIS INFORMATION. ANY METHOD OF SHOWING UNDERGROUND IMPROVEMENTS, OR ANY COMBINATION THEREOF, MAY NOT PROVIDE COMPLETE AND ACCURATE LOCATIONS FOR ALL UNDERGROUND IMPROVEMENTS. IF ACCURATE LOCATIONS FOR UNDERGROUND IMPROVEMENTS ARE REQUIRED, THEY WILL HAVE TO BE VERIFIED BY FIELD POT-HOLING OF THE IMPROVEMENTS. LANDMARK CONSULTANTS, INC. AND THE SURVEYOR OR ENGINEERS OF RECORD SHALL NOT BE LIABLE FOR THE FAILURE TO ACCURATELY AND COMPLETELY DEPICT THE LOCATIONS OF UNDERGROUND IMPROVEMENTS.
9. ALL REFERENCES HEREON TO BOOKS, PAGES, FILES AND RECEPTION NUMBERS ARE TO PUBLIC DOCUMENTS FILED IN THE RECORDS OF ROUTT COUNTY, COLORADO.
10. THE SUBJECT PROPERTY CONTAINS A CALCULATED AREA OF 10,019 SQUARE FEET OR 0.23 ACRES.
11. POSTED ADDRESS: 135 11TH STREET
12. PROJECT BENCHMARK: A RECOVERED NO. 5 REBAR W/ ALUMINUM CAP STAMPED "LGI PLS 38569" FLUSH W/ GROUND, HAVING AN ELEVATION OF 6715.97' BASED ON THE NORTH AMERICAN VERTICAL DATUM OF 1988 (NAVD88) AS SHOWN HEREON.
13. CONTOUR INTERVAL = 1 FOOT

PROPERTY DESCRIPTION:
RIVER HOUSE CONDOMINIUM, A CONDOMINIUM LOCATED IN A PORTION OF LOTS 1, 2, AND 3, BLOCK 12 AND OAK STREET, TOWN OF STEAMBOAT SPRINGS, IN THE SOUTHWEST 1/4 OF SECTION 8, TOWNSHIP 6 NORTH, RANGE 84 WEST OF THE 6TH P.M., LOCATED IN THE CITY OF STEAMBOAT SPRINGS, ROUTT COUNTY, COLORADO CONTAINING +/- 0.23 ACRES.



LANDMARK CONSULTANTS, INC.
CIVIL ENGINEERS | SURVEYORS
141 9th Street - P.O. Box 77494, Steamboat Springs, CO 80477
(970) 871-9494 - www.LANDMARK-CO.com

These drawings are instruments of service provided by Landmark Consultants, Inc. and are not to be used for any type of construction or contracting unless signed and sealed by a Professional Engineer in the employ of Landmark Consultants, Inc.

COLORADO LICENSED SURVEYOR
18972
2025
FOR APPROVAL NOT FOR CONSTRUCTION

NO.	DATE:	BY:	DISCRESSION:
1	10-30-2025	RS	ADDRESS DRT COMMENTS
PROJECT:	2725-001		
DATE:	08/25/2025		
CONTRACT:	RCS		
EMAIL:	rs@landmark-co.com		

MARSHALL HOUSE
EXISTING CONDITIONS PLAN

DRAWING FILENAME: P:\2725-001\DWG\2725-001-C002-Existing Conditions.dwg; LAYOUT NAME: C002; DATE: 08/25/2025; 1:30pm DAD (P) (M) (R) (S) (T) (U) (V) (W) (X) (Y) (Z) (AA) (AB) (AC) (AD) (AE) (AF) (AG) (AH) (AI) (AJ) (AK) (AL) (AM) (AN) (AO) (AP) (AQ) (AR) (AS) (AT) (AU) (AV) (AW) (AX) (AY) (AZ) (BA) (BB) (BC) (BD) (BE) (BF) (BG) (BH) (BI) (BJ) (BK) (BL) (BM) (BN) (BO) (BP) (BQ) (BR) (BS) (BT) (BU) (BV) (BW) (BX) (BY) (BZ) (CA) (CB) (CC) (CD) (CE) (CF) (CG) (CH) (CI) (CJ) (CK) (CL) (CM) (CN) (CO) (CP) (CQ) (CR) (CS) (CT) (CU) (CV) (CW) (CX) (CY) (CZ) (DA) (DB) (DC) (DD) (DE) (DF) (DG) (DH) (DI) (DJ) (DK) (DL) (DM) (DN) (DO) (DP) (DQ) (DR) (DS) (DT) (DU) (DV) (DW) (DX) (DY) (DZ) (EA) (EB) (EC) (ED) (EE) (EF) (EG) (EH) (EI) (EJ) (EK) (EL) (EM) (EN) (EO) (EP) (EQ) (ER) (ES) (ET) (EU) (EV) (EW) (EX) (EY) (EZ) (FA) (FB) (FC) (FD) (FE) (FF) (FG) (FH) (FI) (FJ) (FK) (FL) (FM) (FN) (FO) (FP) (FQ) (FR) (FS) (FT) (FU) (FV) (FW) (FX) (FY) (FZ) (GA) (GB) (GC) (GD) (GE) (GF) (GG) (GH) (GI) (GJ) (GK) (GL) (GM) (GN) (GO) (GP) (GQ) (GR) (GS) (GT) (GU) (GV) (GW) (GX) (GY) (GZ) (HA) (HB) (HC) (HD) (HE) (HF) (HG) (HH) (HI) (HJ) (HK) (HL) (HM) (HN) (HO) (HP) (HQ) (HR) (HS) (HT) (HU) (HV) (HW) (HX) (HY) (HZ) (IA) (IB) (IC) (ID) (IE) (IF) (IG) (IH) (II) (IJ) (IK) (IL) (IM) (IN) (IO) (IP) (IQ) (IR) (IS) (IT) (IU) (IV) (IW) (IX) (IY) (IZ) (JA) (JB) (JC) (JD) (JE) (JF) (JG) (JH) (JI) (JJ) (JK) (JL) (JM) (JN) (JO) (JP) (JQ) (JR) (JS) (JT) (JU) (JV) (JW) (JX) (JY) (JZ) (KA) (KB) (KC) (KD) (KE) (KF) (KG) (KH) (KI) (KJ) (KK) (KL) (KM) (KN) (KO) (KP) (KQ) (KR) (KS) (KT) (KU) (KV) (KW) (KX) (KY) (KZ) (LA) (LB) (LC) (LD) (LE) (LF) (LG) (LH) (LI) (LJ) (LK) (LL) (LM) (LN) (LO) (LP) (LQ) (LR) (LS) (LT) (LU) (LV) (LW) (LX) (LY) (LZ) (MA) (MB) (MC) (MD) (ME) (MF) (MG) (MH) (MI) (MJ) (MK) (ML) (MM) (MN) (MO) (MP) (MQ) (MR) (MS) (MT) (MU) (MV) (MW) (MX) (MY) (MZ) (NA) (NB) (NC) (ND) (NE) (NF) (NG) (NH) (NI) (NJ) (NK) (NL) (NM) (NO) (NP) (NQ) (NR) (NS) (NT) (NU) (NV) (NW) (NX) (NY) (NZ) (OA) (OB) (OC) (OD) (OE) (OF) (OG) (OH) (OI) (OJ) (OK) (OL) (OM) (ON) (OO) (OP) (OQ) (OR) (OS) (OT) (OU) (OV) (OW) (OX) (OY) (OZ) (PA) (PB) (PC) (PD) (PE) (PF) (PG) (PH) (PI) (PJ) (PK) (PL) (PM) (PN) (PO) (PP) (PQ) (PR) (PS) (PT) (PU) (PV) (PW) (PX) (PY) (PZ) (QA) (QB) (QC) (QD) (QE) (QF) (QG) (QH) (QI) (QJ) (QK) (QL) (QM) (QN) (QO) (QP) (QQ) (QR) (QS) (QT) (QU) (QV) (QW) (QX) (QY) (QZ) (RA) (RB) (RC) (RD) (RE) (RF) (RG) (RH) (RI) (RJ) (RK) (RL) (RM) (RN) (RO) (RP) (RQ) (RR) (RS) (RT) (RU) (RV) (RW) (RX) (RY) (RZ) (SA) (SB) (SC) (SD) (SE) (SF) (SG) (SH) (SI) (SJ) (SK) (SL) (SM) (SN) (SO) (SP) (SQ) (SR) (SS) (ST) (SU) (SV) (SW) (SX) (SY) (SZ) (TA) (TB) (TC) (TD) (TE) (TF) (TG) (TH) (TI) (TJ) (TK) (TL) (TM) (TN) (TO) (TP) (TQ) (TR) (TS) (TT) (TU) (TV) (TW) (TX) (TY) (TZ) (UA) (UB) (UC) (UD) (UE) (UF) (UG) (UH) (UI) (UJ) (UK) (UL) (UM) (UN) (UO) (UP) (UQ) (UR) (US) (UT) (UU) (UV) (UW) (UX) (UY) (UZ) (VA) (VB) (VC) (VD) (VE) (VF) (VG) (VH) (VI) (VJ) (VK) (VL) (VM) (VN) (VO) (VP) (VQ) (VR) (VS) (VT) (VU) (VW) (VX) (VY) (VZ) (WA) (WB) (WC) (WD) (WE) (WF) (WG) (WH) (WI) (WJ) (WK) (WL) (WM) (WN) (WO) (WP) (WQ) (WR) (WS) (WT) (WU) (WV) (WW) (WX) (WY) (WZ) (XA) (XB) (XC) (XD) (XE) (XF) (XG) (XH) (XI) (XJ) (XK) (XL) (XM) (XN) (XO) (XP) (XQ) (XR) (XS) (XT) (XU) (XV) (XW) (XX) (XY) (XZ) (YA) (YB) (YC) (YD) (YE) (YF) (YG) (YH) (YI) (YJ) (YK) (YL) (YM) (YN) (YO) (YP) (YQ) (YR) (YS) (YT) (YU) (YV) (YW) (YX) (YZ) (ZA) (ZB) (ZC) (ZD) (ZE) (ZF) (ZG) (ZH) (ZI) (ZJ) (ZK) (ZL) (ZM) (ZN) (ZO) (ZP) (ZQ) (ZR) (ZS) (ZT) (ZU) (ZV) (ZW) (ZX) (ZY) (ZZ)