

SUNDANCE PLAZA

**1 VICINITY PLAN**



BUILDING "C"  
SUNDANCE PLAZA  
THE EGG RESTAURANT


**2 SUNDANCE PLAZA ARIEL VIEW**



BUILDING "C"  
325 ANGLERS DRIVE  
THE EGG RESTAURANT

BUILDING "C"  
THE EGG RESTAURANT  
PATIO AREA

**3 BUILDING "C" ARIEL VIEW**

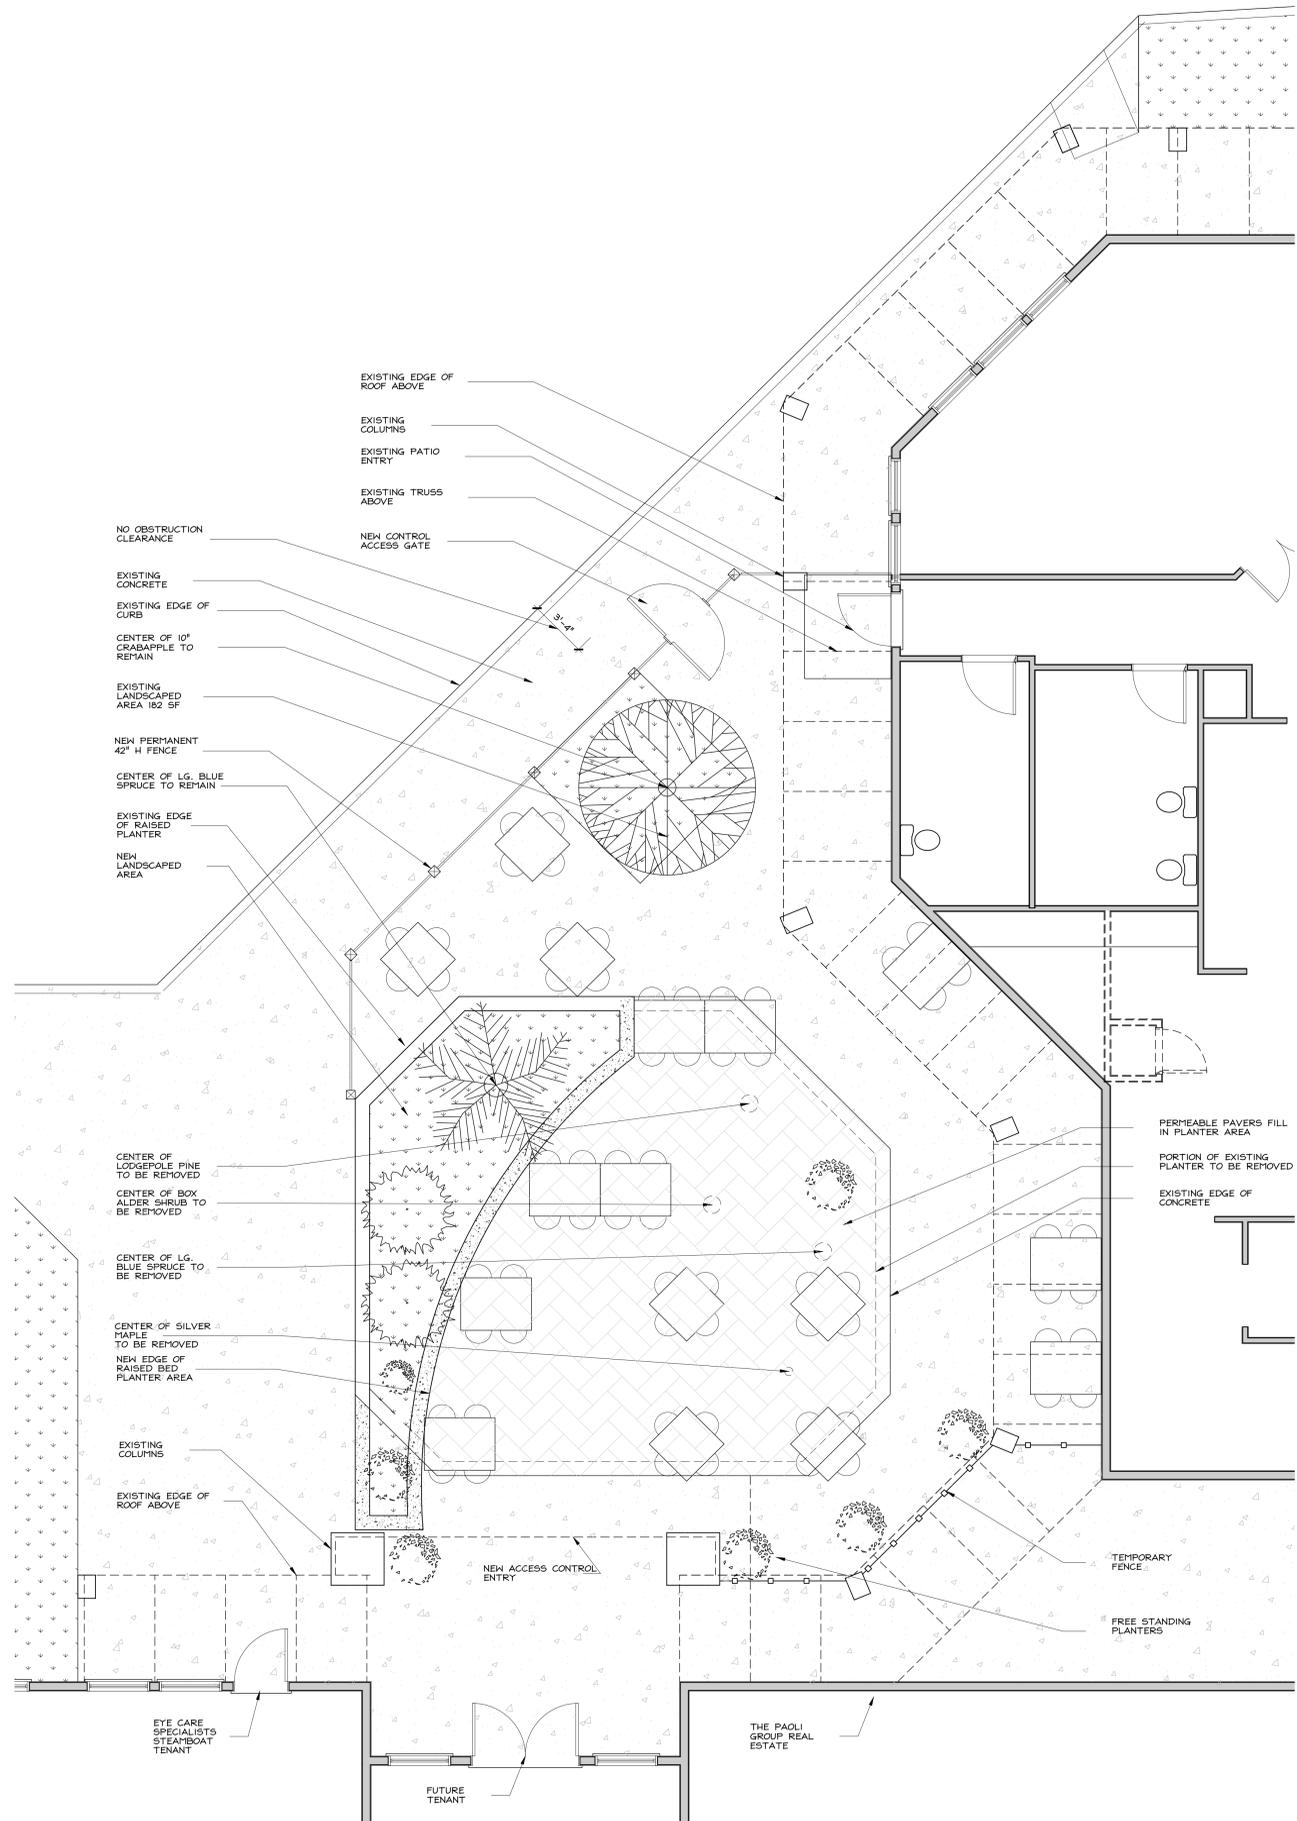

**4 PATIO LEVEL PLAN**

FIELD MEASURED DRAWING NOT A SURVEY

SCALE: 1/4" = 1'-0"

AS BUILT

The Egg  
325 Anglers Drive  
Steamboat Springs, CO  
Sunscope LLC

Drawn	Project Number	
SB	202522	
Checked	AD File Name (Number)	
SB		
Drawing Title		
Rev	Revisions	Date
Submitted Date	Drawing Number	
02/26/2026		
Last Date		
02/26/2026		