


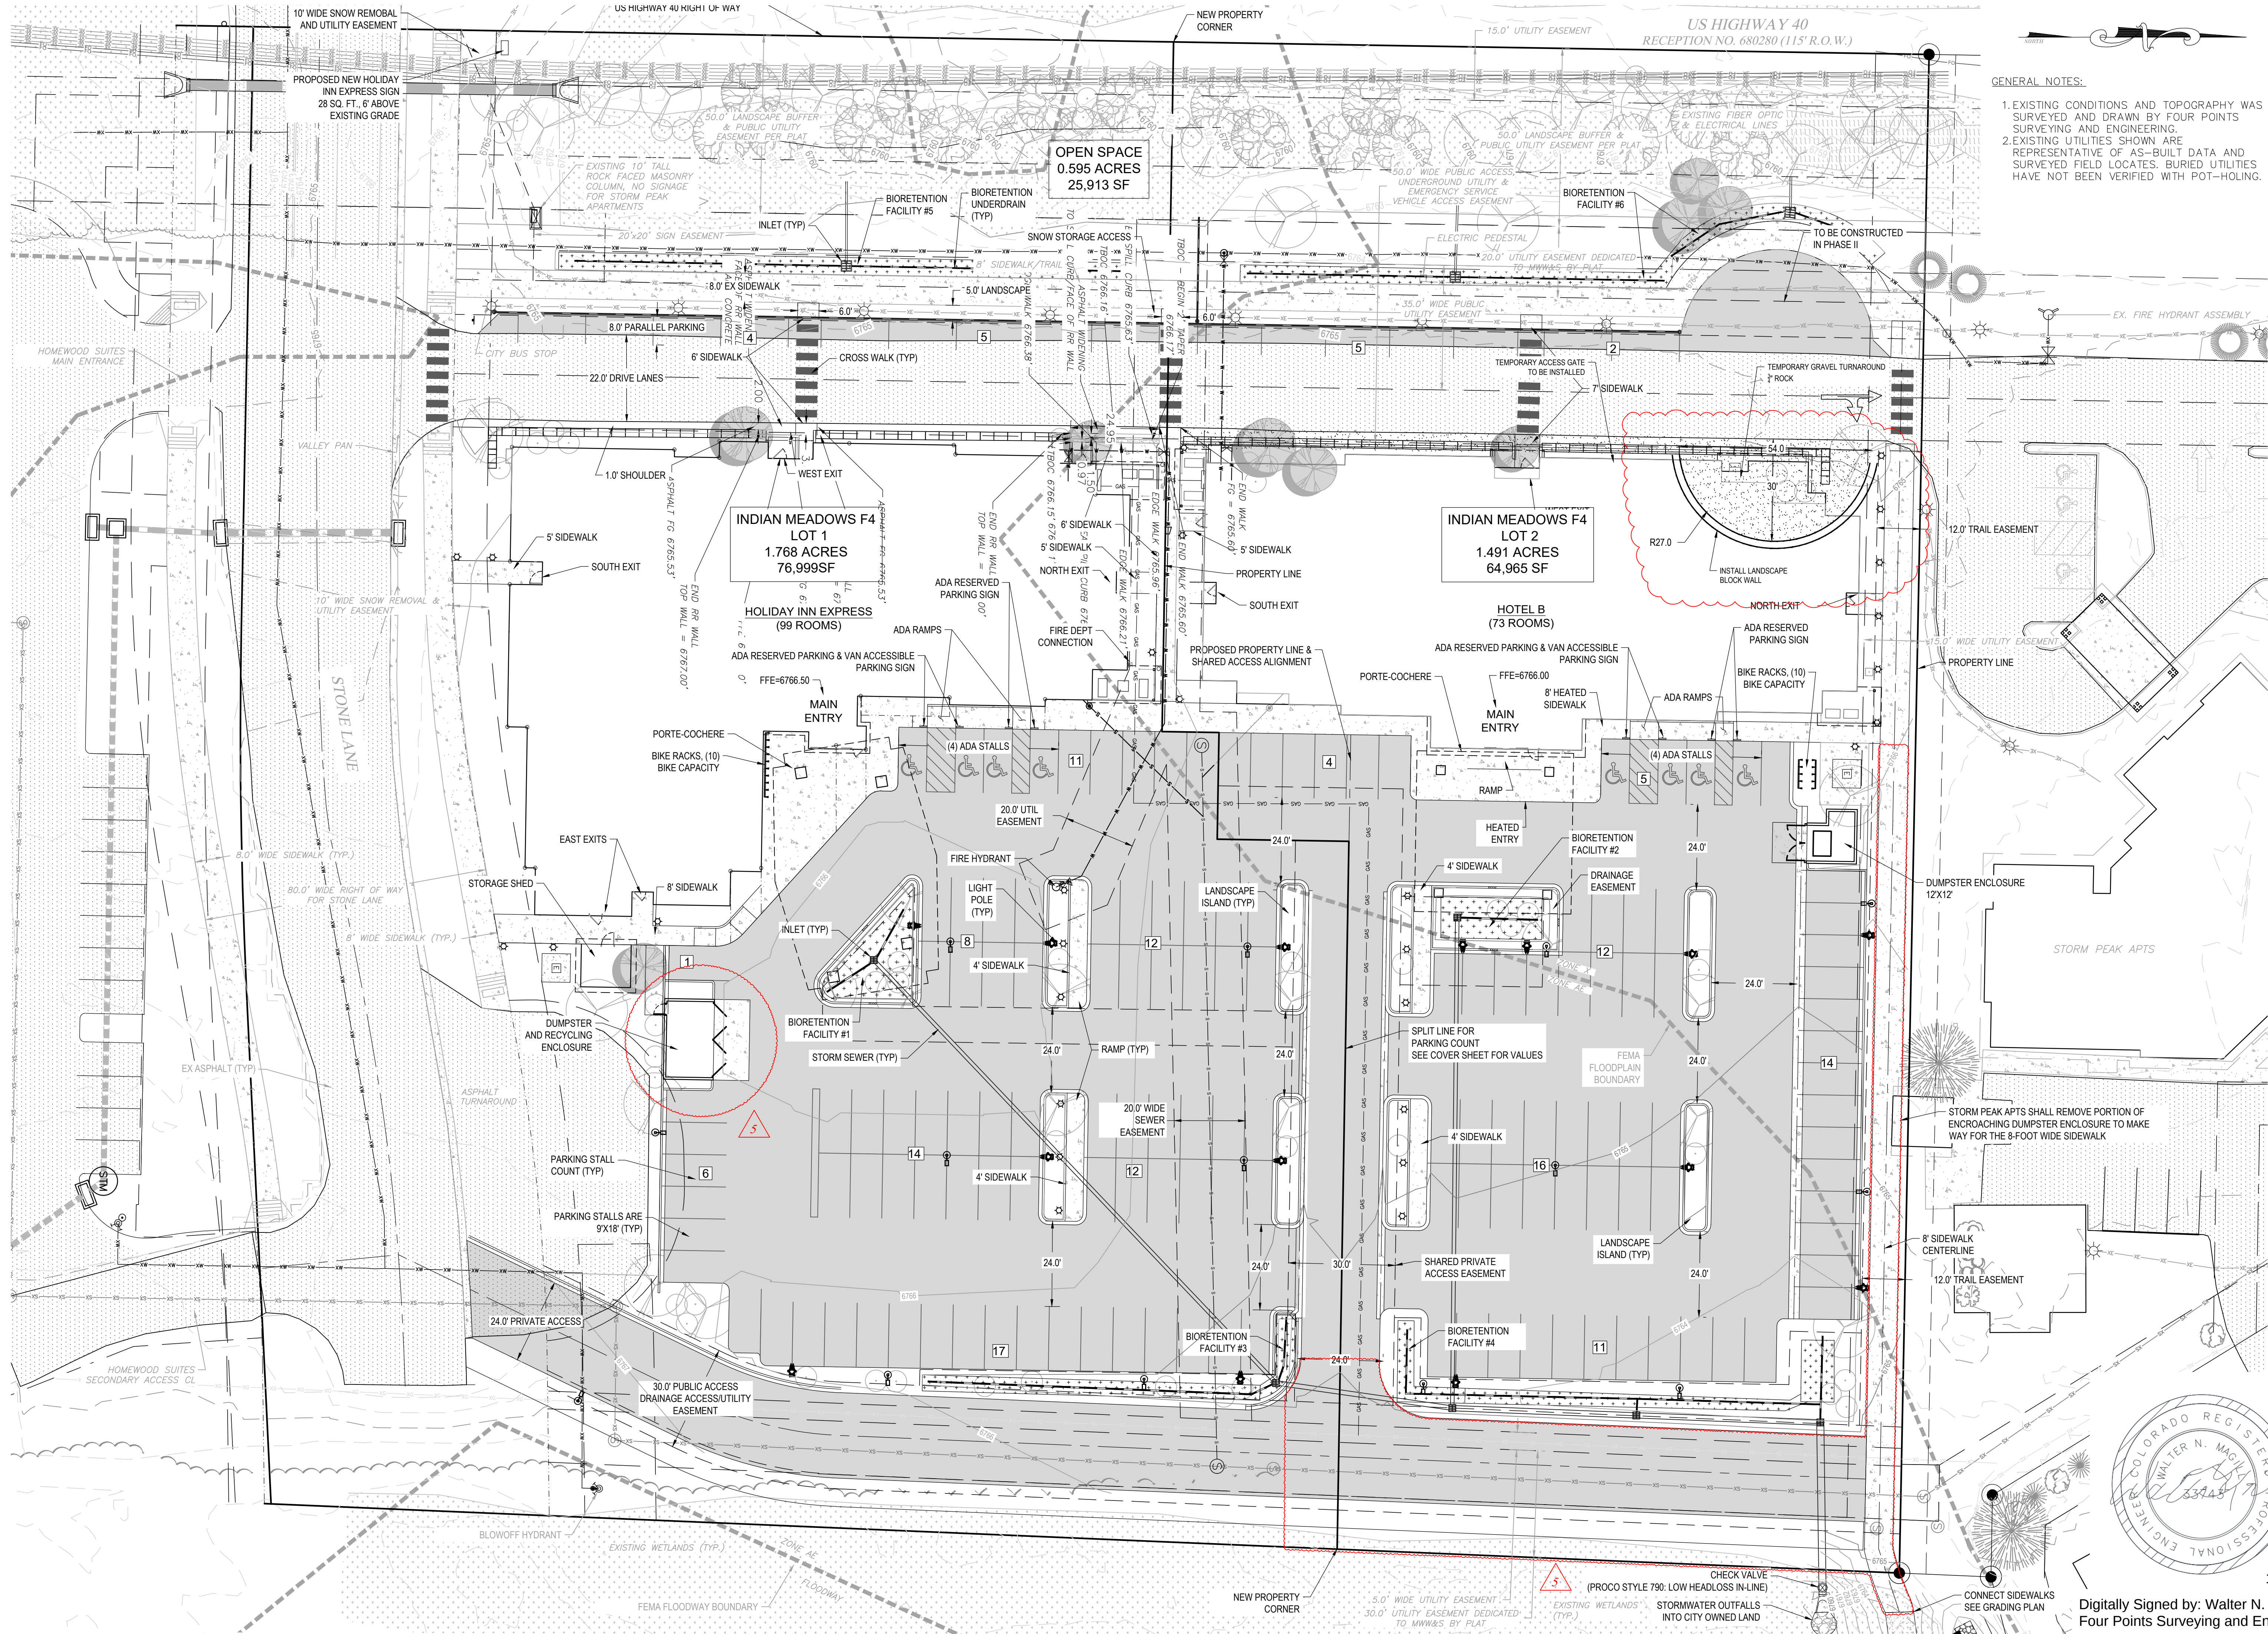

GENERAL NOTES:
1. EXISTING CONDITIONS AND TOPOGRAPHY WAS SURVEYED AND DRAWN BY FOUR POINTS SURVEYING AND ENGINEERING.
2. EXISTING UTILITIES SHOWN ARE REPRESENTATIVE OF AS-BUILT DATA AND SURVEYED FIELD LOCATES. BURIED UTILITIES HAVE NOT BEEN VERIFIED WITH POT-HOLING.

410 S. Lincoln Ave, Unit 15
P.O. Box 775966
Steamboat Springs, CO 80487
(970)-871-6772
www.fourpointssurveying.com

**HOLIDAY INN EXPRESS & HOTEL B
CONSTRUCTION PLANS**

**INDIAN MEADOWS F3 LOT NO. 4
LOTS 1 AND 2**

STEAMBOAT SPRINGS, CO 80487

HORIZONTAL SCALE

0 20' 40'

SCALE: 1" = 20'

CONTOUR INTERVAL = 1 FT


DATE: 06-30-2025
JOB #: 1448-005
DRAWN BY: DSC
DESIGN BY: RS
REVIEW BY: WNM

IF THIS DRAWING IS PRESENTED IN A
FORMAT OTHER THAN 24" X 36", THE
GRAPHIC SCALE SHOULD BE UTILIZED.

OVERALL SITE PLAN

HEET NO.

C3

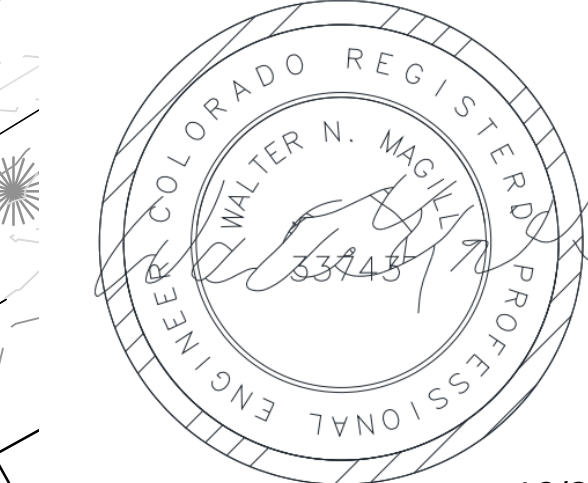

10/24/2025
Digitally Signed by: Walter N. Magill, P.E.
Four Points Surveying and Engineering