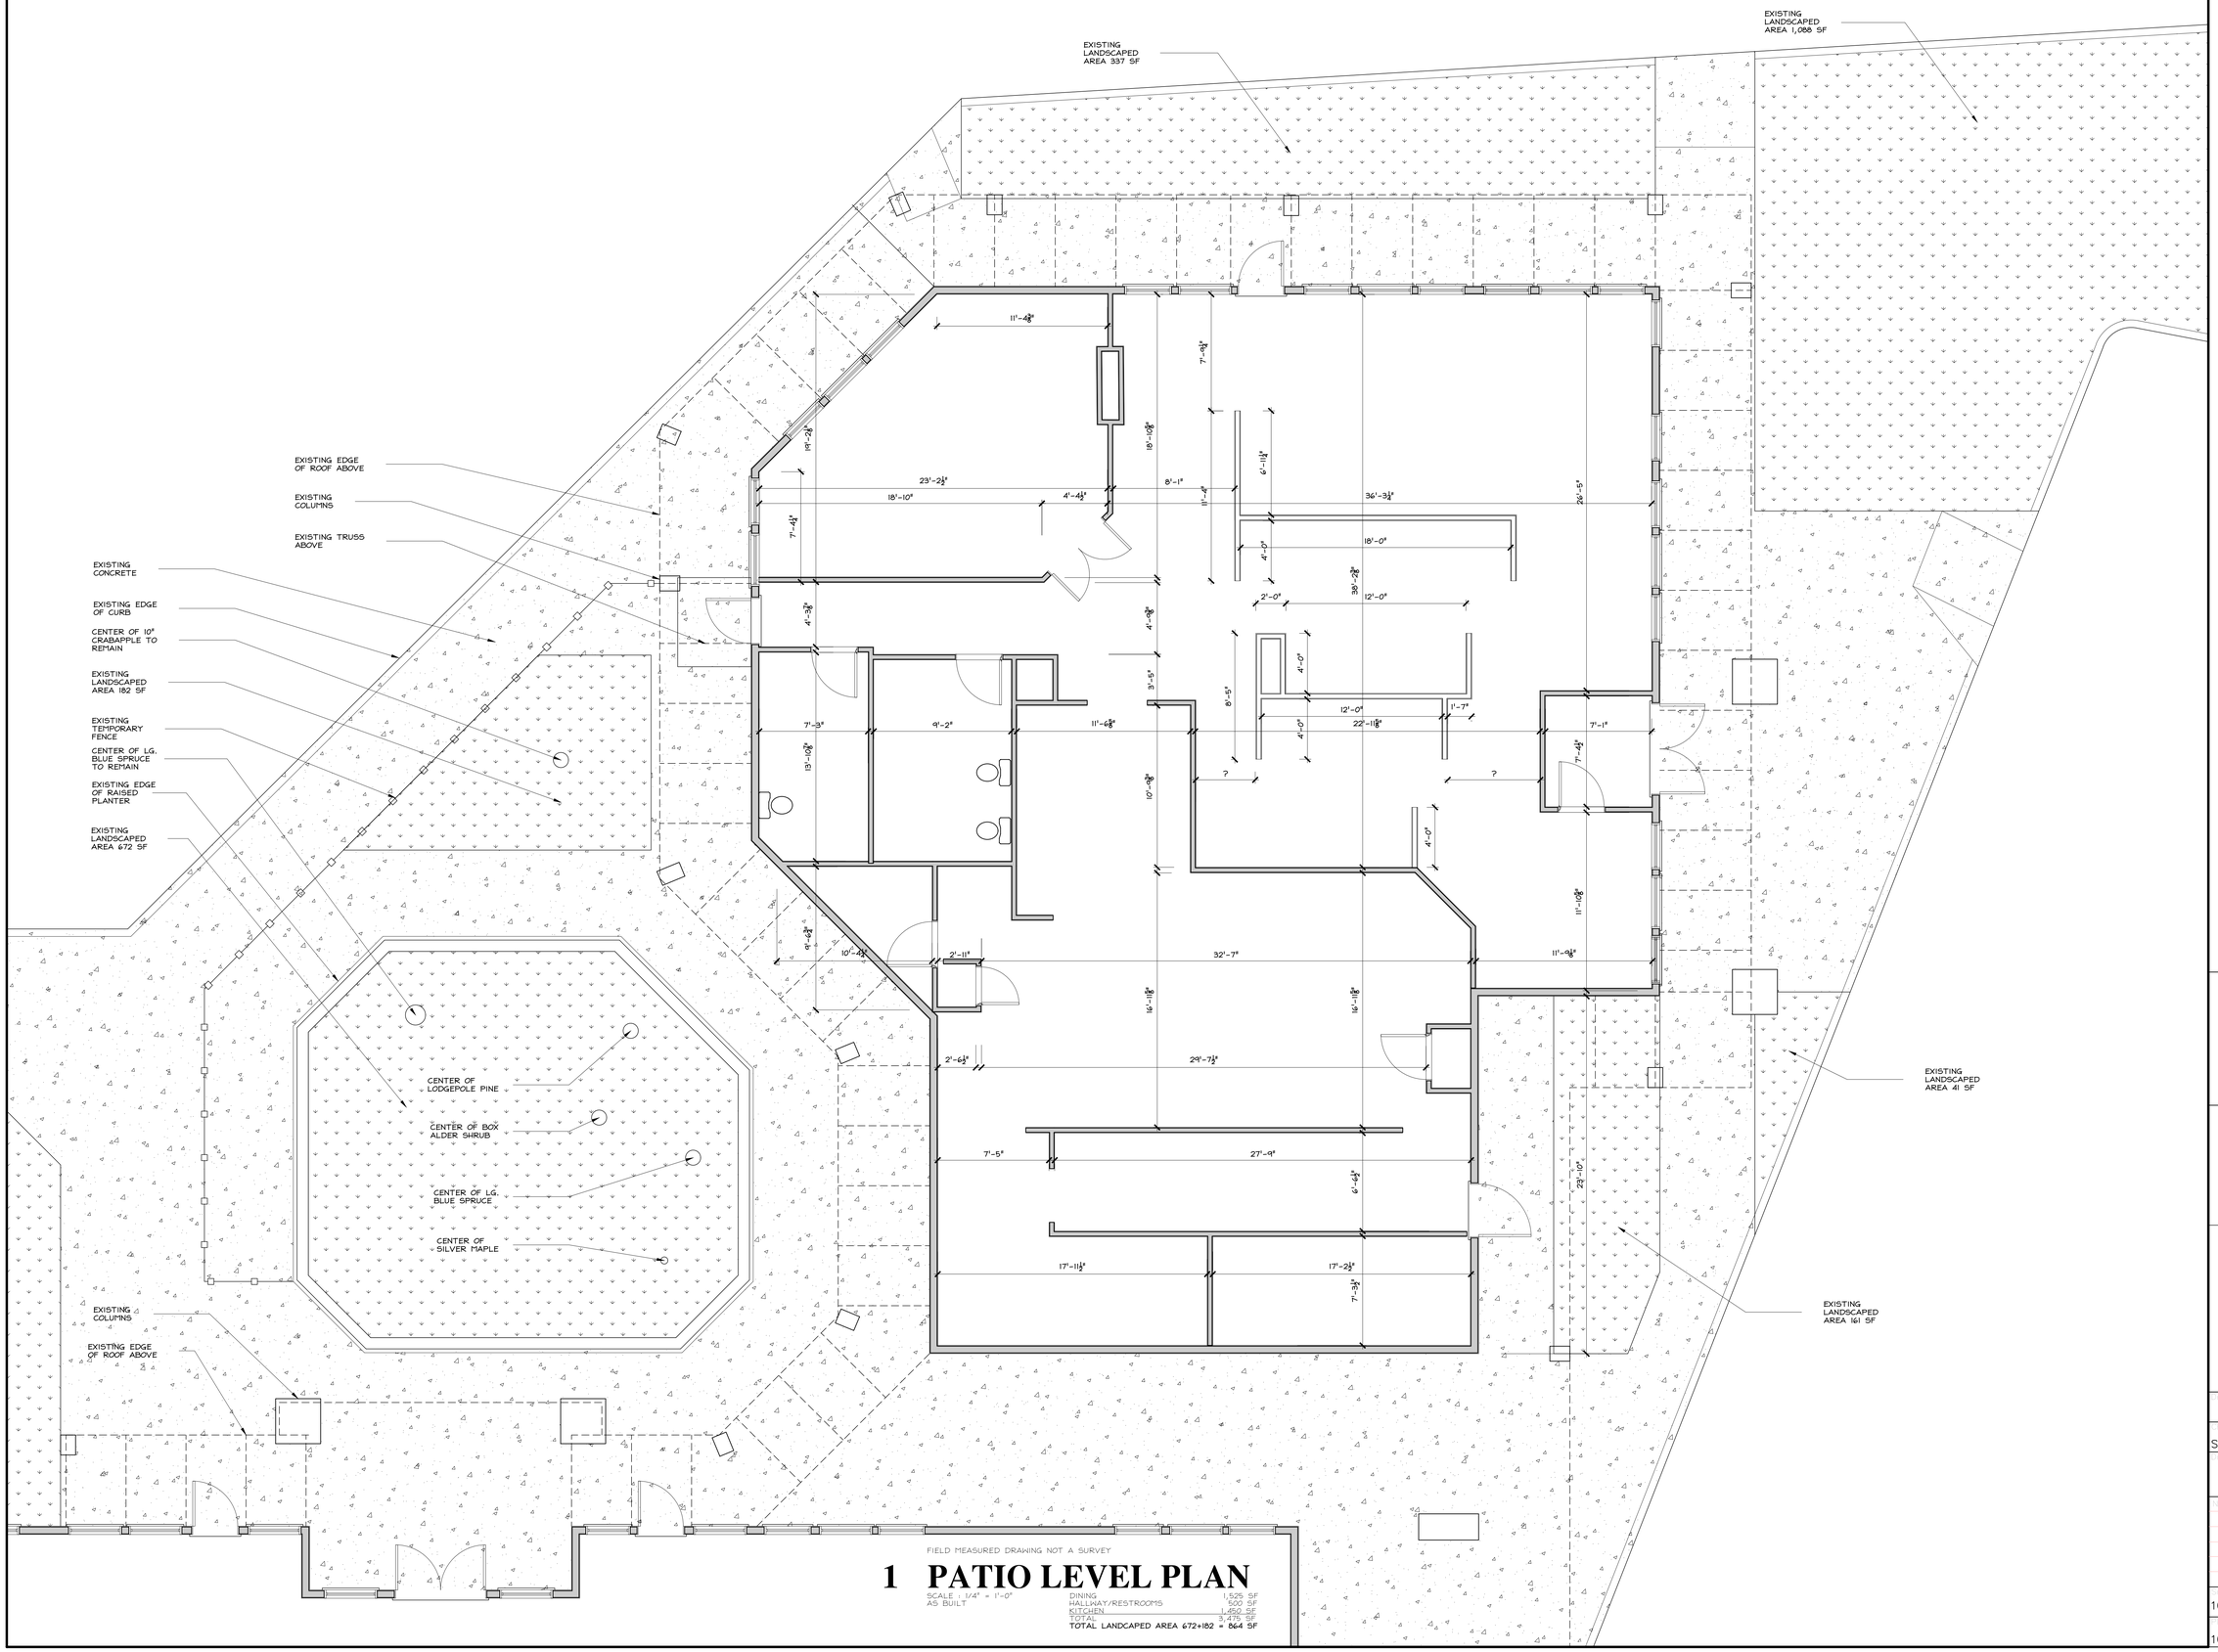

FIELD MEASURED DRAWING NOT A SURVEY

1 PATIO LEVEL PLAN

SCALE : 1/4" = 1'-0"
AS BUILT

DINING	1,525 SF
HALLWAY/RESTROOMS	500 SF
KITCHEN	1,450 SF
TOTAL	3,475 SF

TOTAL LANDCAPED AREA 672+182 = 864 SF

The Egg
325 Anglers Drive
Steamboat Springs, CO

Sunscope LLC

Date:	Project Number: 202522
Drawn: SB	Drawing Number:
Drawing Title:	

No.	Revisions:	Date:

Issue Date: 10/02/2025	Drawing Number:
10/02/2025	